


O.D.O.T. DISTRICT 2 SURVEY OFFICE (USE ONLY)

PERSONNEL NOTES <u>MILLER</u> H.C. <u>MILLER</u> R.C. <u>BARRIERE</u> <u>BLUBAUGH</u> DWG BY <u>BLUBAUGH</u>	REFERENCE NO. <u>28</u> DATE <u>8/9/24</u> WEATHER <u>CLEAR</u> TEMP. <u>65</u> PID <u>114849</u>	SHEET <u>2</u> OF <u>46</u> ROUTE <u>SR 101</u> COUNTY <u>SENECA</u> TOWNSHIP <u>PLEASENT</u> SECTION <u>35</u> T <u>3</u> N R <u>15</u> E
--	--	---

TYPE MONUMENT <u>MAG/WASHER</u> ON SURFACE - BELOW <u>0.5"</u> OFFSET <u>1'</u> <u>LT</u> : <u>RT</u> -- TO -- <u>EDGE PAVEMENT</u> STATION: <u>342+58.44</u>	35 ●
--	--

HORZ.DATUM: <u>NAD83 2011</u> GRID: NORTHING: <u>549263.893</u> LDP: NORTHING: <u>318163.388</u>	GEOID: <u>NAVD88-2018</u> EASTING: <u>1804905.756</u> EASTING: <u>179389.425</u>
--	--

RECORD:
 STA.101+00
 FD. R.R. SPIKE
 SET P.K./WASHER
 8-27-90
 FD P.K./WASHER
 2-4-05, SAH
 SET P.K./WASHER
 6/30/09, DCH
 SET MAG/WASHER
 NEWREF28
 10-05-09, DCH
 FD MAG/WASHER
 REF28
 6-14-16, JFO
 FD MAG/WASHER
 REF28
 10-12-16, JFO
 9-18-17, JFO
 FD MAG/WASH
 REF28
 12/20/23, DSA
 FD TONE, DID NOT
 UNCOVER, PAINTED
 8/9/24, JAM

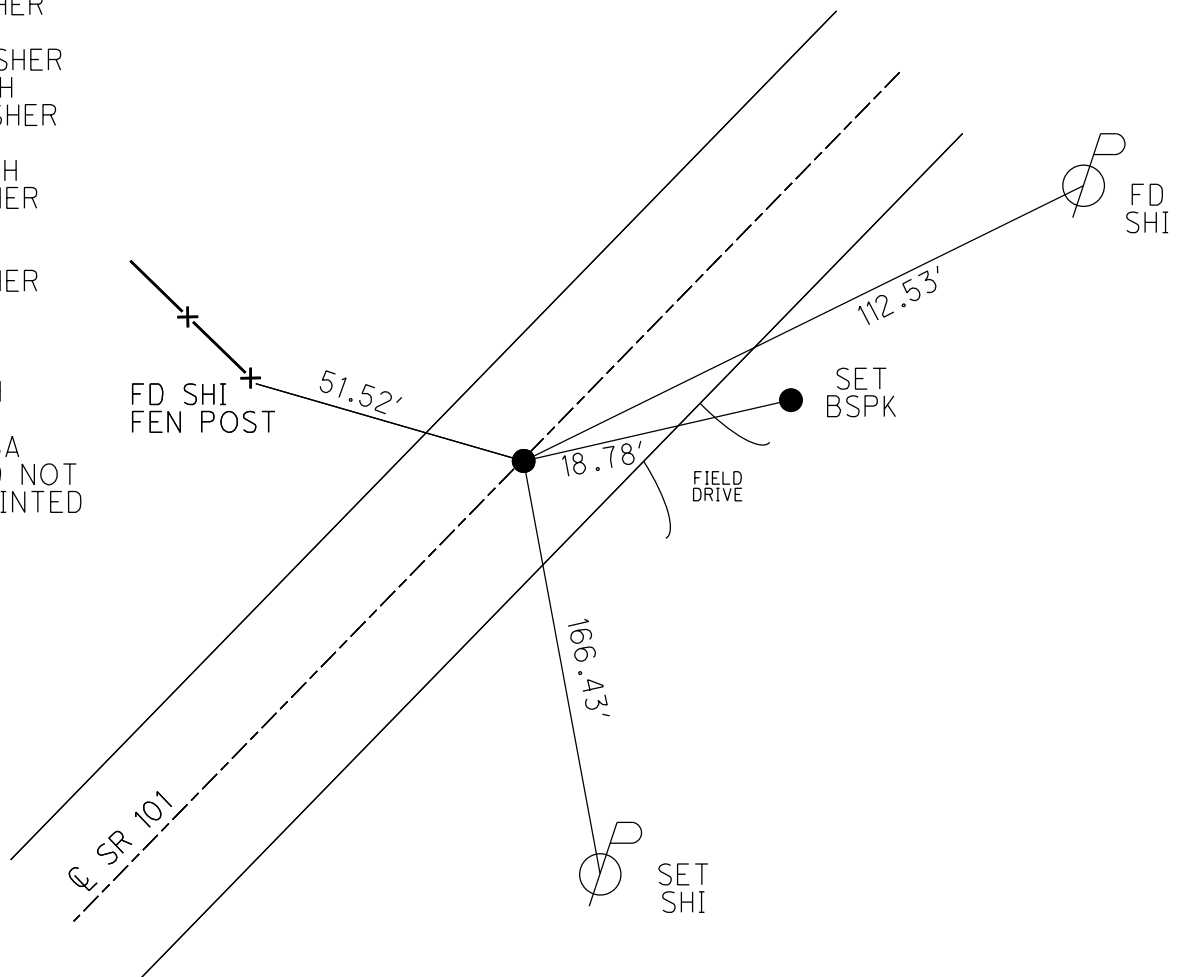


O.D.O.T. DISTRICT 2 SURVEY OFFICE (USE ONLY)


PERSONNEL _____ REFERENCE NO. 28 SHEET 2 OF 46
 NOTES HOMAN DATE 6-30-09 ROUTE SR 101
 H.C. HOMAN WEATHER CLOUDY COUNTY SENECA
 R.C. ROUSOS TEMP. 65°F TOWNSHIP PLEASENT
 SECTION 35
 DWG BY MAHLER PID 100787 T 3 N R 15 E

TYPE MONUMENT MAG/WASHER
 ON SURFACE - ~~BELOW~~ ON
 OFFSET Q PAVEMENT 1' LT : ~~RT~~
- TO - EDGE PAVEMENT
 STATION: 342+58.44

HORZ.DATUM: NAD83 2011 GEOID: NAVD88-2012A
 GRID: NORTHING: 549263.893 EASTING: 1804905.756

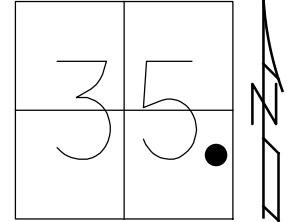


RECORD:
 STA.101+00
 FD. R.R. SPIKE
 SET P.K./WASHER
 8-27-90
 FD P.K./WASHER
 2-4-05, SAH
 SET P.K./WASHER
 6/30/09, DCH
 SET MAG/WASHER
 NEWREF28
 10-05-09, DCH
 FD MAG/WASHER
 REF28
 6-14-16, JFO
 FD MAG/WASHER
 REF28
 10-12-16, JFO
 9-18-17, JFO

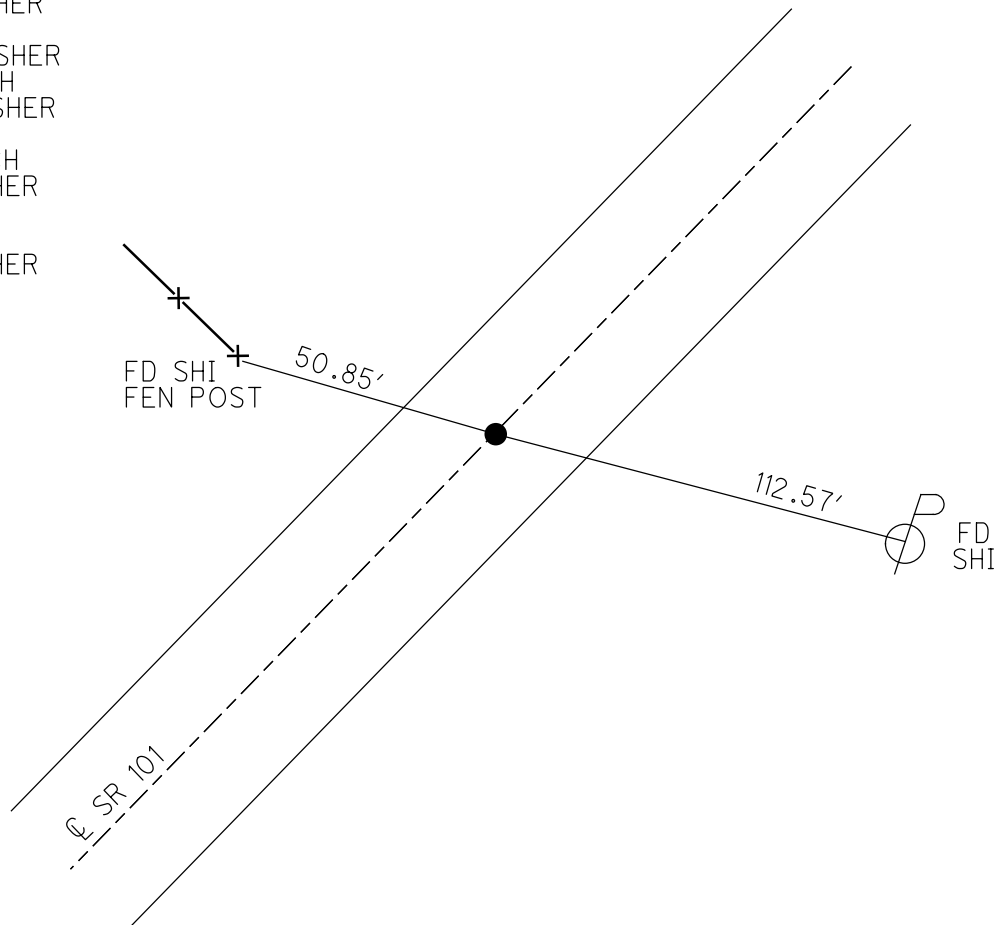


O.D.O.T. DISTRICT 2 SURVEY OFFICE (USE ONLY)

PERSONNEL _____ REFERENCE NO. 28 SHEET 2 OF 46
 NOTES _____ DATE 6/30/09 ROUTE SR 101
 H.C. HOMAN WEATHER CLOUDY COUNTY SENECA
 R.C. ROUSOS TEMP. 65° TOWNSHIP PLEASANT
 _____ SECTION 35
 _____ T 3 N R 15 E

TYPE MONUMENT MAG/WASHER
 ON SURFACE - ~~BELOW~~ ON
 LEFT - ℄ PAV'T - ~~RIGHT~~ 1'
 _____ TO _____ EDGE PAVEMENT
 S.L.M. 342+58.44
 GRID: NORTHING: 549263.910 EASTING: 1804905.743

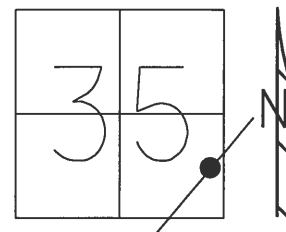

RECORD:
 STA.101+00
 FD. R.R. SPIKE
 SET P.K./WASHER
 8-27-90
 FD P.K./WASHER
 2-4-05, SAH
 SET P.K./WASHER
 6/30/09, DCH
 SET MAG/WASHER
 10-05-09, DCH
 FD MAG/WASHER
 REF28
 6-14-16, JFO
 FD MAG/WASHER
 REF28
 10-12-16, JFO
 9-18-17, JFO

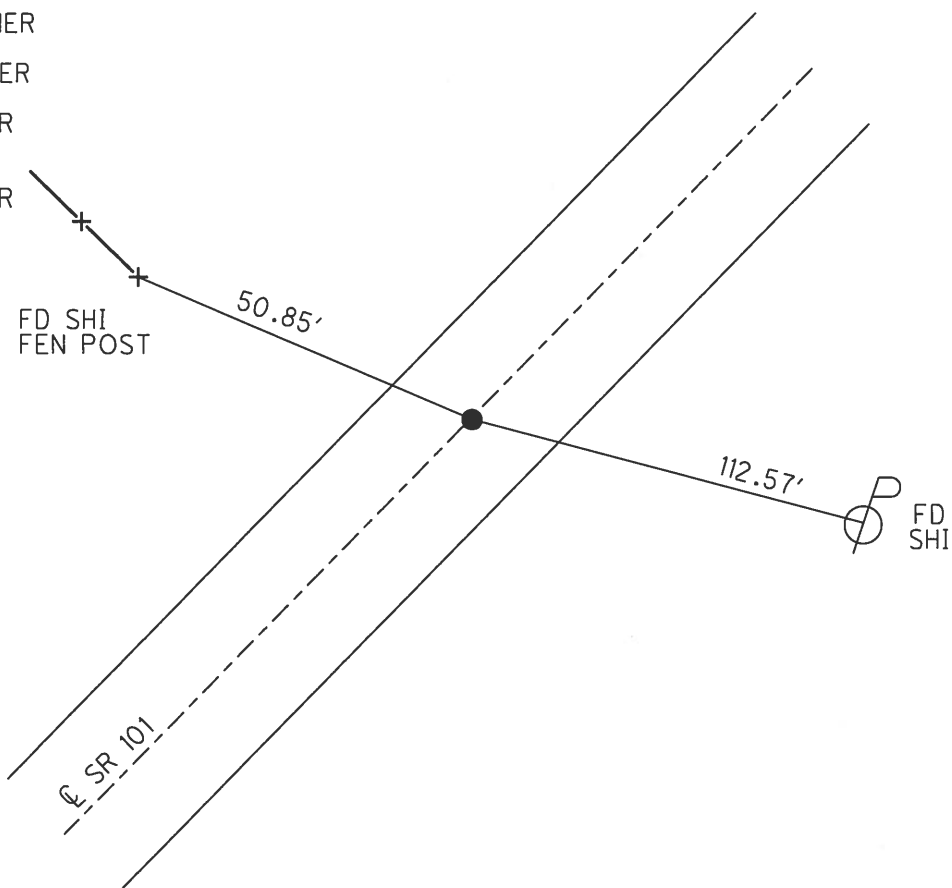

O.D.O.T. DISTRICT 2 SURVEY OFFICE (USE ONLY)

PERSONNEL

REFERENCE NO. 28

SHEET 2 OF 46

NOTES

HOMAN

DATE

6/30/09

ROUTE

SR 101

H.C.

HOMAN

WEATHER

CLOUDY

COUNTY

SENECA

R.C.

ROUSOS

TEMP.

65°

TOWNSHIP

PLEASANT

SECTION

35

T 3 N R 15 E

TYPE MONUMENT

P.K./WASHER

ON SURFACE - ~~BELOW~~

ON

LEFT - Q PAV'T - ~~RIGHT~~

1'


- TO - EDGE PAVEMENT

S.L.M.

342+57

GRID: NORTHING: 549263.893

EASTING: 1804905.756

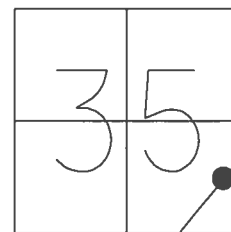

RECORD:

STA.101+00

FD. R.R. SPIKE

SET P.K./WASHER

8/27/90

FD P.K./WASHER

2/4/05, SAH

SET MAG/WASHER

10-05-09, DH


FD MAG/WASHER

REF28

6/14/16, JFO

UNCOVERED

9/18/17, JFO

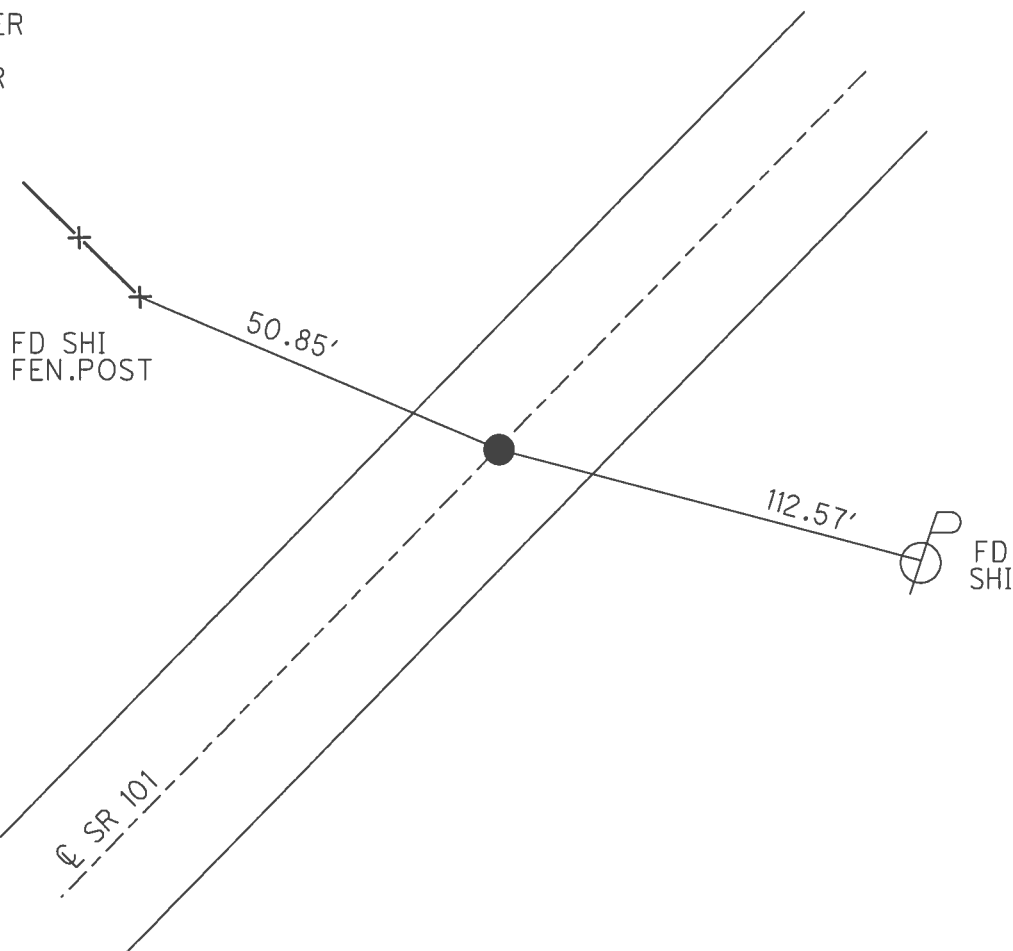


O.D.O.T. DISTRICT 2 SURVEY OFFICE (USE ONLY)


PERSONNEL _____ REFERENCE NO. 28 SHEET 2 OF 46
 NOTES HOMAN DATE 6-30-09 ROUTE SR 101
 H.C. HOMAN WEATHER CLOUDY COUNTY SENECA
 R.C. ROUSOS TEMP. 65° TOWNSHIP PLEASANT
 SECTION 35
 T 3 N R 15 E

TYPE MONUMENT P.K./WASHER
 ON SURFACE - ~~BELOW~~ ON _____
 LEFT - Q PAV'T - ~~RIGHT~~ 1'
 - TO - EDGE PAVEMENT
 S.L.M. 342+57

GRID: NORTHING: 549263.935 EASTING: 1804905.698

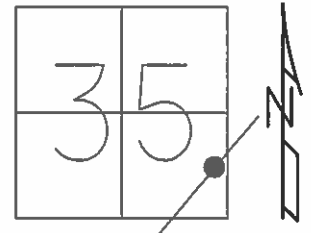

RECORD:
 STA.101+00
 FD. R.R. SPIKE
 SET P.K./WASHER
 8/27/90
 FD P.K./WASHER
 2/4/05, SAH
 SET MAG/WASHER
 10-05-09, DH

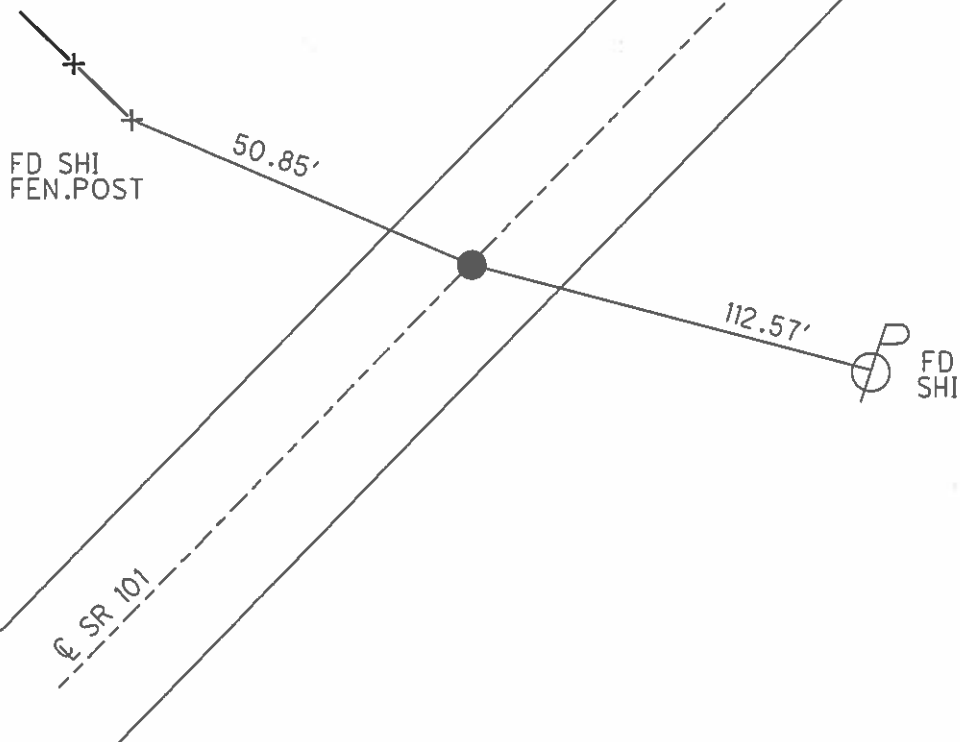

O.D.O.T. DISTRICT 2 SURVEY OFFICE

PERSONNEL

REFERENCE NO. 28

SHEET 2 OF 41

NOTES RIPPLE

H.C. BARBOUR

R.C. _____

DATE 8/27/90

WEATHER SUNNY

TEMP. 73°

ROUTE SR#101

COUNTY SENeca

TOWNSHIP PLEASANT

SECTION 35

T3 N R 15 E


TYPE MONUMENT Set. P.K. & WASHER

ON SURFACE - BELOW R.R. SPIKE


LEFT- & PAV'T. - RIGHT 1' LT. & PAV'T

TO EDGE PAVEMENT

S.L.M. _____

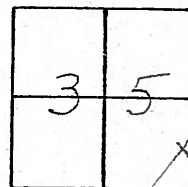

342+57

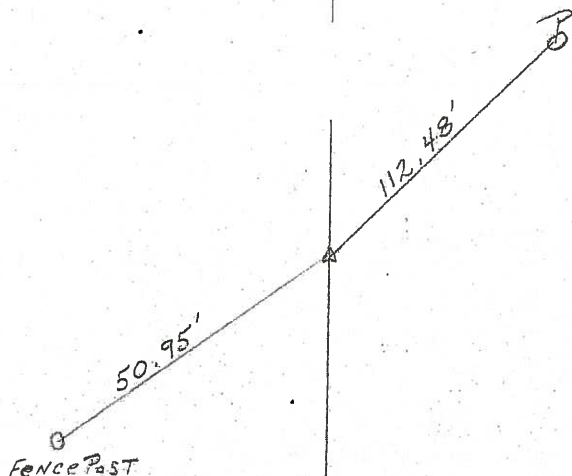

101+00

R/W SR#101

Fd

02-04-05

SAH

O.D.O.T. DISTRICT 2 SURVEY OFFICE

PERSONNEL

REFERENCE NO. 28

SHEET 2 OF 41

NOTES Ripple

H.C. Barbour

R.C. _____

DATE 8/27/90

WEATHER SUNNY

TEMP. 73°

ROUTE SR #101

COUNTY Seneca

TOWNSHIP Pleasant

SECTION 35

T3 N R 15 E



TYPE MONUMENT Set. P.K. & Washer

ON SURFACE - BELOW R.R. spike

LEFT- & PAV'T. - RIGHT 1' LT. & PAV'T

TO _____ EDGE PAVEMENT

S.L.M. _____

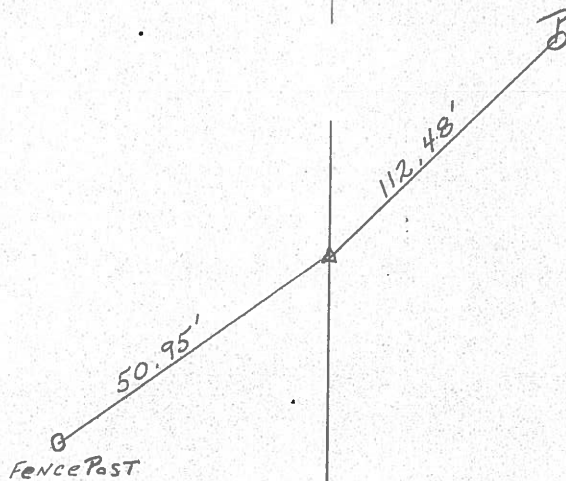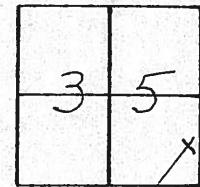

101+00

Q.D.O.T. DISTRICT 2 SURVEY OFFICE

Sht. ____ of ____

County Seneca S.R. 101

Township Pleasant

Section 35

T₃N, R₁₅E

Personnel Schneider

Mosser



Barbour

Date 6-26-79


Weather Fair

Temp. 65°

(28)

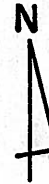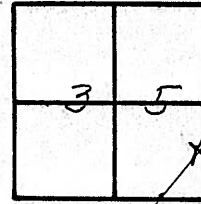

~~34~~

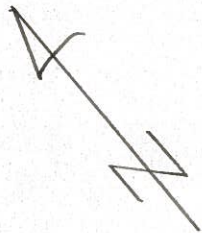


101+00

R.R. spk. on ϕ R/W

Reset P. K. Nail

$\Delta = 0^\circ - 2' \text{ LT.}$

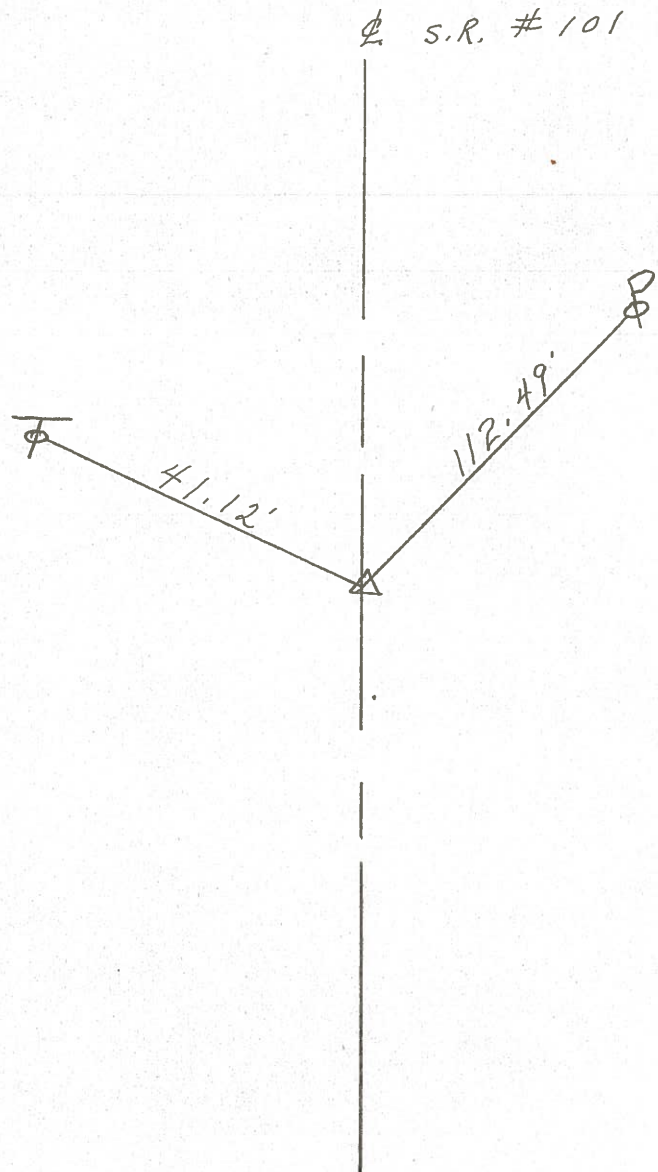

PERSONNEL TITLE PERSONNEL TITLE

COUNTY Seneca DATE 11-23-69

S. R. # 101 WEATHER

SEC TEMP. 50°

DESCRIPTION LEFT CENTER LINE RIGHT JOB NO.

(29)

Ties Good 2/24/69
Sta. 115+72
R.R. spk. on & R/W
1/2" below surface

~~381~~

8477

(28)

Ties Good 2/24/69
Sta. 191+00
R.R. spk. on & R/W
1/2" below surface

~~380~~

8476

(27)

P.K. R.R. spk. on & R/W
1" & 2" below surface

8475

~~379~~

Found
2-24-69

8935
3792
126
417

(26)

Ties Good 2/24/69
Sta. 194+35.6
R.R. spk. on & R/W
on surface
2' R.R. & P.T.


8474

~~378~~

Found
2-24-69

(25)

Found R.R. spk.
on surface
8492

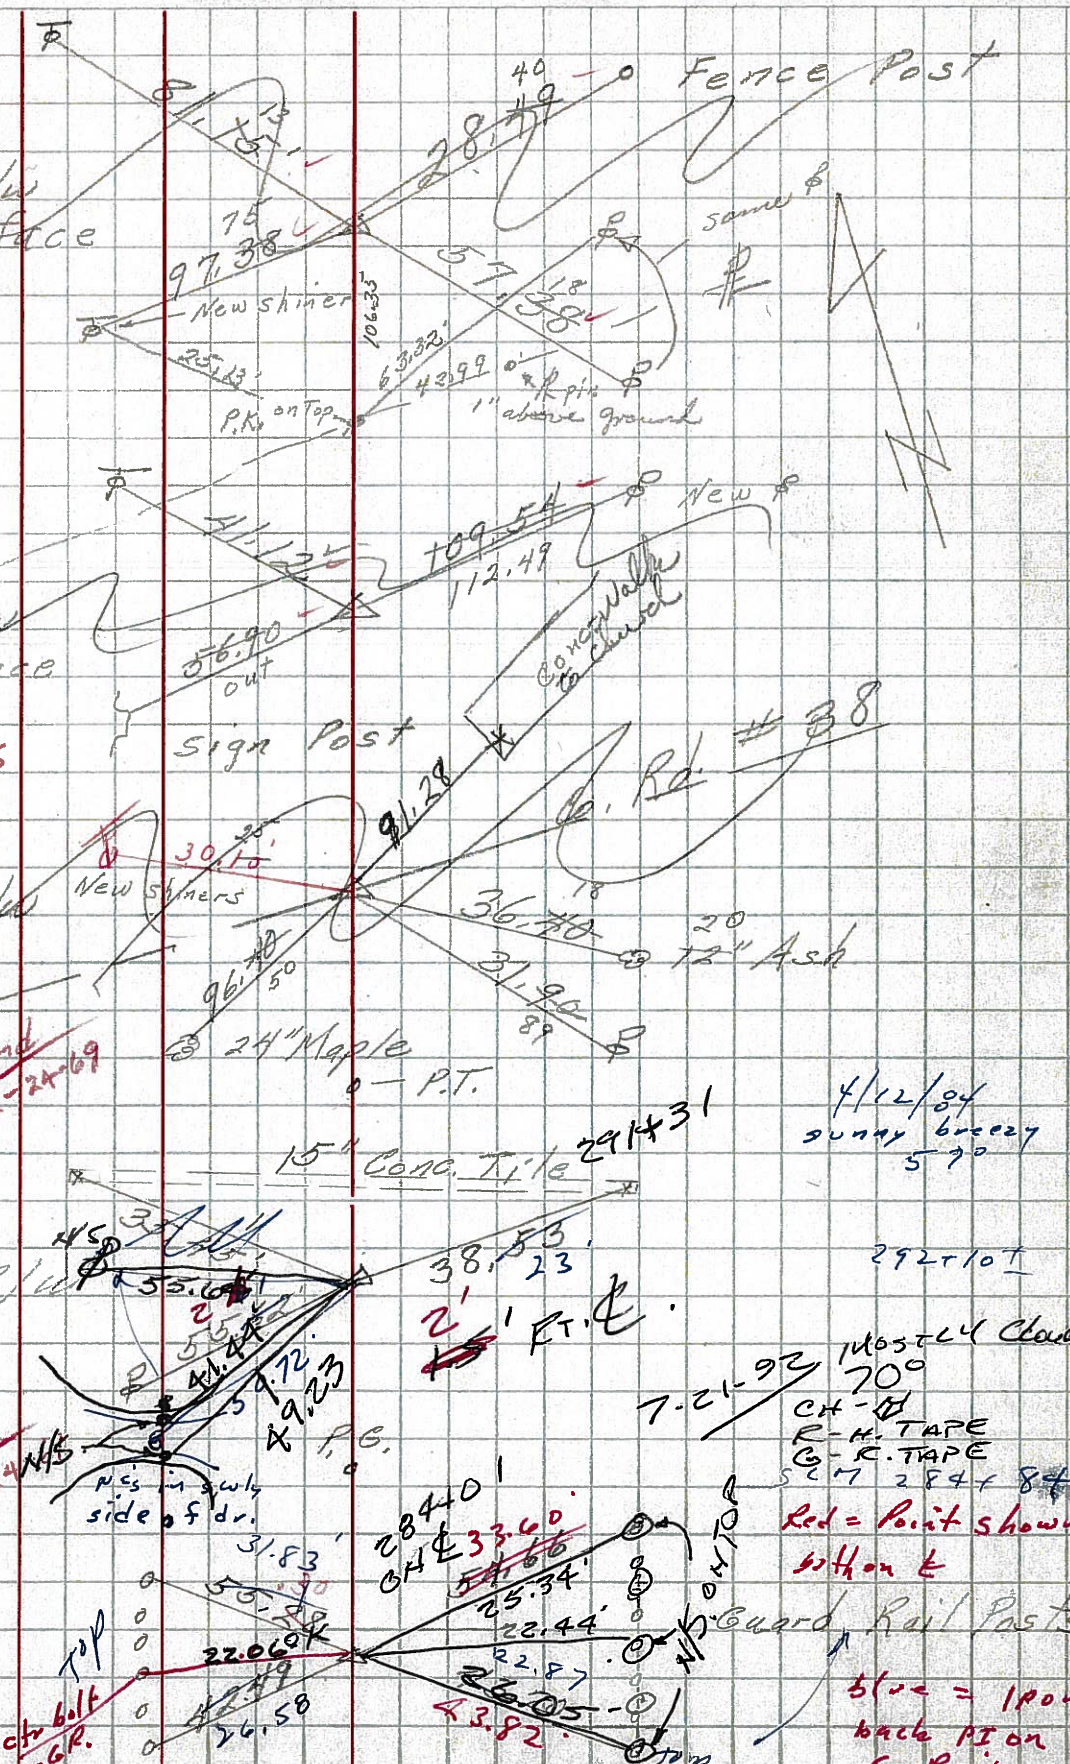

4/12/84
sunny breezy
57°

292+10

7-21-92 mostly clear
700
CH-TAPE
R-H. TAPE
G-R. TAPE
SEM 284+84

Red = Point shown
both on &

blue = 190+
back RI on
G Rail

PERSONNEL	TITLE	PERSONNEL	TITLE	COUNTY	DATE	S. R.	WEATHER	SEC.	TEMP.
F Krabill				Seneca		101			
Kowaleski									
Geyman									
Bruggman									

DESCRIPTION	LEFT	CENTER LINE	RIGHT	JOB NO.
-------------	------	-------------	-------	---------

