

O.D.O.T. DISTRICT 2 SURVEY OFFICE (USE ONLY)

PERSONNEL

REFERENCE NO. 29 A

SHEET 4 OF 46

NOTES MILLER

DATE 8/9/24

ROUTE SR 101

H.C. MILLER

WEATHER SUNNY

COUNTY SENECA

R.C. BARRIERE

TEMP. 66

TOWNSHIP PLEASENT

BLUBAUGH

SECTION 36

DWG BY BLUBAUGH

PID 114849

T 3 N R 15 E

TYPE MONUMENT MAG/WASHER

ON SURFACE - ~~BELOW~~ ON

OFFSET $\mathcal{C}$ PAVEMENT ON LT : RT

-- TO -- EDGE PAVEMENT

STATION: 356+29

HORIZ.DATUM: NAD83 2011


GEOID: NAVD88-2018

GRID: NORTHING: 550274.265

EASTING: 1805831.787

LDP: NORTHING: 319180.655


EASTING: 180308.064

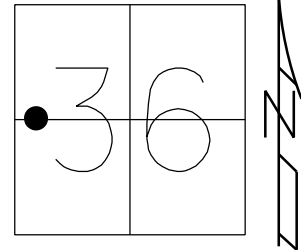

RECORD:

D.N.F.
2/4/05, SAH
FD P.K./WASHER
REFB29
7/14/09, DCH
SET MAG/WASHER
NEWREFB29
10/8/09, DCH
D.N.F.
6/14/16, JFO
FD MAG/W
REF29A
12/20/23, DSA
FD TONE. DID NOT UNCOVER, PAINTED
8/9/24, JAM

DIST.
29-29A = 8.79'
29-29B = 106.47'
29A-29B = 97.69'

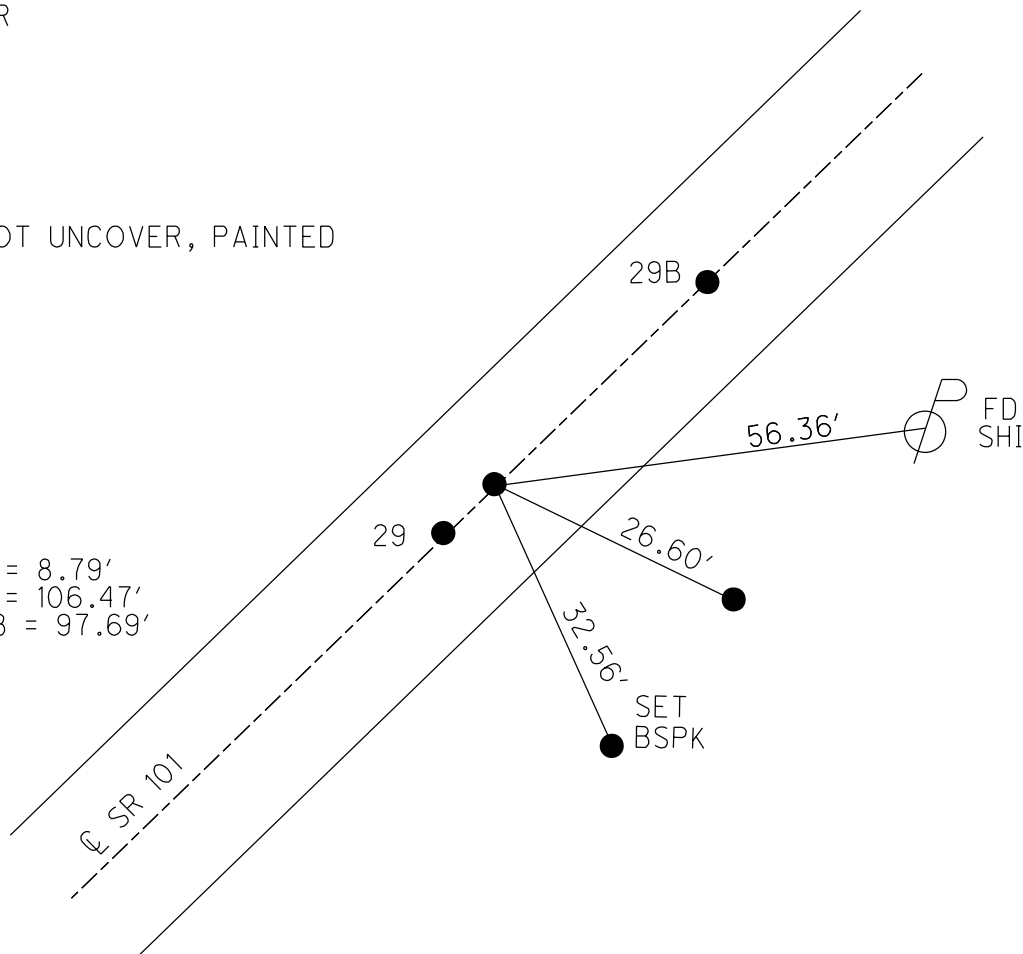

O.D.O.T. DISTRICT 2 SURVEY OFFICE (USE ONLY)

PERSONNEL

REFERENCE NO. 29 A

SHEET 4 OF 46

NOTES HOMAN

DATE 7-14-09

ROUTE SR 101

H.C. HOMAN

WEATHER SUNNY

COUNTY SENECA

R.C. ROUSOS

TEMP. 75°F

TOWNSHIP PLEASENT

SECTION 36

DWG BY MAHLER

PID 100787

T 3 N R 15 E

TYPE MONUMENT MAG NAIL

ON SURFACE - ~~BELOW~~ ON

OFFSET Q PAVEMENT ON LT : RT

- TO - EDGE PAVEMENT


STATION: 356+29

HORZ.DATUM: NAD83 2009

GEOID: NAVD88-2009

GRID: NORTHING: 550274.265

EASTING: 1805831.787

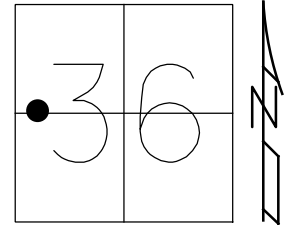

RECORD:

D.N.F.

2/4/05, SAH

FD P.K./WASHER

REFB29

7/14/09, DCH

SET MAG/WASHER

NEWREFB29

10/8/09, DCH

D.N.F.


6/14/16, JFO

DIST.

29-29A = 8.70'

29-29B = 106.40'

29A-29B = 97.70'

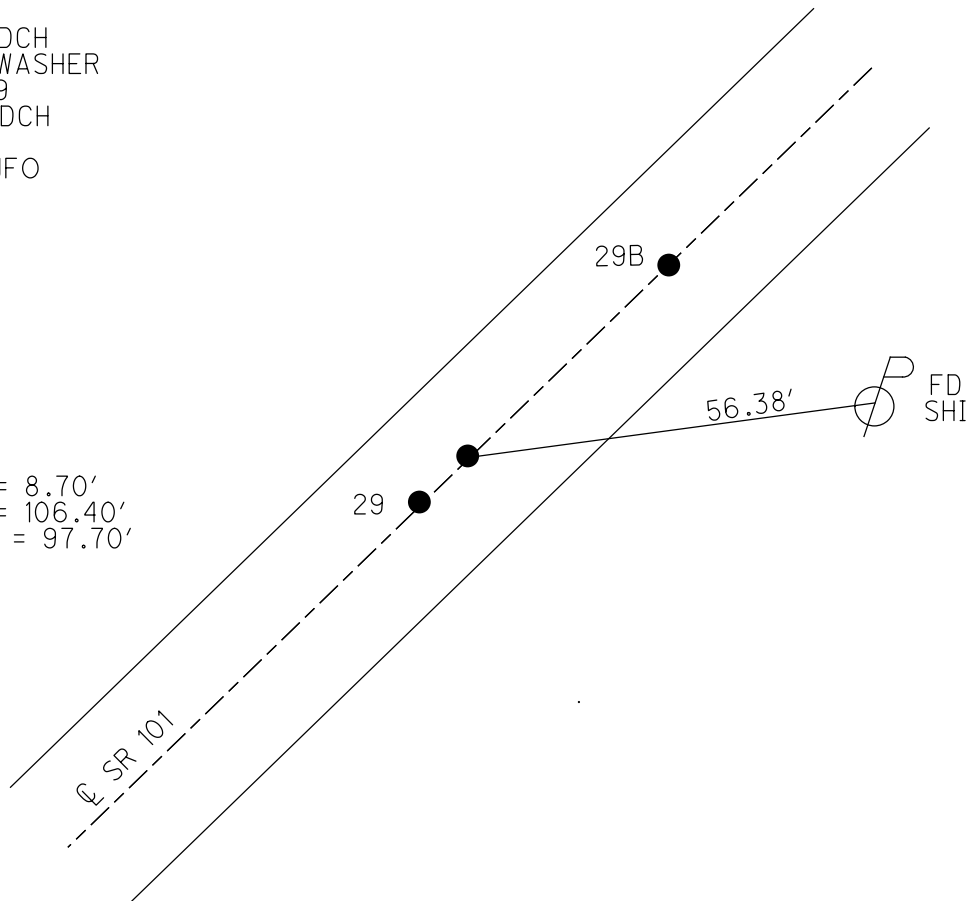

O.D.O.T. DISTRICT 2 SURVEY OFFICE (USE ONLY)

PERSONNEL

REFERENCE NO.

29 A

SHEET

4

OF 46

NOTES

HOMAN

DATE

7/14/09

ROUTE

SR 101

H.C.

HOMAN

WEATHER

SUNNY

COUNTY

SENECA

R.C.

ROUSOS

TEMP.

75°

TOWNSHIP

PLEASANT

SECTION

36

T 3 N

R 15 E

TYPE MONUMENT

P.K.NAIL

~~ON SURFACE~~ - BELOW

1 1/2"

LEFT - C PAV'T - RIGHT ON


TO EDGE PAVEMENT

S.L.M.

356+29

GRID: NORTHING: -

EASTING: -

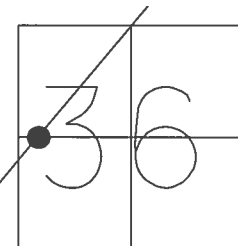

RECORD:

D.N.F.

2/4/05, SAH


6/14/16, JFO

DIST.

29-29A = 8.70'

29-29B = 106.40'

29A-29B = 97.70'

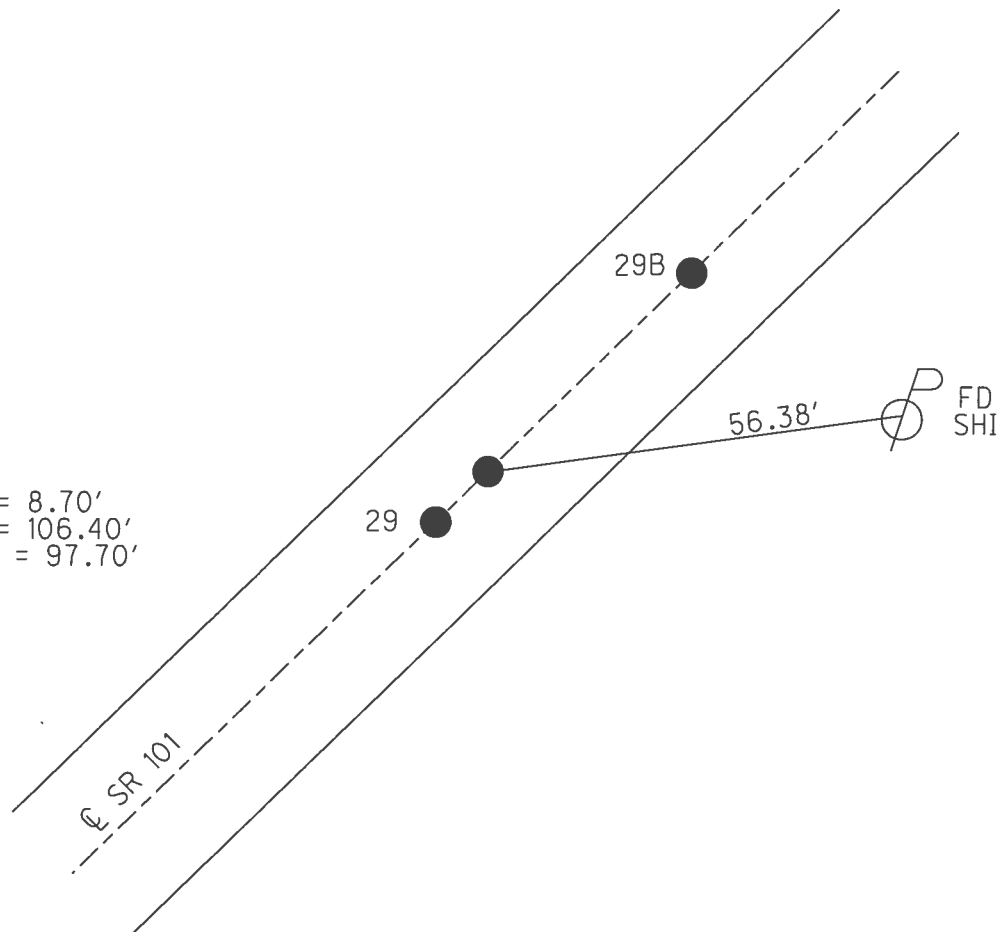

O.D.O.T. DISTRICT 2 SURVEY OFFICE (USE ONLY)

PERSONNEL

REFERENCE NO.

29 A

SHEET

4

OF 46

NOTES

HOMAN

DATE

7/14/09

ROUTE

SR 101

H.C.

HOMAN

WEATHER

SUNNY

COUNTY

SENECA

R.C.

ROUSOS

TEMP.

75°

TOWNSHIP

PLEASANT

SECTION

36

T 3 N R 15 E

TYPE MONUMENT

P.K.NAIL

~~ON SURFACE~~ - BELOW


1 1/2"

LEFT - C PAV'T - RIGHT ON

TO EDGE PAVEMENT

S.L.M. 356+29

GRID: NORTHING: 550346.277 EASTING: 1805897.737

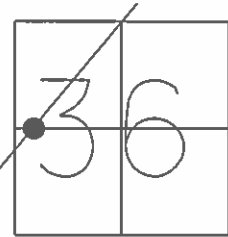

RECORD:
SET MAG & WASHER
10-08-09, DH

DIST.
29-29A = 8.70'
29-29B = 106.40'
29A-29B = 97.70'

