


O.D.O.T. DISTRICT 2 SURVEY OFFICE (USE ONLY)

PERSONNEL NOTES <u>MILLER</u> H.C. <u>MILLER</u> R.C. <u>BARRIERE</u> <u>BLUBAUGH</u> DWG BY <u>BLUBAUGH</u>	REFERENCE NO. <u>29 B</u> DATE <u>8/9/24</u> WEATHER <u>SUNNY</u> TEMP. <u>66</u> PID <u>114849</u>	SHEET <u>5</u> OF <u>46</u> ROUTE <u>SR 101</u> COUNTY <u>SENECA</u> TOWNSHIP <u>PLEASENT</u> SECTION <u>36</u> T <u>3</u> N R <u>15</u> E
--	--	---


TYPE MONUMENT MAG/WASHER
ON SURFACE - BELOW 2.0"
OFFSET $\mathcal{C}$ PAVEMENT ON **LT : RT**
-- **TO** -- **EDGE PAVEMENT**
STATION: 357+26

HORIZ.DATUM: <u>NAD83 2011</u>	GEOID: <u>NAVD88-2018</u>
GRID: NORTHING: <u>550346.303</u>	EASTING: <u>1805897.713</u>
LDP: NORTHING: <u>319253.268</u>	EASTING: <u>180373.417</u>

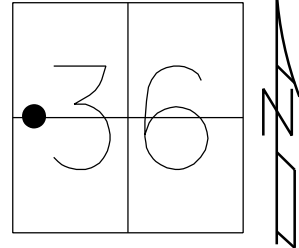

RECORD:
 FD MAG NAIL
 REFA29
 7/14/09, DCH
 SET MAG/WASHER
 NEWREFA29
 10-08-09, DCH
 FD MAG/WASHER
 REFA29
 6/14/16
 9/18/17, JFO
 FD MAG/W
 REF29B
 12/20/23, DSA
 FD TONE.DID NOT UNCOVER, PAINTED
 8/9/24, JAM

DIST.
 29-29A = 8.79'
 29-29B = 106.47'
 29A-29B = 97.69'

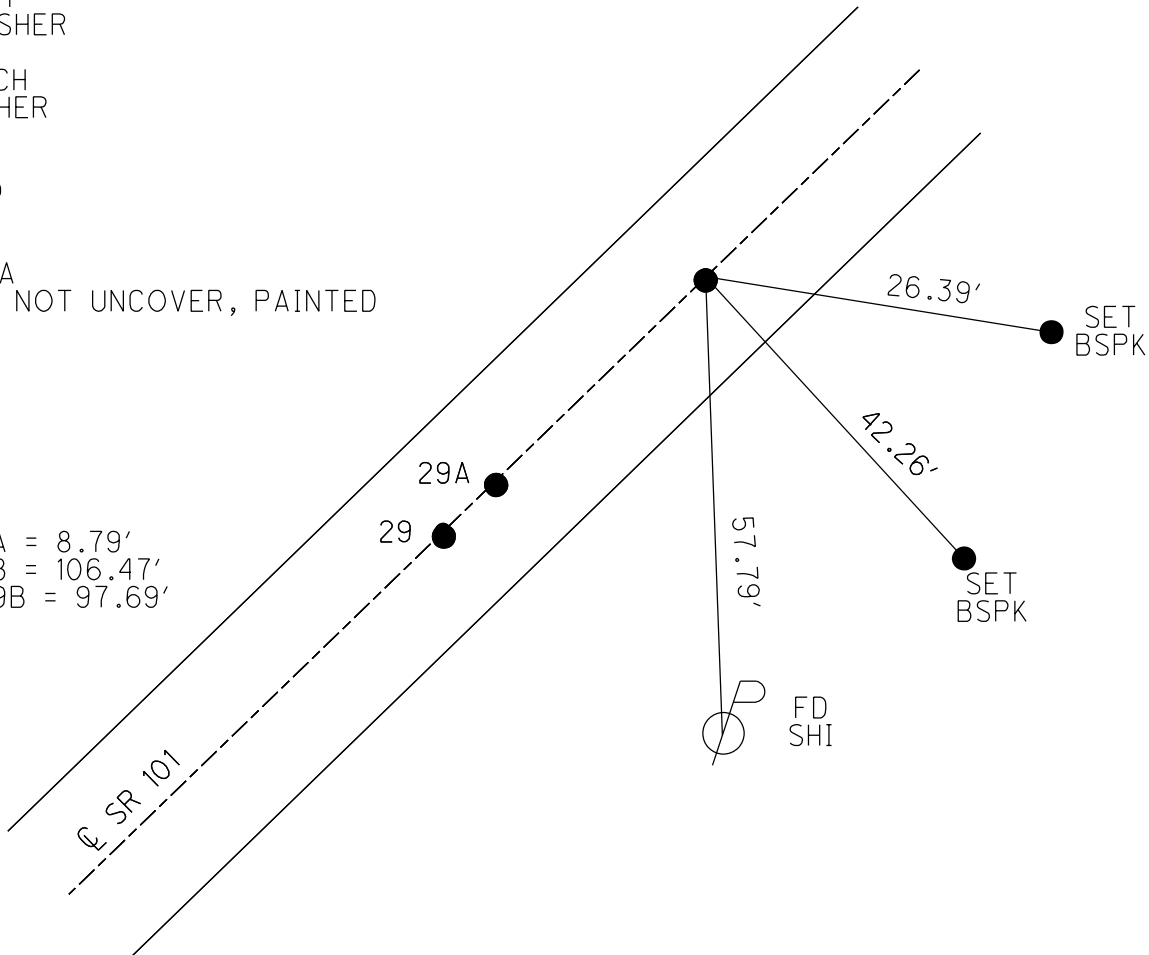

O.D.O.T. DISTRICT 2 SURVEY OFFICE (USE ONLY)

PERSONNEL

REFERENCE NO. 29 B

SHEET 5 OF 46

NOTES HOMAN

DATE 7-14-09

ROUTE SR 101

H.C. HOMAN

WEATHER SUNNY

COUNTY SENECA

R.C. ROUSOS

TEMP. 75°F

TOWNSHIP PLEASENT

DWG BY MAHLER

PID 100787

SECTION 36

T 3 N R 15 E

TYPE MONUMENT P.K./WASHER

~~ON SURFACE~~ - BELOW 1.5"

OFFSET Q PAVEMENT ON LT : RT

- TO - EDGE PAVEMENT


STATION: 357+26

HORZ.DATUM: NAD83 2011

GEOID: NAVD88-2012A


GRID: NORTHING: 550346.303

EASTING: 1805897.713

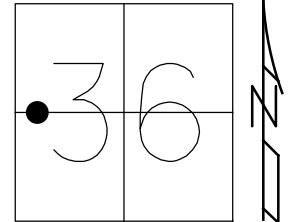

RECORD:
FD MAG NAIL
REFA29
7/14/09, DCH
SET MAG/WASHER
NEWREFA29
10-08-09, DCH
FD MAG/WASHER
REFA29
6/14/16
9/18/17, JFO

DIST.
29-29A = 8.70'
29-29B = 106.40'
29A-29B = 97.70'

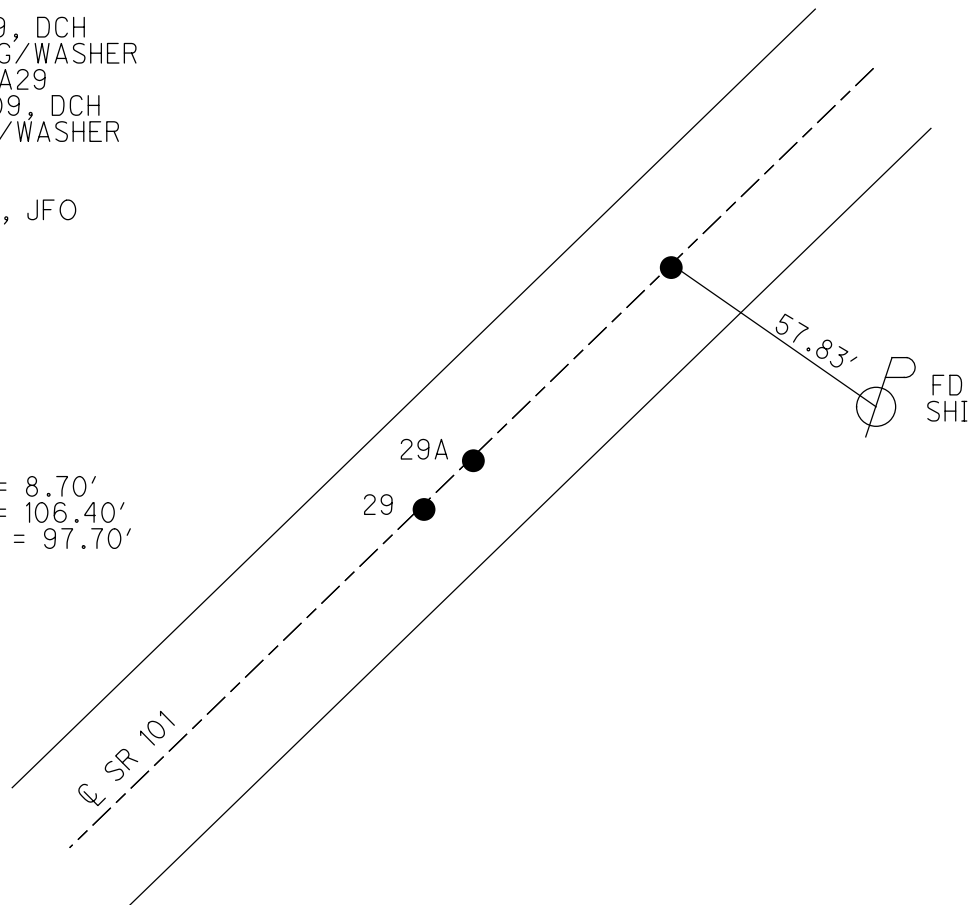

O.D.O.T. DISTRICT 2 SURVEY OFFICE (USE ONLY)

PERSONNEL

REFERENCE NO.

29 B

SHEET

5

OF 46

NOTES

HOMAN

DATE

7/14/09

ROUTE

SR 101

H.C.

HOMAN

WEATHER

SUNNY

COUNTY

SENECA

R.C.

ROUSOS

TEMP.

75°

TOWNSHIP

PLEASENT

SECTION

36

T 3 N

R 15 E

TYPE MONUMENT

MAG NAIL

~~ON SURFACE~~ - BELOW

1 1/2"

LEFT - C PAV'T - RIGHT

ON


- TO - EDGE PAVEMENT

S.L.M.

357+26

GRID: NORTHING: 550346.303

EASTING: 1805897.713

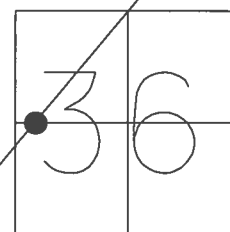

RECORD:

SET MAG & WASHER

10-08-09, DH

FD MAG/WASHER

REFA29

6/14/16, JFO

UNCOVERED


9/18/17, JFO

DIST.

29-29A = 8.70'

29-29B = 106.40'

29A-29B = 97.70'

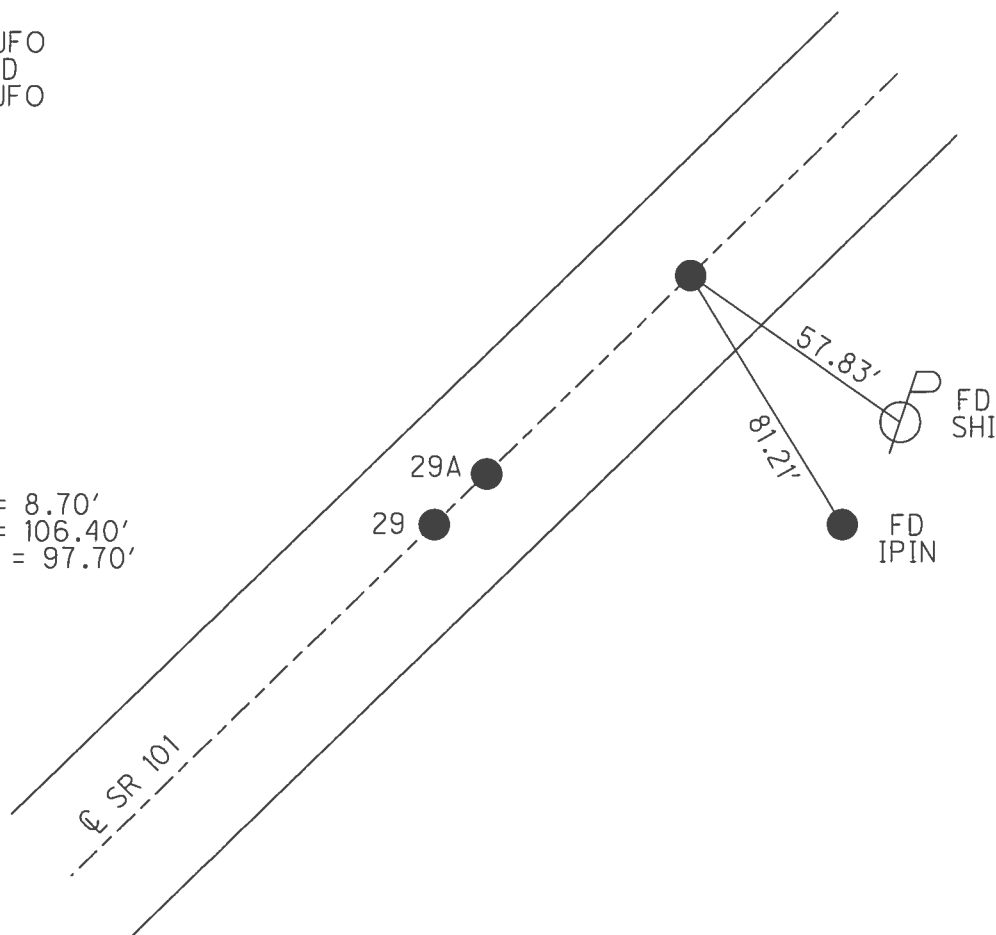

O.D.O.T. DISTRICT 2 SURVEY OFFICE (USE ONLY)

PERSONNEL

REFERENCE NO.

29 B

SHEET

5

OF

46

NOTES

HOMAN

DATE

7/14/09

ROUTE

SR 101

H.C.

HOMAN

WEATHER

SUNNY

COUNTY

SENECA

R.C.

ROUSOS

TEMP.

75°

TOWNSHIP

PLEASENT

SECTION

36

T 3 N

R 15 E

TYPE MONUMENT

MAG NAIL

~~ON SURFACE~~

- BELOW

1 1/2"

LEFT - C

PAV'T

- RIGHT

ON

- TO -


EDGE PAVEMENT

S.L.M.

357+26

GRID: NORTHING: 550346.277

EASTING: 1805897.737

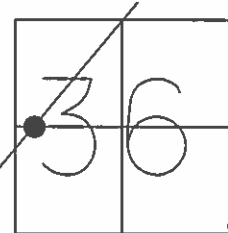

RECORD:

D.N.F.

2/4/05, SAH

SET MAG & WASHER


10-08-09, DH

DIST.

29-29A = 8.70'

29-29B = 106.40'

29A-29B = 97.70'

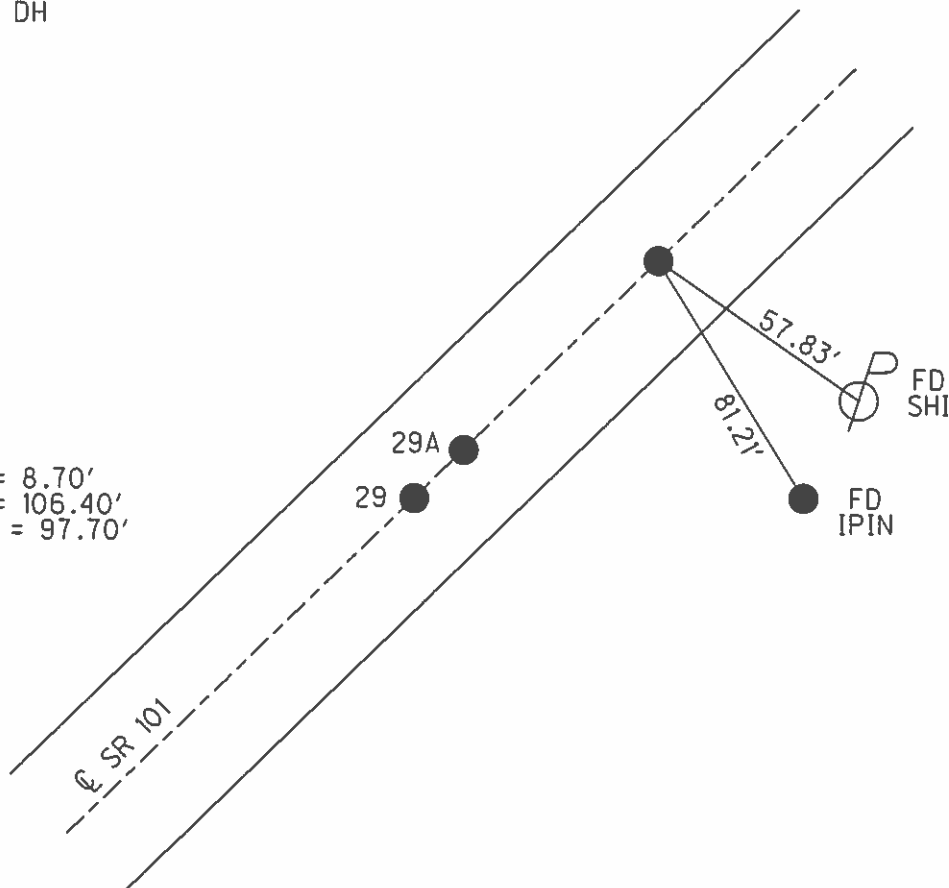

O.D.O.T. DISTRICT 2 SURVEY OFFICE

PERSONNEL

REFERENCE NO. 29

SHEET 3 OF 41

NOTES RIPPLE

H.C. BARBOUR

R.C. _____

DATE 8/27/90

WEATHER SUNNY

TEMP. 73°

ROUTE S.R.# 101

COUNTY SENECA

TOWNSHIP PLEASANT

SECTION 36


T. 3 N. R. 15 E.

TYPE MONUMENT SET P.K. & WASHER
ON SURFACE - BELOW P.K. NAIL AT TOP RR SPIKE

LEFT - & PAV'T. - RIGHT &

TO EDGE PAVEMENT


S.L.M. _____

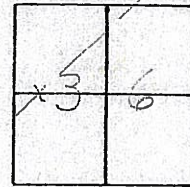

29-B

Ⓐ 356+20

B DNF

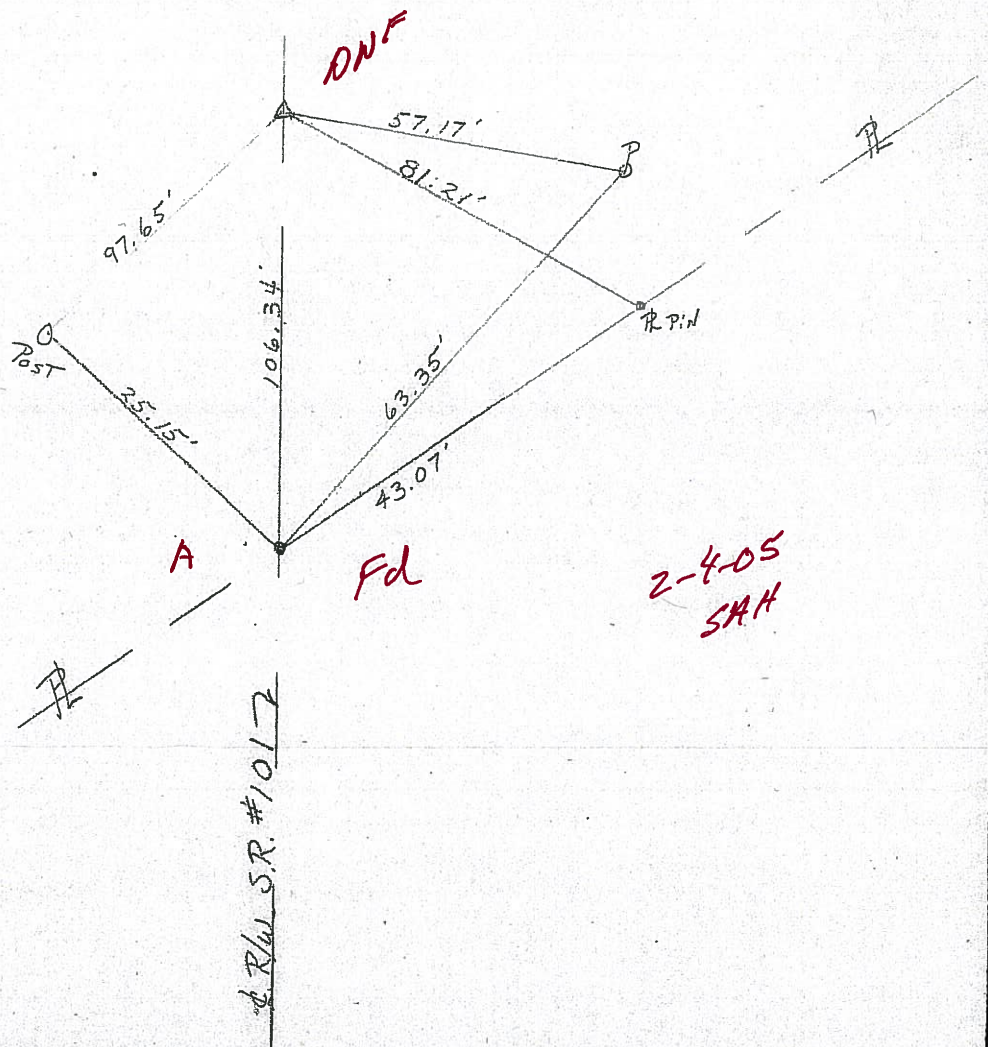

O.D.O.T. DISTRICT 2 SURVEY OFFICE

PERSONNEL

REFERENCE NO. 29

SHEET 3 OF 41

NOTES Ripple

H.C. Barbour

R.C. _____

DATE 8/27/90

WEATHER SUNNY

TEMP. 73°

ROUTE SR.# 101

COUNTY Seneca


TOWNSHIP Pleasant

SECTION 36


T 3 N R 15 E

TYPE MONUMENT Set P.K. & Washer
ON SURFACE - BELOW P.K. Nail at Top R/R spike
LEFT - ℄ PAV'T. - RIGHT ℄
____ TO ____ EDGE PAVEMENT
S.L.M. _____

(29-B)

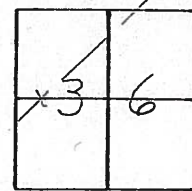


115+72

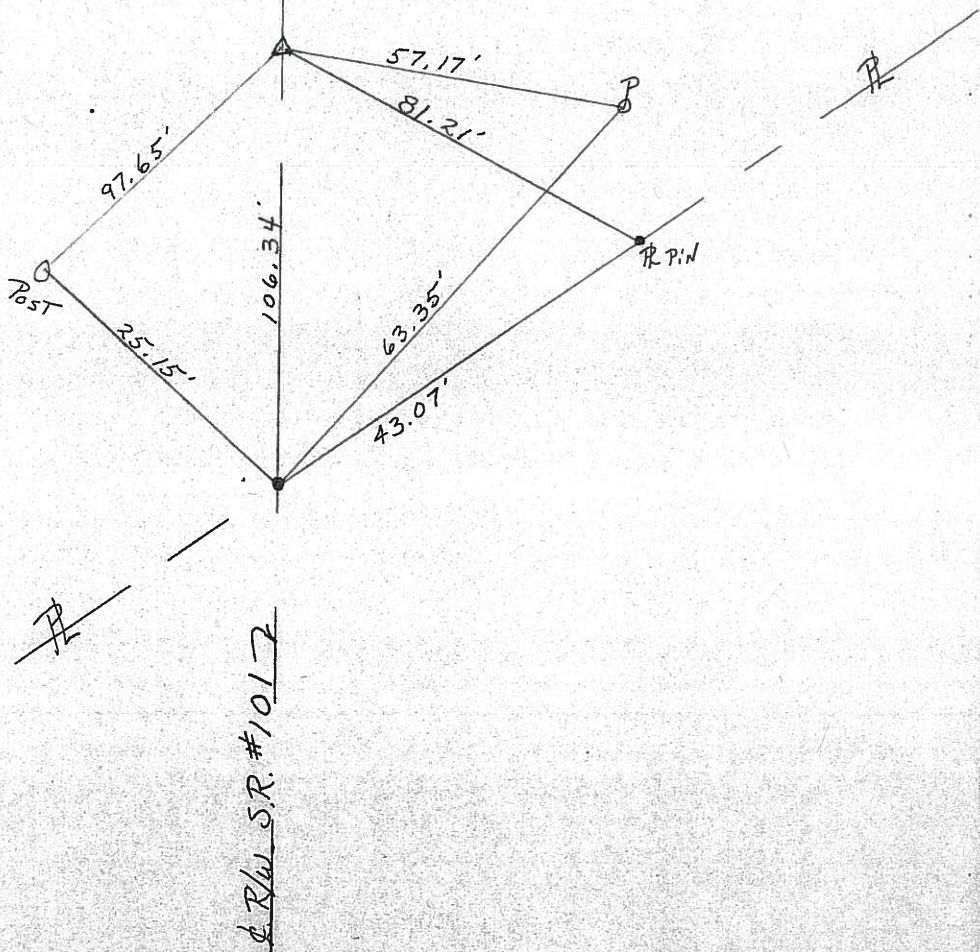

County Seneca S.R. 101Date 6-26-79Township PleasantWeather FairSection 36Temp. 65°T3N, R15EPersonnel SchneiderMosserBarbour

(29-B)

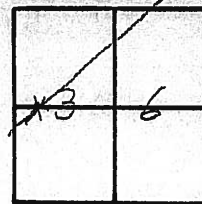

P.I.

115 + 72

R.R. 5pk. on E R/w

Reset P.K. Nail

 $\Delta = 0^\circ - 18' \text{ LT.}$ 