


O.D.O.T. DISTRICT 2 SURVEY OFFICE (USE ONLY)


PERSONNEL	REFERENCE NO. <u>32</u>	SHEET <u>8</u> OF <u>46</u>
NOTES <u>MILLER</u>	DATE <u>8/9/24</u>	ROUTE <u>SR 101</u>
H.C. <u>MILLER</u>	WEATHER <u>SUNNY</u>	COUNTY <u>SENECA</u>
R.C. <u>BARRIERE</u>	TEMP. <u>66°F</u>	TOWNSHIP <u>PLEASENT</u>
		SECTION <u>25</u>
DWG BY <u>BLUBAUGH</u>	PID <u>114849</u>	T <u>3</u> N R <u>15</u> E

TYPE MONUMENT MAG/WASHER
 ON SURFACE - ~~BELOW~~ 0.5"
 OFFSET Q PAVEMENT 2.3' LT : RT
-- TO -- EDGE PAVEMENT
 STATION: 402+46

HORZ.DATUM: <u>NAD83 2011</u>	GEOID: <u>NAVD88-2018</u>
GRID: NORTHING: <u>553679.363</u>	EASTING: <u>1808942.359</u>
LDP: NORTHING: <u>322609.276</u>	EASTING: <u>183393.423</u>

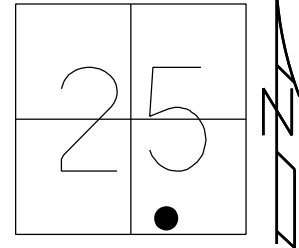

RECORD: P.I.
 $\Delta = 7^{\circ} 04' 30''$ RT
 STA. 404+41.26
 STA. 160+82
 FD BOAT SPIKE/SHI
 SET P.K./WASHER
 8/27/90
 FD P.K./WASHER
 REF32
 7/14/09, DCH
 SET MAG/WASHER
 NEWREF32
 11/4/09, DCH
 FD MAG/WASHER
 REF32
 6/14/16, JFO
 UNCOVERED
 9/18/17, JFO
 FD MAG/W
 REF32
 12/20/23, DSA
 FD TONE. DID NOT UNCOVER, PAINTED
 8/9/24, JAM

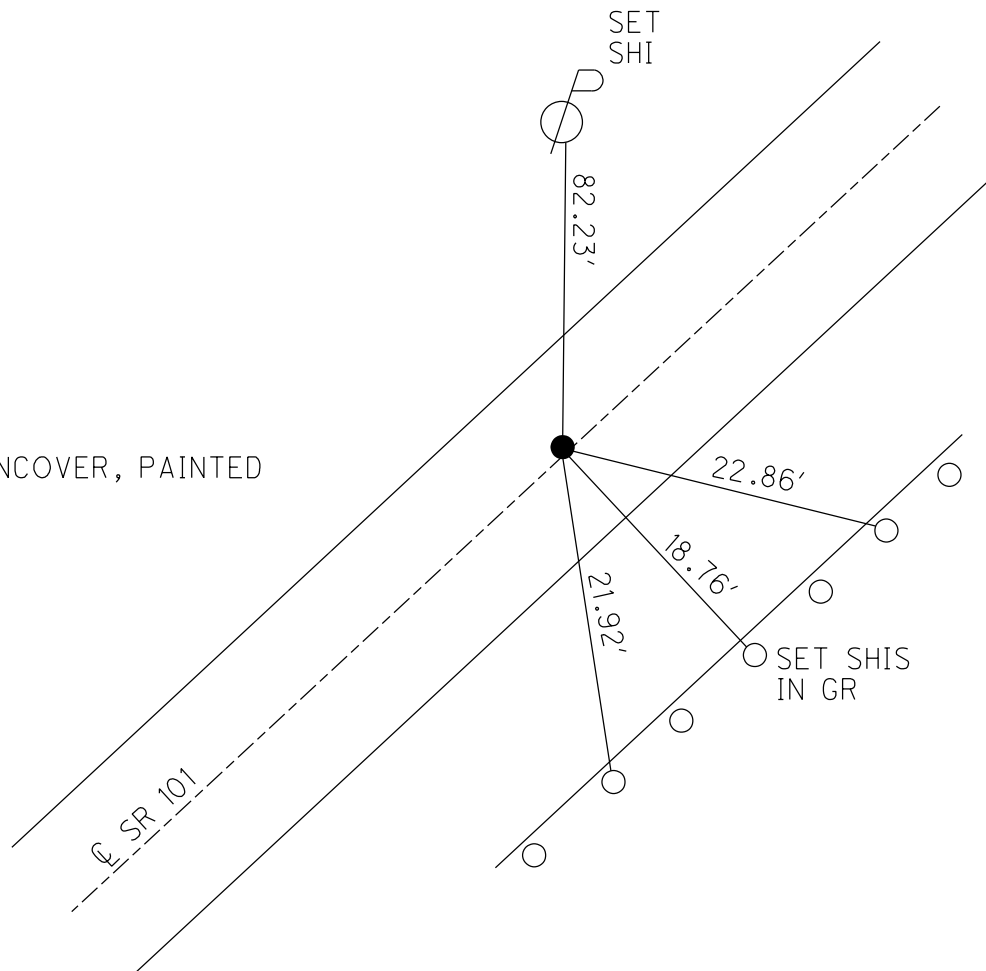

O.D.O.T. DISTRICT 2 SURVEY OFFICE (USE ONLY)

PERSONNEL

REFERENCE NO. 32

SHEET 8 OF 46

NOTES HOMAN

DATE 7-14-09

ROUTE SR 101

H.C. HOMAN

WEATHER SUNNY

COUNTY SENECA

R.C. ROUSOS

TEMP. 80°F

TOWNSHIP PLEASANT

DWG BY MAHLER

PID 100787

SECTION 25

T 3 N R 15 E

TYPE MONUMENT P.K./WASHER

ON SURFACE - ~~BELOW~~ ON

OFFSET ℄ PAVEMENT 2.3' LT : ~~RT~~

- TO - EDGE PAVEMENT


STATION: 402+46

HORZ.DATUM: NAD83 2011


GEOID: NAVD88-2012A

GRID: NORTHING: 553679.363

EASTING: 1808942.359

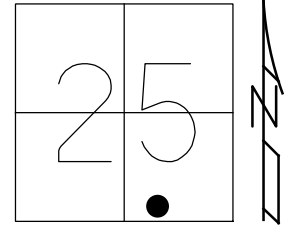

RECORD: P.I.
 $\Delta = 7^{\circ} 04' 30''$ RT
STA. 404+41.26
STA. 160+82
FD BOAT SPIKE/SHI
SET P.K./WASHER
8/27/90
FD P.K./WASHER
REF32
7/14/09, DCH
SET MAG/WASHER
NEWREF32
11/4/09, DCH
FD MAG/WASHER
REF32
6/14/16, JFO
UNCOVERED
9/18/17, JFO

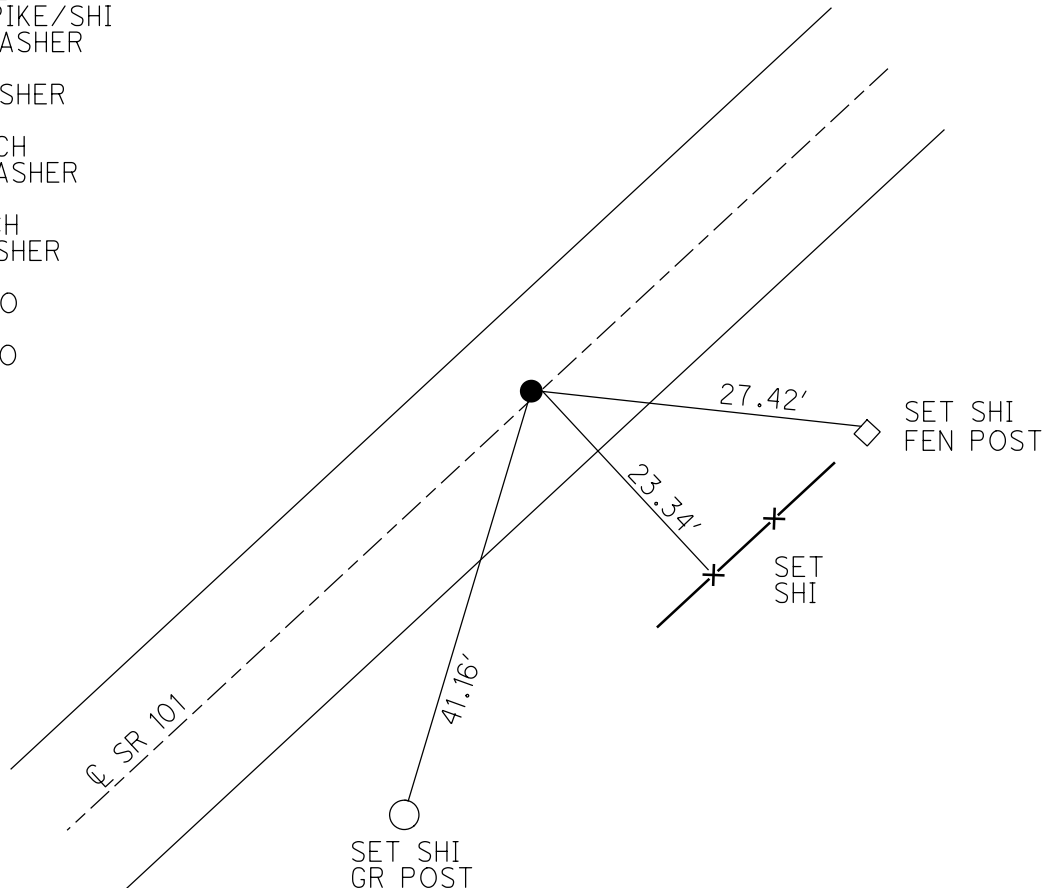


O.D.O.T. DISTRICT 2 SURVEY OFFICE (USE ONLY)


PERSONNEL	REFERENCE NO. <u>32</u>	SHEET <u>8</u> OF <u>46</u>
NOTES	DATE <u>7/14/09</u>	ROUTE <u>SR 101</u>
H.C. <u>HOMAN</u>	WEATHER <u>SUNNY</u>	COUNTY <u>SENECA</u>
R.C. <u>ROUSOS</u>	TEMP. <u>80°</u>	TOWNSHIP <u>PLEASANT</u>
		SECTION <u>25</u>
		T <u>3</u> N R <u>15</u> E

TYPE MONUMENT P.K./WASHER
 ON SURFACE - ~~BELOW~~ ON
 LEFT - ℄ PAV'T - ~~RIGHT~~ 2.3'
 - TO - EDGE PAVEMENT
 S.L.M. 402+46

GRID: NORTHING: 553679.363 EASTING: 1808942.359

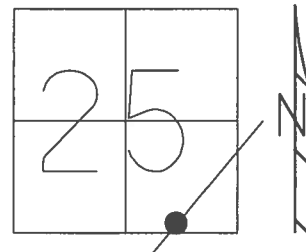

RECORD: P.I.
 $\Delta = 7^{\circ} 04' 30''$ RT
 STA. 404+41.26
 STA. 160+82
 FD BOAT SPIKE/SHI
 SET P.K./WASHER
 8/27/90
 SET MAG/WASHER
 11/4/09, DCH
 FD MAG/WASHER
 REF32
 6/14/16, JFO
 UNCOVERED
 9/18/17, JFO

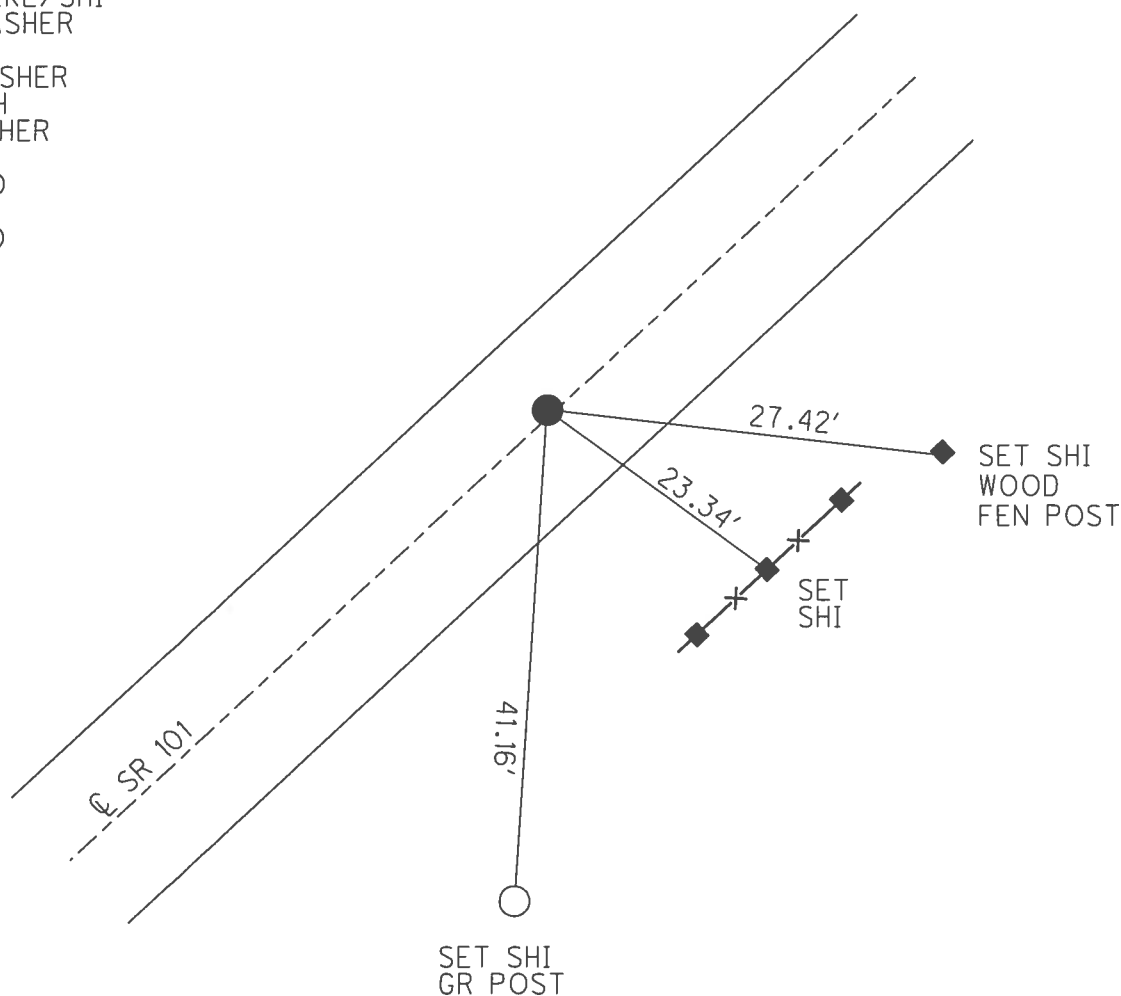


O.D.O.T. DISTRICT 2 SURVEY OFFICE (USE ONLY)


PERSONNEL _____ REFERENCE NO. 32 SHEET 8 OF 46
 NOTES HOMAN DATE 7/14/09 ROUTE SR 101
 H.C. HOMAN WEATHER SUNNY COUNTY SENECA
 R.C. ROUSOS TEMP. 80° TOWNSHIP PLEASANT
 SECTION 25
 T 3 N R 15 E

TYPE MONUMENT P.K./WASHER
 ON SURFACE - ~~BELOW~~ ON _____
 LEFT - C PAV'T - ~~RIGHT~~ 2.3'
 TO _____ EDGE PAVEMENT
 S.L.M. 402+46

GRID: NORTHING: 553679.439 EASTING: 1808942.320

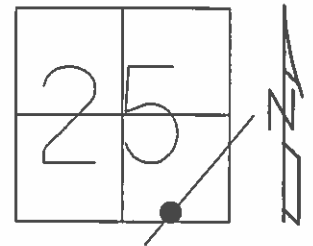

RECORD: P.I.
 $\Delta = 7^{\circ} 04' 30''$ RT
 STA. 404+41.26
 STA. 160+82
 FD BOAT SPIKE/SHI
 SET P.K./WASHER
 8/27/90
 SET MAG/WASHER
 11/4/09, DCH

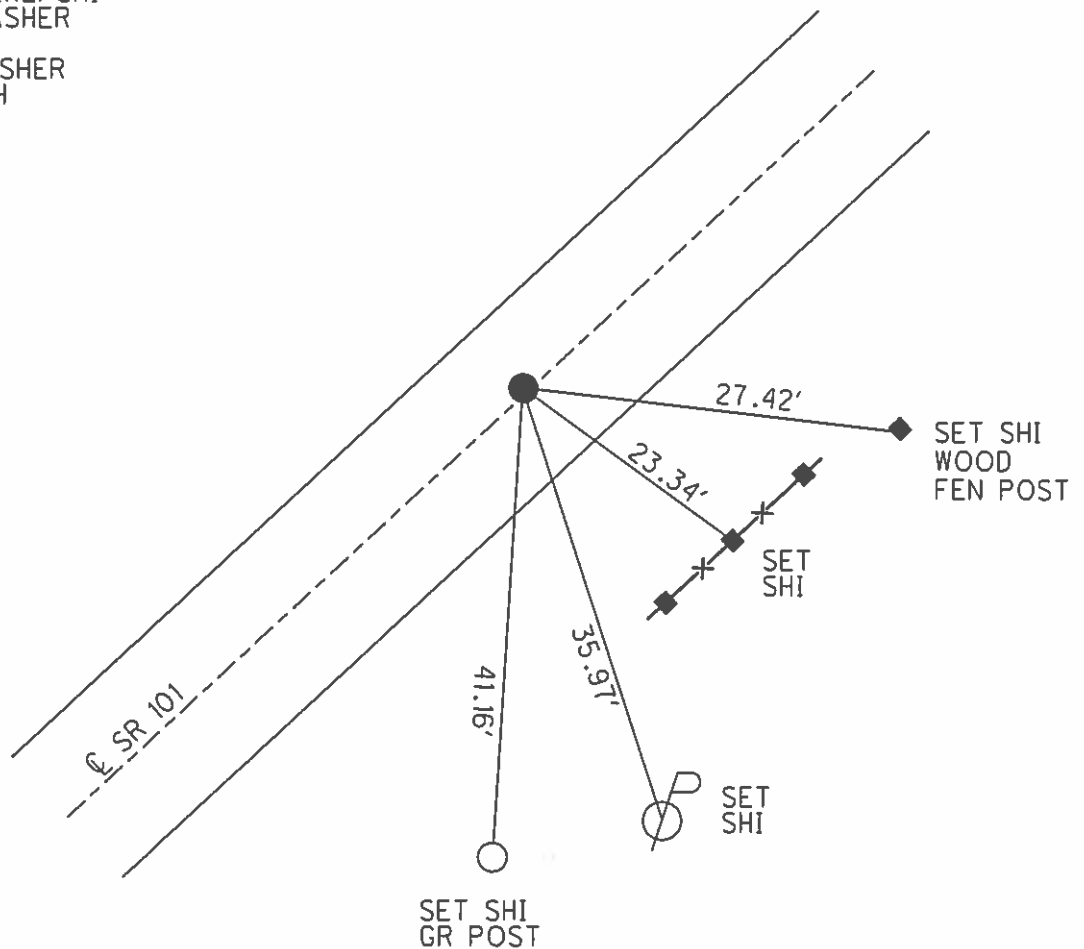

O.D.O.T. DISTRICT 2 SURVEY OFFICE

PERSONNEL

REFERENCE NO. 32

SHEET 6 OF 41

NOTES RIPPLE

H.C. BARBOUR

R.C. _____

DATE 8/27/90

WEATHER SUNNY

TEMP. 73°

ROUTE SR#101


COUNTY SENECA

TOWNSHIP PLEASANT

SECTION 25


T 3 N R 15 E

TYPE MONUMENT SET P.K. & WASHER
ON SURFACE - BELOW BOAT SPIKE & SHINER
LEFT-CL PAW'T. - RIGHT 2.3' LT. of CL PAW'T.
TO _____ EDGE PAVEMENT
S.L.M. _____

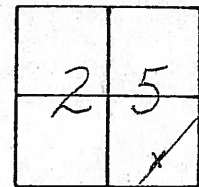

402+46

A = 7° 04' 30" RT.
P.I. 404+41.26
160+82 old STATIONS

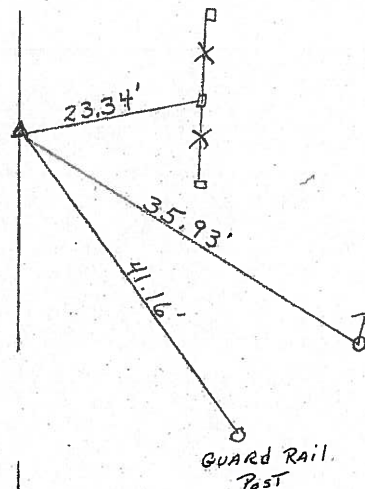

*FD hole
2-4-85
SAH*

CL RW SR#101

O.D.O.T. DISTRICT 2 SURVEY OFFICE

PERSONNEL

REFERENCE NO. 32

SHEET 6 OF 41

NOTES RIPPLE

H.C. BARBOUR

R.C. _____

DATE 8/27/90

WEATHER SUNNY

TEMP. 73°

ROUTE SR#101

COUNTY SENECA

TOWNSHIP PLEASANT

SECTION 25

T 3 N R 15 E


TYPE MONUMENT SET P.K. & WASHER

ON SURFACE - BELOW BOAT SPIKE & SHINER

LEFT - CL PAV'T. - RIGHT 2.3' LT. of CL PAV'T.

TO _____ EDGE PAVEMENT


S.L.M. _____

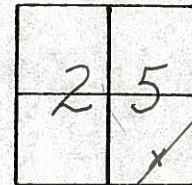

A = 7° 04' 30" RT.

P.I. 404 + 41.26

160 + 82 old STATIONS

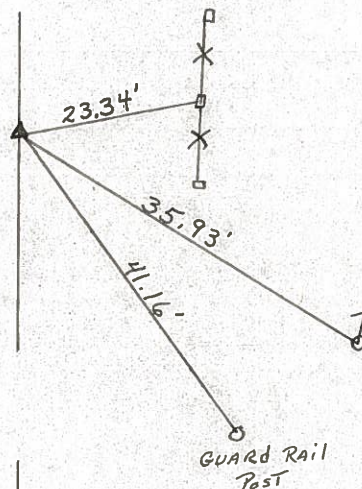

CL/LS SR#101 R

County Seneca S.R. 101

Date 6-26-79

Township Pleasant

Weather Fair

Section 25

Temp. 72°



T₃N, R₁₅E

Personnel Schneider


Mosser

Barbour


(32)

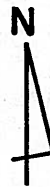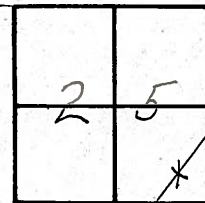

~~#37~~

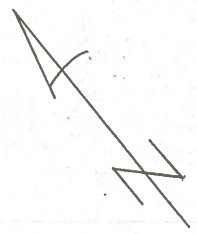

⊥ S.R. # 101

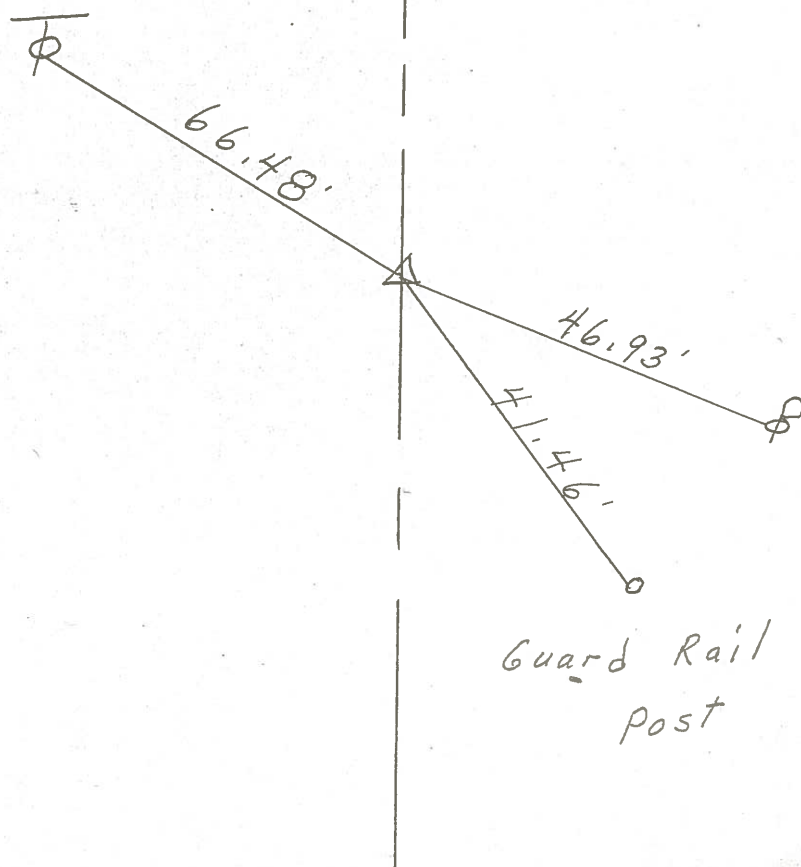

P. I. 404 + 41.26

160 + 82 old stations

R.R. spk. on ⊥ R/W

2 1/2" down

Reset Mine spk.

2.3' Lt. of ⊥

Δ = 7°04'30" Rt.

Δ = 6°-58' RT. SEC. K
1924 PLANS

PERSONNEL	TITLE	PERSONNEL	TITLE	COUNTY	DATE	WEATHER	TEMP
Schneider		Vin'son		Seneca	10-4-71	Fair	72°
Mosser				S. R. 101			
Barbour				SEC. Br. # 8.10			
Geyman							

DESCRIPTION

LEFT

CENTER LINE


RIGHT

JOB NO. 02827(0)

(32)

~~32~~ X


P.I.
404 + 41.26
Fd. R.R. spk.
2 1/2" down
 $\Delta = 7^{\circ} 04' 30''$

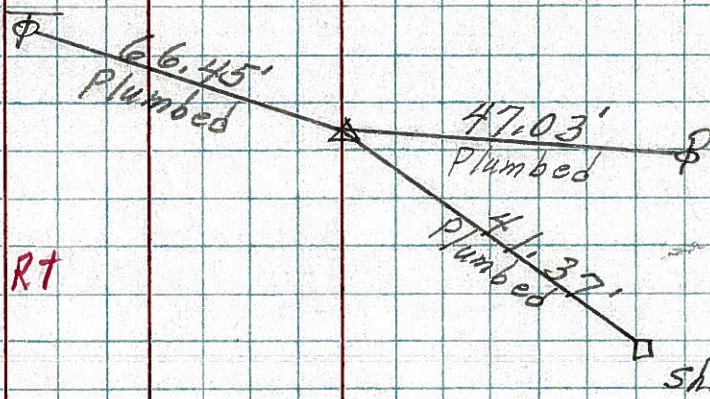

(31)

~~31~~

P.I.
389 + 04.61
Fd. R.R. spk.
1 1/2" down
($\Delta = 0^{\circ} 33' RT$)
(from 1924 Plan)

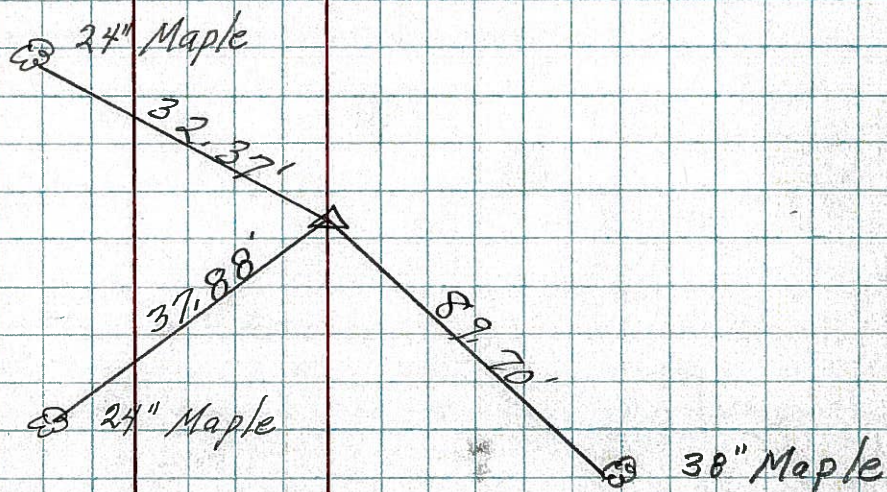

PERSONNEL TITLE PERSONNEL TITLE

COUNTY Seneca

DATE

S. R. 101

WEATHER

SEC.

TEMP.

DESCRIPTION

LEFT

CENTER LINE

RIGHT

JOB NO.

135+00

#382

145+00

#383

Pipe

stone cor. post

80.60'

38.08'

2-10-64

37.93'

24" maple

30" maple

2-10-64

(36)

160+82

#384

Iron pin

66.56

46.95

2-10-64

41.24

(36)

172+56

#385

conc. curb.

conc. curb.

16.5' 385

Did not find