

O.D.O.T. DISTRICT 2 SURVEY OFFICE (USE ONLY)

PERSONNEL

REFERENCE NO. 33

SHEET 9 OF 46

NOTES RIPPLE

DATE 8/27/90

ROUTE SR 101

H.C. BARBOUR

WEATHER SUNNY

COUNTY SENECA

R.C. GEYMAN

TEMP. 82°

TOWNSHIP PLEASENT

DWG BY MAHLER

PID 100787

SECTION 25

T 3 N R 15 E

TYPE MONUMENT P.K./WASHER

ON SURFACE - ~~BELOW~~ ON

OFFSET Q PAVEMENT ON LT : RT

-- TO -- EDGE PAVEMENT

STATION: 408+10±

HORZ.DATUM: -


GEOID: -

GRID: NORTHING: -

EASTING: -

LDP: NORTHING: -

EASTING: -

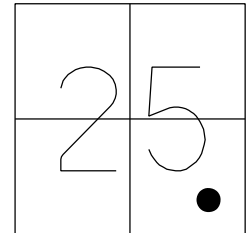


RECORD: P.O.T.
STA. 410+04.86
FD P.K./WASHER
ATOP P.K.NAIL
8/27/90, BARBOUR
D.N.F.
7/14/09, DCH
6/14/16, JFO
8/7/24, JAM

SET SHI
12" BOXELDER

SET SHI
14" CEDAR

SET SHI
4" ELM

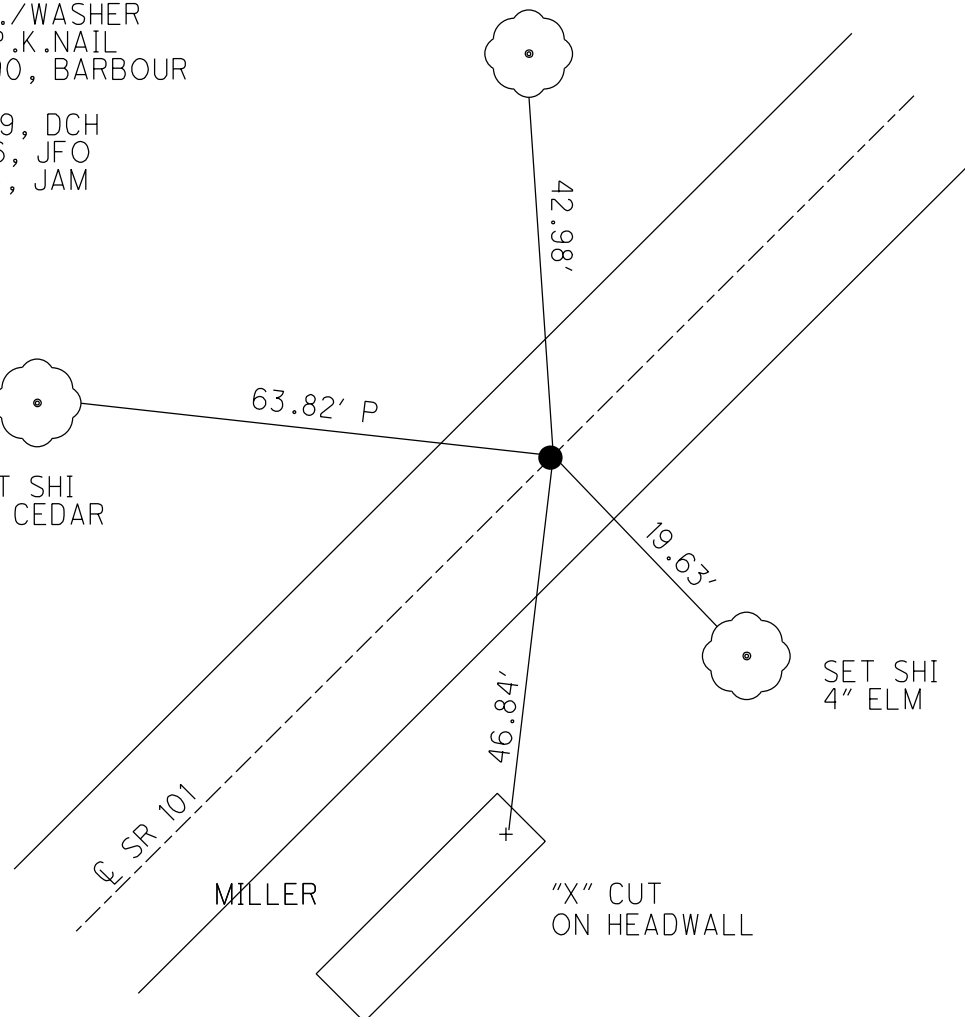

O.D.O.T. DISTRICT 2 SURVEY OFFICE (USE ONLY)

PERSONNEL

REFERENCE NO. 33

SHEET 9 OF 46

NOTES RIPPLE

DATE 8/27/90

ROUTE SR 101

H.C. BARBOUR

WEATHER SUNNY

COUNTY SENECA

R.C. GEYMAN

TEMP. 82°

TOWNSHIP PLEASENT

DWG BY MAHLER

PID 100787

SECTION 25

T 3 N R 15 E

TYPE MONUMENT P.K./WASHER

ON SURFACE - ~~BELOW~~ ON


OFFSET CL PAVEMENT ON LT : RT

- TO - EDGE PAVEMENT


STATION: 408+10±

HORIZ.DATUM: - GEOID: -

GRID: NORTHING: - EASTING: -

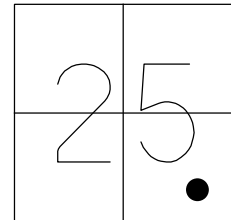


RECORD: P.O.T.
STA. 410+04.86
FD P.K./WASHER
ATOP P.K.NAIL
8/27/90, BARBOUR
D.N.F.
7/14/09, DCH
6/14/16, JFO

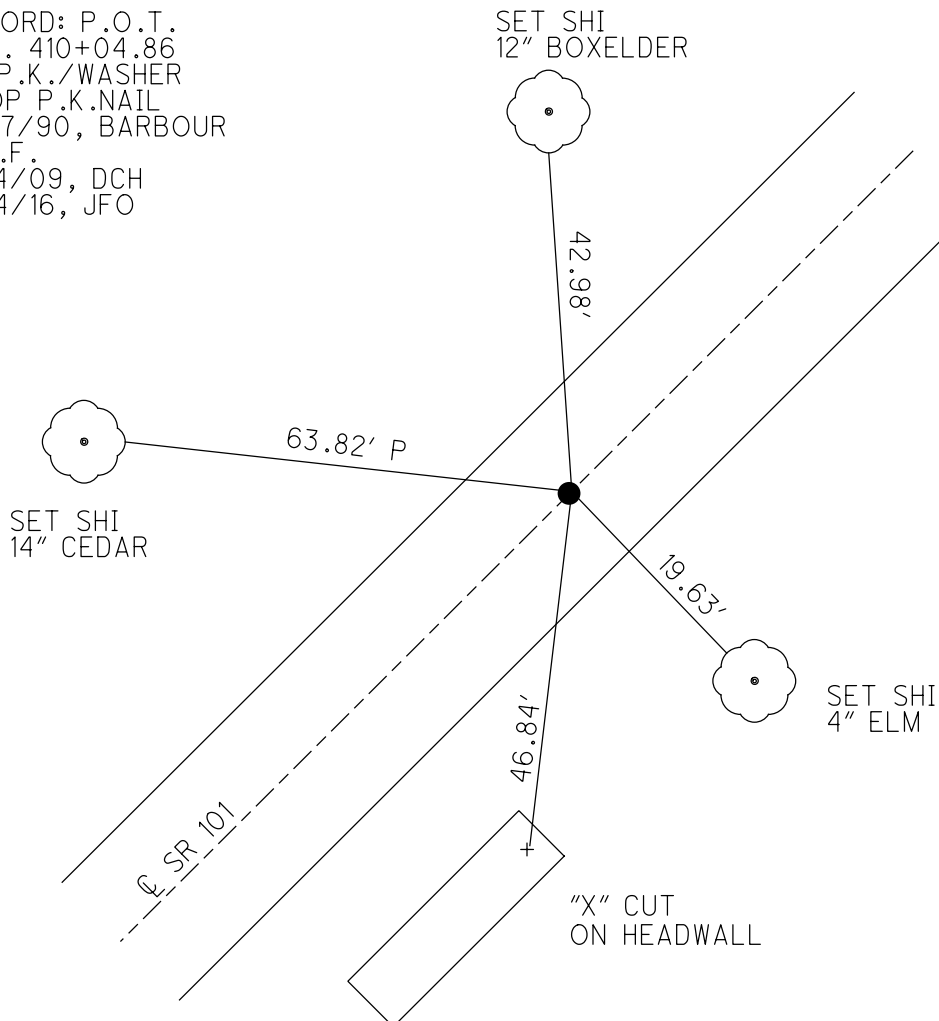


O.D.O.T. DISTRICT 2 SURVEY OFFICE (USE ONLY)

PERSONNEL	REFERENCE NO. <u>33</u>	SHEET <u>9</u> OF <u>46</u>
NOTES	DATE <u>7/14/09</u>	ROUTE <u>SR 101</u>
H.C. <u>HOMAN</u>	WEATHER <u>SUNNY</u>	COUNTY <u>SENECA</u>
R.C. <u>ROUSOS</u>	TEMP. <u>80°</u>	TOWNSHIP <u>PLEASANT</u>
		SECTION <u>25</u>
		T <u>3</u> N R <u>15</u> E

TYPE MONUMENT P.K./WASHER
 ON SURFACE - ~~BELOW~~ ON
 LEFT - Q PAV'T - RIGHT ON
- TO - EDGE PAVEMENT
 S.L.M. 408+10 ±
 GRID: NORTHING: - EASTING: -

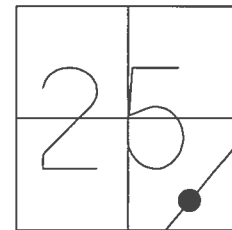

RECORD: P.O.T.
 STA. 410+04.86
 FD P.K.NAIL
 SET P.K./WASHER
 8/27/90
 D.N.F.
 7/14/09, DCH
 6/14/16, JFO

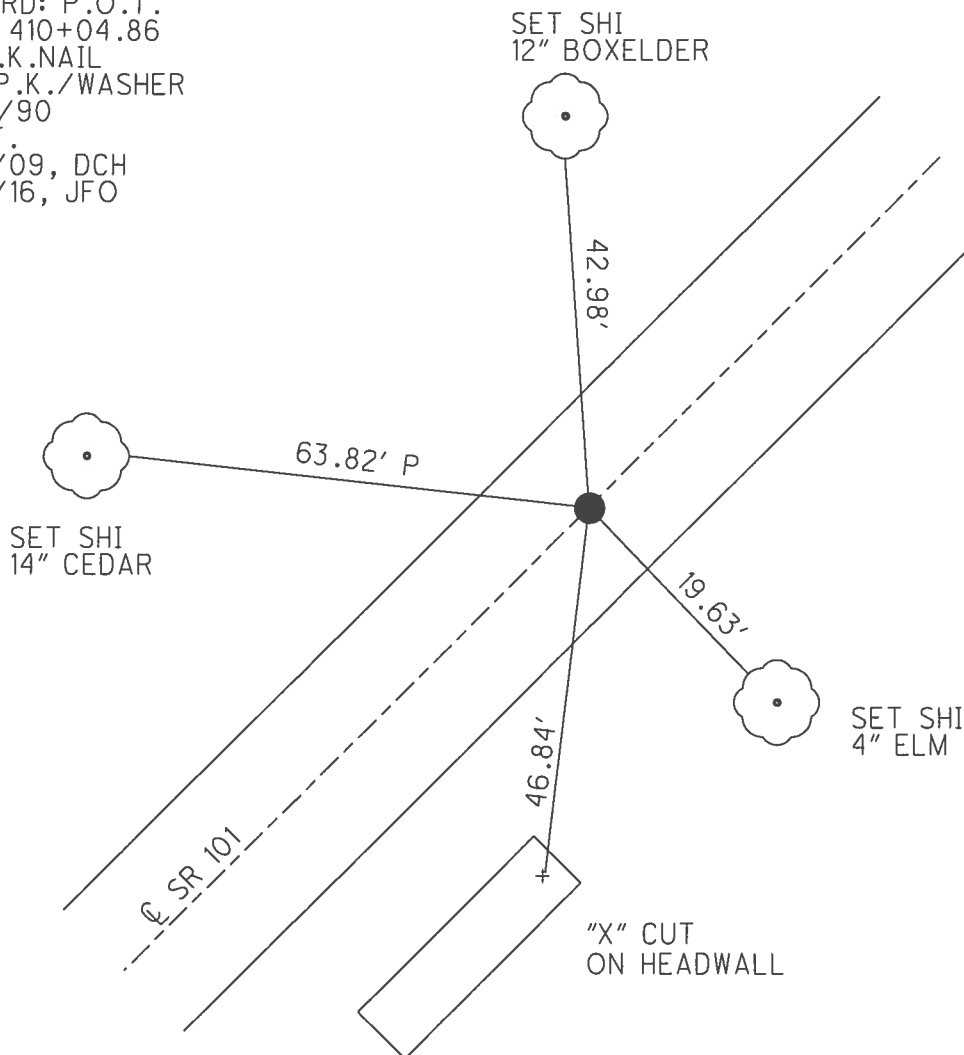


O.D.O.T. DISTRICT 2 SURVEY OFFICE (USE ONLY)


PERSONNEL _____ REFERENCE NO. 33 SHEET 9 OF 46
 NOTES HOMAN DATE 7/14/09 ROUTE SR 101
 H.C. HOMAN WEATHER SUNNY COUNTY SENECA
 R.C. ROUSOS TEMP. 80° TOWNSHIP PLEASANT
 _____ SECTION 25
 _____ T 3 N R 15 E

TYPE MONUMENT _____ P.K./WASHER
 ON SURFACE - ~~BELOW~~ _____ ON
 LEFT - ℄ PAV'T - RIGHT _____ ON
 _____ TO _____ EDGE PAVEMENT
 S.L.M. 408+10 ±

GRID: NORTHING: _____ EASTING: _____

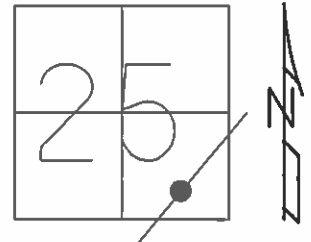

RECORD: P.O.T.
 STA. 410+04.86
 FD P.K.NAIL
 SET P.K./WASHER
 8/27/90
 D.N.F.
 7/14/09, DCH

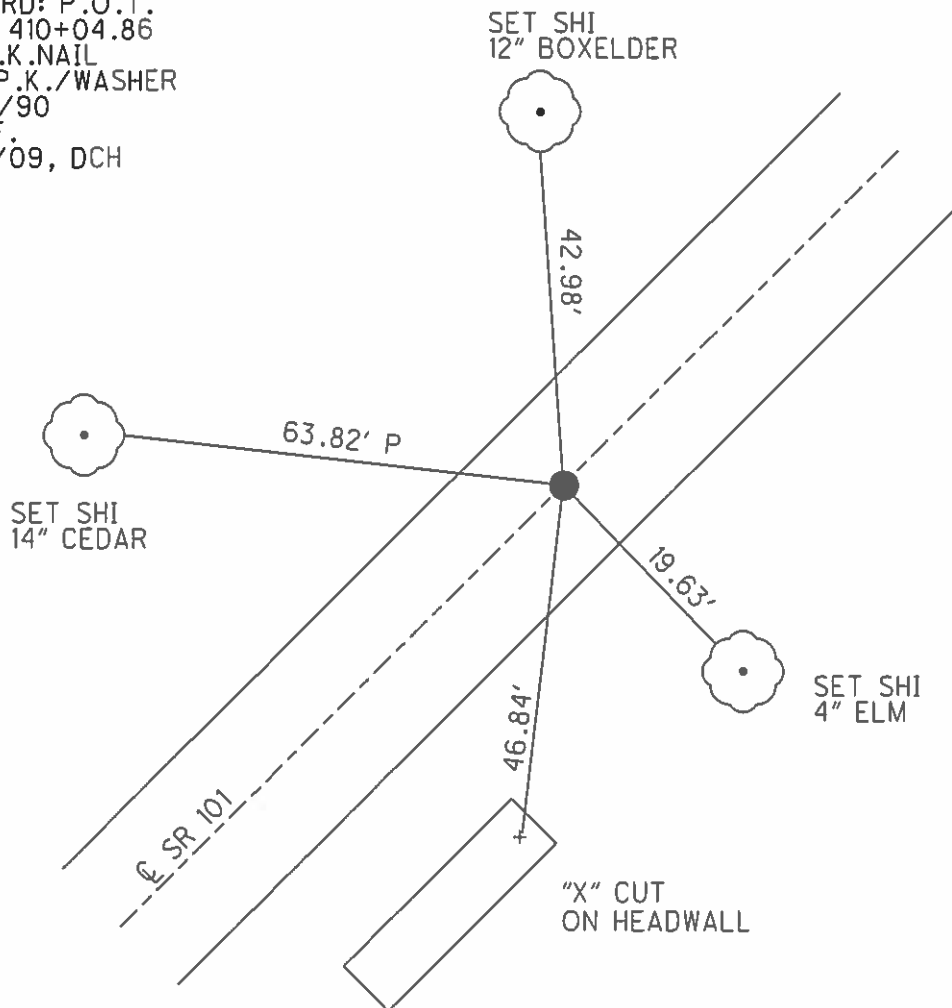

O.D.O.T. DISTRICT 2 SURVEY OFFICE

PERSONNEL

REFERENCE NO. 33

SHEET 7 OF 41

NOTES Ripple

H.C. Barbour

R.C. _____

DATE 8/27/90

WEATHER SUNNY

TEMP. 82°

ROUTE SR#101

COUNTY Seneca

TOWNSHIP Pleasant

SECTION 25

T. 3 N. R. 15 E.


TYPE MONUMENT P.K. & Washer

ON SURFACE - BELOW P.K. Nail

LEFT-℄ PAV'T. - RIGHT ℄

TO _____ EDGE PAVEMENT

S.L.M. _____

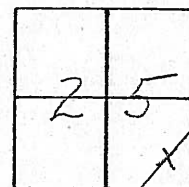

408+10

Need
Traffic
Control

P.O.T. 410+04.86

12" Box Elder 42.98'

19.63' 4" Elm

63.82' Plumb

14" Cedar

46.84'

"X" cut on Hdwl.

℄ R/W SR. #101

O.D.O.T. DISTRICT 2 SURVEY OFFICE

PERSONNEL

REFERENCE NO. 33

SHEET 7 OF 41

NOTES RIPPLE

H.C. BARBOUR

R.C. _____

DATE 8/27/90

WEATHER SUNNY

TEMP. 82°

ROUTE SR#101

COUNTY SENECA

TOWNSHIP PLEASANT

SECTION 25

T.3 N. R.15 E


TYPE MONUMENT P.K. & Washer

ON SURFACE - BELOW P.K. Nail

LEFT- & PAV'T. - RIGHT &

TO EDGE PAVEMENT

S.L.M. _____

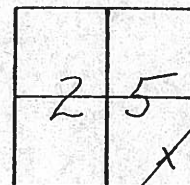

12" Box Elder 42.98'

P.O.T. 410+04.86

19.63' 4" Elm

63.82' Plumbbed 14" Cedar

46.84'

"X" cut on Hdwl.

& R/W S.R. #101

Q.D.O.T. DISTRICT 2 SURVEY OFFICE

Sht. ____ of ____

County Seneca S.R. 101

Township Pleasant

Section 25

T 3 N, R 15 E

Personnel Schneider

Mosser


Barbour

Date 6-26-79

Weather Fair

Temp. 72°

(33)

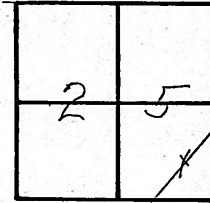

~~36~~




± S.R. # 101

P.O.T.

410 + 04.86

Reset P.K. Nail

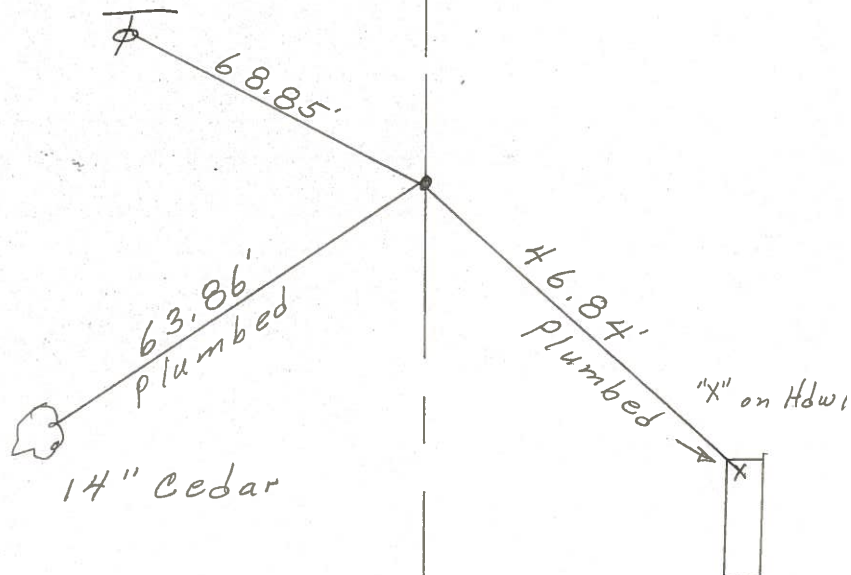

PERSONNEL	TITLE	PERSONNEL	TITLE	COUNTY	DATE	WEATHER	TEMP.
Schneider		Vinson		Seneca	10-4-71	Fair	72'
Mosser				S. R. 101			
Barbour				SEC. Br. #8.10			
Geyman							

DESCRIPTION	LEFT	CENTER LINE	RIGHT	JOB NO.
				028270

(35-A)

~~40~~

P.O.T.
426+97.81
set small spk.

10" Cottonwood

69.79'

71.70'

32.75'

26" Ash

Twp. line
Twp. Rd. #169 South

35.51'

62.24'

59.85'

24" Ash


(35)

P.I.
426+91.80
Ed. sq. bolt
 $\Delta = 0^\circ 29' \text{ Lt.}$

~~39~~

(34)

P.I.
414+04.19
set small spk.
 $\Delta = 9^\circ 48' \text{ Lt.}$

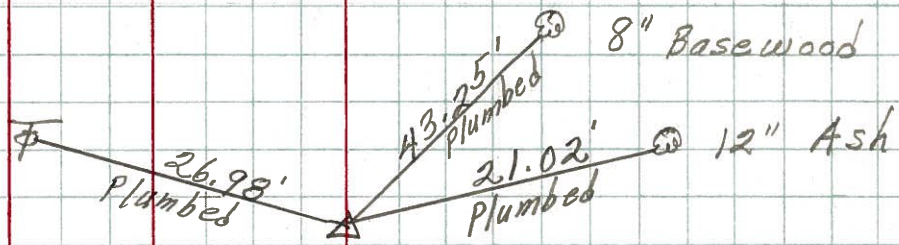

(33)

~~38~~

P.O.T.
410+41.26
set P.K. Nail

