
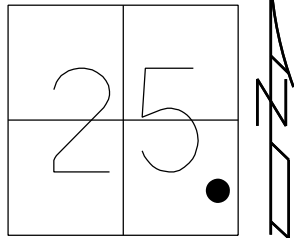


O.D.O.T. DISTRICT 2 SURVEY OFFICE (USE ONLY)

PERSONNEL _____		REFERENCE NO. <u>34</u>	SHEET <u>10</u> OF <u>46</u>
NOTES <u>RIPPLE</u>	DATE <u>8-27-90</u>	ROUTE <u>SR 101</u>	
H.C. <u>BARBOUR</u>	WEATHER <u>SUNNY</u>	COUNTY <u>SENECA</u>	
R.C. <u>GEYMAN</u>	TEMP. <u>82°F</u>	TOWNSHIP <u>PLEASENT</u>	
DWG BY <u>MAHLER</u> PID <u>100787</u>		SECTION <u>25</u>	
TYPE MONUMENT <u>MINE SPIKE</u>		T <u>3</u> N R <u>15</u> E	
ON SURFACE - BELOW <u>-</u>			
OFFSET $\mathbb{Q}$ PAVEMENT <u>5.7'</u> LT : RT			
<u>--</u> TO <u>--</u> EDGE PAVEMENT			
STATION: <u>412+09±</u>			
HORZ.DATUM: <u>-</u>		GEOID: <u>-</u>	
GRID: NORTHING: <u>-</u>		EASTING: <u>-</u>	
LDP: NORTHING: <u>-</u>		EASTING: <u>-</u>	

RECORD: P.I.
 STA. 414+04.19
 FD MINE SPIKE
 8/27/90, BARBOUR
 D.N.F.
 7/14/09, DCH
 6/14/16, JFO
 8/7/24, JAM

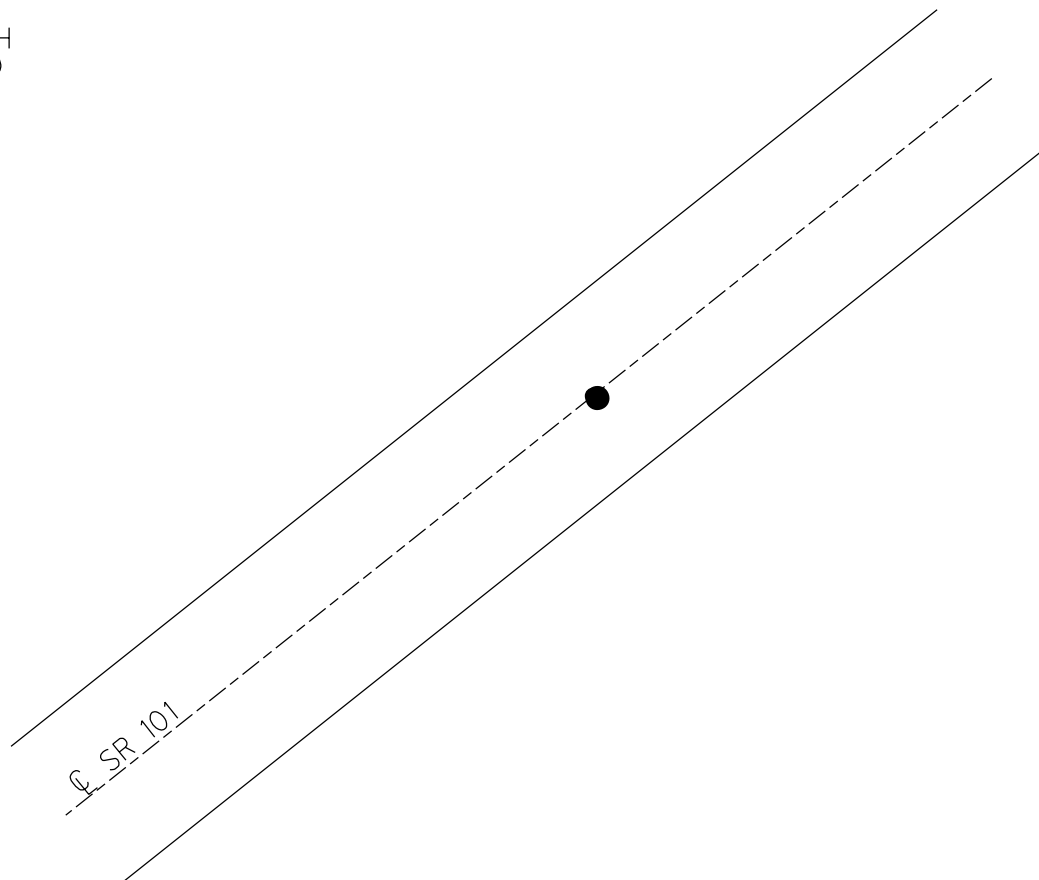

O.D.O.T. DISTRICT 2 SURVEY OFFICE (USE ONLY)

PERSONNEL

REFERENCE NO. 34

SHEET 10 OF 46

NOTES RIPPLE

DATE 8-27-90

ROUTE SR 101

H.C. BARBOUR

WEATHER SUNNY

COUNTY SENECA

R.C. GEYMAN

TEMP. 82°F

TOWNSHIP PLEASENT

SECTION 25

DWG BY MAHLER

PID 100787

T 3 N R 15 E

TYPE MONUMENT MINE SPIKE

ON SURFACE - BELOW -

OFFSET Q PAVEMENT 5.7' ~~LT~~ : RT

- TO - EDGE PAVEMENT


STATION: 412+09±

HORZ.DATUM: -


GEOID: -

GRID: NORTHING: -

EASTING: -

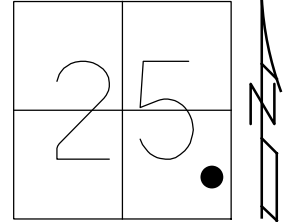


RECORD: P.I.
STA. 414+04.19
FD MINE SPIKE
8/27/90, BARBOUR
D.N.F.
7/14/09, DCH
6/14/16, JFO

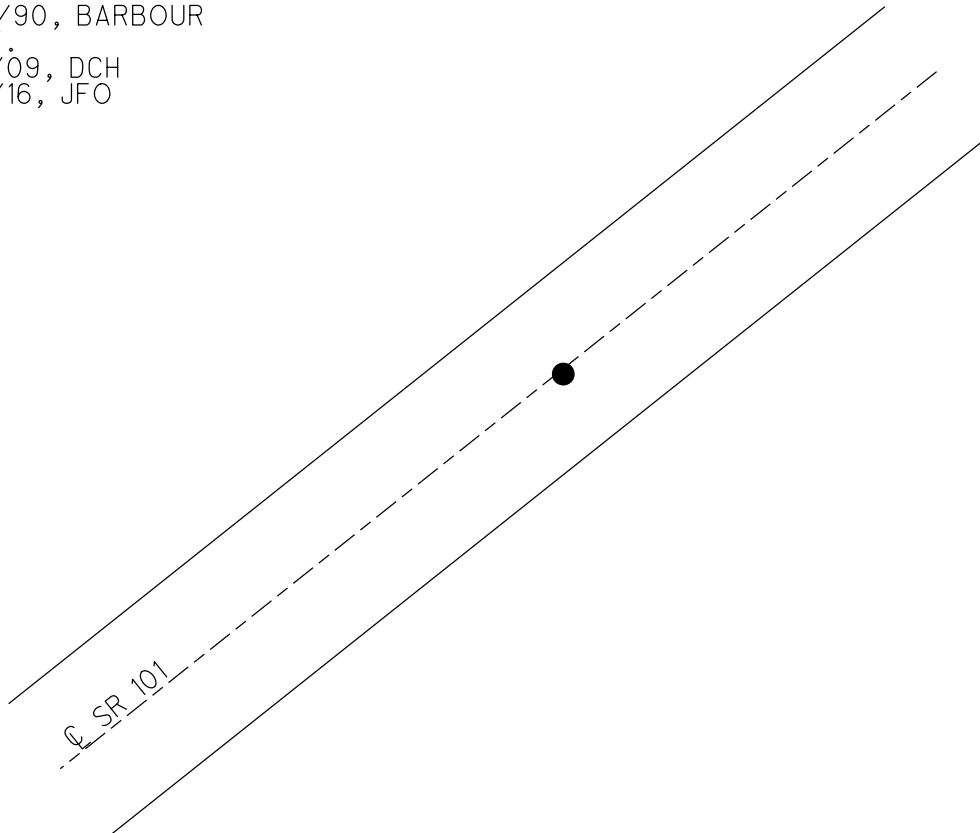


O.D.O.T. DISTRICT 2 SURVEY OFFICE (USE ONLY)

PERSONNEL	REFERENCE NO. <u>34</u>	SHEET <u>10</u> OF <u>46</u>
NOTES	DATE <u>8/27/90</u>	ROUTE <u>SR 101</u>
H.C. <u>BARBOUR</u>	WEATHER <u>SUNNY</u>	COUNTY <u>SENECA</u>
R.C. <u>GEYMAN</u>	TEMP. <u>82°</u>	TOWNSHIP <u>PLEASANT</u>
		SECTION <u>25</u>
		T <u>3</u> N R <u>25</u> E

TYPE MONUMENT MINE SPIKE
 ON SURFACE - BELOW -
~~LEFT~~ - ℄ PAV'T - RIGHT 5.7'
- TO - EDGE PAVEMENT
 S.L.M. 412+09 ±
 GRID: NORTHING: - EASTING: -

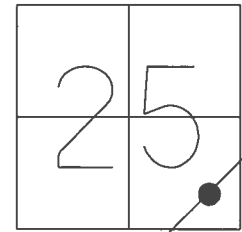

RECORD: P.I.
 STA. 414+04.19
 FD MINE SPIKE
 8/27/90
 D.N.F.
 7/14/09, DCH
 ALL TIES DESTROYED
 6/14/16, JFO

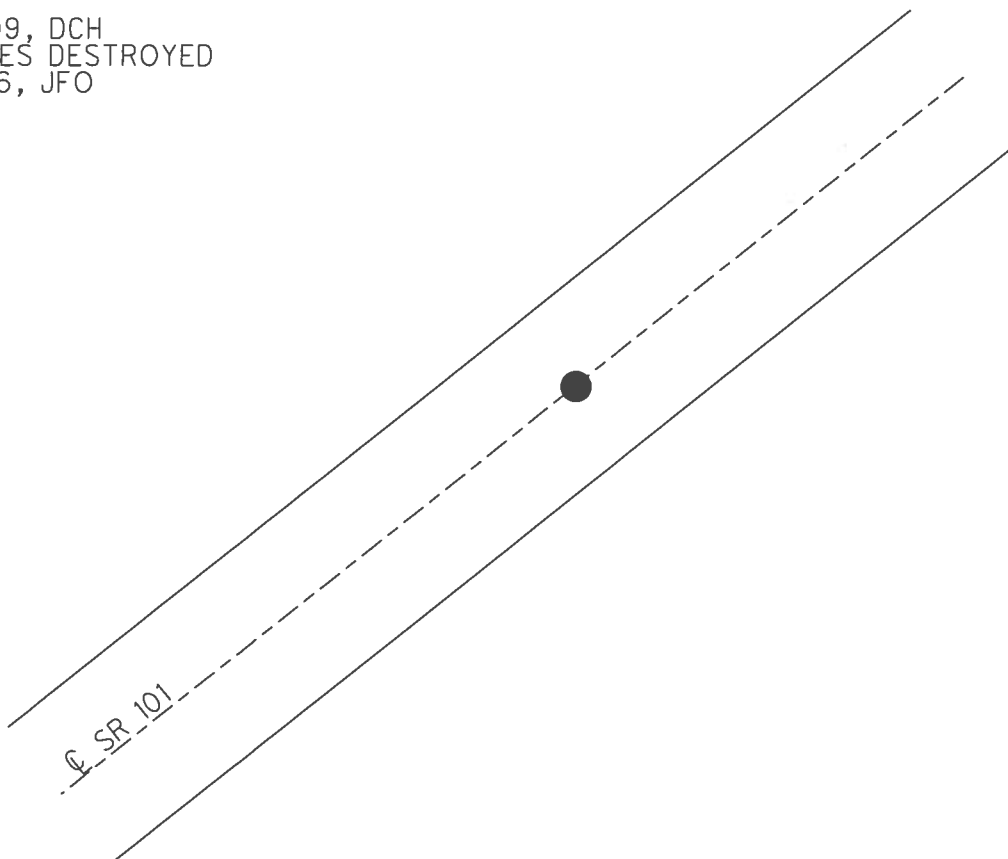

O.D.O.T. DISTRICT 2 SURVEY OFFICE (USE ONLY)

PERSONNEL _____ REFERENCE NO. 34 SHEET 10 OF 46
 NOTES RIPPLE DATE 8/27/90 ROUTE SR 101
 H.C. BARBOUR WEATHER SUNNY COUNTY SENECA
 R.C. GEYMAN TEMP. 82° TOWNSHIP PLEASANT
 SECTION 25
 T 3 N R 25 E

TYPE MONUMENT MINE SPIKE


ON SURFACE - BELOW -

~~LEFT~~ - CL PAV'T - RIGHT 5.7'


- TO - EDGE PAVEMENT

S.L.M. 412+09 ±

GRID: NORTHING: - EASTING: -

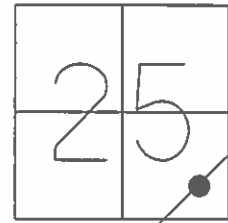

RECORD: P.I.
 STA. 414+04.19
 FD MINE SPIKE
 8/27/90
 D.N.F.
 7/14/09, DCH

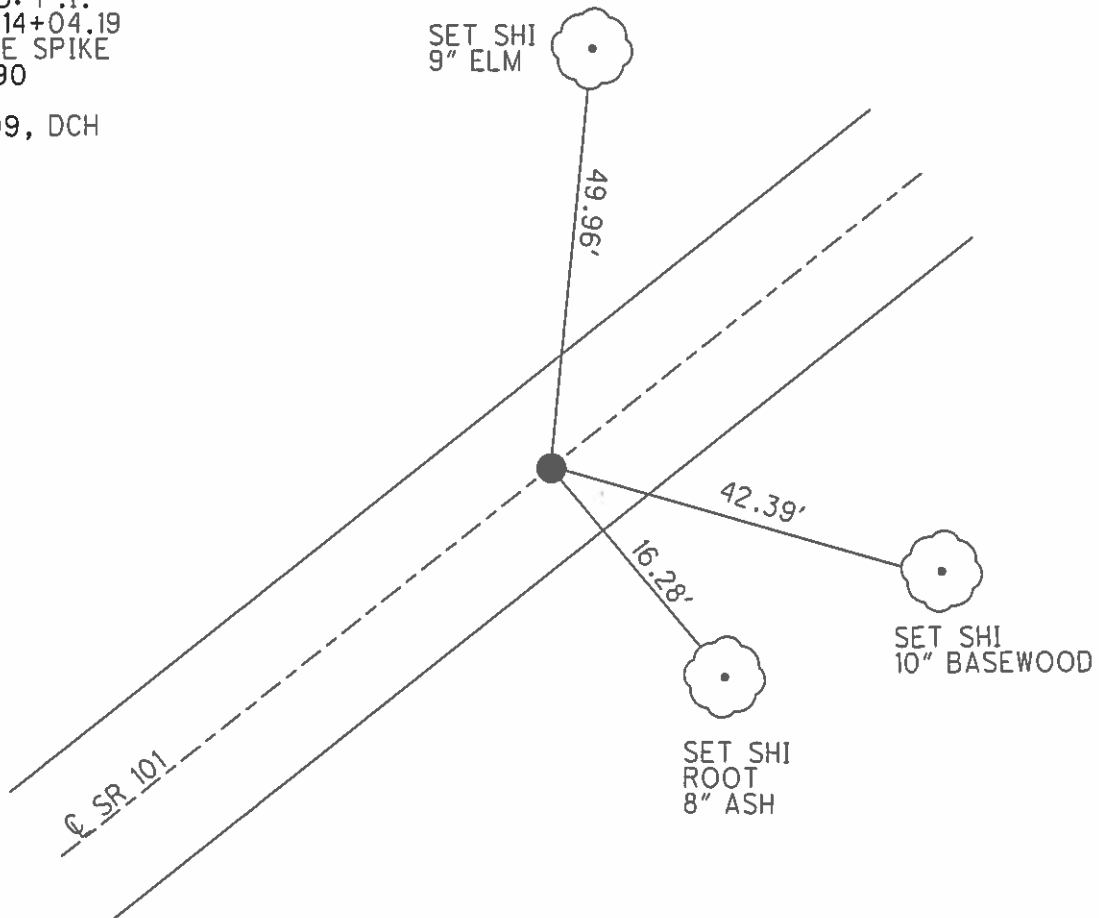

O.D.O.T. DISTRICT 2 SURVEY OFFICE

PERSONNEL

REFERENCE NO. 33

SHEET 7 OF 41

NOTES Ripple

H.C. Barbour

R.C. _____

DATE 8/27/90

WEATHER SUNNY

TEMP. 82°

ROUTE SR#101

COUNTY Seneca

TOWNSHIP Pleasant

SECTION 25

T. 3 N. R. 15 E.


TYPE MONUMENT P.K. & Washer

ON SURFACE - BELOW P.K. Nail

LEFT-℄ PAV'T. - RIGHT ℄

TO _____ EDGE PAVEMENT

S.L.M. _____

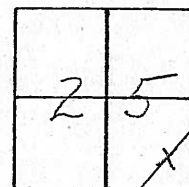

408+10

Need
Traffic
Control

P.O.T. 410+04.86

12" Box Elder 42.98'

19.63' 4" Elm

63.82' Plumb

14" Cedar

46.84'

"X" cut on Hdwl.

℄ R/W SR. #101

O.D.O.T. DISTRICT 2 SURVEY OFFICE

PERSONNEL

REFERENCE NO. 33

SHEET 7 OF 41

NOTES RIPPLE

H.C. BARBOUR

R.C. _____

DATE 8/27/90

WEATHER SUNNY

TEMP. 82°

ROUTE SR#101

COUNTY SENECA

TOWNSHIP PLEASANT

SECTION 25

T.3 N. R.15 E



TYPE MONUMENT P.K. & Washer

ON SURFACE - BELOW P.K. Nail

LEFT- & PAV'T. - RIGHT &

TO EDGE PAVEMENT

S.L.M. _____

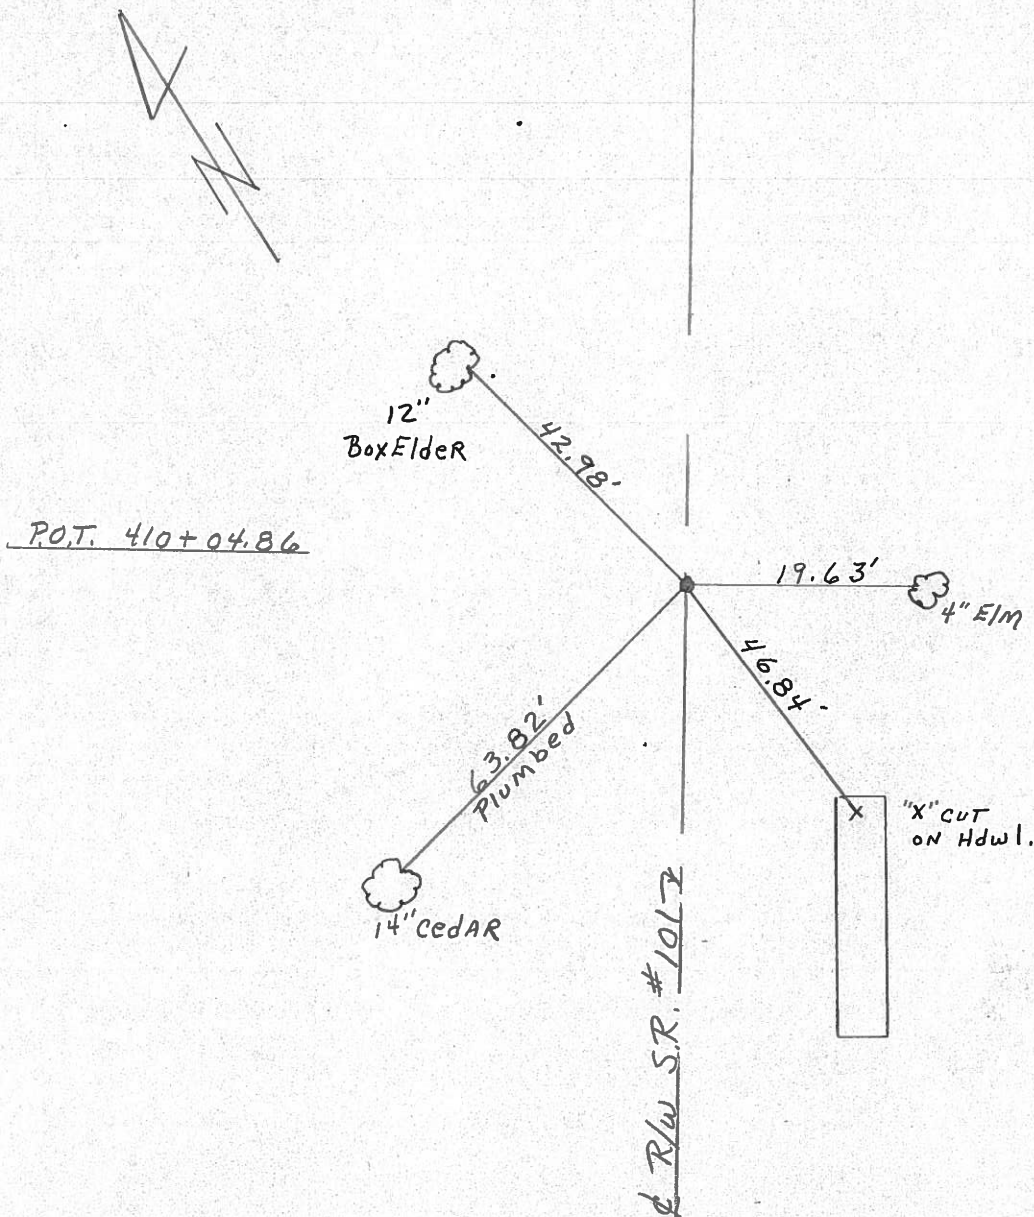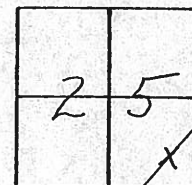

Q.D.O.T. DISTRICT 2 SURVEY OFFICE

Sht. ____ of ____

County Seneca S.R. 101

Township Pleasant

Section 25

T₃N, R₁₅E

Personnel Schneider

Mosser


Barbour

Date 6-26-79

Weather Fair

Temp. 72°

(33)

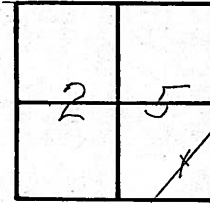

#36




§ S.R. # 101

P.O.T.

410 + 04.86

Reset P.K. Nail

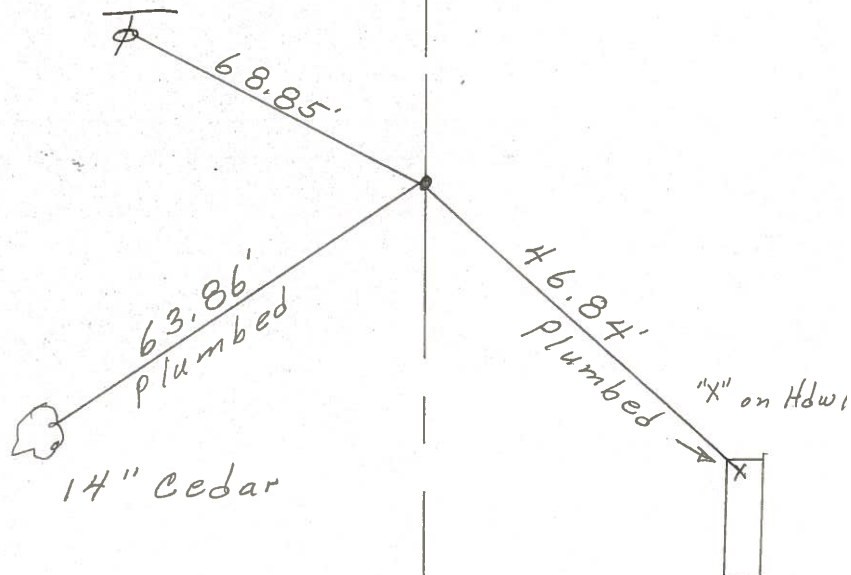

PERSONNEL	TITLE	PERSONNEL	TITLE	COUNTY	DATE	WEATHER	TEMP.
Schneider		Vinson		Seneca	10-4-71	Fair	72'
Mosser				S. R. 101			
Barbour				SEC. Br. #8.10			
Geyman							

DESCRIPTION	LEFT	CENTER LINE	RIGHT	JOB NO.
				028270

(35-A)

~~40~~

P.O.T.
426+97.81
set small spk.

10" Cottonwood

69.79'

71.70'

32.75'

26" Ash

Twp. line
Twp. Rd. #169 South

35.51'

62.24'

59.85'

24" Ash


(35)

P.I.
426+91.80
Ed. sq. bolt
 $\Delta = 0^{\circ} 29' \text{ Lt.}$

~~39~~

(34)


P.I.
414+04.19
set small spk.
 $\Delta = 9^{\circ} 48' \text{ Lt.}$

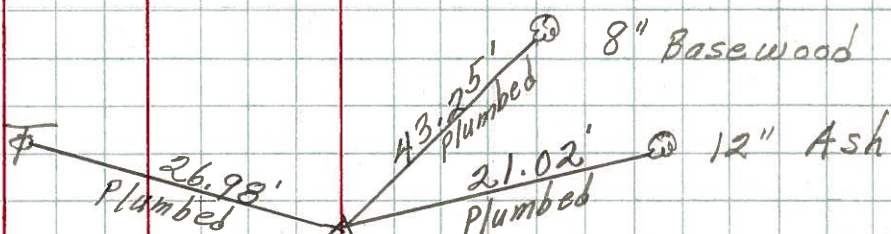

(33)

~~38~~

P.O.T.
410+41.26
set P.K. Nail

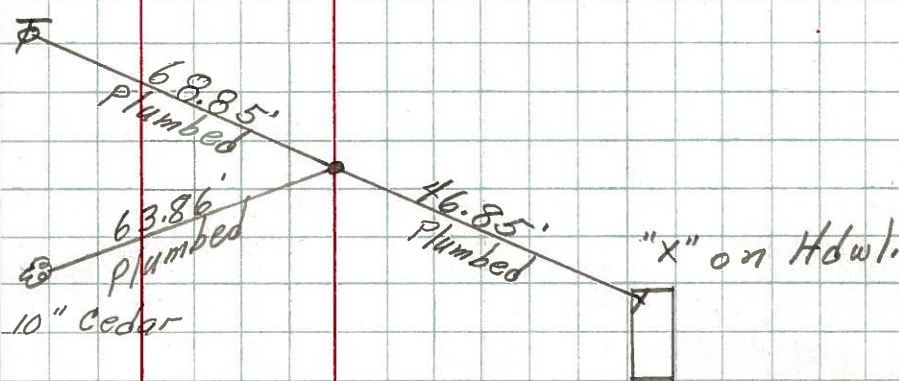

O.D.O.T. DISTRICT 2 SURVEY OFFICE

PERSONNEL

REFERENCE NO. 34

SHEET 8 OF 41

NOTES RIPPLE

H.C. BARBOUR

DATE 8/27/90

ROUTE SR#101

R.C. GEYMAN

WEATHER SUNNY

COUNTY SENECA

TEMP. 82°

TOWNSHIP PLEASANT

SECTION 25

T 3 N R 15 E



TYPE MONUMENT Dig When Needed

ON SURFACE - BELOW mine spike

LEFT- & PAV'T. - RIGHT 5.7' RT. & PAVMT.

TO EDGE PAVEMENT

S.L.M.

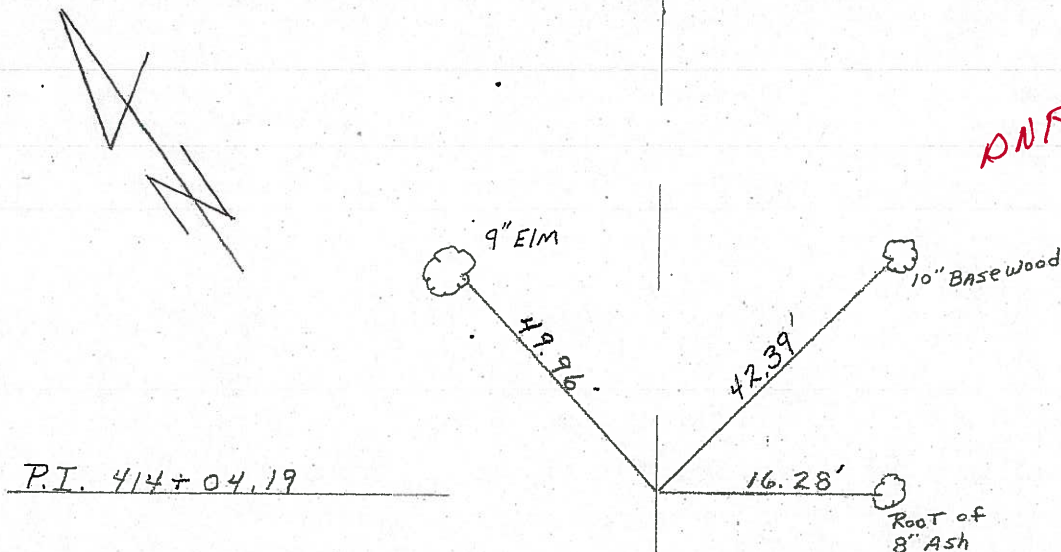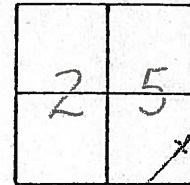

SR#101

O.D.O.T. DISTRICT 2 SURVEY OFFICE

PERSONNEL

REFERENCE NO. 34

SHEET 8 OF 41

NOTES RIPPLE

H.C. BARBOUR

R.C. GEYMAN

DATE 8/27/90

WEATHER SUNNY

TEMP. 82°

ROUTE SR#101

COUNTY SENECA

TOWNSHIP PLEASANT

SECTION 25

T 3 N R 15 E


TYPE MONUMENT Dig When Needed

ON SURFACE - BELOW mine spike

LEFT- & PAV'T. - RIGHT 5.7' R.T. & Pavmt.

TO EDGE PAVEMENT

S.L.M.

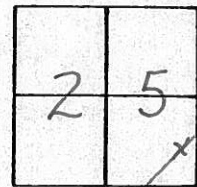

P.I. 414+04.19

9" ELM

49.86'

10" BASEWOOD

42.39'

16.28'

Root of
8" Ash

SR#101

Q.D.O.T. DISTRICT 2 SURVEY OFFICE

Sht. ___ of ___

County Seneca S.R. 101

Township Pleasant

Section 25

T3N, R15E

Personnel Schneider

Mosser


Barbour

Date 6-26-79


Weather Fair

Temp. 75°


(34)

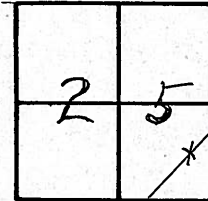

#34

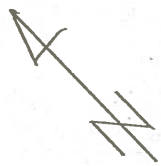

⊥ S.R. #101

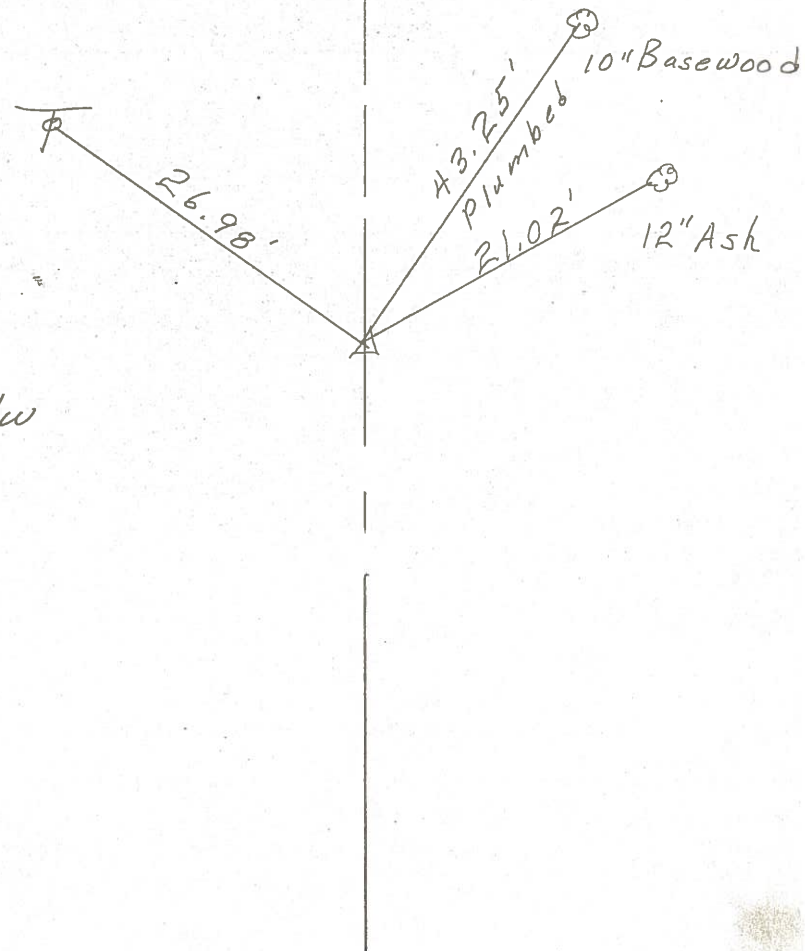

P.I. $\Delta = 9^{\circ}48' \text{ LT}$

414 + 04.19

Small R.R. spk. on ⊥ R/W

1 1/2" down

PERSONNEL	TITLE	PERSONNEL	TITLE	COUNTY	DATE	WEATHER	TEMP.
Schneider		Vinson		Seneca	10-4-71	Fair	72'
Mosser				S. R. 101			
Barbour				SEC. Br. #8.10			
Geyman							

DESCRIPTION

LEFT

CENTER LINE

RIGHT

JOB NO. 028270

(35-A)

~~40~~

P.O.T.
426+97.81
set small spk.

10" Cottonwood

59.79'

71.70'

32.75'

35.51'

59.85'

Twp. line
Twp. Rd. #169 South

26" Ash

24" Ash


(35)

P.I.
426+91.80
Fd. sp. bolt
 $\Delta = 0^\circ 29' \text{ Lt.}$

(34)

~~39~~

P.I.
414+04.19
set small spk.
 $\Delta = 9^\circ 48' \text{ Lt.}$

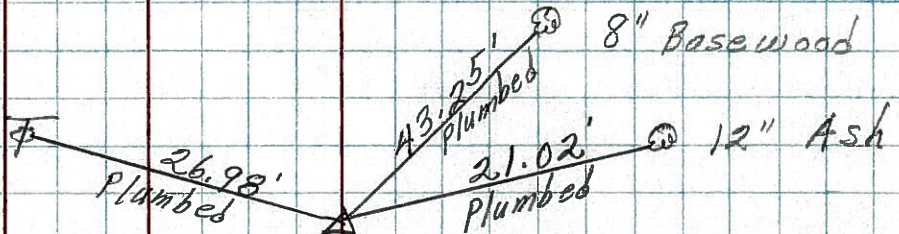

(33)

~~38~~

P.O.T.
410+41.26
set P.K. Nail

