
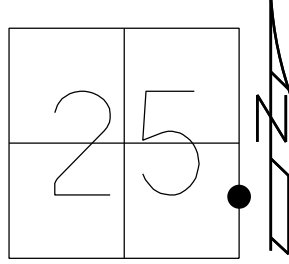


O.D.O.T. DISTRICT 2 SURVEY OFFICE (USE ONLY)

PERSONNEL NOTES <u>MILLER</u> H.C. <u>MILLER</u> R.C. <u>BARRIERE</u> BLUBAUGH, ASTON, PRESTON-COLVIN DWG BY <u>BLUBAUGH</u>	REFERENCE NO. <u>35</u> DATE <u>8/7/24</u> WEATHER <u>WINDY/CLOUDY</u> TEMP. <u>70°F</u> PID <u>114849</u>	SHEET <u>11</u> OF <u>46</u> ROUTE <u>SR 101</u> COUNTY <u>SENECA</u> TOWNSHIP <u>PLEASENT</u> SECTION <u>25</u> T <u>3</u> N R <u>15</u> E
TYPE MONUMENT <u>MONBOX</u> ON SURFACE - BELOW <u>0.5"</u> OFFSET <u>1'</u> <u>LT</u> : RT -- TO -- <u>EDGE PAVEMENT</u> STATION: <u>425+00</u>		
HORZ.DATUM: <u>NAD83 (2011)</u> GEOID: <u>NAVD88-2018</u> GRID: NORTHING: <u>555287.618</u> EASTING: <u>1810504.685</u> LDP: NORTHING: <u>324229.237</u> EASTING: <u>184943.911</u>		

RECORD: P.I.
 STA. 426+91.80
 $\Delta = 0^\circ 29' \text{ LT}$
 8/27/90, BARBOUR
 FD MONBOX
 2/4/05, SAH
 7/14/09, DCH
 FD MONBOX
 REF35
 6/14/16
 9/18/17, JFO
 FD MONBOX
 (COULD NOT OPEN)
 SHOT MID LID
 REF35
 12/20/23, JAM
 FD MONBOX COVERED.
 PAINTED LOCATION
 8/7/24, JAM

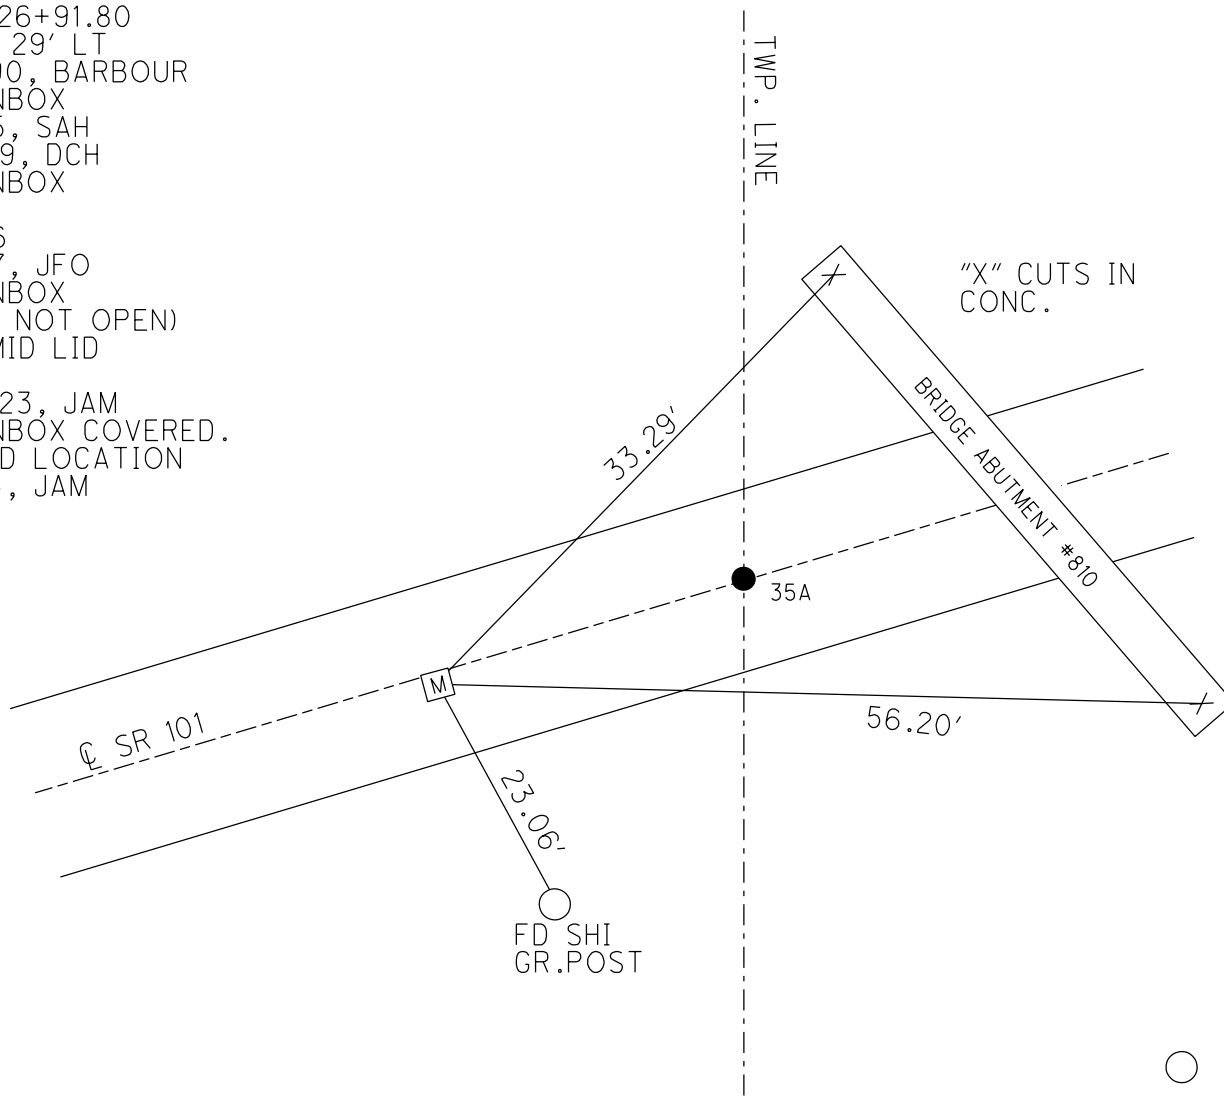

O.D.O.T. DISTRICT 2 SURVEY OFFICE (USE ONLY)

PERSONNEL

REFERENCE NO. 35

SHEET 11 OF 46

NOTES HOMAN

DATE 7-14-09

ROUTE SR 101

H.C.	HOMAN
------	-------

WEATHER SUNNY

COUNTY SENECA

R.C. ROUSOS

TEMP. 80°F

TOWNSHIP PLEASANT

SECTION 25

DWG BY MAHLER

PID 100787

T₃N R₁₅E

TYPE MONUMENT MONBOX

ON SURFACE - ~~BELOW~~ ON

OFFSET C PAVEMENT 1' ~~17'~~ : RT


_____TO_____EDGE PAVEMENT

STATION: 425+00


HORZ.DATUM: NAD83 (2011)

GEOID: NAVD88-2012A

GRID: NORTHING: 555287.618

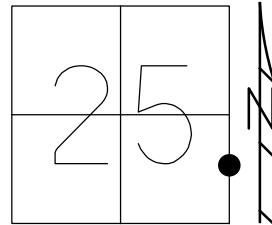EASTING: 1810504.685

RECORD: P.I.
STA. 426+91.80
 $\Delta = 0^\circ 29' \text{ LT}$
8/27/90, BARBOUR
FD MONBOX
2/4/05, SAH
7/14/09, DCH
FD MONBOX
REF35
6/14/16
9/18/17, JFO

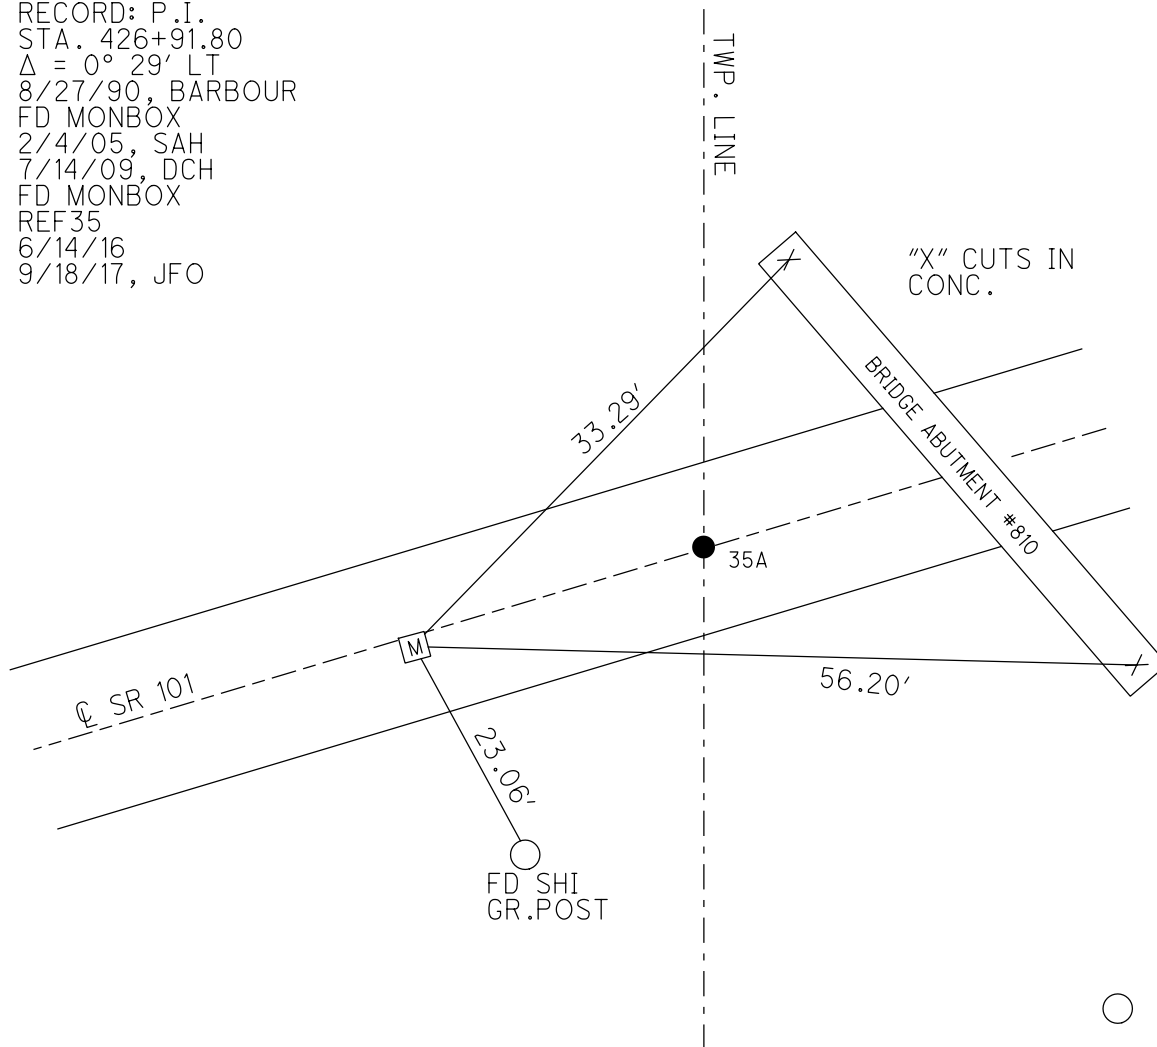


O.D.O.T. DISTRICT 2 SURVEY OFFICE (USE ONLY)


PERSONNEL	REFERENCE NO. <u>35</u>	SHEET <u>11</u> OF <u>46</u>
NOTES	DATE <u>7/14/09</u>	ROUTE <u>SR 101</u>
H.C. <u>HOMAN</u>	WEATHER <u>SUNNY</u>	COUNTY <u>SENECA</u>
R.C. <u>ROUSOS</u>	TEMP. <u>80°</u>	TOWNSHIP <u>PLEASANT</u>
		SECTION <u>25</u>
		T <u>3</u> N R <u>15</u> E

TYPE MONUMENT MONBOX
 ON SURFACE - ~~BELOW~~ ON
~~LEFT~~ - CL PAV'T - RIGHT 1'
- TO - EDGE PAVEMENT
 S.L.M. 425+00

GRID: NORTHING: 555287.618 EASTING: 1810504.685

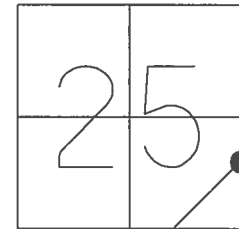

RECORD: P.I.
 STA. 426+91.80
 $\Delta = 0^\circ 29' \text{ LT}$
 8/27/90
 FD MONBOX
 2/4/05, SAH
 7/14/09, DCH
 FD MONBOX
 REF35
 6/14/16, JFO
 UNCOVERED
 9/18/17, JFO

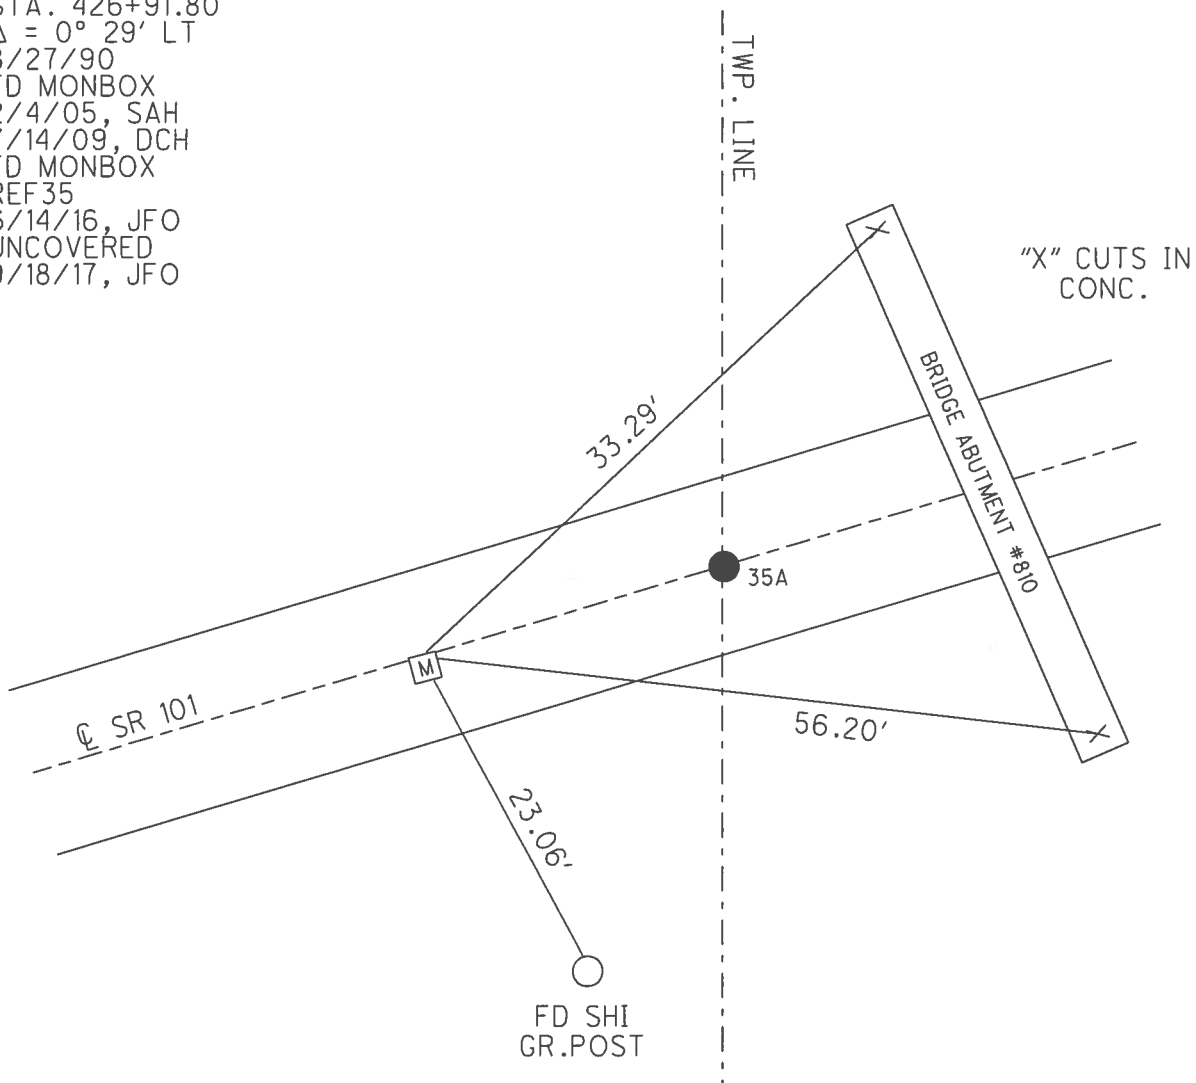


O.D.O.T. DISTRICT 2 SURVEY OFFICE (USE ONLY)


PERSONNEL _____ REFERENCE NO. 35 SHEET 11 OF 46
 NOTES HOMAN DATE 7/14/09 ROUTE SR 101
 H.C. HOMAN WEATHER SUNNY COUNTY SENECA
 R.C. ROUSOS TEMP. 80° TOWNSHIP PLEASANT
 _____ SECTION 25
 _____ T 3 N R 15 E

TYPE MONUMENT MONBOX
 ON SURFACE - ~~BELOW~~ ON _____
~~LEFT~~ - Q PAV'T - RIGHT 1'
 _____ TO _____ EDGE PAVEMENT
 S.L.M. 425+00

GRID: NORTHING: 555287.679 EASTING: 1810504.791

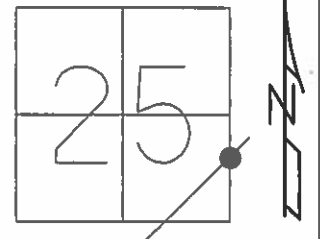

RECORD: P.I.
 STA. 426+91.80
 $\Delta = 0^\circ 29' \text{ LT}$
 8/27/90
 FD MONBOX
 2/4/05, SAH
 7/14/09, DCH

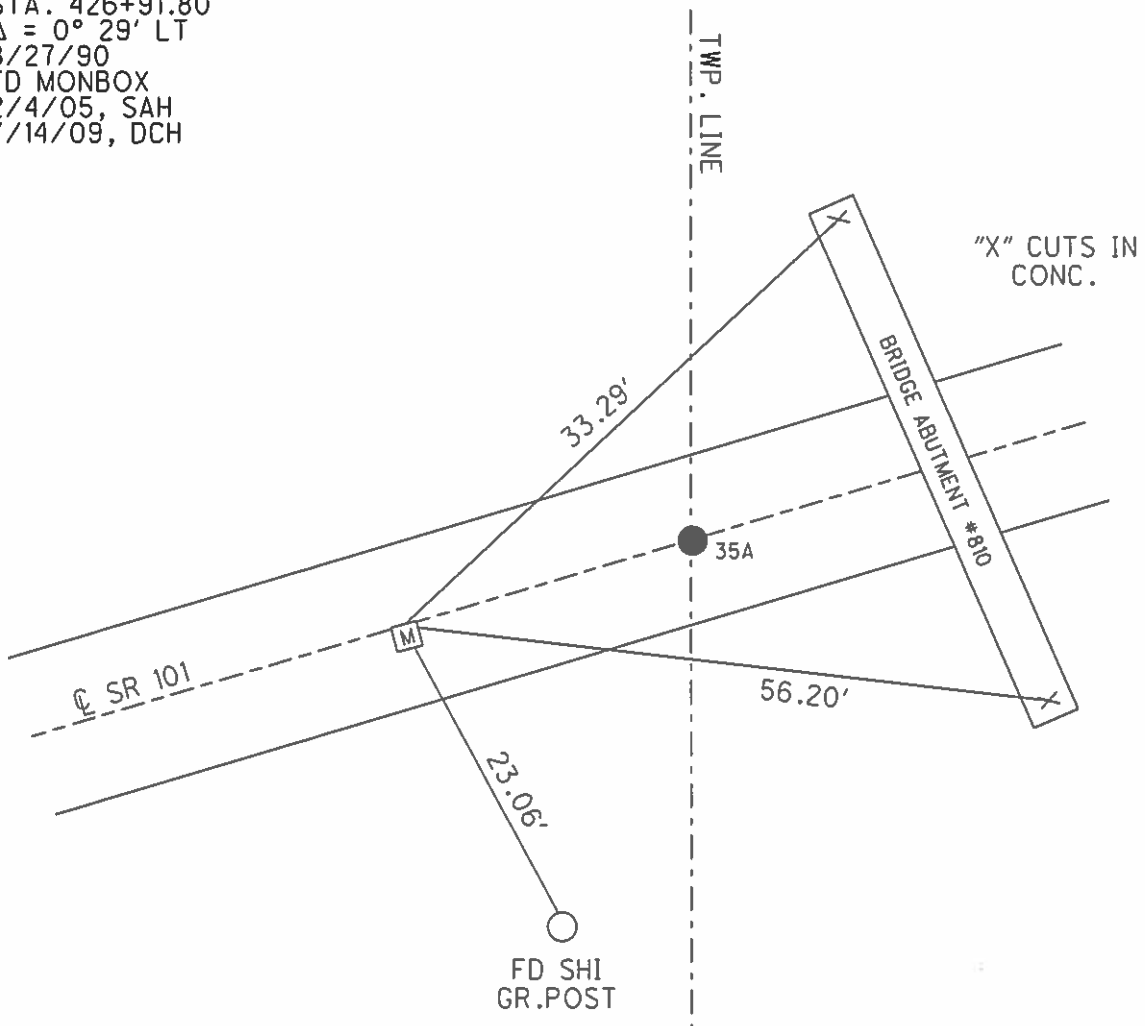

O.D.O.T. DISTRICT 2 SURVEY OFFICE

PERSONNEL

REFERENCE NO. 35

SHEET 9 OF 41

NOTES RIPPLE

H.C. BARBOUR

R.C. GEYMAN

DATE 8/27/90

WEATHER SUNNY

TEMP. 92°


ROUTE SR#101

COUNTY SENECA

TOWNSHIP PLEASANT ADAMS

SECTION 25 30

T. 3 N. R. 15 E. PLEASANT

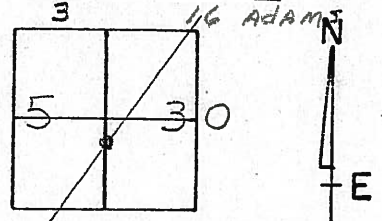


TYPE MONUMENT See Notes Below

ON SURFACE - BELOW P.O.T. = P.K. 425+11 P.I. Mon. Box

LEFT- & PAV'T. - RIGHT & PAV'T. #35 = 1' RT

TO EDGE PAVEMENT

S.L.M. A = 425+00 B = 425+06

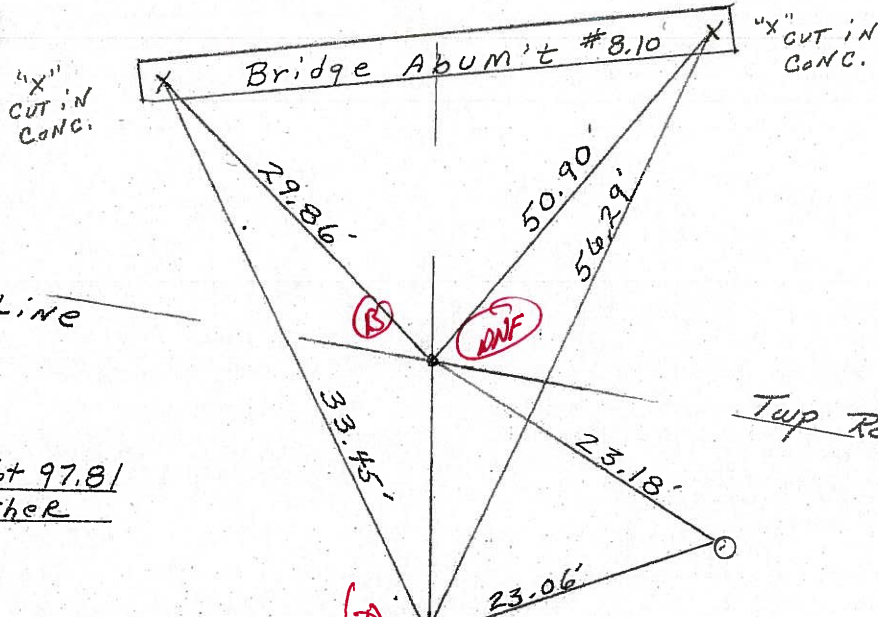

P.O.T. 426+97.81

P.K. & WASHER

P.I. 426+91.80

Mon. Box

A = 0° 29' LT.

425+00 (A)

F & Mon Box
2-4-05
SAH

& R/W SR#101

O.D.O.T. DISTRICT 2 SURVEY OFFICE

PERSONNEL

REFERENCE NO. 35

SHEET 9 OF 41

NOTES RIPPLE

H.C. BARBOUR

R.C. Geyman

DATE 8/27/90

WEATHER SUNNY

TEMP. 92°

ROUTE SR#101

COUNTY Seneca

TOWNSHIP Pleasant Adams

SECTION 25 30

T 3 NR 15 E Pleasant

3 1/6 ADAMS




TYPE MONUMENT See Notes Below

ON SURFACE - BELOW $P.O.T. = P.K.^{NA''1} P.I. Men. Box$

LEFT - & PAV'T. - RIGHT & PAV'T.

____TO____EDGE PAVEMENT

S.L.M. _____

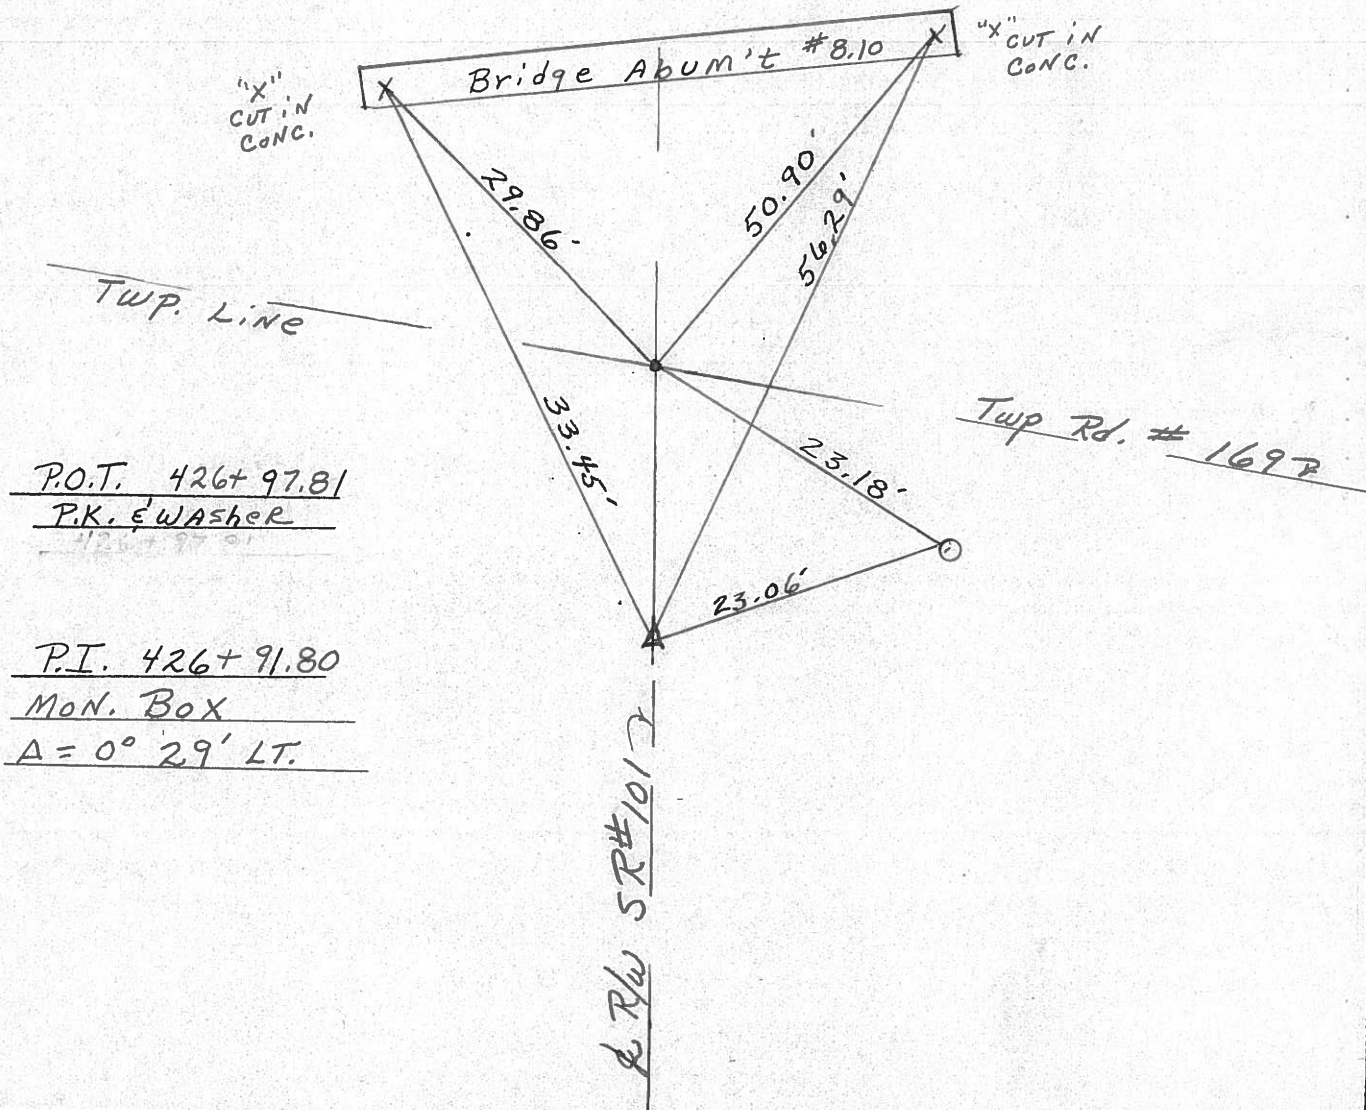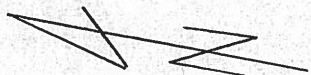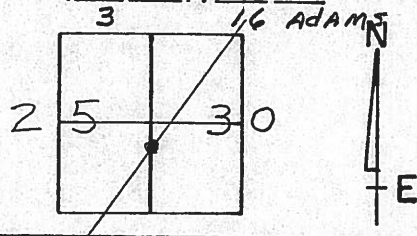

County Seneca S.R. 101

Township (Pleasant) & (Adams)

Section 25 30

T₃N, R₁₅E Pleasant
3 Adams

Personnel Schneider

Mosser



Barbour

Date 6-26-79

Weather Sunny

Temp. 75°

(35)

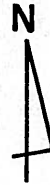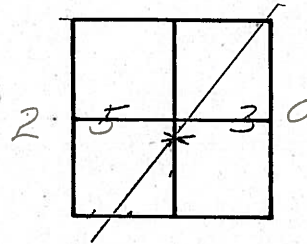

~~#40~~



P.O.T.

Small Spk.

426 + 97.81


R.K. Nail

P.I.

426 + 91.80

$\Delta = 0^\circ 29'$ Lt.

Mon. Box

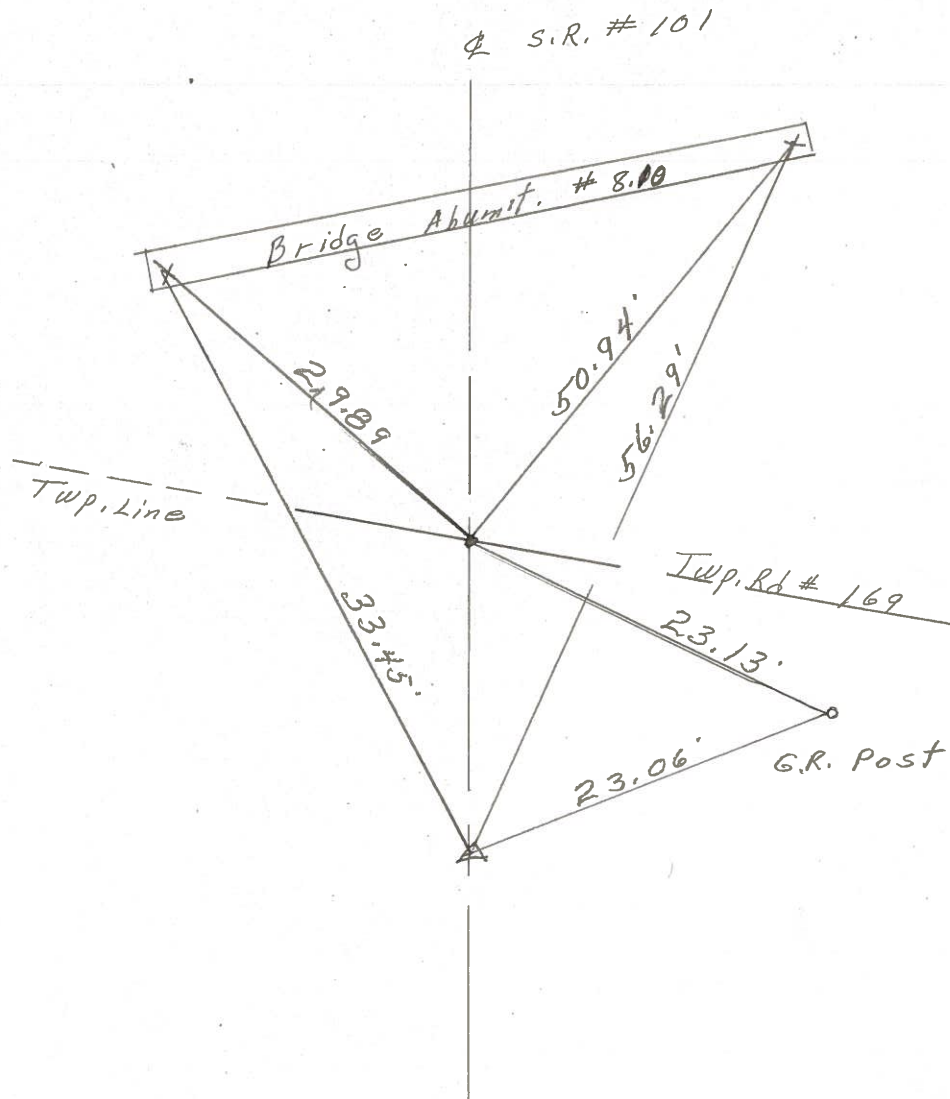

PERSONNEL TITLE PERSONNEL TITLE

Schneider

COUNTY Seneca

DATE

9-12-77
4-8-77

Mosser

S. R. 101

WEATHER

Fair

Barbour

SEC. Br 8.10

TEMP.

30°

70°

DESCRIPTION


Ties for Control Points

JOB NO.

LEFT

CENTER LINE

RIGHT

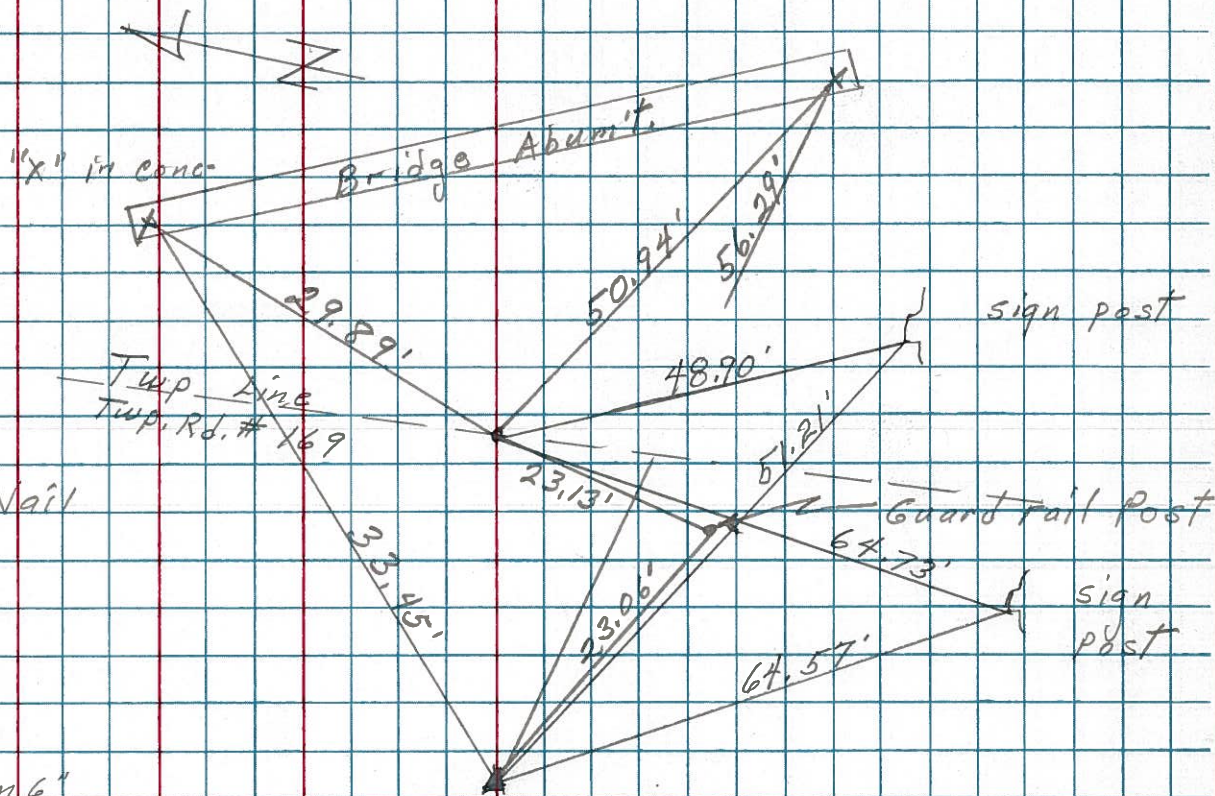

P.O.T.

426+97.81

small spk.

Reset P.K. Nail

P.I.

426+91.80

sq. bolt down 6"

 $\Delta = 0^\circ 29' \text{ Lt.}$

P.K. on surface

Mon Box

PERSONNEL	TITLE	PERSONNEL	TITLE	COUNTY	DATE	WEATHER	TEMP
Schneider		Vinson		Seneca	10-4-71	Fair	72'
Mosser				S. R. 101			
Barbour				SEC. Br. #8.10			
Geyman							

DESCRIPTION	LEFT	CENTER LINE	RIGHT	JOB NO.
				028270

(35-A)

~~40~~

P.O.T.
426+97.81
set small spk.

10" Cottonwood

69.79'

71.70'

32.75'

35.51'

59.85'

Twp. line
Twp. Rd. #169 South

26" Ash

24" Ash

(35)

P.I.
426+91.80
Ed. sp. bolt
 $\Delta = 0^\circ 29' \text{ Lt.}$

~~39~~

(34)

P.I.
414+04.19
set small spk.
 $\Delta = 9^\circ 48' \text{ Lt.}$

8" Basewood
12" Ash
43.25' Plumb
26.98' Plumb
21.02' Plumb

(33)

~~38~~

P.O.T.
410+41.26
set P.K. Nail

10" Cedar
68.85' Plumb
63.86' Plumb
46.85' Plumb
"X" on Hdwl.

PERSONNEL TITLE PERSONNEL TITLE

COUNTY Seneca DATE

S. R. 101 WEATHER

SEC. TEMP.

DESCRIPTION LEFT CENTER LINE RIGHT JOB NO.


(35)

184+16.5

#386

P.K. nail

2-10-64

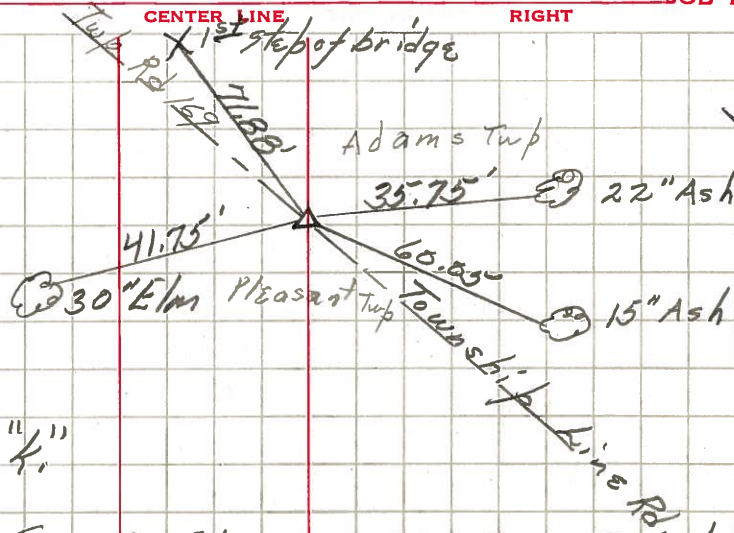

SEC 0 Sta 0+00 = 184+16.5 Sec. 4

Start of sec. 0.


(37)

19+77.65

#387

P.K. nail

2-10-64

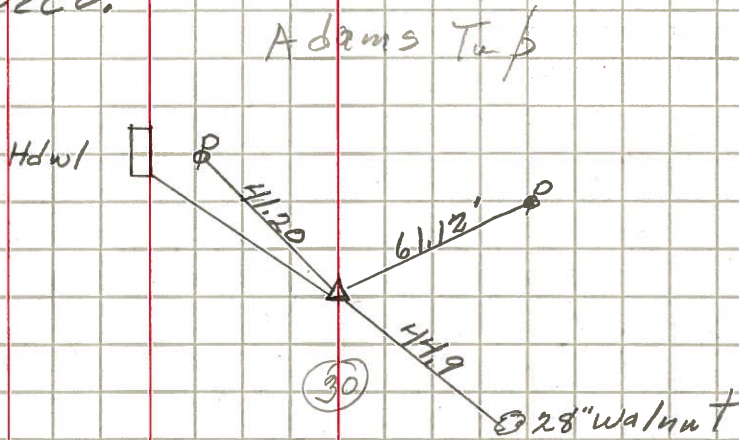

(38)

41+76.8

#388

P.K. nail

2-10-64

