

O.D.O.T. DISTRICT 2 SURVEY OFFICE (USE ONLY)

PERSONNEL

REFERENCE NO. 35 A

SHEET 12 OF 46

NOTES RIPPLE
H.C. BARBOUR
R.C. GEYMAN

DATE 8-27-90
WEATHER SUNNY
TEMP. 92°F

ROUTE SR 101
COUNTY SENECA
TOWNSHIP ADAMS
SECTION 30
T 3 N R 16 E

DWG BY MAHLER PID 100787

TYPE MONUMENT P.K.NAIL

ON SURFACE - ~~BELOW~~ ON

OFFSET $\varnothing$ PAVEMENT ON ~~LT~~ : RT


-- TO -- EDGE PAVEMENT

STATION: 425+06


HORZ.DATUM: - GEOID: -

GRID: NORTHING: - EASTING: -

LDP: NORTHING: - EASTING: -

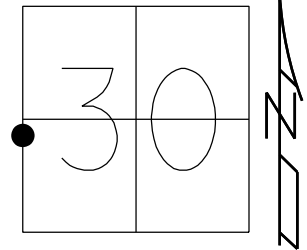

RECORD: P.O.T.
STA.426+97.81
FD P.K./WASHER
8/27/90, BARBOUR
D.N.F.
2/4/05, SAH
7/14/09, DCH
6/14/16, JFO
8/7/24, JAM

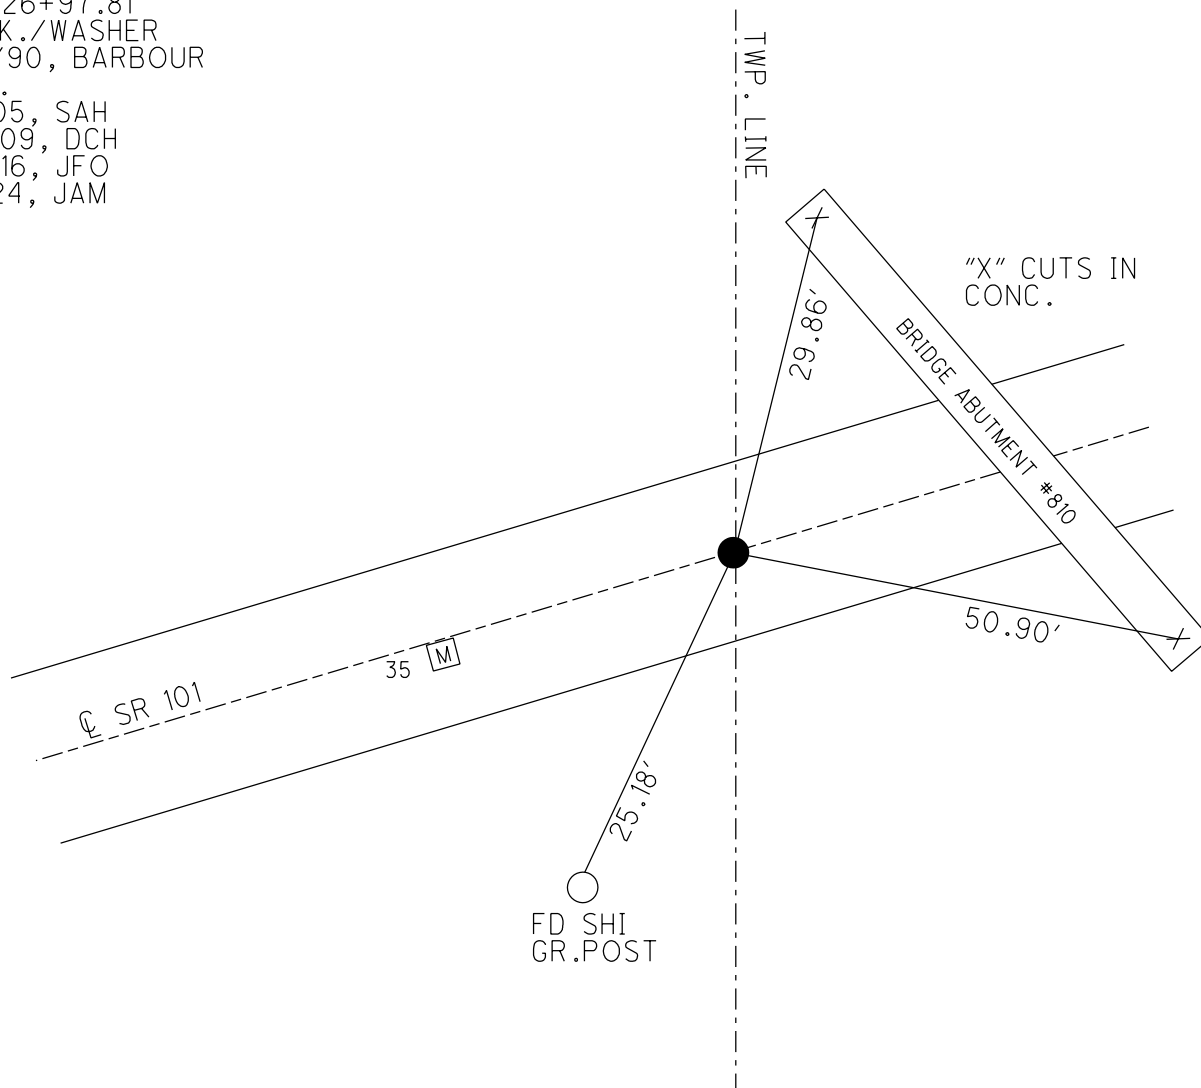

O.D.O.T. DISTRICT 2 SURVEY OFFICE (USE ONLY)

PERSONNEL

REFERENCE NO. 35 A

SHEET 12 OF 46

NOTES RIPPLE

DATE 8-27-90

ROUTE SR 101

H.C. BARBOUR

WEATHER SUNNY

COUNTY SENECA

R.C. GEYMAN

TEMP. 92°F

TOWNSHIP ADAMS

DWG BY MAHLER PID 100787

SECTION 30

T 3 N R 16 E

TYPE MONUMENT P.K.NAIL

ON SURFACE - ~~BELOW~~ ON


OFFSET Q PAVEMENT ON LT : RT

- TO - EDGE PAVEMENT


STATION: 425+06

HORIZ.DATUM: - GEOID: -

GRID: NORTHING: - EASTING: -

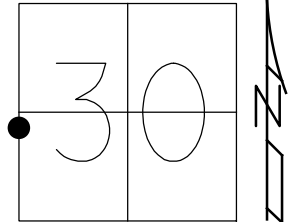


RECORD: P.O.T.
STA. 426+97.81
FD P.K./WASHER
8/27/90, BARBOUR
D.N.F.
2/4/05, SAH
7/14/09, DCH
6/14/16, JFO

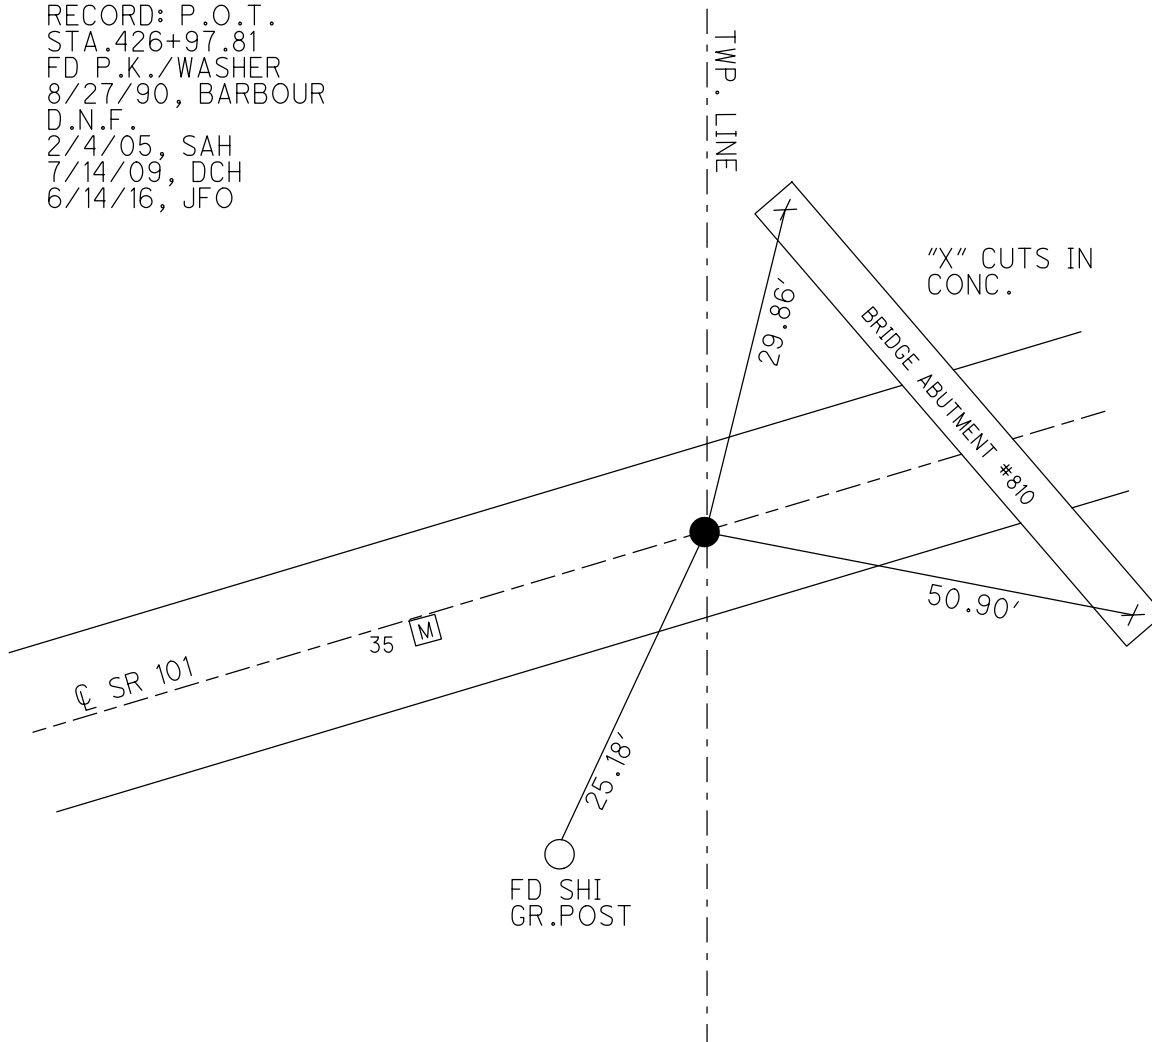


O.D.O.T. DISTRICT 2 SURVEY OFFICE (USE ONLY)

PERSONNEL	REFERENCE NO. <u>35 A</u>	SHEET <u>12</u> OF <u>46</u>
NOTES	DATE <u>8/27/90</u>	ROUTE <u>SR 101</u>
H.C. <u>BARBOUR</u>	WEATHER <u>SUNNY</u>	COUNTY <u>SENECA</u>
R.C. <u>GEYMAN</u>	TEMP. <u>92°</u>	TOWNSHIP <u>ADAMS</u>
		SECTION <u>30</u>
		T <u>3</u> N R <u>16</u> E

TYPE MONUMENT P.K.NAIL
 ON SURFACE - ~~BELOW~~ ON
 LEFT - ℄ PAV'T - RIGHT ON
- TO - EDGE PAVEMENT
 S.L.M. 425+06
 GRID: NORTHING: - EASTING: -

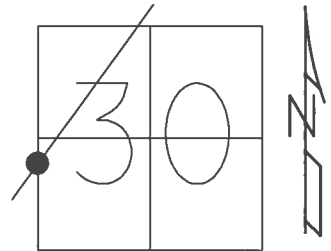


RECORD: P.O.T.
 STA. 426+97.81
 FD P.K./WASHER
 8/27/90
 D.N.F.
 2/4/05, SAH
 7/14/09, DCH
 6/14/16, JFO

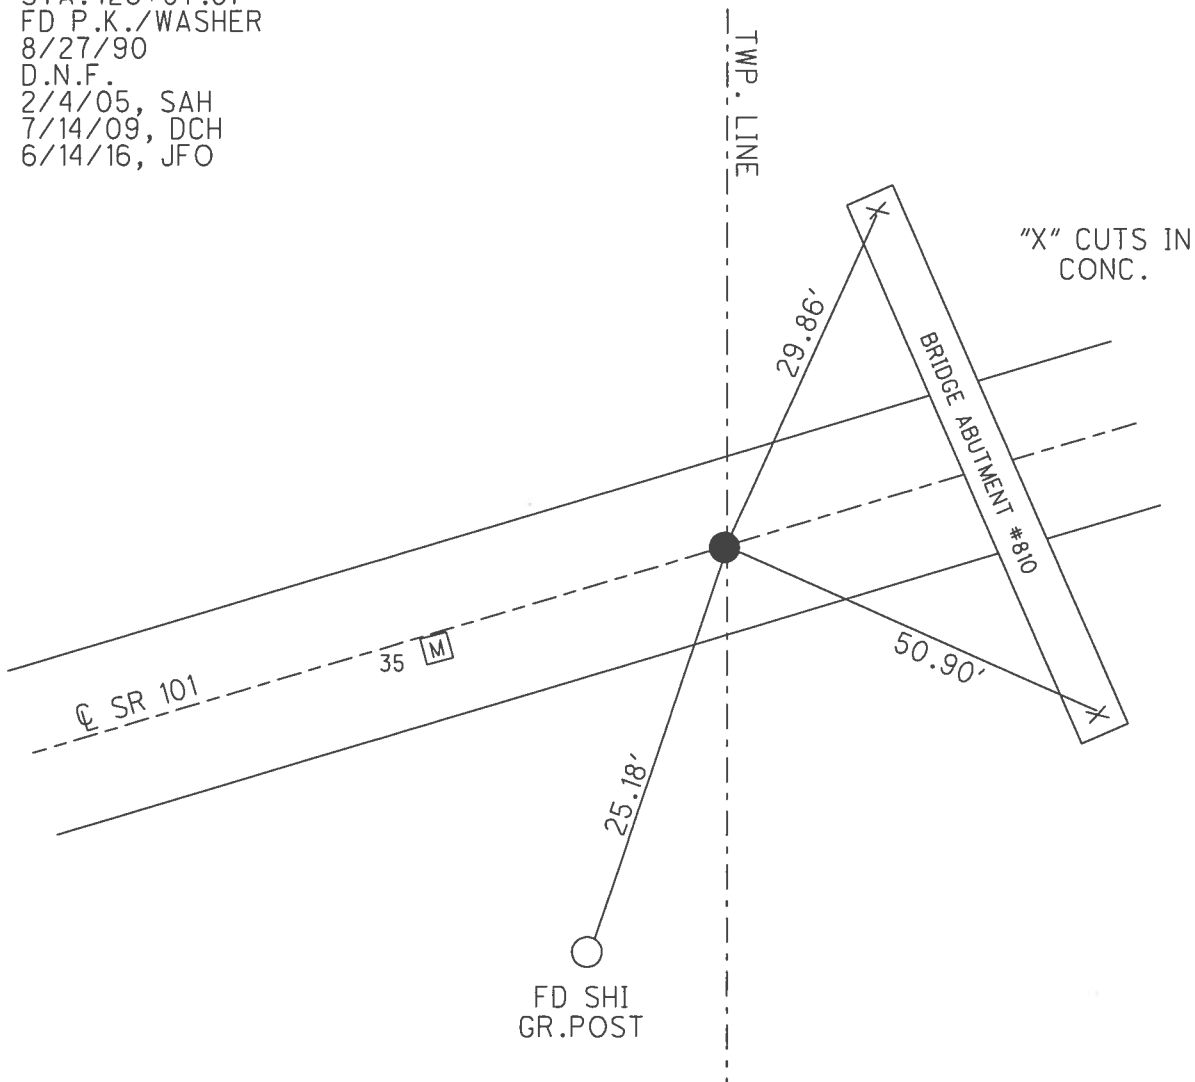


O.D.O.T. DISTRICT 2 SURVEY OFFICE (USE ONLY)

PERSONNEL _____ REFERENCE NO. 35 A SHEET 12 OF 46
 NOTES RIPPLE _____ DATE 8/27/90 ROUTE SR 101
 H.C. BARBOUR _____ WEATHER SUNNY COUNTY SENECA
 R.C. GEYMAN _____ TEMP. 92° TOWNSHIP ADAMS
 _____ SECTION 30
 _____ T 3 N R 16 E

TYPE MONUMENT P.K.NAIL
 ON SURFACE - ~~BELOW~~ ON _____
 LEFT - ℄ PAV'T - RIGHT ON _____
 - TO - EDGE PAVEMENT
 S.L.M. 425+06
 GRID: NORTHING: _____ EASTING: _____

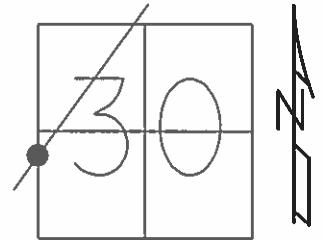

RECORD: P.O.T.
 STA. 426+97.81
 FD P.K./WASHER
 8/27/90
 D.N.F.
 2/4/05, SAH
 7/14/09, DCH

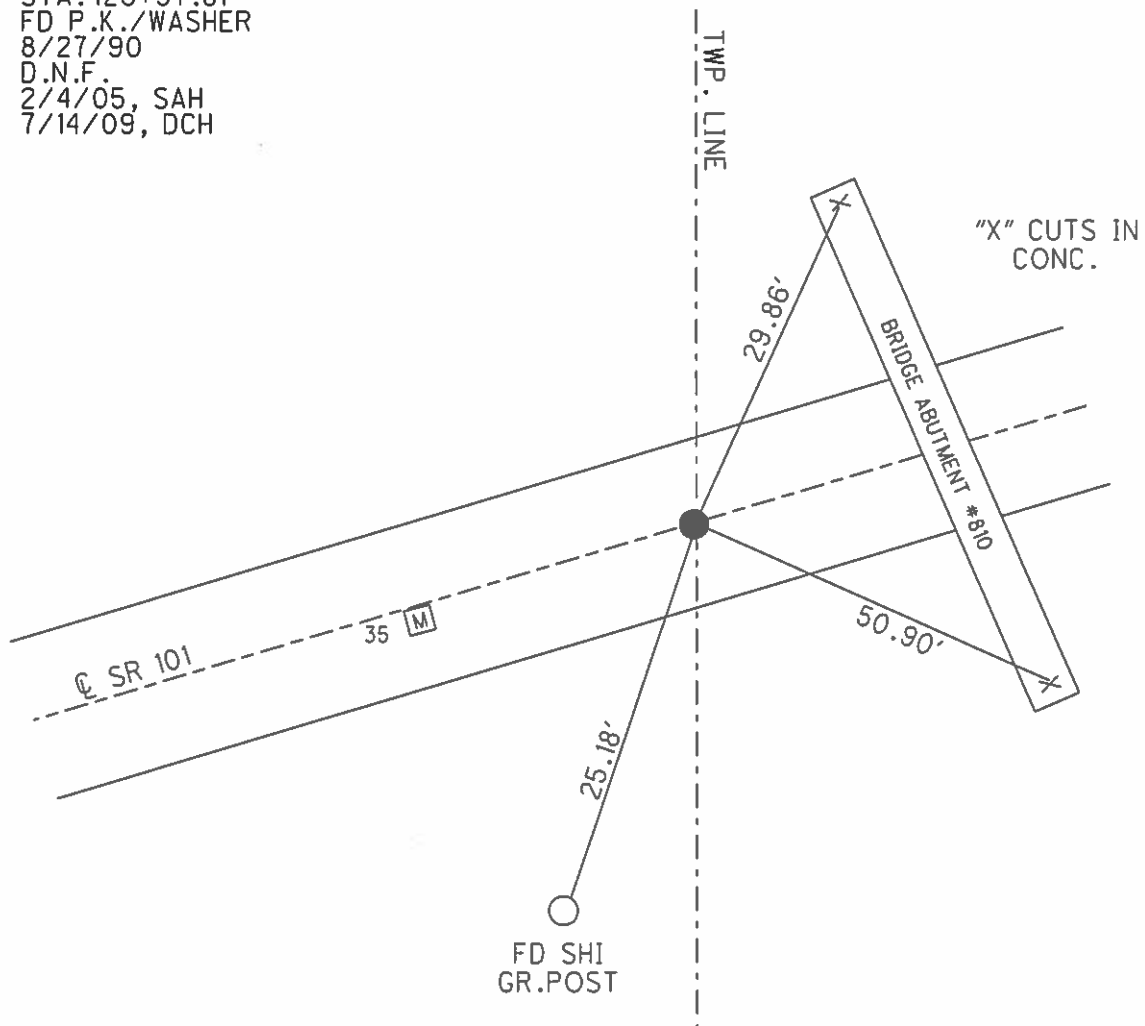

O.D.O.T. DISTRICT 2 SURVEY OFFICE

PERSONNEL

REFERENCE NO. 35

SHEET 9 OF 41

NOTES RIPPLE

H.G. BARBOUR

R.G. GEYMAN

DATE 8/27/90

WEATHER SUNNY

TEMP. 92°

ROUTE SR #101

COUNTY SENECA

TOWNSHIP PLEASANT ADAM

SECTION 25 30

T. 3 N. R. 15 E. PLEASANT

3 16 ADAM


TYPE MONUMENT See Notes Below

ON SURFACE - BELOW P.O.T. = P.K. 425+100 P.I. Mon. Box



LEFT- & PAV'T. - RIGHT & PAV'T. #35 = 1' RT

TO EDGE PAVEMENT

S.L.M. A = 425+00 B = 425+06

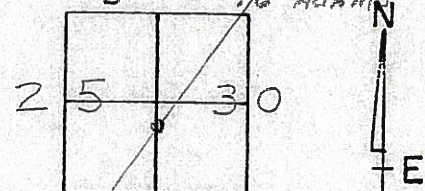

35-A

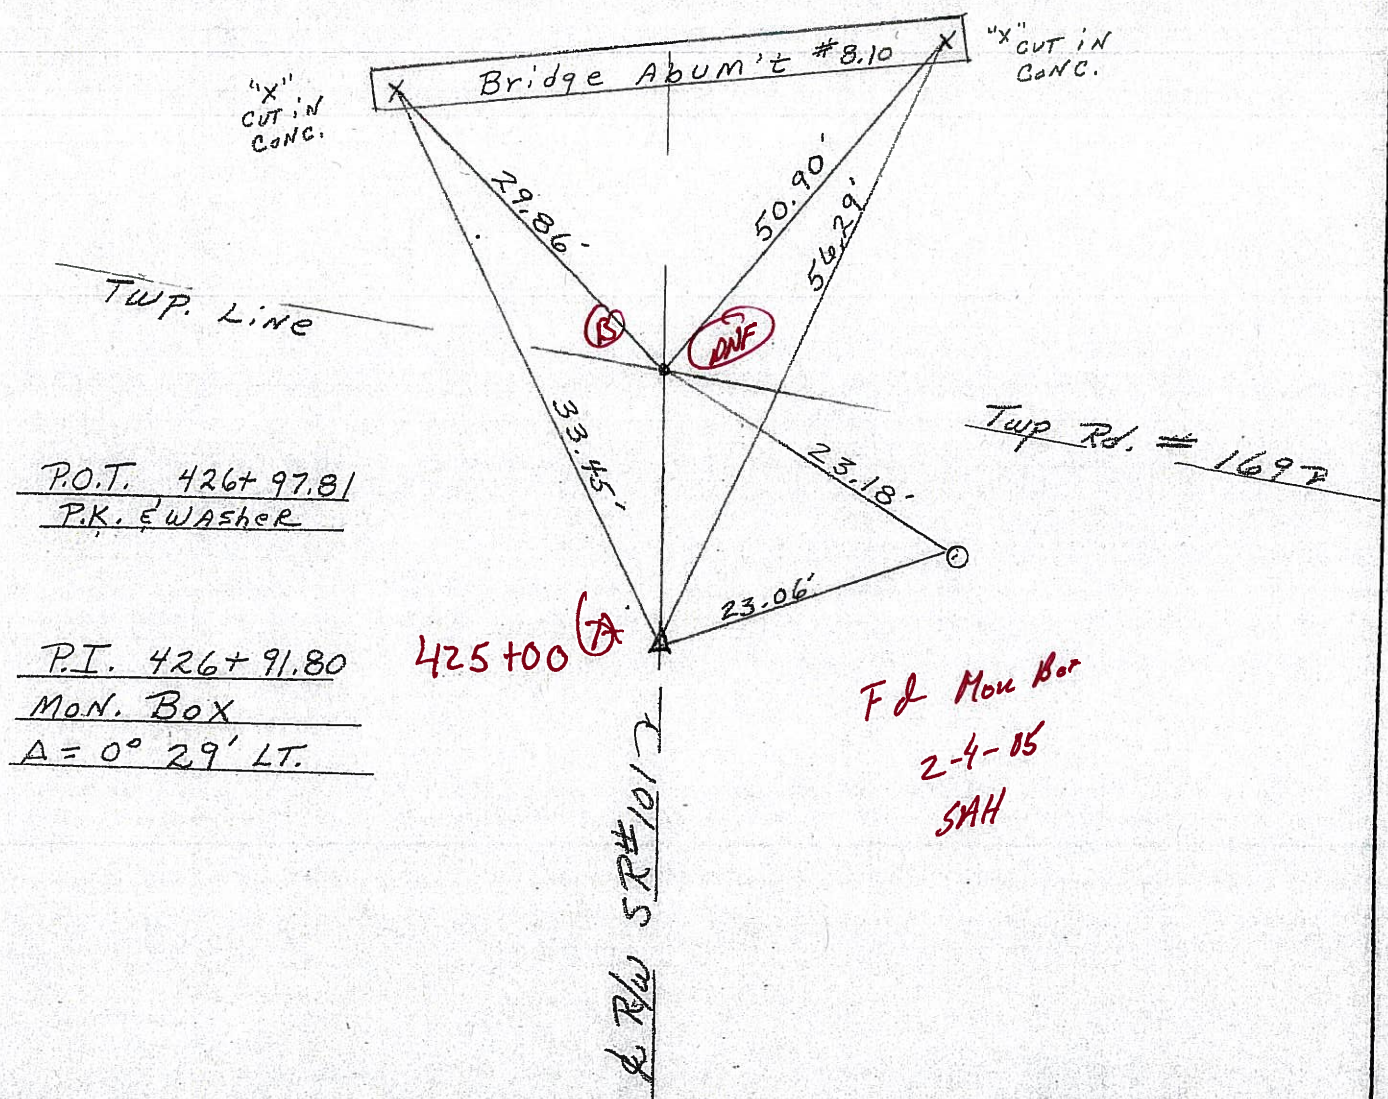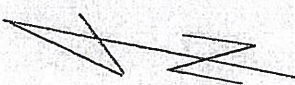

O.D.O.T. DISTRICT 2 SURVEY OFFICE

PERSONNEL

REFERENCE NO. 35

SHEET 9 OF 41

NOTES RIPPLE

H.C. BARBOUR

R.G. GEYMAN

DATE 8/27/90

WEATHER SUNNY

TEMP. 92°

ROUTE SR#101

COUNTY SENECA

TOWNSHIP PLEASANT & ADAMS

SECTION 25 30

T. 3 N. R. 15 E. PLEASANT

3 16 ADAMS

TYPE MONUMENT See Notes Below



ON SURFACE - BELOW P.O.T. = P.K. 426+97.81 P.I. Mon. Box


LEFT- & PAV'T. - RIGHT & PAV'T.

TO EDGE PAVEMENT

S.L.M. _____

35-A

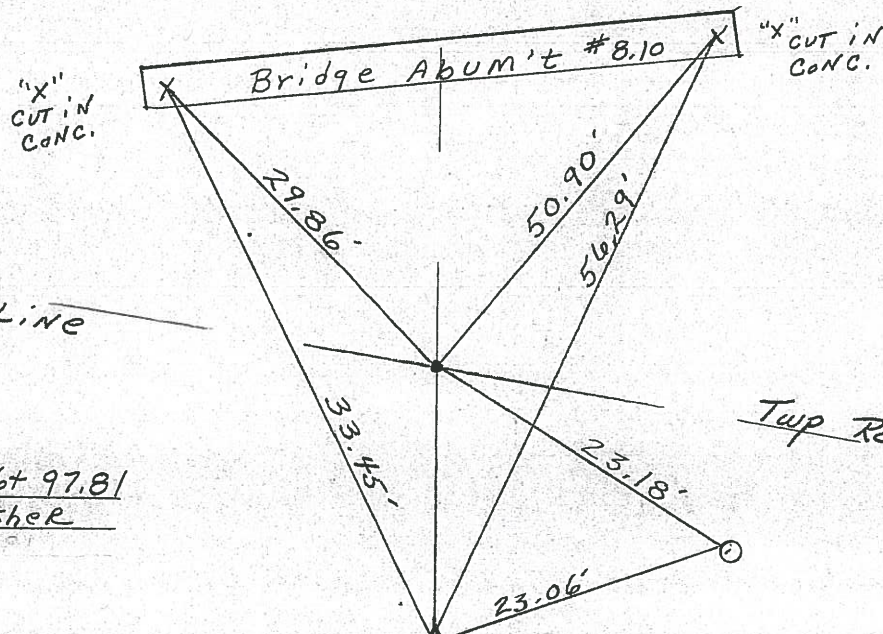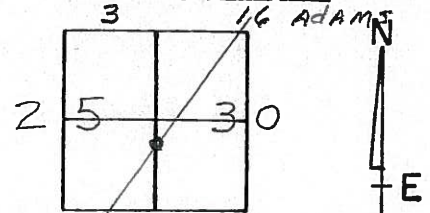

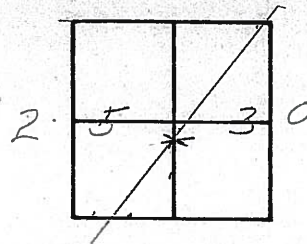County Seneca S.R. 101Township (Pleasant) & (Adams)Section 25 30T 3 N, R 15 E Pleasant3 16 AdamsPersonnel SchneiderMosserBarbourDate 6-26-79Weather SunnyTemp. 75°**35-A**~~#40~~

P.O.T.

small cph.

426 + 97.81


R.K. Nail

P.I.

426 + 91.80

 $\Delta = 0^\circ 29'$ Lt.

Mon. Box

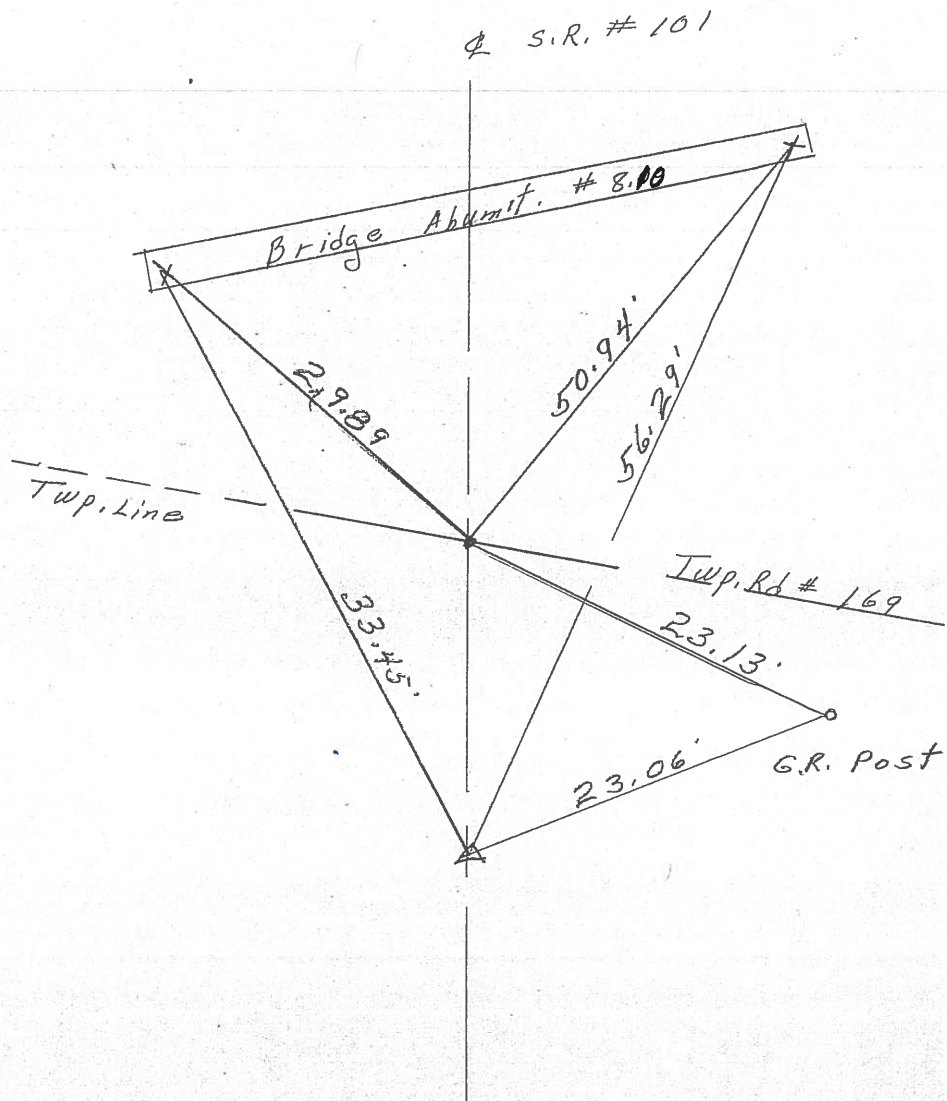

PERSONNEL TITLE PERSONNEL TITLE


COUNTY SenecaDATE 9-12-77
4-8-77SchneiderMosserBarbourS. R. 101WEATHER FairSEC. Br. 8.10TEMP. 30° 70DESCRIPTION Ties for Control Points

JOB NO.

LEFT

CENTER LINE

RIGHT

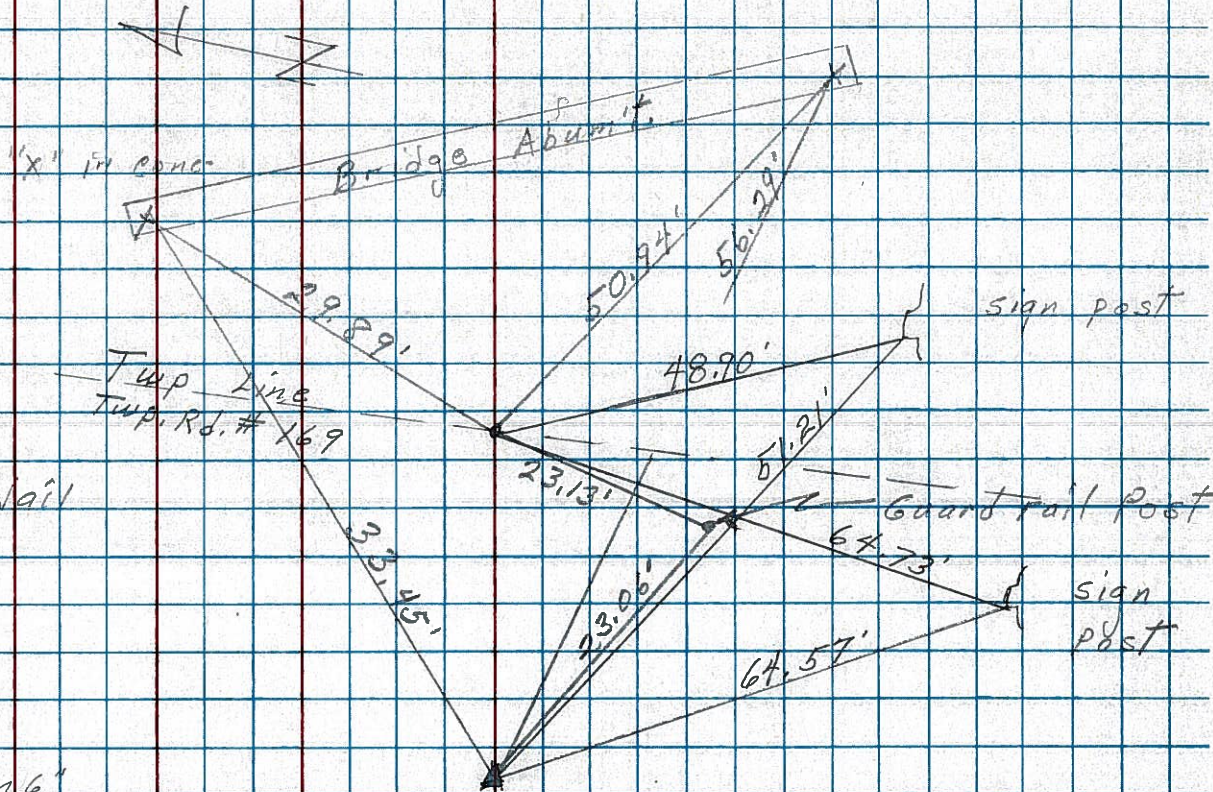

P.O.T.

426+97.81

small spk.

Reset P.K. Nail

P.I.

426+91.80

sq. bolt down 6"

 $\Delta = 0^\circ 29' \text{ Lt.}$

P.K. on surface

Mon BOX

(35-A)

(35)

PERSONNEL	TITLE	PERSONNEL	TITLE	COUNTY	DATE	WEATHER	TEMP
Schneider		Vinson		Seneca	10-4-71	Fair	72'
Mosser				S. R. 101			
Barbour				SEC. Br. #8.10			
Geyman							

DESCRIPTION

LEFT

CENTER LINE


RIGHT

JOB NO. 028270

(35-A)

~~40~~

P.O.T.
426+97.81
set small spk.

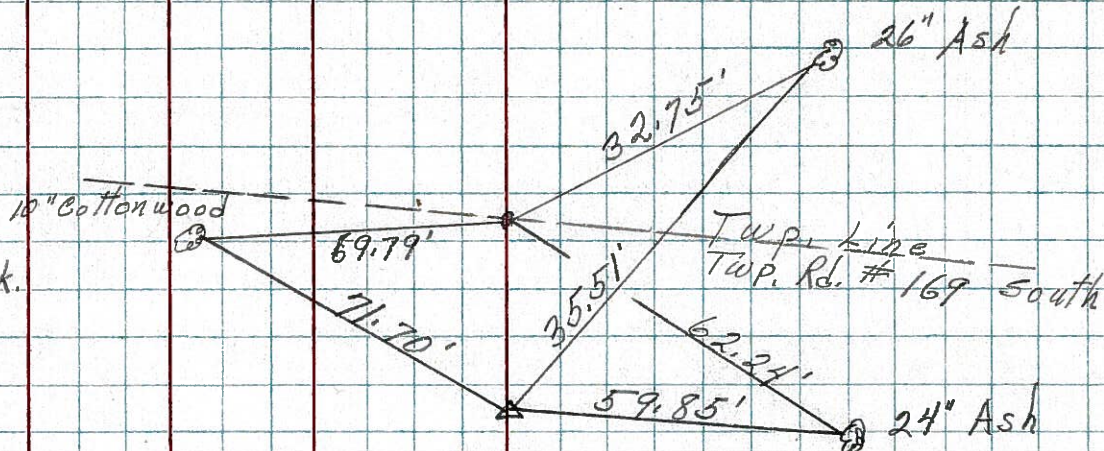


(35)

P.T.
426+91.80
Ed. sp. bolt
 $\Delta = 0^\circ 29' \text{ Lt.}$

(34)

~~39~~

P.I.
414+04.19
set small spk.
 $\Delta = 9^\circ 48' \text{ Lt.}$

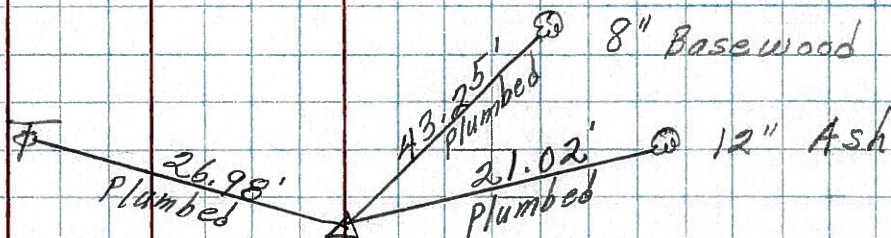

(33)

~~38~~

P.O.T.
410+41.26
set P.K. Nail

