

O.D.O.T. DISTRICT 2 SURVEY OFFICE (USE ONLY)

PERSONNEL

REFERENCE NO. 37

SHEET 14 OF 46

NOTES MILLER DATE 8/7/24

H.C. MILLER WEATHER SUNNY

R.C. BARRIERE TEMP. 75°F

BLUBAUGH, ASTON, PRESTON-COLVIN

DWG BY BLUBAUGH PID 114849ROUTE SR 101

COUNTY SENECA

TOWNSHIP ADAMSSECTION 30

T_3_N R_16_E

TYPE MONUMENT MAG/WASHER

ON SURFACE - BELOW 0.5"

OFFSET 0 PAVEMENT ON LT : RT


____TO____EDGE PAVEMENT

STATION: 445+55


HORZ.DATUM: NAD82 (2011)

GEOID: NAVD88-2018

GRID: NORTHING: 556869.989

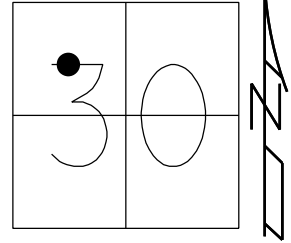EASTING: 1811808.728LDP: NORTHING: 325821.447EASTING: 186236.180

RECORD: P.I.
STA. 447+43.01
 $\Delta = 1^{\circ} 31' 30''$
FD 1/2" IPIN
SET P.K.WASHER
8/27/90, BARBOUR
FD P.K./WASHER
2/4/05, SAH
FD P.K./WASHER
REF37
7/14/09, DCH
SET MAG/WASHER
NEWREF37
10/8/09, DCH
FD MAG/WASHER
REF37
6/14/16
9/18/17, JFO
FD MAG/WASHER
REF37
12/14/23, JAM
FD TONE. DID
NOT UNCOVER.
PAINTED
8/7/24, JAM

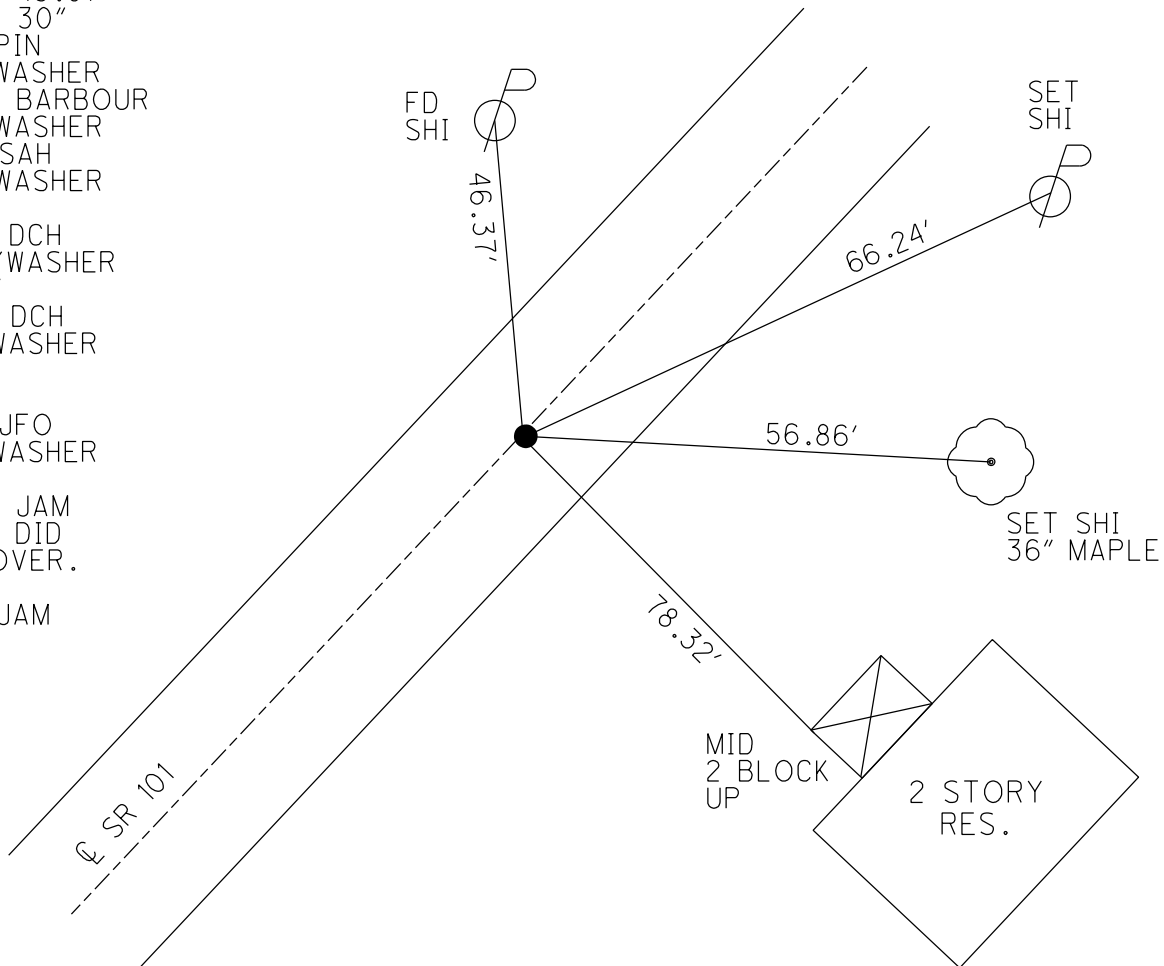

O.D.O.T. DISTRICT 2 SURVEY OFFICE (USE ONLY)

PERSONNEL

REFERENCE NO. 37

SHEET 14 OF 46

NOTES HOMAN

DATE 7-14-09

ROUTE SR 101

H.C. HOMAN

WEATHER SUNNY

COUNTY SENECA

R.C. ROUSOS

TEMP. 85°F

TOWNSHIP ADAMS

DWG BY MAHLER PID 100787

SECTION 30

T 3 N R 16 E

TYPE MONUMENT P.K./WASHER

ON SURFACE - ~~BELOW~~ ON

OFFSET ℄ PAVEMENT ON LT : RT

- TO - EDGE PAVEMENT


STATION: 445+55

HORIZ.DATUM: NAD83 (2011)


GEOID: NAVD88-2012A

GRID: NORTHING: 556869.989

EASTING: 1811808.728

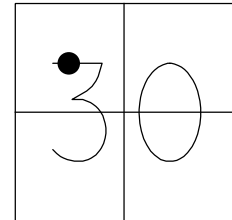


RECORD: P.I.
STA. 447+43.01
 $\Delta = 1^\circ 31' 30''$
FD 1/2" IPIN
SET P.K.WASHER
8/27/90, BARBOUR
FD P.K./WASHER
2/4/05, SAH
FD P.K./WASHER
REF37
7/14/09, DCH
SET MAG/WASHER
NEWREF37
10/8/09, DCH
FD MAG/WASHER
REF37
6/14/16
9/18/17, JFO

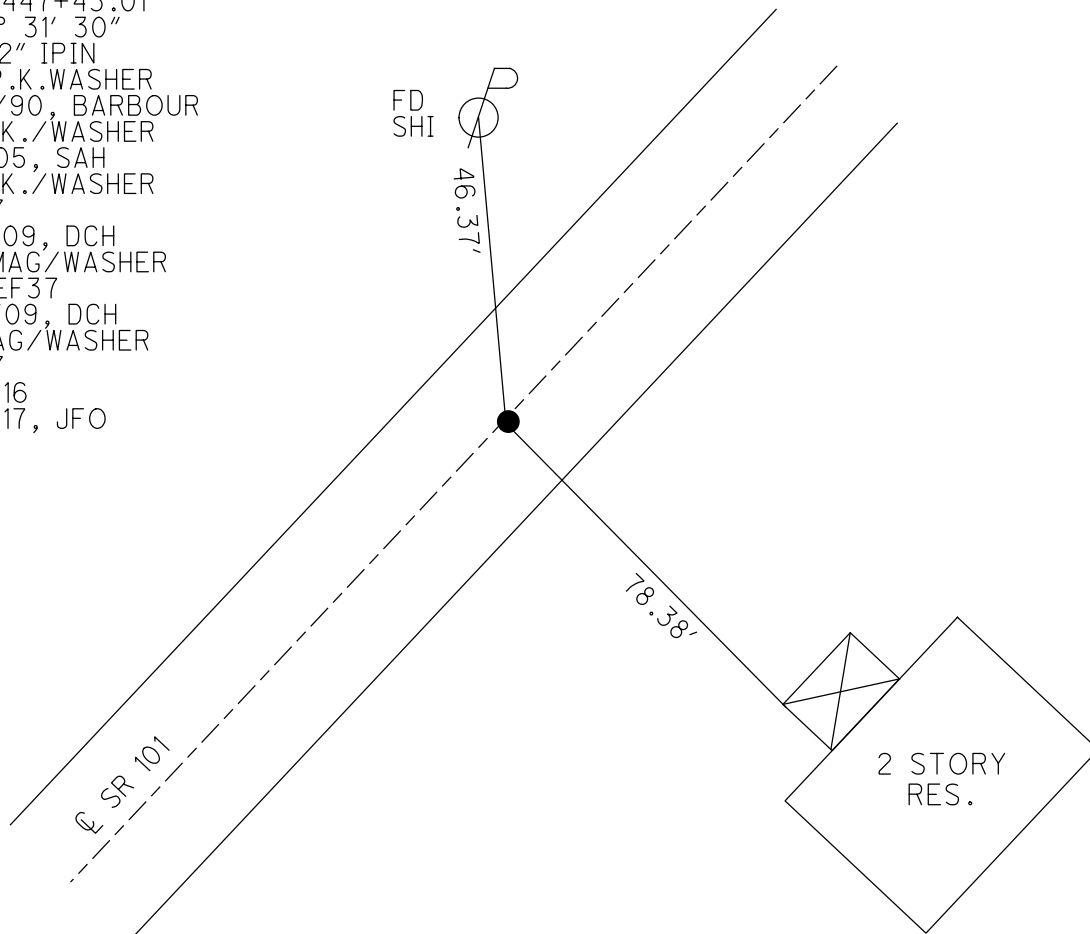

O.D.O.T. DISTRICT 2 SURVEY OFFICE (USE ONLY)


PERSONNEL	REFERENCE NO. <u>37</u>	SHEET <u>14</u> OF <u>46</u>
NOTES	DATE <u>7/14/09</u>	ROUTE <u>SR 101</u>
H.C. <u>HOMAN</u>	WEATHER <u>SUNNY</u>	COUNTY <u>SENECA</u>
R.C. <u>ROUSOS</u>	TEMP. <u>85°</u>	TOWNSHIP <u>ADAMS</u>
		SECTION <u>30</u>
		T <u>3</u> N R <u>16</u> E

TYPE MONUMENT P.K./WASHER
 ON SURFACE - ~~BELOW~~ ON
 LEFT - ℄ PAV'T - RIGHT ON
- TO - EDGE PAVEMENT
 S.L.M. 445+55

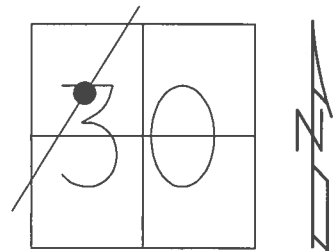

GRID: NORTHING: 556869.989 EASTING: 1811808.728

RECORD: P.I.
 STA. 447+43.01
 $\Delta = 1^\circ 31' 30''$
 FD 1/2" IPIN
 SET P.K.WASHER
 8/27/90
 FD P.K./WASHER
 2/4/05, SAH
 SET MAG/WASHER
 10/8/09, DCH
 FD MAG/WASHER
 REF37
 6/14/16, JFO
 UNCOVERED
 9/18/17, JFO

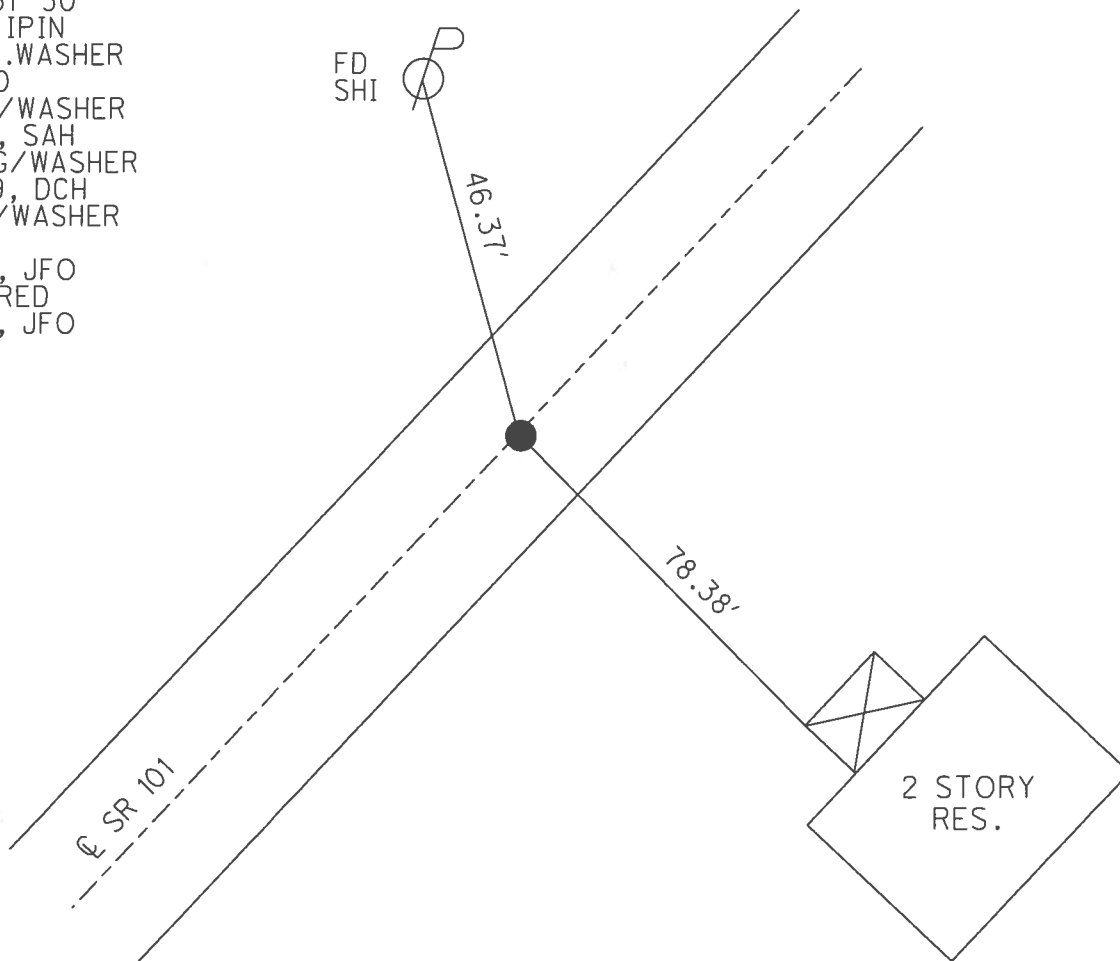


O.D.O.T. DISTRICT 2 SURVEY OFFICE (USE ONLY)


PERSONNEL _____ REFERENCE NO. 37 SHEET 14 OF 46
 NOTES _____ DATE 7/14/09 ROUTE SR 101
 H.C. HOMAN WEATHER SUNNY COUNTY SENECA
 R.C. ROUSOS TEMP. 85° TOWNSHIP ADAMS
 _____ SECTION 30
 _____ T 3 N R 16 E

TYPE MONUMENT P.K./WASHER
 ON SURFACE - ~~BELOW~~ ON
 LEFT - C PAV'T - RIGHT ON
 _____ TO _____ EDGE PAVEMENT
 S.L.M. 445+55

GRID: NORTHING: 556870.068 EASTING: 1811808.699

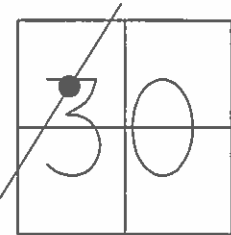

RECORD: P.I.
 STA. 447+43.01
 $\Delta = 1^{\circ} 31' 30''$
 FD 1/2" IPIN
 SET P.K.WASHER
 8/27/90
 FD P.K./WASHER
 2/4/05, SAH
 SET MAG/WASHER
 10/8/09, DCH

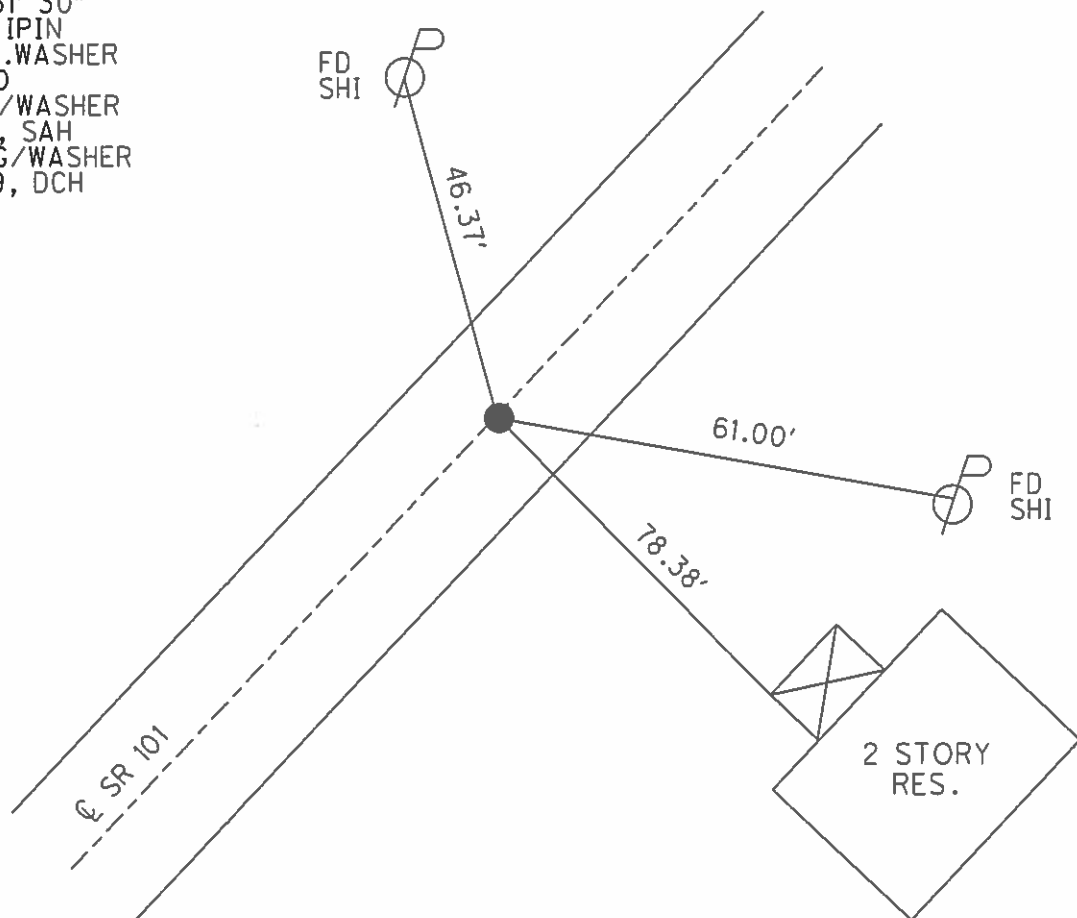

O.D.O.T. DISTRICT 2 SURVEY OFFICE

PERSONNEL

REFERENCE NO. 37

SHEET 11 OF 41

NOTES RIPPLE

H.C. BARBOUR

R.C. GEYMAN

DATE 8/27/90

WEATHER SUNNY

TEMP. 92°

ROUTE SR.#101


COUNTY SENECA

TOWNSHIP ADAMS

SECTION 30

T3 N R 16 E

TYPE MONUMENT SET P.K. & WASHER
ON SURFACE - BELOW 1/2" IRON PIN ON & R/W
LEFT-& PAV'T. - RIGHT & PAV'T.
____ TO ____ EDGE PAVEMENT
S.L.M. _____

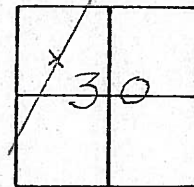

445+55

P.I. 447+43.01
 $\Delta = 1^{\circ} 31' 30''$ RT.

SW Cor.
CONC. HDWL.

2 STORY
Res.

Fd
2-4-05
SATT

& R/W SR #101

O.D.O.T. DISTRICT 2 SURVEY OFFICE

PERSONNEL

REFERENCE NO. 37

SHEET 11 OF 41

NOTES Ripple

H.C. BARBOUR

R.C. Geyman

DATE 8/27/90

WEATHER SUNNY

TEMP. 92°

ROUTE SR.#101


COUNTY Seneca

TOWNSHIP Adams

SECTION 30

T3 N R 16 E

TYPE MONUMENT Set P.K. & Washer
 ON SURFACE - BELOW 1/2" IRON PIN ON & R/W
 LEFT- & PAV'T. - RIGHT & PAV'T.
 TO EDGE PAVEMENT
 S.L.M. _____

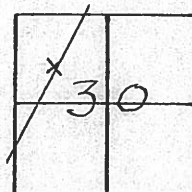


P.I. 447+43.01
 $\Delta = 1^{\circ} 31' 30''$ RT.

SW Cor.
 CONC. HDWL.


2 Story
 Res.

& R/W SR#101

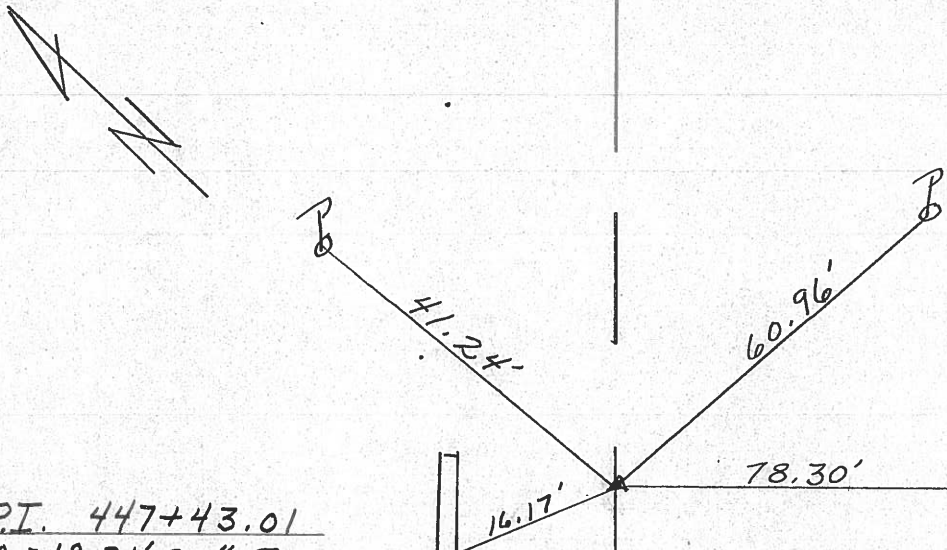

County Seneca S.R. 101Date 6-26-79Township AdamsWeather FairSection 30Temp. 75°T3N, R16EPersonnel SchneiderMosserBarbour

(37)

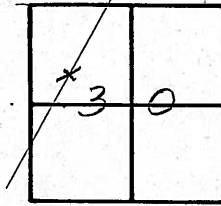


#48



P.I.

447+43.01

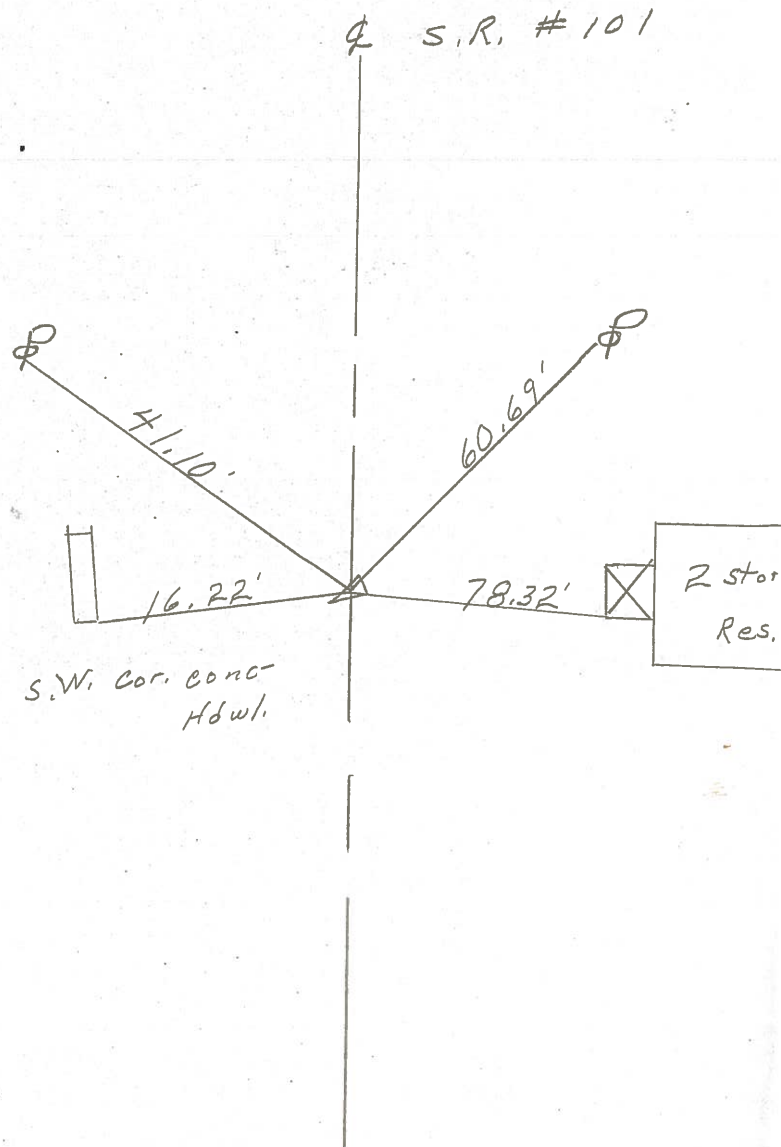 $\Delta = 1^{\circ}31'30''$ Rt. $\frac{1}{2}$ " iron pin on ϕ R/W $\frac{3}{4}$ " down

PERSONNEL TITLE PERSONNEL TITLE

Schneider

Vinson

COUNTY Seneca

DATE 9-29-71

Mosser

S. R. 101

WEATHER Hot

Barbour

SEC. Br. # 8.10

TEMP. 85°

Geyman

DESCRIPTION

Ties for Control Points

JOB NO. 02827(0)

LEFT

CENTER LINE

RIGHT

(38)

P.I.

469+42.37

small spk. on E R/W



42" Ash



34.73'

35.27'

36" Maple




30" Oak

54.94'

78.41'

30.94'

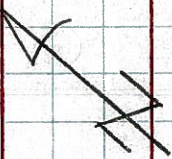

(37)

P.I.

447+43.01

Δ = 1°31'30" RT

1/2" Iron pin on E R/W
2" down

41.10'

60.69'

16.22'

78.32'

S.W. cor. conc. Hdwl.

2 story
Res.

(36)

P.O.T.

440+00


set P.K. Nail

1'x7'
conc. Hdwl.

16.37'

24.28'

52.24'

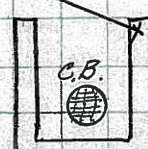Wood
fence post

PERSONNEL TITLE PERSONNEL TITLE

COUNTY Seneca DATES. R. 101 WEATHER

SEC. TEMP.

DESCRIPTION LEFT CENTER LINE RIGHT JOB NO.

(35)

184+16.5

#386

P.K. nail

2-10-64

1st step of bridge

Adams Twp

35.75'

22" Ash

41.75'

30" Elm

Pleasant Twp

60.00'

15" Ash

End of sec "k"

SEC 0 Sta 0+00 = 184+16.5 Sec k

Start of sec "0."

Adams Twp

(37)

19+77.65

#387

P.K. nail

2-10-64

Hdw

8

41.20'

61.12'

(30)

44.9'

28" Walnut

(38)

41+76.8

#388

P.K. nail

2-10-64

25" Walnut

62.1'

35.52'

22" Maple

35.8'

74.40'

70.18'

(30)