

O.D.O.T. DISTRICT 2 SURVEY OFFICE (USE ONLY)

PERSONNEL

REFERENCE NO. 39

SHEET 17 OF 46

NOTES MILLER

DATE 8/7/24

ROUTE SR 101

H.C. MILLER

WEATHER CLOUDY/WINDY

COUNTY SENECA

R.C. BARRIERE

TEMP. 70°F

TOWNSHIP ADAMS

BLUBAUGH, ASTON, PRESTON-COLVIN

SECTION 19

DWG BY BLUBAUGH

PID 114849

T 3 N R 16 E

TYPE MONUMENT MAG/WASHER

ON SURFACE - ~~BELOW~~ ON

OFFSET $\mathcal{C}$ PAVEMENT ON LT : RT

-- TO -- EDGE PAVEMENT

STATION: 494+89

HORZ.DATUM: NAD83 (2011)


GEOID: NAVD88-2018

GRID: NORTHING: 560572.335


EASTING: 1815060.100

LDP: NORTHING: 329548.246

EASTING: 189460.172

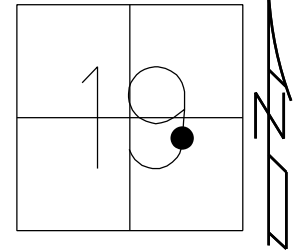

RECORD:
STA. 64+05.92
FD MINE SPIKE
SET P.K./WASHER
8/27/90, BARBOUR
FD P.K./WASHER
2/4/05, SAH
FD P.K./WASHER
REF39
7/21/09, DCH
SET MAG/WASHER
NEWREF39
10/8/09, DCH
FD MAG/WASHER
REF39
6/14/16
9/18/17, JFO
FD MAG/WASHER
REF39
12/14/23, JAM
FD TONE. DID
NOT UNCOVER
PAINTED
8/7/24, JAM

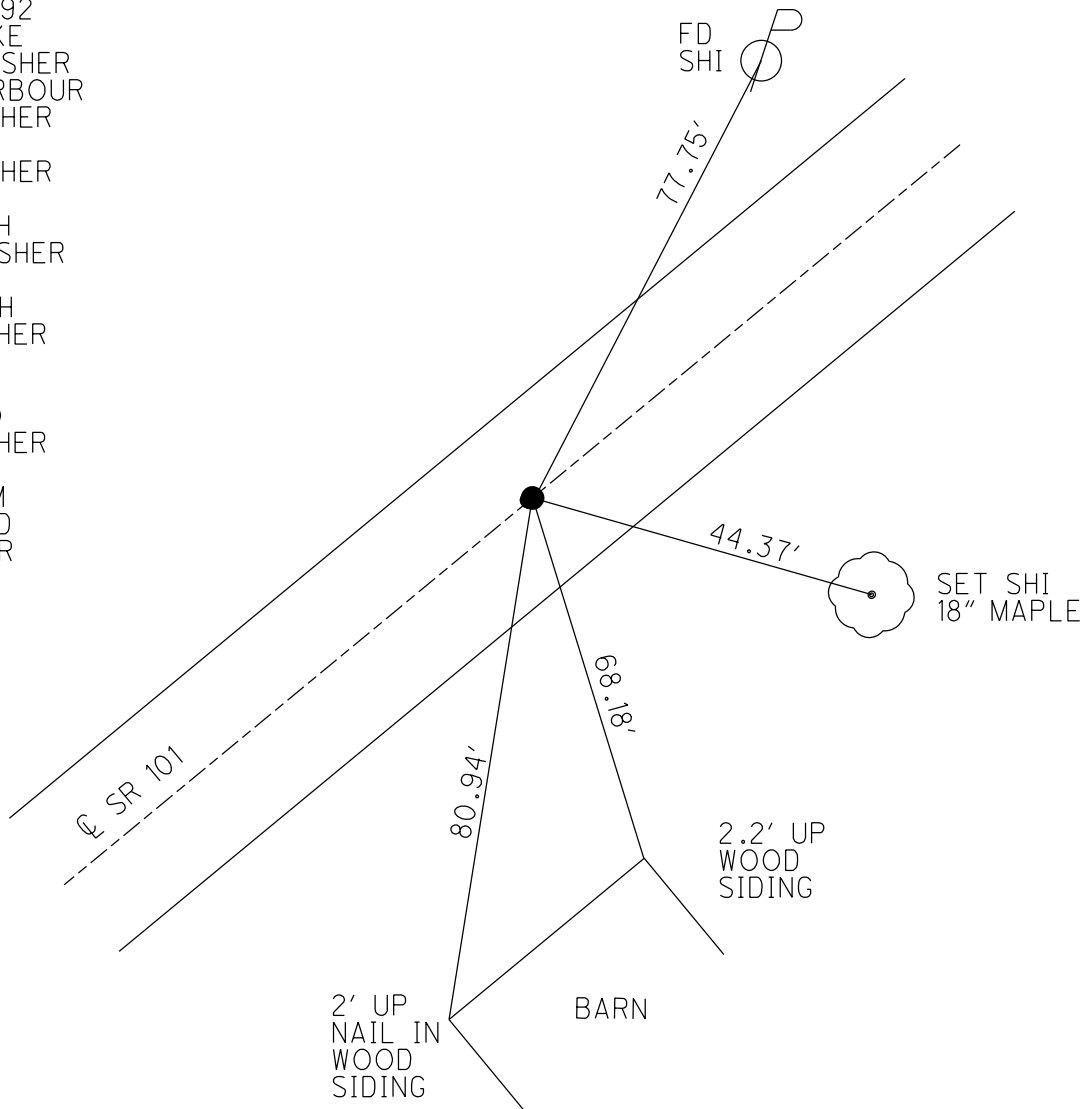

O.D.O.T. DISTRICT 2 SURVEY OFFICE (USE ONLY)

PERSONNEL

REFERENCE NO. 39

SHEET 17 OF 46

NOTES HOMAN

DATE 7-21-09

ROUTE SR 101

H.C. HOMAN

WEATHER SUNNY

COUNTY SENECA

R.C. ROUSOS

TEMP. 75°F

TOWNSHIP ADAMS

SECTION 19

DWG BY MAHLER

PID 100787

T 3 N R 16 E

TYPE MONUMENT P.K./WASHER

ON SURFACE - ~~BELOW~~ ON

OFFSET Q PAVEMENT ON LT : RT

- TO - EDGE PAVEMENT


STATION: 494+89

HORZ.DATUM: NAD83 (2011)


GEOID: NAVD88-2012A

GRID: NORTHING: 560572.335

EASTING: 1815060.100

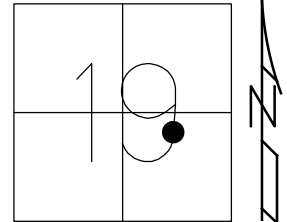

RECORD:
STA. 64+05.92
FD MINE SPIKE
SET P.K./WASHER
8/27/90, BARBOUR
FD P.K./WASHER
2/4/05, SAH
FD P.K./WASHER
REF39
7/21/09, DCH
SET MAG/WASHER
NEWREF39
10/8/09, DCH
FD MAG/WASHER
REF39
6/14/16
9/18/17, JFO

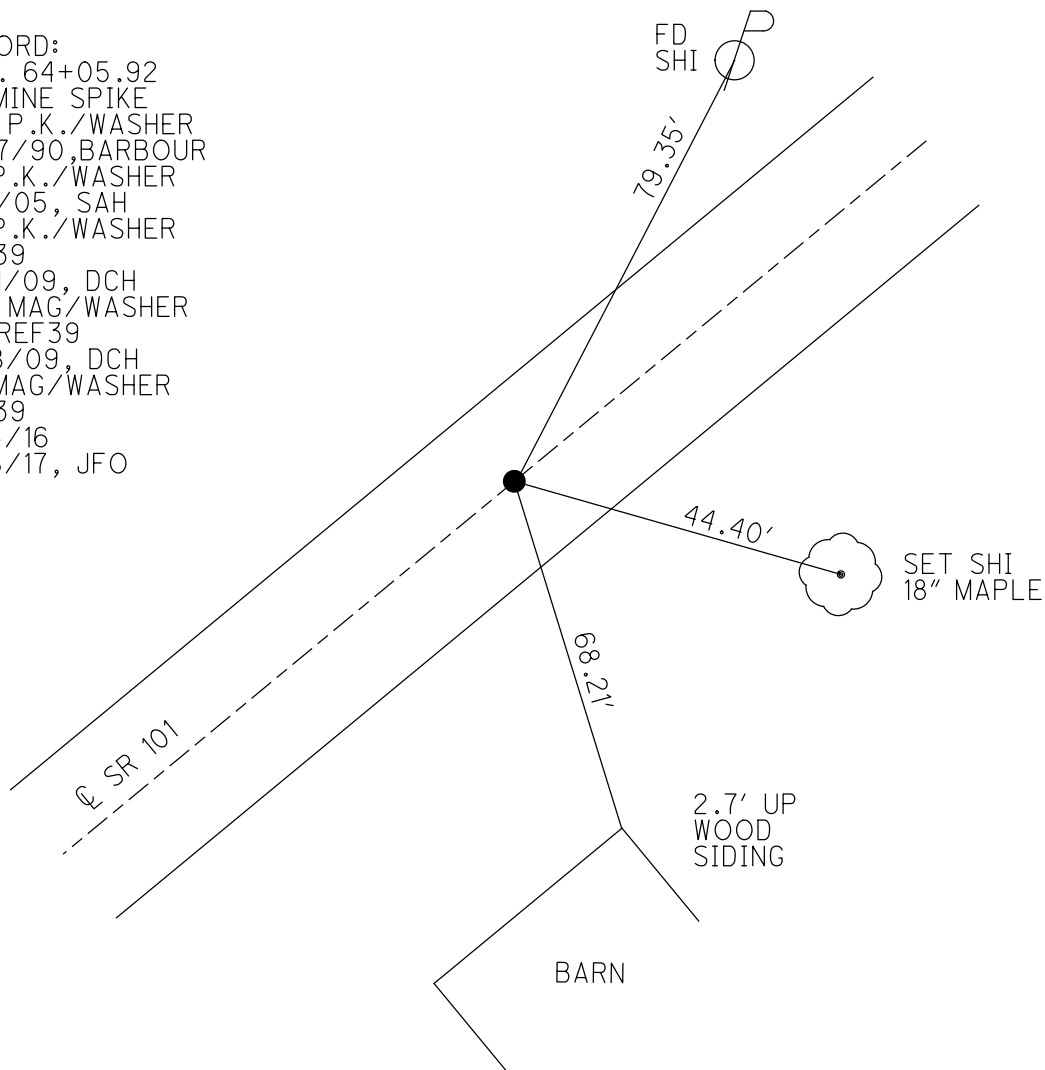


O.D.O.T. DISTRICT 2 SURVEY OFFICE (USE ONLY)


PERSONNEL	REFERENCE NO. <u>39</u>	SHEET <u>17</u> OF <u>46</u>
NOTES	DATE <u>7/21/09</u>	ROUTE <u>SR 101</u>
H.C. <u>HOMAN</u>	WEATHER <u>SUNNY</u>	COUNTY <u>SENECA</u>
R.C. <u>ROUSOS</u>	TEMP. <u>75°</u>	TOWNSHIP <u>ADAMS</u>
		SECTION <u>19</u>
		T <u>3</u> N R <u>16</u> E

TYPE MONUMENT P.K./WASHER
 ON SURFACE - ~~BELOW~~ ON
 LEFT - C PAV'T - RIGHT ON
- TO - EDGE PAVEMENT
 S.L.M. 494+89

GRID: NORTHING: 560572.335 EASTING: 1815060.100

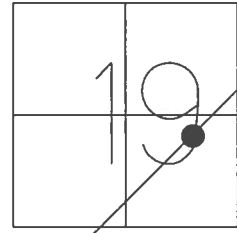

RECORD:
 STA. 64+05.92
 FD MINE SPIKE
 SET P.K./WASHER
 8/27/90
 FD P.K./WASHER
 2/4/05, SAH
 SET MAG/WASHER
 10/8/09, DCH
 FD MAG/WASHER
 REF39
 6/14/16, JFO
 UNCOVERED
 9/18/17, JFO

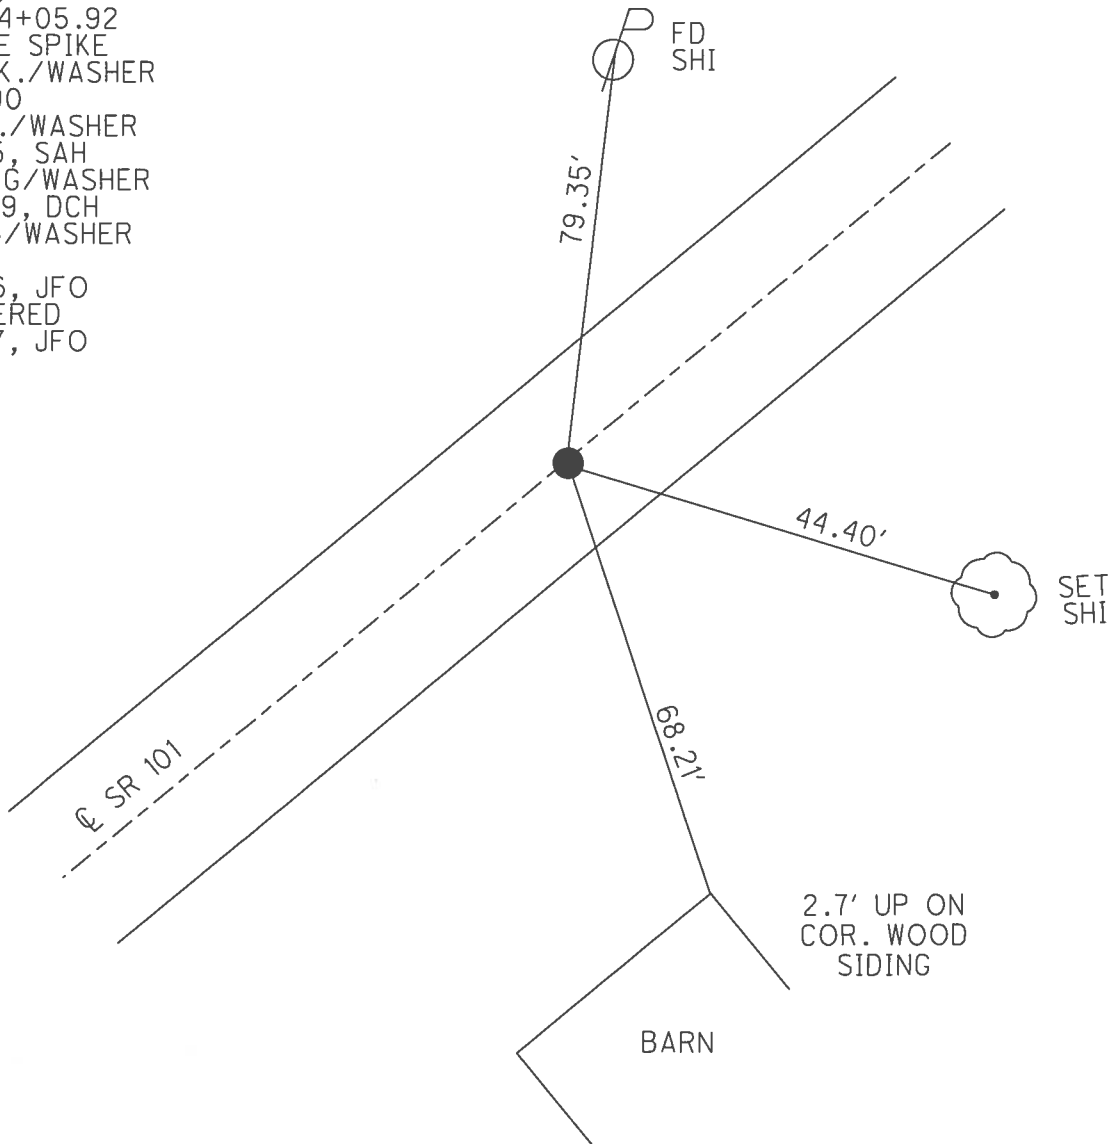


O.D.O.T. DISTRICT 2 SURVEY OFFICE (USE ONLY)


PERSONNEL _____ REFERENCE NO. 39 SHEET 17 OF 46
 NOTES HOMAN DATE 7/21/09 ROUTE SR 101
 H.C. HOMAN WEATHER SUNNY COUNTY SENECA
 R.C. ROUSOS TEMP. 75° TOWNSHIP ADAMS
 _____ SECTION 19
 _____ T 3 N R 16 E

TYPE MONUMENT P.K./WASHER
 ON SURFACE - ~~BELOW~~ ON
 LEFT - C PAV'T - RIGHT ON
 - TO - EDGE PAVEMENT
 S.L.M. 494+89

GRID: NORTHING: 560572.347 EASTING: 1815060.096

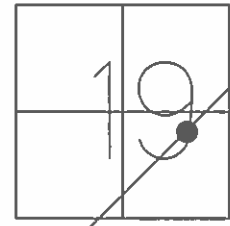

RECORD:
 STA. 64+05.92
 FD MINE SPIKE
 SET P.K./WASHER
 8/27/90
 FD P.K./WASHER
 2/4/05, SAH
 SET MAG/WASHER
 10/8/09, DCH

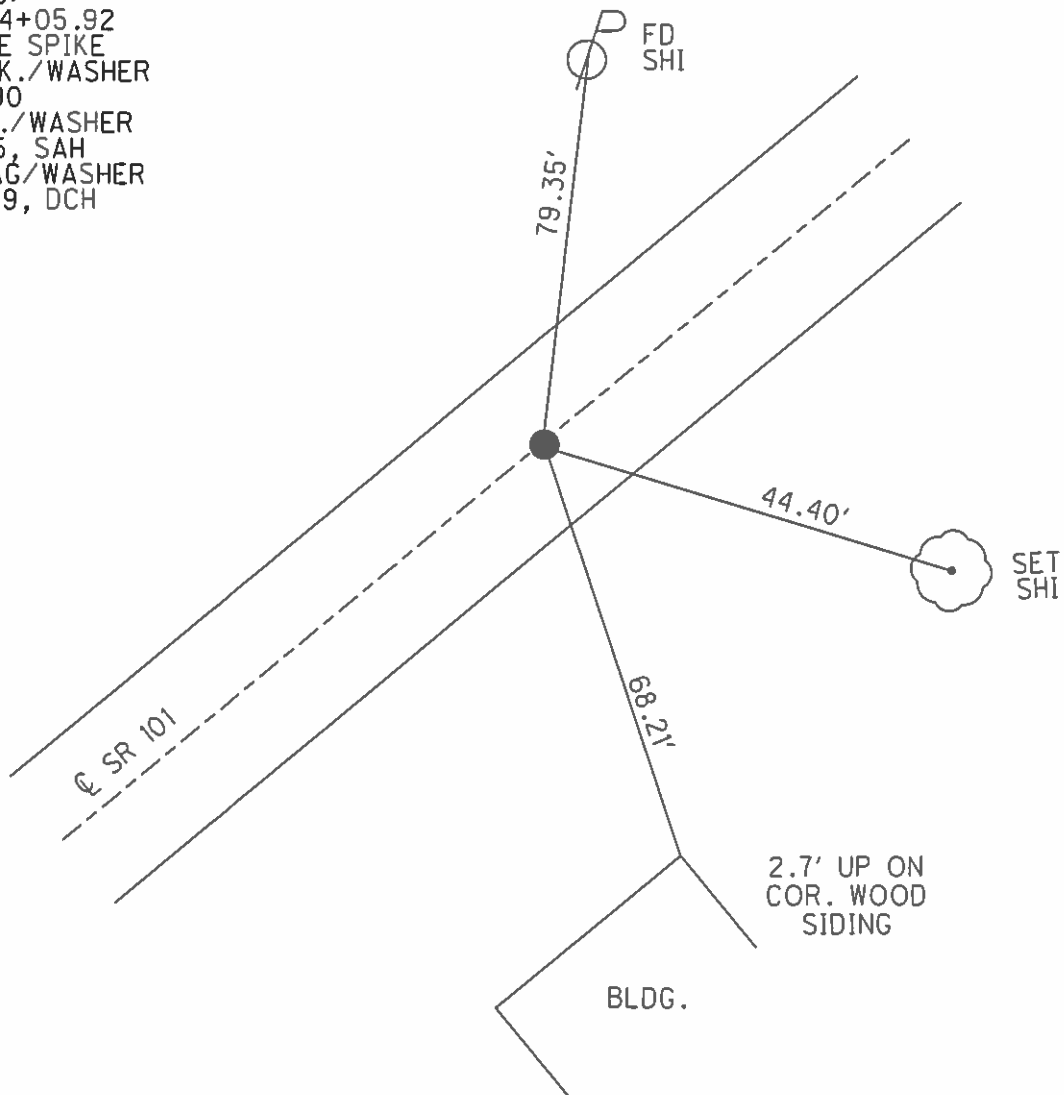

O.D.O.T. DISTRICT 2 SURVEY OFFICE

PERSONNEL

REFERENCE NO. 39

SHEET 13 OF 41

NOTES RIPPLE

H.C. BARBOUR

R.C. GEYMAN

DATE 8/27/90

WEATHER SUNNY

TEMP. 92°

ROUTE S.R. #101



COUNTY SENECA

TOWNSHIP ADAMS

SECTION 19

T 3 N R 16 E

TYPE MONUMENT Set P.K. & washer
 ON SURFACE - BELOW mine spike on & R/W
 LEFT - & Pav't. - RIGHT & Pav't.
TO EDGE PAVEMENT
 S.L.M.

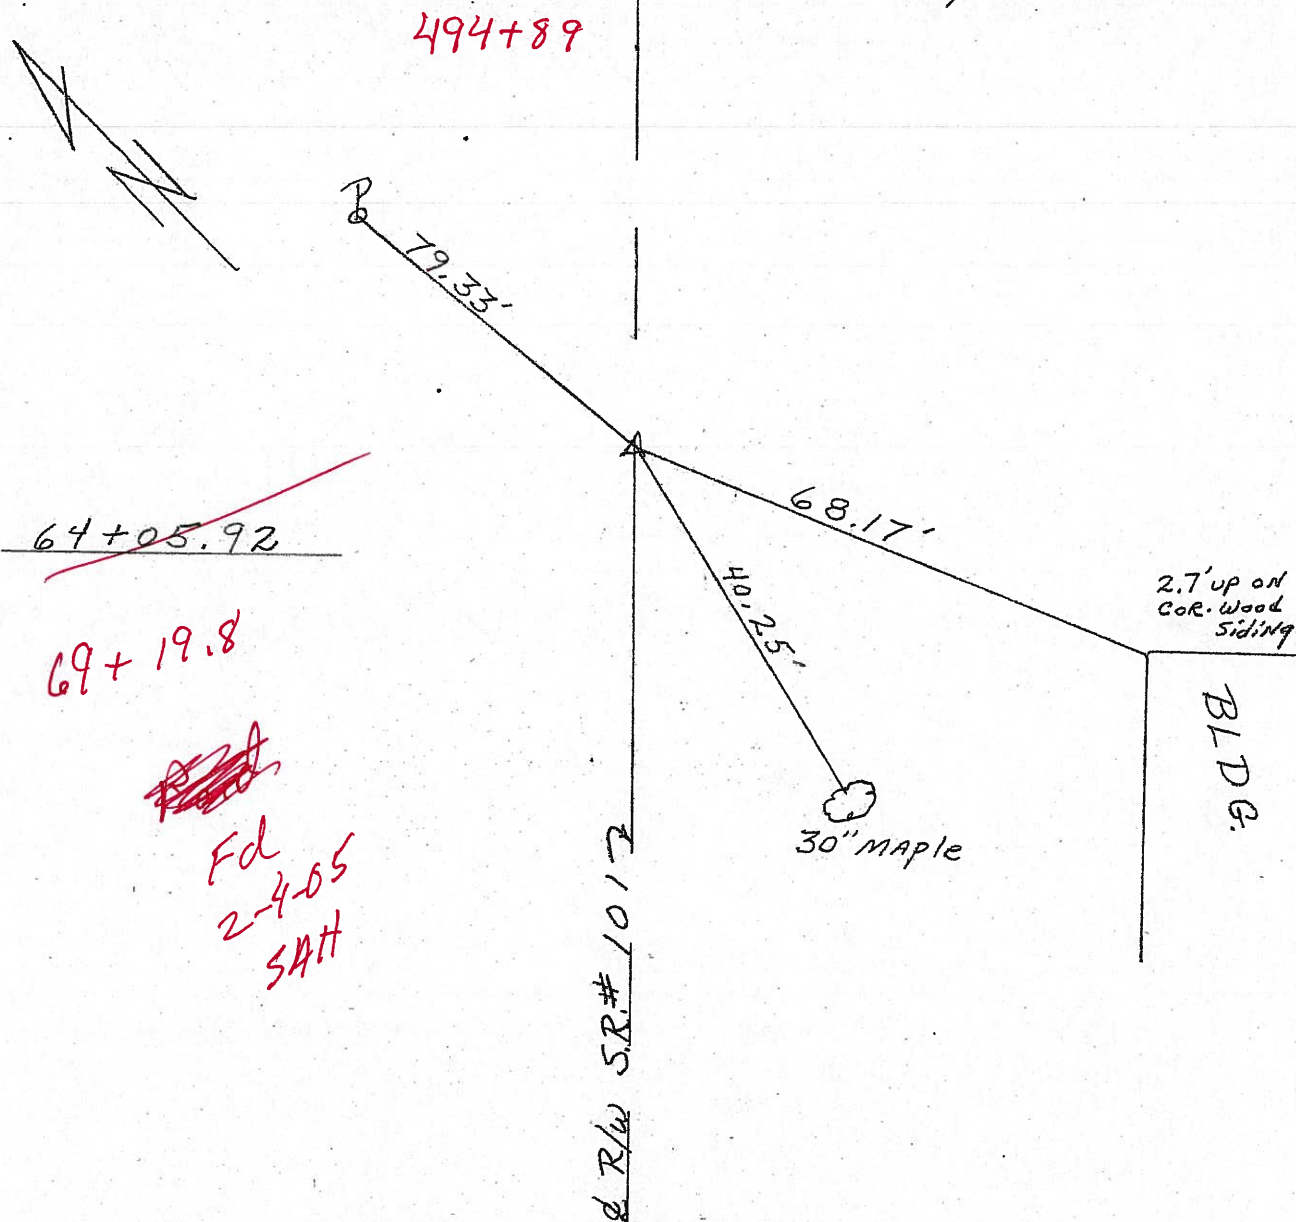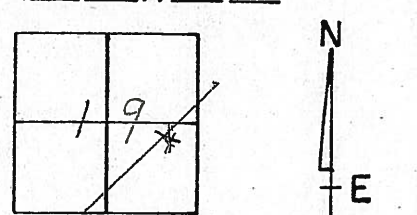

O.D.O.T. DISTRICT 2 SURVEY OFFICE

PERSONNEL

REFERENCE NO. 39

SHEET 13 OF 41

NOTES RIPPLE

H.C. BARBOUR

R.C. GEYMAN

DATE 8/27/90

WEATHER SUNNY

TEMP. 92°

ROUTE S.R. #101


COUNTY SENECA

TOWNSHIP ADAMS

SECTION 19

T 3 N R 16 E

TYPE MONUMENT Set P.K. & washer
ON SURFACE - BELOW mine spike on & R/W
LEFT - & Pav't. - RIGHT & Pav't.
TO EDGE PAVEMENT
S.L.M.

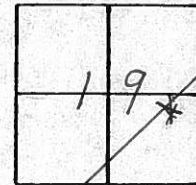

64+05.92

79.33'



68.17'

40.25'

30" MAPLE

2.7' up on
cor. wood
siding

BLDG.

& R/W S.R. #101


Q.D.O.T. DISTRICT 2 SURVEY OFFICE

Sht. of


County Seneca S.R. 101
Township Adams
Section 19
T 3 N, R 16 E
Personnel Schneider
Mosser
Barbour

Date 6-25-79
Weather Fair
Temp. 60°

(39)

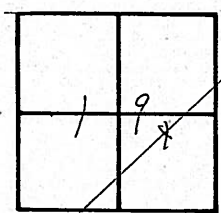

64+05.92
Mine spk. on $\frac{1}{2}$ R/w
on top
Reset P.K. Nail

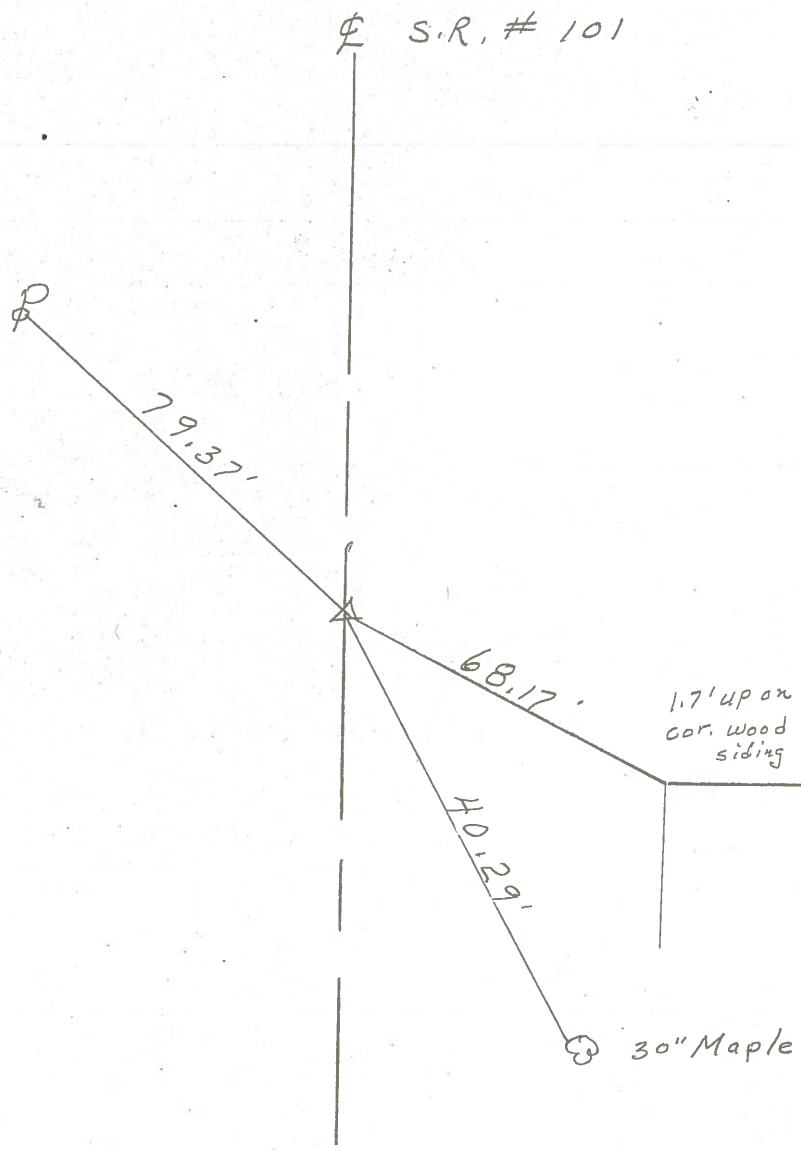

PERSONNEL	TITLE	PERSONNEL	TITLE
Krabill			
Kowaleski			
Geyman			
Bruggeman			

COUNTY Seneca DATE 2-10-64S. R. # 101 WEATHER

SEC. TEMP.

DESCRIPTION LEFT CENTER LINE RIGHT JOB NO.

(39)

STA. 69+04.92

P.K.

389

End of Sec. O

Start of Sec. J

Adams Twp

28.08' 12" Maple

45.10'

40.42'

12' Hickory

30" Maple

5440'
 S.R. # 378
 C. B.
 5440'
 Sec. Line

49.16' 11" Maple

69.62'

49.90'

Walnut

House
Car. Porch

(40)

STA. 0+00

P.K.

389A

Res.

27.12'

20.30'

Locust

22.44'

80.85'

11" Maple

Howe

(41)

STA. 1+00

R.R. Spiko

390