

O.D.O.T. DISTRICT 2 SURVEY OFFICE (USE ONLY)

PERSONNEL

REFERENCE NO. 40

SHEET 18 OF 46

NOTES MILLER

DATE 8/7/24

ROUTE SR 101

H.C. MILLER

WEATHER CLOUDY/WINDY

COUNTY SENECA

R.C. BARRIERE

TEMP. 70°F

TOWNSHIP ADAMS

BLUBAUGH, ASTON, PRESTON-COLVIN

SECTION 19

DWG BY BLUBAUGH

PID 114849

T 3 N R 16 E

TYPE MONUMENT MAG/WASHER

~~ON SURFACE~~ - BELOW 0.5"

OFFSET $\odot$ PAVEMENT ON LT : RT

-- TO -- EDGE PAVEMENT

STATION: 509+76

HORZ.DATUM: NAD83 (2011)


GEOID: NAVD88-2018

GRID: NORTHING: 561671.714


EASTING: 1816059.780

LDP: NORTHING: 330655.180

EASTING: 190451.695

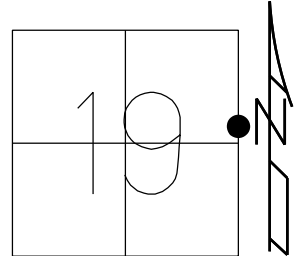

RECORD:
STA. 0+00
FD P.K./WASHER
ATOP IPIN
SET P.K./WASHER
8/27/90
FD P.K./WASHER
2/4/05, SAH
FD IPIN
1 1/2" DOWN
REF40
7/21/09, DCH
SET MAG/WASHER
NEWREF40
10/8/09, DCH
FD MAG/WASHER
REF40
6/14/16
9/18/17, JFO
FD MAG/WASHER
REF40
9/12/19
8/2/21,
6/6/22, DSA
FD MAG/WASHER
REF40
12/14/24, JAM
FD TONE. DID NOT
UNCOVER. PAINTED
8/7/24, JAM

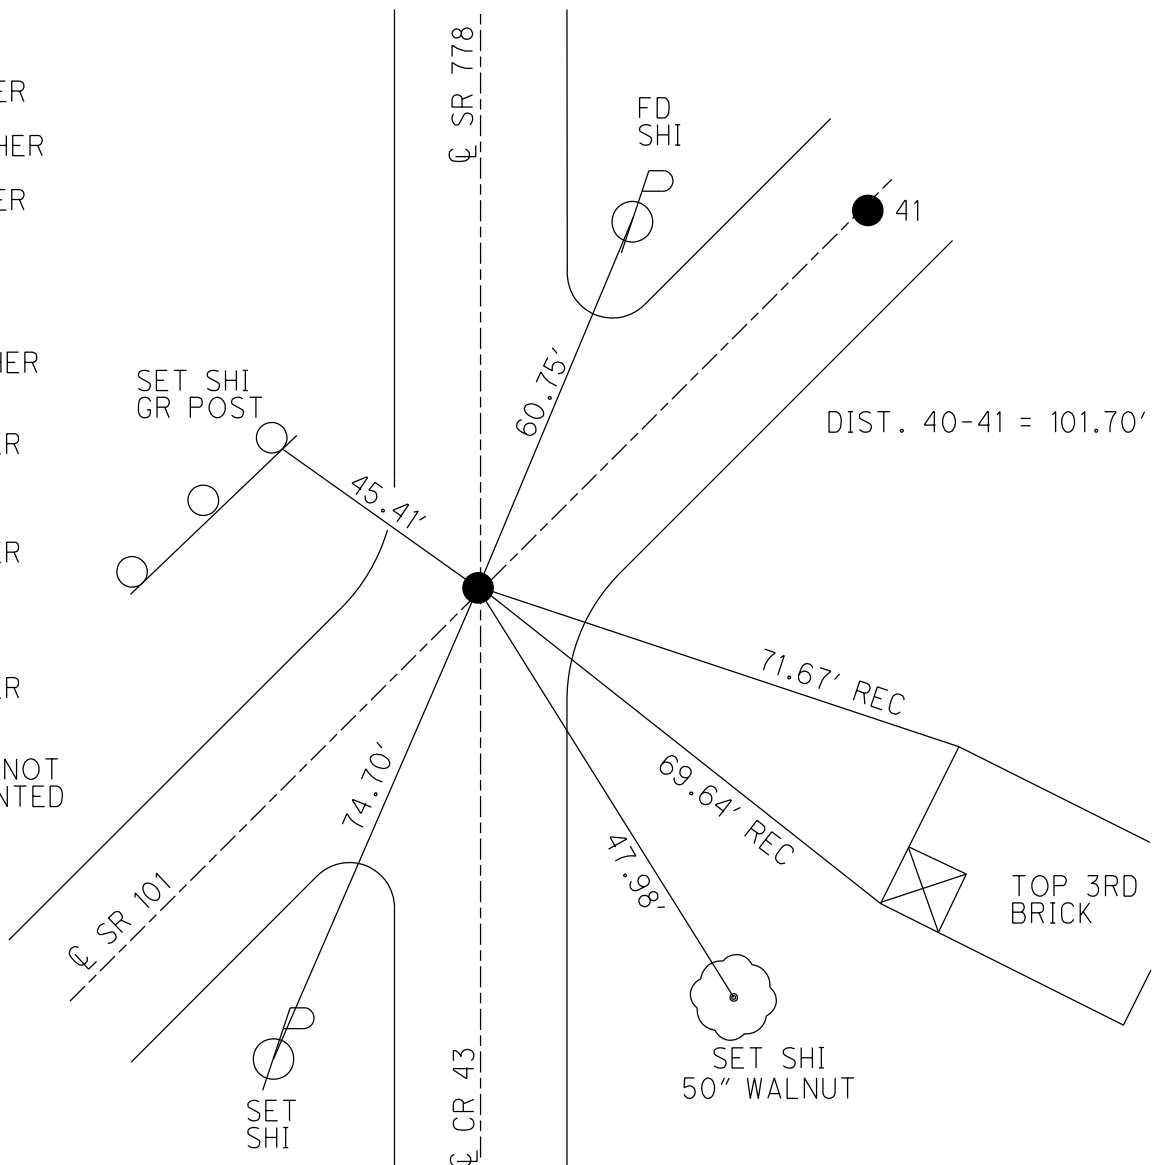

O.D.O.T. DISTRICT 2 SURVEY OFFICE (USE ONLY)

PERSONNEL

REFERENCE NO. 40

SHEET 18 OF 46

NOTES HOMAN

DATE 7-21-09

ROUTE SR 101

H.C. HOMAN

WEATHER SUNNY

COUNTY SENECA

R.C. ROUSOS

TEMP. 80°F

TOWNSHIP ADAMS

SECTION 19

DWG BY WHITAKER PID 101165

T 3 N R 16 E

TYPE MONUMENT IPIN

~~ON SURFACE~~ - BELOW 1 1/2"

OFFSET Q PAVEMENT ON LT : RT

- TO - EDGE PAVEMENT


STATION: 509+76

HORIZ.DATUM: NAD83 (2011)


GEOID: NAVD88-2012A

GRID: NORTHING: 561671.714

EASTING: 1816059.780

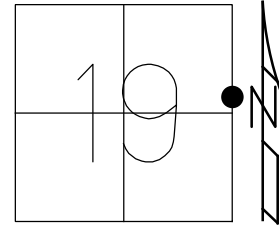

RECORD:
STA. 0+00
FD P.K./WASHER
ATOP IPIN
SET P.K./WASHER
8/27/90
FD P.K./WASHER
2/4/05, SAH
FD IPIN
1 1/2" DOWN
REF40
7/21/09, DCH
SET MAG/WASHER
NEWREF40
10/8/09, DCH
FD MAG/WASHER
REF40
6/14/16
9/18/17, JFO
FD MAG/WASHER
REF40
9/12/19
8/2/21,
6/6/22, DSA

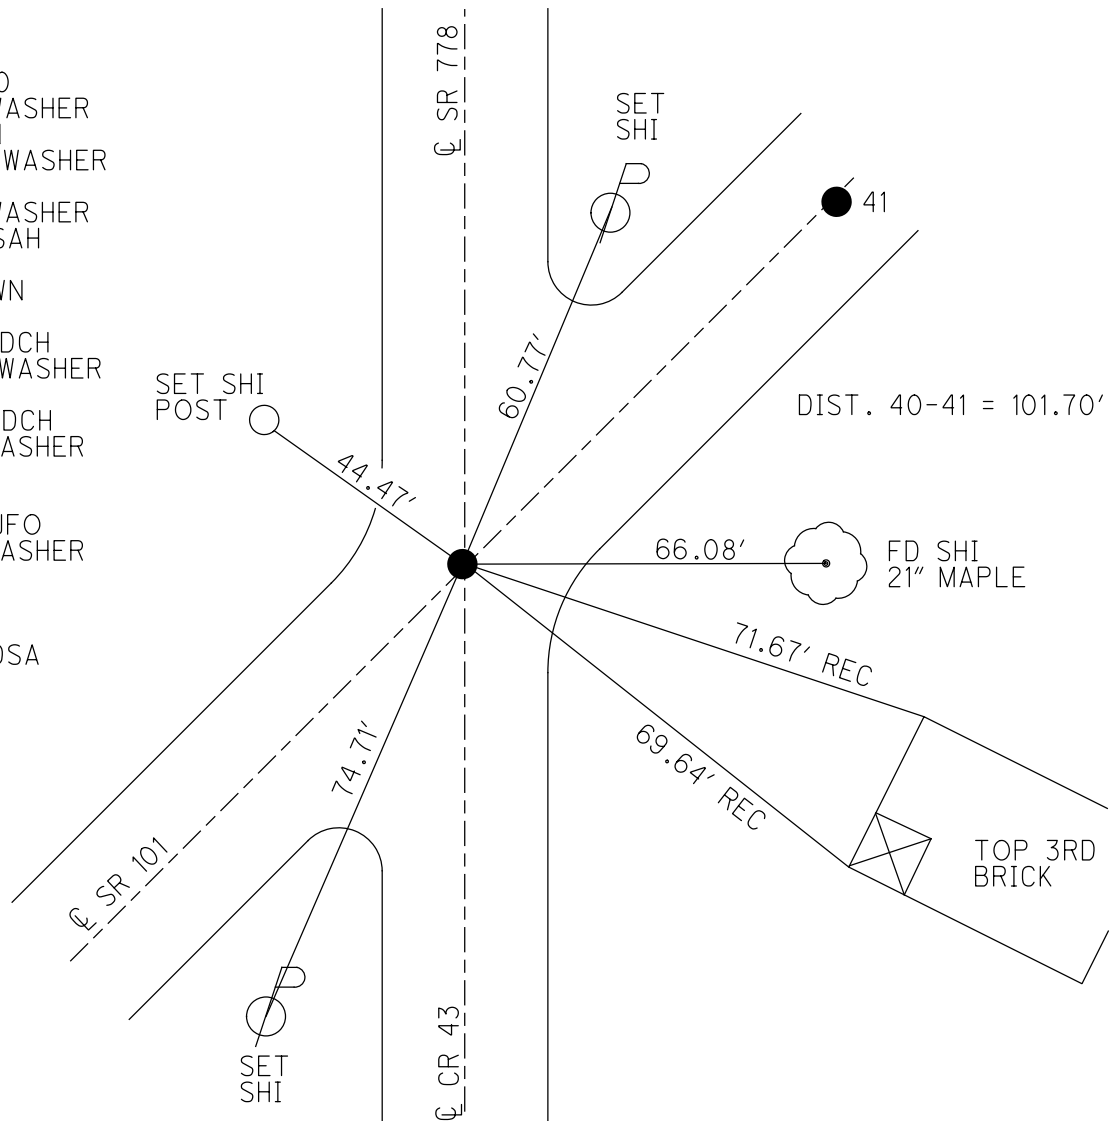

O.D.O.T. DISTRICT 2 SURVEY OFFICE (USE ONLY)

PERSONNEL

REFERENCE NO. 40

SHEET 18 OF 46

NOTES HOMAN

DATE 7-21-09

ROUTE SR 101

H.C. HOMAN

WEATHER SUNNY

COUNTY SENECA

R.C. ROUSOS

TEMP. 80°F

TOWNSHIP ADAMS

SECTION 19

DWG BY MAHLER

PID 100787

T 3 N R 16 E

TYPE MONUMENT IPIN

~~ON SURFACE~~ - BELOW 1 1/2"

OFFSET Q PAVEMENT ON LT : RT

- TO - EDGE PAVEMENT


STATION: 509+76

HORZ. DATUM: NAD83 (2011)


GEOID: NAVD88-2012A

GRID: NORTHING: 561671.718

EASTING: 1816059.766

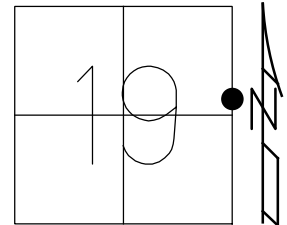

RECORD:
STA. 0+00
FD P.K./WASHER
ATOP IPIN
SET P.K./WASHER
8/27/90
FD P.K./WASHER
2/4/05, SAH
FD IPIN
1 1/2" DOWN
REF40
7/21/09, DCH
SET MAG/WASHER
NEWREF40
10/8/09, DCH
FD MAG/WASHER
REF40
6/14/16
9/18/17, JFO

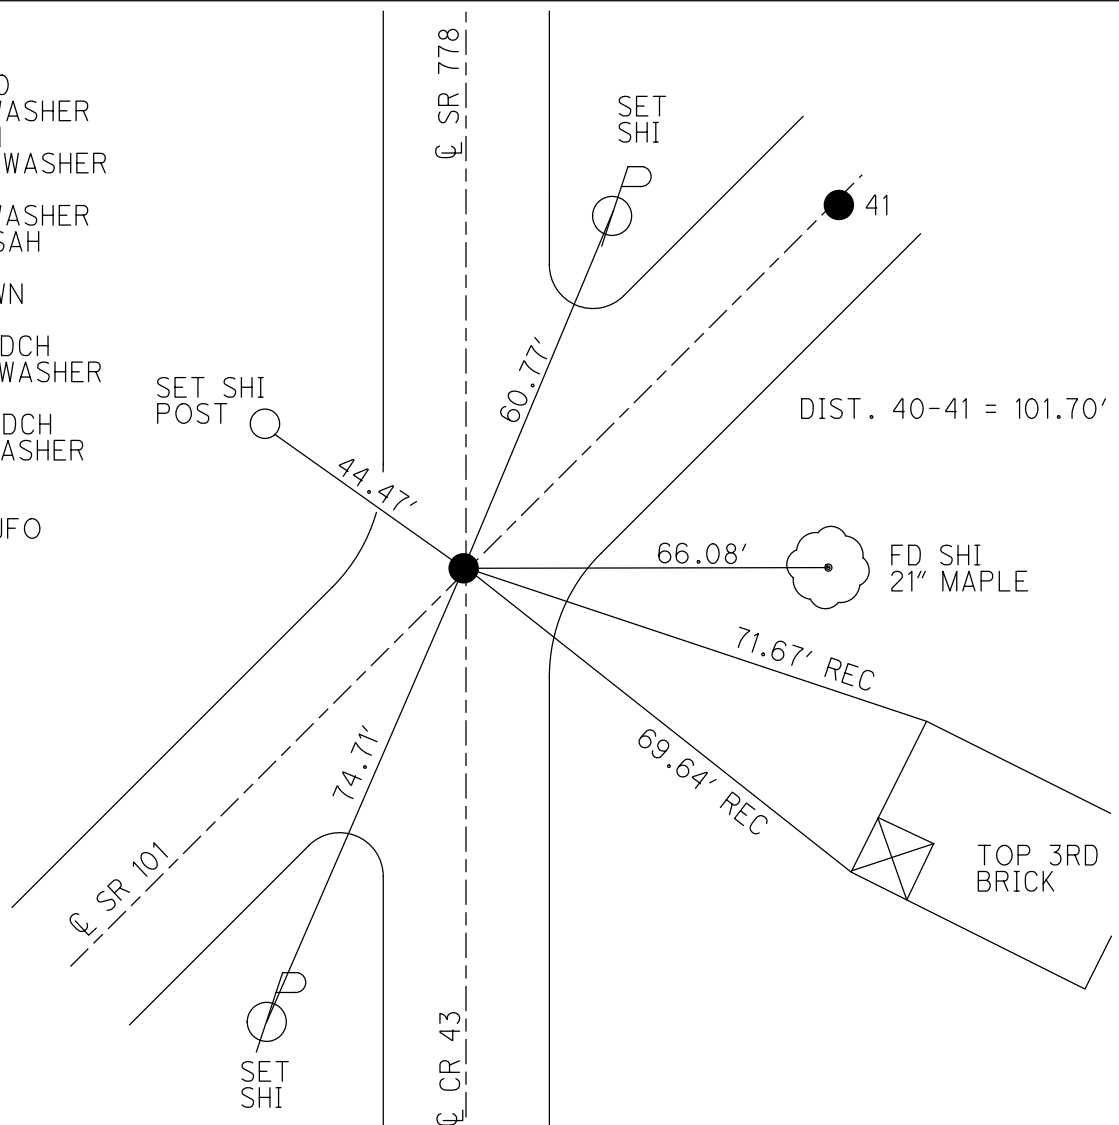


O.D.O.T. DISTRICT 2 SURVEY OFFICE (USE ONLY)


PERSONNEL	REFERENCE NO. <u>40</u>	SHEET <u>18</u> OF <u>46</u>	
NOTES	HOMAN	DATE <u>7/21/09</u>	ROUTE <u>SR 101</u>
H.C.	HOMAN	WEATHER <u>SUNNY</u>	COUNTY <u>SENECA</u>
R.C.	ROUSOS	TEMP. <u>80°</u>	TOWNSHIP <u>ADAMS</u>
			SECTION <u>19</u>
			T <u>3</u> N R <u>16</u> E

TYPE MONUMENT IPIN
~~ON SURFACE~~ - BELOW 1 1/2"
 LEFT - ℄ PAV'T - RIGHT ON
- TO - EDGE PAVEMENT
 S.L.M. 509+76

GRID: NORTHING: 561671.718 EASTING: 1816059.766

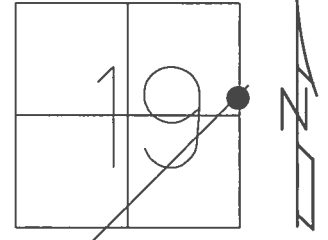

RECORD:
 STA. 0+00
 FD P.K./WASHER
 ATOP IPIN
 SET P.K./WASHER
 8/27/90
 FD P.K./WASHER
 2/4/05, SAH
 SET MAG/WASHER
 10/8/09, DCH
 FD MAG/WASHER
 REF40
 6/14/16, JFO
 UNCOVERED
 9/18/17, JFO

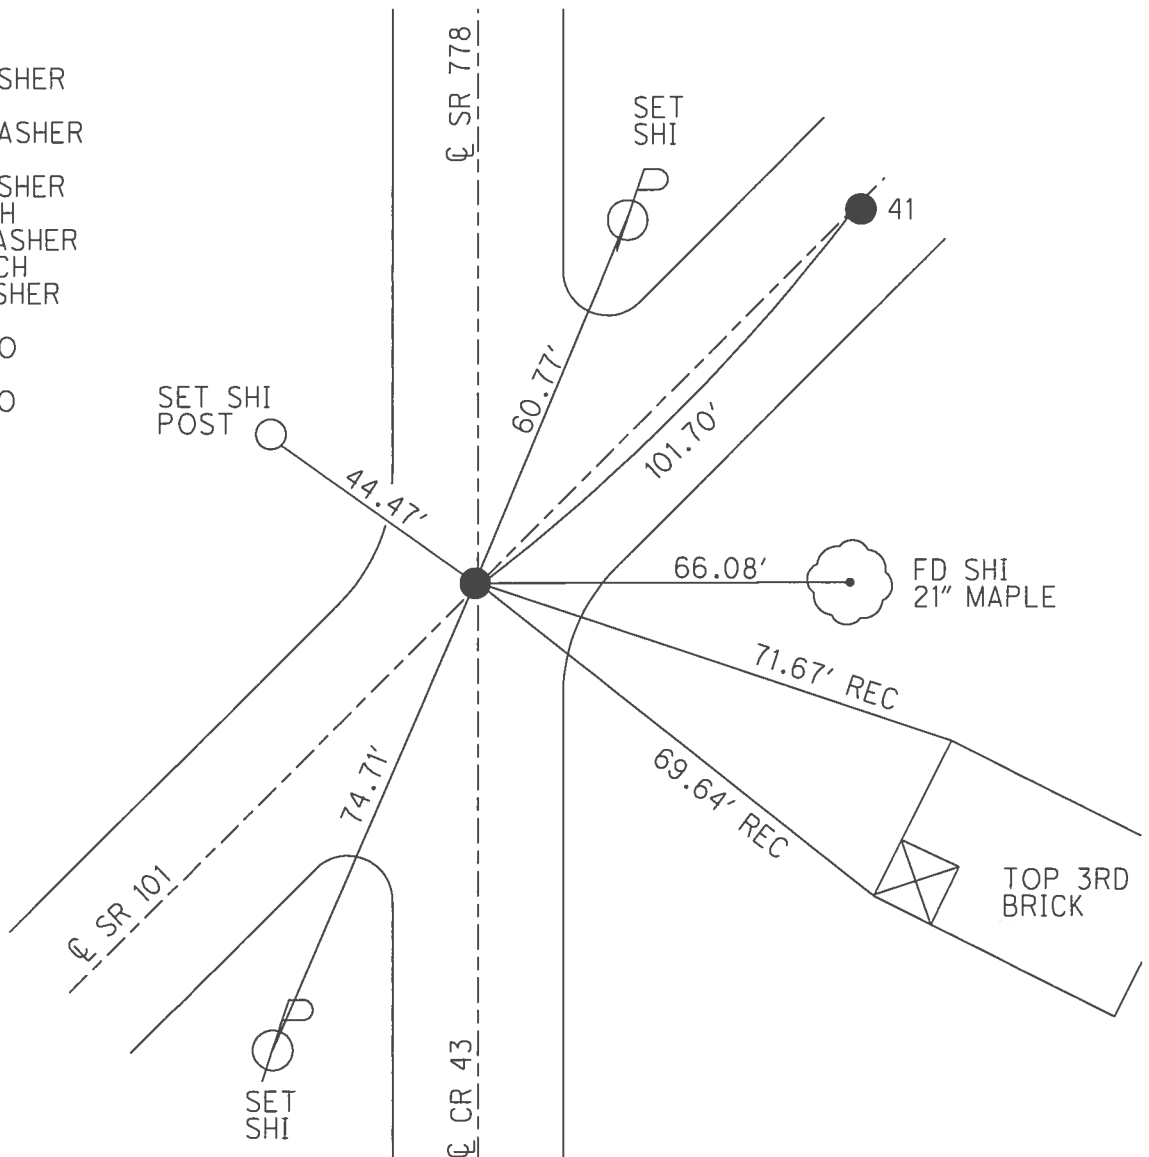


O.D.O.T. DISTRICT 2 SURVEY OFFICE (USE ONLY)


PERSONNEL _____ REFERENCE NO. 40 SHEET 18 OF 46
 NOTES HOMAN DATE 7/21/09 ROUTE SR 101
 H.C. HOMAN WEATHER SUNNY COUNTY SENECA
 R.C. ROUSOS TEMP. 80° TOWNSHIP ADAMS
 SECTION 19
 T 3 N R 16 E

TYPE MONUMENT IPIN
~~ON SURFACE~~ - BELOW 1 1/2"
 LEFT - Q PAV'T - RIGHT ON
- TO - EDGE PAVEMENT
 S.L.M. 509+76

GRID: NORTHING: 561671.763 EASTING: 1816059.709

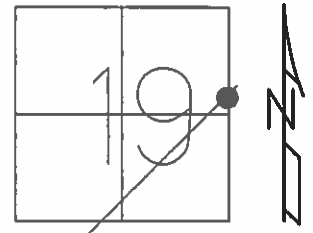

RECORD:
 STA. 0+00
 FD P.K./WASHER
 ATOP IPIN
 SET P.K./WASHER
 8/27/90
 FD P.K./WASHER
 2/4/05, SAH
 SET MAG/WASHER
 10/8/09, DCH

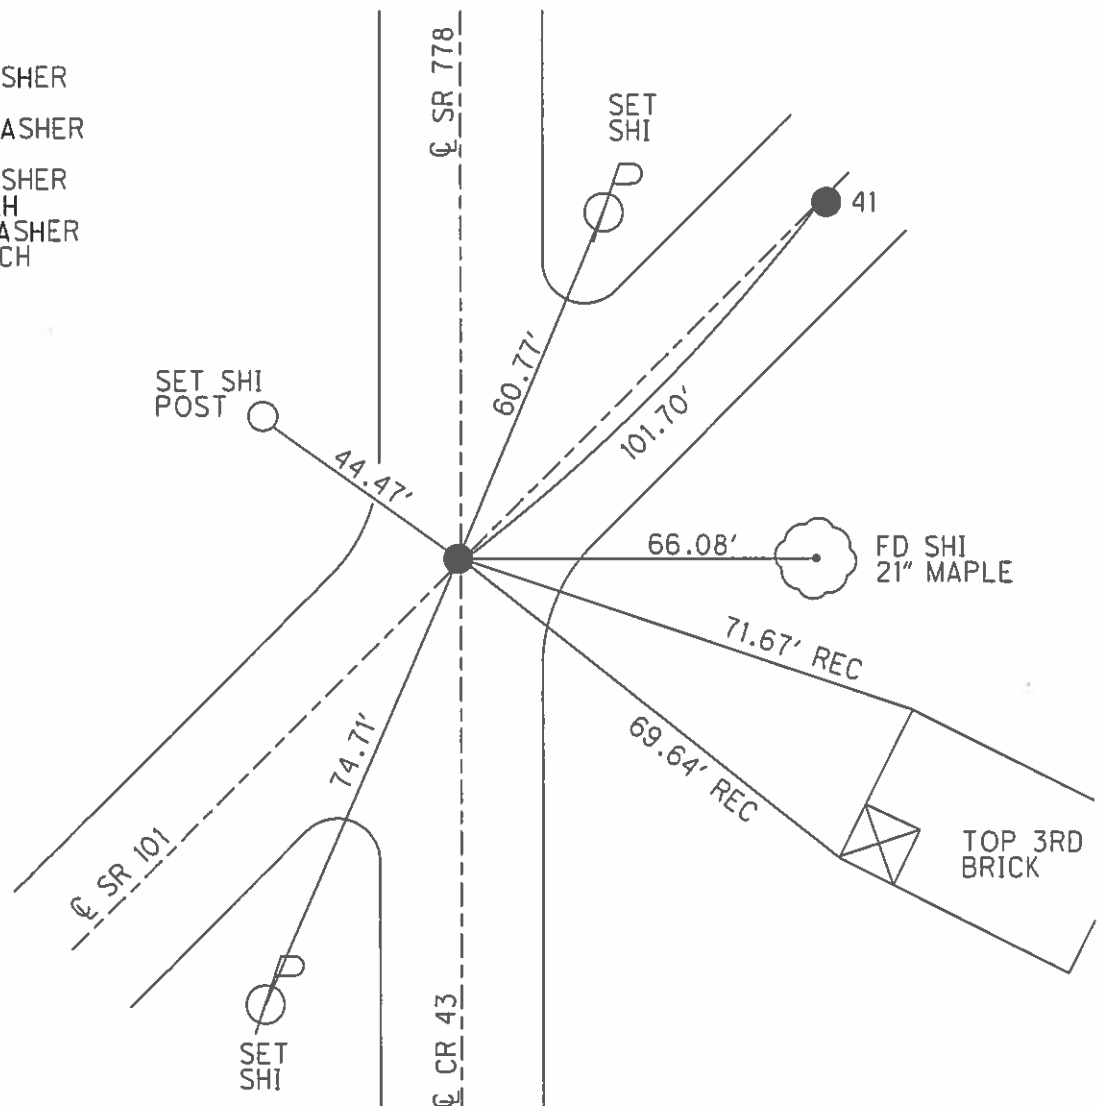

O.D.O.T. DISTRICT 2 SURVEY OFFICE

PERSONNEL

REFERENCE NO. 40

SHEET 14 OF 41

NOTES RIPPLE

H.C. BARBOUR

R.C. GEYMAN

DATE 8/27/90

WEATHER SUNNY

TEMP. 92°

ROUTE SR# 101



COUNTY SENECA

TOWNSHIP ADAMS

SECTION 19

T3 N R 16 E

TYPE MONUMENT SET P.K. & WASHER
ON SURFACE - BELOW P.K. & WASHER A TOP IRON PIN
LEFT - CL PAV'T. - RIGHT CL PAV'T.
TO EDGE PAVEMENT
S.L.M. _____

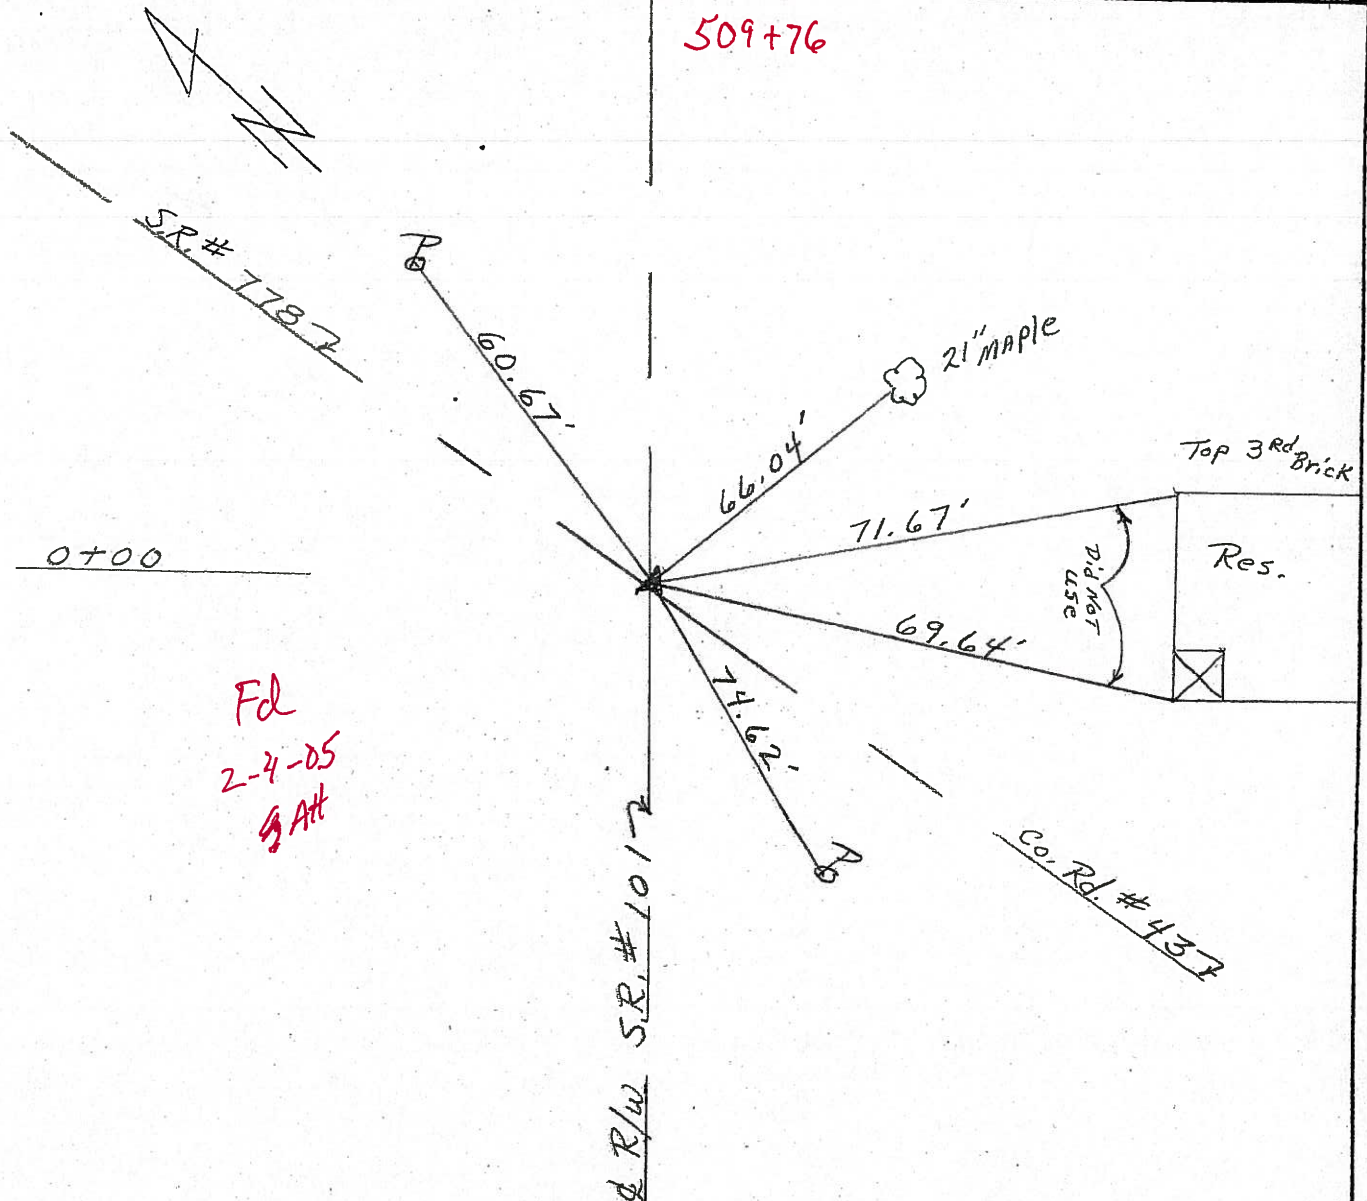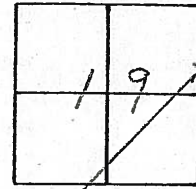

O.D.O.T. DISTRICT 2 SURVEY OFFICE

PERSONNEL

REFERENCE NO. 40

SHEET 14 OF 41

NOTES Ripple

H.C. BARBOUR

R.C. GEYMAN

DATE 8/27/90

WEATHER SUNNY

TEMP. 92°

ROUTE SR# 101

COUNTY Seneca

TOWNSHIP ADAMS

SECTION 19

T 3 N R 16 E



TYPE MONUMENT Set P.K. & Washer

ON SURFACE - BELOW P.K. & Washer A Tap IRON PIN

LEFT - ℄ PAV'T. - RIGHT ℄ PAV'T.

TO EDGE PAVEMENT

S.L.M.

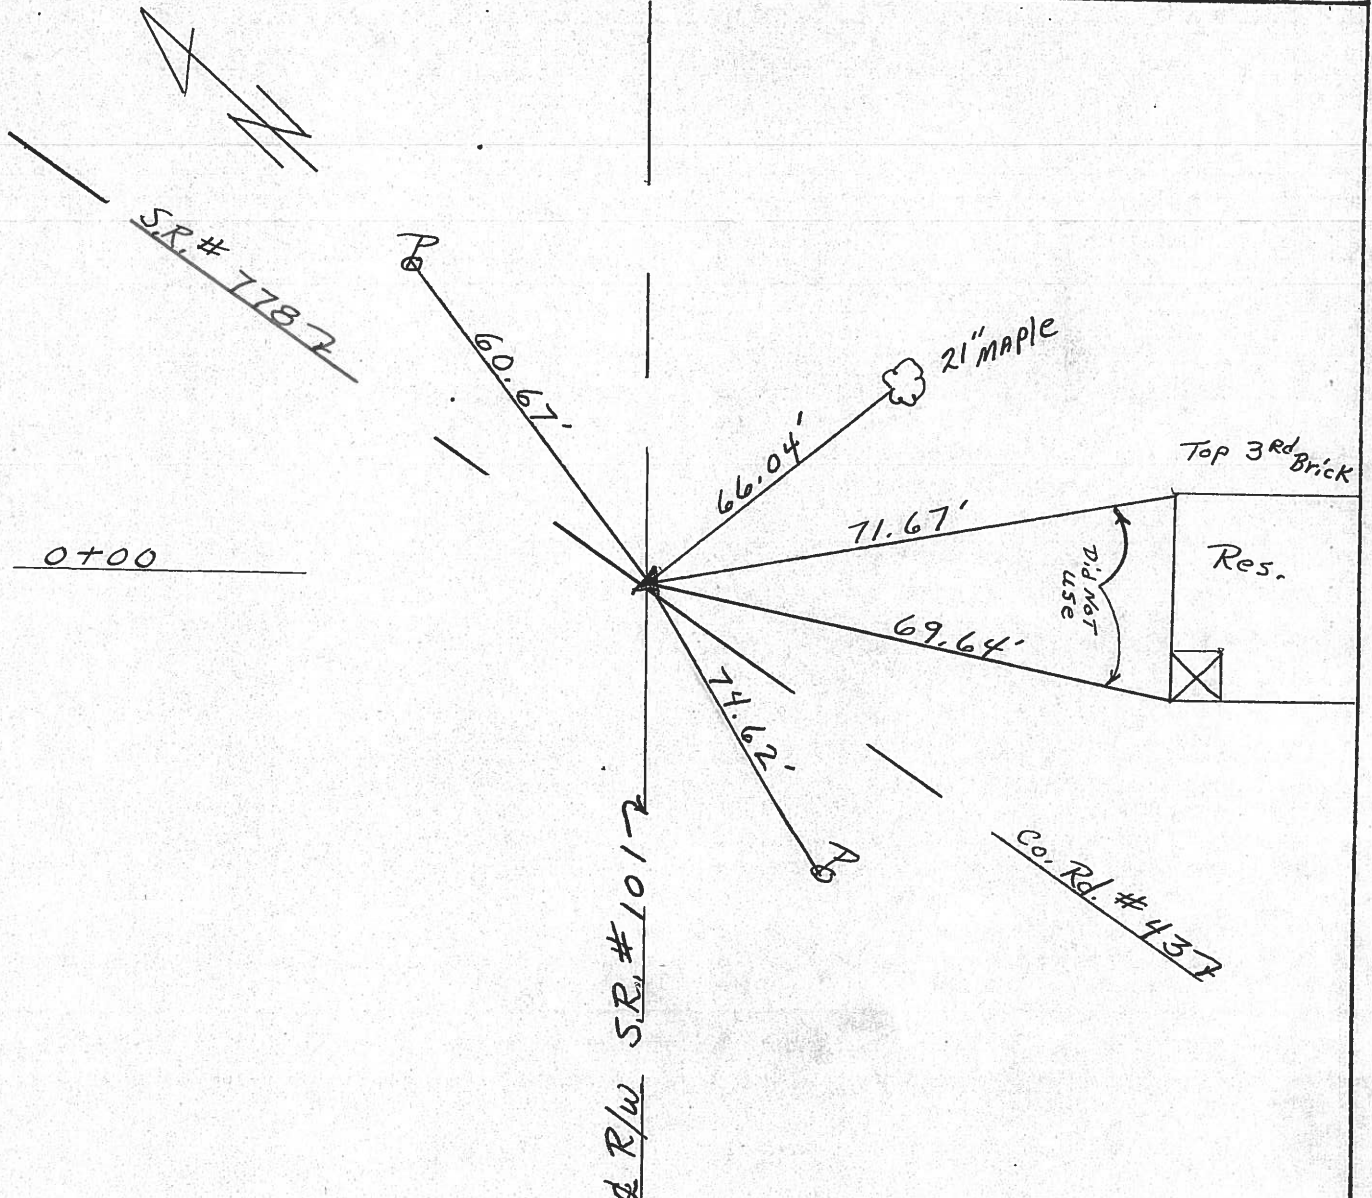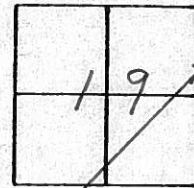

County Seneca S.R. # 101

Township Adams

Section 19

T 3 N, R 16 E

Personnel Schneider

Mosser


Barbour

Date 6-26-79


Weather Fair

Temp. 68°

(40)

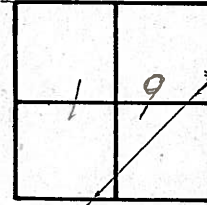

~~#40~~

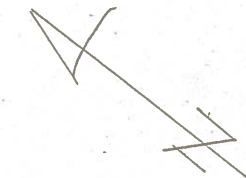


0+00

Iron Pin on $\perp$ R/W

2" down

Reset P. K. Nail

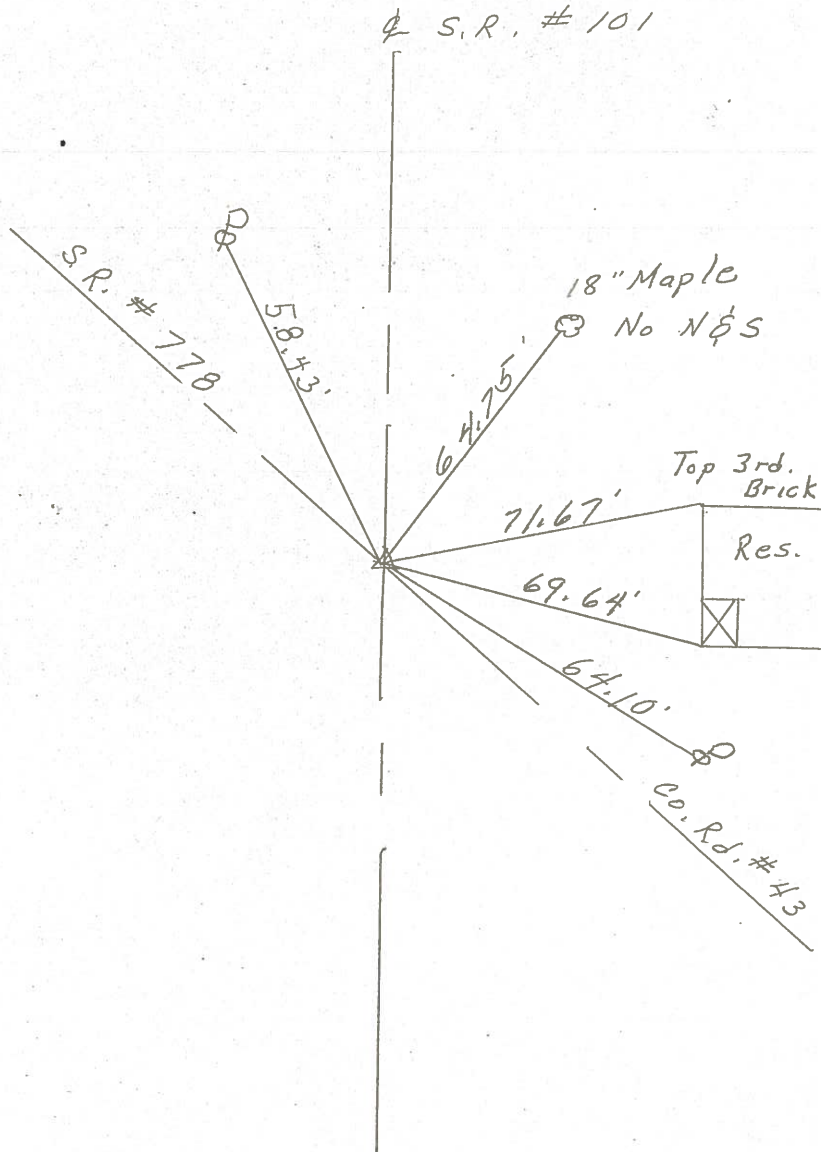

PERSONNEL	TITLE	PERSONNEL	TITLE
Krabill			
Kowaleski			
Geyman			
Bruggeman			

COUNTY SenecaDATE 2-10-64S. R. # 101

WEATHER

SEC.

TEMP.

DESCRIPTION

LEFT

CENTER LINE

RIGHT

JOB NO.

(39)

STA. 60+04.92

P.K.

± 389

End of Sec. O

Start of Sec. J

Adams Twp

28.08' 12" Maple

45.10'

40.42'

12" Hickory

30" Maple

(40)

STA. 0+00

P.K.

± 389A

S. R. # 178

49.16'

11" Maple

69.62'

49.90'

House

Car Porch

Walnut

Co. Rd. # 101

(41)

STA. 1+00

R.R. Spike

± 390

Res.

28.12'

20.30'

Locust

22.44'

80.85'

House

11" Maple

(10)