

O.D.O.T. DISTRICT 2 SURVEY OFFICE (USE ONLY)

PERSONNEL

REFERENCE NO. 41

SHEET 19 OF 46

NOTES MILLER

DATE 8/7/24

ROUTE SR 101

H.C. MILLER

WEATHER CLOUDY/WINDY

COUNTY SENECA

R.C. BARRIERE

TEMP. 85°F

TOWNSHIP ADAMS

BLUBAUGH, ASTON, PRESTON-COLVIN

SECTION 20

DWG BY BLUBAUGH

PID 114849

T 3 N R 16 E

TYPE MONUMENT MAG/WASHER

ON SURFACE - ~~BELOW~~ 0.5"

OFFSET $\mathcal{C}$ PAVEMENT 2' ~~LT~~ : RT

-- TO -- EDGE PAVEMENT

STATION: 510+78

HORIZ.DATUM: NAD83 (2011)



GEOID: NAVD88-2018

GRID: NORTHING: 561744.998

EASTING: 1816130.320

LDP: NORTHING: 330728.983

EASTING: 190521.663

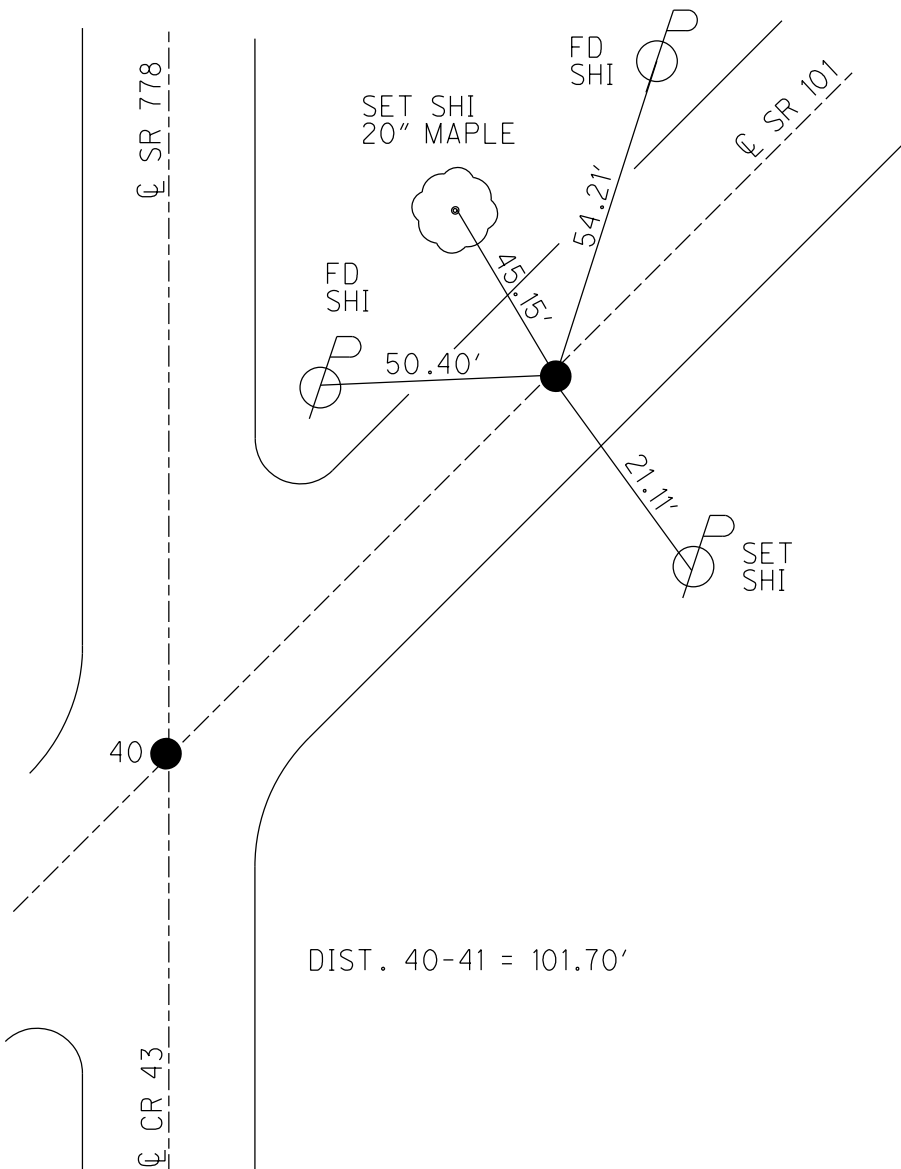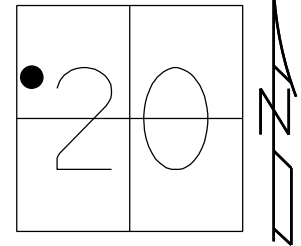

RECORD:
 STA. 1+00
 FD P.K.NAIL
 ATOP R.R.SPIKE
 SET P.K./WASHER
 8/27/90, BARBOUR
 FD P.K./WASHER
 2/7/05, SAH
 FD P.K./WASHER
 REF41
 7/21/09, DCH
 SET MAG/WASHER
 NEWREF41
 10/8/09, DCH
 FD MAG/WASHER
 REF41
 6/14/16
 9/18/17, JFO
 FD MAG/WASHER
 REF 41
 9/12/19
 8/2/21,
 6/6/22, DSA
 FD MAG/WASHER
 REF41
 12/14/23, JAM
 FD TONE. DID NOT
 UNCOVER PAINTED
 8/7/24, JAM

DIST. 40-41 = 101.70'

O.D.O.T. DISTRICT 2 SURVEY OFFICE (USE ONLY)

PERSONNEL

REFERENCE NO. 41

SHEET 19 OF 46

NOTES HOMAN

DATE 7-21-09

ROUTE SR 101

H.C. HOMAN

WEATHER SUNNY

COUNTY SENECA

R.C. ROUSOS

TEMP. 85°F

TOWNSHIP ADAMS

DWG BY WHITAKER

PID 101165

SECTION 20

T 3 N R 16 E

TYPE MONUMENT P.K./WASHER

ON SURFACE - ~~BELOW~~ ON

OFFSET Q PAVEMENT 2' ~~LT~~ : RT

- TO - EDGE PAVEMENT



STATION: 510+78

HORIZ.DATUM: NAD83 (2011)

GEOID: NAVD88-2012A

GRID: NORTHING: 561744.998

EASTING: 1816130.320

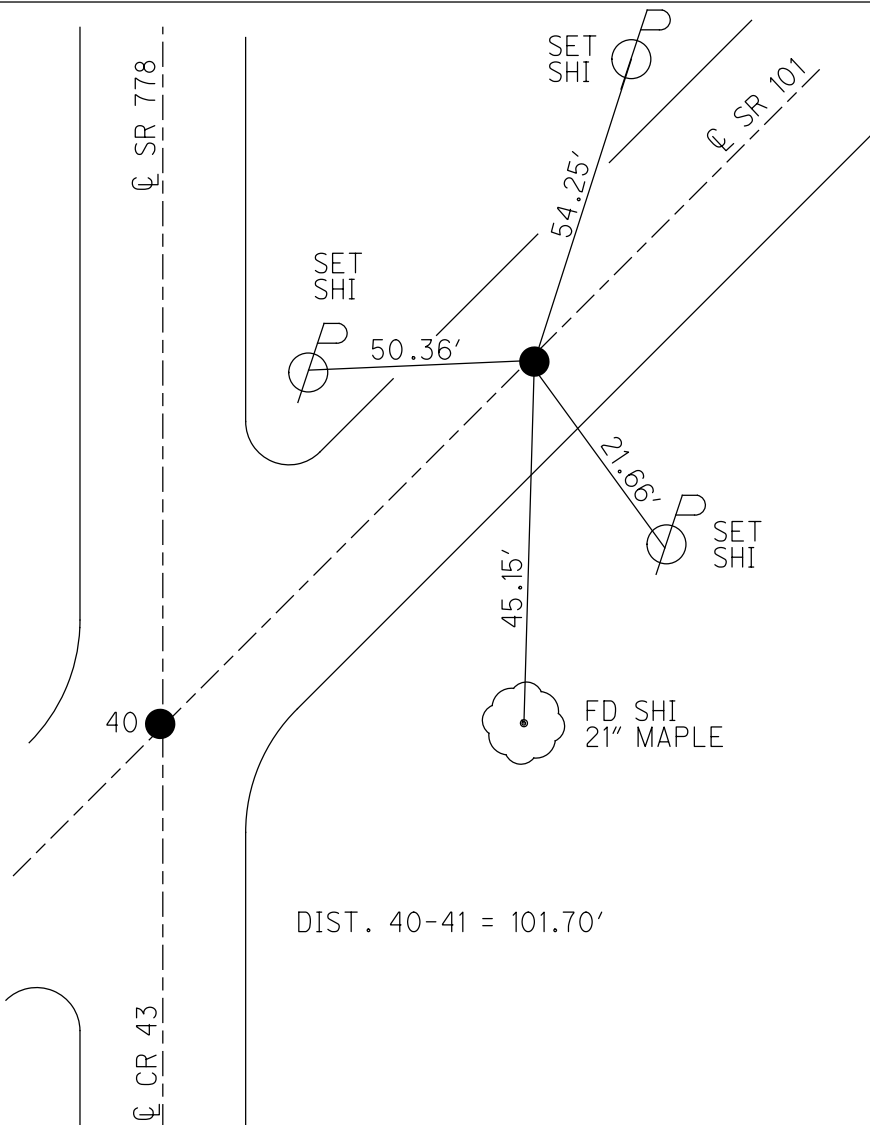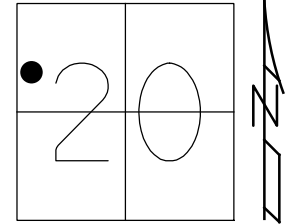

RECORD:
STA. 1+00
FD P.K.NAIL
ATOP R.R.SPIKE
SET P.K./WASHER
8/27/90, BARBOUR
FD P.K./WASHER
2/7/05, SAH
FD P.K./WASHER
REF41
7/21/09, DCH
SET MAG/WASHER
NEWREF41
10/8/09, DCH
FD MAG/WASHER
REF41
6/14/16
9/18/17, JFO
FD MAG/WASHER
REF 41
9/12/19
8/2/21,
6/6/22, DSA

O.D.O.T. DISTRICT 2 SURVEY OFFICE (USE ONLY)

PERSONNEL

REFERENCE NO. 41

SHEET 19 OF 46

NOTES HOMAN

DATE 7-21-09

ROUTE SR 101

H.C. HOMAN

WEATHER SUNNY

COUNTY SENECA

R.C. ROUSOS

TEMP. 85°F

TOWNSHIP ADAMS

SECTION 20

DWG BY MAHLER

PID 100787

T 3 N R 16 E

TYPE MONUMENT P.K./WASHER

ON SURFACE - ~~BELOW~~ ON

OFFSET CL PAVEMENT 2' ~~LT~~ : RT

- TO - EDGE PAVEMENT



STATION: 510+78

HORZ.DATUM: NAD83 (2011)

GEOID: NAVD88-2012A

GRID: NORTHING: 561744.973

EASTING: 1816130.294

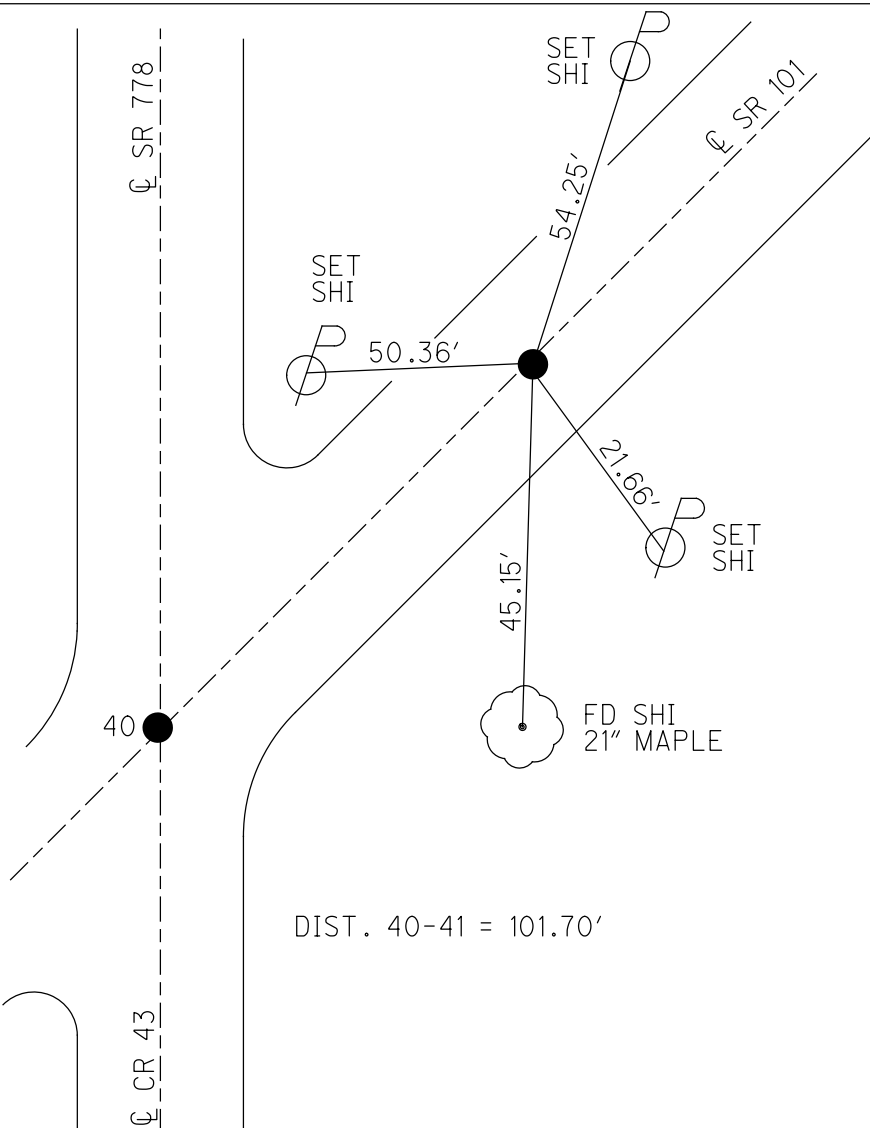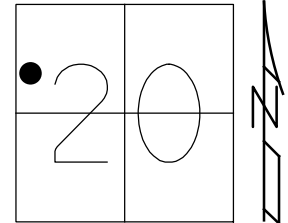



RECORD:
STA. 1+00
FD P.K.NAIL
ATOP R.R.SPIKE
SET P.K./WASHER
8/27/90, BARBOUR
FD P.K./WASHER
2/7/05, SAH
FD P.K./WASHER
REF41
7/21/09, DCH
SET MAG/WASHER
NEWREF41
10/8/09, DCH
FD MAG/WASHER
REF41
6/14/16
9/18/17, JFO

O.D.O.T. DISTRICT 2 SURVEY OFFICE (USE ONLY)

PERSONNEL	REFERENCE NO. <u>41</u>	SHEET <u>19</u> OF <u>46</u>
NOTES	DATE <u>7/21/09</u>	ROUTE <u>SR 101</u>
H.C. <u>HOMAN</u>	WEATHER <u>SUNNY</u>	COUNTY <u>SENECA</u>
R.C. <u>ROUSOS</u>	TEMP. <u>85°</u>	TOWNSHIP <u>ADAMS</u>
		SECTION <u>20</u>
		T <u>3</u> N R <u>16</u> E

TYPE MONUMENT P.K./WASHER
 ON SURFACE - ~~BELOW~~ ON
~~LEFT~~ - Q PAV'T - RIGHT 2'
- TO - EDGE PAVEMENT
 S.L.M. 510+78

GRID: NORTHING: 561744.973 EASTING: 1816130.294

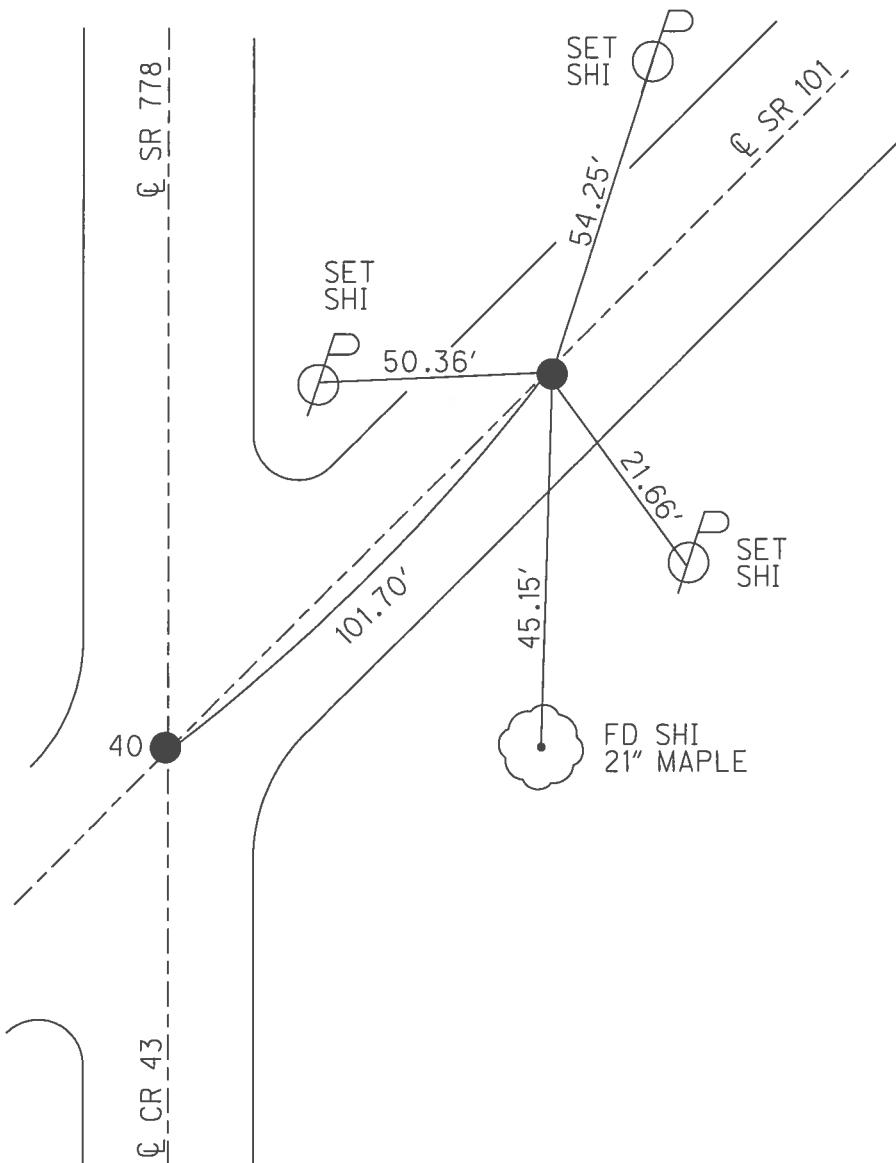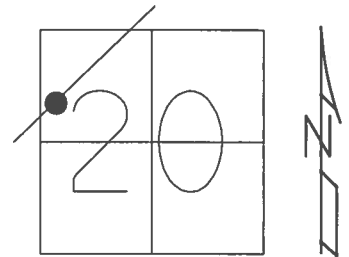



RECORD:
 STA. 1+00
 FD P.K.NAIL ATOP
 R.R.SPIKE
 SET P.K./WASHER
 8/27/90
 FD P.K./WASHER
 2/7/05, SAH
 SET MAG/WASHER
 10/8/09, DCH
 FD MAG/WASHER
 REF41
 6/14/16, JFO
 UNCOVERED
 9/18/17, JFO

O.D.O.T. DISTRICT 2 SURVEY OFFICE (USE ONLY)

PERSONNEL _____ REFERENCE NO. 41 SHEET 19 OF 46
 NOTES HOMAN DATE 7/21/09 ROUTE SR 101
 H.C. HOMAN WEATHER SUNNY COUNTY SENECA
 R.C. ROUSOS TEMP. 85° TOWNSHIP ADAMS
 SECTION 20
 T 3 N R 16 E

TYPE MONUMENT P.K./WASHER
 ON SURFACE - ~~BELOW~~ ON
~~LEFT~~ - Q PAV'T - RIGHT 2'
- TO - EDGE PAVEMENT
 S.L.M. 510+78

GRID: NORTHING: 561745.056 EASTING: 1816130.260

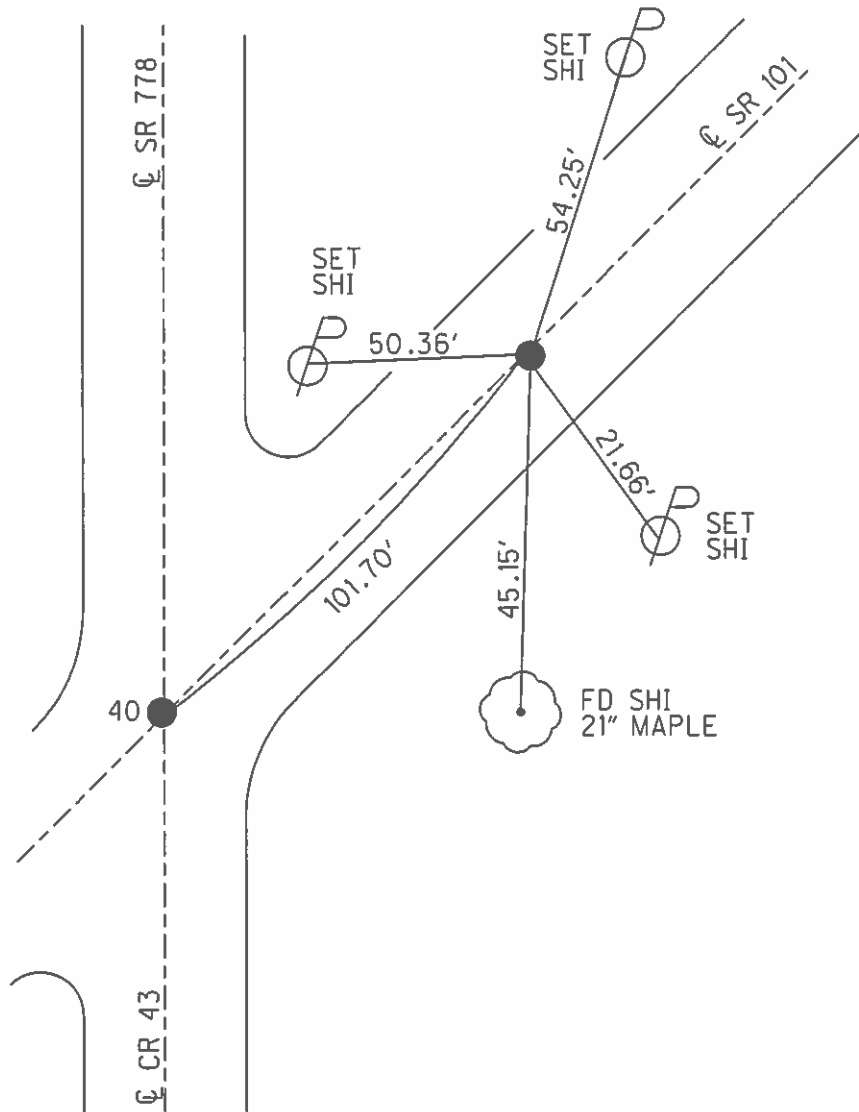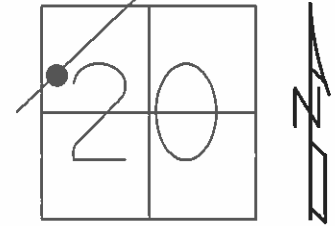

RECORD:
 STA. 1+00
 FD P.K.NAIL ATOP
 R.R.SPIKE
 SET P.K./WASHER
 8/27/90
 FD P.K./WASHER
 2/7/05, SAH
 SET MAG/WASHER
 10/8/09, DCH

O.D.O.T. DISTRICT 2 SURVEY OFFICE

PERSONNEL

REFERENCE NO. 41

SHEET 15 OF 41

NOTES RIPPLE

H.C. BARBOUR

R.C. GEYMAN

DATE 8/27/90

WEATHER SUNNY

TEMP. 92°

ROUTE SR#101


COUNTY SENECA

TOWNSHIP ADAMS

SECTION 20


T. 3 N R. 16 E

TYPE MONUMENT SET P.K. & WASHER
ON SURFACE - BELOW P.K. NAIL ATOP RR SPIKE
LEFT - 2' RT. & PAV'T. RIGHT 2' RT. & PAV'T.
TO EDGE PAVEMENT
S.L.M. _____

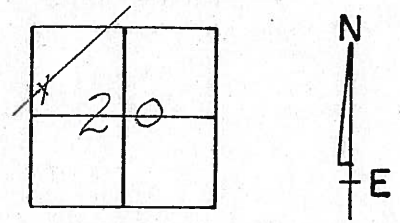

510 +78

1+00

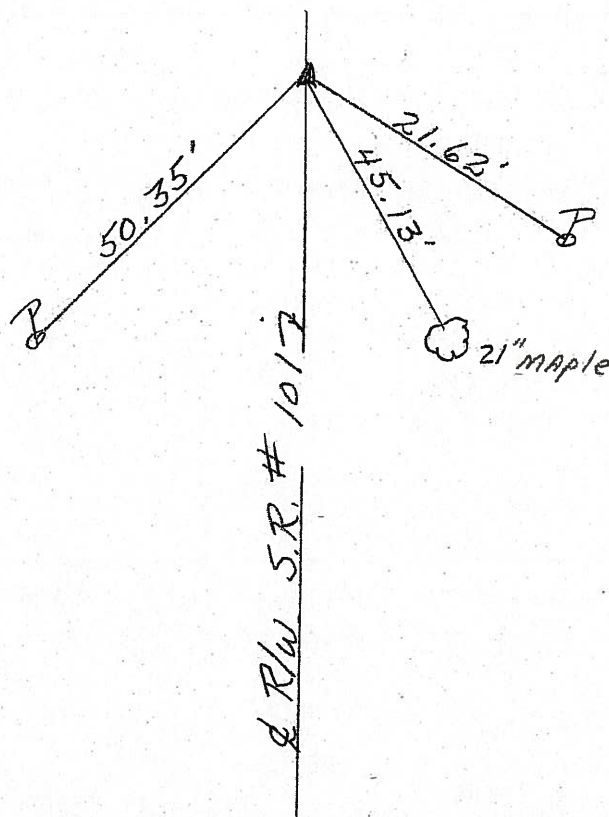

fd
2-7-05
SAA

O.D.O.T. DISTRICT 2 SURVEY OFFICE

PERSONNEL

REFERENCE NO. 41A

SHEET 15 OF 41

NOTES RIPPLE

H.C. BARBOUR

R.C. GEYMAN

DATE 8/27/90

WEATHER SUNNY

TEMP. 92°

ROUTE SR.#101


COUNTY SENECA

TOWNSHIP ADAMS


SECTION 20

T. 3 N R. 16 E

TYPE MONUMENT SET P.K. & WASHER
ON SURFACE - BELOW P.K. NAIL ATop RR SPIKE
LEFT - & PAV'T. - RIGHT 2' RT. & PAV'T.
____ TO ____ EDGE PAVEMENT
S.L.M. _____

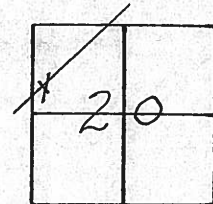

1+00

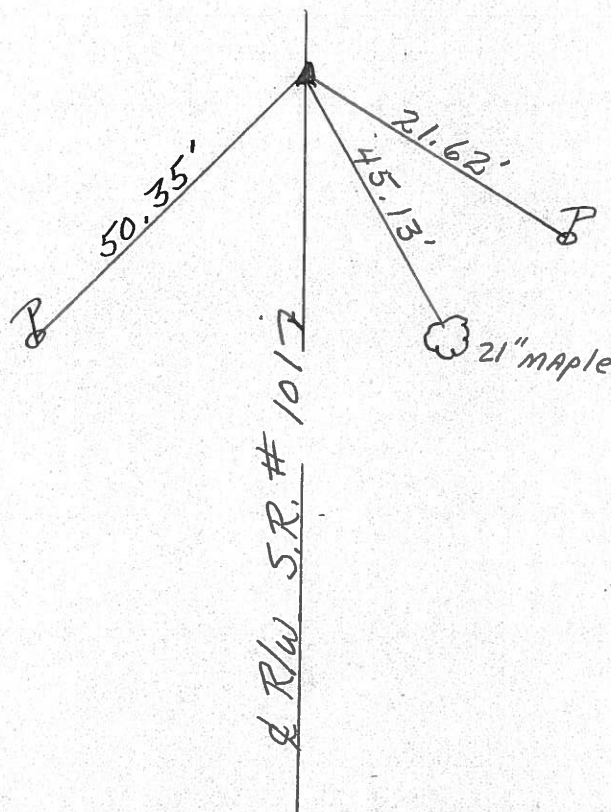

Q.D.O.T. DISTRICT 2 SURVEY OFFICE

Sht. of

County Seneca S.R. 101

Township Adams

Section 2

T₃N, R₁₆E

Personnel Schneider



Masser

Barbour

Date 6-26-79

Weather Fair

Temp. 70°

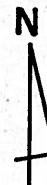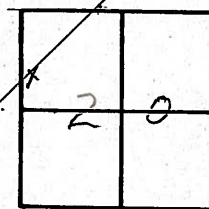

(41)


~~# 43 A~~

1+00

R.R. spk. on & R/w

2" down 2 1/2' Rt. of &

Reset P. K. Nail

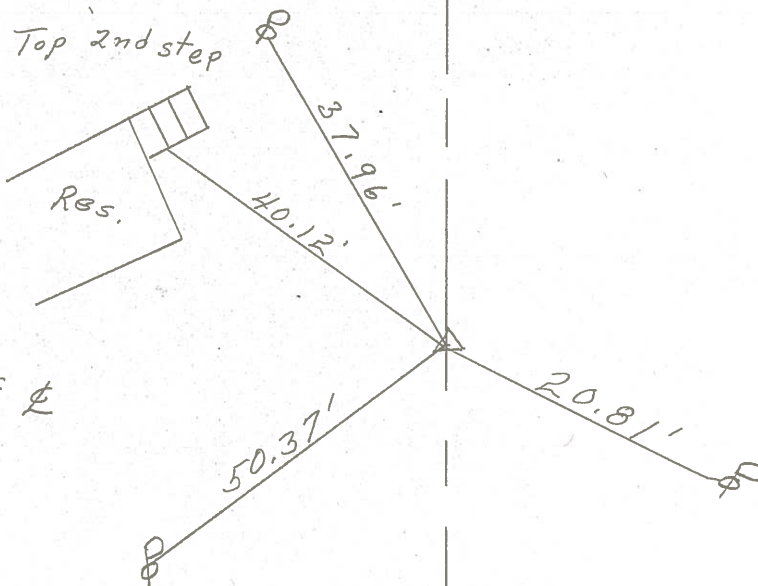

PERSONNEL TITLE PERSONNEL TITLE

COUNTY Seneca

DATE 2-10-64

Krabill
Kowaleski

S. R. # 101

WEATHER

Geymah

SEC.

TEMP.

DESCRIPTION

LEFT

CENTER LINE

RIGHT

JOB NO.

(39)

STA. 69+04.92

P.K.

389

End of Sec. O

Start of Sec. J

Adams Twp

28.08' 12" Maple

45.10'

40.42'

12" Hickory

30" Maple

(40)

STA. 0+00

P.K.

389A

C. B.
S.R. # 101
54.40'

49.16'

11" Maple

69.62'

House

49.90'

Con. Porch

Walnut

Co. Rd. # 43
Sec. Line

(41)

STA. 1+00

R.R. Sp'ko

390

Res.

27.12'

20.30'

Locust

22.44'

11" Maple

80.85'

House