

O.D.O.T. DISTRICT 2 SURVEY OFFICE (USE ONLY)

PERSONNEL

REFERENCE NO. 42

SHEET 20 OF 46

NOTES MILLER

DATE 8/7/24

ROUTE SR 101

H.C. MILLER

WEATHER CLOUDY/WINDY

COUNTY SENECA

R.C. BARRIERE

TEMP. 70°F

TOWNSHIP ADAMSBLUBAUGH, ASTON, PRESTON-COLVINDWG BY BLUBAUGHPID 114849

T 3 N R 16 F

TYPE MONUMENT MAG/WASHER

ON SURFACE - ~~BELOW~~ 0.5"

OFFSET $\frac{1}{2}$ PAVEMENT _____ ON _____ LT : RT

____TO____EDGE PAVEMENT

STATION: 517+79


HORZ.DATUM: NAD83 (2011)

GEOID: NAVD88-2018A


GRID: NORTHING: 562272.665

EASTING: 1816590.285

LDP: NORTHING: 331260.138

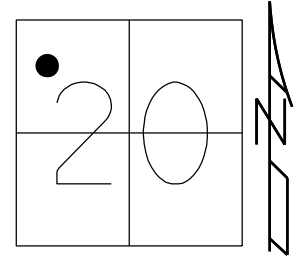EASTING: 190977.749

RECORD:
STA.8+00
FD P.K./WASHER
ATOP R.R.SPIKE
SET P.K./WASHER
8/27/90
FD P.K./WASHER
2/7/05, SAH
FD P.K./WASHER
REF42
7/21/09, DCH
SET MAG/WASHER
NEWREF42
10/5/09, DCH
FD MAG/WASHER
REF42
6/14/16
9/18/17, JFO
FD MAG/WASHER
REF 42
9/25/2019, JLL
8/2/21,
6/6/22, DSA
FD MAG/WASHER
REF42
12/14/23, JAM
FD TONE. DID NOT
UNCOVER. PAINTED
8/7/24, JAM

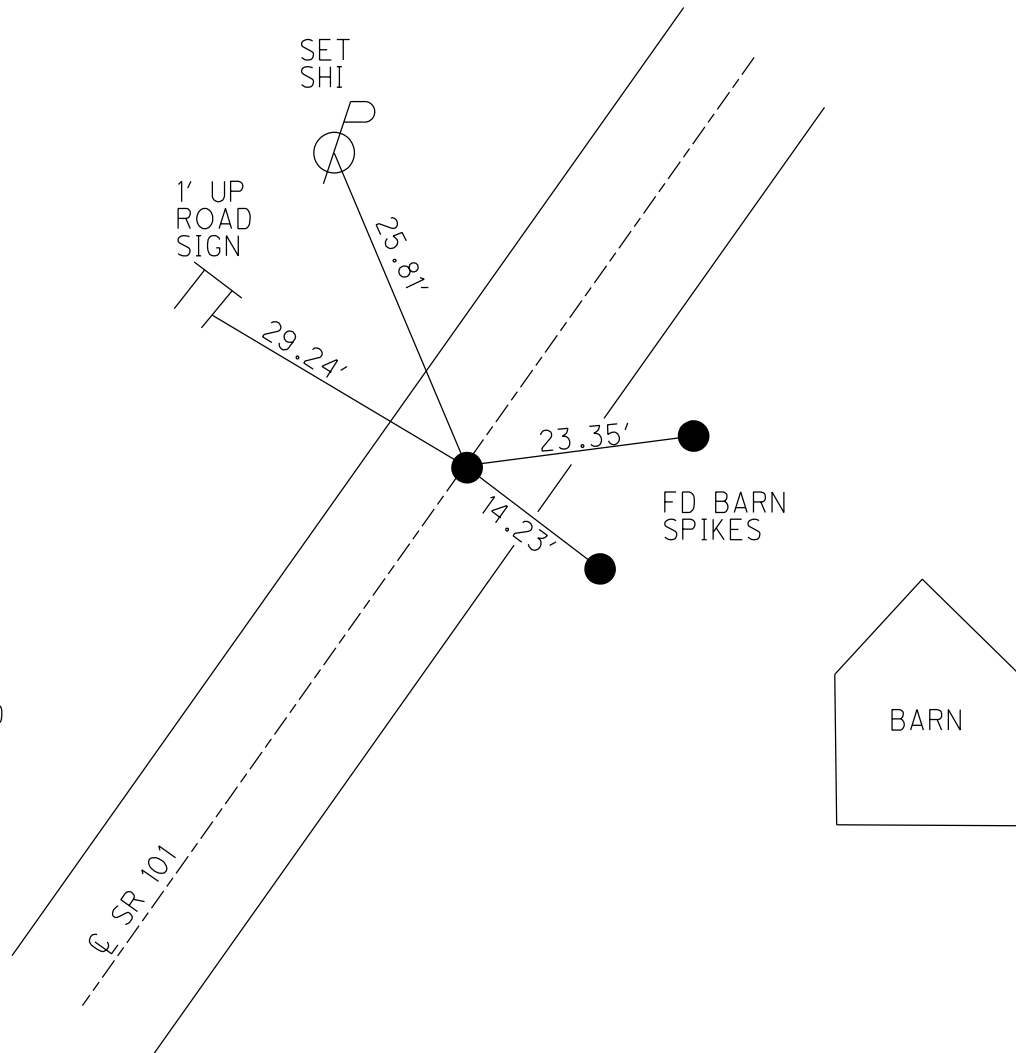

O.D.O.T. DISTRICT 2 SURVEY OFFICE (USE ONLY)

PERSONNEL

REFERENCE NO. 42

SHEET 20 OF 46

NOTES AUBLE

DATE 8/2/21

ROUTE SR 101

H.C. AUBLE

WEATHER SUNNY

COUNTY SENECA

R.C. NIESE

TEMP. 85°F

TOWNSHIP ADAMS

DWG BY RHOADES PID 101165

SECTION 20

T 3 N R 16 E

TYPE MONUMENT MAG/WASHER

ON SURFACE - ~~BELOW~~ ON

OFFSET Q PAVEMENT ON LT : RT

- TO - EDGE PAVEMENT


STATION: 517+79

HORIZ.DATUM: NAD83 (2011)


GEOID: NAVD88-2012A

GRID: NORTHING: 562272.665

EASTING: 1816590.285

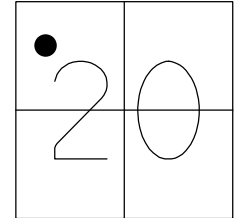

RECORD:
STA.8+00
FD P.K./WASHER
ATOP R.R.SPIKE
SET P.K./WASHER
8/27/90
FD P.K./WASHER
2/7/05, SAH
FD P.K./WASHER
REF42
7/21/09, DCH
SET MAG/WASHER
NEWREF42
10/5/09, DCH
FD MAG/WASHER
REF42
6/14/16
9/18/17, JFO
FD MAG/WASHER
REF 42
9/25/2019, JLL
8/2/21,
6/6/22, DSA

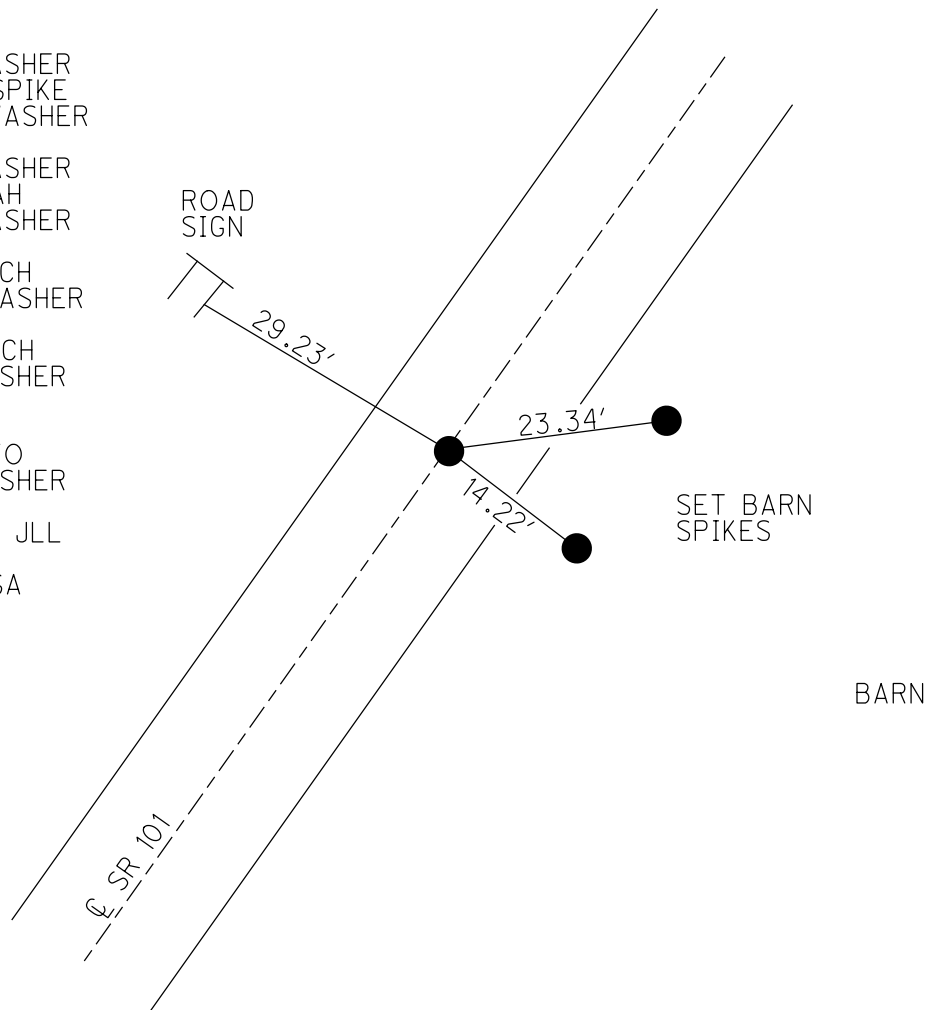

O.D.O.T. DISTRICT 2 SURVEY OFFICE (USE ONLY)

PERSONNEL

REFERENCE NO. 42

SHEET 20 OF 46

NOTES HOMAN

DATE 7-21-09

ROUTE SR 101

H.C. HOMAN

WEATHER SUNNY

COUNTY SENECA

R.C. ROUSOS

TEMP. 85°F

TOWNSHIP ADAMS

SECTION 20

DWG BY MAHLER

PID 100787

T 3 N R 16 E

TYPE MONUMENT P.K./WASHER

ON SURFACE - ~~BELOW~~ ON

OFFSET Q PAVEMENT ON LT : RT

- TO - EDGE PAVEMENT


STATION: 517+79

HORIZ.DATUM: NAD83 (2011)


GEOID: NAVD88-2012A

GRID: NORTHING: 562272.653

EASTING: 1816590.281

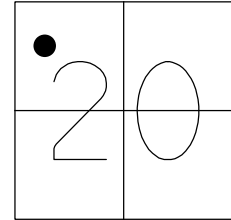

RECORD:
STA.8+00
FD P.K./WASHER
ATOP R.R.SPIKE
SET P.K./WASHER
8/27/90
FD P.K./WASHER
2/7/05, SAH
FD P.K./WASHER
REF42
7/21/09, DCH
SET MAG/WASHER
NEWREF42
10/5/09, DCH
FD MAG/WASHER
REF42
6/14/16
9/18/17, JFO

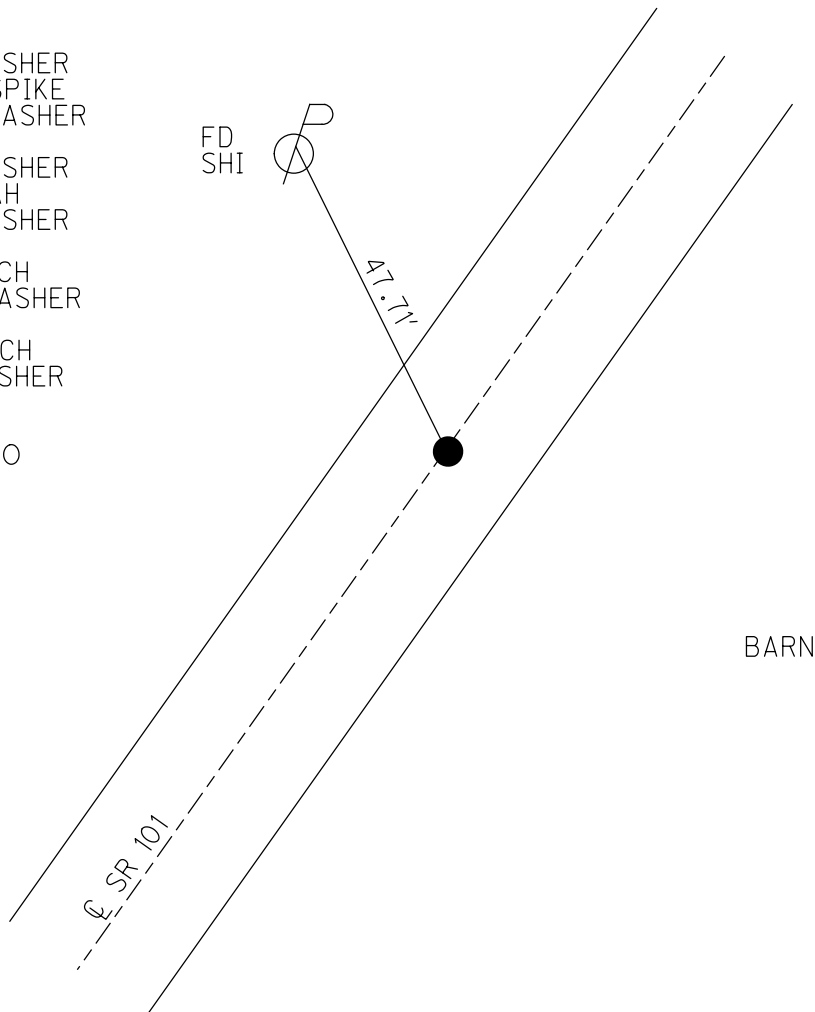


O.D.O.T. DISTRICT 2 SURVEY OFFICE (USE ONLY)


PERSONNEL _____ REFERENCE NO. 42 SHEET 20 OF 46
 NOTES HOMAN DATE 7/21/09 ROUTE SR 101
 H.C. HOMAN WEATHER SUNNY COUNTY SENECA
 R.C. ROUSOS TEMP. 85° TOWNSHIP ADAMS
 _____ SECTION 20
 _____ T 3 N R 16 E

TYPE MONUMENT P.K./WASHER
 ON SURFACE - ~~BELOW~~ ON
 LEFT - ℄ PAV'T - ~~RIGHT~~ 0.3'
TO - EDGE PAVEMENT
 S.L.M. 517+79

GRID: NORTHING: 562272.653 EASTING: 1816590.281

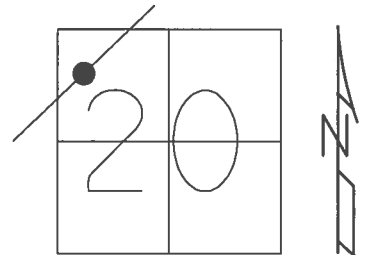

RECORD:
 STA.8+00
 FD P.K./WASHER
 ATOP R.R.SPIKE
 SET P.K./WASHER
 8/27/90
 FD P.K./WASHER
 2/7/05, SAH
 SET MAG/WASHER
 10/5/09, DCH
 FD MAG/WASHER
 REF42
 6/14/16, JFO
 UNCOVERED
 9/18/17, JFO

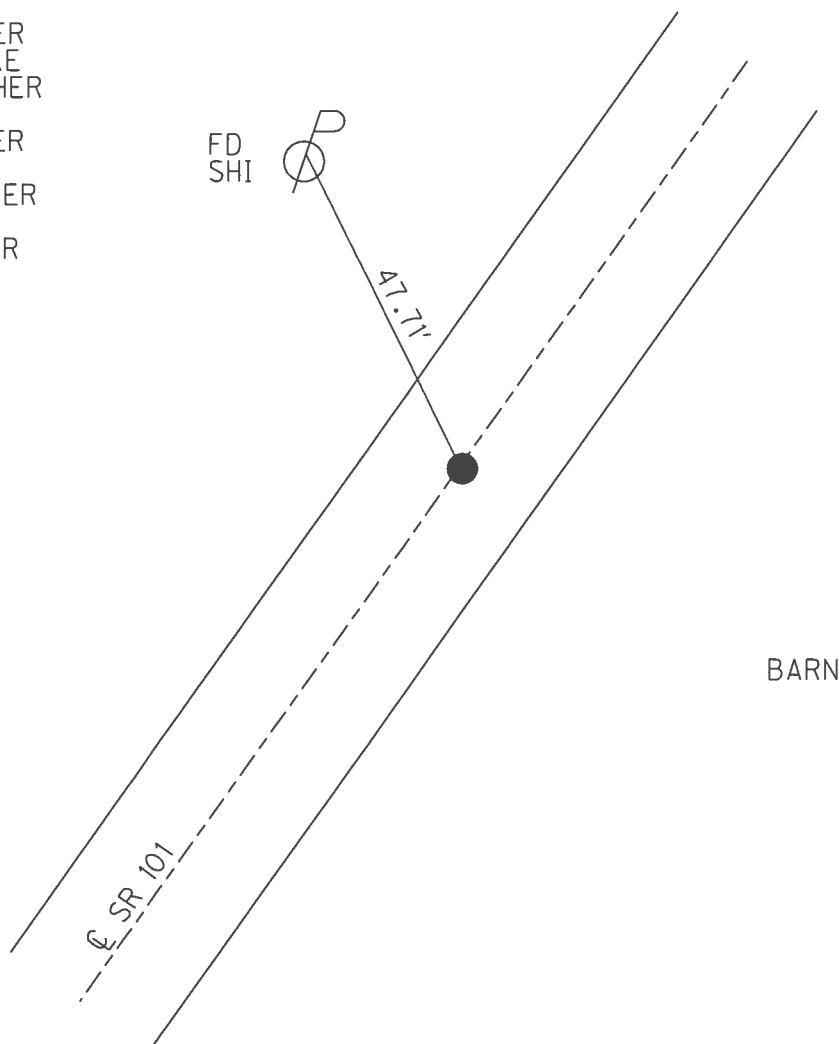


O.D.O.T. DISTRICT 2 SURVEY OFFICE (USE ONLY)


PERSONNEL _____ REFERENCE NO. 42 SHEET 20 OF 46
 NOTES HOMAN DATE 7/21/09 ROUTE SR 101
 H.C. HOMAN WEATHER SUNNY COUNTY SENECA
 R.C. ROUSOS TEMP. 85° TOWNSHIP ADAMS
 SECTION 20
 T 3 N R 16 E

TYPE MONUMENT P.K./WASHER
 ON SURFACE - ~~BELOW~~ ON
 LEFT - C PAV'T - RIGHT ON
 - TO - EDGE PAVEMENT
 S.L.M. 517+79

GRID: NORTHING: 562272.712 EASTING: 1816590.247

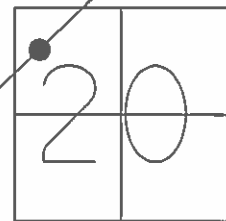

RECORD:
 STA. 8+00
 FD P.K./WASHER
 ATOP R.R. SPIKE
 SET P.K./WASHER
 8/27/90
 FD P.K./WASHER
 2/7/05, SAH
 SET MAG/WASHER
 10/5/09, DCH

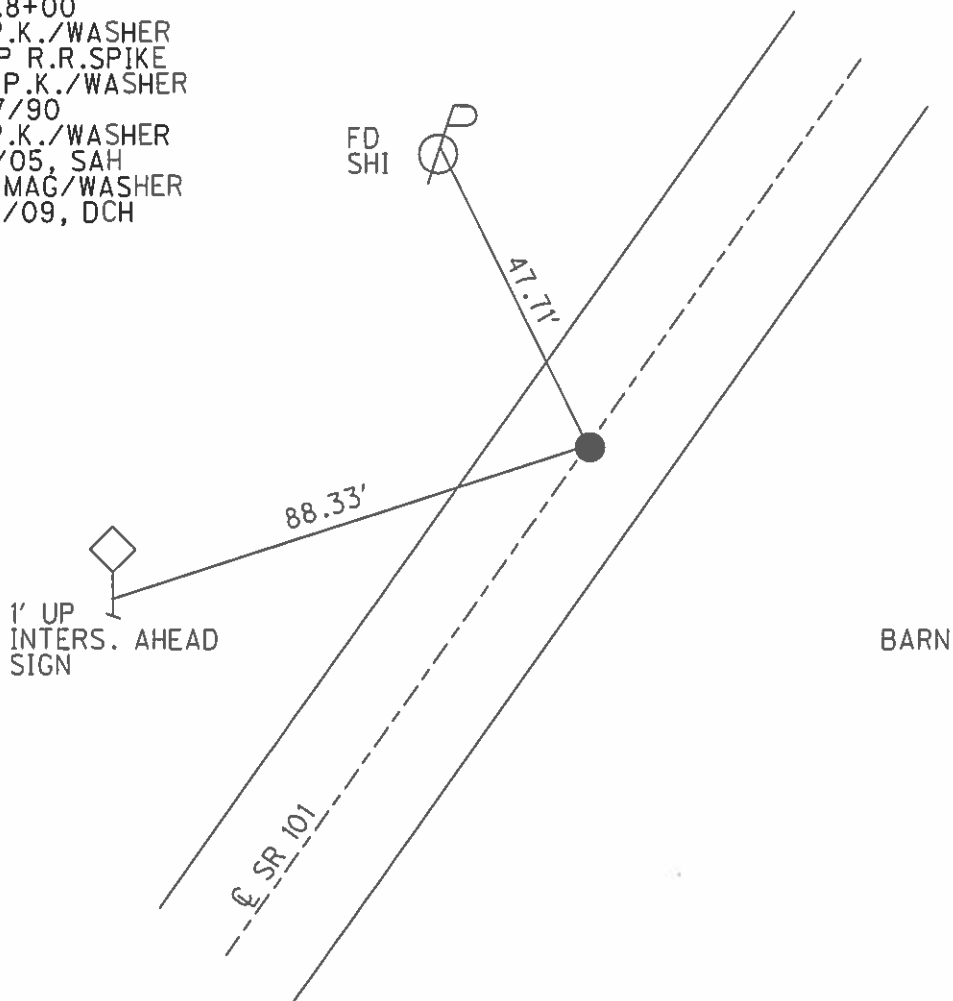

O.D.O.T. DISTRICT 2 SURVEY OFFICE

PERSONNEL

REFERENCE NO. 42

SHEET 16 OF 41

NOTES RIPPLE

H.C. BARBOUR

R.C. GEYMAN

DATE 8/27/90

WEATHER SUNNY

TEMP. 92°

ROUTE SR#101


COUNTY SENECA

TOWNSHIP ADAMS

SECTION 20

T.3 N R 16 E

TYPE MONUMENT SET P.K. & WASHER
ON SURFACE - BELOW P.K. & WASHER AT TOP RR SPIKE
LEFT - CL PAV'T. - RIGHT CL PAV'T.
TO EDGE PAVEMENT
S.L.M.

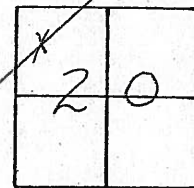

517+79



47.73'

82.17'

82.72'

CONC. BLOCK
WALL 10th BLOCK
FROM BARN

BARN

FQ
2-2-05
SAH

RR/W SR#101

O.D.O.T. DISTRICT 2 SURVEY OFFICE

PERSONNEL

REFERENCE NO. 42

SHEET 16 OF 41

NOTES RIPPLE

H.C. BARBOUR

R.C. GEYMAN

DATE 8/27/90

WEATHER SUNNY

TEMP. 92°

ROUTE SR.#101


COUNTY SENECA

TOWNSHIP ADAMS

SECTION 20

T. 3 N R. 16 E

TYPE MONUMENT Set P.K. & washer
ON SURFACE - BELOW PK. & washer A Top RR spike
LEFT - ℄ PAV'T. - RIGHT ℄ PAV'T.
____ TO ____ EDGE PAVEMENT
S.L.M. _____

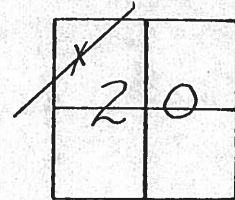

8+00

47.73'

82.17'

82.72'

CONC. Block
Wall 10th Block
FROM BARN



N₆₅°E

BARN

℄ RR/W SR #101

County Seneca S.R. # 101Township AdamsSection 20T 3 N, R 16 EPersonnel SchneiderMosserBarbourDate 6-26-79Weather FairTemp. 70°

(42)

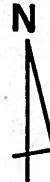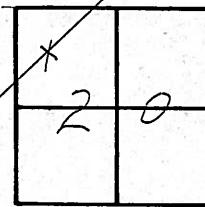~~#458~~

S.R. # 101

Conc-block
wall 10th blo
from Barn

47.73'

82.05'
Plumbed
82.74'

8+00

R.R. spk. on & R/w.

2 1/2" down

Re set P.K. Nail

PERSONNEL TITLE PERSONNEL TITLE

COUNTY Seneca

DATE 2-10-64

Krabill

Kowaleski

Geyma

Bruggeman

S. R. 101

WEATHER

SEC.

TEMP.

DESCRIPTION

LEFT


CENTER LINE

RIGHT

JOB NO.


(42)

STA. 8+00

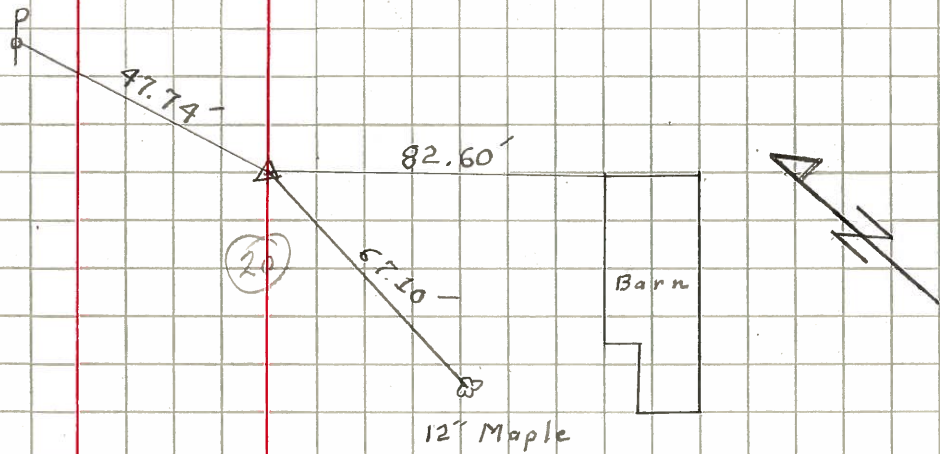Iron Pin
391


(43)

STA. 21+50

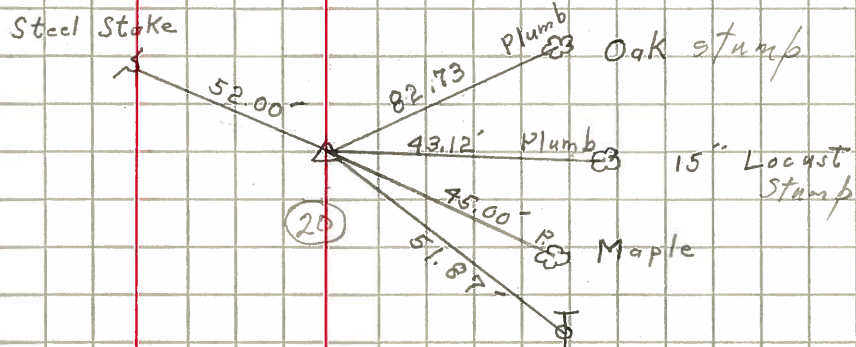Iron Pin
392

(44)

STA. 29+00

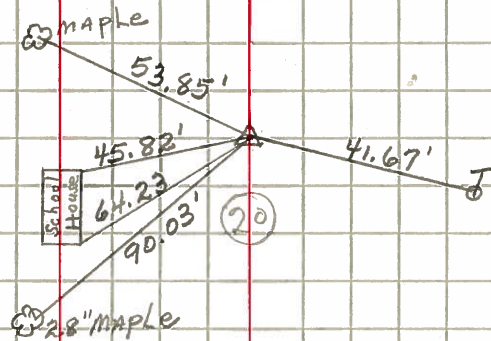Iron Pin
393

(45)

STA. 46+00

IRON PIN
394