

O.D.O.T. DISTRICT 2 SURVEY OFFICE (USE ONLY)

PERSONNEL

REFERENCE NO. 43

SHEET 21 OF 46

NOTES MILLER

DATE 8/7/24

ROUTE SR 101

H.C. MILLER

WEATHER WINDY

COUNTY SENECA

R.C. BARRIERE

TEMP. 70°F

TOWNSHIP ADAMS

BLUBAUGH, ASTON, PRESTON-COLVIN

SECTION 20

DWG BY BLUBAUGH

PID 114849

T 3 N R 16 E

TYPE MONUMENT R.R.SPIKE

~~ON SURFACE~~ - BELOW 7.5"

OFFSET $\angle$ PAVEMENT 1.1' LT : ~~RT~~

10.7' TO LT EDGE PAVEMENT

STATION: 531+16

HORIZ.DATUM: NAD83 (2011)


GEOID: NAVD88-2018

GRID: NORTHING: 563284.576

EASTING: 1817480.462

LDP: NORTHING: 332279.006

EASTING: 191860.486

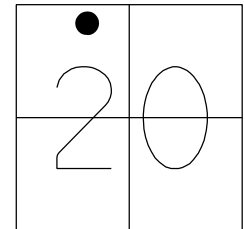

RECORD:

STA. 21+50

FD P.K.NAIL

ATOP R.R.SPIKE

SET P.K./WASHER

8/27/90

FD P.K./WASHER

2/7/05, SAH

FD P.K./WASHER

REF43

7/21/09, DCH

SET MAG/WASHER

NEWREF43

10/5/09, DCH

D.N.F.

6/14/16, JFO

FD R.R.SPIKE

7 1/4" DOWN

REF 43

9/25/19, JLL

FD R.R.SPIKE

REF 43

8/2/21,

6/6/22, DSA

FD R.R.SPIKE


REF43

12/14/23, JAM

FD TONE. DID NOT

UNCOVER. PAINT

8/7/24, JAM

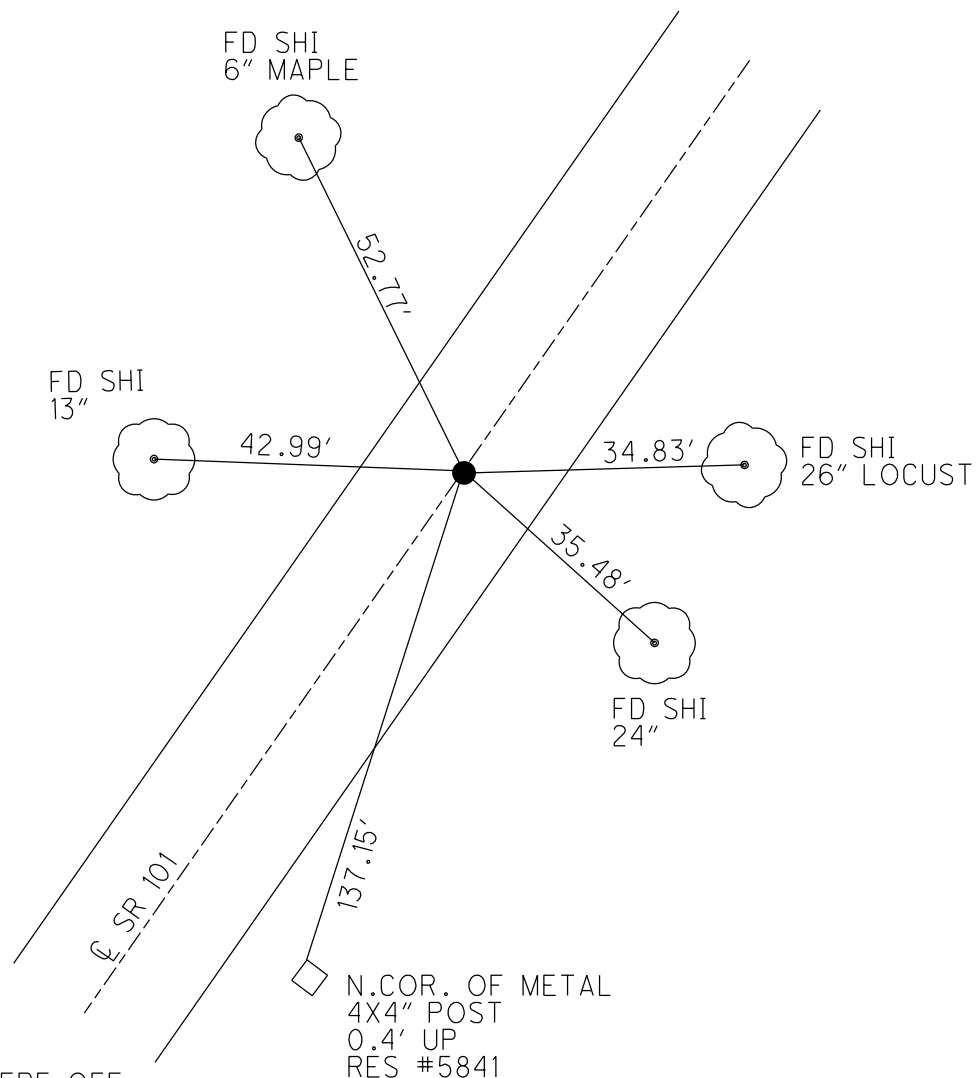


*PULLED TIES TO SET. TIES WERE OFF

O.D.O.T. DISTRICT 2 SURVEY OFFICE (USE ONLY)


PERSONNEL _____ REFERENCE NO. 43 SHEET 21 OF 46
 NOTES LEU DATE 9-25-19 ROUTE SR 101
 H.C. LEU WEATHER CLOUDY COUNTY SENECA
 R.C. AUBLE TEMP. 77°F TOWNSHIP ADAMS
 NASON SECTION 20
 DWG BY WHITAKER PID 101165 T 3 N R 16 E

TYPE MONUMENT R.R.SPIKE
~~ON SURFACE~~ - BELOW 7 1/4"
 OFFSET $\varnothing$ PAVEMENT 1.1' LT : ~~RT~~
10.7' TO LT EDGE PAVEMENT
 STATION: 531+16

HORIZ.DATUM: NAD83 2009 GEOID: NAVD88 2009
 GRID: NORTHING: 563284.576 EASTING: 1817480.462

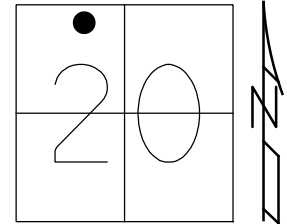

RECORD:
 STA. 21+50
 FD P.K.NAIL
 ATOP R.R.SPIKE
 SET P.K./WASHER
 8/27/90
 FD P.K./WASHER
 2/7/05, SAH
 FD P.K./WASHER
 REF43
 7/21/09, DCH
 SET MAG/WASHER
 NEWREF43
 10/5/09, DCH
 D.N.F.
 6/14/16, JFO
 FD R.R.SPIKE
 7 1/4" DOWN
 REF 43
 9/25/19, JLL
 FD R.R.SPIKE
 REF 43
 8/2/21,
 6/6/22, DSA

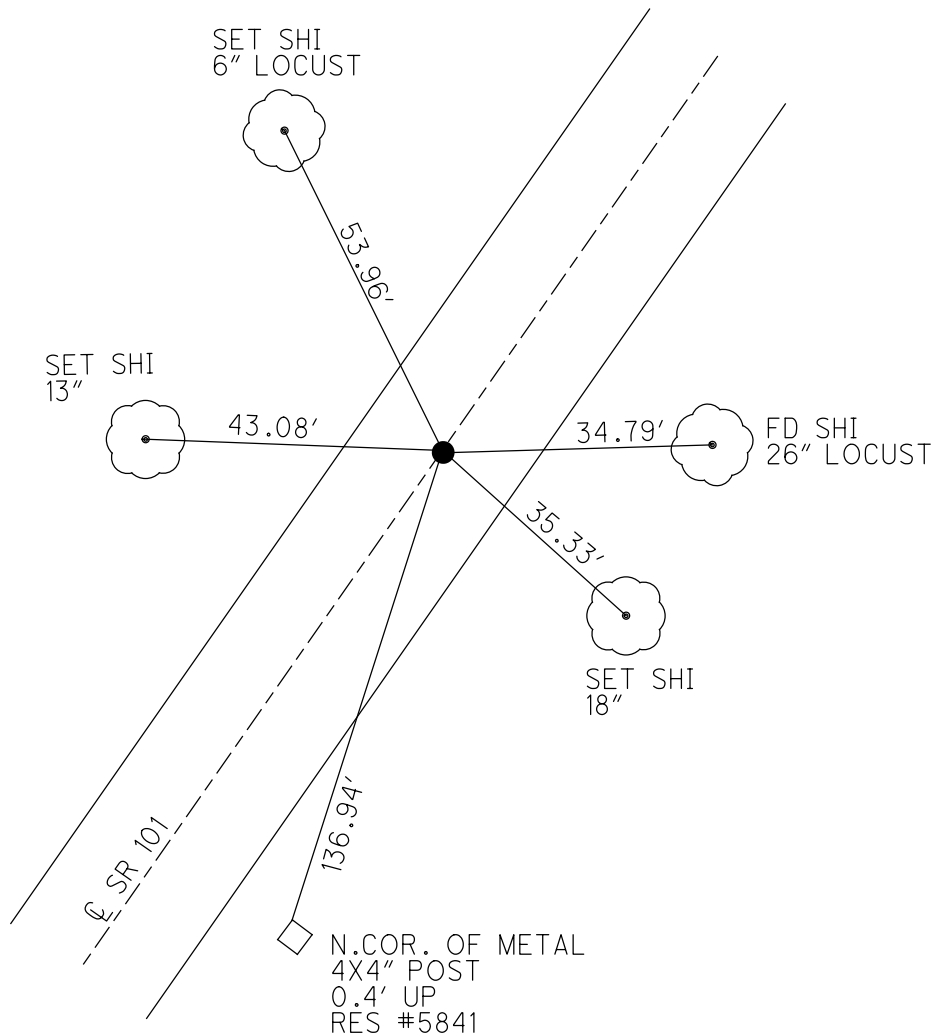

O.D.O.T. DISTRICT 2 SURVEY OFFICE (USE ONLY)

PERSONNEL

REFERENCE NO. 43

SHEET 21 OF 46

NOTES HOMAN

DATE 7-21-09

ROUTE SR 101

H.C. HOMAN

WEATHER SUNNY

COUNTY SENECA

R.C. ROUSOS

TEMP. 85°F

TOWNSHIP ADAMS

SECTION 20

DWG BY MAHLER PID 100787

T 3 N R 16 E

TYPE MONUMENT P.K./WASHER

ON SURFACE - ~~BELOW~~ ON

OFFSET Q PAVEMENT ON LT : RT

- TO - EDGE PAVEMENT


STATION: 531+16

HORZ.DATUM: NAD83 2009


GEOID: NAVD88 2009

GRID: NORTHING: 563802.158

EASTING: 1818022.005

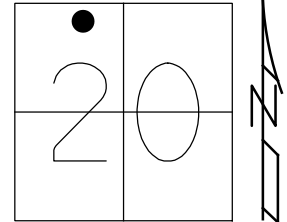

RECORD:
STA. 21+50
FD P.K.NAIL
ATOP R.R.SPIKE
SET P.K./WASHER
8/27/90
FD P.K./WASHER
2/7/05, SAH
FD P.K./WASHER
REF43
7/21/09, DCH
SET MAG/WASHER
NEWREF43
10/5/09, DCH
D.N.F.
6/14/16, JFO

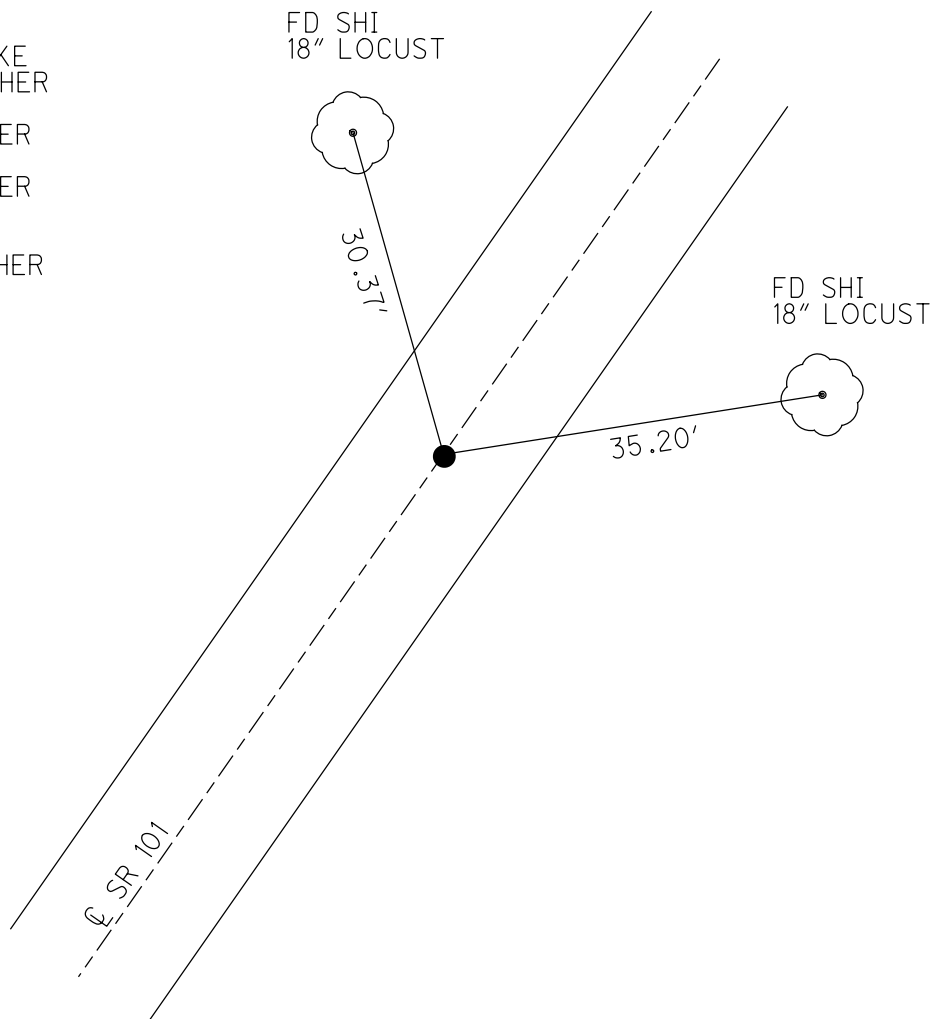

O.D.O.T. DISTRICT 2 SURVEY OFFICE (USE ONLY)

PERSONNEL

REFERENCE NO.

43

SHEET

21

OF

46

NOTES

HOMAN

DATE

7/21/09

ROUTE

SR 101

H.C.

HOMAN

WEATHER

SUNNY

COUNTY

SENECA

R.C.

ROUSOS

TEMP.

85°

TOWNSHIP

ADAMS

SECTION

20

T 3 N

R 16 E

TYPE MONUMENT

P.K./WASHER

ON SURFACE - ~~BELOW~~

ON

LEFT - Q PAV'T - RIGHT

ON


TO EDGE PAVEMENT

S.L.M.

531+16

GRID: NORTHING: -

EASTING: -

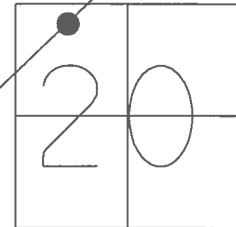

RECORD:

STA. 21+50

FD P.K.NAIL

ATOP R.R.SPIKE

SET P.K./WASHER

8/27/90

FD P.K./WASHER


2/7/05, SAH

SET MAG/WASHER

10/5/09, DCH

D.N.F.

6/14/16, JFO

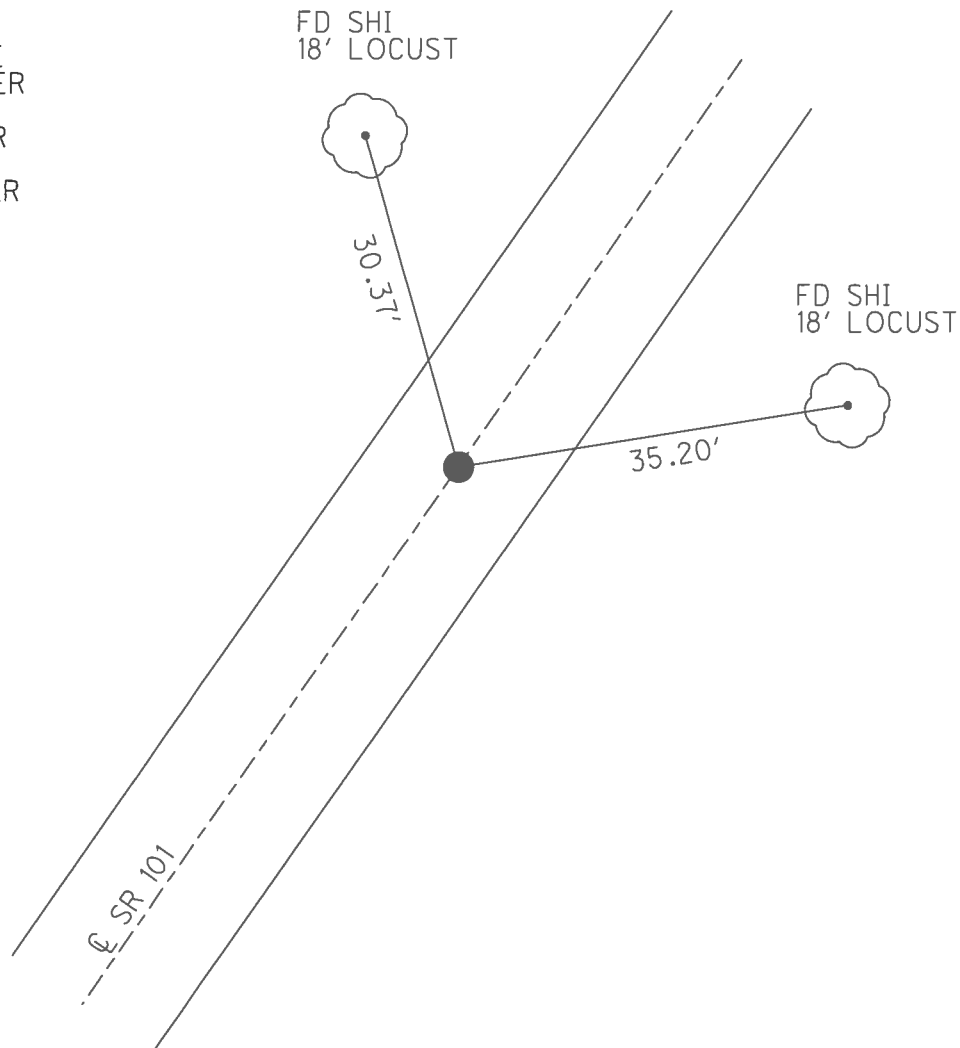

O.D.O.T. DISTRICT 2 SURVEY OFFICE (USE ONLY)

PERSONNEL

REFERENCE NO. 43

SHEET 21 OF 46

NOTES

HOMAN

DATE 7/21/09

ROUTE SR 101

H.C.

HOMAN

WEATHER SUNNY

COUNTY SENECA

R.C.

ROUSOS

TEMP. 85°

TOWNSHIP ADAMS

SECTION 20

T 3 N R 16 E

TYPE MONUMENT P.K./WASHER


ON SURFACE - ~~BELOW~~ ON

LEFT - ℄ PAV'T - RIGHT ON

TO EDGE PAVEMENT

S.L.M. 531+16

GRID: NORTHING: 563802.158 EASTING: 1818022.005

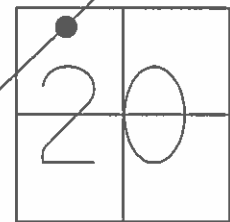

RECORD:

STA. 21+50
FD P.K.NAIL
ATOP R.R.SPIKE
SET P.K./WASHER
8/27/90
FD P.K./WASHER
2/7/05, SAH
SET MAG/WASHER
10/5/09, DCH

FD SHI
18' LOCUST




30.31'

FD SHI
18' LOCUST



35.20'

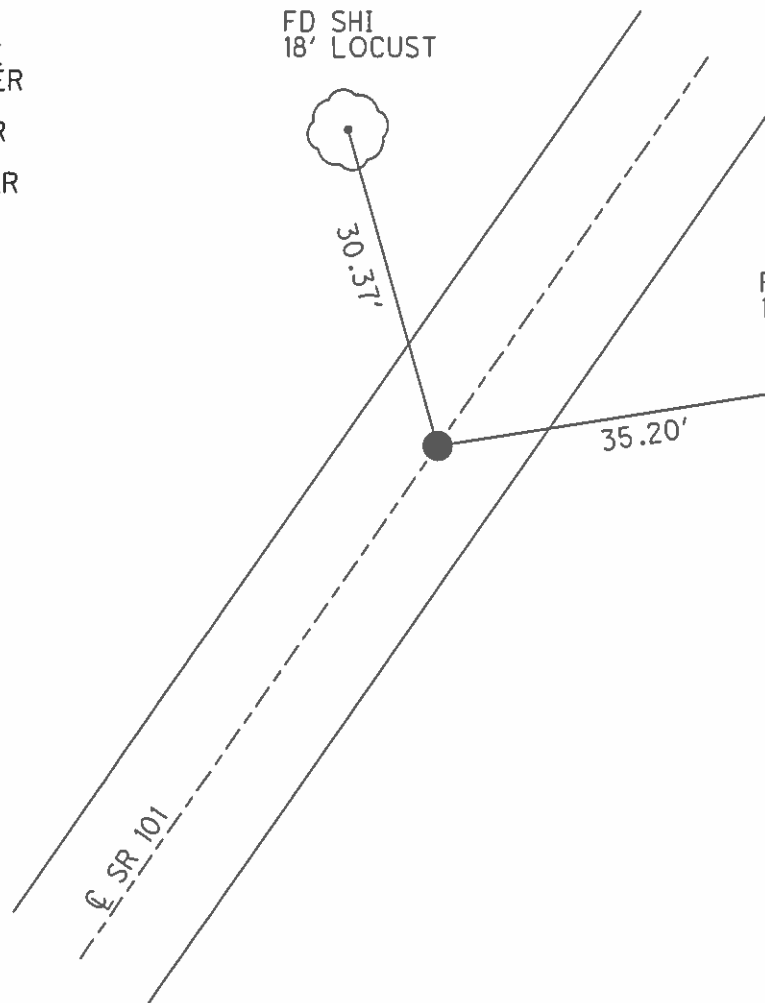

O.D.O.T. DISTRICT 2 SURVEY OFFICE

PERSONNEL

REFERENCE NO. 43

SHEET 17 OF 41

NOTES RIPPLE

H.C. BARBOUR

R.C. GEYMAN

DATE 8/27/90

WEATHER SUNNY

TEMP. 92°

ROUTE SR#101

COUNTY SENECA

TOWNSHIP ADAMS

SECTION 20


T. 3 N R. 16 E

TYPE MONUMENT Set P.K. & washer
ON SURFACE - BELOW PK. A Top RR spike

LEFT - CL PAV'T. - RIGHT


 TO EDGE PAVEMENT

S.L.M.

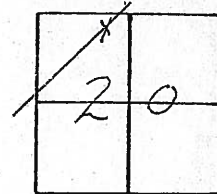

531 +16

21 +50

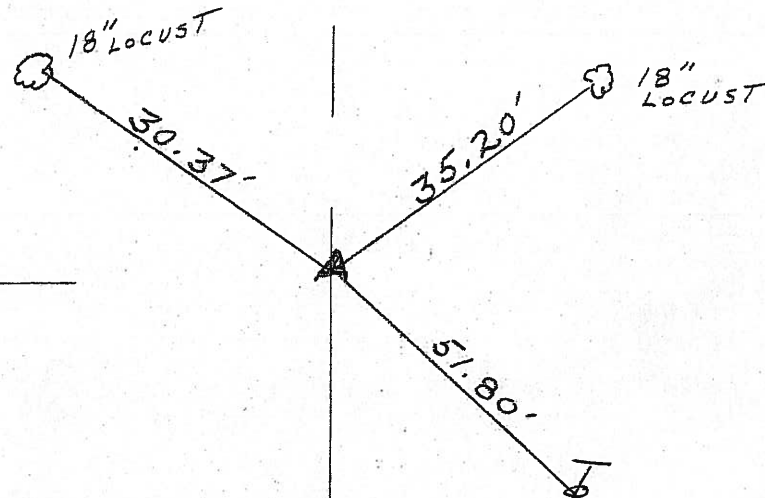

CL R/W SR#101

Fd

2-7-05

SAH

O.D.O.T. DISTRICT 2 SURVEY OFFICE

PERSONNEL

REFERENCE NO. 43

SHEET 17 OF 41

NOTES RIPPLE

H.C. BARBOUR

R.C. GEYMAN

DATE 8/27/90

WEATHER SUNNY

TEMP. 92°

ROUTE SR#101

COUNTY SENECA

TOWNSHIP ADAMS

SECTION 20

T.3 N R.16 E


TYPE MONUMENT Set P.K. & washer

ON SURFACE - BELOW P.K. A Top RR spike

LEFT - CL PAV'T. - RIGHT

 TO EDGE PAVEMENT

S.L.M.

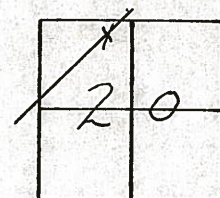

18" LOCUST

30.37'

35.20'

18" LOCUST

51.80'

21+50

RR/w SR#101

County Seneca S.R. # 101

Township Adams

Section 20

T 3 N, R 16 E

Personnel Schneider

Mosser


Barbour

Date 6-26-79


Weather Fair

Temp. 70°

43

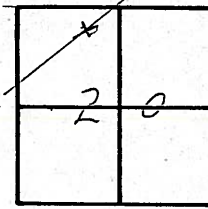

~~# 45~~

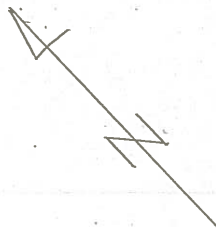


21+50

R.R. spk. on ϕ R/W

3" down

Reset P.K. Nail

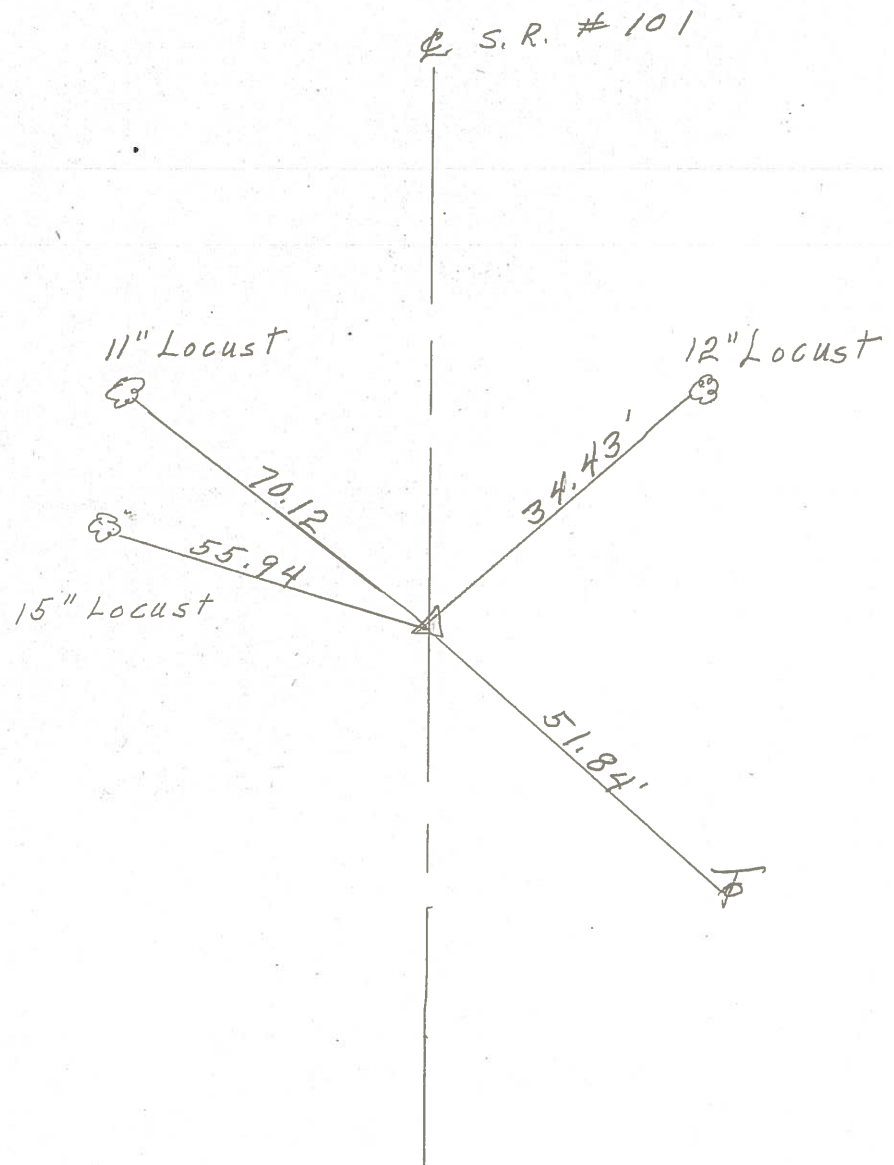

PERSONNEL TITLE PERSONNEL TITLE


COUNTY Seneca DATE 2-10-64S. R. 101 WEATHER _____

SEC. _____ TEMP. _____

DESCRIPTION LEFT CENTER LINE RIGHT JOB NO. _____


(42)

STA. 8+00
 Iron Pin
 # 391

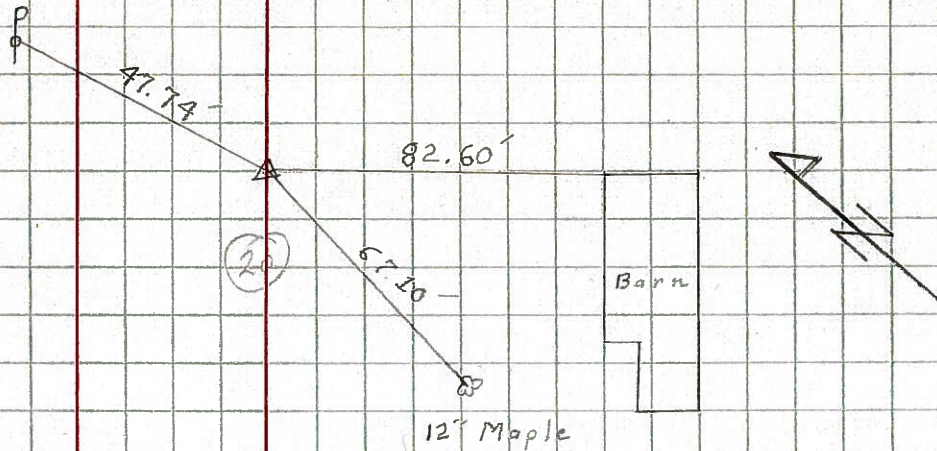


(43)

STA. 21+50
 Iron Pin
 # 392

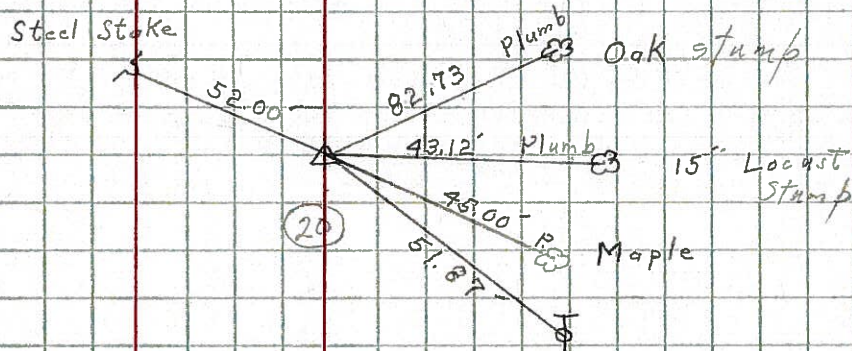

(44)

STA. 29+00
 Iron Pin
 # 393

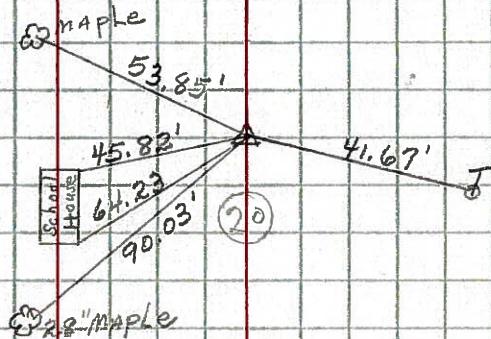

(45)

STA. 46+00
 Iron Pin
 # 394

