

O.D.O.T. DISTRICT 2 SURVEY OFFICE (USE ONLY)

PERSONNEL

REFERENCE NO. 44

SHEET 22 OF 46

NOTES MILLER

DATE 8/7/24

ROUTE SR 101

H.C. MILLER

WEATHER WINDY

COUNTY SENECA

R.C. BARRIERE

TEMP. 70°F

TOWNSHIP ADAMS

BLUBAUGH, ASTON, PRESTON-COLVIN

SECTION 20

DWG BY BLUBAUGH

PID 114849

T 3 N R 16 E

TYPE MONUMENT MAG/WASHER

ON SURFACE - ~~BELOW~~ 0.5"

OFFSET $\mathcal{C}$ PAVEMENT 3 1/2' LT : ~~RT~~

-- TO -- EDGE PAVEMENT

STATION: 538+80

HORZ.DATUM: NAD83 (2011)


GEOID: NAVD88-2018

GRID: NORTHING: 563802.121


EASTING: 1818022.071

LDP: NORTHING: 332800.360

EASTING: 192398.206

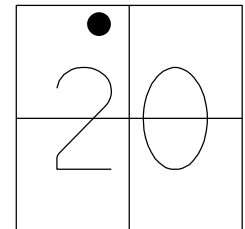

RECORD: P.I.
STA. 29+00
FD P.K./WASHER
ATOP R.R.SPIKE
SET P.K./WASHER
8/27/90
FD P.K./WASHER
2/7/05, SAH
FD P.K./WASHER
REF44
7/21/09, DCH
SET MAG/WASHER
NEWREF44
10/5/09, DCH
FD MAG/WASHER
REF44
6/14/16
9/18/17, JFO
FD MAG/WASHER
REF 44
9/25/19, JLL
8/02/21,
6/6/22, DSA
FD MAG/WASHER
REF44
12/14/23, JAM
FD TONE. DID NOT
UNCOVER. PAINTED
8/7/24
FD MAG/WASHER
REF 44
12/14/23, JAM
FD TONE. DID NOT
UNCOVER. PAINTED
8/7/24, JAM

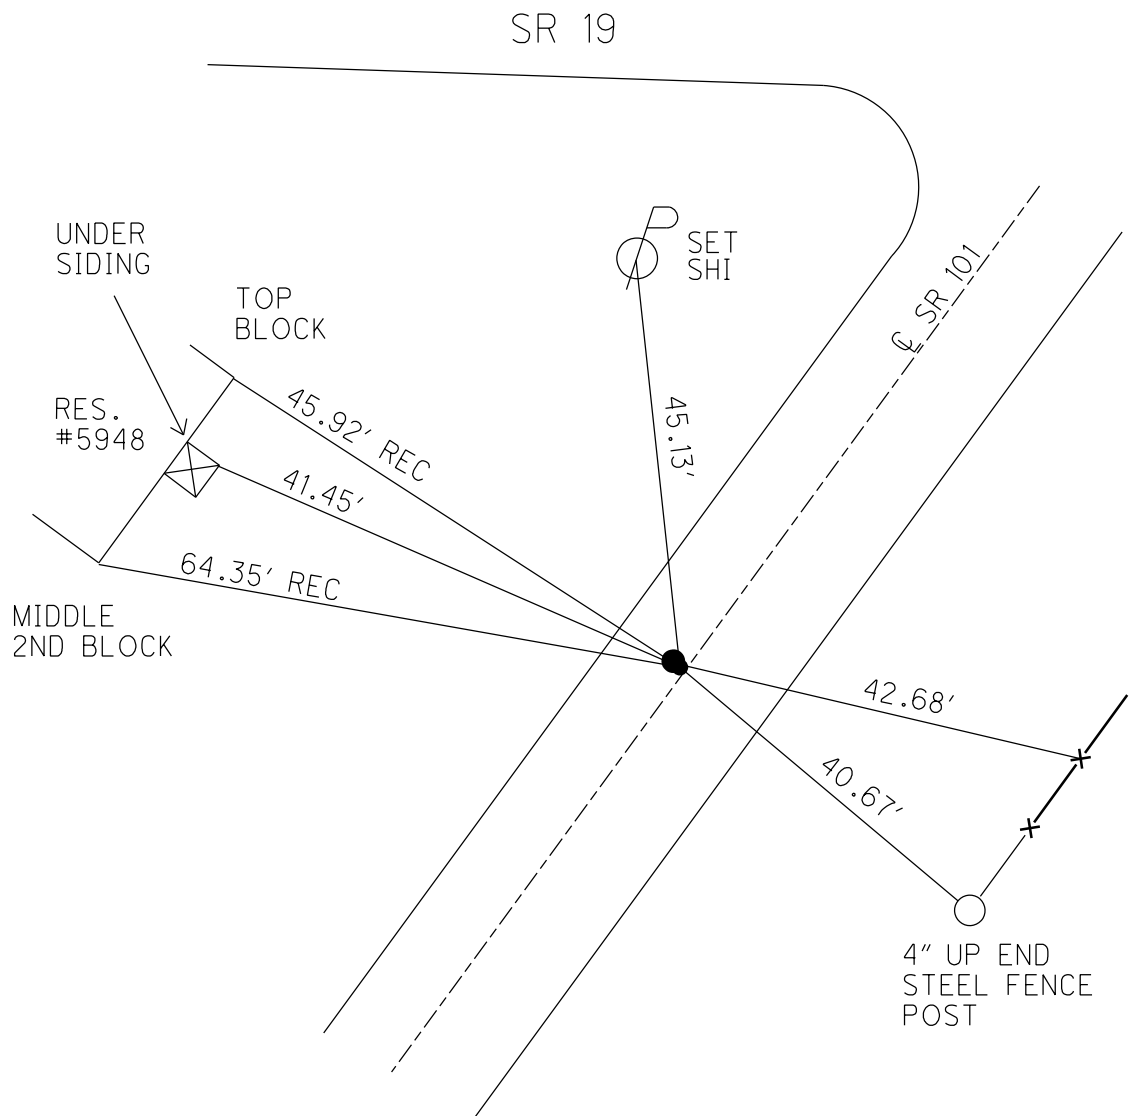

O.D.O.T. DISTRICT 2 SURVEY OFFICE (USE ONLY)

PERSONNEL

REFERENCE NO. 44

SHEET 22 OF 46

NOTES HOMAN

DATE 7-21-09

ROUTE SR 101

H.C. HOMAN

WEATHER SUNNY

COUNTY SENECA

R.C. ROUSOS

TEMP. 85°F

TOWNSHIP ADAMS

SECTION 20

DWG BY WHITAKER

PID 101165

T 3 N R 16 E

TYPE MONUMENT P.K./WASHER

ON SURFACE - ~~BELOW~~ ON

OFFSET Q PAVEMENT 3 1/2' LT : ~~RT~~

- TO - EDGE PAVEMENT


STATION: 538+80

HORIZ.DATUM: NAD83 (2011)


GEOID: NAVD88-2012A

GRID: NORTHING: 563802.121

EASTING: 1818022.071

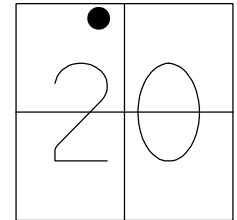

RECORD: P.I.
STA. 29+00
FD P.K./WASHER
ATOP R.R.SPIKE
SET P.K./WASHER
8/27/90
FD P.K./WASHER
2/7/05, SAH
FD P.K./WASHER
REF44
7/21/09, DCH
SET MAG/WASHER
NEWREF44
10/5/09, DCH
FD MAG/WASHER
REF44
6/14/16
9/18/17, JFO
FD MAG/WASHER
REF 44
9/25/19, JLL
8/02/21,
6/6/22, DSA

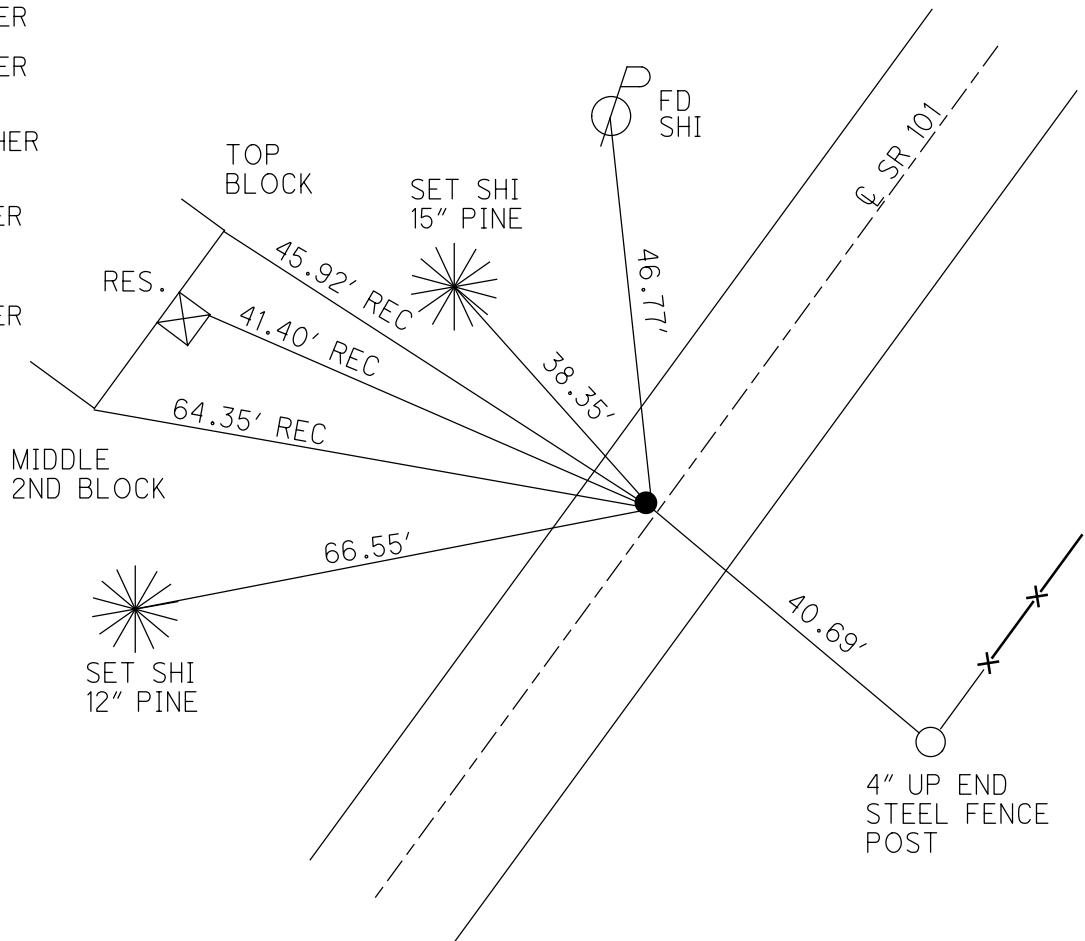

O.D.O.T. DISTRICT 2 SURVEY OFFICE (USE ONLY)

PERSONNEL

REFERENCE NO. 44

SHEET 22 OF 46

NOTES HOMAN

DATE 7-21-09

ROUTE SR 101

H.C. HOMAN

WEATHER SUNNY

COUNTY SENECA

R.C. ROUSOS

TEMP. 85°F

TOWNSHIP ADAMS

DWG BY MAHLER PID 100787

SECTION 20

T 3 N R 16 E

TYPE MONUMENT P.K./WASHER

ON SURFACE - ~~BELOW~~ ON

OFFSET ℄ PAVEMENT 3 1/2' LT : ~~RT~~

- TO - EDGE PAVEMENT


STATION: 538+80

HORIZ.DATUM: NAD83 (2011)


GEOID: NAVD88-2012A

GRID: NORTHING: 563802.131

EASTING: 1818022.068

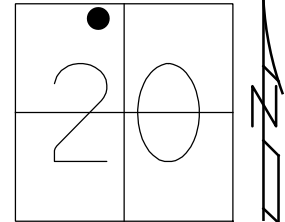

RECORD: P.I.
STA. 29+00
FD P.K./WASHER
ATOP R.R.SPIKE
SET P.K./WASHER
8/27/90
FD P.K./WASHER
2/7/05, SAH
FD P.K./WASHER
REF44
7/21/09, DCH
SET MAG/WASHER
NEWREF44
10/5/09, DCH
FD MAG/WASHER
REF44
6/14/16
9/18/17, JFO

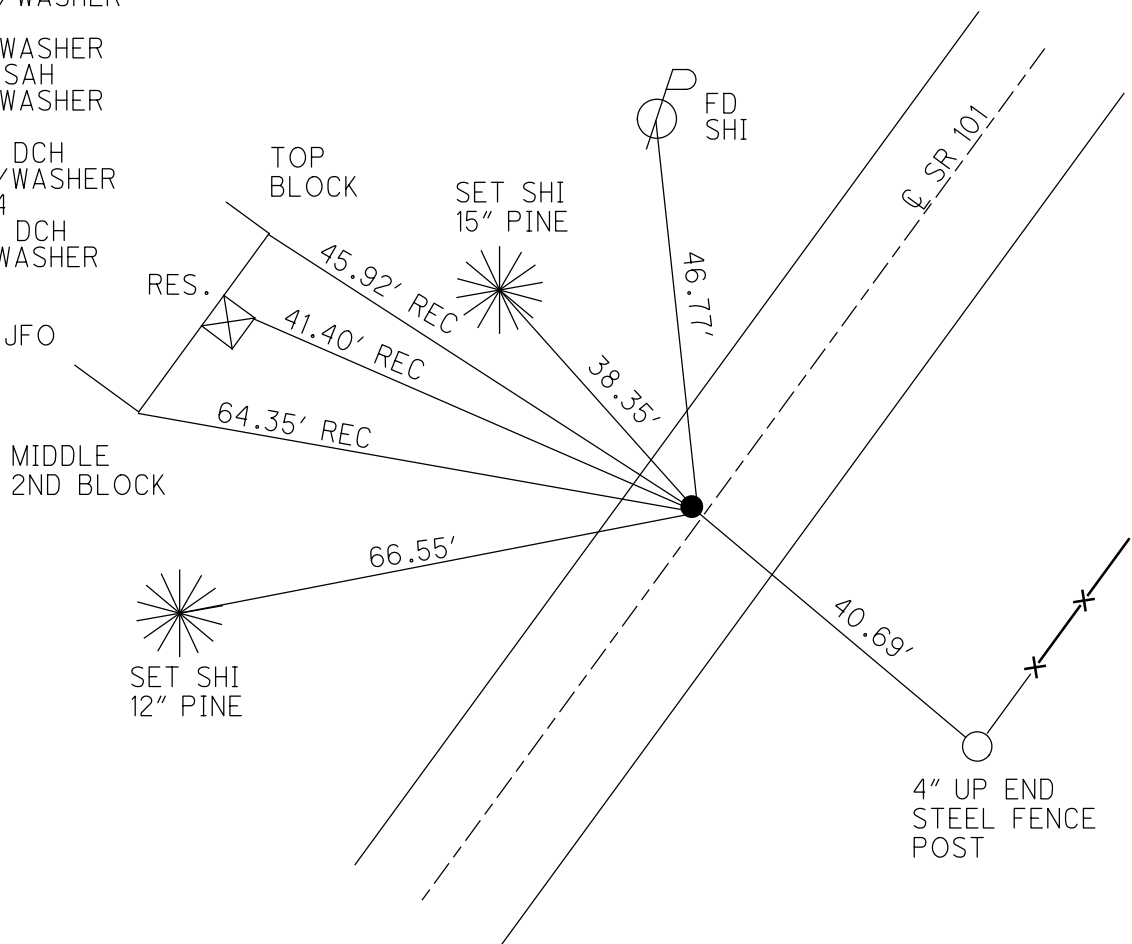


O.D.O.T. DISTRICT 2 SURVEY OFFICE (USE ONLY)


PERSONNEL	REFERENCE NO. <u>44</u>	SHEET <u>22</u> OF <u>46</u>
NOTES	DATE <u>7/21/09</u>	ROUTE <u>SR 101</u>
H.C. <u>HOMAN</u>	WEATHER <u>SUNNY</u>	COUNTY <u>SENECA</u>
R.C. <u>ROUSOS</u>	TEMP. <u>85°</u>	TOWNSHIP <u>ADAMS</u>
		SECTION <u>20</u>
		T <u>3</u> N R <u>16</u> E

TYPE MONUMENT P.K./WASHER
 ON SURFACE - ~~BELOW~~ ON
 LEFT - Q PAV'T - ~~RIGHT~~ 3 1/2'
 - TO - EDGE PAVEMENT
 S.L.M. 538+80

GRID: NORTHING: 563802.131 EASTING: 1818022.068

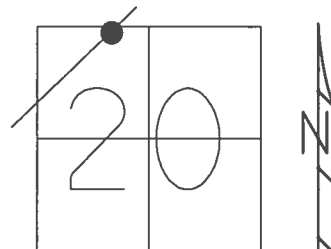

RECORD: P.I.
 STA. 29+00
 FD P.K./WASHER
 ATOP R.R.SPIKE
 SET P.K./WASHER
 8/27/90
 FD P.K./WASHER
 2/7/05, SAH
 SET MAG/WASHER
 10/5/09, DCH
 FD MAG/WASHER
 REF44
 6/14/16, JFO
 UNCOVERED
 9/18/17, JFO

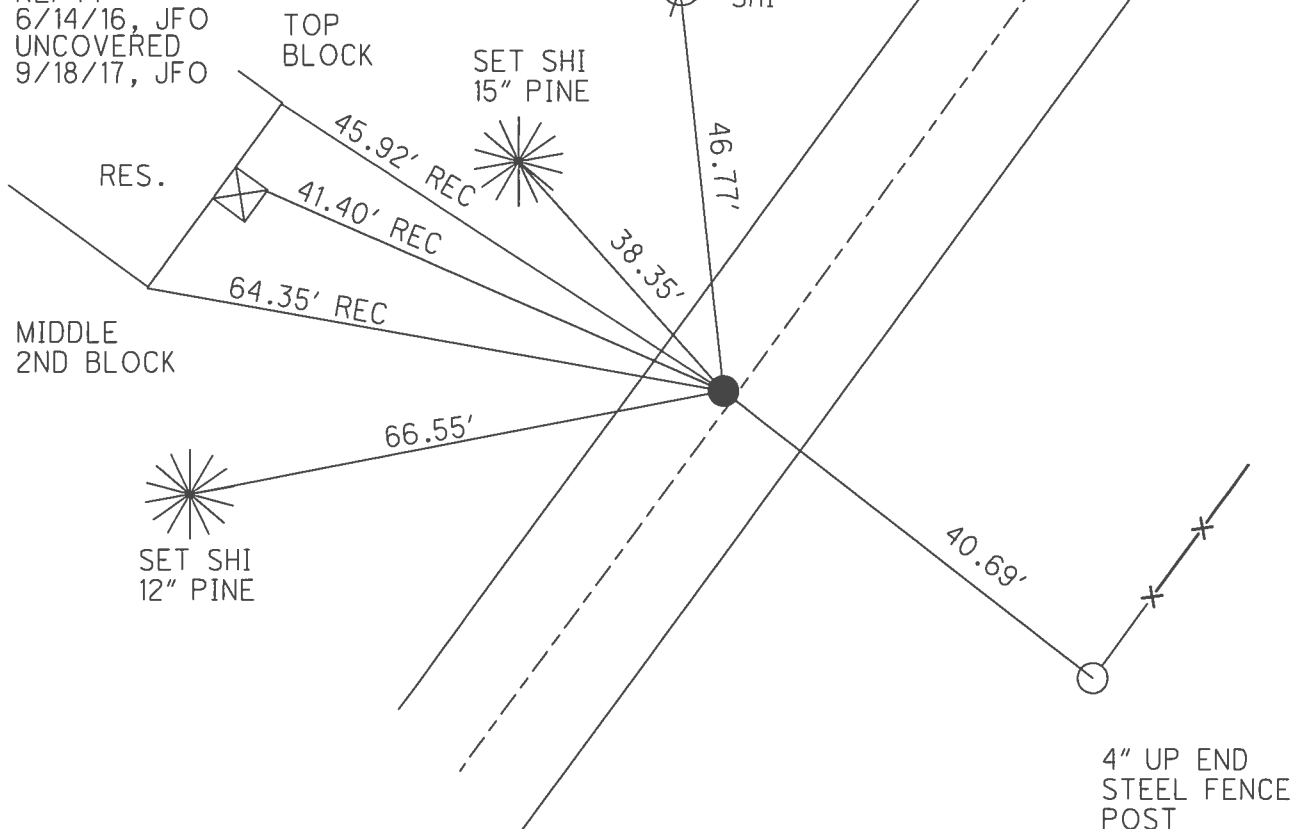

O.D.O.T. DISTRICT 2 SURVEY OFFICE (USE ONLY)

PERSONNEL

REFERENCE NO. 44


SHEET 22 OF 46

NOTES
H.C. HOMAN
R.C. ROUSOS

DATE 7/21/09
WEATHER SUNNY
TEMP. 85°


ROUTE SR 101
COUNTY SENECA
TOWNSHIP ADAMS
SECTION 20
T 3 N R 16 E

TYPE MONUMENT P.K./WASHER
ON SURFACE - ~~BELOW~~ ON
LEFT - C PAV'T - ~~RIGHT~~ 3 1/2'
- TO - EDGE PAVEMENT
S.L.M. 538+80

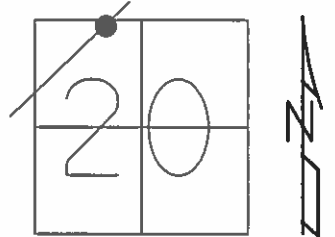

GRID: NORTHING: 564794.494 EASTING: 1819399.969

RECORD: P.I.
STA. 29+00
FD P.K./WASHER
ATOP R.R.SPIKE
SET P.K./WASHER
8/27/90
FD P.K./WASHER
2/7/05, SAH
SET MAG/WASHER
10/5/09, DCH

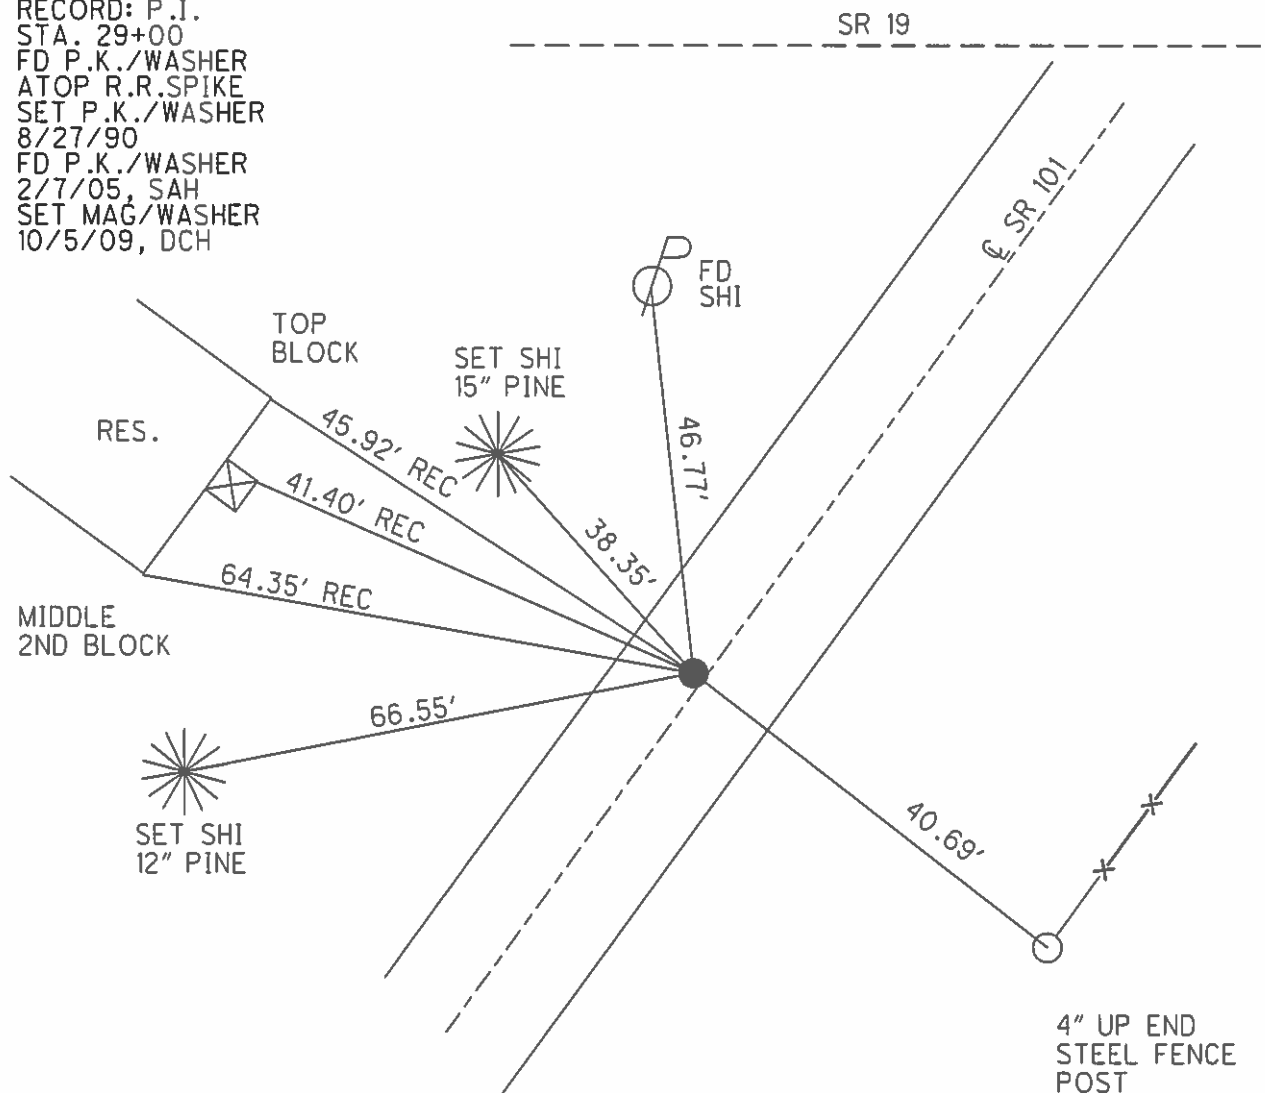

O.D.O.T. DISTRICT 2 SURVEY OFFICE

PERSONNEL

REFERENCE NO. 44

SHEET 18 OF 41

NOTES RIPPLE

H.C. BARBOUR

R.C. GEYMAN

DATE 8/27/90

WEATHER SUNNY

TEMP. 92°

ROUTE SR#101




COUNTY SENECA

TOWNSHIP ADAMS

SECTION 20

T3 N R 16 E

TYPE MONUMENT Set P.K. & washer
ON SURFACE - BELOW P.K. & washer at top RR spike
LEFT - PAV'T. - RIGHT 3 1/2' LT. of PAV'T.
TO EDGE PAVEMENT
S.L.M. _____

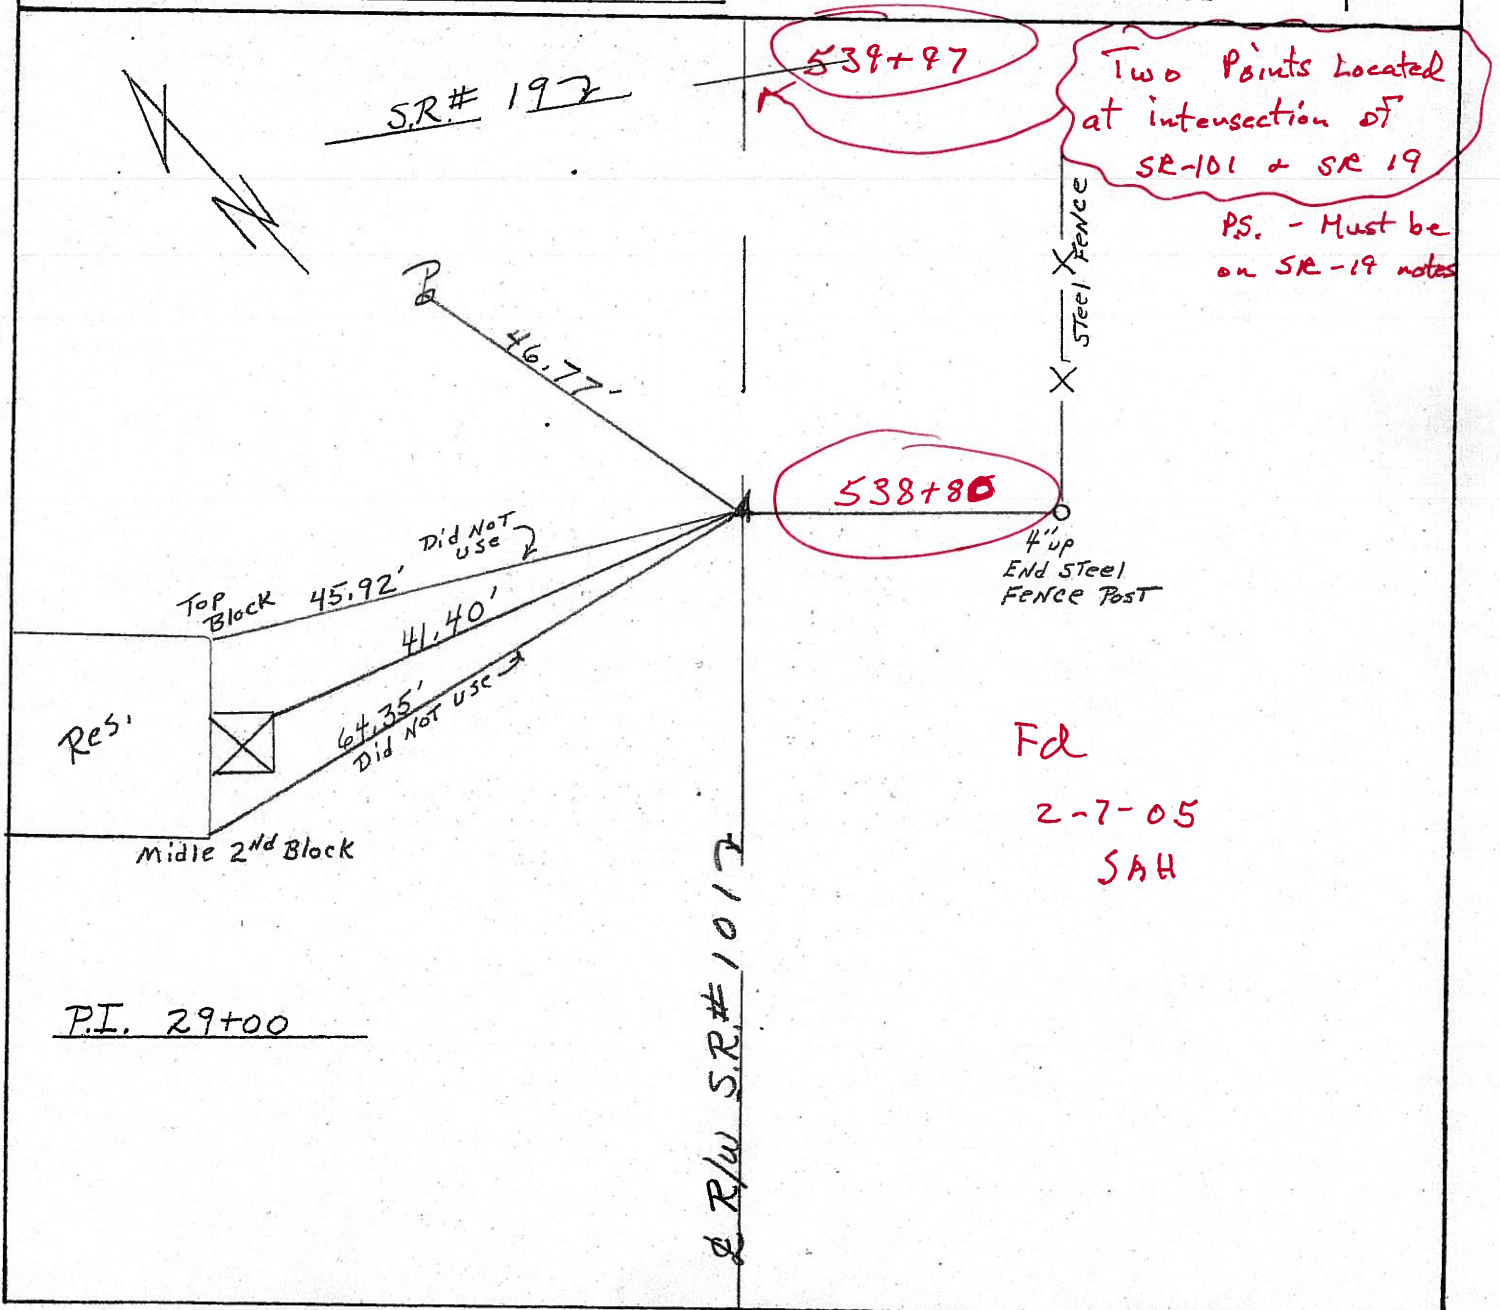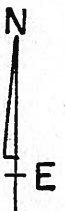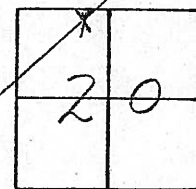

O.D.O.T. DISTRICT 2 SURVEY OFFICE

PERSONNEL

REFERENCE NO. 44

SHEET 18 OF 41

NOTES Ripple

H.C. BARBOUR

R.C. Geyman

DATE 8/27/90

WEATHER SUNNY

TEMP. 92°

ROUTE SR#101



COUNTY Seneca

TOWNSHIP Adams

SECTION 20

T3 N R 16 E

TYPE MONUMENT Set P.K. & washer
ON SURFACE - BELOW P.K. & washer at top RR. spike
LEFT - & PAV'T. - RIGHT 3 1/2' LT. of & PAV'T.
_____ TO _____ EDGE PAVEMENT
S.L.M. _____

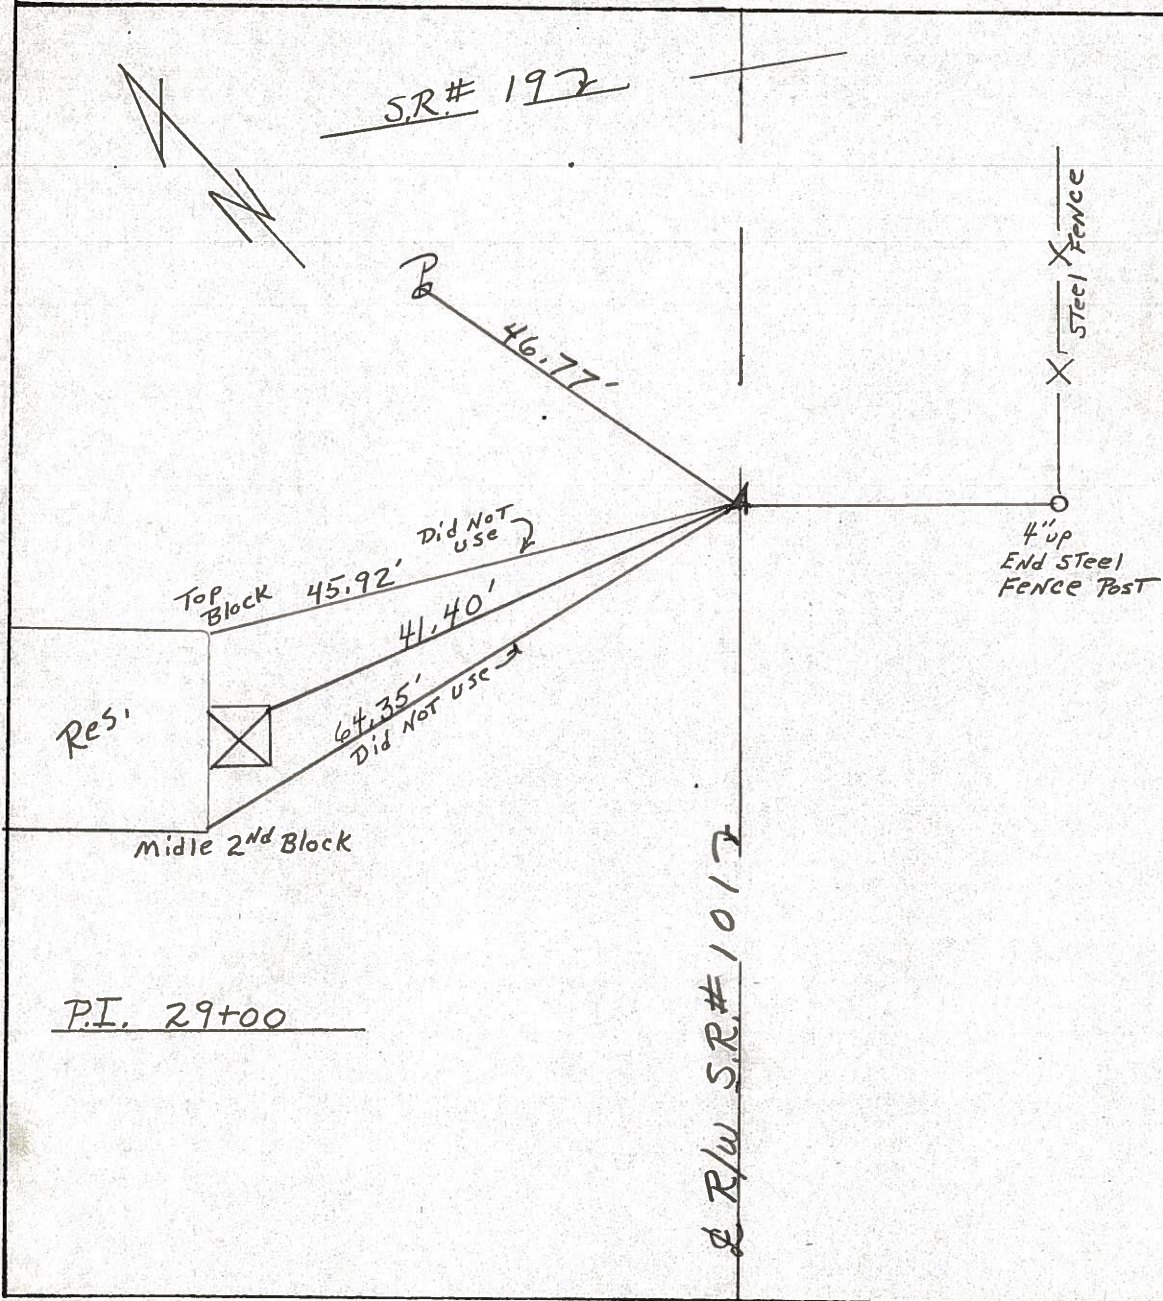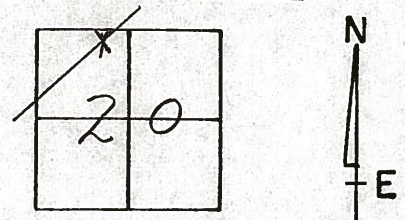

County Seneca S.R. # 101

Township Adams

Section 20

T 3 N, R 16 E

Personnel Schneider


Messer

Barbour

Date 6-26-79

Weather Fair

Temp. 70°

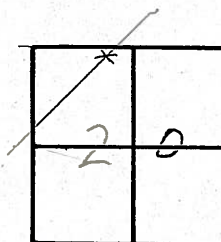

(44)

~~#43-D~~

P.I.


29+00

R.R. spk. on $\perp$ R/W

1 1/2" down

Reset P.K. Nail

3' Lt. of $\perp$

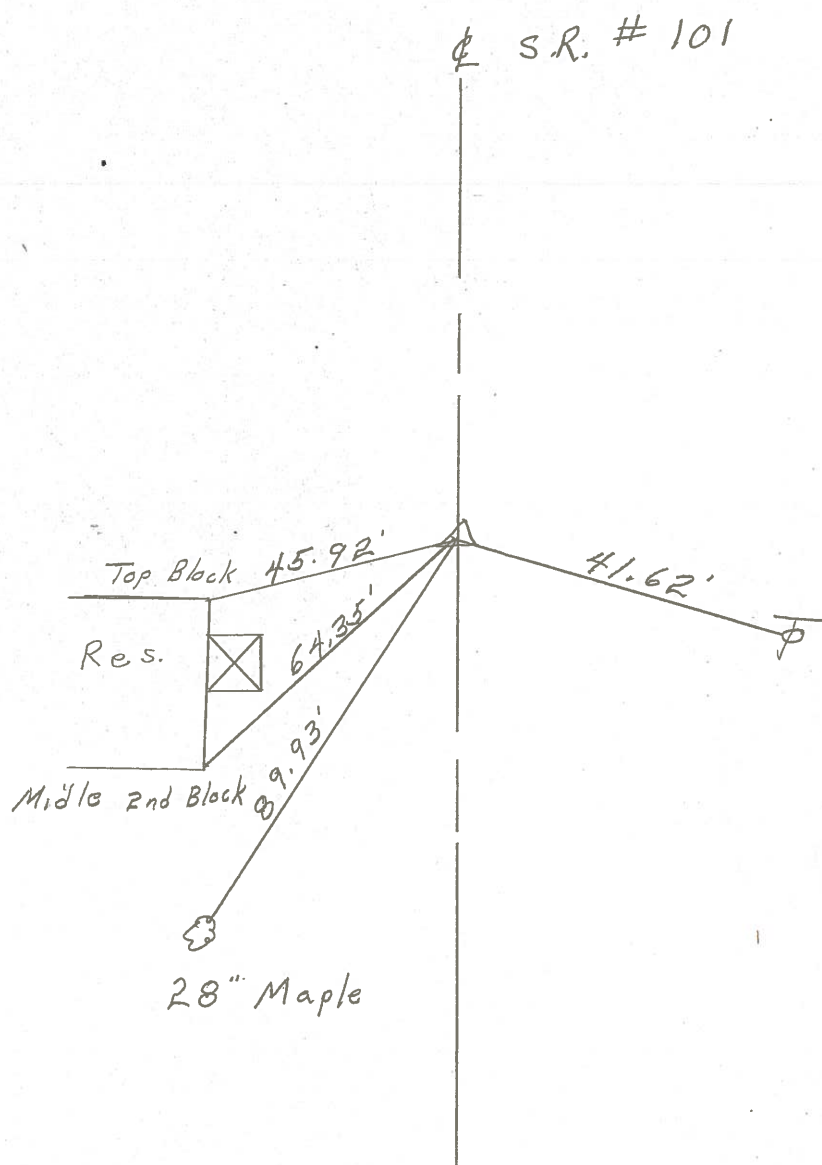

PERSONNEL	TITLE	PERSONNEL	TITLE
Krabill			
Kowaleski			
Geymahr			
Bruggeman			

COUNTY Seneca DATE 2-10-64


S. R. 101 WEATHER _____

SEC. _____ TEMP. _____

DESCRIPTION _____ LEFT _____ CENTER LINE _____ RIGHT _____ JOB NO. _____


(42)

STA. 8+00
Iron Pin
391

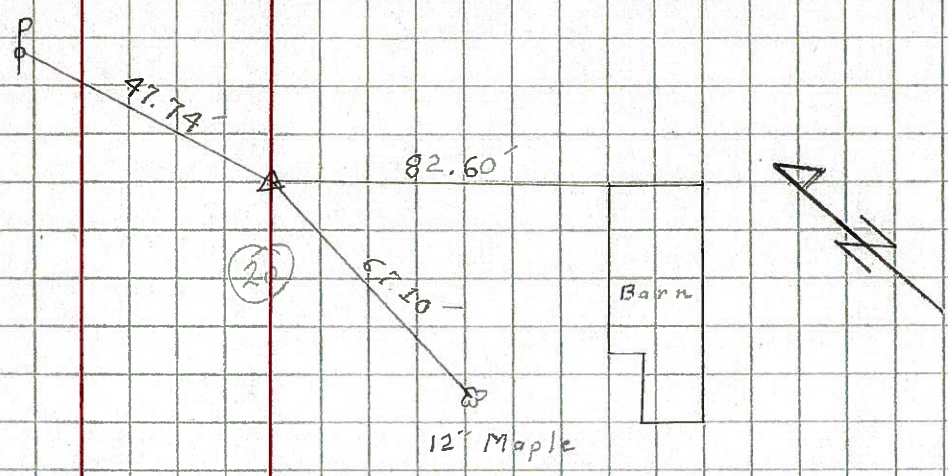


(43)

STA. 21+50
Iron Pin
392

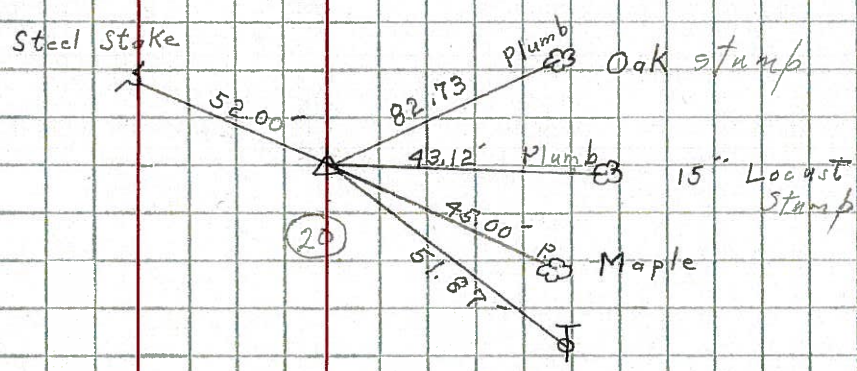

(44)

STA. 29+00
Iron Pin
393

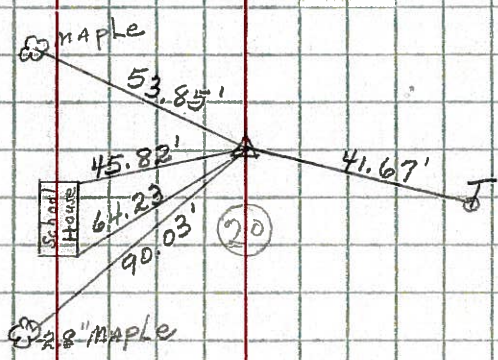

(45)

STA. 46+00
IRON PIN
394

