

O.D.O.T. DISTRICT 2 SURVEY OFFICE (USE ONLY)

PERSONNEL

REFERENCE NO. 45

SHEET 23 OF 46

NOTES MILLER

DATE 8/7/24

ROUTE SR 101

H.C. MILLER

WEATHER WINDY

COUNTY SENECA

R.C. BARRIERE

TEMP. 70°F

TOWNSHIP ADAMS

BLUBAUGH, ASTON, PRESTON-COLVIN

SECTION 17

DWG BY BLUBAUGH

PID 114849

T 3 N R 16 E

TYPE MONUMENT MAG/WASHER

ON SURFACE - ~~BELOW~~ 0.5"

OFFSET Q PAVEMENT 1' LT : RT

-- TO -- EDGE PAVEMENT

STATION: 555+77

HORIZ.DATUM: NAD83 (2011)


GEOID: NAVD88-2018

GRID: NORTHING: 564794.453


EASTING: 1819400.025

LDP: NORTHING: 333803.017

EASTING: 193768.882

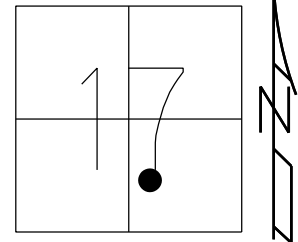

RECORD:
 STA. 46+00
 FD P.K.NAIL
 ATOP R.R.SPIKE
 SET P.K./WASHER
 8/27/90, BARBOUR
 FD P.K./WASHER
 2/7/05, SAH
 FD P.K./WASHER
 REF45
 7/21/09, DCH
 SET MAG/WASHER
 NEWREF45
 10/5/09, DCH
 FD MAG/WASHER
 REF45
 6/14/16
 9/18/17, JFO
 FD MAG/WASHER
 REF 45
 9/25/19, JLL
 6/6/22, DSA
 FD MAG/WASHER
 REF 45
 12/14/23, JAM
 FD TONE. DID NOT
 UNCOVER. PAINTED
 8/7/24, JAM

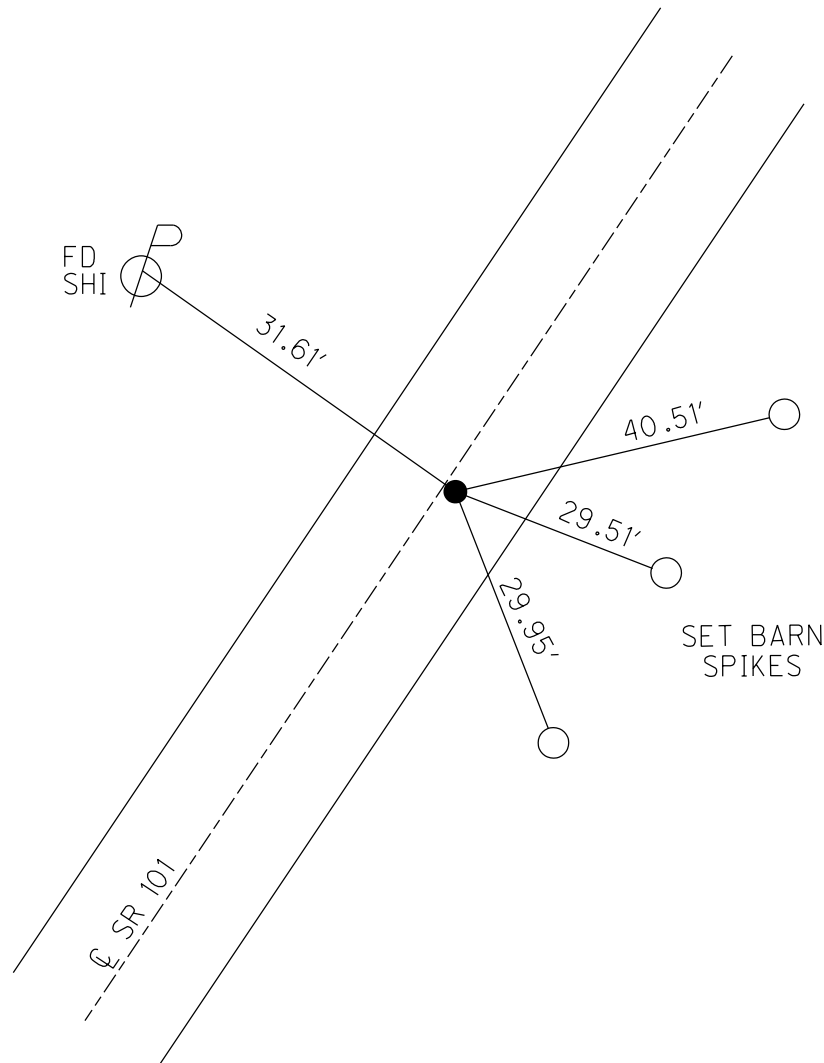

O.D.O.T. DISTRICT 2 SURVEY OFFICE (USE ONLY)

PERSONNEL

REFERENCE NO. 45

SHEET 23 OF 46

NOTES HOMAN

DATE 7-21-09

ROUTE SR 101

H.C. HOMAN

WEATHER SUNNY

COUNTY SENECA

R.C. ROUSOS

TEMP. 85°F

TOWNSHIP ADAMS

SECTION 17

DWG BY WHITAKER

PID 101165

T 3 N R 16 E

TYPE MONUMENT P.K./WASHER

ON SURFACE - ~~BELOW~~ ON

OFFSET CL PAVEMENT 1' ~~LT~~ : RT

- TO - EDGE PAVEMENT


STATION: 555+77

HORZ.DATUM: NAD83 (2011)


GEOID: NAVD88-2012A

GRID: NORTHING: 564794.453

EASTING: 1819400.025

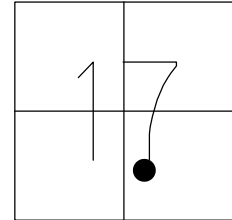

RECORD:
STA. 46+00
FD P.K.NAIL
ATOP R.R.SPIKE
SET P.K./WASHER
8/27/90, BARBOUR
FD P.K./WASHER
2/7/05, SAH
FD P.K./WASHER
REF45
7/21/09, DCH
SET MAG/WASHER
NEWREF45
10/5/09, DCH
FD MAG/WASHER
REF45
6/14/16
9/18/17, JFO
FD MAG/WASHER
REF 45
9/25/19, JLL
6/6/22, DSA

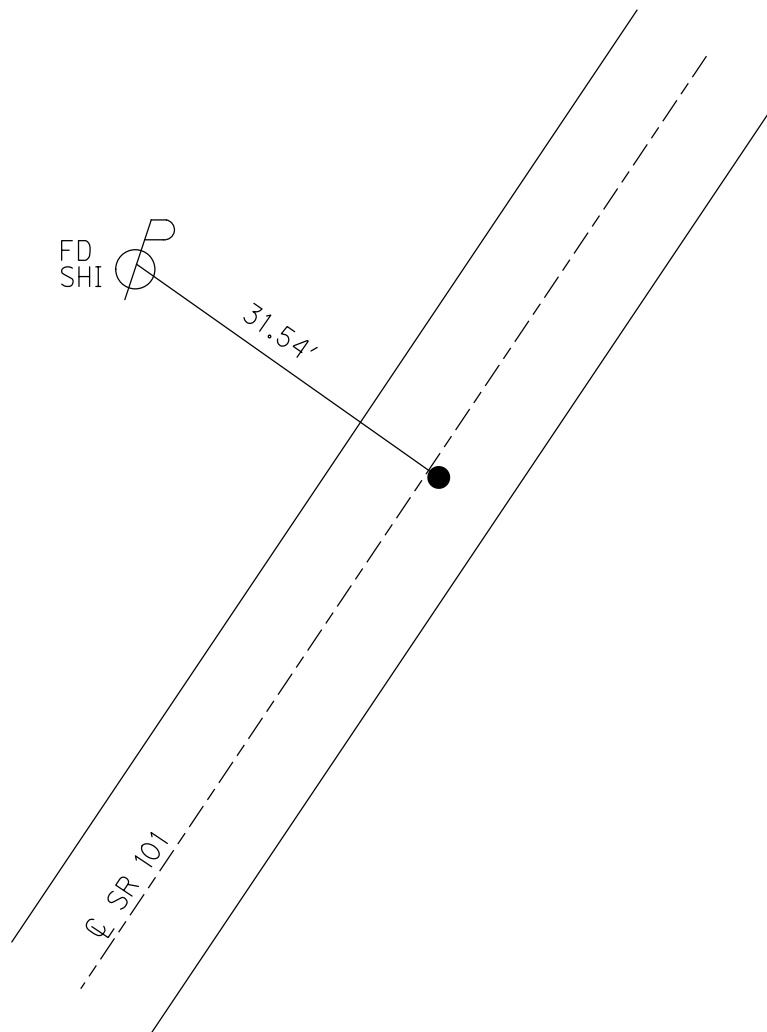

O.D.O.T. DISTRICT 2 SURVEY OFFICE (USE ONLY)

PERSONNEL

REFERENCE NO. 45

SHEET 23 OF 46

NOTES HOMAN

DATE 7-21-09

ROUTE SR 101

H.C. HOMAN

WEATHER SUNNY

COUNTY SENECA

R.C. ROUSOS

TEMP. 85°F

TOWNSHIP ADAMS

SECTION 17

DWG BY MAHLER PID 100787

T 3 N R 16 E

TYPE MONUMENT P.K./WASHER

ON SURFACE - ~~BELOW~~ ON

OFFSET CL PAVEMENT 1' LT : RT

- TO - EDGE PAVEMENT


STATION: 555+77

HORZ.DATUM: NAD83 (2011)

GEOID: NAVD88-2012A


GRID: NORTHING: 564794.453

EASTING: 1819400.009

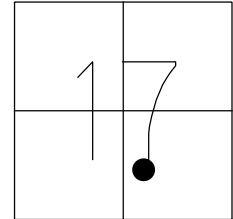

RECORD:

STA. 46+00
FD P.K.NAIL
ATOP R.R.SPIKE
SET P.K./WASHER
8/27/90, BARBOUR
FD P.K./WASHER
2/7/05, SAH
FD P.K./WASHER
REF45
7/21/09, DCH
SET MAG/WASHER
NEWREF45
10/5/09, DCH
FD MAG/WASHER
REF45
6/14/16
9/18/17, JFO

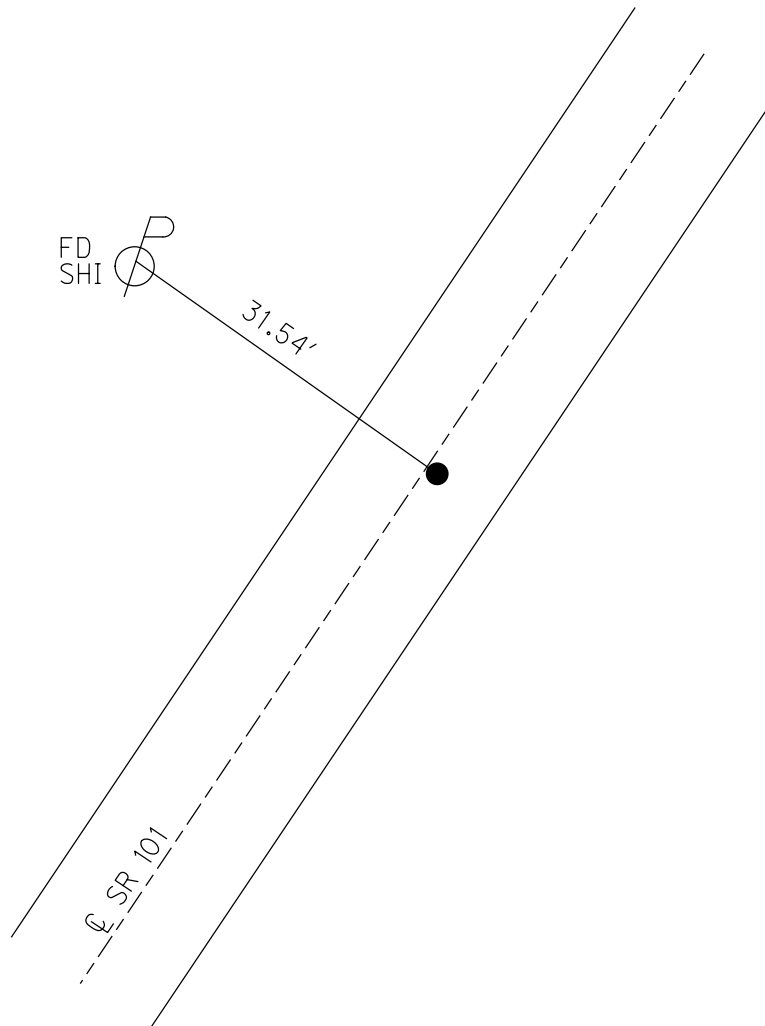


O.D.O.T. DISTRICT 2 SURVEY OFFICE (USE ONLY)


PERSONNEL	REFERENCE NO. <u>45</u>	SHEET <u>23</u> OF <u>46</u>
NOTES	DATE <u>7/21/09</u>	ROUTE <u>SR 101</u>
H.C. <u>HOMAN</u>	WEATHER <u>SUNNY</u>	COUNTY <u>SENECA</u>
R.C. <u>ROUSOS</u>	TEMP. <u>85°</u>	TOWNSHIP <u>ADAMS</u>
		SECTION <u>17</u>
		T <u>3</u> N R <u>16</u> E

TYPE MONUMENT P.K./WASHER
 ON SURFACE - ~~BELOW~~ ON
~~LEFT~~ - C PAV'T - RIGHT 2'
- TO - EDGE PAVEMENT
 S.L.M. 555+77

GRID: NORTHING: 564794.453 EASTING: 1819400.009

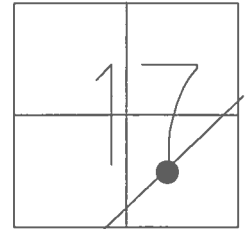

RECORD:
 STA. 46+00
 FD P.K.NAIL ATOP
 R.R.SPIKE
 SET P.K./WASHER
 8/27/90
 FD P.K./WASHER
 2/7/05, SAH
 SET MAG/WASHER
 10/5/09, DCH
 FD MAG/WASHER
 REF45
 6/14/16, JFO
 UNCOVERED
 9/18/17, JFO

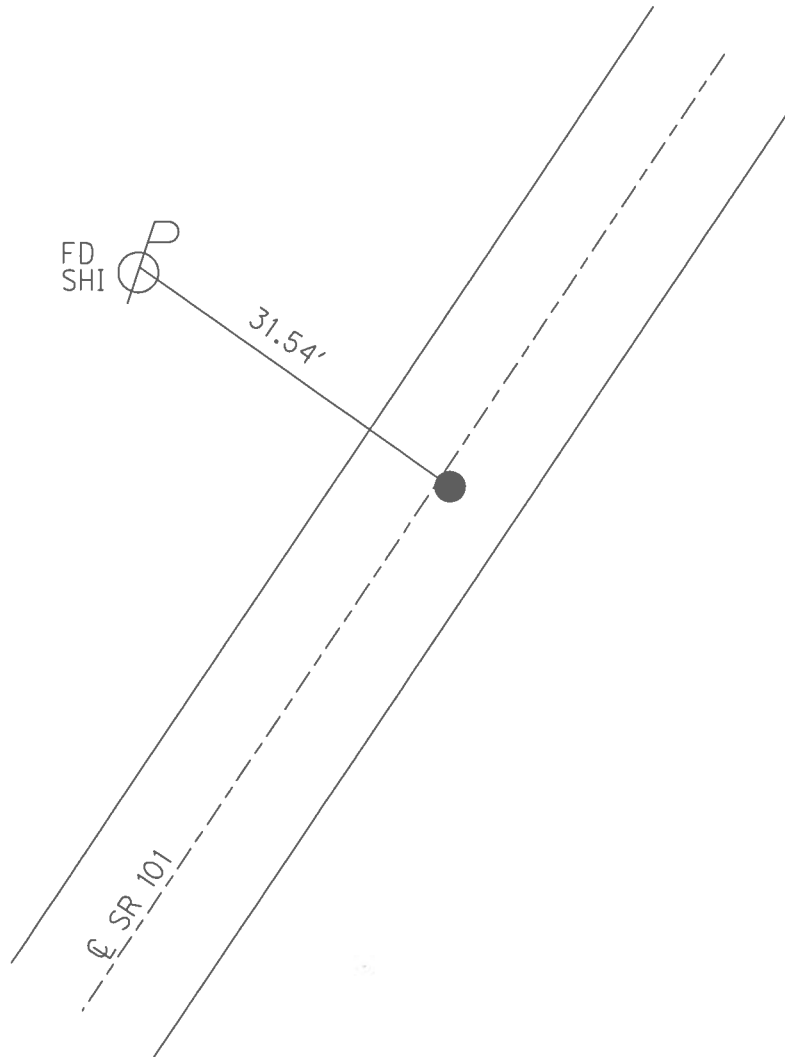


O.D.O.T. DISTRICT 2 SURVEY OFFICE (USE ONLY)


PERSONNEL _____ REFERENCE NO. 45 SHEET 23 OF 46
 NOTES HOMAN DATE 7/21/09 ROUTE SR 101
 H.C. HOMAN WEATHER SUNNY COUNTY SENECA
 R.C. ROUSOS TEMP. 85° TOWNSHIP ADAMS
 SECTION 17
 T 3 N R 16 E

TYPE MONUMENT P.K./WASHER
 ON SURFACE - ~~BELOW~~ ON
~~LEFT~~ - Q PAV'T - RIGHT 1'
- TO - EDGE PAVEMENT
 S.L.M. 555+77

GRID: NORTHING: 565434.376 EASTING: 1820169.692

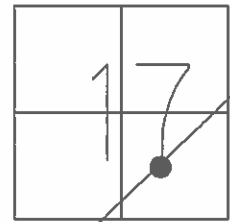

RECORD:
 STA. 46+00
 FD P.K.NAIL ATOP
 R.R.SPIKE
 SET P.K./WASHER
 8/27/90
 FD P.K./WASHER
 2/7/05, SAH
 SET MAG/WASHER
 10/5/09, DCH

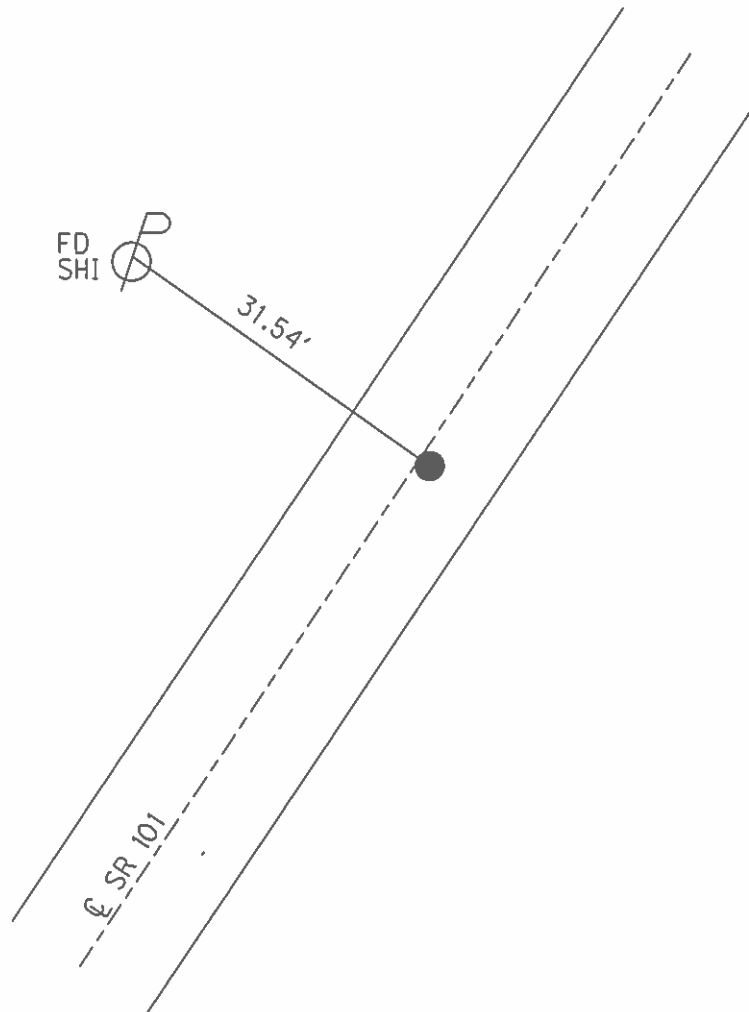

O.D.O.T. DISTRICT 2 SURVEY OFFICE

PERSONNEL

REFERENCE NO. 45

SHEET 19 OF 41

NOTES RIPPLE

H.C. BARBOUR

R.C. GEYMAN

DATE 8/27/90

WEATHER SUNNY

TEMP. 92°

ROUTE SR. #101

COUNTY SENECA

TOWNSHIP ADAMS

SECTION 17


T. 3 N. R. 16 E.

TYPE MONUMENT SET P.K. & WASHER
ON SURFACE - BELOW P.K. NAIL AT TOP RR SPIKE


LEFT - 1' RT. & PAV'T.

TO EDGE PAVEMENT

S.L.M. _____

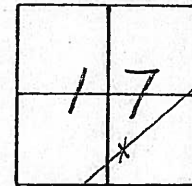

555 + 17

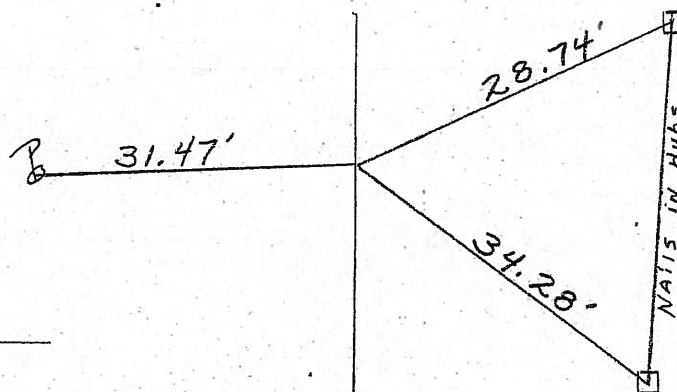

46 + 00

& R/W SR # 101

FL
2-2-05
SAH

O.D.O.T. DISTRICT 2 SURVEY OFFICE

PERSONNEL

REFERENCE NO. 45

SHEET 19 OF 41

NOTES RIPPLE

H.C. BARBOUR

R.C. GEYMAN

DATE 8/27/90

WEATHER SUNNY

TEMP. 92°

ROUTE S.R. #101



COUNTY SENECA

TOWNSHIP ADAMS

SECTION 17

T 3 N R 16 E

TYPE MONUMENT SET P.K. & WASHER
ON SURFACE - BELOW P.K. NAIL AT TOP RR SPIKE
LEFT - & PAV'T. - RIGHT 1' RT. & PAV'T.
____ TO ____ EDGE PAVEMENT
S.L.M. _____

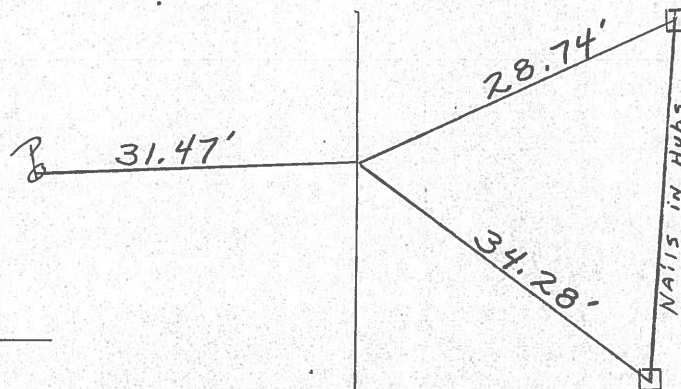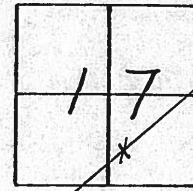

46+00

& R/W SR # 1017

County Seneca S.R. # 101

Township Adams

Section 17

T 3 N, R 16 E

Personnel Schneider

Messer



Barbour

Date 6-26-79

Weather Fair

Temp. 70°

(45)

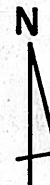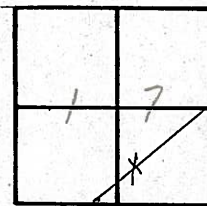


~~#46~~

46+00

R.R. spk. on & R/w

Reset P.K. Nail

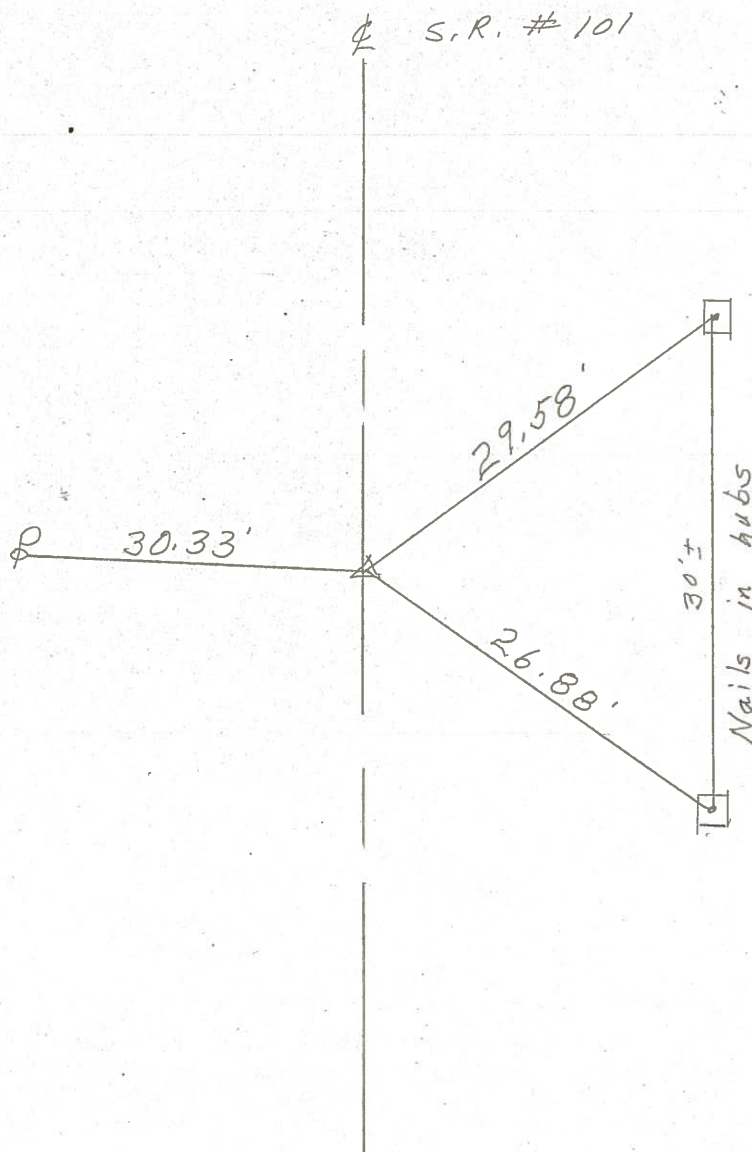


PERSONNEL	TITLE	PERSONNEL	TITLE	COUNTY	DATE	WEATHER
Krabill				Seneca	2-10-69	
Kowaleski				S. R. 101		
Geyman				SEC.		TEMP.
Bruggeman						

DESCRIPTION	LEFT	CENTER LINE	RIGHT	JOB NO.
-------------	------	-------------	-------	---------


(42)

STA. 8+00
Iron Pin
391

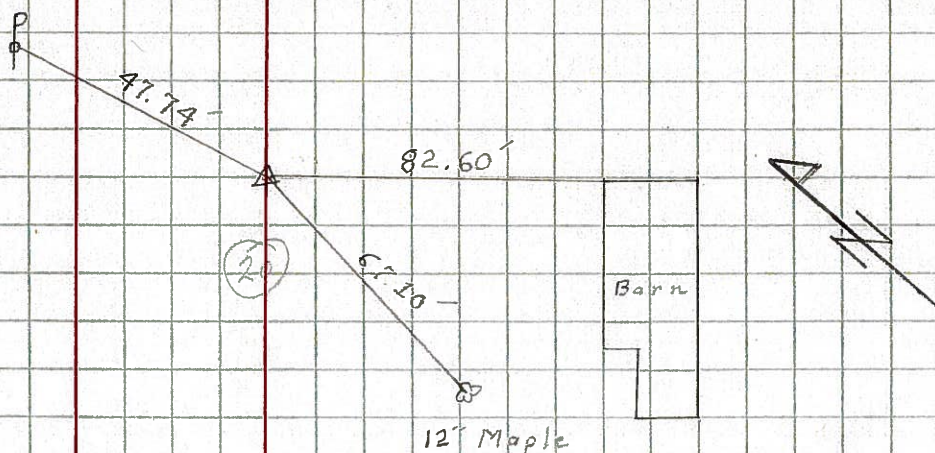


(43)

STA. 21+50
Iron Pin
392

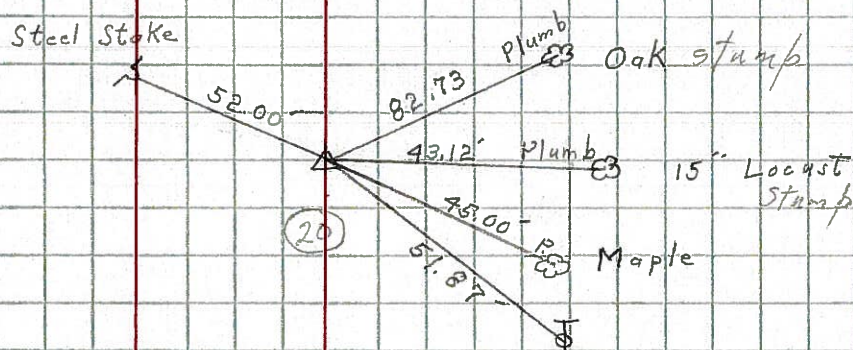

(44)

STA. 29+00
Iron Pin
393

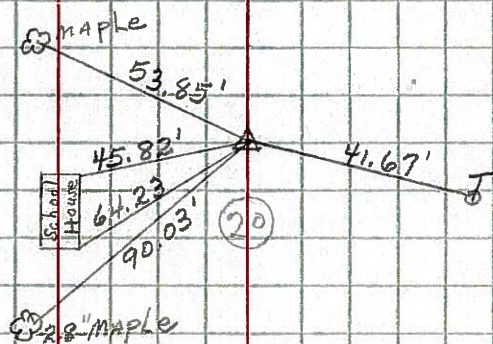

(45)

STA. 46+00
Iron Pin
394

