

O.D.O.T. DISTRICT 2 SURVEY OFFICE (USE ONLY)

PERSONNEL

REFERENCE NO. 46

SHEET 24 OF 46

NOTES MILLER

DATE 8/7/24

ROUTE SR 101

H.C. MILLER

WEATHER WINDY

COUNTY SENECA

R.C. BARRIERE

TEMP. 70°F

TOWNSHIP ADAMS

BLUBAUGH, ASTON, PRESTON-COLVIN

SECTION 17

DWG BY BLUBAUGH

PID 114849

T 3 N R 16 E

TYPE MONUMENT MAG/WASHER

ON SURFACE - ~~BELOW~~ ON

OFFSET $\mathcal{C}$ PAVEMENT 1.5' LT : RT

-- TO -- EDGE PAVEMENT

STATION: 565+79

HORZ.DATUM: NAD83 (2011)


GEOID: NAVD88-2018

GRID: NORTHING: 565434.287


EASTING: 1820169.785

LDP: NORTHING: 334448.639

EASTING: 194533.851

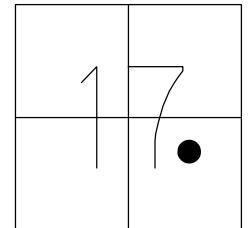

RECORD:
STA. 56+00
FD P.K.NAIL
ATOP R.R.SPIKE
SET P.K./WASHER
8/28/90
FD P.K./WASHER
2/7/05, SAH
FD P.K./WASHER
REF46
7/28/09, DCH
SET MAG/WASHER
NEWREF46
10/5/09, DCH
FD MAG/WASHER
REF46
6/14/16
9/18/17, JFO
REF46
12/13/23, JAM
FD TONE. DID NOT
UNCOVER. PAINTED
8/7/24, JAM

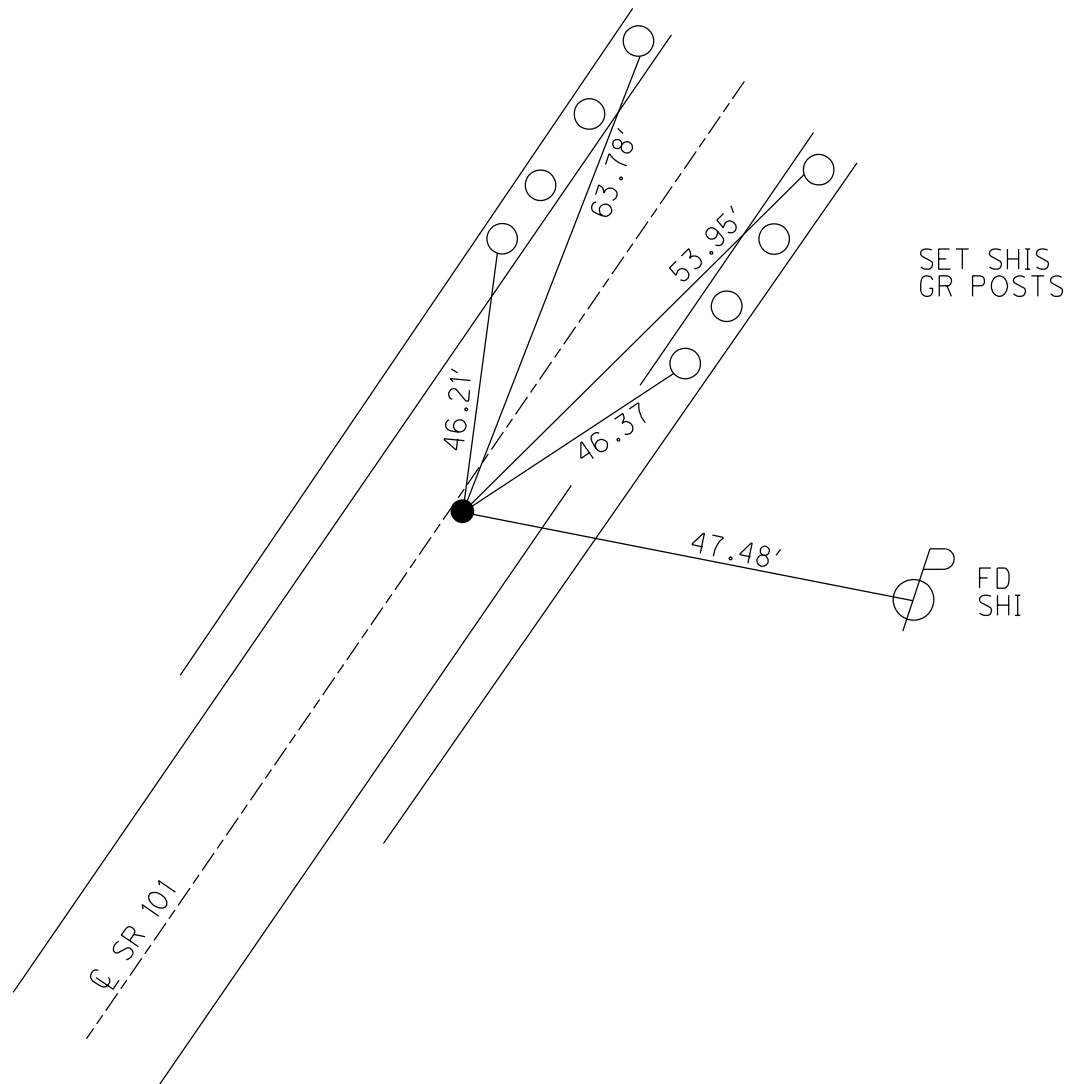

O.D.O.T. DISTRICT 2 SURVEY OFFICE (USE ONLY)

PERSONNEL

REFERENCE NO. 46

SHEET 24 OF 46

NOTES HOMAN

DATE 7-21-09

ROUTE SR 101

H.C. HOMAN

WEATHER SUNNY

COUNTY SENECA

R.C. ROUSOS

TEMP. 85°F

TOWNSHIP ADAMS

SECTION 17

DWG BY MAHLER PID 100787

T 3 N R 16 E

TYPE MONUMENT P.K./WASHER

ON SURFACE - ~~BELOW~~ ON

OFFSET 1.5' LT : RT

- TO - EDGE PAVEMENT


STATION: 565+79

HORIZ.DATUM: NAD83 (2011)


GEOID: NAVD88-2012A

GRID: NORTHING: 565434.287

EASTING: 1820169.785

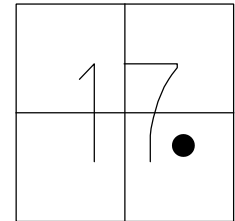


RECORD:
STA. 56+00
FD P.K.NAIL
ATOP R.R.SPIKE
SET P.K./WASHER
8/28/90
FD P.K./WASHER
2/7/05, SAH
FD P.K./WASHER
REF46
7/28/09, DCH
SET MAG/WASHER
NEWREF46
10/5/09, DCH
FD MAG/WASHER
REF46
6/14/16
9/18/17, JFO

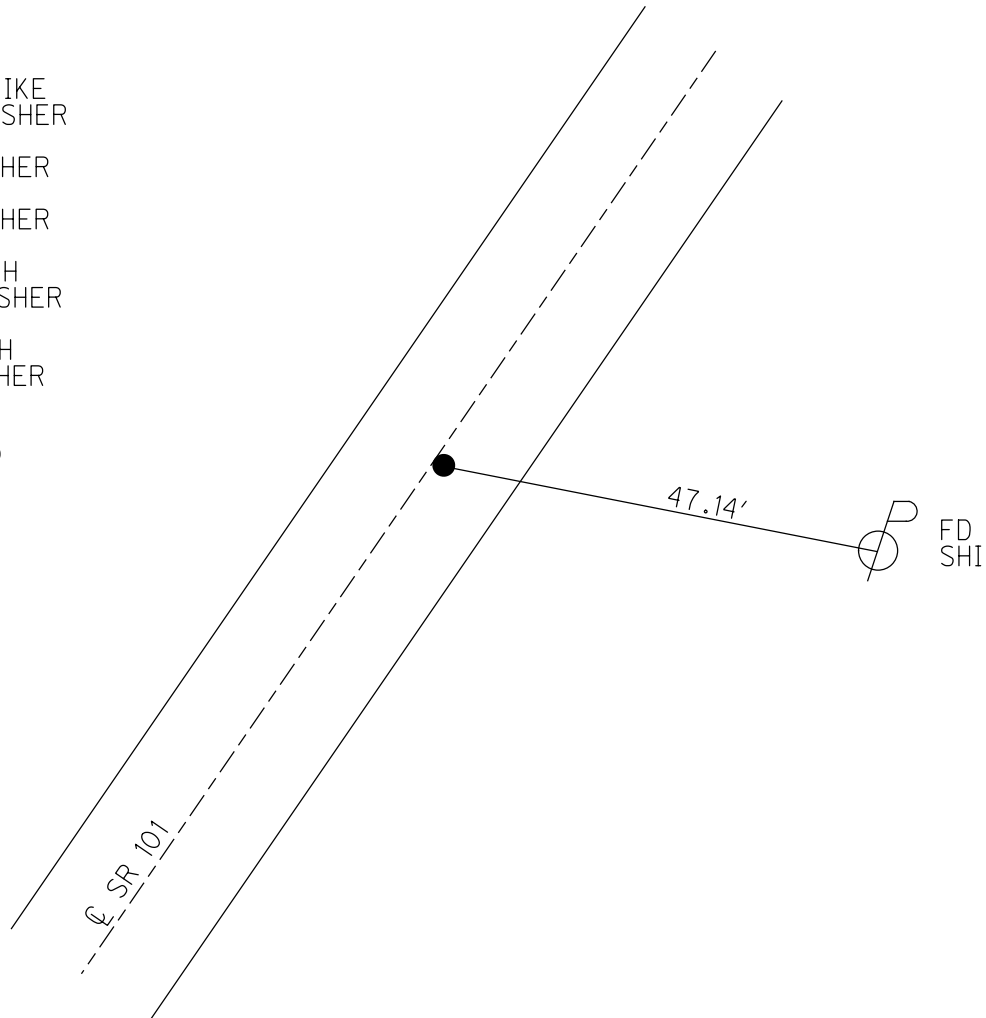

O.D.O.T. DISTRICT 2 SURVEY OFFICE (USE ONLY)


PERSONNEL _____ REFERENCE NO. 46 SHEET 24 OF 46
 NOTES HOMAN DATE 7/21/09 ROUTE SR 101
 H.C. HOMAN WEATHER SUNNY COUNTY SENECA
 R.C. ROUSOS TEMP. 85° TOWNSHIP ADAMS
 _____ SECTION 17
 _____ T 3 N R 16 E

TYPE MONUMENT P.K./WASHER
 ON SURFACE - ~~BELOW~~ ON
~~LEFT~~ - C PAV'T - RIGHT 1.5'
- TO - EDGE PAVEMENT
 S.L.M. 565+79

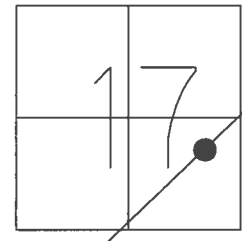

GRID: NORTHING: 565434.287 EASTING: 1820169.785

RECORD:
 STA. 56+00
 FD P.K.NAIL ATOP
 R.R.SPIKE
 SET P.K./WASHER
 8/28/90
 FD P.K./WASHER
 2/7/05, SAH
 SET MAG/WASHER
 10/5/09, DCH
 FD MAG/WASHER
 REF46
 6/14/16, JFO
 UNCOVERED
 9/18/17, JFO

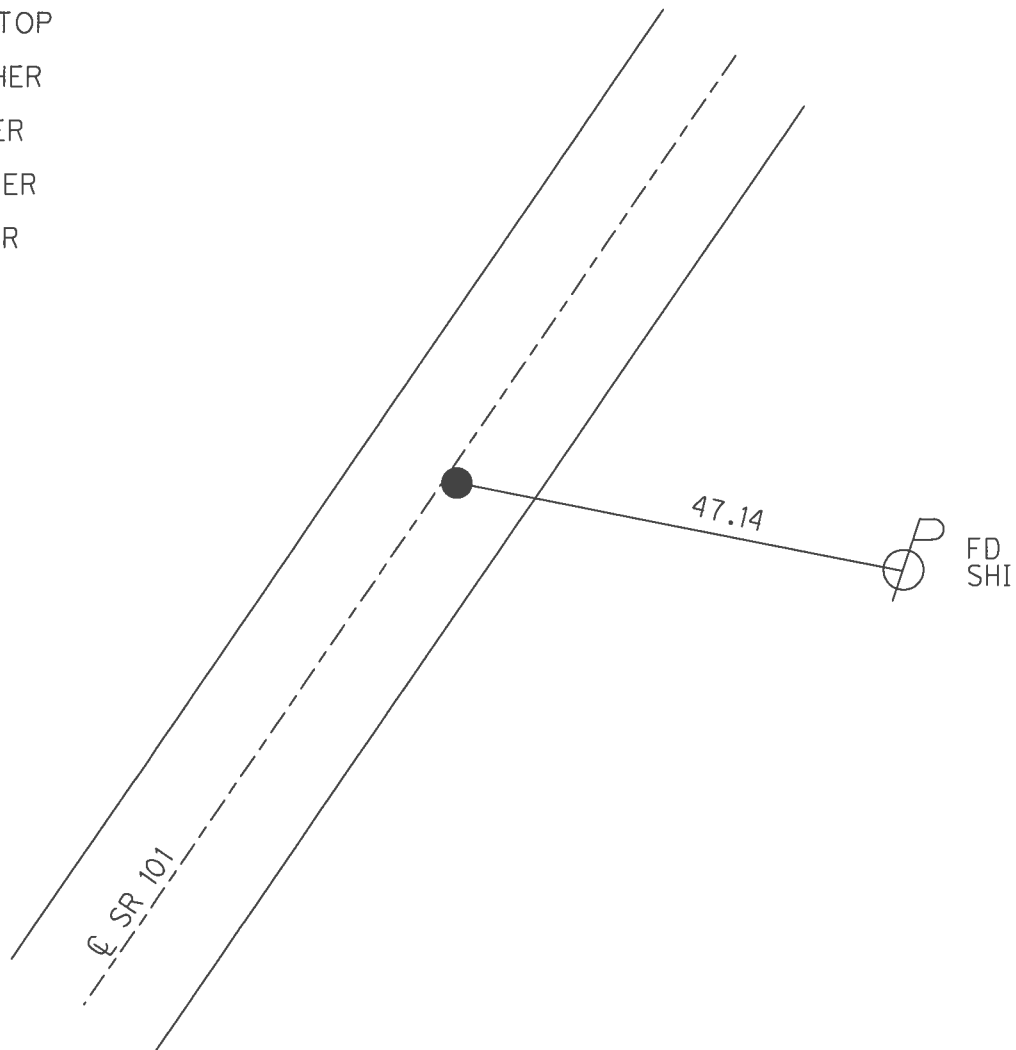


O.D.O.T. DISTRICT 2 SURVEY OFFICE (USE ONLY)


PERSONNEL _____ REFERENCE NO. 46 SHEET 24 OF 46
 NOTES HOMAN DATE 7/21/09 ROUTE SR 101
 H.C. HOMAN WEATHER SUNNY COUNTY SENECA
 R.C. ROUSOS TEMP. 85° TOWNSHIP ADAMS
 _____ SECTION 17
 T 3 N R 16 E

TYPE MONUMENT P.K./WASHER
 ON SURFACE - ~~BELOW~~ ON
~~LEFT~~ - CL PAV'T - RIGHT 1.5'
- TO - EDGE PAVEMENT
 S.L.M. 565+79

GRID: NORTHING: 565434.324 EASTING: 1820169.778

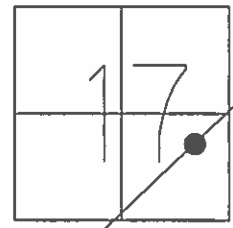

RECORD:
 STA. 56+00
 FD P.K. NAIL ATOP
 R.R. SPIKE
 SET P.K./WASHER
 8/28/90
 FD P.K./WASHER
 2/7/05, SAH
 SET MAG/WASHER
 10/5/09, DCH

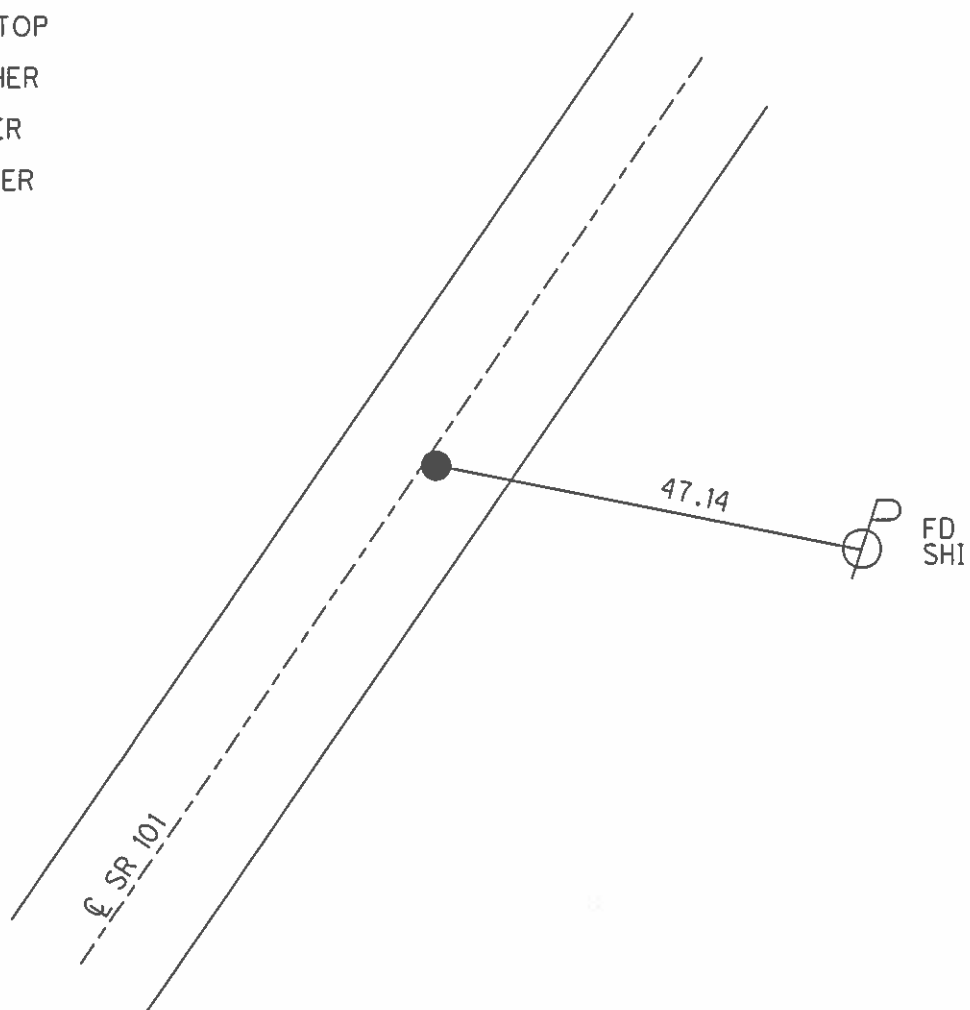

O.D.O.T. DISTRICT 2 SURVEY OFFICE

PERSONNEL

REFERENCE NO. 46

SHEET 20 OF 41

NOTES RIPPLE

H.C. BARBOUR

R.C. GEYMAN

DATE 8/28/90

WEATHER SUNNY

TEMP. 86°

ROUTE SR # 101



COUNTY SENECA

TOWNSHIP ADAMS

SECTION 17

T 3 N R 16 E

TYPE MONUMENT Set P.K. Nail & shiner
ON SURFACE - BELOW PK. Nail A Top RR spike
LEFT - CL PAV'T. - RIGHT 1.5' RT. CL PAV'T
TO EDGE PAVEMENT
S.L.M. _____

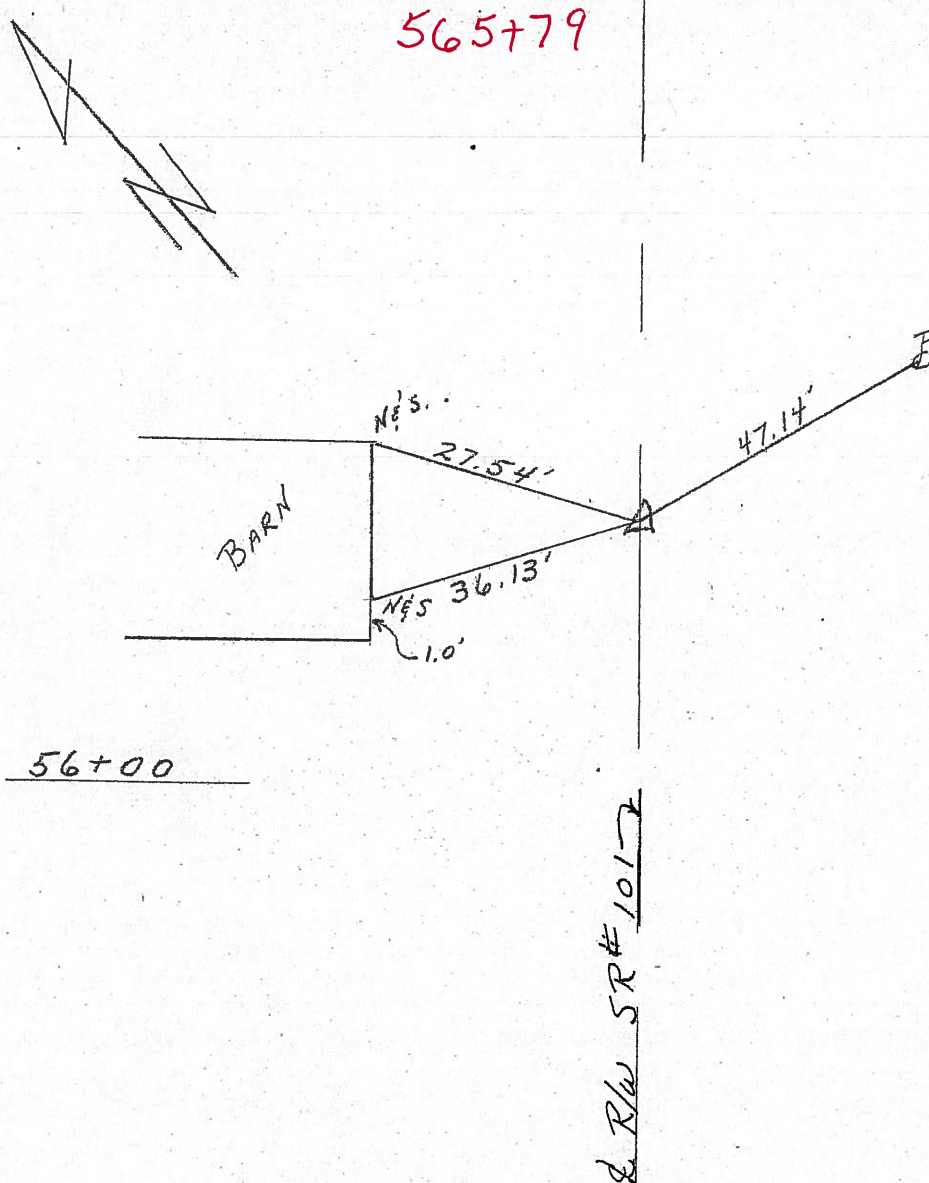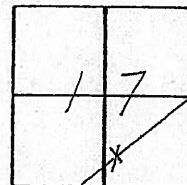

Fd
2-7-05
SAH

O.D.O.T. DISTRICT 2 SURVEY OFFICE

PERSONNEL

REFERENCE NO. 46

SHEET 20 OF 41

NOTES RIPPLE

H.C. BARBOUR

R.C. GEYMAN

DATE 8/28/90

WEATHER SUNNY

TEMP. 86°

ROUTE SR.# 101



COUNTY Seneca

TOWNSHIP Adams

SECTION 17

T.3 N R.16 E

TYPE MONUMENT Set P.K. Nail & shiner
ON SURFACE - BELOW PK. Nail A Top RR spike
LEFT - PAV'T. - RIGHT 1.5' RT. & PAV'T
TO EDGE PAVEMENT
S.L.M.

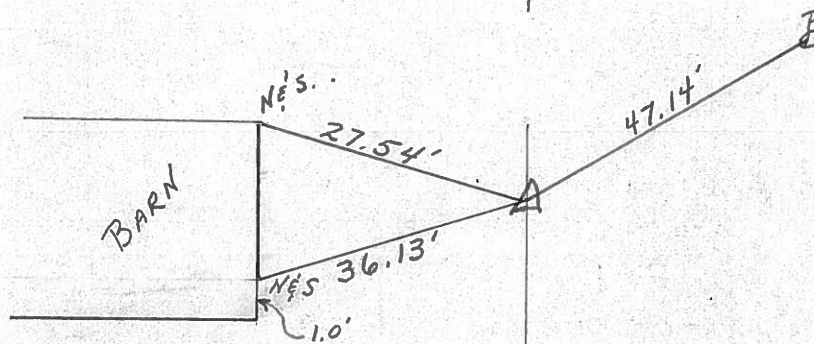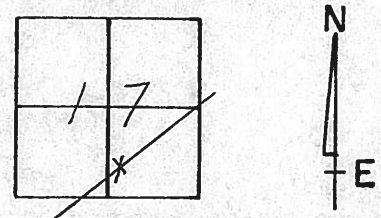

56+00

2 R/W SR # 101

County Seneca S.R. # 101

Township Adams

Section 17

T₃N, R₁₆E

Personnel schneider


Mosser

Barbour


Date 6-27-79

Weather Fair

Temp. 70°

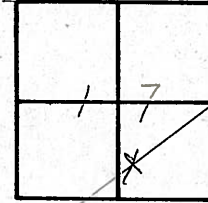

46-A

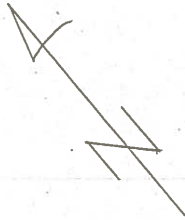


56+00

R.R. spk. on & R/w

2" down 1' R.T. of &

Reset P. K. Nail

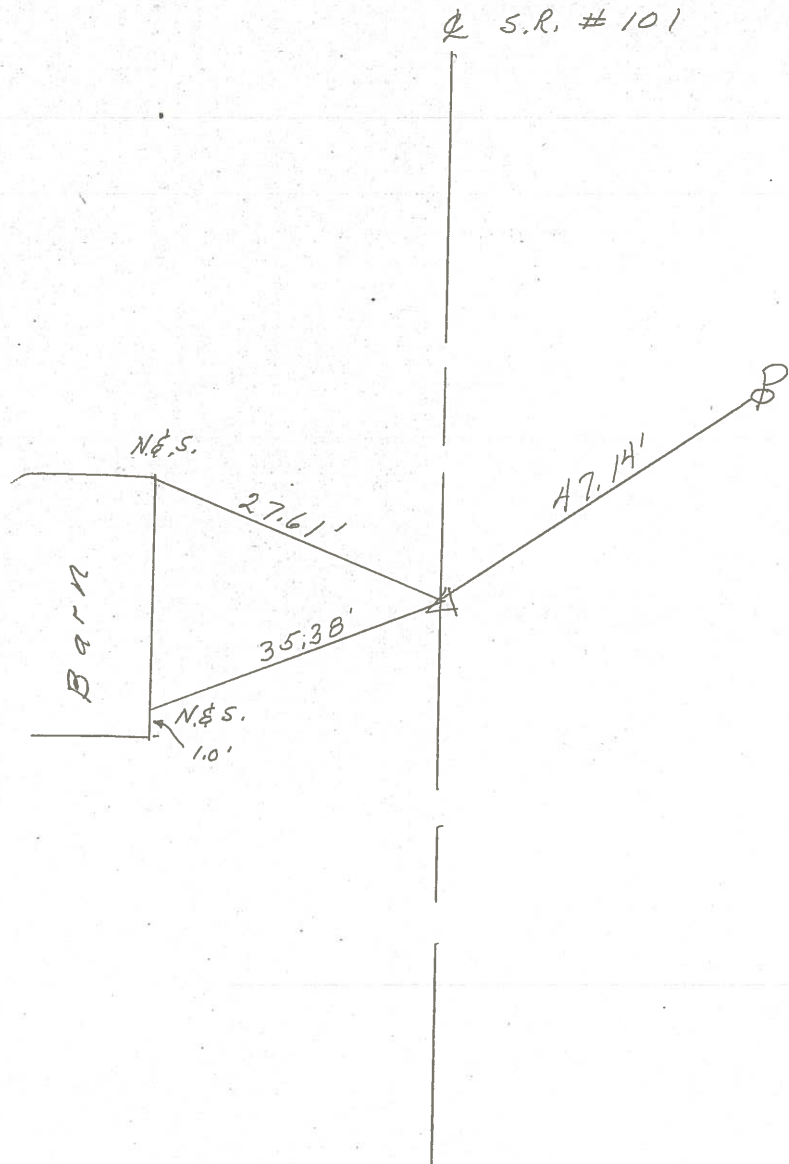

PERSONNEL TITLE PERSONNEL TITLE

COUNTY Seneca

DATE 2-11-64

KraBill

Kowaleski

Geyman

Bruggeman

S. R. #101

WEATHER

SEC.

TEMP.

DESCRIPTION S.R. #101 Tiffin To Sen. Co. Line

JOB NO.

LEFT

CENTER LINE

RIGHT

Adams

46

STA. 56+00

Iron Pin

#395



36.35'

36.17'

(17)



47

STA. 71+00

Iron Pin

#396



50.70'

Pear tree

1/2 (17)

83.22'




X in Hdwl.

48

STA. 81+00

Iron Pin

#397

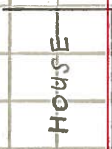

89.33'

89.16'

86.70'

(16)

82.50'



49

STA. 90+00

Iron Pin

#398



30.30'

Plumb

(16)

38.52'

Steel Stake

53.75'

Steel Stake



51.50'

Steel Stake

27.77'

(16)

46.86'

STA. 97+00

Iron Pin

#399