

O.D.O.T. DISTRICT 2 SURVEY OFFICE (USE ONLY)

PERSONNEL

REFERENCE NO. 47

SHEET 24 OF 46

NOTES MILLER

DATE 8/7/24

ROUTE SR 101

H.C. MILLER

WEATHER WINDY

COUNTY SENECA

R.C. BARRIERE

TEMP. 70°F

TOWNSHIP ADAMS

BLUBAUGH, ASTON, PRESTON-COLVIN

SECTION 17

DWG BY BLUBAUGH

PID 114849

T 3 N R 16 E

TYPE MONUMENT MAG/WASHER

ON SURFACE - ~~BELOW~~ ON

OFFSET $\mathcal{C}$ PAVEMENT 1.5' LT : RT

-- TO -- EDGE PAVEMENT

STATION: 565+79

HORZ.DATUM: NAD83 (2011)


GEOID: NAVD88-2018

GRID: NORTHING: 565434.287


EASTING: 1820169.785

LDP: NORTHING: 335455.602

EASTING: 195646.444

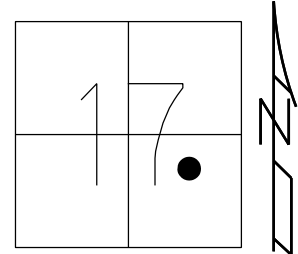

RECORD:
 STA. 56+00
 FD P.K.NAIL
 ATOP R.R.SPIKE
 SET SQ.HEADED
 NAIL/WASHER
 8/28/90, BARBOUR
 FD SQ.HEADED
 NAIL/WASHER
 2/7/05, SAH
 REF47
 7/28/09, DCH
 SET MAG/WASHER
 NEWREF47
 10/5/09, DCH
 FD MAG/WASHER
 REF47
 6/14/16
 9/18/17, JFO
 FD MAG/WASHER
 REF 47
 12/13/23, JAM
 FD TONE. DID NOT
 UNCOVER. PAINTED
 8/7/24, JAM

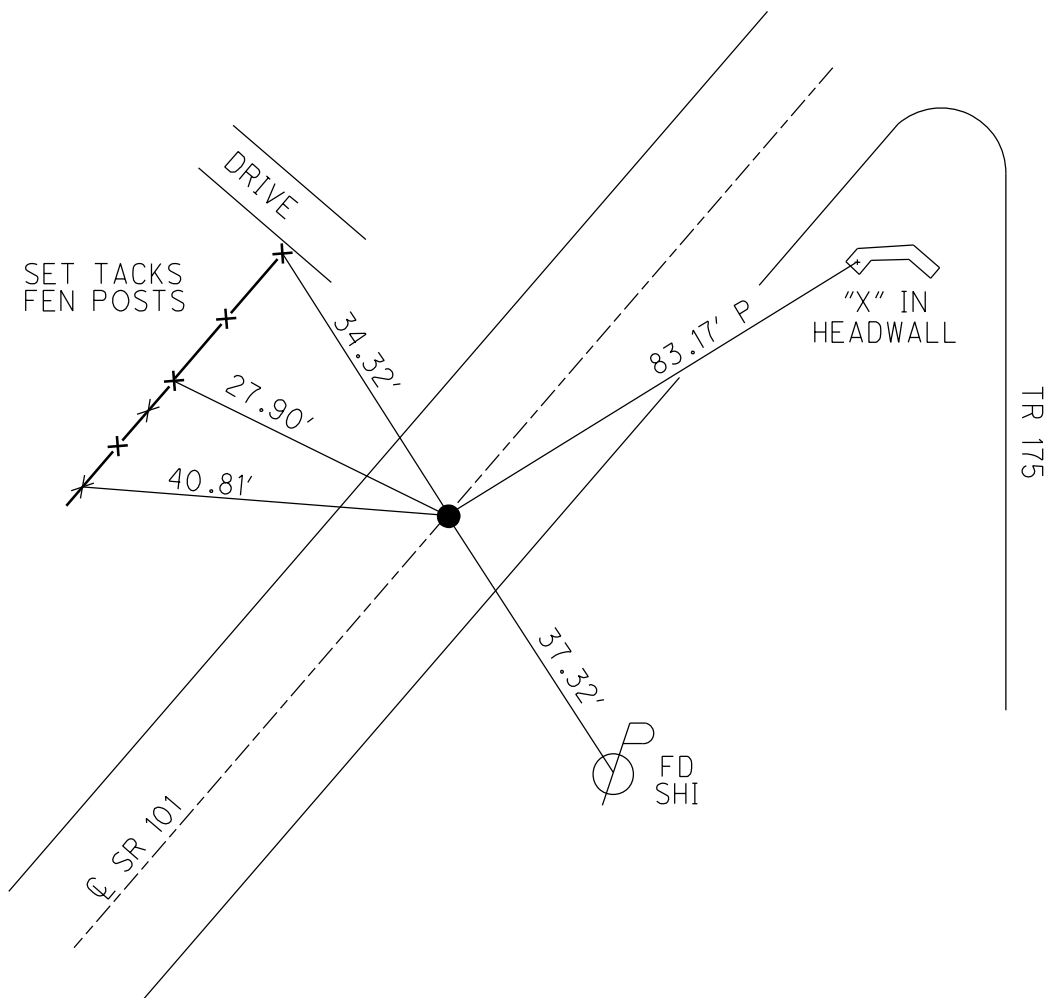

O.D.O.T. DISTRICT 2 SURVEY OFFICE (USE ONLY)

PERSONNEL

REFERENCE NO. 47

SHEET 25 OF 46

NOTES HOMAN

DATE 7-21-09

ROUTE SR 101

H.C. HOMAN

WEATHER SUNNY

COUNTY SENECA

R.C. ROUSOS

TEMP. 85°F

TOWNSHIP ADAMS

SECTION 17

DWG BY MAHLER PID 100787

T 3 N R 16 E

TYPE MONUMENT SQ HEADED NAIL/WASHER

ON SURFACE - ~~BELOW~~ ON

OFFSET Q PAVEMENT ON LT : RT

- TO - EDGE PAVEMENT


STATION: 580+80

HORIZ.DATUM: NAD83 (2011)


GEOID: NAVD88-2012A

GRID: NORTHING: 566432.842

EASTING: 1821289.739

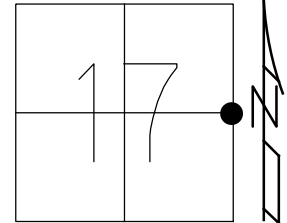

RECORD:
STA. 56+00
FD P.K.NAIL
ATOP R.R.SPIKE
SET SQ.HEADED
NAIL/WASHER
8/28/90, BARBOUR
FD SQ.HEADED
NAIL/WASHER
2/7/05, SAH
REF47
7/28/09, DCH
SET MAG/WASHER
NEWREF47
10/5/09, DCH
FD MAG/WASHER
REF47
6/14/16
9/18/17, JFO

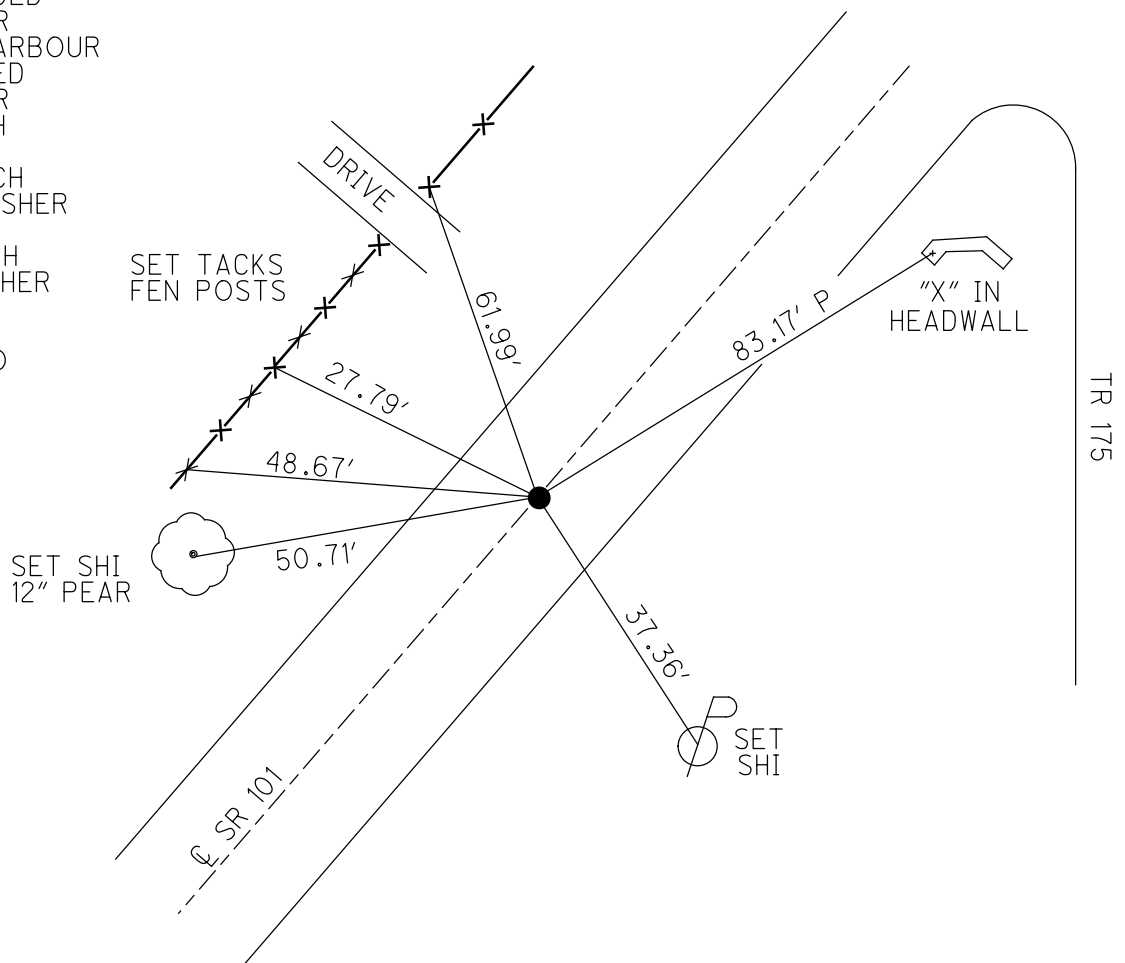


O.D.O.T. DISTRICT 2 SURVEY OFFICE (USE ONLY)


PERSONNEL	REFERENCE NO. <u>47</u>	SHEET <u>25</u> OF <u>46</u>
NOTES	DATE <u>7/21/09</u>	ROUTE <u>SR 101</u>
H.C. <u>HOMAN</u>	WEATHER <u>SUNNY</u>	COUNTY <u>SENECA</u>
R.C. <u>ROUSOS</u>	TEMP. <u>85°</u>	TOWNSHIP <u>ADAMS</u>
		SECTION <u>17</u>
		T <u>3</u> N R <u>16</u> E

TYPE MONUMENT SQ. HEADED NAIL/WASHER
 ON SURFACE - ~~BELOW~~ ON
 LEFT - ℄ PAV'T - RIGHT ON
- TO - EDGE PAVEMENT
 S.L.M. 580+80

GRID: NORTHING: 566432.842 EASTING: 1821289.739

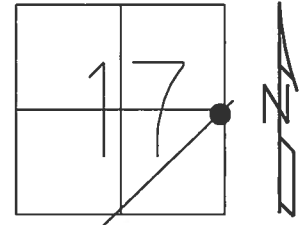

RECORD:
 STA. 56+00
 FD P.K. NAIL ATOP
 R.R. SPIKE
 SET SQ. HEADED
 NAIL/WASHER
 8/28/90
 FD SQ. HEADED
 NAIL/WASHER
 2/7/05, SAH
 SET MAG/WASHER
 10/5/09, DCH
 FD MAG/WASHER
 REF 47
 6/14/16, JFO
 UNCOVERED
 9/18/17, JFO

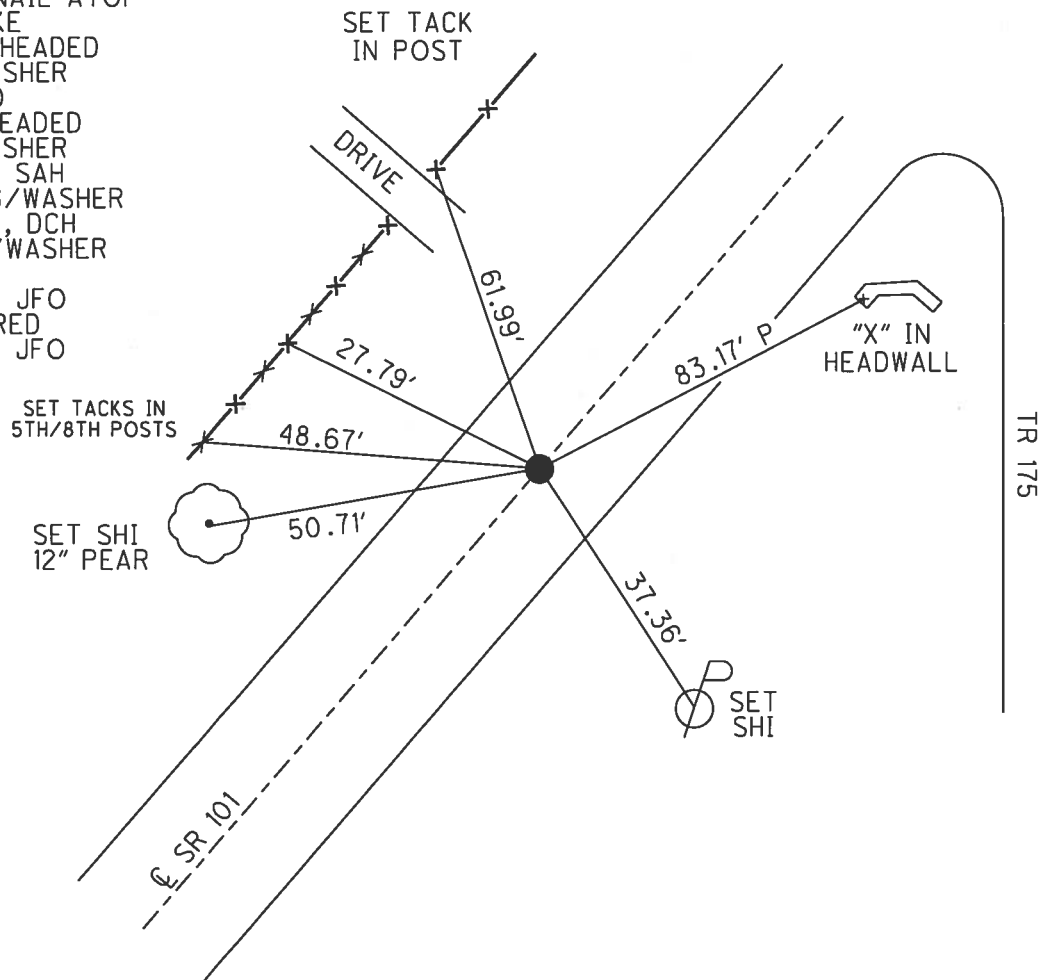

O.D.O.T. DISTRICT 2 SURVEY OFFICE (USE ONLY)

PERSONNEL

REFERENCE NO. 47

SHEET 25 OF 46

NOTES

HOMAN

DATE 7/21/09

ROUTE SR 101

H.C.

HOMAN

WEATHER SUNNY

COUNTY SENECA

R.C.

ROUSOS

TEMP. 85°

TOWNSHIP ADAMS

SECTION 17

T 3 N R 16 E

TYPE MONUMENT SQ. HEADED NAIL/WASHER


ON SURFACE - ~~BELOW~~ ON

LEFT - ℄ PAV'T - RIGHT ON

- TO - EDGE PAVEMENT

S.L.M. 580+80

GRID: NORTHING: 5566432.920 EASTING: 1821289.666

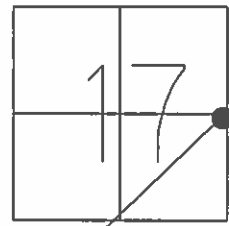

RECORD:

STA. 56+00

FD P.K. NAIL ATOP

R.R. SPIKE

SET SQ. HEADED

NAIL/WASHER

8/28/90


FD SQ. HEADED

NAIL/WASHER

2/7/05, SAH

SET MAG/WASHER

10/5/09, DCH

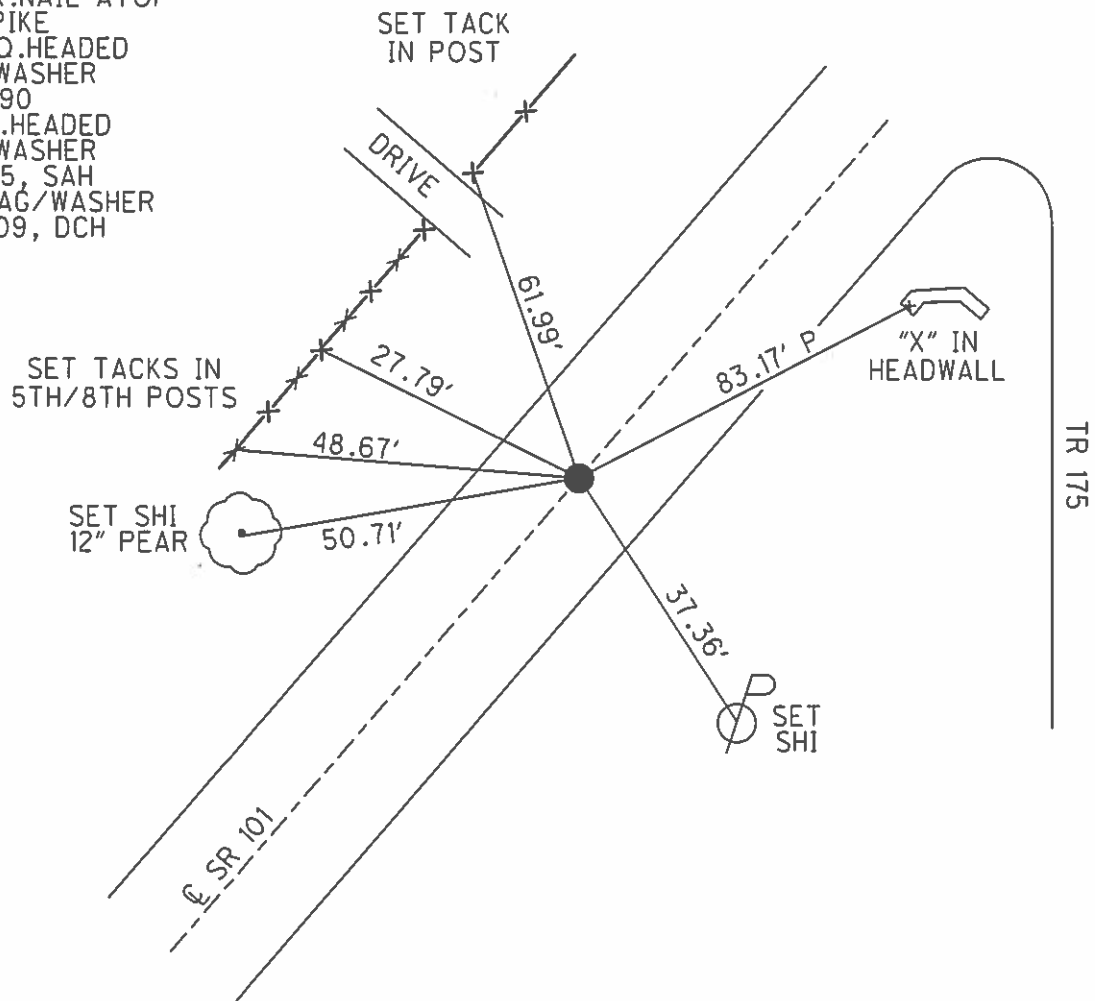

O.D.O.T. DISTRICT 2 SURVEY OFFICE

PERSONNEL

REFERENCE NO. 47

SHEET 21 OF 41

NOTES RIPPLE

H.C. BARBOUR

R.C. GEYMAN

DATE 8/28/90

WEATHER SUNNY

TEMP. 86°

ROUTE SR#101

COUNTY SENECA

TOWNSHIP ADAMS

SECTION 17

T. 3 N. R. 16 E.


TYPE MONUMENT SET SQUARE HEADED NAIL & SHINER

ON SURFACE - BELOW P.K. NAIL A TOP R.R. SPIKE

LEFT - CL PAV'T. - RIGHT CL PAV'T.


TO EDGE PAVEMENT

S.L.M.

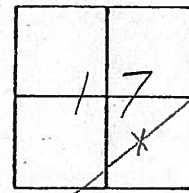

580+80

P.O.T. 71+00

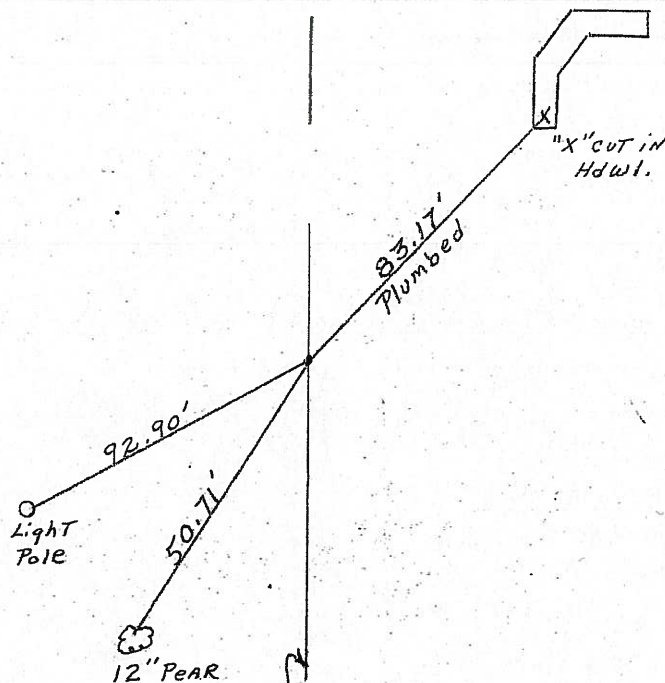

Fd
2-7-05
SAH

O.D.O.T. DISTRICT 2 SURVEY OFFICE

PERSONNEL

REFERENCE NO. 47

SHEET 21 OF 41

NOTES RIPPLE

H.C. BARBOUR

R.C. GEYMAN

DATE 8/28/90

WEATHER SUNNY

TEMP. 86°

ROUTE SR#101

COUNTY SENECA

TOWNSHIP ADAMS

SECTION 17

T.3 N R 16 E


TYPE MONUMENT Set Square Headed Nail & shiner

ON SURFACE - BELOW P.K. Nail A Top RR spike


LEFT - CL PAV'T. - RIGHT CL PAV'T.

TO EDGE PAVEMENT

S.L.M. _____


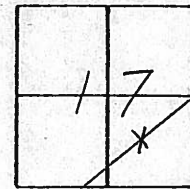


P.O.T. 71+00

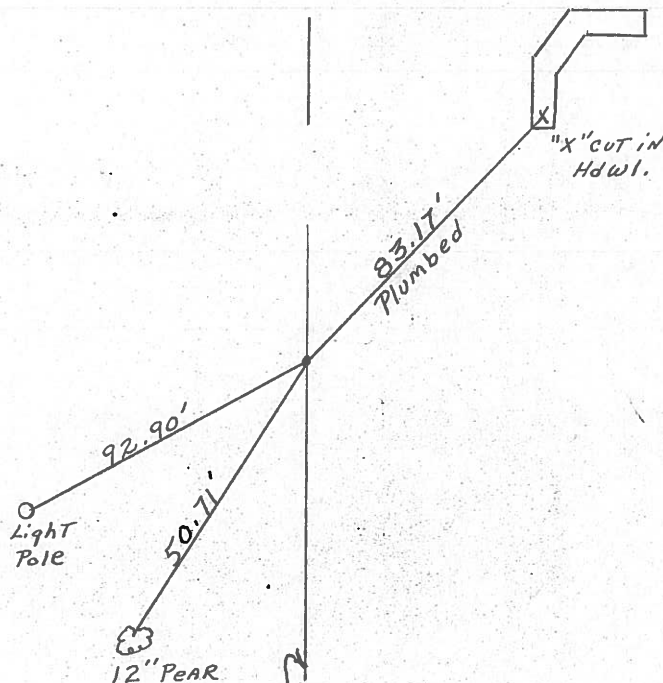

Q.D.O.T. DISTRICT 2 SURVEY OFFICE

Sht. ___ of ___

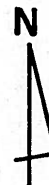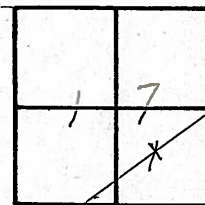County Seneca S.R. # 101Township AdamsSection 17T 3 N, R 16 EPersonnel SchneiderMosserBarbourDate 7-2-79Weather FairTemp. 65°

(47)


~~468~~

S.R. # 101

P.O.T.
71+00R.R. spk. on ϕ R/W

2" down

Reset P.K. Nail

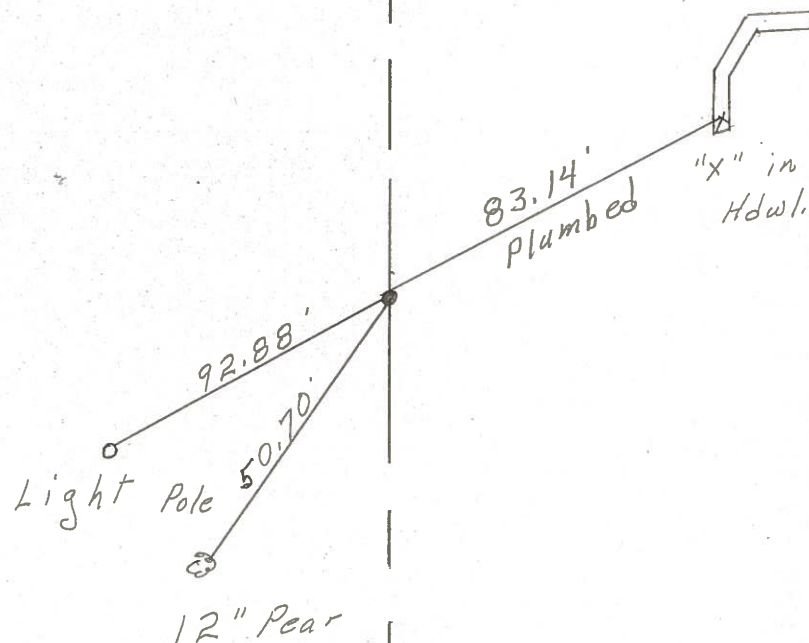

PERSONNEL TITLE PERSONNEL TITLE

COUNTY Seneca

DATE 2-11-64

KraBill

Kowaleski

Geyman

Bruggeman

S. R. #101

WEATHER

SEC.

TEMP.

DESCRIPTION S.R. #101 Tiffin To Sen. Co. Line

JOB NO.

LEFT

CENTER LINE

RIGHT


Adams

46

STA. 56+00

Iron Pin

#395


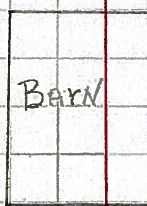


47

STA. 71+00

Iron Pin

#396

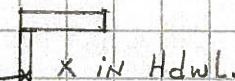
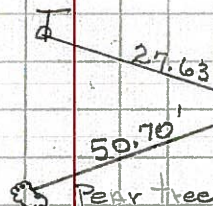


48

STA. 81+00

Iron Pin

#397

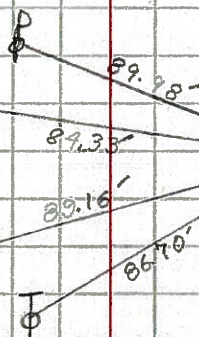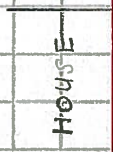


49

STA. 90+00

Iron Pin

#398

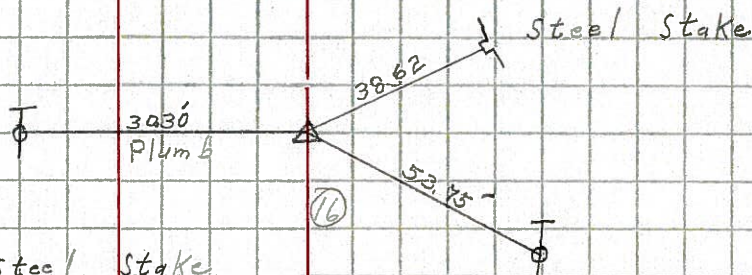

STA. 97+00

Iron Pin

#399

