

O.D.O.T. DISTRICT 2 SURVEY OFFICE (USE ONLY)

PERSONNEL

REFERENCE NO. 49

SHEET 27 OF 46

NOTES MILLER

DATE 8/7/24

ROUTE SR 101

H.C. MILLER

WEATHER WINDY

COUNTY SENECA

R.C. BARRIERE

TEMP. 34°F

TOWNSHIP ADAMS

BLUBAUGH, ASTON, PRESTON-COLVIN

SECTION 16

DWG BY BLUBAUGH

PID 114849

T 3 N R 16 E

TYPE MONUMENT R.R.SPIKE

~~ON SURFACE~~ - BELOW 6 1/2"

OFFSET $\odot$ PAVEMENT 1' LT : RT

-- TO -- EDGE PAVEMENT

STATION: 599+82

HORIZ.DATUM: NAD83 (2011)


GEOID: NAVD88-2018

GRID: NORTHING: 567676.511


EASTING: 1822727.247

LDP: NORTHING: 336709.977

EASTING: 197074.807

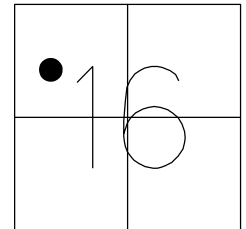

RECORD: P.O.T.
STA.90+00
FD P.K. NAIL
ATOP R.R. SPIKE
SET SQ. HEADED
NAIL/WASHER
8/23/90
FD SQ.HEADED
NAIL/WASHER
2/7/05, SAH
REF49
7/28/09, DCH
SET MAG/WASHER
10/6/09, DH
FD LG.R.R.SPIKE
6 1/2" DOWN
REF49
6/14/16
9/18/17, JFO
FD R.R.SPIKE
6 1/2" DOWN
REF 49
12/13/23, JAM
FD TONE. DID NOT
UNCOVER. PAINTED
8/7/24, JAM

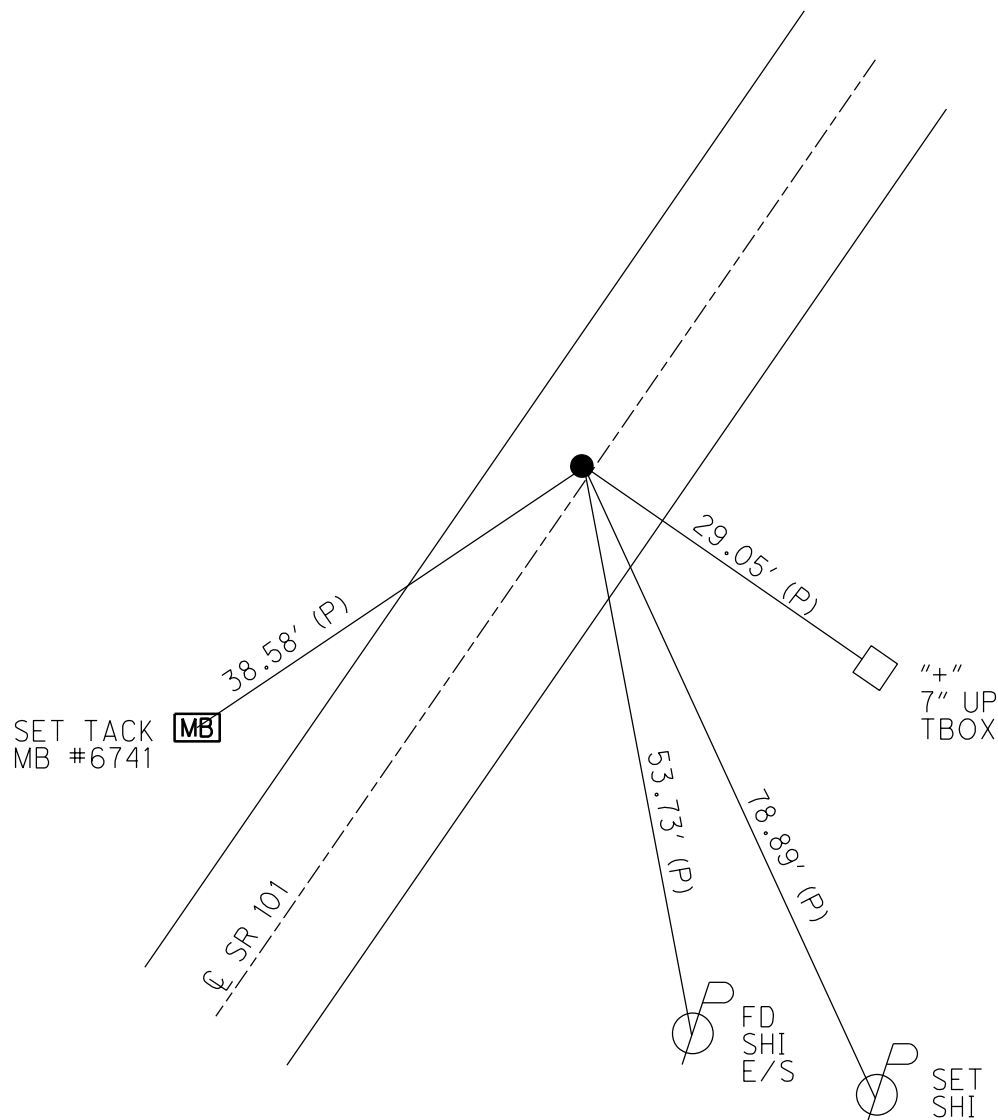

O.D.O.T. DISTRICT 2 SURVEY OFFICE (USE ONLY)

PERSONNEL

REFERENCE NO. 49

SHEET 27 OF 46

NOTES RHOADES

DATE 3-28-17

ROUTE SR 101

H.C. O'DONNELL

WEATHER MIST

COUNTY SENECA

R.C. RHOADES

TEMP. 42°F

TOWNSHIP ADAMS

SECTION 16

DWG BY MAHLER

PID 100787

T 3 N R 16 E

TYPE MONUMENT LG.R.R.SPIKE

~~ON SURFACE~~ - BELOW 6 1/2"

OFFSET Q PAVEMENT 1' LT : RT

- TO - EDGE PAVEMENT


STATION: 599+82

HORZ.DATUM: NAD83 (2011)


GEOID: NAVD88-2012A

GRID: NORTHING: 567676.511

EASTING: 1822727.247

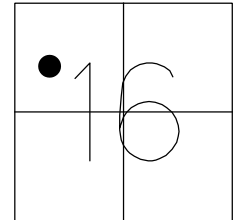

RECORD: P.O.T.
STA.90+00
FD P.K. NAIL
ATOP R.R. SPIKE
SET SQ. HEADED
NAIL/WASHER
8/23/90
FD SQ.HEADED
NAIL/WASHER
2/7/05, SAH
REF49
7/28/09, DCH
SET MAG/WASHER
10/6/09, DH
FD LG.R.R.SPIKE
6 1/2" DOWN
REF49
6/14/16
9/18/17, JFO

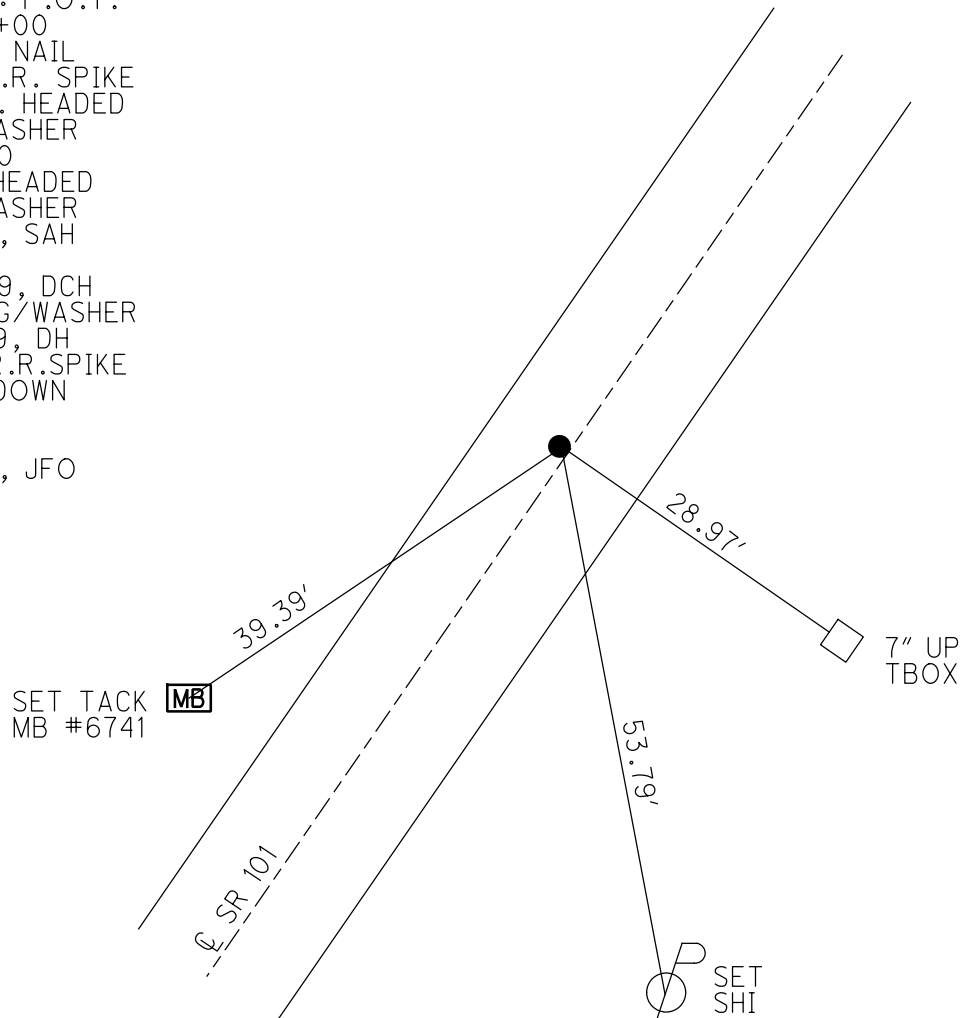

O.D.O.T. DISTRICT 2 SURVEY OFFICE (USE ONLY)

PERSONNEL _____ REFERENCE NO. 49 SHEET 27 OF 46

NOTES RHOADES _____ DATE 3/28/17 ROUTE SR 101
H.C. O'DONNELL _____ WEATHER MIST COUNTY SENECA
R.C. RHOADES _____ TEMP. 42° TOWNSHIP ADAMS
SECTION 16
T 3 N R 16 E

TYPE MONUMENT LG.R.R.SPIKE


~~ON SURFACE~~ - BELOW 6 1/2"

LEFT - Q PAV'T - ~~RIGHT~~ 1'

- TO - EDGE PAVEMENT


S.L.M. 599+82

GRID: NORTHING: 567676.511 EASTING: 1822727.247

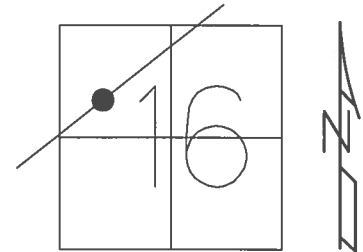

RECORD: P.O.T.
STA. 90+00
FD P.K. NAIL ATOP
R.R. SPIKE
SET SQ. HEADED
NAIL/WASHER
8/23/90
FD SQ. HEADED
NAIL/WASHER
2/7/05, SAH
SET MAG/WASHER
10/6/09, DH
FD LG.R.R.SPIKE
6 1/2" DOWN
REF49
6/14/16, JFO
FD HOLE W/R.R.SPIKE
COVERED W/SAND
9/18/17, JFO

SET TACK N/S IN
MAILBOX #6741

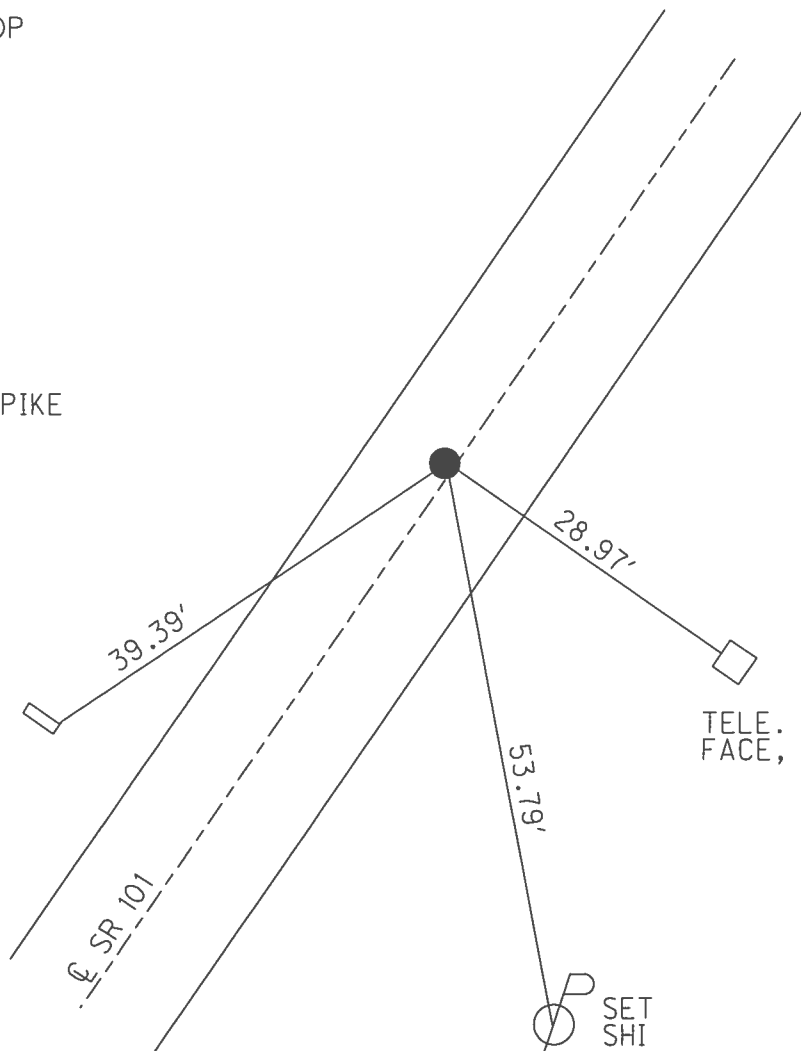

TELE. UG BOX POST
FACE, 7" FR/BOTTOM

SET
SHI

O.D.O.T. DISTRICT 2 SURVEY OFFICE (USE ONLY)

PERSONNEL _____ REFERENCE NO. 49 SHEET 27 OF 46
 NOTES HOMAN DATE 7/21/09 ROUTE SR 101
 H.C. HOMAN WEATHER SUNNY COUNTY SENECA
 R.C. ROUSOS TEMP. 85° TOWNSHIP ADAMS
 SECTION 16
 T 3 N R 16 E

TYPE MONUMENT SQ. HEADED NAIL/WASHER


ON SURFACE - ~~BELOW~~ ON

LEFT - C PAV'T - ~~RIGHT~~ 1'

- TO - EDGE PAVEMENT


S.L.M. 599+82

GRID: NORTHING: 567696.183 EASTING: 1822752.287

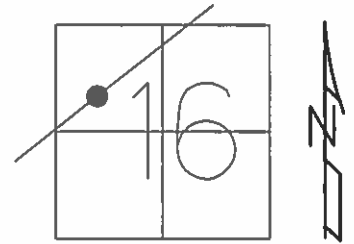

RECORD: P.O.T.
 STA. 90+00
 FD P.K. NAIL ATOP
 R.R. SPIKE
 SET SQ. HEADED
 NAIL/WASHER
 8/23/90
 FD SQ. HEADED
 NAIL/WASHER
 2/7/05, SAH
 SET MAG/WASHER
 10/6/09, DH

SET TACK N/S IN
 MAILBOX #6741

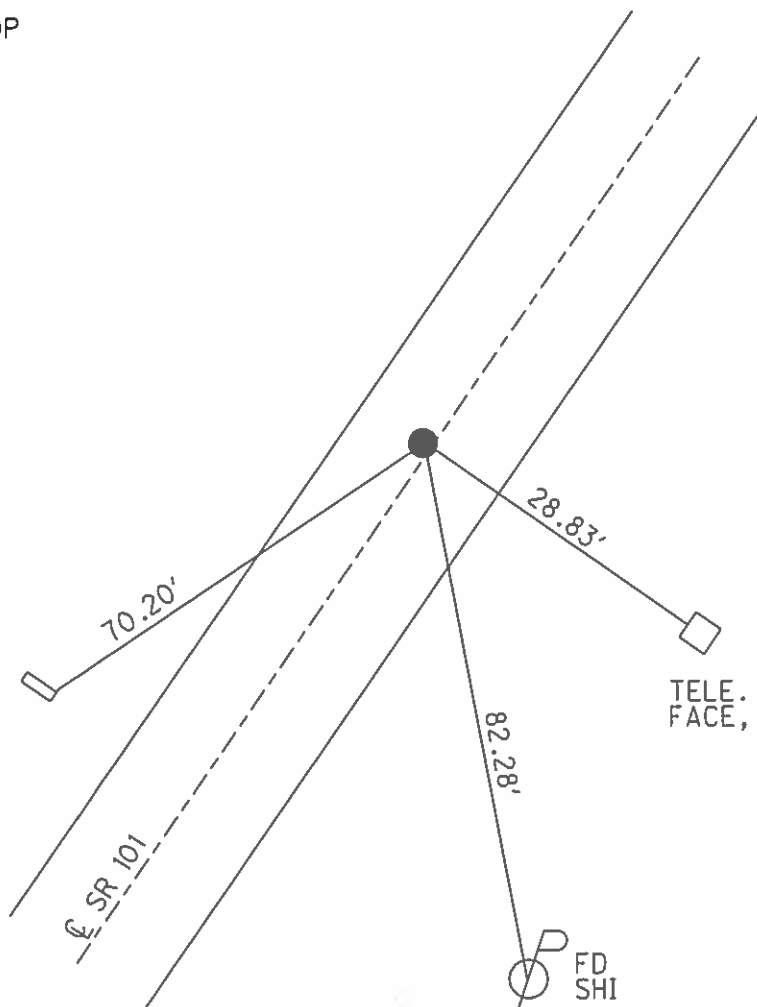

O.D.O.T. DISTRICT 2 SURVEY OFFICE

PERSONNEL

REFERENCE NO. 49

SHEET 23 OF 41

NOTES RIPPLE

H.C. BARBOUR

R.C. GEYMAN

DATE 8/23/90

WEATHER SUNNY

TEMP. 86°

ROUTE SR#101

COUNTY Seneca

TOWNSHIP Adams

SECTION 16

T. 3 N R. 16 E


TYPE MONUMENT Set. Square Headed Nail & washer

ON SURFACE - BELOW P.K. Nail A Top RR spike

LEFT - CL PAV'T. - RIGHT 1' LT. & PAV'T.

TO EDGE PAVEMENT

S.L.M. _____

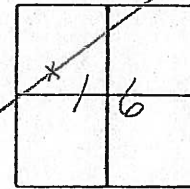

599 + 82

P.O.T. 90+00

Fd

2-7-05

SAH

28.83'

Telephone
underground
Box Post
Face 1' from Top

53.77'

60.58'

fence
Post

SR#101

O.D.O.T. DISTRICT 2 SURVEY OFFICE

PERSONNEL

REFERENCE NO. 49A

SHEET 23 OF 41

NOTES Ripplie

H.C. BARBOUR

R.C. GEYMAN

DATE 8/23/90

WEATHER SUNNY

TEMP. 86°

ROUTE SR#101

COUNTY Seneca

TOWNSHIP Adams

SECTION 16

T 3 N R 16 E



TYPE MONUMENT Set. Square Headed Nail & washer

ON SURFACE - BELOW P.K. Nail A Top RR spike

LEFT - CL PAV'T. - RIGHT 1' LT. & PAV'T.


TO EDGE PAVEMENT

S.L.M.

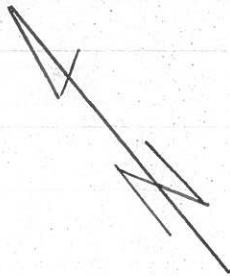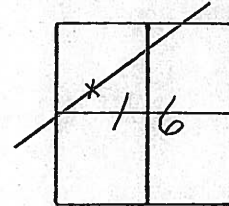

P.O.T. 90+00

& R/W SR#101

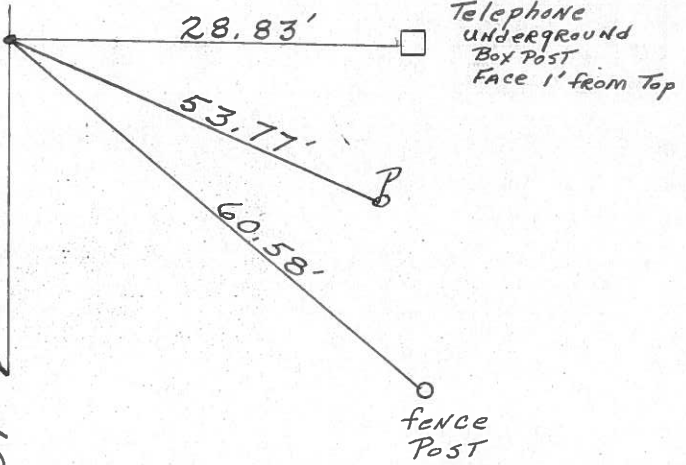

Q.D.O.T. DISTRICT 2 SURVEY OFFICE

23

Sht. of

County Seneca S.R. # 101

Township Adams

Section 16

T 3 N, R 16 E

Personnel Schneider

Mosser


Barbour

Date 7-2-79

Weather Fair

Temp. 65°

(49)

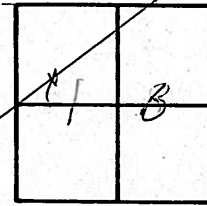

~~47-A~~



S.R. # 101

P.O.T.

90+00

R.R. spk. on E R/W.

2" down 1' Lt. E

Reset P.K. Nail

Telephone
Underground Med
Post face 1'
from Top

26.67'

53.78'

60.48'

Fence
Post

PERSONNEL TITLE PERSONNEL TITLE

COUNTY Seneca

DATE 2-11-64

Kra Bill

Kowaleski

Geyman

Bruggeman

S. R. #101

WEATHER

SEC.

TEMP.

DESCRIPTION S.R. #101 Tiffin To Sen. Co. Line

JOB NO.

LEFT


CENTER LINE

RIGHT

Adams

(46)

STA. 56+00

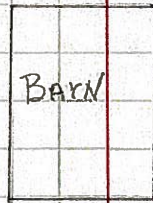Iron Pin
#395

36.35'


(17)

36.17'



(47)


STA. 71+00

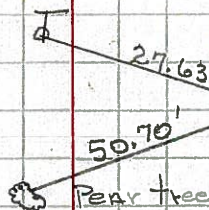Iron Pin
#396

50.70'


1/2 (17)

83.22'

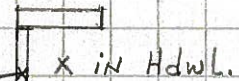

(48)

STA. 81+00

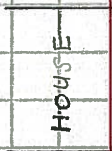Iron Pin
#397

89.35'

89.16'


86.70'

(16)

82.50'

(49)

STA. 90+00

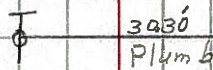Iron Pin
#398

30.30'

(16)

38.62'

Steel Stake

53.75'

STA. 97+00

Iron Pin
#399

Steel Stake

Steel Stake

51.50'

27.77'

(16)

46.86'