

O.D.O.T. DISTRICT 2 SURVEY OFFICE (USE ONLY)

PERSONNEL

REFERENCE NO. 53A

SHEET 32 OF 46

NOTES MILLER

DATE 8/7/24

ROUTE SR 101

H.C. MILLER

WEATHER WINDY

COUNTY SENECA

R.C. BARRIERE

TEMP. 70°F

TOWNSHIP ADAMS

BLUBAUGH, ASTON, PRESTON-COLVIN

SECTION 9

DWG BY BLUBAUGH

PID 114849

T 3 N R 16 E

TYPE MONUMENT MAG/WASHER

ON SURFACE - ~~BELOW~~ ON

OFFSET $\mathcal{C}$ PAVEMENT ON LT : RT

-- TO -- EDGE PAVEMENT

STATION: 636+92

HORIZ.DATUM: NAD83 (2011)


GEOID: NAVD88-2018

GRID: NORTHING: 570105.958


EASTING: 1825511.141

LDP: NORTHING: 339160.441

EASTING: 199840.683

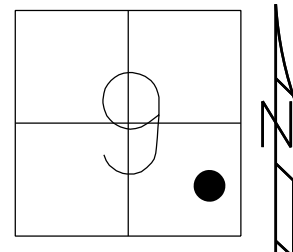

RECORD:
SET SQ. HEADED
NAILS/WASHERS
8/28/90, BARBOUR
FD P.K./WASHER
REFA53
6/29/09, DCH
SET MAG/WASHER
NEWREFA53
10-06-09, DH
FD MAG/WASHER
REFA53
6/14/16
9/19/17, JFO
FD MAG/WASHER
REF53A
12/13/23, JAM
FD TONE. DID NOT
UNCOVER. PAINTED
8/7/24, JAM

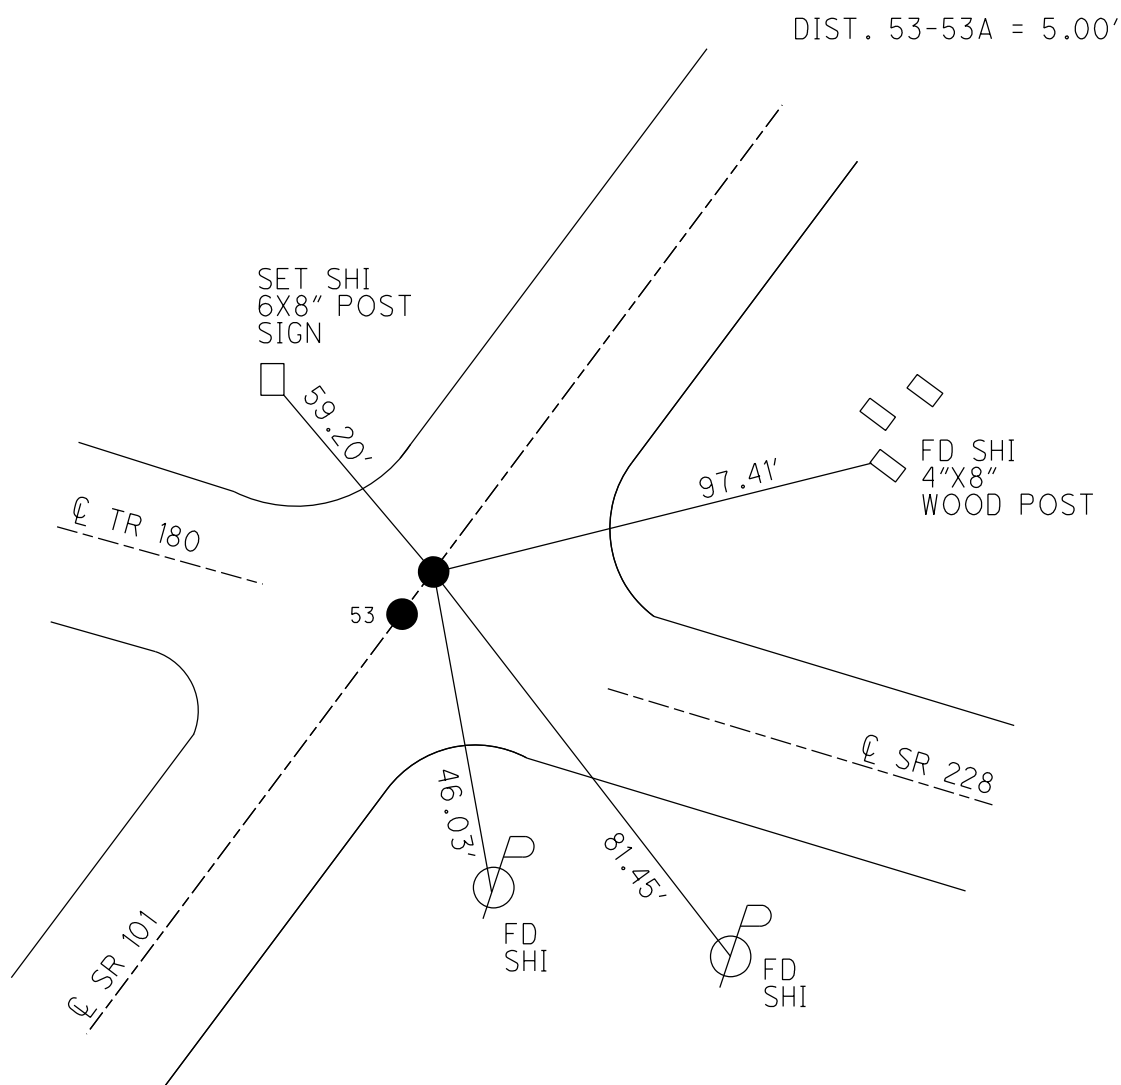

O.D.O.T. DISTRICT 2 SURVEY OFFICE (USE ONLY)

PERSONNEL

REFERENCE NO. 53 A

SHEET 32 OF 46

NOTES HOMAN

DATE 6-29-09

ROUTE SR 101

H.C. ROUSOS

WEATHER SUNNY

COUNTY SENECA

R.C. HOMAN

TEMP. 80°F

TOWNSHIP ADAMS

DWG BY MAHLER PID 100787

SECTION 9

T 3 N R 16 E

TYPE MONUMENT P.K./WASHER

ON SURFACE - ~~BELOW~~ ON

OFFSET Q PAVEMENT ON LT : RT

- TO - EDGE PAVEMENT


STATION: 636+92

HORZ.DATUM: NAD83 (2011)

GEOID: NAVD88-2012A


GRID: NORTHING: 570105.958

EASTING: 1825511.141

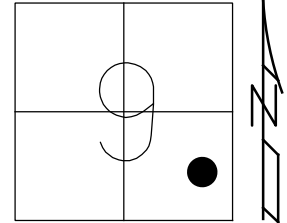

RECORD:
SET SQ. HEADED
NAILS/WASHERS
8/28/90, BARBOUR
FD P.K./WASHER
REFA53
6/29/09, DCH
SET MAG/WASHER
NEWREFA53
10-06-09, DH
FD MAG/WASHER
REFA53
6/14/16
9/19/17, JFO

DIST. 53-53A = 5.02'

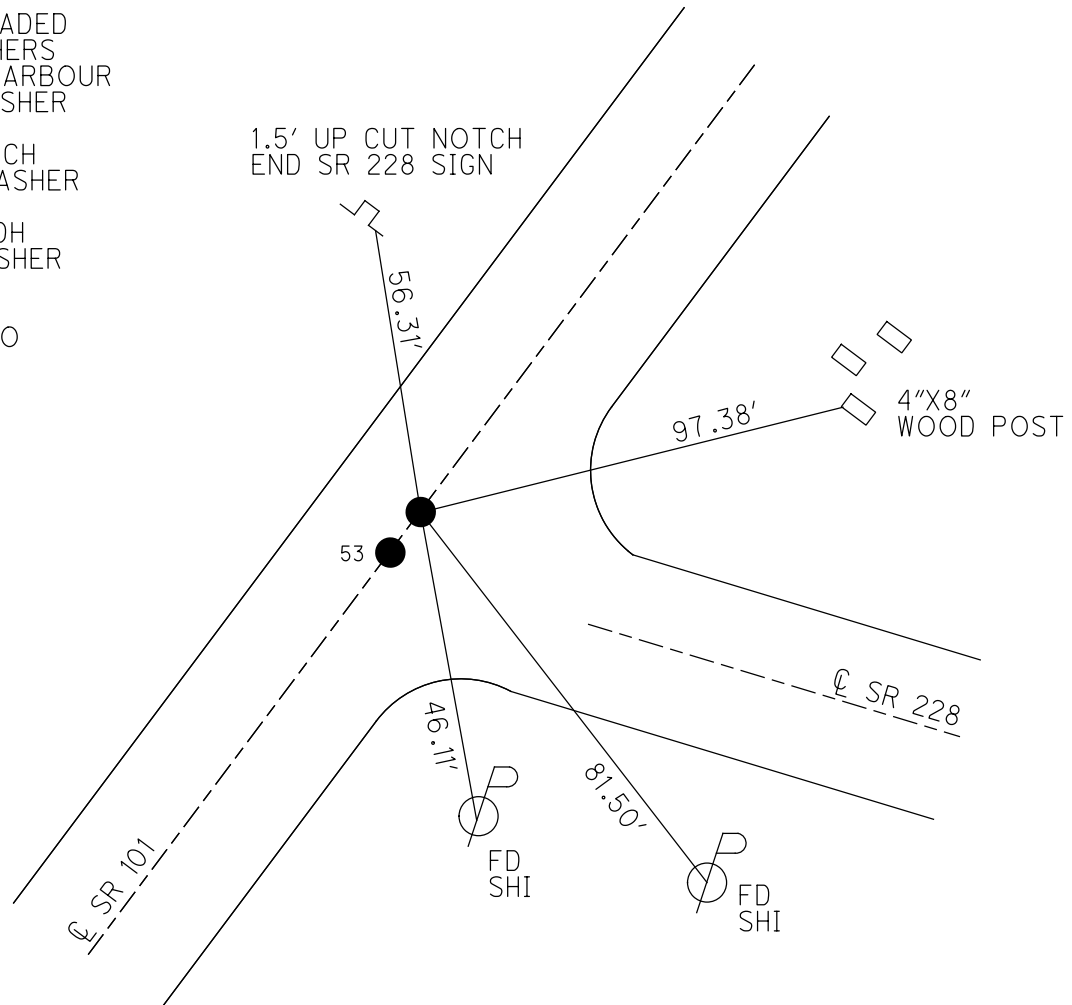

O.D.O.T. DISTRICT 2 SURVEY OFFICE (USE ONLY)

PERSONNEL

REFERENCE NO. 53 A

SHEET 32 OF 46

NOTES

HOMAN

DATE 6/29/09

ROUTE SR 101

H.C.

ROUSOS

WEATHER SUNNY

COUNTY SENECA

R.C.

HOMAN

TEMP. 80°

TOWNSHIP ADAMS

SECTION 9

T 3 N R 16 E

TYPE MONUMENT SQ. HEADED NAIL/WASHER


ON SURFACE - ~~BELOW~~ ON

~~LEFT~~ - CL PAV'T - RIGHT 1'

- TO - EDGE PAVEMENT

S.L.M. 636+92

GRID: NORTHING: 570105.958 EASTING: 1825511.141

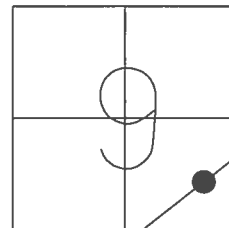

RECORD:

FD P.K. NAIL ATOP

R.R. SPIKE

SET SQ. HEADED

NAILS/WASHERS

8/28/90

SET MAG/WASHER

10-06-09, DH


FD MAG/WASHER

REFA53

6/14/16, JFO

UNCOVERED


9/19/17, JFO

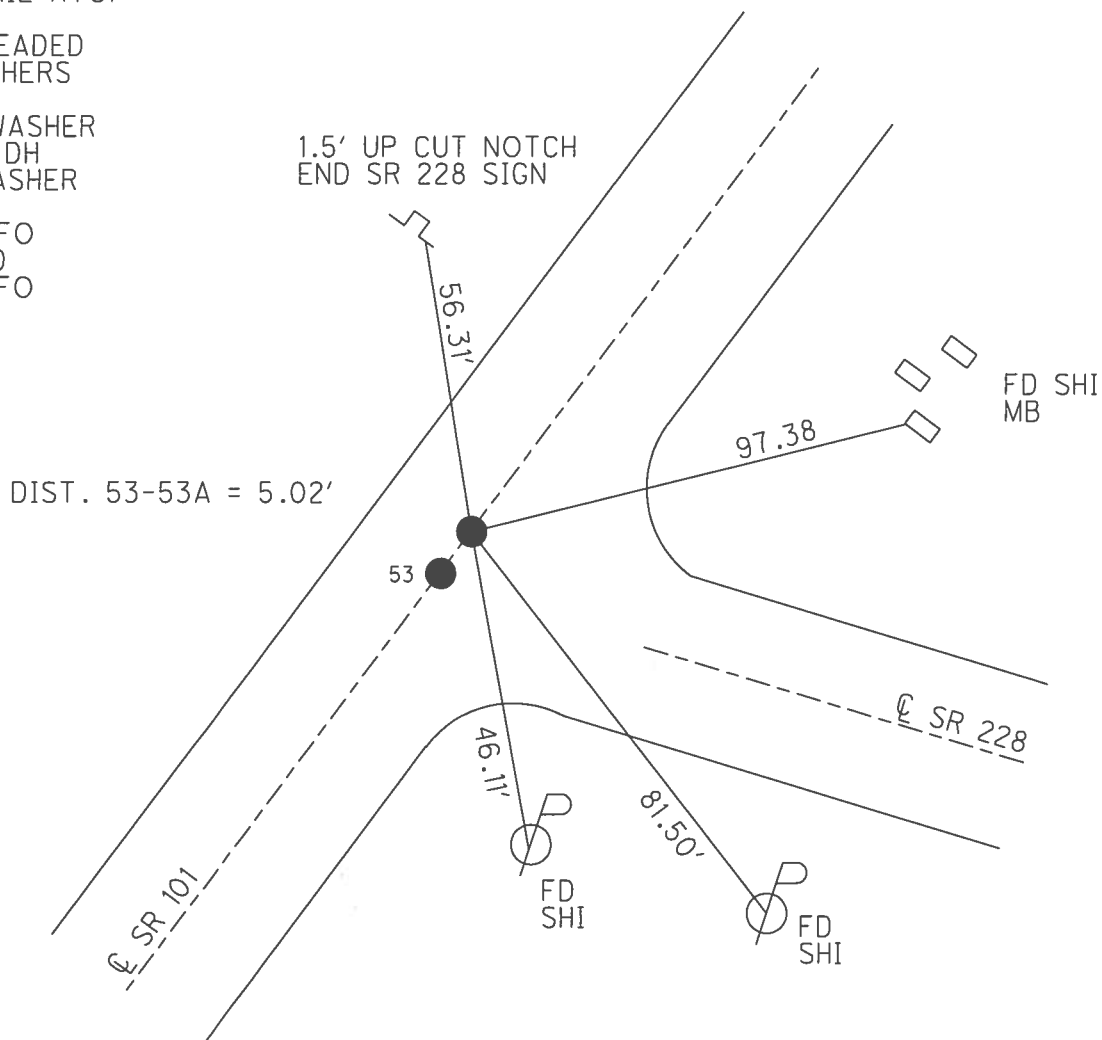


O.D.O.T. DISTRICT 2 SURVEY OFFICE (USE ONLY)

PERSONNEL _____ REFERENCE NO. 53 A SHEET 32 OF 46
 NOTES HOMAN DATE 6/29/09 ROUTE SR 101
 H.C. ROUSOS WEATHER SUNNY COUNTY SENECA
 R.C. HOMAN TEMP. 80° TOWNSHIP ADAMS
 SECTION 9
 T 3 N R 16 E

TYPE MONUMENT SQ. HEADED NAIL/WASHER
 ON SURFACE - ~~BELOW~~ ON
 LEFT - ℄ PAV'T - RIGHT ON
- TO - EDGE PAVEMENT
 S.L.M. 636+92
 GRID: NORTHING: 570106.088 EASTING: 1825511.041

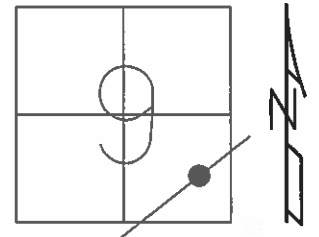

RECORD:
 FD P.K. NAIL ATOP
 R.R. SPIKE
 SET SQ. HEADED
 NAILS/WASHERS
 8/28/90
 SET MAG/WASHER
 10-06-09, DH

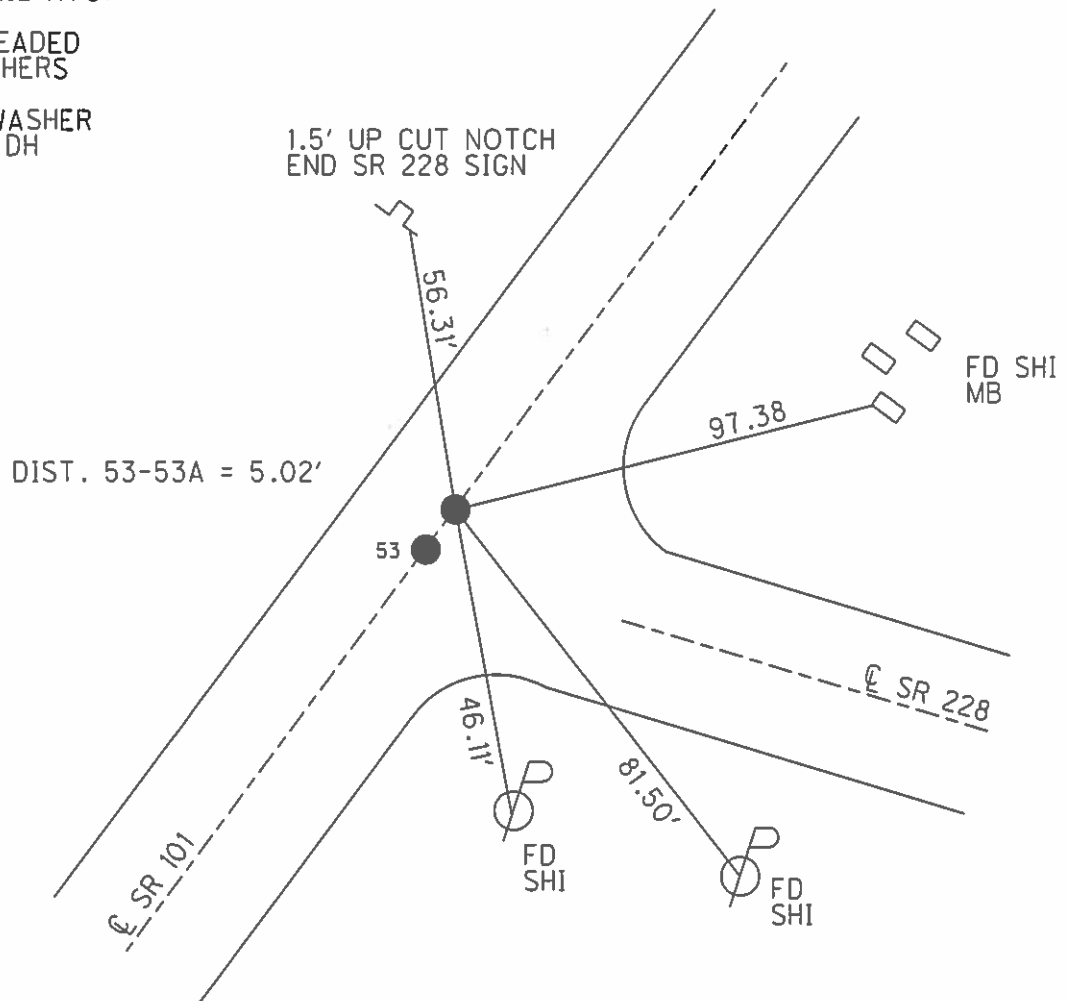

O.D.O.T. DISTRICT 2 SURVEY OFFICE

PERSONNEL

REFERENCE NO. 53

SHEET 28 OF 41

NOTES Ripple

H.C. BARBOUR

DATE 8/28/90

ROUTE SR#101

R.C. Geyman

WEATHER SUNNY

COUNTY Seneca

TEMP. 86°

TOWNSHIP Adams

SECTION 9

T 3 N R 16 E

TYPE MONUMENT Set Square Handed Nails & washers


ON SURFACE - BELOW P.K. Nail at Top RR Spike

LEFT - CL PAV'T. - RIGHT CL PAV'T.

TO EDGE PAVEMENT

S.L.M. _____

53-A

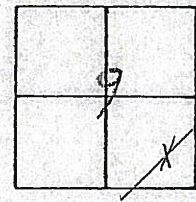

B 636+~~92~~ 92
A 636+82

36"
Cottonwood

41.78'

B

SR# 228

CoR.
of Hdwl.

33.69'

26.93'

35.70'

A

49.74'

58.34'

36.78'

END
G.R. Post

CL R/W SR# 101

To
Dangerous

O.D.O.T. DISTRICT 2 SURVEY OFFICE

PERSONNEL

REFERENCE NO. 53

SHEET 28 OF 41

NOTES RIPPLE

H.C. BARBOUR

R.C. GEYMAN

DATE 8/28/90

WEATHER SUNNY

TEMP. 86°

ROUTE SR#101

COUNTY SENECA

TOWNSHIP ADAMS

SECTION 9

T. 3 N R. 16 E

TYPE MONUMENT SET SQUARE HEADED NAILS & WASHERS


ON SURFACE - BELOW P.K. NAIL A TOP RR SPIKE

LEFT - CL PAV'T. - RIGHT CL PAV'T.

TO EDGE PAVEMENT

S.L.M. _____

53-A

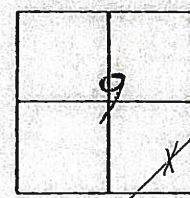

36"
Cottonwood

41.78'



COR.
OF HDWL.

33.69'

26.93'

35.70'

49.74'

58.34'

36.78'

END
G.R. POST

CL R/W SR# 1017

SR# 228

Q.D.O.T. DISTRICT 2 SURVEY OFFICE

Sht. of

County Seneca S.R. # 101

Township Adams

Section 9

T 3 N, R 16 E

Personnel Schneider

Mosser



Barbour

Date 6-26-79

Weather Fair

Temp. 75°

53-A

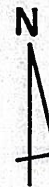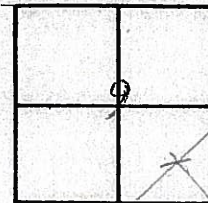

~~#48-B~~

127+00

R.R. spk. on $\frac{1}{2}$ R/W

Reset 2 P.K. Nails

Cor. of
Hdwl.

End G.R. Post

36" Cottonwood

$\frac{1}{2}$ S.R. #101

F.B.P.K.

S.R. # 228

41.78'

33.66'

35.70'

26.92'

36.78'

10.27'

5.05'

56.16'

47.39'

F.B.P.K. Nail