

O.D.O.T. DISTRICT 2 SURVEY OFFICE (USE ONLY)

PERSONNEL

REFERENCE NO. 55

SHEET 33 OF 46

NOTES MILLER

DATE 8/7/24

ROUTE SR 101

H.C. MILLER

WEATHER WINDY

COUNTY SENECA

R.C. BARRIERE

TEMP. 70°F

TOWNSHIP ADAMS

BLUBAUGH, ASTON, PRESTON-COLVIN

SECTION 9

DWG BY BLUBAUGH

PID 114849

T 3 N R 16 E

TYPE MONUMENT MAG/WASHER

ON ~~SURFACE~~ - BELOW 0.5"

OFFSET Q PAVEMENT 1' ~~LT~~ : RT

-- TO -- EDGE PAVEMENT

STATION: 639+35

HORIZ.DATUM: NAD83 (2011)


GEOID: NAVD88-2018

GRID: NORTHING: 570604.009


EASTING: 1826093.928

LDP: NORTHING: 339662.820

EASTING: 200419.828

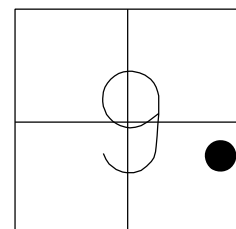

RECORD:
 STA. 134+65
 FD R.R. SPIKE
 4" DOWN
 SET SQ.HEADED
 NAIL/WASHER
 8/28/90, BARBOUR
 FD SQ.HEADED
 NAIL/WASHER
 2/7/05, SAH
 FD P.K.NAIL
 REF55
 7/8/09, DCH
 SET MAG/WASHER
 NEWREF55
 10-06-09, DH
 FD MAG/WASHER
 REF55
 6/15/16
 9/19/17, JFO
 FD MAG/WASHER
 REF55
 12/13/23, JAM
 FD TONE. DID NOT
 UNCOVER. PAINT
 8/7/24, JAM

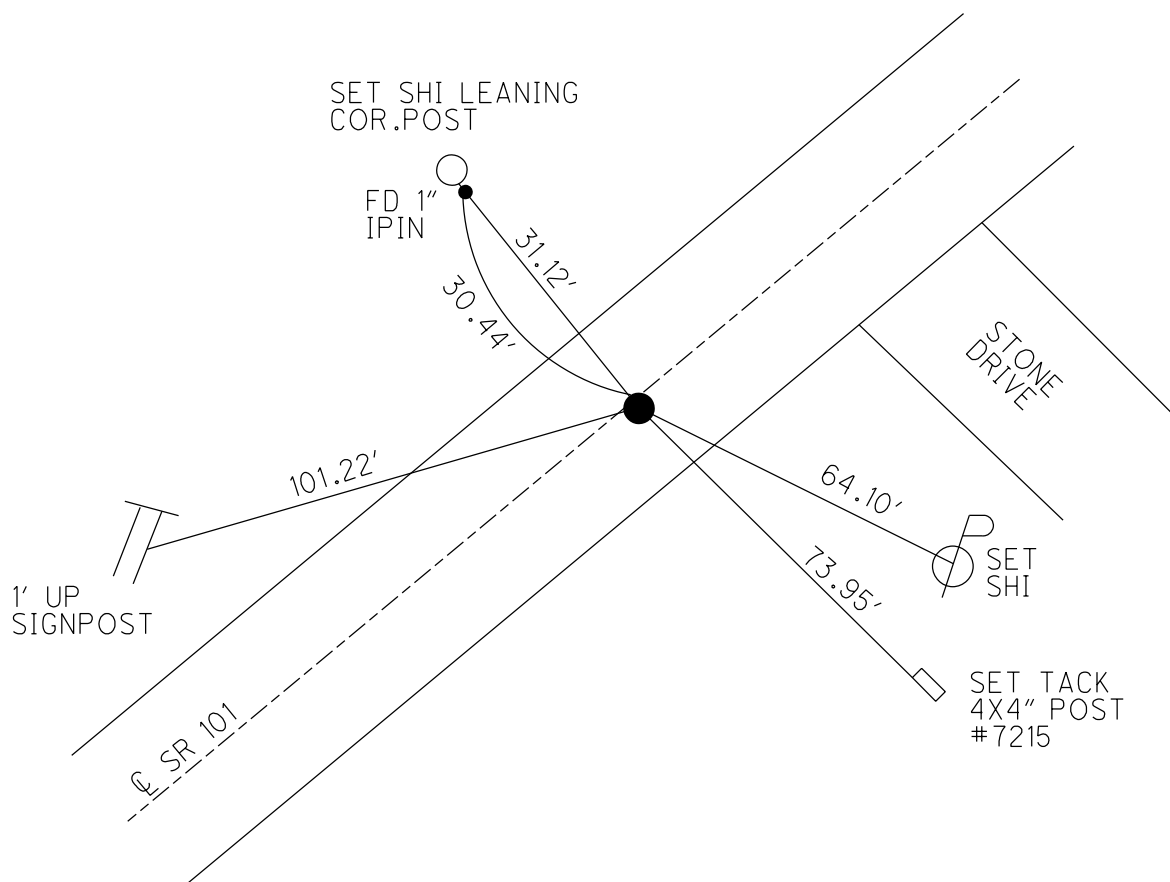


€ SR 101

O.D.O.T. DISTRICT 2 SURVEY OFFICE (USE ONLY)


PERSONNEL	REFERENCE NO. <u>55</u>	SHEET <u>34</u> OF <u>46</u>
NOTES	DATE <u>7/08/09</u>	ROUTE <u>SR 101</u>
H.C. <u>HOMAN</u>	WEATHER <u>SUNNY</u>	COUNTY <u>SENECA</u>
R.C. <u>ROUSOS</u>	TEMP. <u>80°</u>	TOWNSHIP <u>ADAMS</u>
		SECTION <u>9</u>
		T <u>3</u> N R <u>16</u> E

TYPE MONUMENT P.K.NAIL
 ON SURFACE - ~~BELOW~~ ON
~~LEFT~~ - ℄ PAV'T - RIGHT 1'
 TO EDGE PAVEMENT
 S.L.M. 644+52

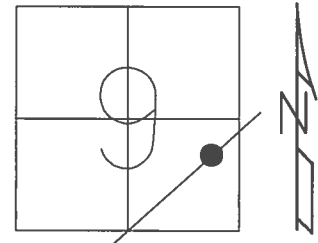

GRID: NORTHING: 570604.009 EASTING: 1826093.928


RECORD:
 STA. 134+65
 FD R.R. SPIKE
 4" DOWN
 SET SQ.HEADED
 NAIL/WASHER
 8/28/90
 FD SQ.HEADED
 NAIL/WASHER
 2/7/05, SAH
 SET MAG/WASHER
 10-06-09, DH
 FD MAG/WASHER
 REF55
 6/15/16, JFO
 UNCOVERED
 9/19/17, JFO

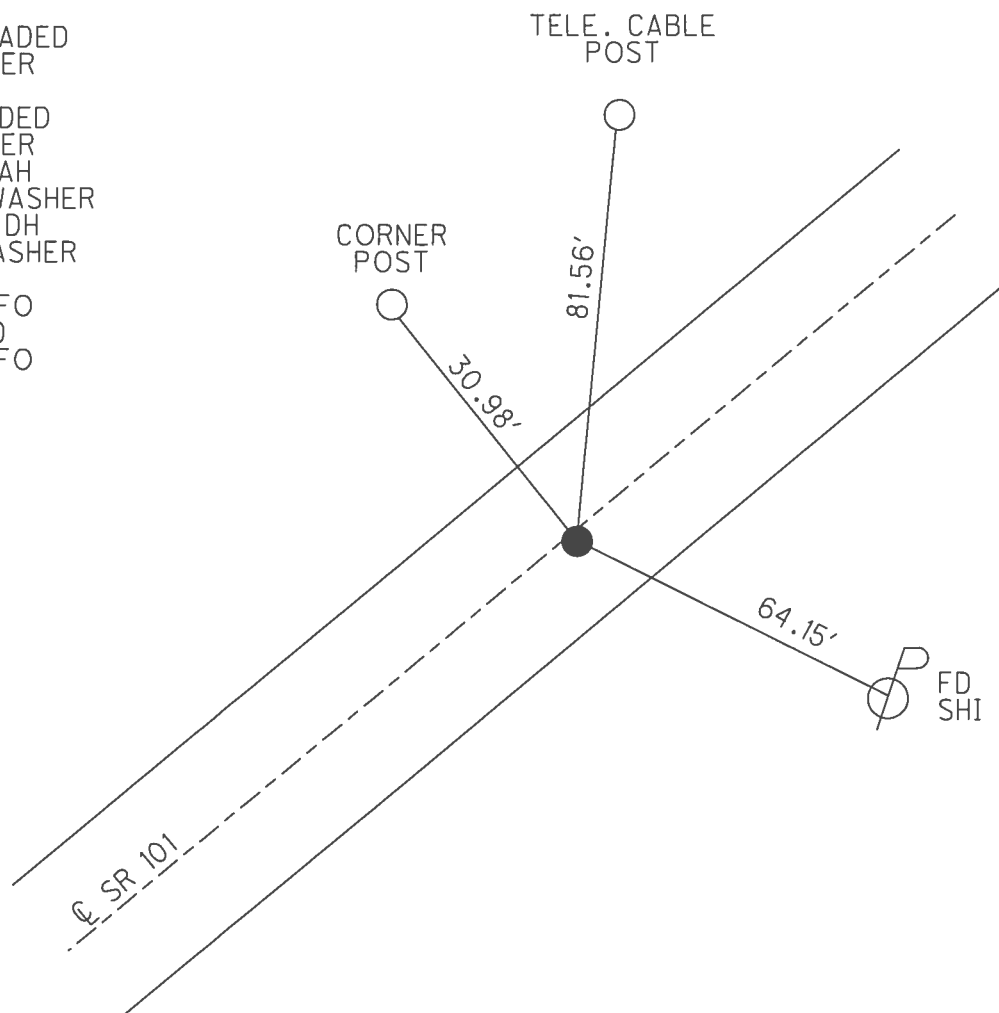

O.D.O.T. DISTRICT 2 SURVEY OFFICE (USE ONLY)


PERSONNEL _____ REFERENCE NO. 55 SHEET 34 OF 46
 NOTES HOMAN DATE 7/08/09 ROUTE SR 101
 H.C. HOMAN WEATHER SUNNY COUNTY SENECA
 R.C. ROUSOS TEMP. 80° TOWNSHIP ADAMS
 SECTION 9
 T 3 N R 16 E

TYPE MONUMENT P.K.NAIL
 ON SURFACE - ~~BELOW~~ ON _____
~~LEFT~~ - Q PAV'T - RIGHT 1'
 - TO - EDGE PAVEMENT
 S.L.M. 644+52

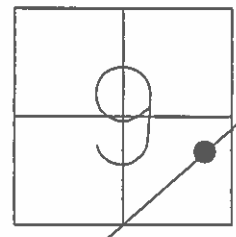

GRID: NORTHING: 570604.009 EASTING: 1826093.845

RECORD:
 STA. 134+65
 FD R.R. SPIKE
 4" DOWN
 SET SQ.HEADED
 NAIL/WASHER
 8/28/90
 FD SQ.HEADED
 NAIL/WASHER
 2/7/05, SAH
 SET MAG/WASHER
 10-06-09, DH

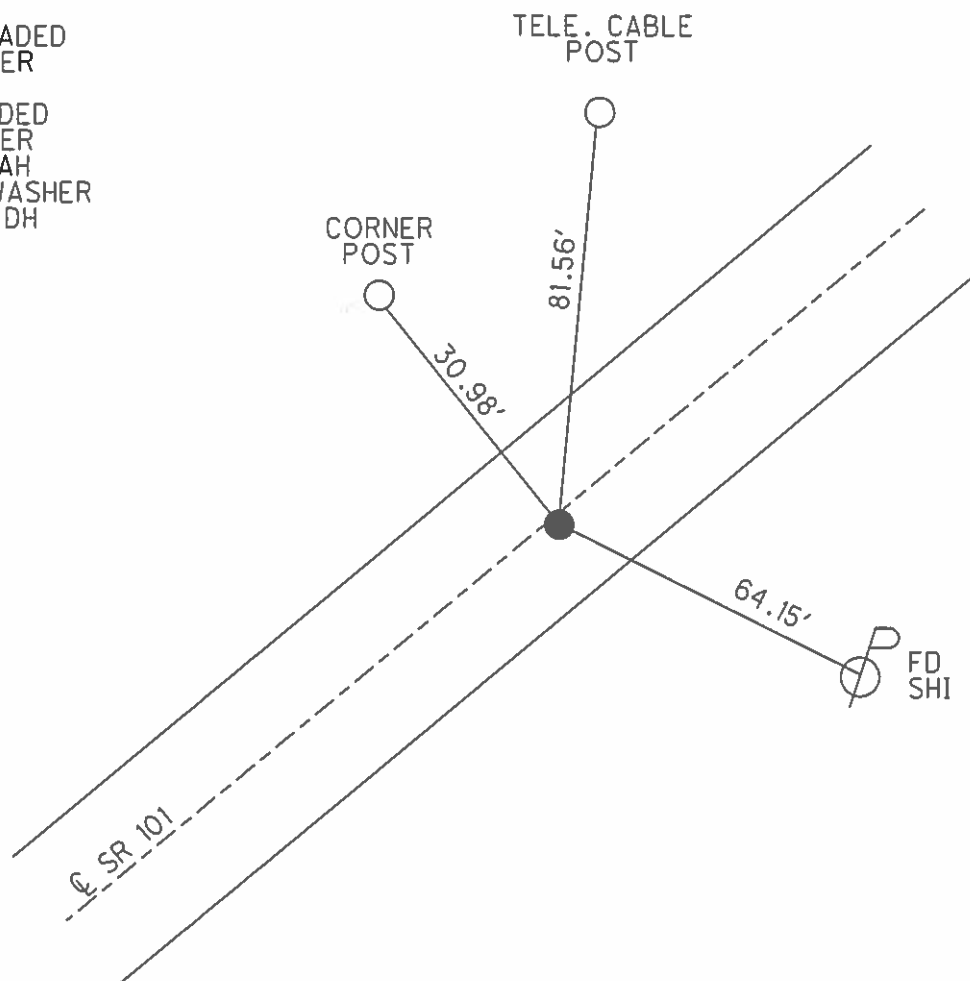

O.D.O.T. DISTRICT 2 SURVEY OFFICE

PERSONNEL

REFERENCE NO. 55

SHEET 30 OF 41

NOTES Ripple

H.C. BARKHUR

R.C. SEYMAN

DATE 8-28-90

WEATHER SUNNY

TEMP. 88°

ROUTE 101

COUNTY Sen

TOWNSHIP Adams

SECTION 9

T 3 N R 16 E


TYPE MONUMENT Sq. Headed Nail & Washer

ON SURFACE - BELOW R/R spike 4" down

LEFT - ℄ PAV'T. - RIGHT 1' RT. ℄

TO EDGE PAVEMENT

S.L.M. _____

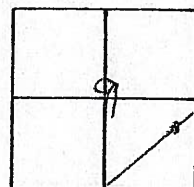

644+50

STA. 134+65


Tele. Cable
Post

81.59

Cor. Post

30.92

64.13'

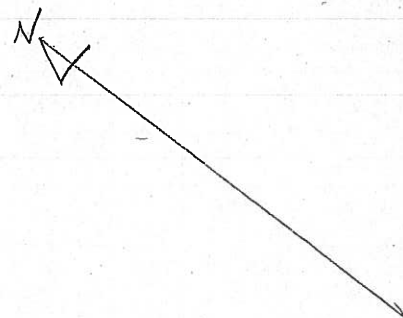

FJ

2-7-05

SAH

O.D.O.T. DISTRICT 2 SURVEY OFFICE

PERSONNEL

REFERENCE NO. 55

SHEET 30 OF 41

NOTES Ripple

H.C. BARBOUR

R.C. SEYMAN

DATE 8-28-90

WEATHER SUNNY

TEMP. 88°

ROUTE 101

COUNTY Sen

TOWNSHIP ADAMS

SECTION 9

T 3 N R 16 E


TYPE MONUMENT Sq. Headed Nail + Washer

ON SURFACE - BELOW R/R spike 4" down

LEFT-℄ PAV'T. - RIGHT 1' RT. ℄

TO EDGE PAVEMENT

S.L.M.

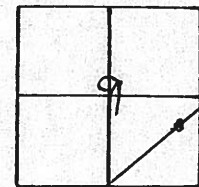

STA. 134+65


Tk. Cable
Post

81.59

Cor. Post

30.92

64.13'

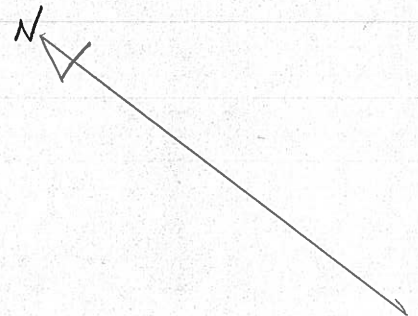

PERSONNEL TITLE PERSONNEL TITLE

COUNTY Seneca

DATE 2-11-64

Krabill

Kowaleski

Geyman

Bruggeman

S. R. # 101

WEATHER

SEC.

TEMP.

DESCRIPTION S. R. # 101 Tiffin to Sen. Co. Line

JOB NO.


LEFT

CENTER LINE

RIGHT


55

STA. 134+65

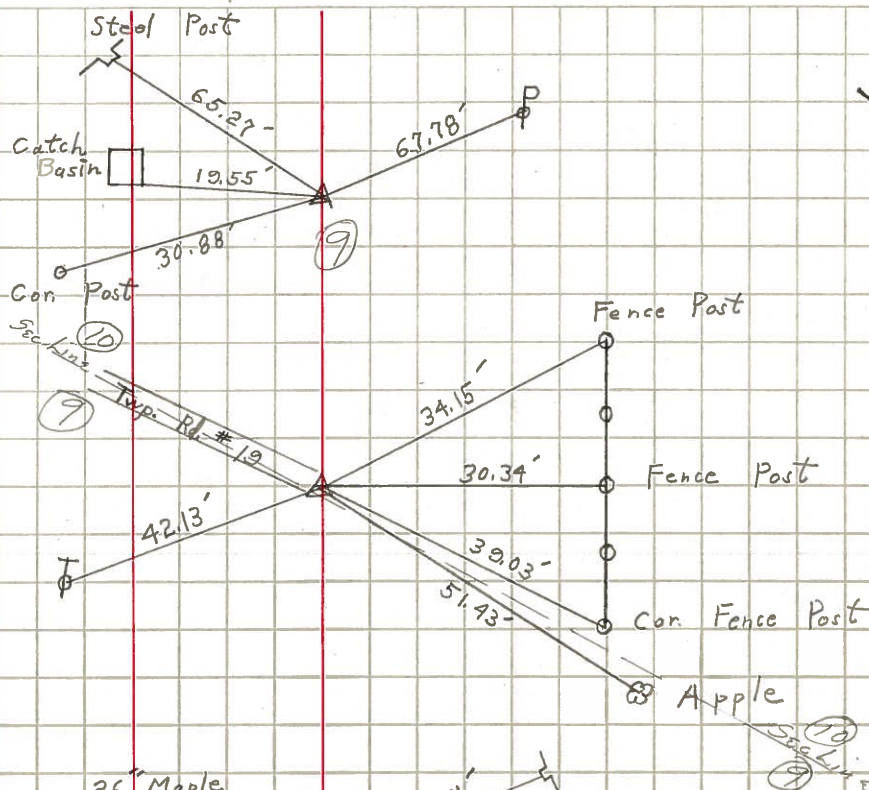R. R. Spike
405


56

STA. 144+34.30'

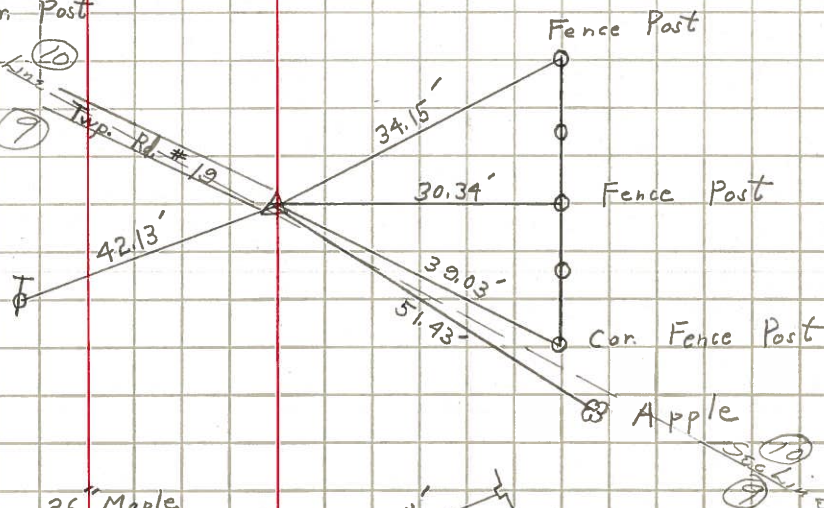R. R. Spike
406


57

STA. 160+00

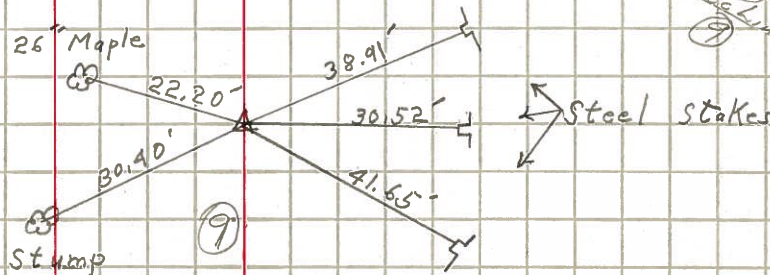Iron Pin
407

58

STA. 173+00

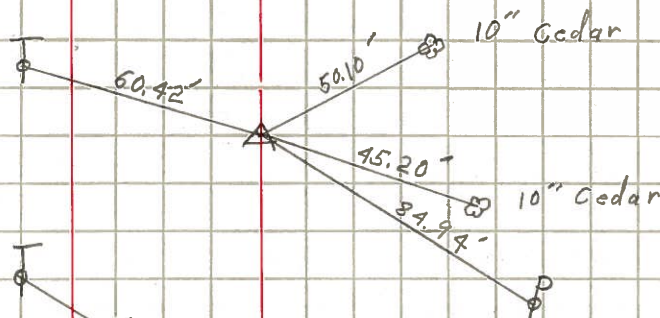Iron Pin
408

59

STA. 181+00

Iron Pin
409