

O.D.O.T. DISTRICT 2 SURVEY OFFICE (USE ONLY)

PERSONNEL

REFERENCE NO. 56

SHEET 33 OF 46

NOTES MILLER

DATE 8/7/24

ROUTE SR 101

H.C. MILLER

WEATHER WINDY

COUNTY SENECA

R.C. BARRIERE

TEMP. 70°F

TOWNSHIP ADAMS

BLUBAUGH, ASTON, PRESTON-COLVIN

SECTION 10

DWG BY BLUBAUGH

PID 114849

T 3 N R 16 E

TYPE MONUMENT MAG/WASHER

ON ~~SURFACE~~ - BELOW 0.5"

OFFSET Q PAVEMENT 1' LT : RT

-- TO -- EDGE PAVEMENT

STATION: 654+20

HORIZ.DATUM: NAD83 (2011)


GEOID: NAVD88-2018

GRID: NORTHING: 571232.451


EASTING: 1826832.820

LDP: NORTHING: 340296.779

EASTING: 201154.113

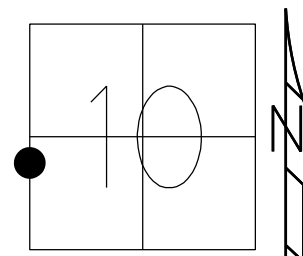

RECORD:
STA. 144+34.3
FD IPIPE
5" DOWN
SET SQ.HEADED
NAIL/WASHER
8/28/90, BARBOUR
FD SQ.HEADED
NAIL/WASHER
2/7/05, SAH
FD P.K.NAIL
REF56
7/8/09, DCH
SET MAG/WASHER
NEWREF56
10-06-09, DH
FD MAG/WASHER
REF56
6/15/16
9/19/17, JFO
FD MAG/W
REF56
12/12/23, TDN
FD TONE. DID NOT
UNCOVER. PAINTED
8/7/24, JAM

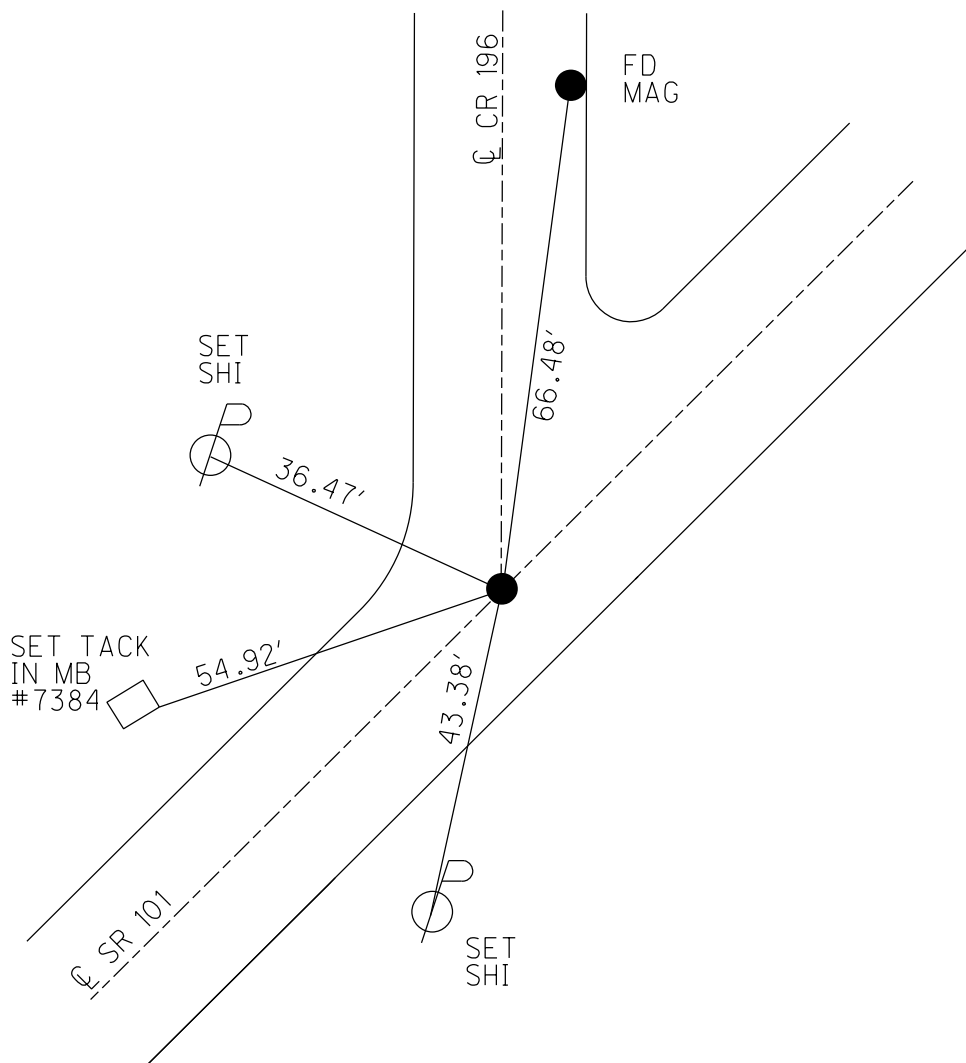

O.D.O.T. DISTRICT 2 SURVEY OFFICE (USE ONLY)

PERSONNEL

REFERENCE NO. 56

SHEET 35 OF 46

NOTES HOMAN

DATE 7-8-09

ROUTE SR 101

H.C. HOMAN

WEATHER SUNNY

COUNTY SENECA

R.C. ROUSOS

TEMP. 80°F

TOWNSHIP ADAMS

SECTION 10

DWG BY MAHLER

PID 100787

T 3 N R 16 E

TYPE MONUMENT P.K.NAIL

ON SURFACE - ~~BELOW~~ ON

OFFSET Q PAVEMENT ON LT : RT

- TO - EDGE PAVEMENT


STATION: 654+20

HORIZ.DATUM: NAD83 (2011)


GEOID: NAVD88-2012A

GRID: NORTHING: 571232.451

EASTING: 1826832.820

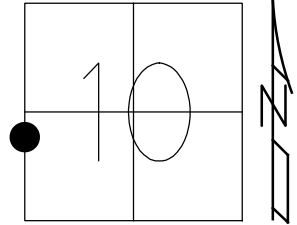


RECORD:
STA.144+34.3
FD IPIPE
5" DOWN
SET SQ.HEADED
NAIL/WASHER
8/28/90, BARBOUR
FD SQ.HEADED
NAIL/WASHER
2/7/05, SAH
FD P.K.NAIL
REF56
7/8/09, DCH
SET MAG/WASHER
NEWREF56
10-06-09, DH
FD MAG/WASHER
REF56
6/15/16
9/19/17, JFO

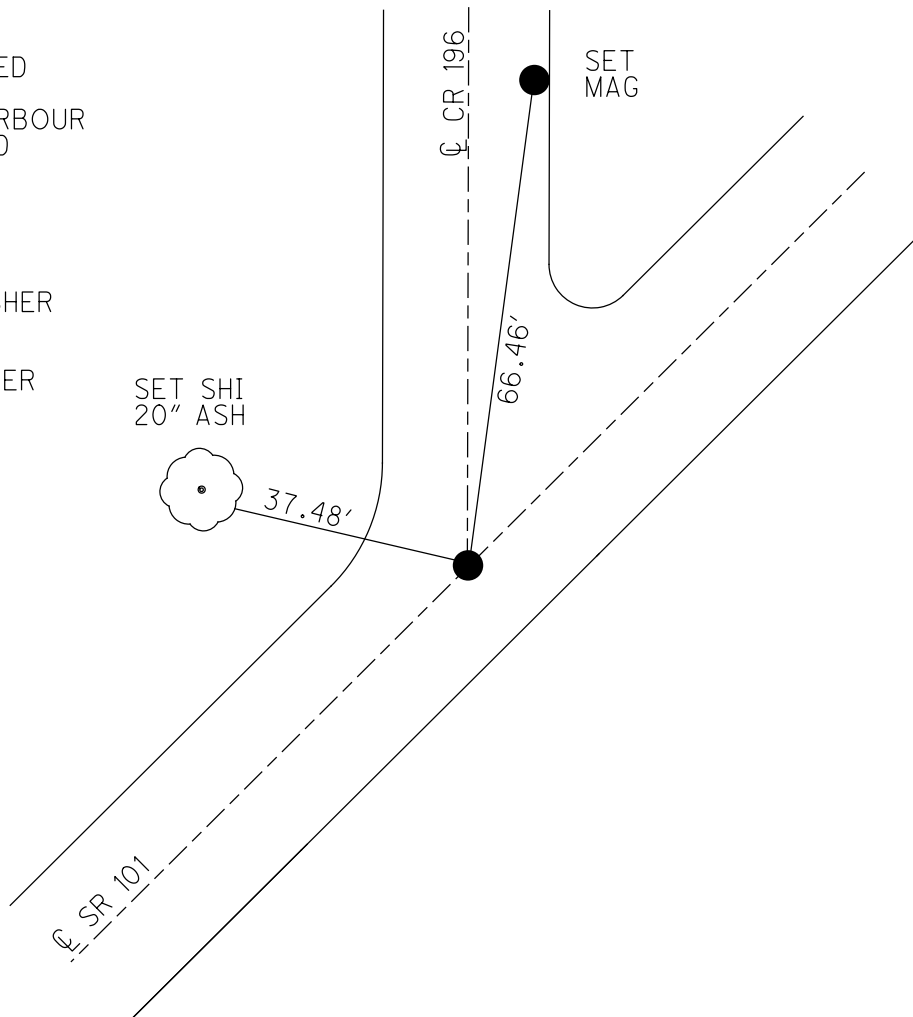

O.D.O.T. DISTRICT 2 SURVEY OFFICE (USE ONLY)


PERSONNEL	REFERENCE NO. <u>56</u>	SHEET <u>35</u> OF <u>46</u>
NOTES	DATE <u>7/08/09</u>	ROUTE <u>SR 101</u>
H.C. <u>HOMAN</u>	WEATHER <u>SUNNY</u>	COUNTY <u>SENECA</u>
R.C. <u>ROUSOS</u>	TEMP. <u>80°</u>	TOWNSHIP <u>ADAMS</u>
		SECTION <u>10</u>
		T <u>3</u> N R <u>16</u> E

TYPE MONUMENT P.K.NAIL
 ON SURFACE - ~~BELOW~~ ON
 LEFT - Q PAV'T - RIGHT ON
- TO - EDGE PAVEMENT
 S.L.M. 654+20

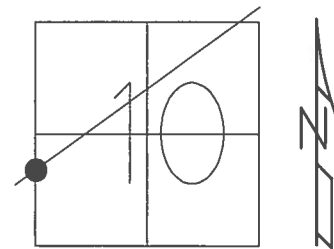

GRID: NORTHING: 571232.451 EASTING: 1826832.820


RECORD:
 STA.144+34.3
 FD IPIPE
 5" DOWN
 SET SQ.HEADED
 NAIL/WASHER
 8/28/90
 FD SQ.HEADED
 NAIL/WASHER
 2/7/05, SAH
 SET MAG/WASHER
 10-06-09, DH
 FD MAG/WASHER
 REF56
 6/15/16, JFO
 UNCOVERED
 9/19/17, JFO

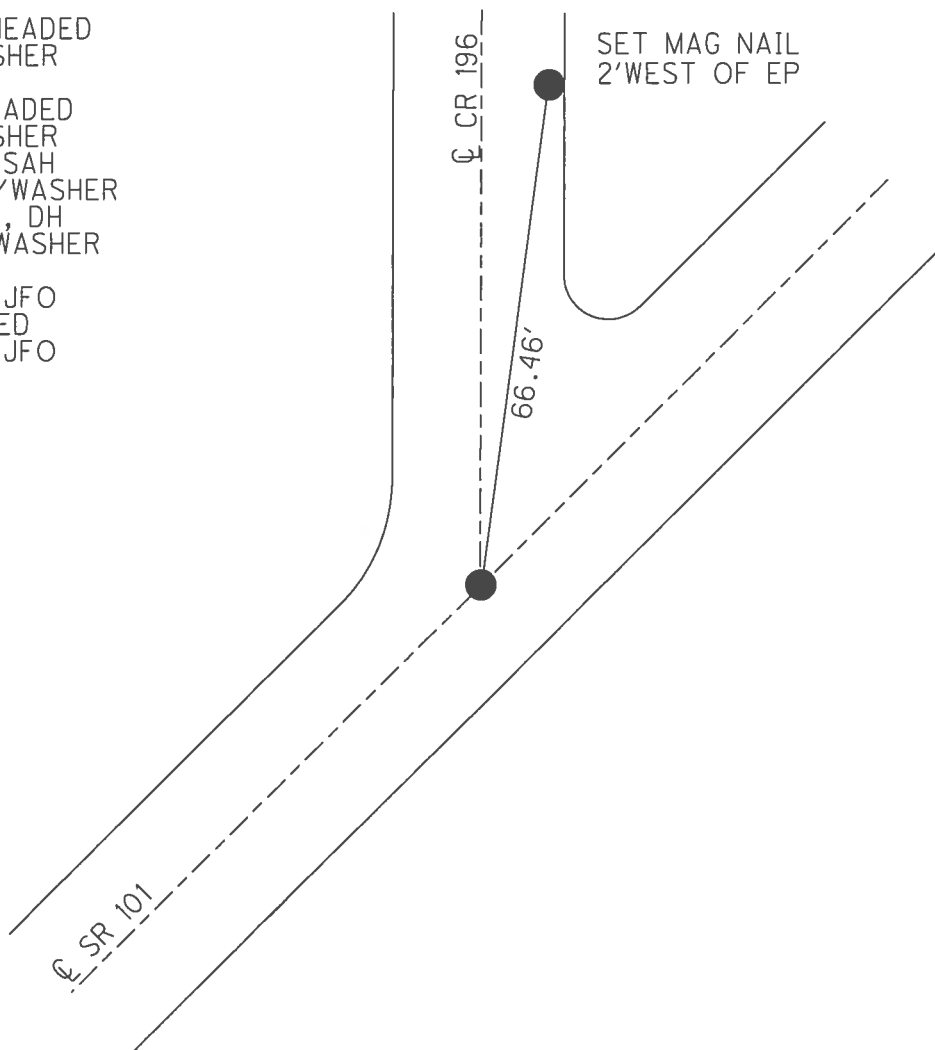

O.D.O.T. DISTRICT 2 SURVEY OFFICE (USE ONLY)


PERSONNEL _____ REFERENCE NO. 56 SHEET 35 OF 46
 NOTES HOMAN DATE 7/08/09 ROUTE SR 101
 H.C. HOMAN WEATHER SUNNY COUNTY SENECA
 R.C. ROUSOS TEMP. 80° TOWNSHIP ADAMS
 SECTION 10
 T 3 N R 16 E

TYPE MONUMENT P.K.NAIL
 ON SURFACE - ~~BELOW~~ ON
 LEFT - Q PAV'T - RIGHT ON
 - TO - EDGE PAVEMENT
 S.L.M. 654+20

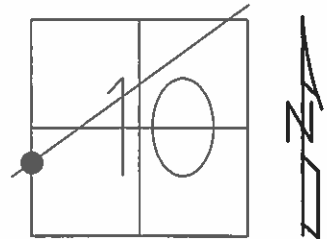

GRID: NORTHING: 571232.473 EASTING: 1826832.784

RECORD:
 STA. 144+34.3
 FD IPIPE
 5" DOWN
 SET SQ. HEADED
 NAIL/WASHER
 8/28/90
 FD SQ. HEADED
 NAIL/WASHER
 2/7/05, SAH
 SET MAG/WASHER
 10-06-09, DH

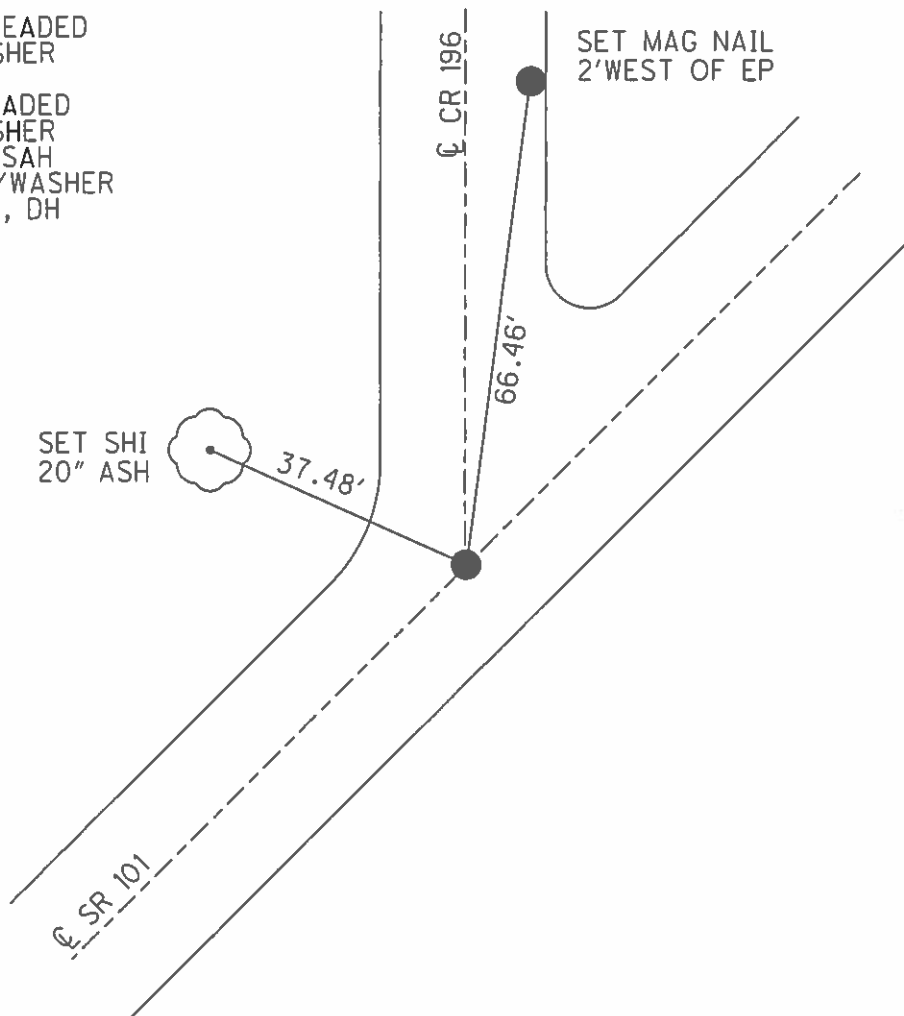

O.D.O.T. DISTRICT 2 SURVEY OFFICE

PERSONNEL

REFERENCE NO. 56

SHEET 31 OF 41

NOTES Ripok

H.C. Barbour

R.C. Geyman

DATE 8-28-90

WEATHER Sunny

TEMP. 89°

ROUTE 101


COUNTY Sen

TOWNSHIP Adams

SECTION 10


T 3 N R 16 E

TYPE MONUMENT 5/8" Headed Nail + Washer
ON SURFACE - BELOW IRON Pipe 5" down
LEFT - PAV'T. - RIGHT £
TO EDGE PAVEMENT
S.L.M. _____

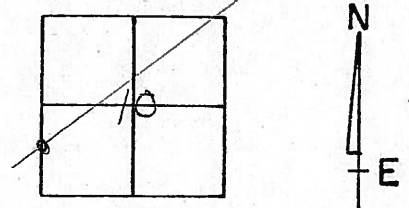

STA. 144+34.3

654+20

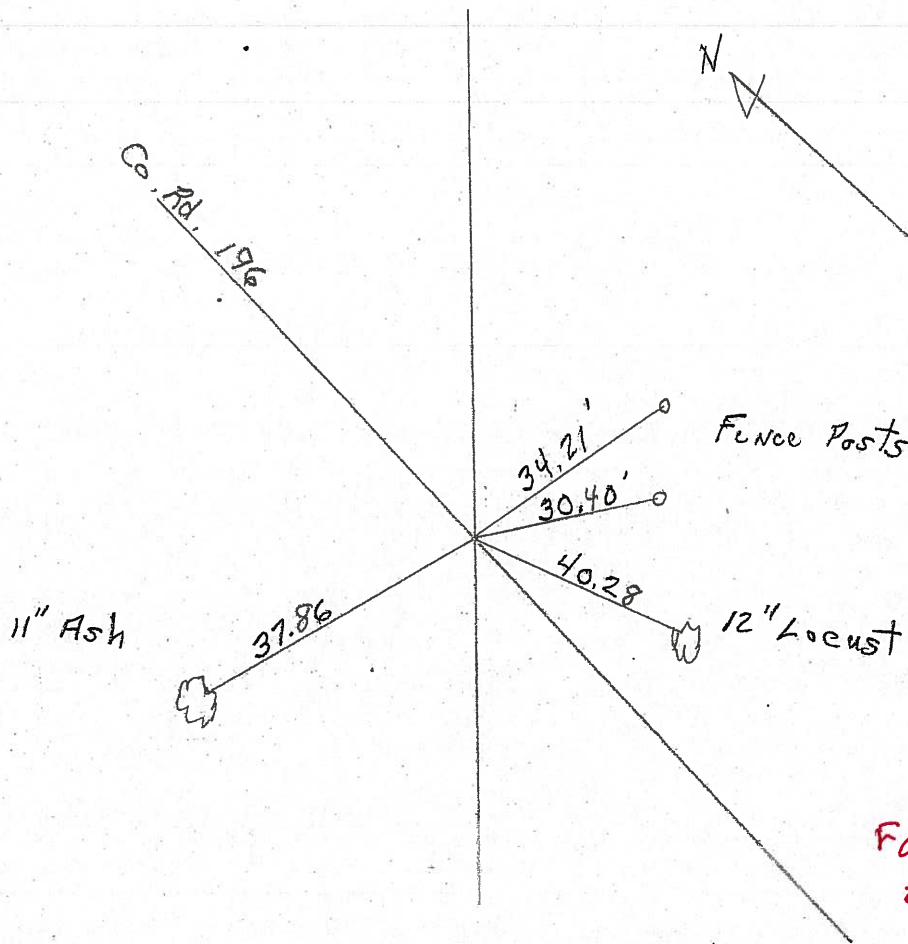

O.D.O.T. DISTRICT 2 SURVEY OFFICE

PERSONNEL

REFERENCE NO. 56

SHEET 31 OF 41

NOTES Ripple

H.C. Barbour

R.C. Geyman

DATE 8-28-90

WEATHER SUNNY

TEMP. 89°

ROUTE 101


COUNTY Sen

TOWNSHIP Adams


SECTION 10

T3 N R16 E

TYPE MONUMENT So. Headed Nail + Washer
ON SURFACE - BELOW IRON Pipe 5" down
LEFT - PAV'T. - RIGHT E
TO EDGE PAVEMENT
S.L.M. _____

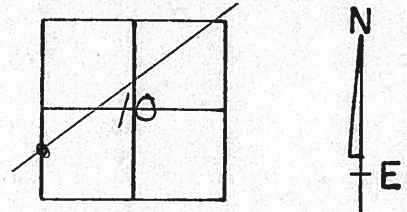

STA. 144 + 34.3

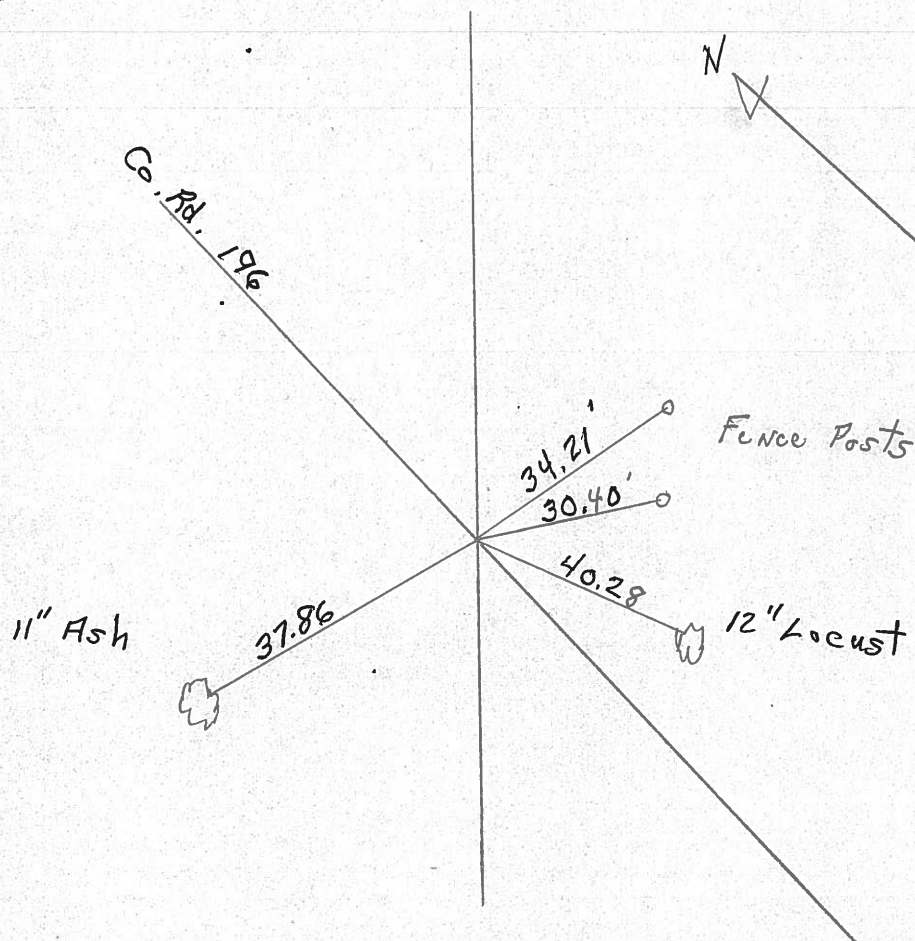

PERSONNEL	TITLE	PERSONNEL	TITLE
1	2	3	4
5	6	7	8
9	10	11	12
13	14	15	16
17	18	19	20
21	22	23	24
25	26	27	28
29	30	31	32
33	34	35	36
37	38	39	40
41	42	43	44
45	46	47	48
49	50	51	52
53	54	55	56
57	58	59	60
61	62	63	64
65	66	67	68
69	70	71	72
73	74	75	76
77	78	79	80
81	82	83	84
85	86	87	88
89	90	91	92
93	94	95	96
97	98	99	100

COUNTY Seneca

DATE 2-14-64

Krabill

Kongreski

Geyman

Bruggeman

S. R. # 101

WEATHER

SEC.

TEMP

DESCRIPTION S.R. # 101 Tiffn to San. Co. Line

JOB NO

LEFT

CENTER LINE

RIGHT

STA. 134+6.5

R. R.	Spike	
	#	40.5

STA. 144+34.30

R. R. Spike
406

STA. 165+00

Iron Pin #407

STA. 173+00

Iron Pipe # 408

STA 181+00

Iron Pin # 409

