

O.D.O.T. DISTRICT 2 SURVEY OFFICE (USE ONLY)

PERSONNEL

REFERENCE NO. 57

SHEET 36 OF 46

NOTES MILLER

DATE 8/7/24

ROUTE SR 101

H.C. MILLER

WEATHER SUNNY

COUNTY SENECA

R.C. BARRIERE

TEMP. 70°F

TOWNSHIP ADAMS

BLUBAUGH, ASTON, PRESTON-COLVIN

SECTION 10

DWG BY BLUBAUGH

PID 114849

T 3 N R 16 E

TYPE MONUMENT MAG/WASHER

ON ~~SURFACE~~ - BELOW 0.5"

OFFSET Q PAVEMENT 1' ~~LT~~ : RT

-- TO -- EDGE PAVEMENT

STATION: 669+83

HORIZ.DATUM: NAD83 (2011)


GEOID: NAVD88-2018

GRID: NORTHING: 572234.022


EASTING: 1828028.785

LDP: NORTHING: 341307.351

EASTING: 202342.691

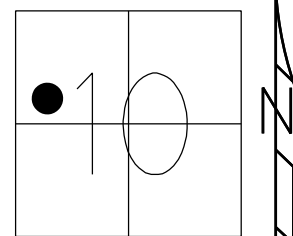

RECORD:
 STA. 160+00
 FD R.R. SPIKE
 4" DOWN
 8/28/90, BARBOUR
 FD P.K./WASHER
 2" DOWN
 7/7/05, SAH
 FD P.K./WASHER
 REF57
 7/8/09, DCH
 SET MAG/WASHER
 NEWREF57
 10/6/09, DH
 FD MAG/WASHER
 REF57
 6/15/16
 9/19/17, JFO
 FD MAG/W
 REF57
 12/12/23, TDN
 FD TONE. DID NOT
 UNCOVER. PAINTED
 8/7/24, JAM

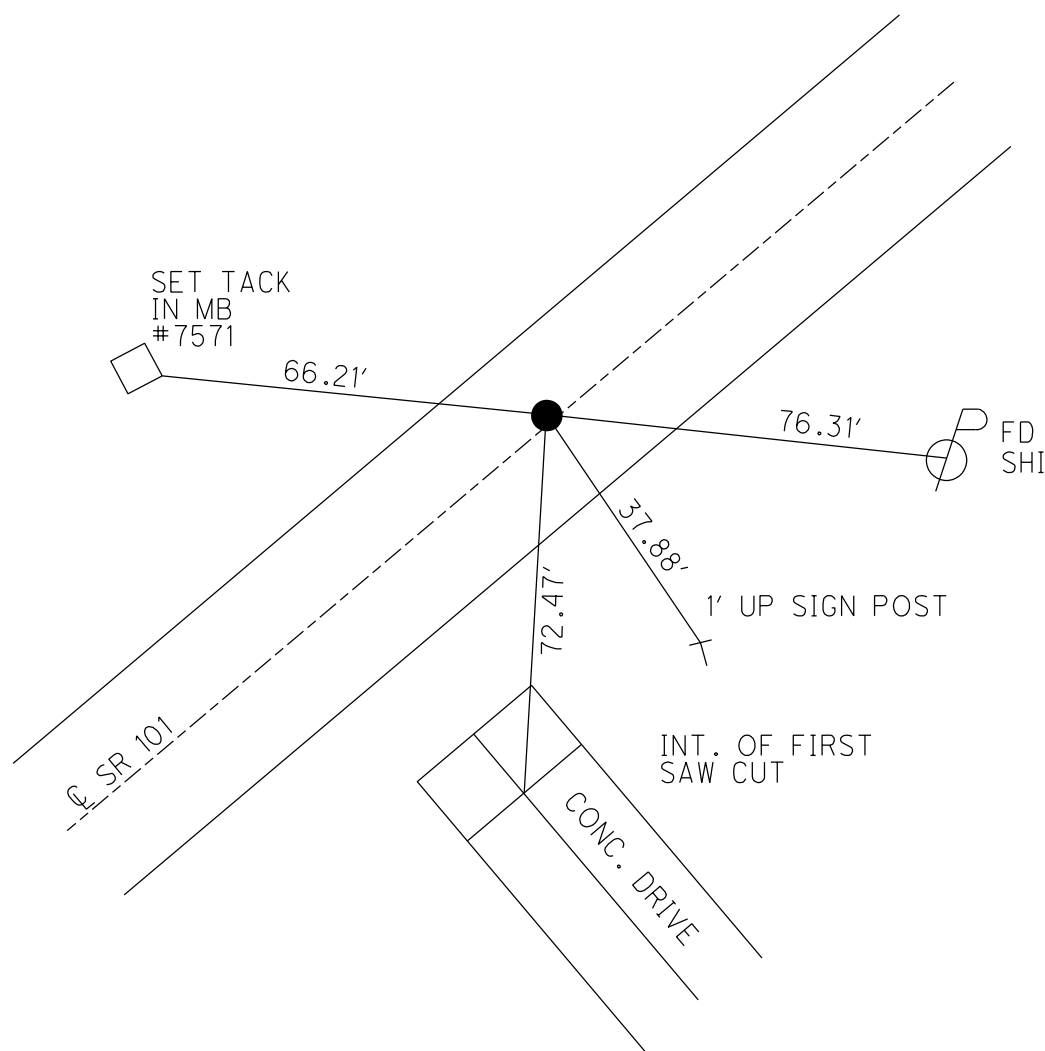

O.D.O.T. DISTRICT 2 SURVEY OFFICE (USE ONLY)

PERSONNEL

REFERENCE NO. 57

SHEET 36 OF 46

NOTES HOMAN

DATE 7-8-09

ROUTE SR 101

H.C. HOMAN

WEATHER SUNNY

COUNTY SENECA

R.C. ROUSOS

TEMP. 80°F

TOWNSHIP ADAMS

DWG BY MAHLER PID 100787

SECTION 10

T 3 N R 16 E

TYPE MONUMENT P.K. NAIL

ON SURFACE - ~~BELOW~~ ON

OFFSET Q PAVEMENT 1' LT : ~~RT~~

- TO - EDGE PAVEMENT


STATION: 669+83

HORIZ. DATUM: NAD83 (2011)

GEOID: NAVD88-2012A


GRID: NORTHING: 572234.022

EASTING: 1828028.785

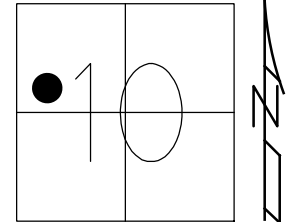

RECORD:

STA. 160+00
FD R.R. SPIKE
4" DOWN
8/28/90, BARBOUR
FD P.K./WASHER
2" DOWN
7/7/05, SAH
FD P.K./WASHER
REF57
7/8/09, DCH
SET MAG/WASHER
NEWREF57
10/6/09, DH
FD MAG/WASHER
REF57
6/15/16
9/19/17, JFO

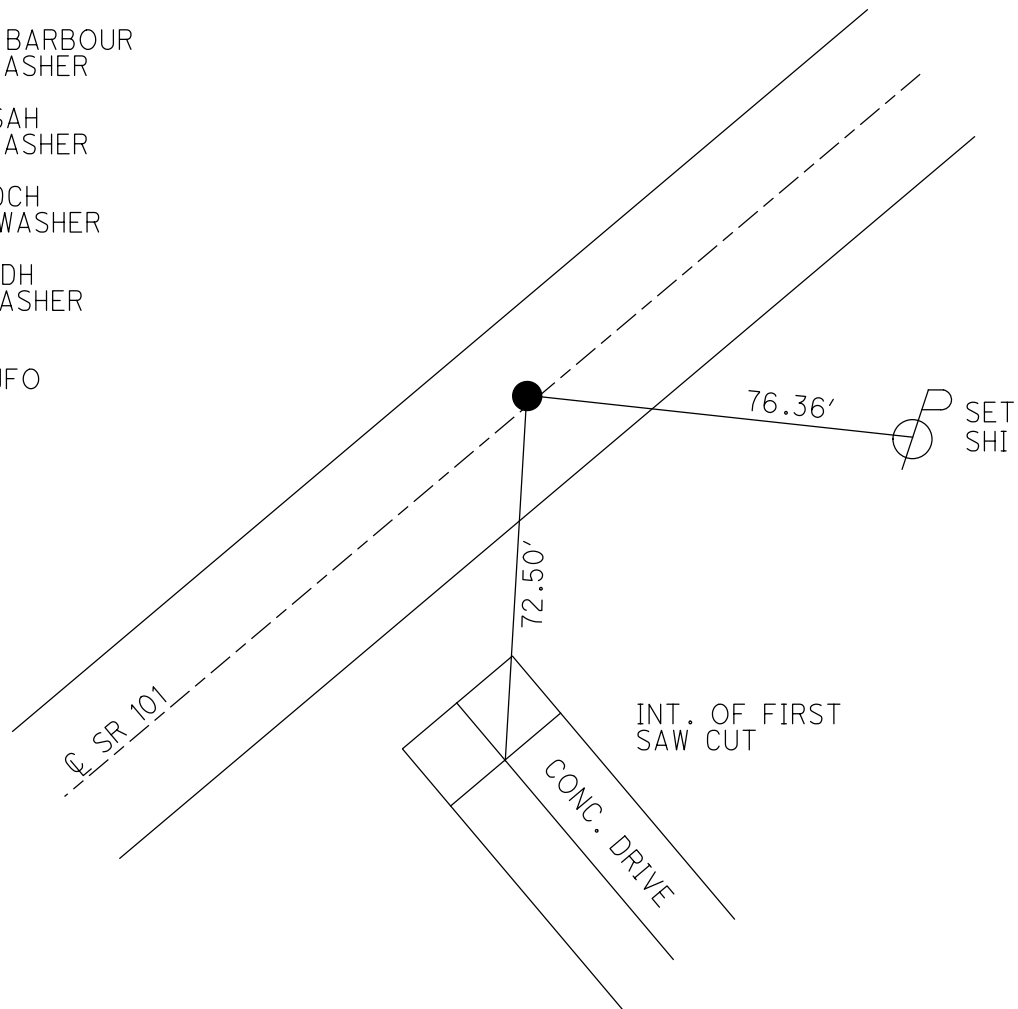


O.D.O.T. DISTRICT 2 SURVEY OFFICE (USE ONLY)


PERSONNEL	REFERENCE NO. <u>57</u>	SHEET <u>36</u> OF <u>46</u>
NOTES	DATE <u>7/08/09</u>	ROUTE <u>SR 101</u>
H.C. <u>HOMAN</u>	WEATHER <u>SUNNY</u>	COUNTY <u>SENECA</u>
R.C. <u>ROUSOS</u>	TEMP. <u>80°</u>	TOWNSHIP <u>ADAMS</u>
		SECTION <u>10</u>
		T <u>3</u> N R <u>16</u> E

TYPE MONUMENT P.K.NAIL
~~ON SURFACE~~ - BELOW ON
~~LEFT~~ - CL PAV'T - RIGHT 1'
- TO - EDGE PAVEMENT
 S.L.M. 669+83

GRID: NORTHING: 572234.022 EASTING: 1828028.785

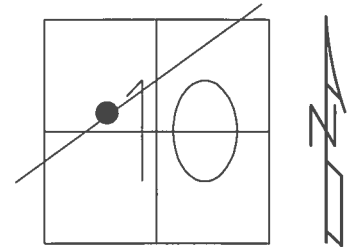


RECORD:
 STA. 160+00
 FD R.R. SPIKE
 4" DOWN
 8/28/90
 FD P.K./WASHER
 2" DOWN, 1' RT CL
 7/7/05, SAH
 SET MAG/WASHER
 10/6/09, DH
 FD MAG/WASHER
 REF57
 6/15/16, JFO
 UNCOVERED
 9/19/17, JFO

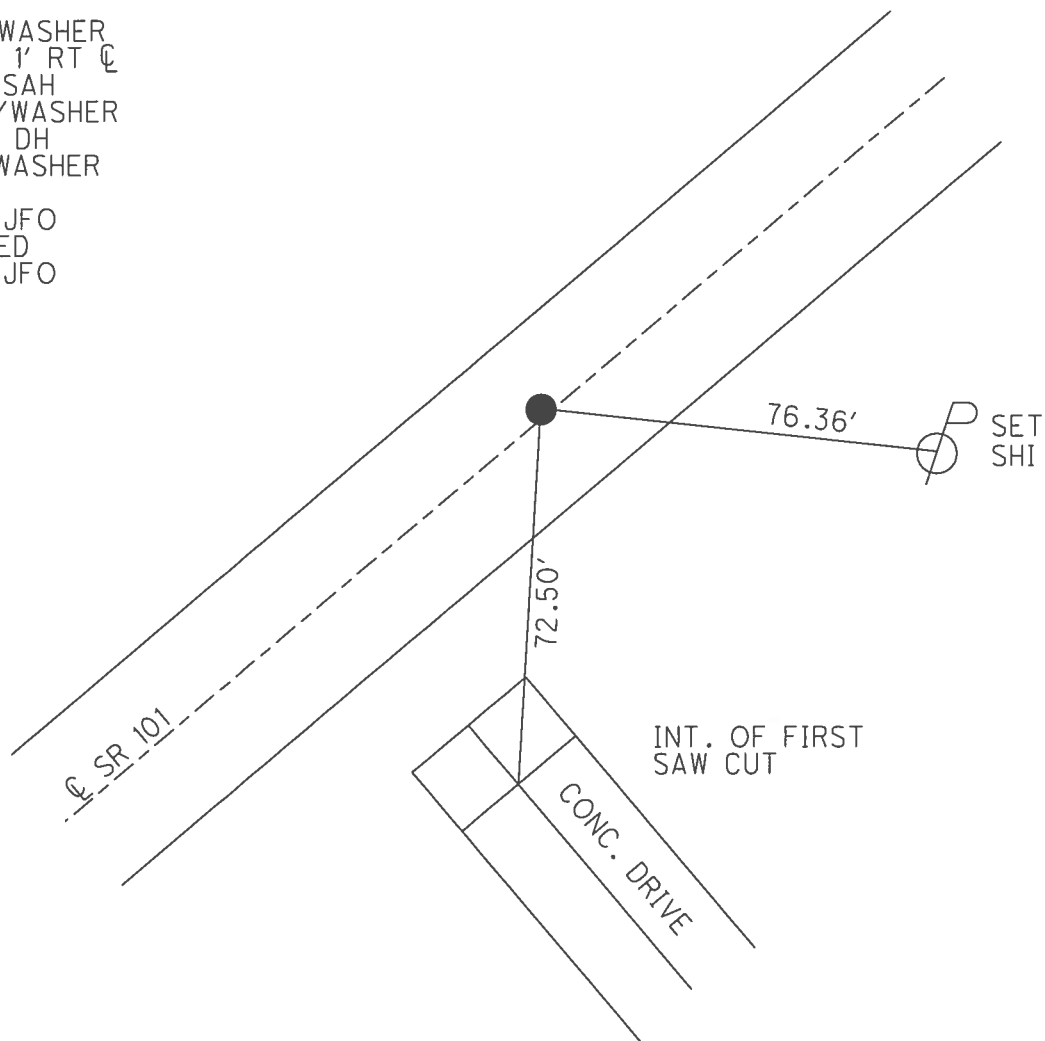

O.D.O.T. DISTRICT 2 SURVEY OFFICE (USE ONLY)


PERSONNEL _____ REFERENCE NO. 57 SHEET 36 OF 46
 NOTES HOMAN DATE 7/08/09 ROUTE SR 101
 H.C. HOMAN WEATHER SUNNY COUNTY SENECA
 R.C. ROUSOS TEMP. 80° TOWNSHIP ADAMS
 _____ SECTION 10
 _____ T 3 N R 16 E

TYPE MONUMENT P.K.NAIL
~~ON SURFACE~~ - BELOW ON
 LEFT - ℄ PAV'T - ~~RIGHT~~ 1'
 - TO - EDGE PAVEMENT
 S.L.M. 669+83

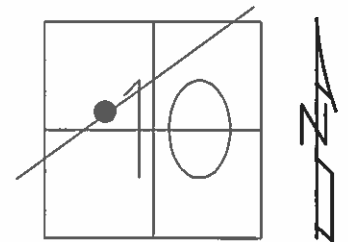

GRID: NORTHING: 572234.023 EASTING: 1828028.760

RECORD:
 STA. 160+00
 FD R.R. SPIKE
 4" DOWN
 8/28/90
 FD P.K./WASHER
 2" DOWN, 1' RT ℄
 7/7/05, SAH
 SET MAG/WASHER
 10/6/09, DH

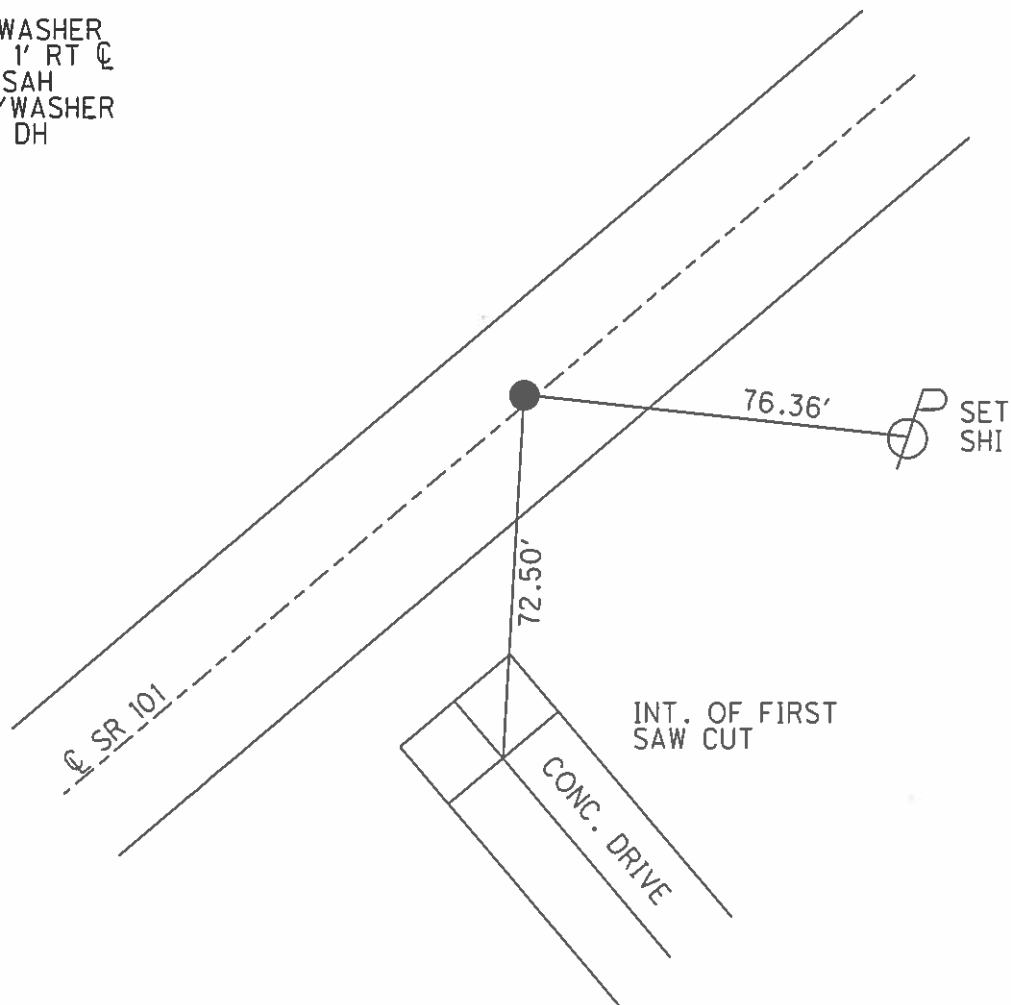

O.D.O.T. DISTRICT 2 SURVEY OFFICE

PERSONNEL

REFERENCE NO. 57

SHEET 32 OF 41

NOTES Ripple

H.C. Barkour

R.C. Geyman

DATE 8-28-90

WEATHER Sunny

TEMP. 89°

ROUTE 101

COUNTY Sen

TOWNSHIP Adams

SECTION 10

T. 3 N R. 16 E


TYPE MONUMENT

ON SURFACE - BELOW R/L Spike 4" down

LEFT - ¢ PAV'T. - RIGHT 1' LT. ¢

TO EDGE PAVEMENT

S.L.M. _____

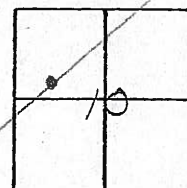

669+83

STA 160

Located with Metal Detector


No possible Ties

ON Top of Hill

Fd PK/W
 2" down
 1' Rt of ¢

 SAH/DH
 07-07-05

Fd hole
 2-7-05
 SAH

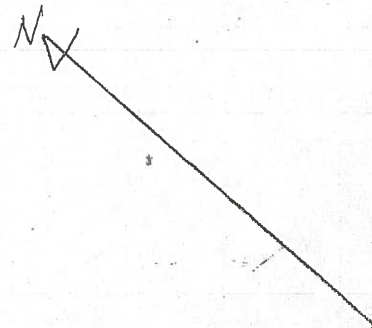

O.D.O.T. DISTRICT 2 SURVEY OFFICE

PERSONNEL

REFERENCE NO. 57

SHEET 32 OF 41

NOTES Ripple

H.C. Barkour

R.C. Peyman

DATE 8-28-90

WEATHER Sunny

TEMP. 89°

ROUTE 101

COUNTY Sen

TOWNSHIP Adams

SECTION 10

T 3 N R 16 E


TYPE MONUMENT

ON SURFACE - BELOW R/c Spike 4" down

LEFT - ¢ PAV'T. - RIGHT 1' LT. ¢

TO EDGE PAVEMENT

S.L.M.

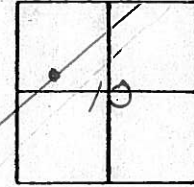


STA 160

Located with Metal Detector

No possible Ties

ON Top of Hill

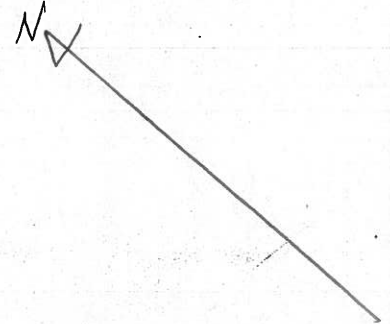

PERSONNEL	TITLE	PERSONNEL	TITLE
1	1	1	1
2	2	2	2
3	3	3	3
100	100	100	100

COUNTY Seneca

DATE 2-14-64

Krabbill

Kowaleski

Geyman

Bruggeman.

S. R. [#] 101

WEATHER

SEC.

TEMP.

DESCRIPTION S.R. # 101 Tiffin to San. Co. Line

JOB NO.**LEFT**

CENTER LINE

RIGHT

JOB NO.

STA. 134+65
R/R. Spike
405

STA. 144+34.30'
R.R. Spike
406

STA. 165+00
Iron Pin
407

STA. 173+00
Iron Pipe
408

STA. 181+00
Iron Pile # 409

