

O.D.O.T. DISTRICT 2 SURVEY OFFICE (USE ONLY)

PERSONNEL

REFERENCE NO. 61

SHEET 41 OF 46

NOTES MILLER

DATE 8/7/24

ROUTE SR 101

H.C. MILLER

WEATHER SUNNY

COUNTY SENECA

R.C. BARRIERE

TEMP. 75°F

TOWNSHIP ADAMS

BLUBAUGH, ASTON, PRESTON-COLVIN

SECTION 3

DWG BY BLUBAUGH

PID 114849

T 3 N R 16 E

TYPE MONUMENT MAG/WASHER

~~ON SURFACE~~ - BELOW 0.5"

OFFSET $\odot$ PAVEMENT ON ~~LT~~ : RT

-- TO -- EDGE PAVEMENT

STATION: 720.97

HORIZ.DATUM: NAD83 (2011)


GEOID: NAVD88-2018

GRID: NORTHING: 575519.992


EASTING: 1831940.301

LDP: NORTHING: 344622.753

EASTING: 206229.864

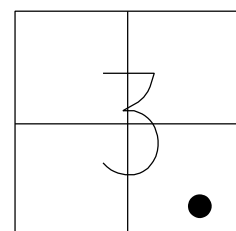

RECORD:
STA. 211+00
FD R.R. SPIKE
4" DOWN
SET P.K./WASHER
8/29/90, BARBOUR
FD P.K./WASHER
2/7/05, SAH
REF61
7/8/09, DCH
SET MAG/WASHER
NEWREF61
10-06-09, DH
FD MAG/WASHER
REF61
6/15/16, JFO
9/12/17, JMR
REF61
12/12/23, TDN
FD TONE. DID NOT
UNCOVER. PAINTED
8/7/24, JAM

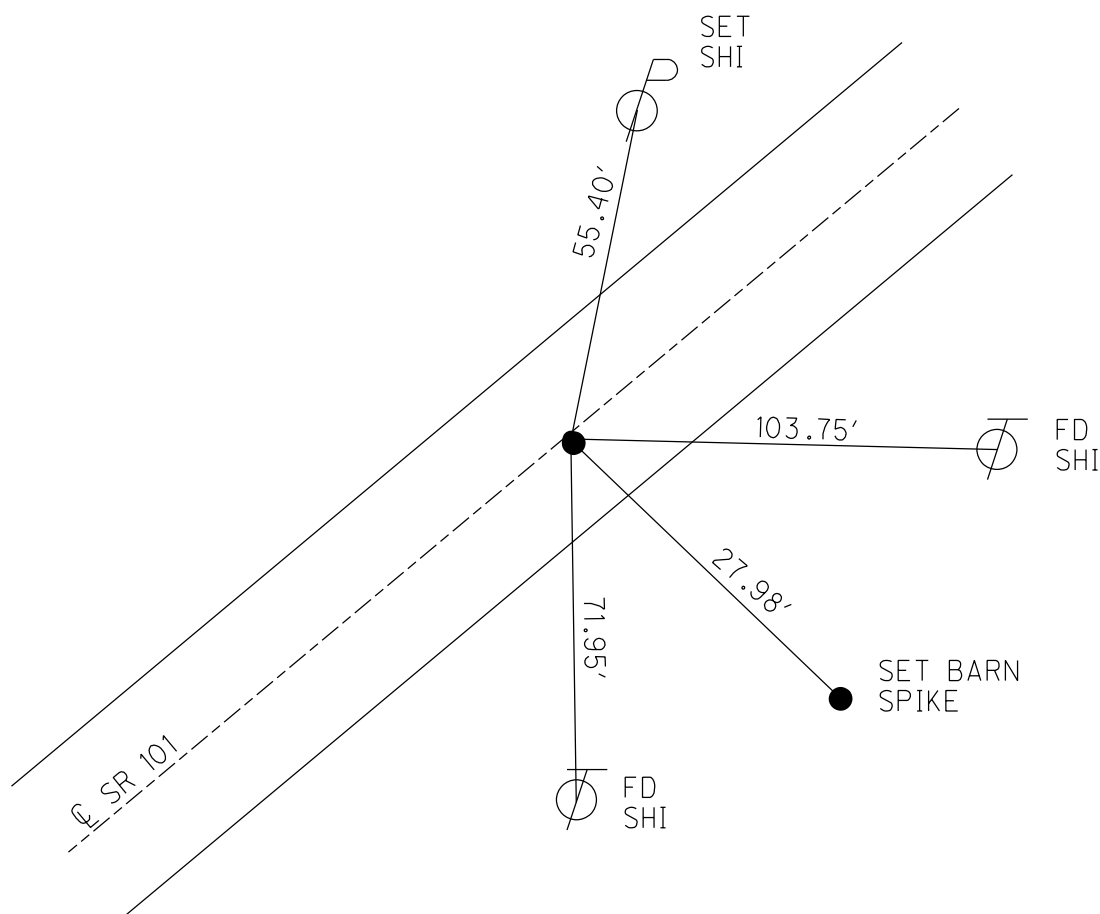

O.D.O.T. DISTRICT 2 SURVEY OFFICE (USE ONLY)

PERSONNEL

REFERENCE NO. 61

SHEET 41 OF 46

NOTES HOMAN

DATE 7-8-09

ROUTE SR 101

H.C. HOMAN

WEATHER SUNNY

COUNTY SENECA

R.C. ROUSOS

TEMP. 75°F

TOWNSHIP ADAMS

SECTION 3

DWG BY MAHLER

PID 100787

T 3 N R 16 E

TYPE MONUMENT P.K./WASHER

ON SURFACE - ~~BELOW~~ ON

OFFSET 0.5' LT : RT

- TO - EDGE PAVEMENT


STATION: 720+97

HORIZ.DATUM: NAD83 (2011)

GEOID: NAVD88-2012A

GRID: NORTHING: 575519.992

EASTING: 1831940.301

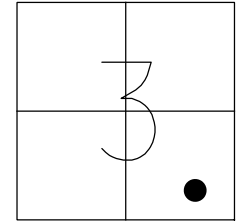

RECORD:

STA. 211+00

FD R.R. SPIKE

4" DOWN

SET P.K./WASHER

8/29/90, BARBOUR

FD P.K./WASHER

2/7/05, SAH

FD P.K./WASHER

REF61

7/8/09, DCH

SET MAG/WASHER

NEWREF61


10-06-09, DH

FD MAG/WASHER

REF61

6/15/16, JFO

9/12/17, JMR

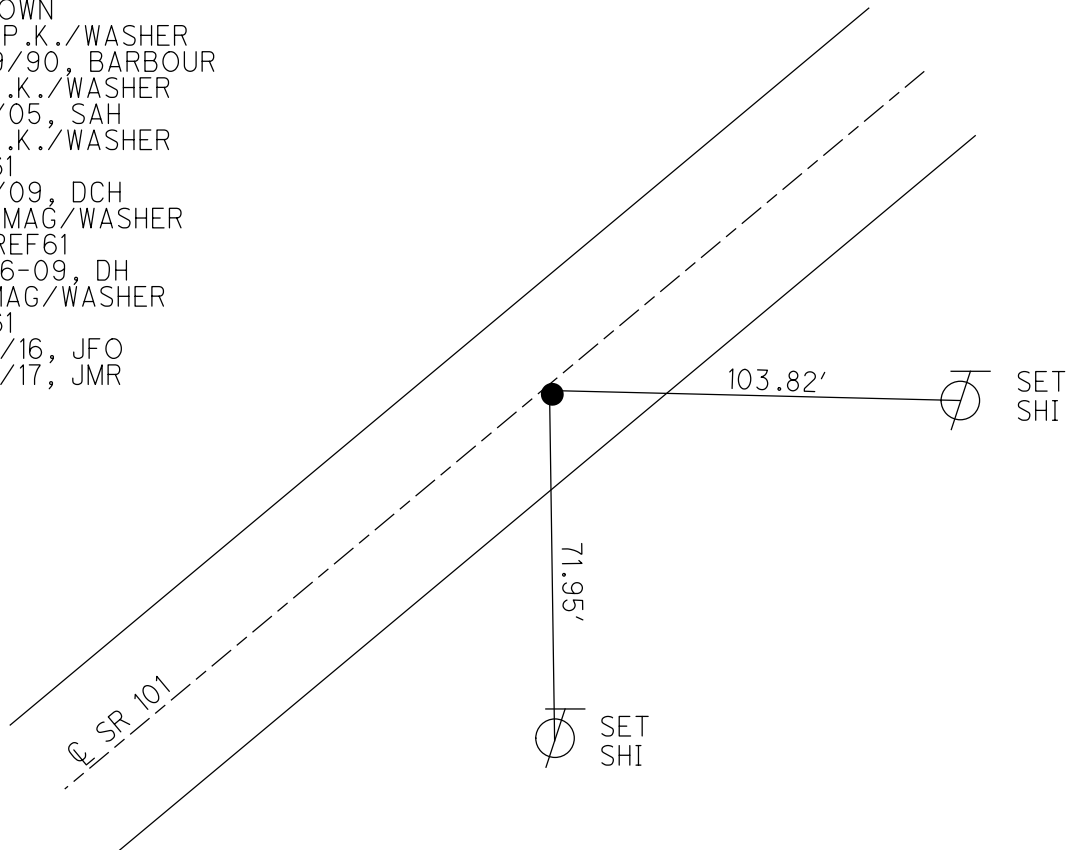


O.D.O.T. DISTRICT 2 SURVEY OFFICE (USE ONLY)


PERSONNEL	REFERENCE NO. <u>61</u>	SHEET <u>41</u> OF <u>46</u>
NOTES	DATE <u>7/08/09</u>	ROUTE <u>SR 101</u>
H.C. <u>HOMAN</u>	WEATHER <u>SUNNY</u>	COUNTY <u>SENECA</u>
R.C. <u>ROUSOS</u>	TEMP. <u>75°</u>	TOWNSHIP <u>ADAMS</u>
		SECTION <u>3</u>
		T <u>3</u> N R <u>16</u> E

TYPE MONUMENT P.K./WASHER
 ON SURFACE - ~~BELOW~~ ON
 LEFT - ℄ PAV'T - RIGHT ON
- TO - EDGE PAVEMENT
 S.L.M. 720+97

GRID: NORTHING: 575519.992 EASTING: 1831940.301

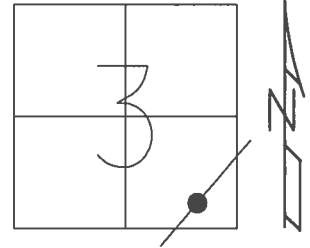

RECORD:
 STA. 211+00
 FD R.R. SPIKE
 4" DOWN
 SET P.K./WASHER
 8/29/90
 FD P.K./WASHER
 2/7/05, SAH
 SET MAG/WASHER
 10-06-09, DH
 FD MAG/WASHER
 REF61
 6/15/16, JFO
 UNCOVERED
 9/12/17, JMR

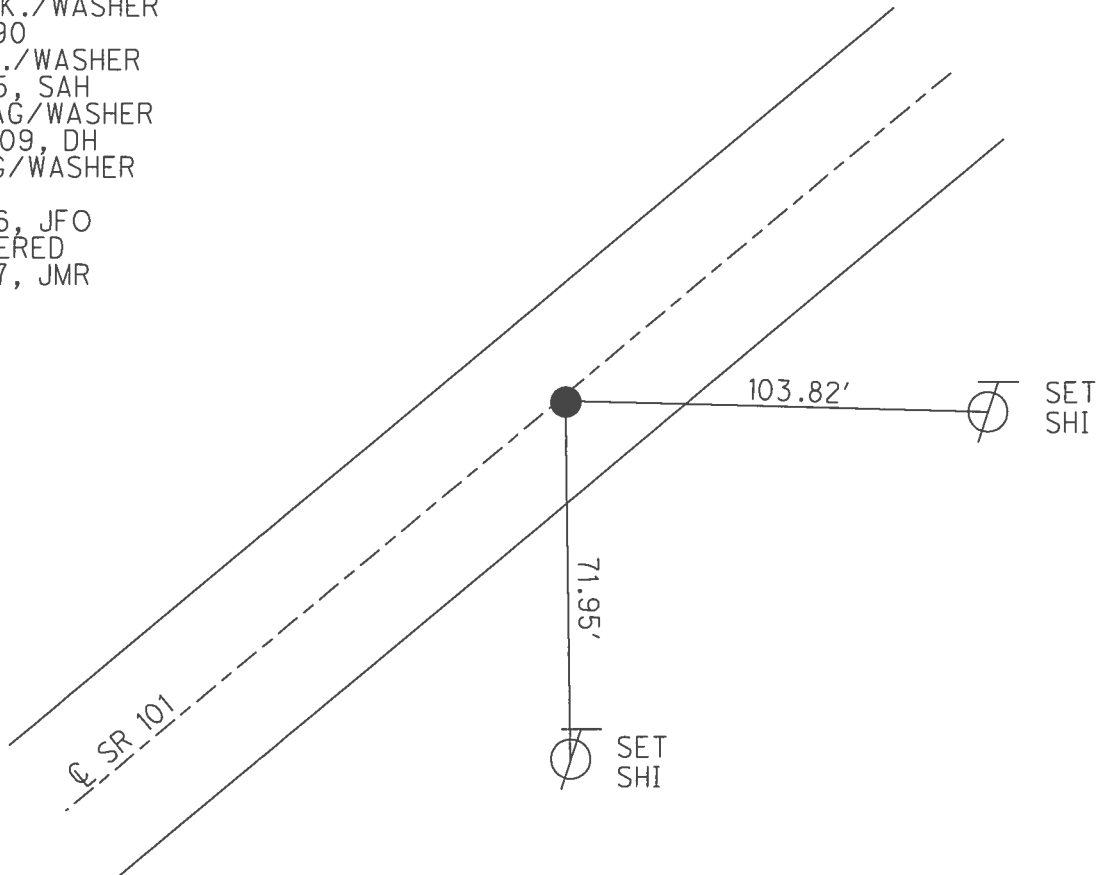

O.D.O.T. DISTRICT 2 SURVEY OFFICE (USE ONLY)

PERSONNEL _____ REFERENCE NO. 61 SHEET 41 OF 46
 NOTES HOMAN DATE 7/08/09 ROUTE SR 101
 H.C. HOMAN WEATHER SUNNY COUNTY SENECA
 R.C. ROUSOS TEMP. 75° TOWNSHIP ADAMS
 _____ SECTION 3
 _____ T 3 N R 16 E

TYPE MONUMENT P.K./WASHER


ON SURFACE - ~~BELOW~~ ON

LEFT - Q PAV'T - RIGHT ON


- TO - EDGE PAVEMENT

S.L.M. 720+97

GRID: NORTHING: 575520.034 EASTING: 1831940.141

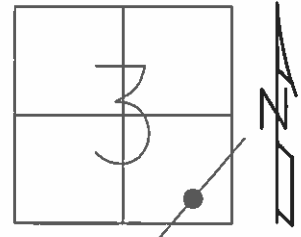

RECORD:
 STA. 211+00
 FD R.R. SPIKE
 4" DOWN
 SET P.K./WASHER
 8/29/90
 FD P.K./WASHER
 2/7/05, SAH
 SET MAG/WASHER
 10-06-09, DH

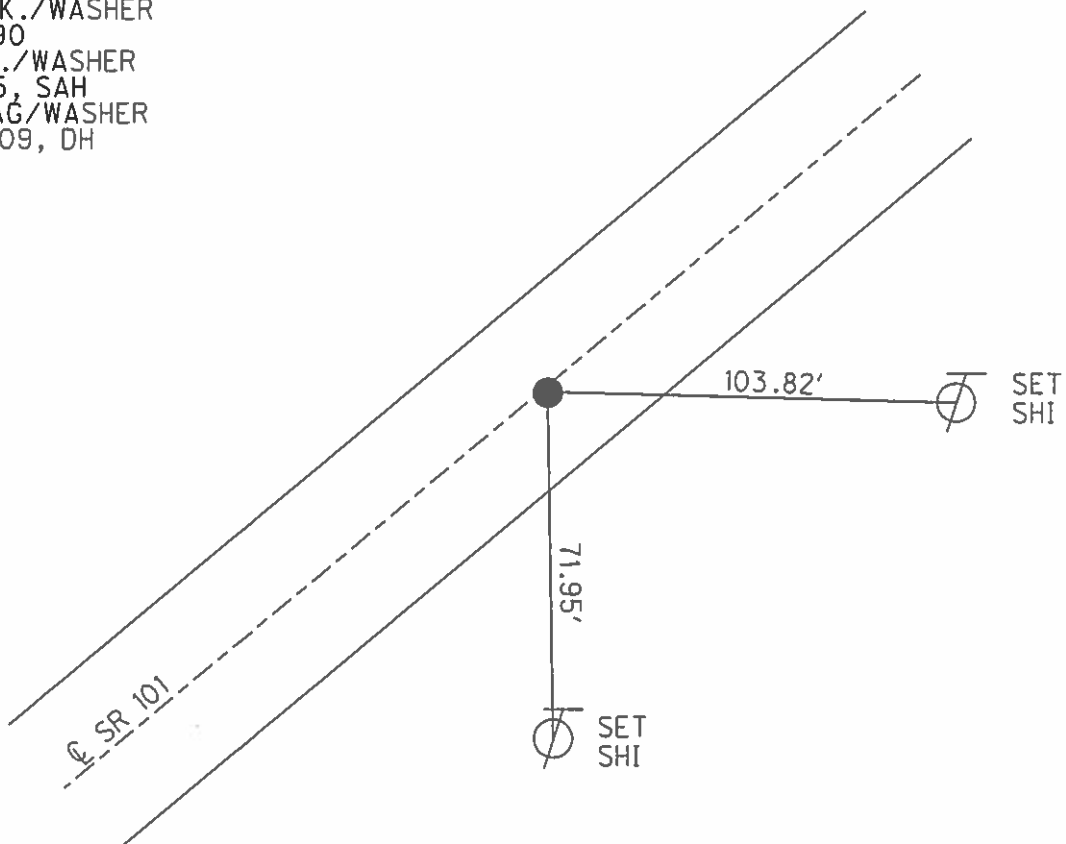

O.D.O.T. DISTRICT 2 SURVEY OFFICE

PERSONNEL _____

REFERENCE NO. 61

SHEET 36 OF 41

NOTES Ripple

H.C. Barbour

R.C. Geyman

DATE 8-29-90

WEATHER Cloudy

TEMP. 78°

ROUTE 101


COUNTY Sen

TOWNSHIP Adams

SECTION 3

T 3 N R 16 E

TYPE MONUMENT Set P.K. & Washer
 ON SURFACE - BELOW R.R. Spike 4" down
 LEFT - CL PAV'T. - RIGHT E RT. d
 TO EDGE PAVEMENT
 S.L.M. _____

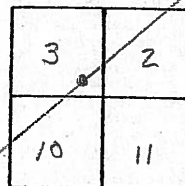

720+97

STA. 211+

Loose Post


33.48

86.15

Measurements
may be inverted

98.61

Fcl
2-2-05
SAH

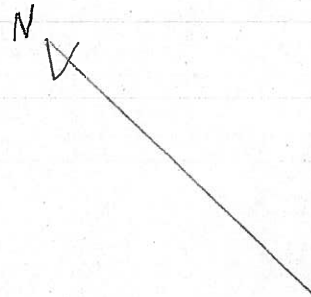

O.D.O.T. DISTRICT 2 SURVEY OFFICE

PERSONNEL

REFERENCE NO. 61

SHEET 36 OF 41

NOTES Ripple

H.C. Barbour

R.C. Geyman

DATE 8-29-90

WEATHER Cloudy

TEMP. 78°

ROUTE 101


COUNTY Sen

TOWNSHIP Adams

SECTION 3

T 3 N R 16 E

TYPE MONUMENT set P.K. & Washer
ON SURFACE - BELOW R/R spike 4" down
LEFT - & PAV'T. - RIGHT 1/2' RT. &
____ TO ____ EDGE PAVEMENT
S.L.M. _____

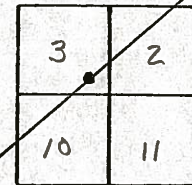


STA. 211+

Loose Post

33.48

86.15

98.61

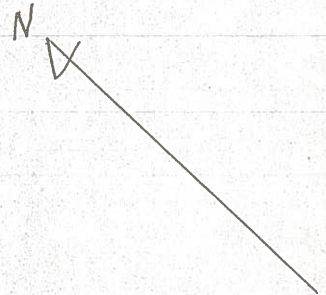

PERSONNEL TITLE PERSONNEL TITLE

COUNTY Seneca

DATE

11-25-63

S. R. # 101

WEATHER

SEC

TEMP

DESCRIPTION

LEFT

CENTER LINE

RIGHT

JOB NO.

4-20-69

2/27/69

Sta. 211+00

R.R. spk. on & R.W.

1 1/2" below surface

HIT

8508

Found

(60-A) Sta. 192+00

R.R. spk. on & R.W.

3" below surface

1' RT. &

HIT

8507

Found

(59) Sta. 181+00

R.R. spk. on & R.W.

2" below surface

HIT

178+

688+05 8506

Found

(58) Sta. 175+00


R.R. spk. on & R.W.

2" below surface

683+

HIT

8505

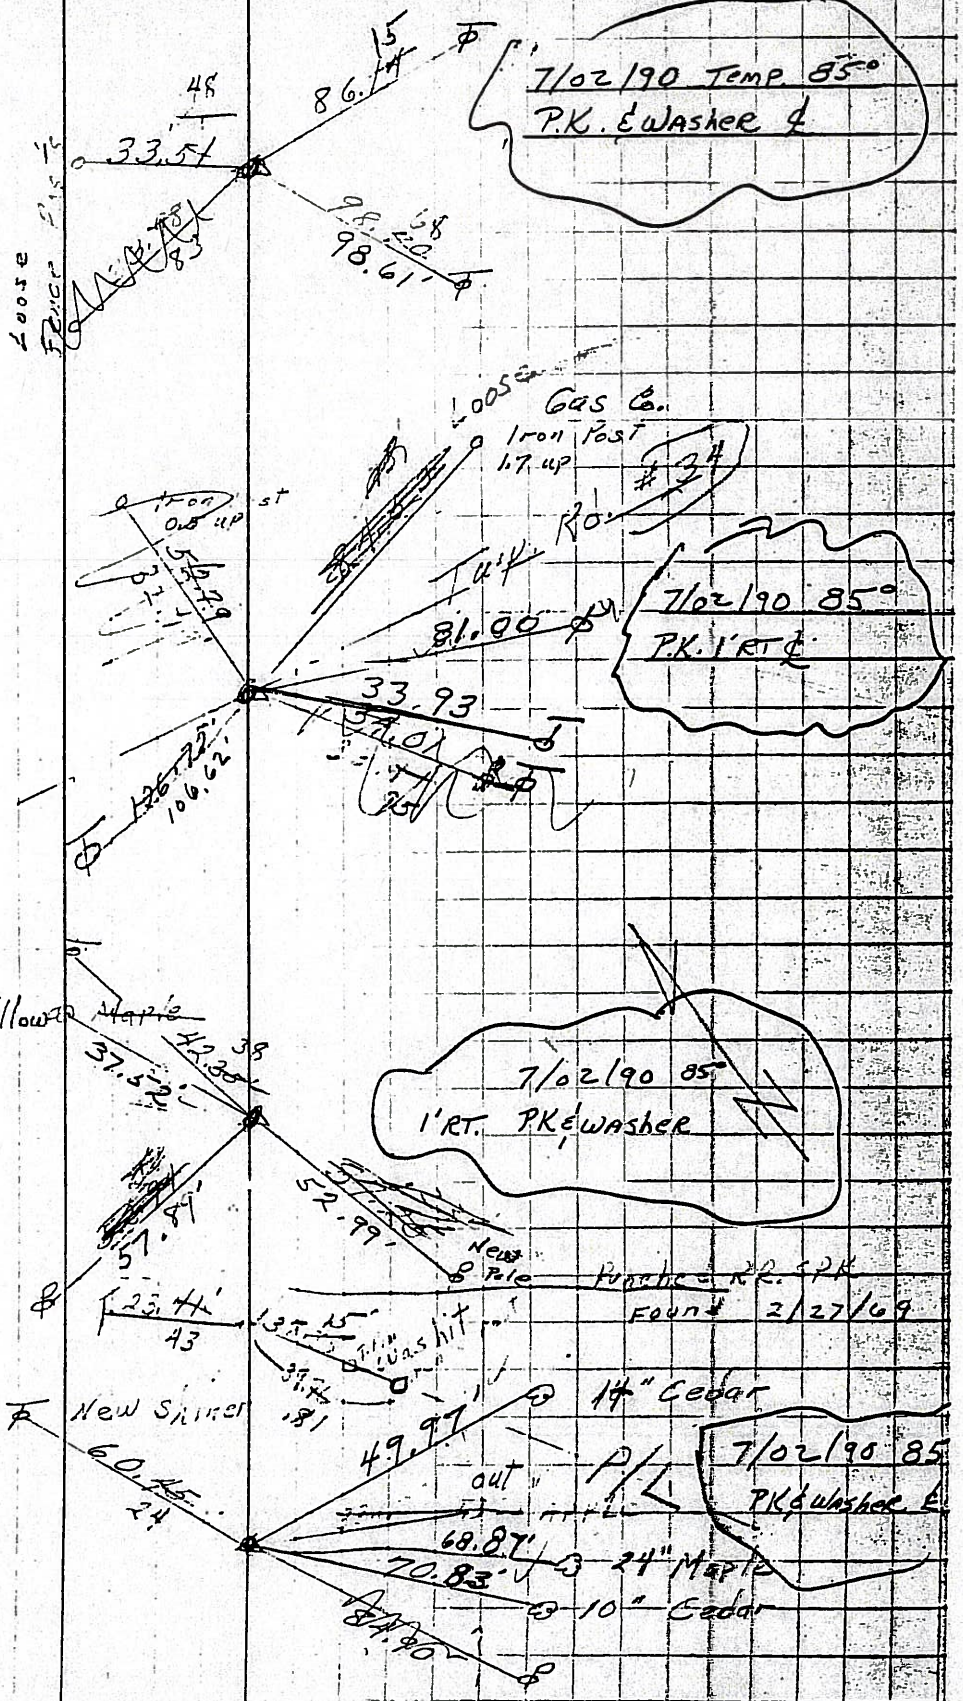

PERSONNEL TITLE PERSONNEL TITLE

COUNTY Seneca

DATE 2-14-64

Krabill

Kowalesko

S. R. # 101

WEATHER

Geyman

SEC.

TEMP.

Bruggeman

DESCRIPTION S. R. # 101 Tiffin to Sen. Co line

JOB NO.


LEFT

CENTER LINE

RIGHT


(60-A)

STA. 192+00

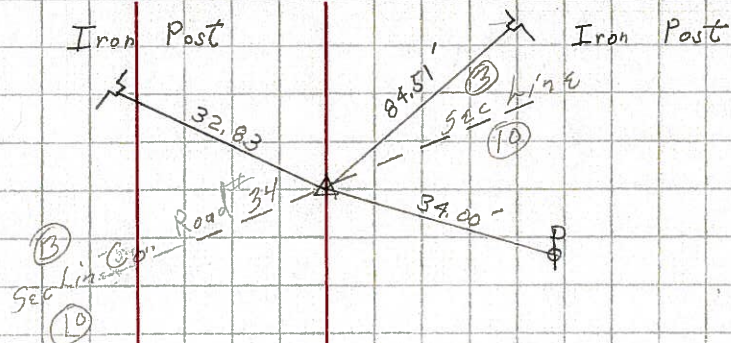Iron Pin
410


(61)

STA. 211+00

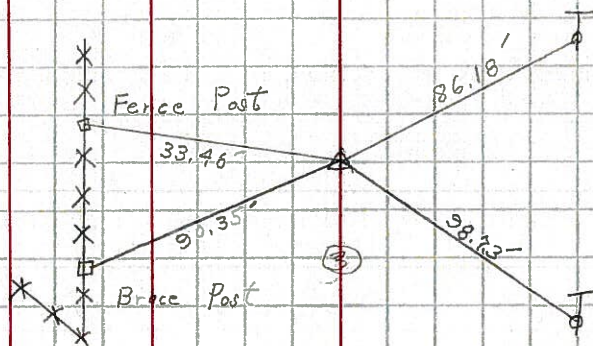Iron Pin
411

(62)

STA. 224+00

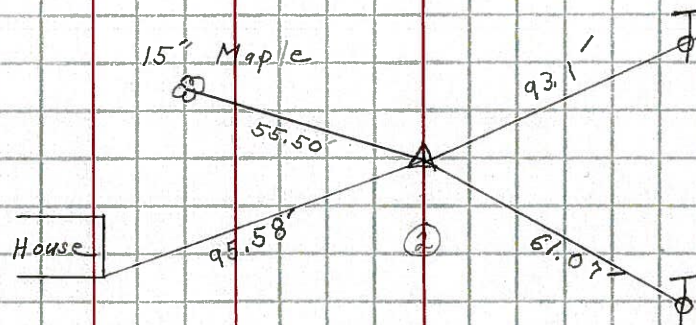Iron Pin
412

(63)

STA. 232+00

Iron Pin
413