

O.D.O.T. DISTRICT 2 SURVEY OFFICE (USE ONLY)

PERSONNEL

REFERENCE NO. 62

SHEET 42 OF 46

NOTES MILLER

DATE 8/7/24

ROUTE SR 101

H.C. MILLER

WEATHER SUNNY

COUNTY SENECA

R.C. BARRIERE

TEMP. 75°F

TOWNSHIP ADAMS

BLUBAUGH, ASTON, PRESTON-COLVIN

SECTION 2

DWG BY BLUBAUGH

PID 114849

T 3 N R 16 E

TYPE MONUMENT MAG/WASHER

~~ON SURFACE~~ - BELOW 0.5"

OFFSET Q PAVEMENT 1.0' LT : ~~RT~~

-- TO -- EDGE PAVEMENT

STATION: 720.97

HORIZ.DATUM: NAD83 (2011)


GEOID: NAVD88-2018

GRID: NORTHING: 576362.605


EASTING: 1832931.398

LDP: NORTHING: 345472.829

EASTING: 207214.761

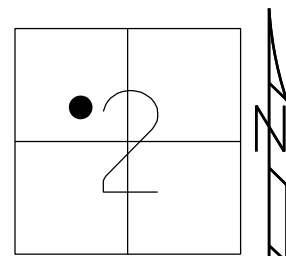

RECORD:
 STA. 224+00
 FD R.R. SPIKE
 4" DOWN
 SET P.K./WASHER
 8/29/90, BARBOUR
 FD P.K./WASHER
 2/7/05, SAH
 REF62
 6/30/09, DCH
 SET MAG/WASHER
 NEWREF62
 10-07-09, DH
 FD MAG/WASHER
 REF62
 6/16/16, JFO
 9/12/17, JMR
 REF62
 12/12/23, TDN
 FD TONE. DID NOT
 UNCOVER. PAINTED
 8/7/24, JAM

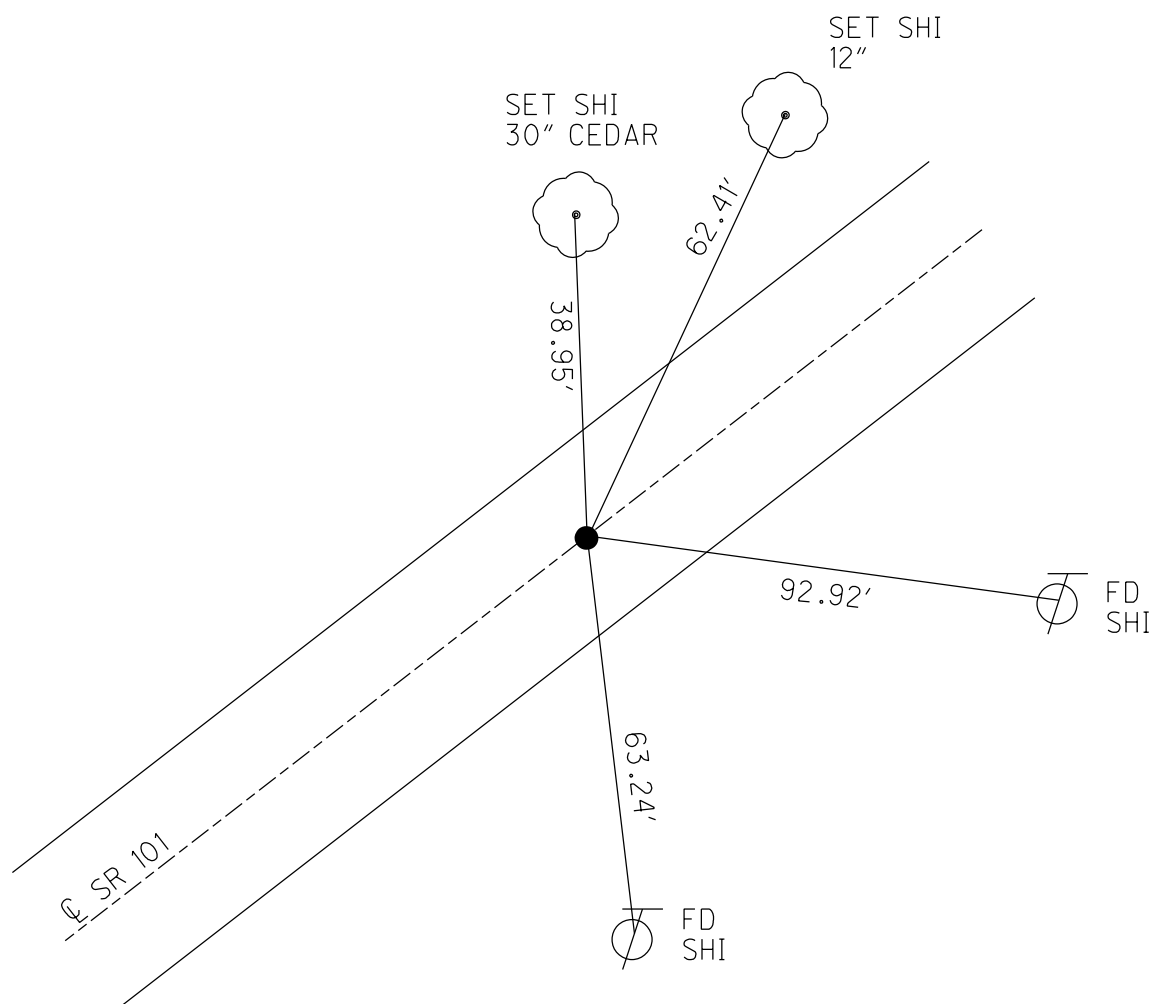

O.D.O.T. DISTRICT 2 SURVEY OFFICE (USE ONLY)

PERSONNEL

REFERENCE NO. 62

SHEET 42 OF 46

NOTES HOMAN

DATE 6-30-09

ROUTE SR 101

H.C. HOMAN

WEATHER CLOUDY

COUNTY SENECA

R.C. ROUSOS

TEMP. 75°F

TOWNSHIP ADAMS

SECTION 2

DWG BY MAHLER

PID 100787

T 3 N R 16 E

TYPE MONUMENT P.K./WASHER

ON SURFACE - ~~BELOW~~ ON

OFFSET Q PAVEMENT ON LT : RT

- TO - EDGE PAVEMENT


STATION: 733+97±

HORIZ.DATUM: NAD83 (2011)


GEOID: NAVD88-2012A

GRID: NORTHING: 576362.605

EASTING: 1832931.398

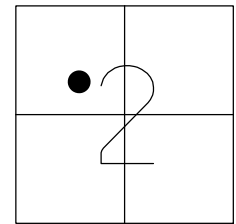

RECORD:
STA. 224+00
FD R.R. SPIKE
4" DOWN
SET P.K./WASHER
8/29/90, BARBOUR
FD P.K./WASHER
2/7/05, SAH
FD P.K./WASHER
REF62
6/30/09, DCH
SET MAG/WASHER
NEWREF62
10-07-09, DH
FD MAG/WASHER
REF62
6/16/16, JFO
9/12/17, JMR

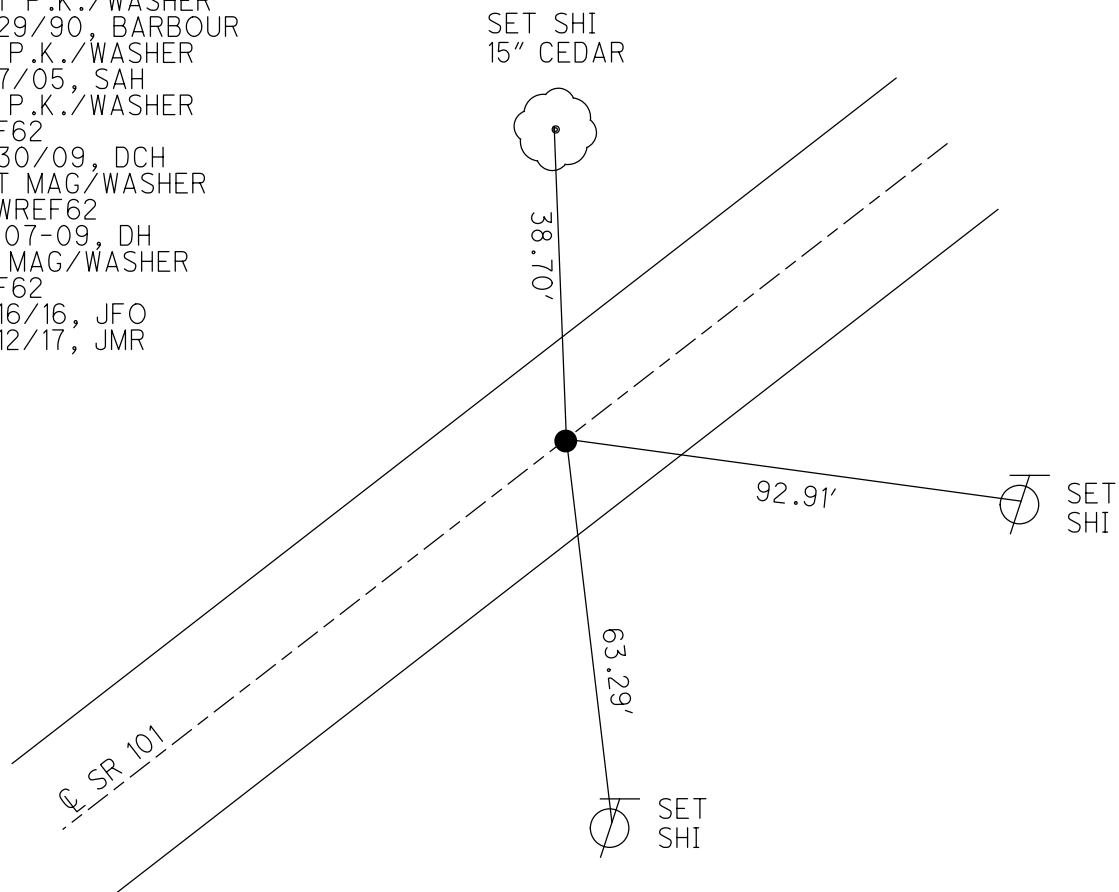


O.D.O.T. DISTRICT 2 SURVEY OFFICE (USE ONLY)


PERSONNEL	REFERENCE NO. <u>62</u>	SHEET <u>42</u> OF <u>46</u>
NOTES	DATE <u>6/30/09</u>	ROUTE <u>SR 101</u>
H.C. <u>HOMAN</u>	WEATHER <u>CLOUDY</u>	COUNTY <u>SENECA</u>
R.C. <u>ROUSOS</u>	TEMP. <u>80°</u>	TOWNSHIP <u>ADAMS</u>
		SECTION <u>2</u>
		T <u>3</u> N R <u>16</u> E

TYPE MONUMENT P.K./WASHER
~~ON SURFACE~~ - BELOW ON
 LEFT - ℄ PAV'T - ~~RIGHT~~ 1'
- TO - EDGE PAVEMENT
 S.L.M. 733+97 ±

GRID: NORTHING: 576362.605 EASTING: 1832931.398

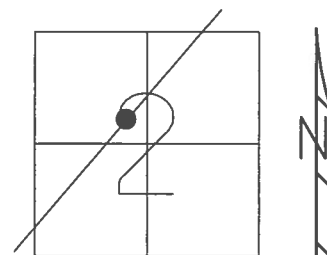

RECORD:
 STA. 224+00
 FD R.R. SPIKE
 4" DOWN
 SET P.K./WASHER
 8/29/90
 FD P.K./WASHER
 2/7/05, SAH
 SET MAG/WASHER
 10-07-09, DH
 FD MAG/WASHER
 REF62
 6/16/16, JFO
 UNCOVERED
 9/12/17, JMR

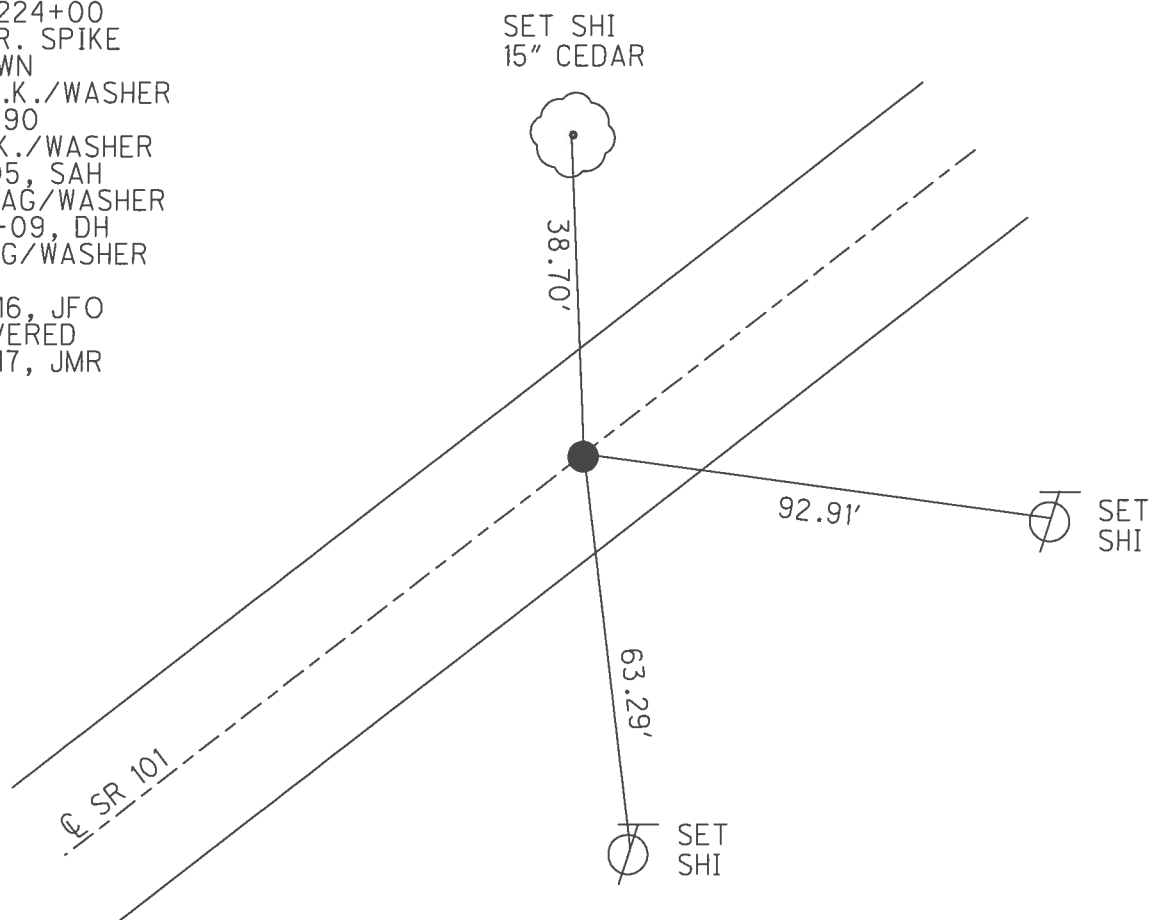


O.D.O.T. DISTRICT 2 SURVEY OFFICE (USE ONLY)


PERSONNEL _____ REFERENCE NO. 62 SHEET 42 OF 46
NOTES HOMAN DATE 6/30/09 ROUTE SR 101
H.C. HOMAN WEATHER CLOUDY COUNTY SENECA
R.C. ROUSOS TEMP. 80° TOWNSHIP ADAMS
SECTION 2
T 3 N R 16 E

TYPE MONUMENT P.K./WASHER
~~ON SURFACE~~ - BELOW ON
LEFT - Q PAV'T - RIGHT ON
- TO - EDGE PAVEMENT
S.L.M. _____

GRID: NORTHING: 576362.730 EASTING: 1832931.346

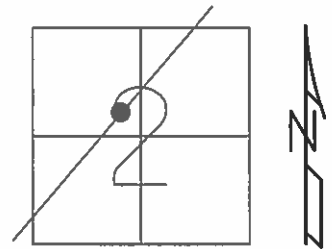

RECORD:
STA. 224+00
FD R.R. SPIKE
4" DOWN
SET P.K./WASHER
8/29/90
FD P.K./WASHER
2/7/05, SAH
SET MAG/WASHER
10-07-09, DH

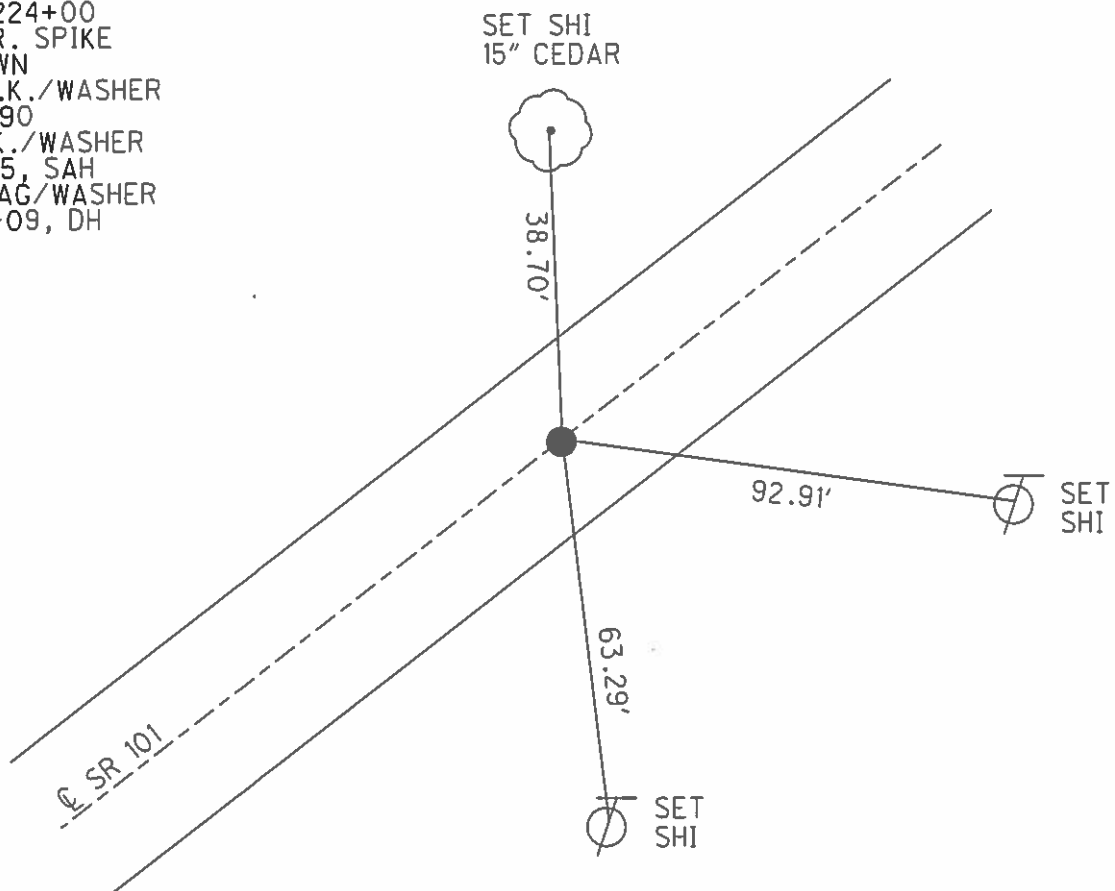

O.D.O.T. DISTRICT 2 SURVEY OFFICE

PERSONNEL

REFERENCE NO. 62

SHEET 37 OF 41

NOTES Ripple

H.C. BARBOUR

R.C. Geyman

DATE 8-29-90

WEATHER Cloudy

TEMP. 78°

ROUTE 101


COUNTY Sen

TOWNSHIP Adams

SECTION 2

T3 N R 16 E

TYPE MONUMENT Set P.K. & Washer
ON SURFACE - BELOW R/R spike 4" down
LEFT - CL PAV'T. - RIGHT CL
TO CL EDGE PAVEMENT
S.L.M.

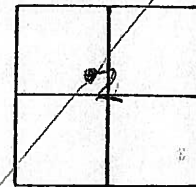

734+60

STA. 224+24 ±

10" Cedar



39.33'

92.99'

61.10'

Fd

2-7-05

SAH

O.D.O.T. DISTRICT 2 SURVEY OFFICE

PERSONNEL

REFERENCE NO. 62

SHEET 37 OF 41

NOTES Ripple

H.C. Barbour

R.C. Geyman

DATE 8-29-90

WEATHER Cloudy

TEMP. 78°

ROUTE 101


COUNTY Sen

TOWNSHIP Adams

SECTION 2

T.3 N R.16 E

TYPE MONUMENT Set P.K. & Washer
ON SURFACE - BELOW R/R spike 4" down
LEFT - ℄ PAV'T. - RIGHT ℄
____ TO ____ EDGE PAVEMENT
S.L.M. _____

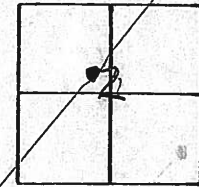

STA. '224+

10" Cedar



39.33'

92.99'

61.10'

N

PERSONNEL	TITLE	PERSONNEL	TITLE	COUNTY	DATE	WEATHER	TEMP
				SENECA	11-26-65		79°
				S. R. # 101			4' 3" 10°
				SEC.			

DESCRIPTION	LEFT	CENTER LINE	RIGHT	JOB NO.
-------------	------	-------------	-------	---------

4-20-79
60°

Found 7/1/69

Sta. 249+00

R.R. sp. or E. R.

1 1/2" below surface

759+

4/4

8511

24" Maple

34.00'

34.00'

7/02/90 85°

1' LT & P.K. Washer

15' Hedgeapple

7/02/90 85°

PK Washer

7/02/90 85°

1' LT & P.K. Washer

Found 5/8/69

Sta. 252+00

Iron Pipe on E. R.

4" below surface

4/4

8510

15" Maple

54.53'

54.53'

49.04 New Pole

49.04'

49.04'

10" Cedar

39.33'

39.33'

73.02'

73.02'

92.99'

92.99'

61.10'

61.10'

Found 8/3/69

Sta. 224+00

R.R. sp. or E. R.

1 1/2" below surface

733+9'

4/4

8509

PERSONNEL TITLE PERSONNEL TITLE

COUNTY Seneca

DATE 2-14-64

Krabill

Kowalesko

S. R. # 101

WEATHER

Geyman

SEC.

TEMP.

Bruggeman

DESCRIPTION S. R. # 101 Tiffin to Sen. Co line

JOB NO.


LEFT

CENTER LINE

RIGHT


(60-A)

STA. 192+00

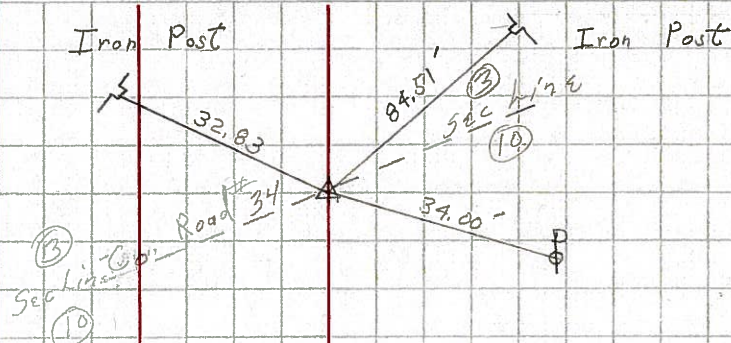Iron Pin
410


(61)

STA. 211+00

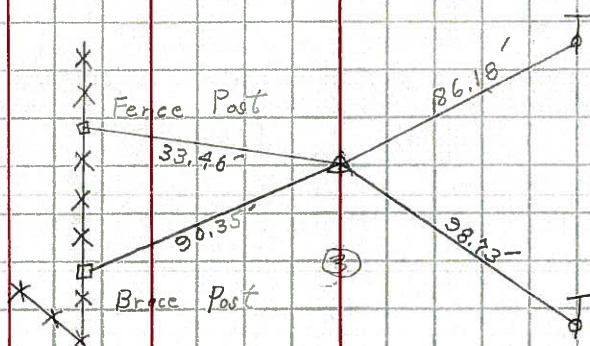Iron Pin
411

(62)

STA. 224+00

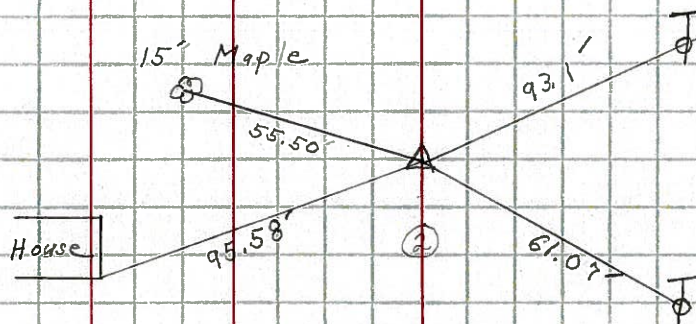Iron Pin
412

(63)

STA. 232+00

Iron Pin
413