

O.D.O.T. DISTRICT 2 SURVEY OFFICE (USE ONLY)

PERSONNEL

REFERENCE NO. 63

SHEET 43 OF 46

NOTES MILLER

DATE 8/7/24

ROUTE SR 101

H.C. MILLER

WEATHER SUNNY

COUNTY SENECA

R.C. BARRIERE

TEMP. 75°F

TOWNSHIP ADAMS

BLUBAUGH, ASTON, PRESTON-COLVIN

SECTION 2

DWG BY BLUBAUGH

PID 114849

T 3 N R 16 E

TYPE MONUMENT MAG NAIL

~~ON SURFACE~~ - BELOW 0.5"

OFFSET $\odot$ PAVEMENT ON LT : RT

-- TO -- EDGE PAVEMENT

STATION: 742+00

HORIZ.DATUM: NAD83 (2011)


GEOID: NAVD88-2018

GRID: NORTHING: 576880.385


EASTING: 1833540.368

LDP: NORTHING: 345995.177

EASTING: 207819.888

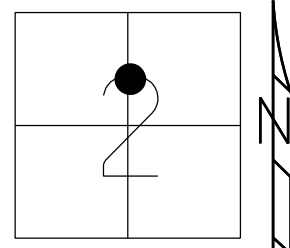

RECORD:
STA. 232+00
FD IPIN
4" BELOW
SET P.K./WASHER
8/29/90, BARBOUR
FD IPIN
4" DOWN
REF63
6/30/09, DCH
SET MAG/WASHER
NEWREF63
10-07-09, DH
FD MAG/WASHER
REF63
6/16/16, JFO
9/12/17, JMR
FD MAG NAIL
REF63
12/12/23, TDN
FD TONE. DID
NOT UNCOVER.
PAINTED
8/7/24, JAM

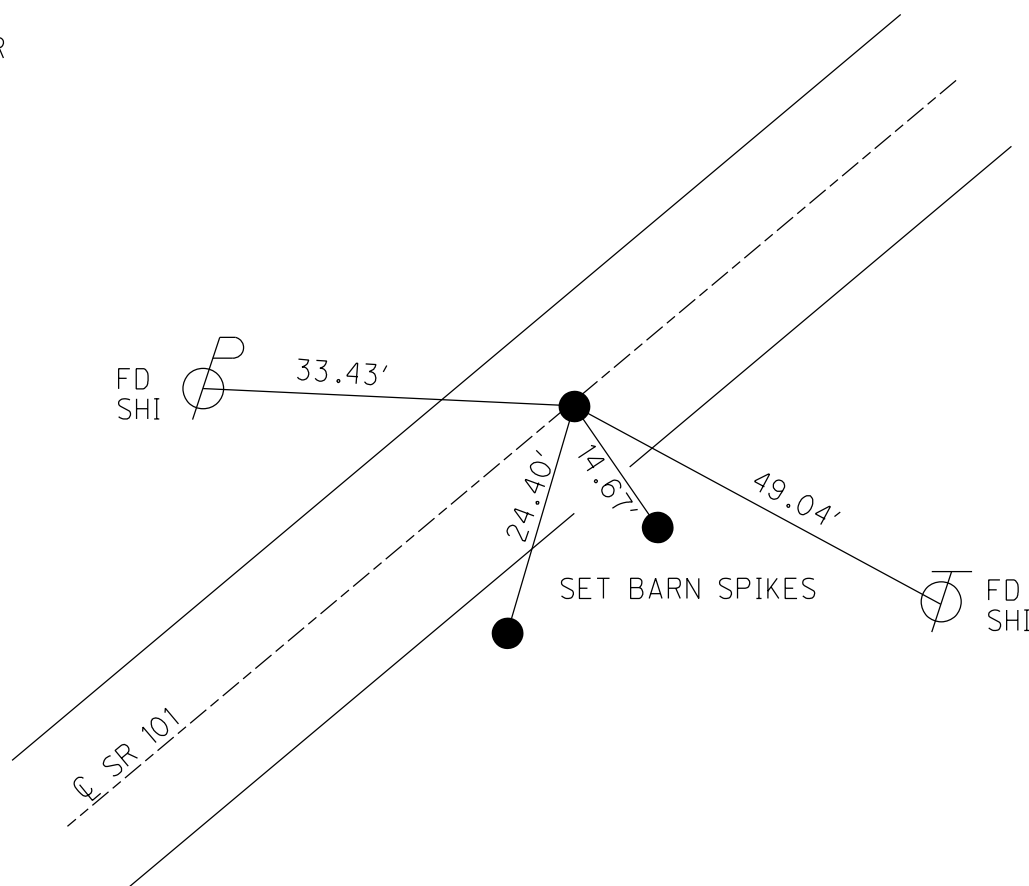

O.D.O.T. DISTRICT 2 SURVEY OFFICE (USE ONLY)

PERSONNEL

REFERENCE NO. 63

SHEET 43 OF 46

NOTES HOMAN

DATE 6-30-09

ROUTE SR 101

H.C. HOMAN

WEATHER CLOUDY

COUNTY SENECA

R.C. ROUSOS

TEMP. 75°F

TOWNSHIP ADAMS

DWG BY MAHLER PID 100787

SECTION 2

T 3 N R 16 E

TYPE MONUMENT IPIN

~~ON SURFACE~~ - BELOW 4"

OFFSET CL PAVEMENT 0.5' ~~LT~~ : RT

- TO - EDGE PAVEMENT


STATION: 742+00

HORIZ.DATUM: NAD83 (2011)


GEOID: NAVD88-2012A

GRID: NORTHING: 576880.385

EASTING: 1833540.368

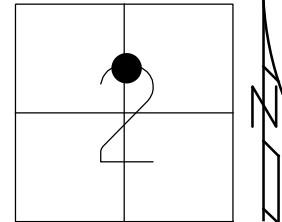

RECORD:
STA. 232+00
FD IPIN
4" BELOW
SET P.K./WASHER
8/29/90, BARBOUR
FD IPIN
4" DOWN
REF63
6/30/09, DCH
SET MAG/WASHER
NEWREF63
10-07-09, DH
FD MAG/WASHER
REF63
6/16/16, JFO
9/12/17, JMR

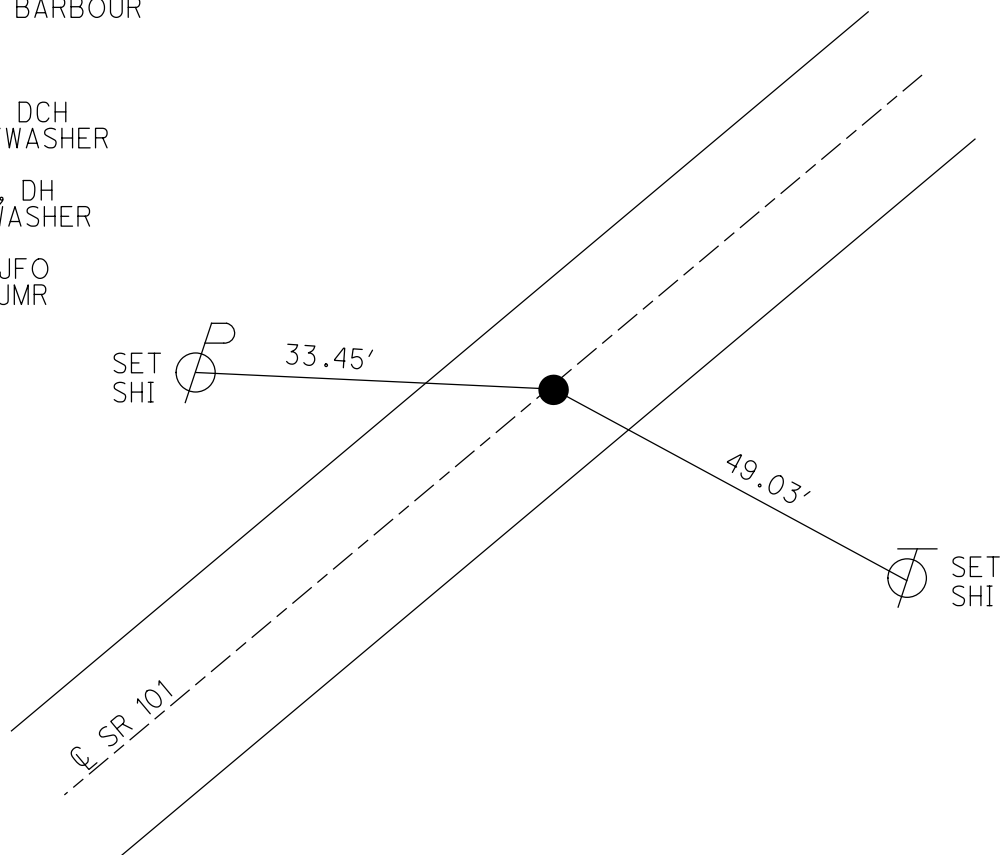

O.D.O.T. DISTRICT 2 SURVEY OFFICE (USE ONLY)

PERSONNEL _____ REFERENCE NO. 63 SHEET 43 OF 46

NOTES HOMAN _____ DATE 6/30/09 ROUTE SR 101
H.C. HOMAN _____ WEATHER CLOUDY COUNTY SENECA
R.C. ROUSOS _____ TEMP. 75° TOWNSHIP ADAMS

SECTION 2
T 3 N R 16 E

TYPE MONUMENT IPIN


~~ON SURFACE~~ - BELOW 4"

~~LEFT~~ - ℄ PAV'T - RIGHT 0.5'


- TO - EDGE PAVEMENT

S.L.M. 742+00

GRID: NORTHING: 576880.385 EASTING: 1833540.368

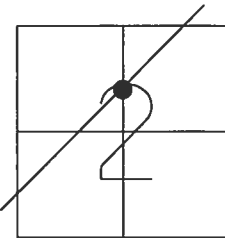

RECORD:
STA. 232+00
FD IPIN
4" BELOW
SET P.K./WASHER
8/29/90
SET MAG/WASHER
10-07-09, DH
FD MAG/WASHER
REF63
6/16/16, JFO
UNCOVERED
9/12/17, JMR

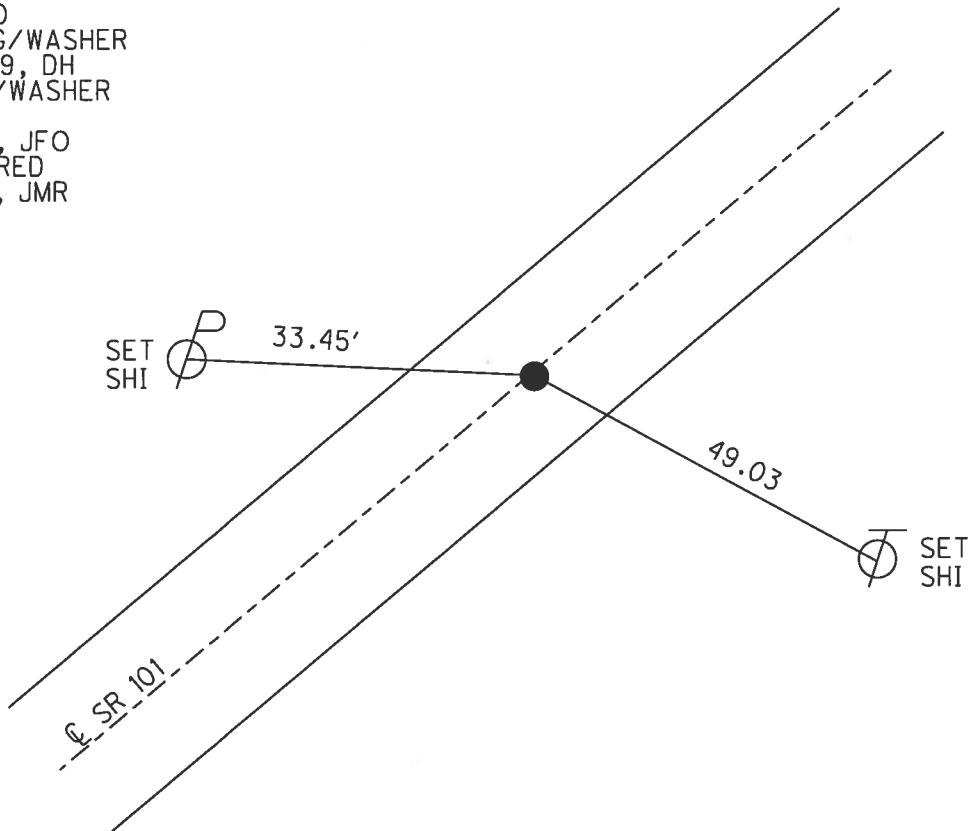

O.D.O.T. DISTRICT 2 SURVEY OFFICE (USE ONLY)

PERSONNEL	REFERENCE NO.	<u>63</u>	SHEET	<u>43</u>	OF	<u>46</u>
NOTES	HOMAN	DATE	<u>6/30/09</u>	ROUTE	<u>SR 101</u>	
H.C.	HOMAN	WEATHER	<u>CLOUDY</u>	COUNTY	<u>SENECA</u>	
R.C.	ROUSOS	TEMP.	<u>75°</u>	TOWNSHIP	<u>ADAMS</u>	
				SECTION	<u>2</u>	
				T	<u>3</u>	N
				R	<u>16</u>	E


TYPE MONUMENT IPIN

~~ON SURFACE~~ - BELOW 4"

~~LEFT~~ - Q PAV'T - RIGHT 0.5'


- TO - EDGE PAVEMENT

S.L.M. 742+00

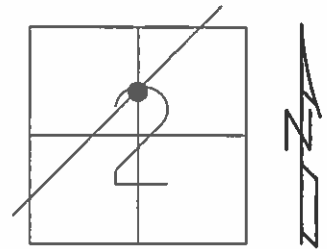

GRID: NORTHING: 576880.460 EASTING: 1833540.285

RECORD:
 STA. 232+00
 FD IPIN
 4" BELOW
 SET P.K./WASHER
 8/29/90
 SET MAG/WASHER
 10-07-09, DH

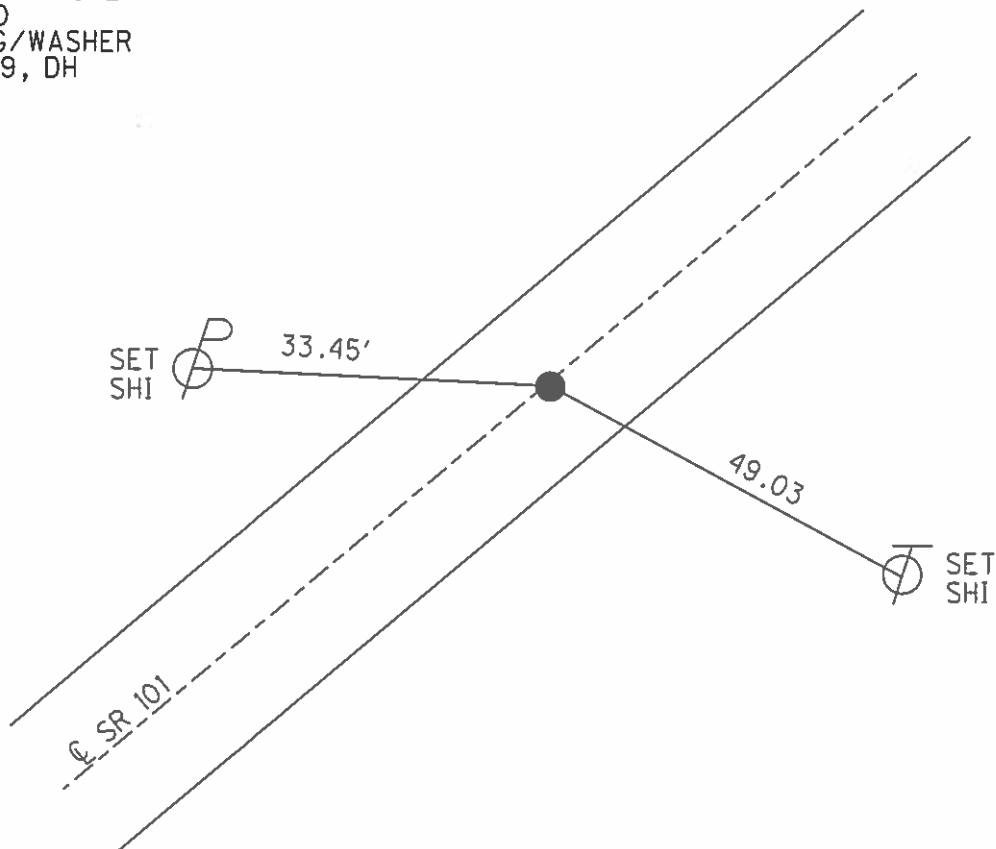

O.D.O.T. DISTRICT 2 SURVEY OFFICE

PERSONNEL

REFERENCE NO. 63

SHEET 38 OF 41

NOTES Ripple

H.C. BARBOUR

R.C. SEYMAN

DATE 8-29-90

WEATHER Cloudy

TEMP. 77°

ROUTE 101


COUNTY SEN

TOWNSHIP Adams


SECTION 2

T 3 N R 16 E

TYPE MONUMENT SET P.K. WASHER
ON SURFACE - BELOW IRON PIN 4" below
LEFT - & PAW'T. - RIGHT 1/2' RT.
____ TO ____ EDGE PAVEMENT
S.L.M. _____

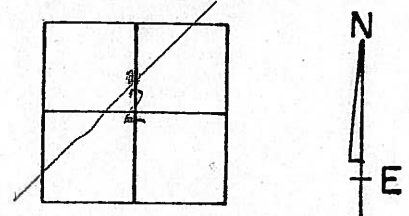

742+00

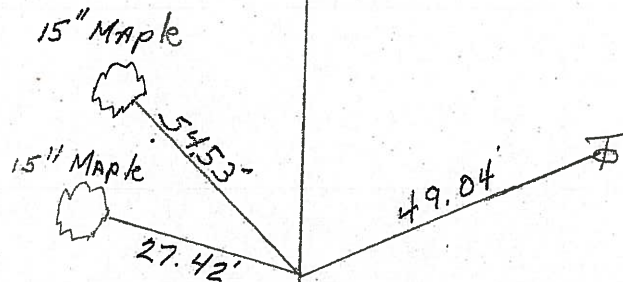

STA. 232+00

Fd note
Need to dig
2-7-06
SAH

O.D.O.T. DISTRICT 2 SURVEY OFFICE

PERSONNEL

REFERENCE NO. 63

SHEET 38 OF 41

NOTES Ripple

H.C. BARBOUR

R.C. GEYMAN

DATE 8-29-90

WEATHER Cloudy

TEMP. 77°

ROUTE 101

COUNTY SEN

TOWNSHIP Adams



SECTION 2

T 3 N R 16 E

TYPE MONUMENT Set PK & Washer
ON SURFACE - BELOW IRON PIN 4" below
LEFT - & PAV'T. - RIGHT 1/2' RT.

TO EDGE PAVEMENT


S.L.M.

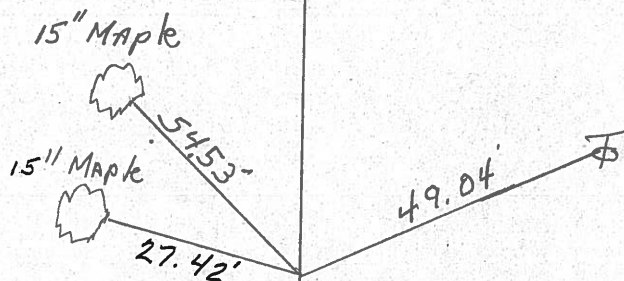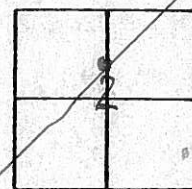

STA. 232+00

PERSONNEL	TITLE	PERSONNEL	TITLE	COUNTY	DATE	WEATHER	TEMP
				St. Lawrence	11-26-65		
				S. R. # 101			
				SEC.			

DESCRIPTION	LEFT	CENTER LINE	RIGHT	JOB NO.
-------------	------	-------------	-------	---------

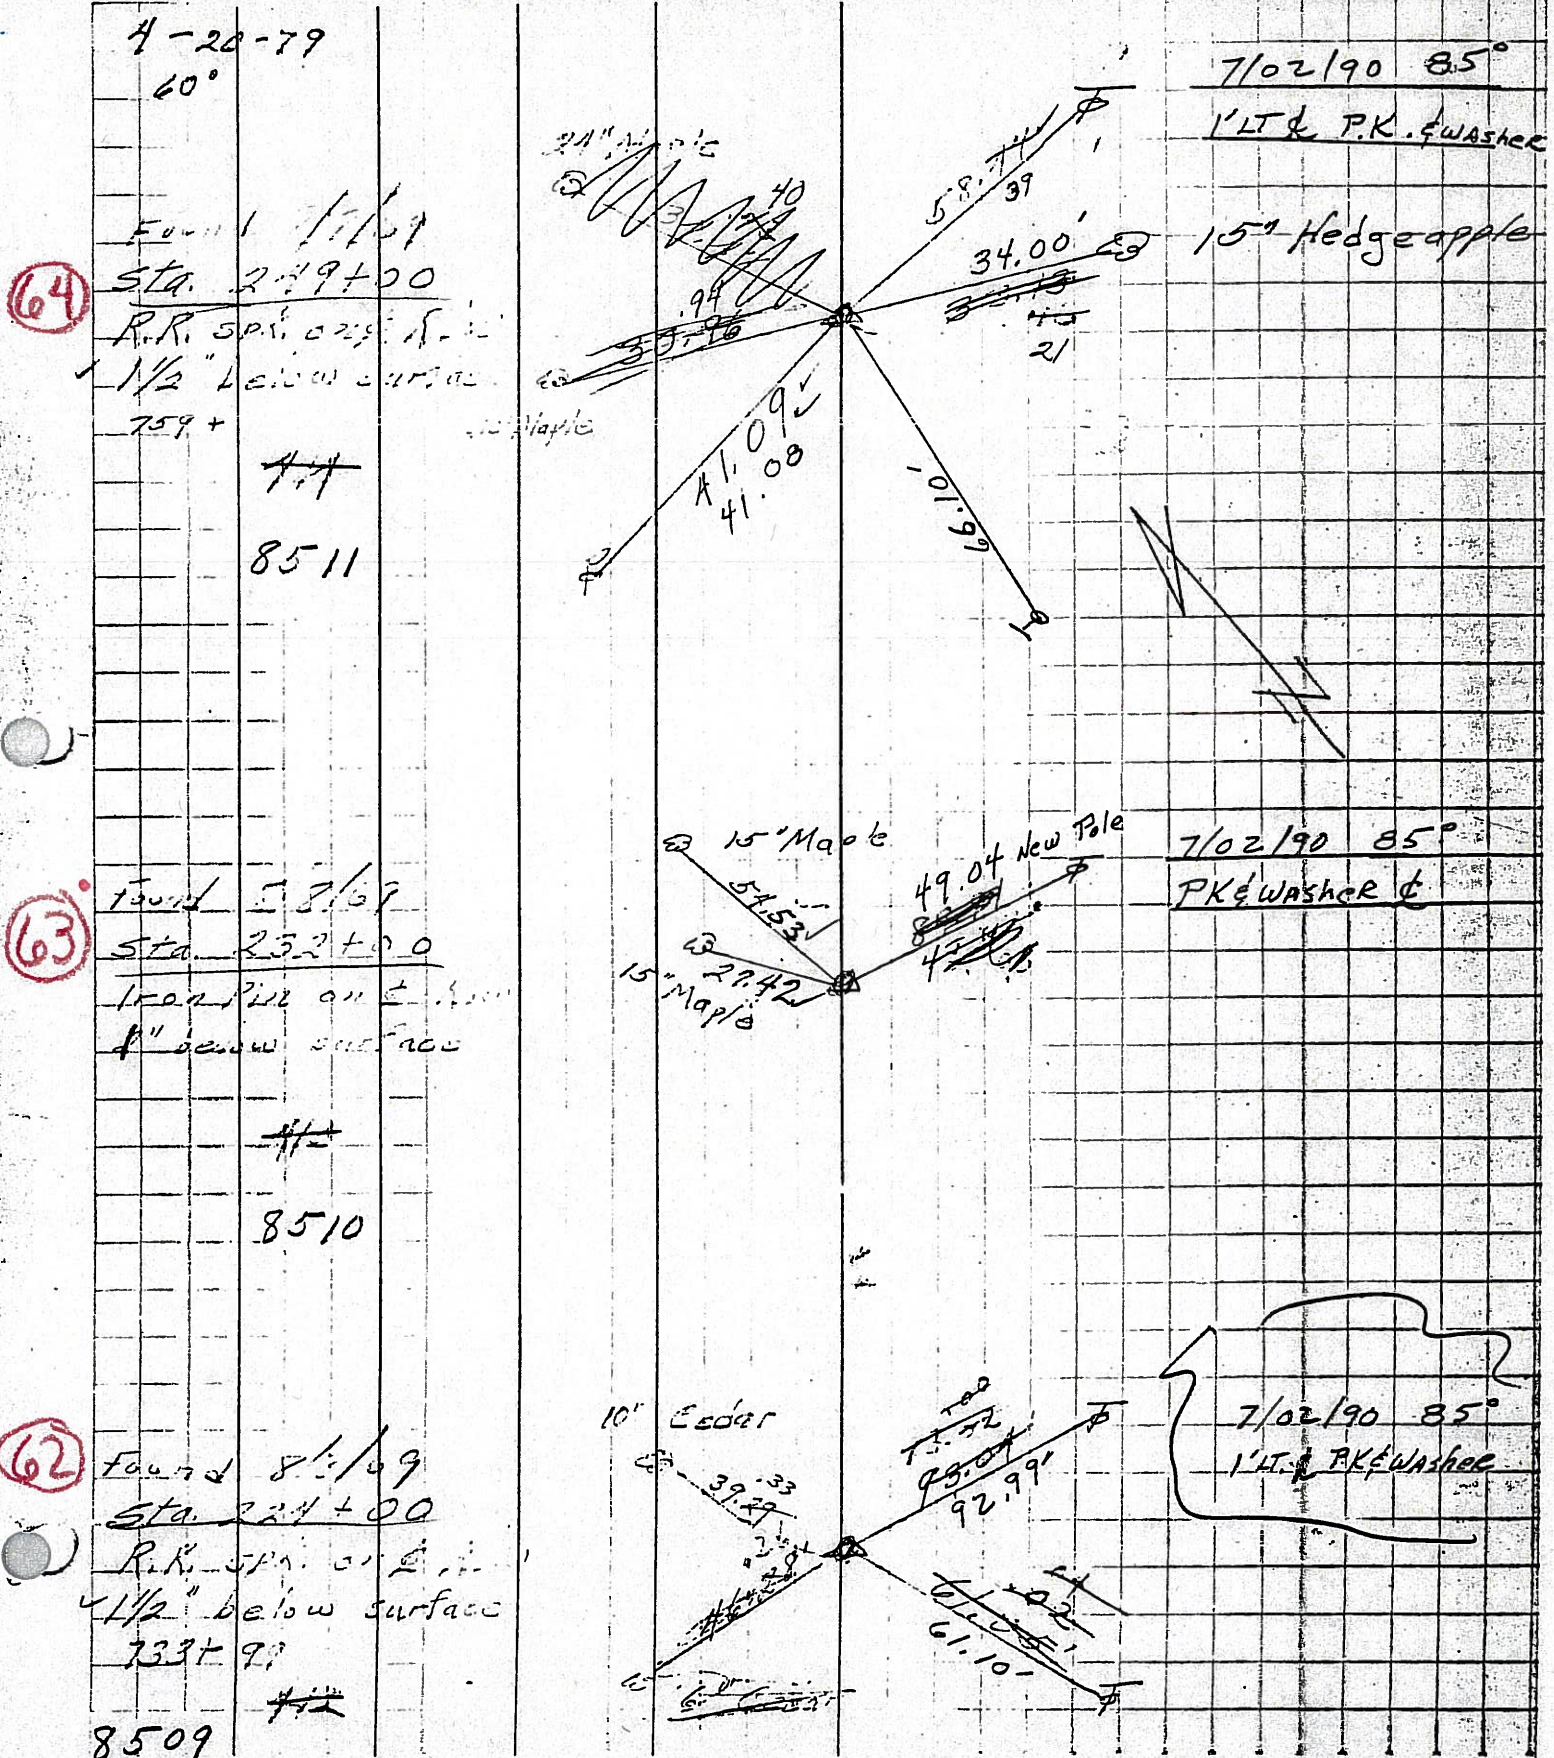

PERSONNEL TITLE PERSONNEL TITLE

COUNTY Seneca

DATE 2-14-64

Krabill

Kowalesko

S. R. # 101

WEATHER

Geyman

SEC.

TEMP.

Bruggeman

DESCRIPTION S. R. # 101 Tiffin to Sen. Co line

JOB NO.


LEFT

CENTER LINE

RIGHT


(60-A)

STA. 192+00

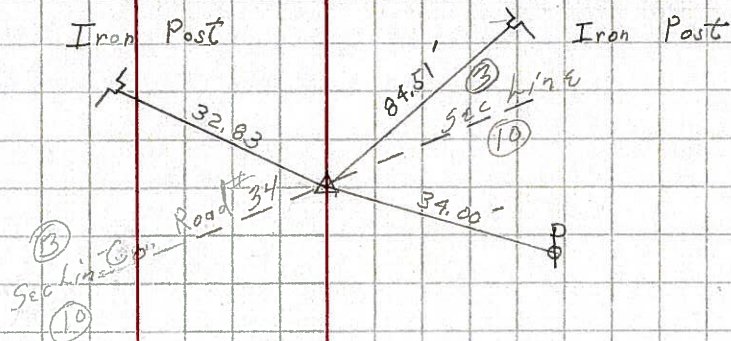Iron Pin
410


(61)

STA. 211+00

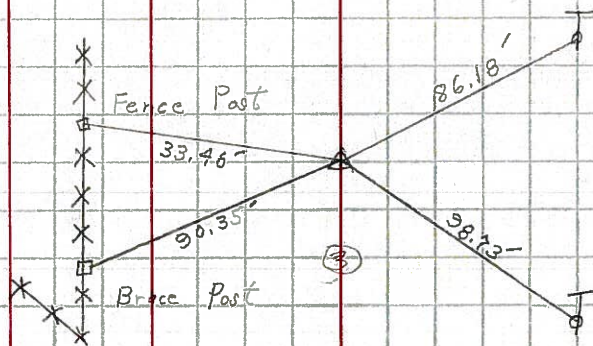Iron Pin
411

(62)

STA. 224+00

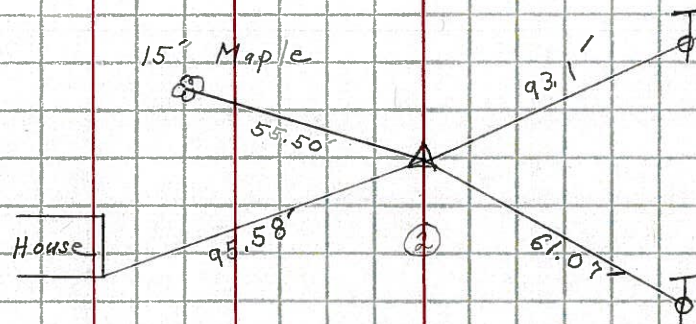Iron Pin
412

(63)

STA. 232+00

Iron Pin
413