

O.D.O.T. DISTRICT 2 SURVEY OFFICE (USE ONLY)

PERSONNEL

REFERENCE NO. 64

SHEET 44 OF 46

NOTES MILLER

DATE 8/7/24

ROUTE SR 101

H.C. MILLER

WEATHER SUNNY

COUNTY SENECA

R.C. BARRIERE

TEMP. 38°F

TOWNSHIP ADAMS

BLUBAUGH, ASTON, PRESTON-COLVIN

SECTION 2

DWG BY BLUBAUGH

PID 114849

T 3 N R 16 E

TYPE MONUMENT MAG/WASHER

ON SURFACE - ~~BELOW~~ ON

OFFSET Q PAVEMENT 1' LT : ~~RT~~

-- TO -- EDGE PAVEMENT

STATION: 759+04

HORIZ.DATUM: NAD83 (2011)


GEOID: NAVD88-2018

GRID: NORTHING: 576880.385


EASTING: 1833540.368

LDP: NORTHING: 347104.007

EASTING: 209111.861

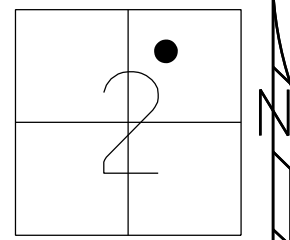

RECORD:
STA. 759+04
FD R.R. SPIKE
4" DOWN
SET P.K./WASHER
8/29/90, BARBOUR
FD P.K./WASHER
2/7/05, SAH
REF64
6/30/09, DCH
SET MAG/WASHER
NEWREF64
10-07-09, DH
FD MAG/WASHER
REF64
6/16/16, JFO
9/12/17, JMR
REF64
12/12/TDN
FD TONE. DID NOT
UNCOVER. PAINTED
8/7/24, JAM

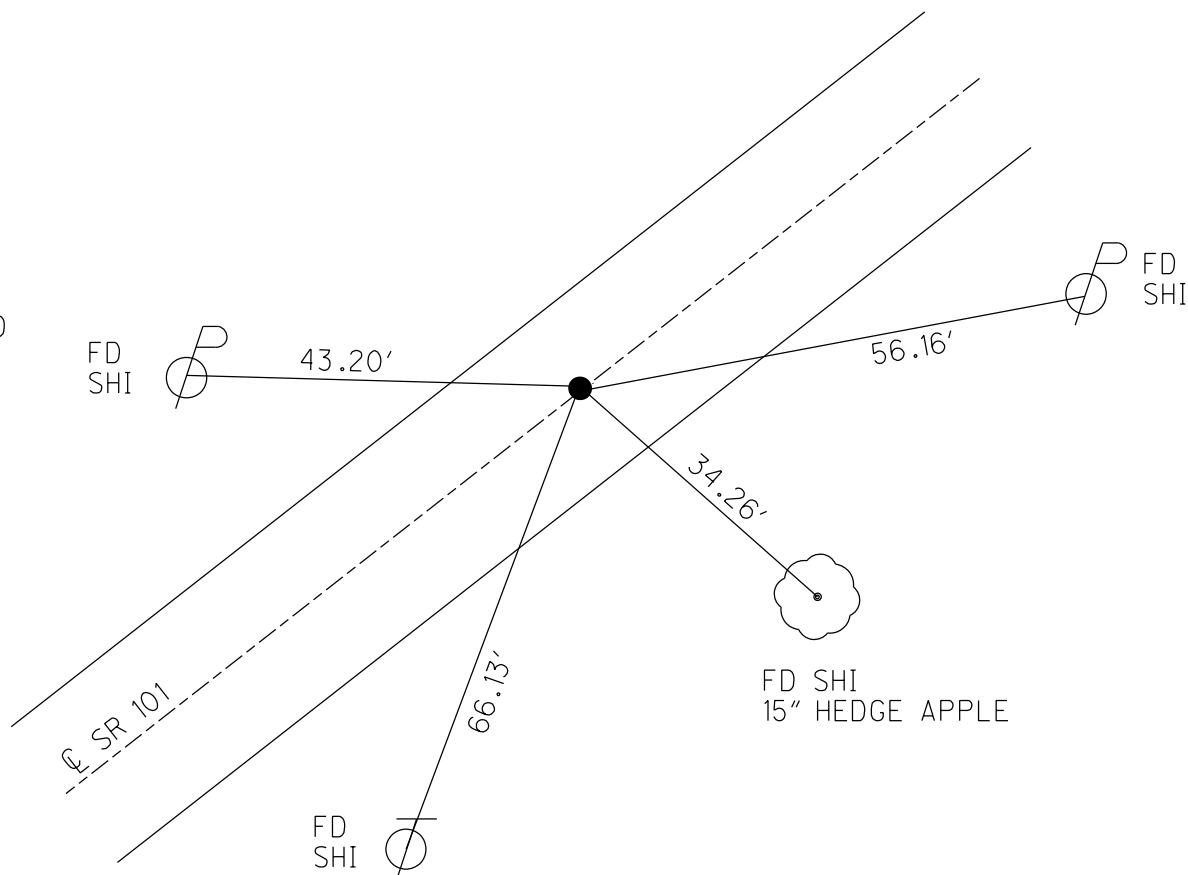

O.D.O.T. DISTRICT 2 SURVEY OFFICE (USE ONLY)

PERSONNEL

REFERENCE NO. 64

SHEET 44 OF 46

NOTES HOMAN

DATE 6-30-09

ROUTE SR 101

H.C. HOMAN

WEATHER CLOUDY

COUNTY SENECA

R.C. ROUSOS

TEMP. 70°F

TOWNSHIP ADAMS

DWG BY MAHLER PID 100787

SECTION 2

T 3 N R 16 E

TYPE MONUMENT P.K./WASHER

ON SURFACE - ~~BELOW~~ ON

OFFSET CL PAVEMENT 1' LT : RT

- TO - EDGE PAVEMENT


STATION: 759+04

HORIZ.DATUM: NAD83 (2011)


GEOID: NAVD88-2012A

GRID: NORTHING: 577979.460

EASTING: 1834840.408

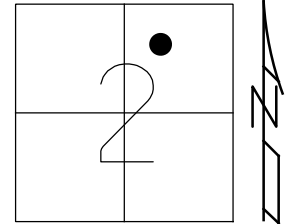


RECORD:
STA. 759+04
FD R.R. SPIKE
4" DOWN
SET P.K./WASHER
8/29/90, BARBOUR
FD P.K./WASHER
2/7/05, SAH
FD P.K./WASHER
REF64
6/30/09, DCH
SET MAG/WASHER
NEWREF64
10-07-09, DH
FD MAG/WASHER
REF64
6/16/16, JFO
9/12/17, JMR

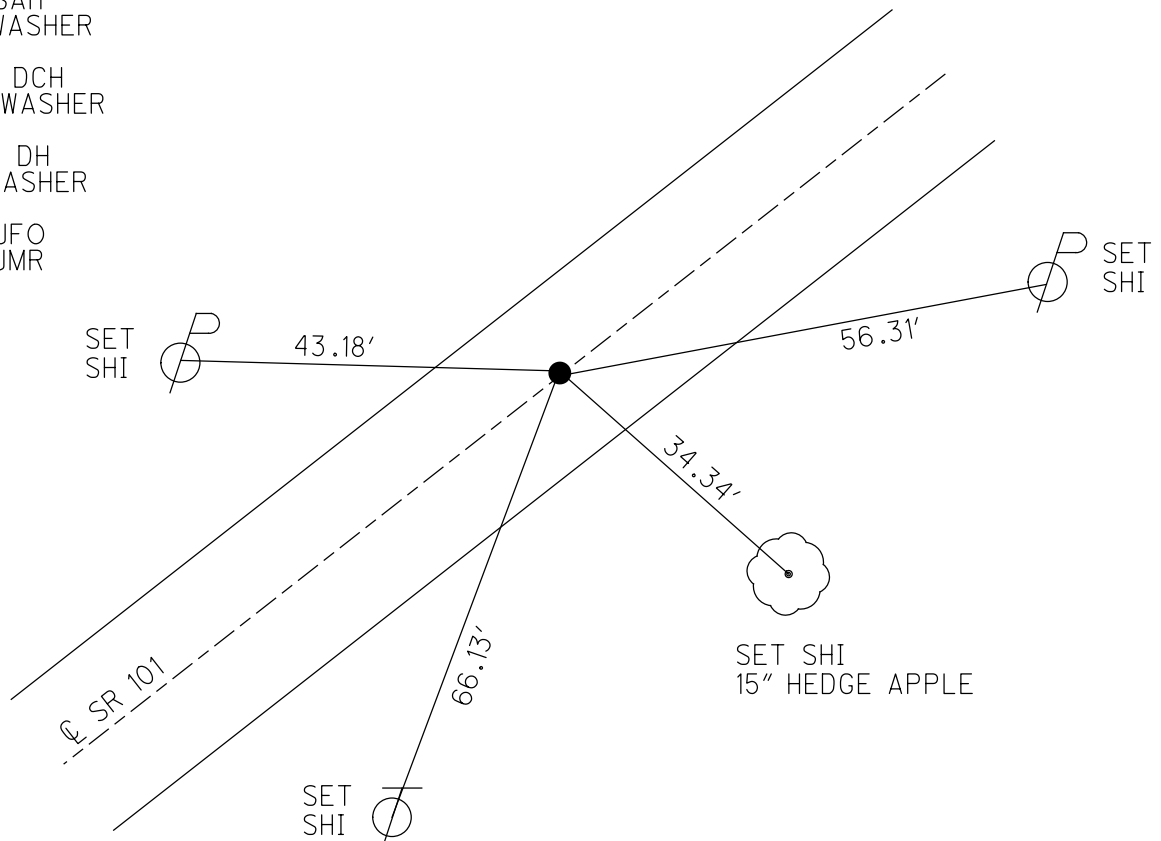

O.D.O.T. DISTRICT 2 SURVEY OFFICE (USE ONLY)


PERSONNEL	REFERENCE NO. <u>64</u>	SHEET <u>44</u> OF <u>46</u>
NOTES	DATE <u>6/30/09</u>	ROUTE <u>SR 101</u>
H.C. <u>HOMAN</u>	WEATHER <u>CLOUDY</u>	COUNTY <u>SENECA</u>
R.C. <u>ROUSOS</u>	TEMP. <u>70°</u>	TOWNSHIP <u>ADAMS</u>
		SECTION <u>2</u>
		T <u>3</u> N R <u>16</u> E

TYPE MONUMENT P.K./WASHER
~~ON SURFACE~~ - BELOW ON
 LEFT - C PAV'T - ~~RIGHT~~ 1 1/2'
- TO - EDGE PAVEMENT
 S.L.M. 759+04

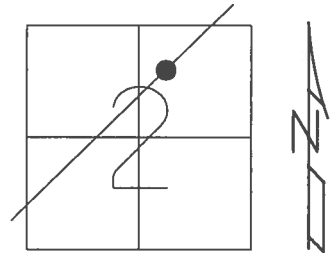

GRID: NORTHING: 577979.460 EASTING: 1834840.408


RECORD:
 STA. 759+04
 FD R.R. SPIKE
 4" DOWN
 SET P.K./WASHER
 8/29/90
 FD P.K./WASHER
 2/7/05, SAH
 SET MAG/WASHER
 10-07-09, DH
 FD MAG/WASHER
 REF64
 6/16/16, JFO
 UNCOVERED
 9/12/17, JMR

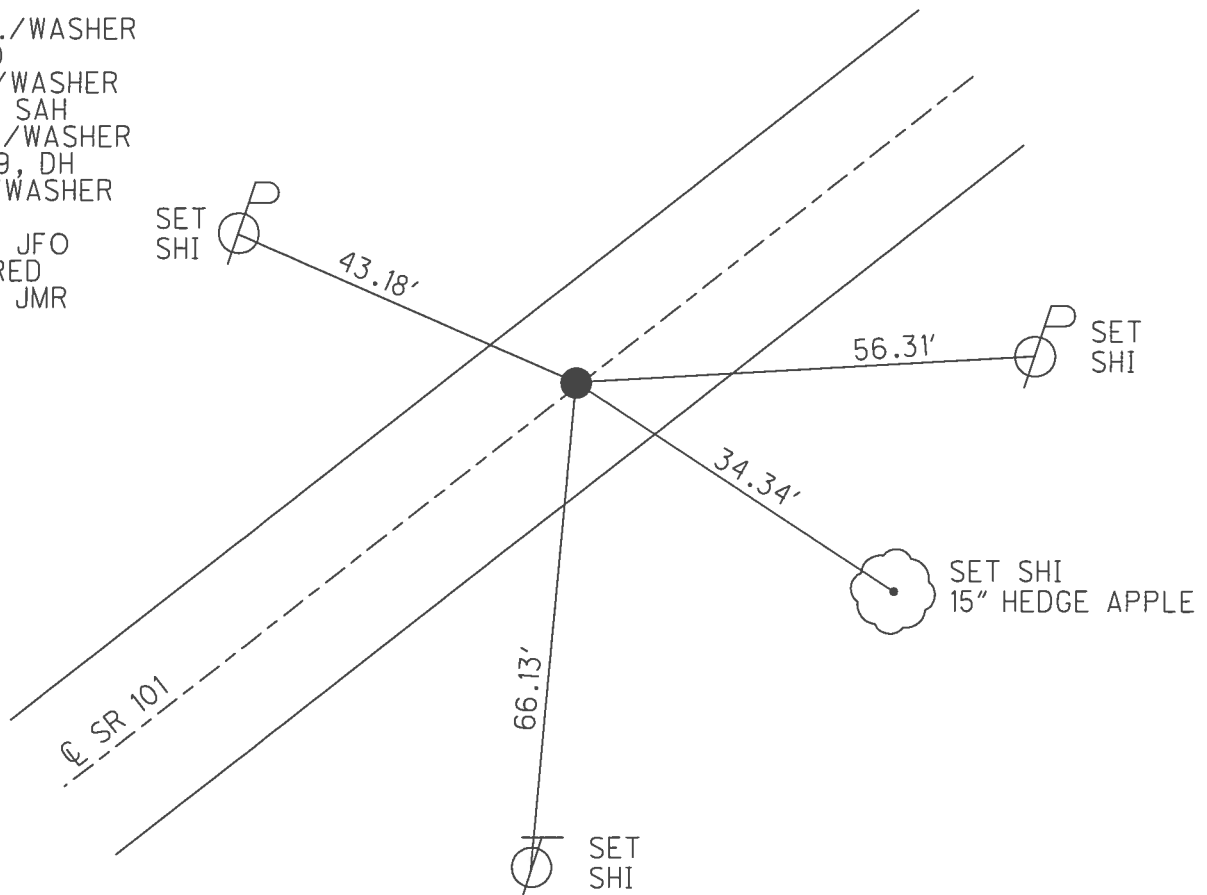

O.D.O.T. DISTRICT 2 SURVEY OFFICE (USE ONLY)


PERSONNEL	REFERENCE NO.	<u>64</u>	SHEET	<u>44</u>	OF	<u>46</u>
NOTES	HOMAN	DATE	<u>6/30/09</u>	ROUTE	<u>SR 101</u>	
H.C.	HOMAN	WEATHER	<u>CLOUDY</u>	COUNTY	<u>SENECA</u>	
R.C.	ROUSOS	TEMP.	<u>70°</u>	TOWNSHIP	<u>ADAMS</u>	
				SECTION	<u>2</u>	
				T	<u>3</u>	N
				R	<u>16</u>	E

TYPE MONUMENT P.K./WASHER
~~ON SURFACE~~ - BELOW ON
 LEFT - Q PAV'T - ~~RIGHT~~ 1'
- TO - EDGE PAVEMENT
 S.L.M. 759+04

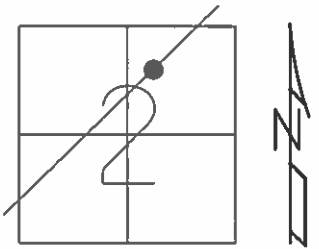

GRID: NORTHING: 577979.515 EASTING: 1834840.410

RECORD:
 STA. 759+04
 FD R.R. SPIKE
 4" DOWN
 SET P.K./WASHER
 8/29/90
 FD P.K./WASHER
 2/7/05, SAH
 SET MAG/WASHER
 10-07-09, DH

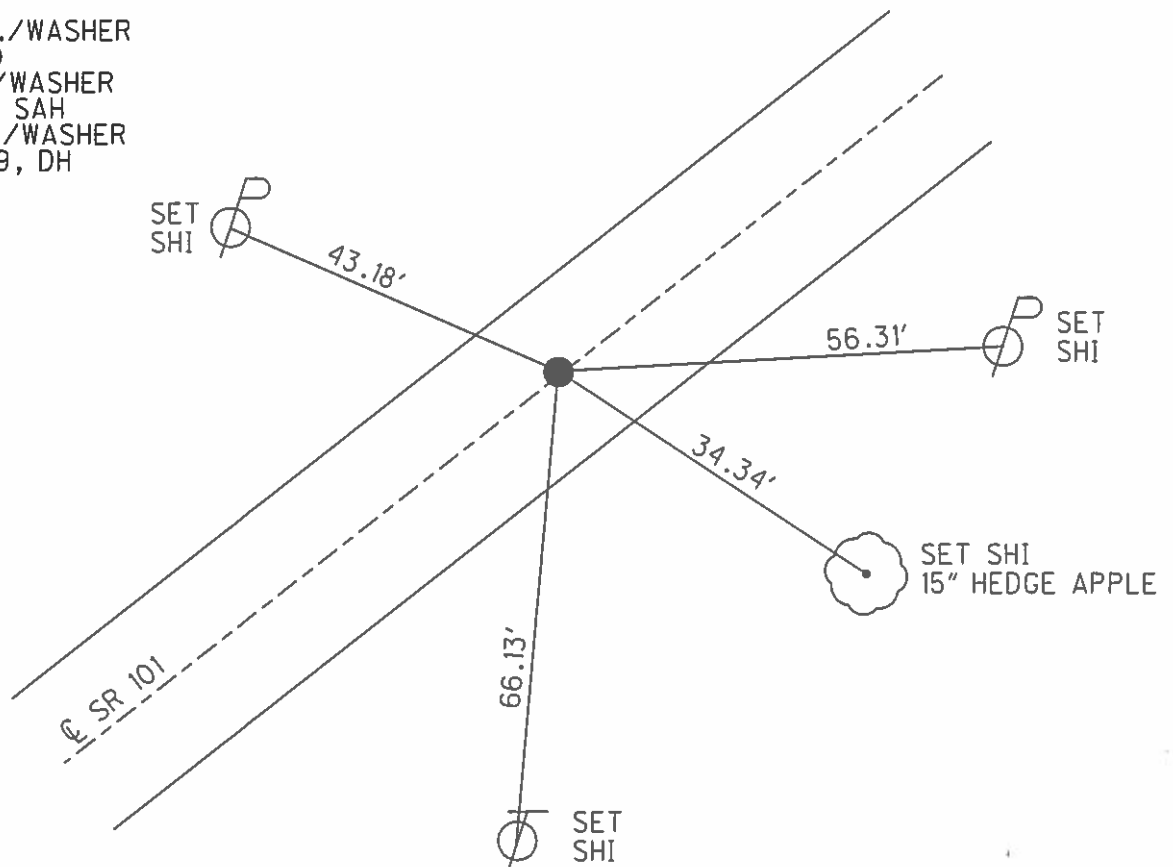

O.D.O.T. DISTRICT 2 SURVEY OFFICE

PERSONNEL

REFERENCE NO. 64

SHEET 39 OF 41

NOTES Ripple

H.C. Barbour

R.C. Geyman

DATE 8-29-90

WEATHER Cloudy

TEMP. 78°

ROUTE 101


COUNTY Sen.

TOWNSHIP Adams

SECTION 2


T 3 N R 16 E

TYPE MONUMENT Set P.K. + Washer
ON SURFACE - BELOW R/R spike 4" down
LEFT - PAV'T. - RIGHT 1' LT.
TO EDGE PAVEMENT
S.L.M. _____

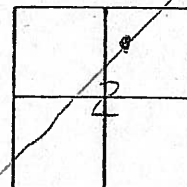

759+04

STA. 249+00

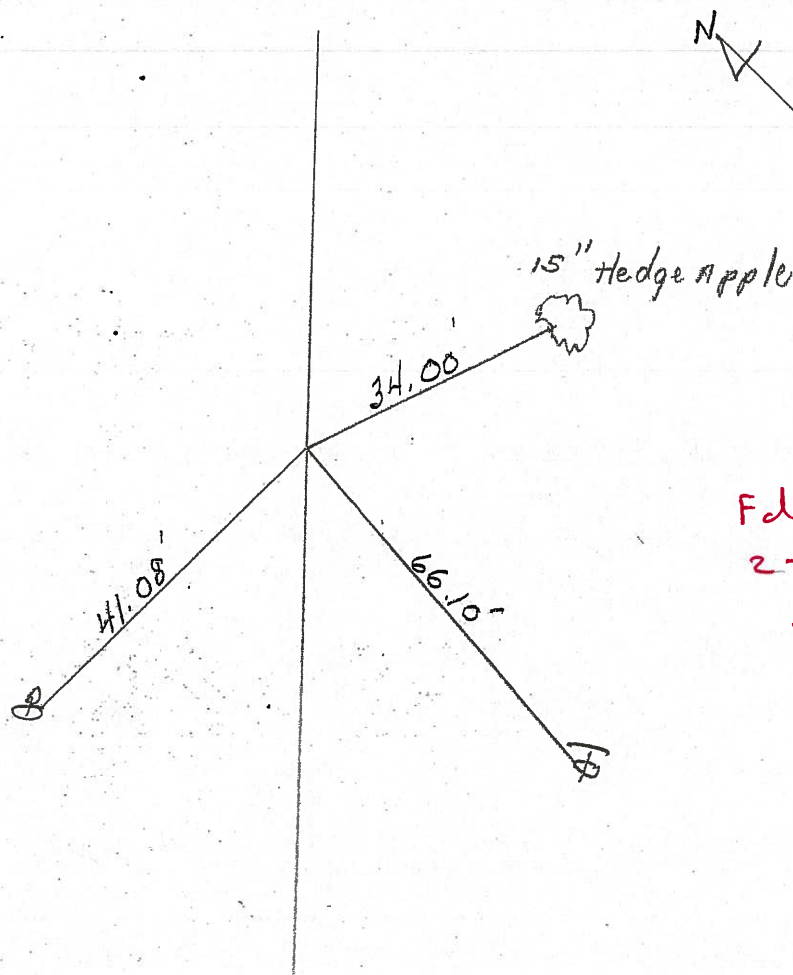

FD
2-7-05
SAH

O.D.O.T. DISTRICT 2 SURVEY OFFICE

PERSONNEL

REFERENCE NO. 64

SHEET 39 OF 41

NOTES Ripple

H.C. Barbour

DATE 8-29-90

ROUTE 101

R.C. Geyman

WEATHER Cloudy

COUNTY Sen.


TEMP. 78°

TOWNSHIP Adams


SECTION 2

T 3 N R 16 E

TYPE MONUMENT Set P.K. & Washer
ON SURFACE - BELOW R/R spike 4" down
LEFT - & PAV'T. - RIGHT 1 Lt.
TO EDGE PAVEMENT
S.L.M.

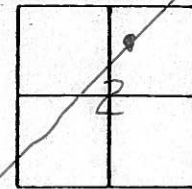

STA. 249+00

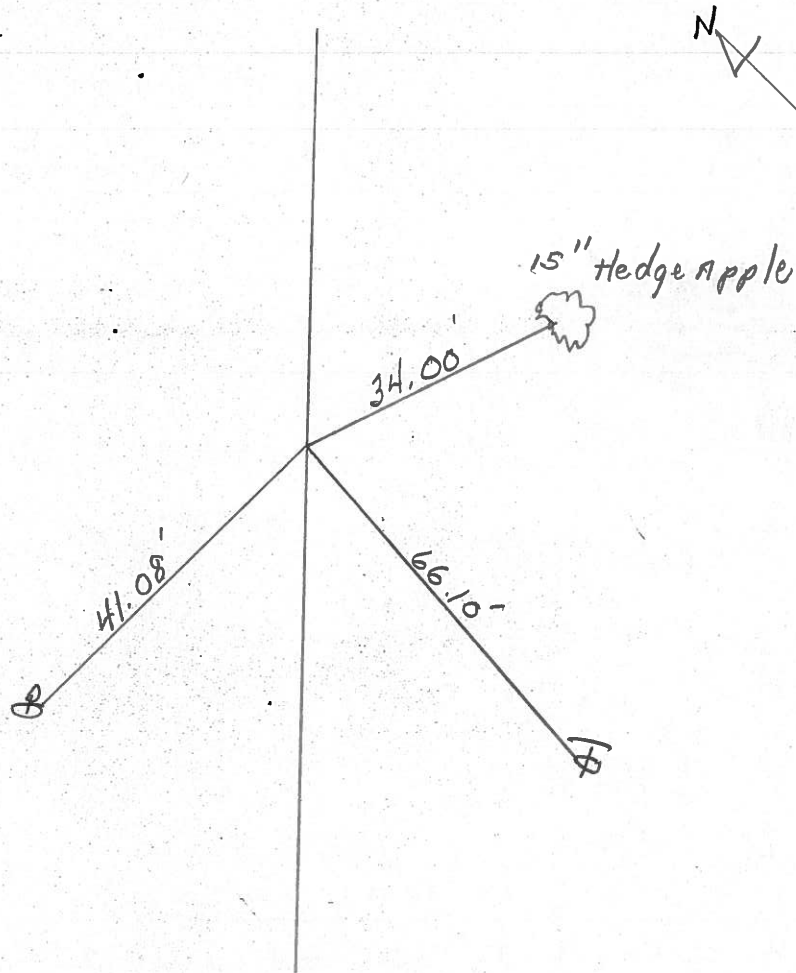

PERSONNEL TITLE PERSONNEL TITLE

COUNTY SenecaDATE 11-26-65S. R. # 101WEATHER 79

SEC.

TEMP 4-3-70

DESCRIPTION

LEFT

CENTER LINE

RIGHT

JOB NO.

4-20-79
60°

Found 7/1/69

Sta. 249+00

R.R. Sp. 0.25 ft. 1.1

1 1/2" below surface

759+

4/4

8511

21" Maple

40

39.76

39.76

58.74

39

34.00'

34.00'

7/02/90 85°

1' LT & P.K. Washer

15" Hedge apple

41.09

41.00

-01.99

15" Maple

54.53

22.42

15" Maple

49.04 New Pole

82.42

43.42

43.42

7/02/90 85°

PK & Washer

10" Escal

39.33

39.33

13.32

73.04

92.99

92.99

7/02/90 85°

1' LT & PK & Washer

Found 8/1/69

Sta. 224+00

R.R. Sp. 0.25 ft. 1.1

1 1/2" below surface

733+99

4/4

8509

13.32

73.04

92.99

92.99

92.99

61.10

61.10

PERSONNEL	TITLE	PERSONNEL	TITLE
Krabill			
Kowaleski			
Geyman			
Bruggeman			

COUNTY Seneca DATE 2-14-64S. R. # 101

WEATHER

SEC.

TEMP.

DESCRIPTION S.R. # 101 Tiffin to Sen. Co. line


JOB NO.

LEFT


CENTER LINE

RIGHT

(64)

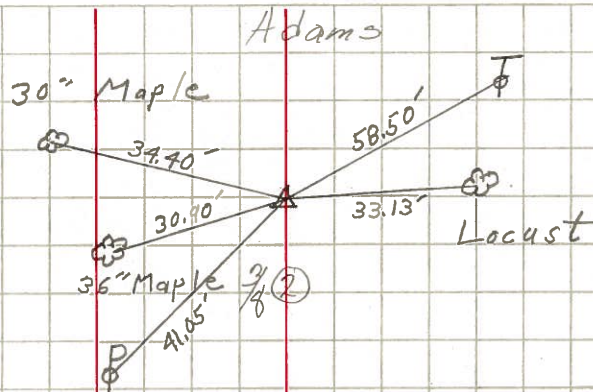STA. 249+00Iron Pin
414

(65)

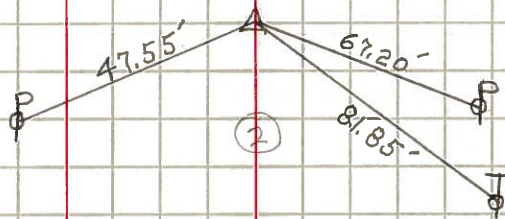STA. 259+00Iron Pin
415STA. 272+14.70Iron Pin
San. - Seneca Co. Line
416