

O.D.O.T. DISTRICT 2 SURVEY OFFICE (USE ONLY)

PERSONNEL

REFERENCE NO. 65

SHEET 45 OF 46

NOTES MILLER

DATE 8/7/24

ROUTE SR 101

H.C. MILLER

WEATHER SUNNY

COUNTY SENECA

R.C. BARRIERE

TEMP. 70°F

TOWNSHIP ADAMS

BLUBAUGH, ASTON, PRESTON-COLVIN

SECTION 2

DWG BY BLUBAUGH

PID 114849

T 3 N R 16 E

TYPE MONUMENT MAG/WASHER

~~ON SURFACE~~ - BELOW 0.5"

OFFSET Q PAVEMENT 1' LT : RT

-- TO -- EDGE PAVEMENT

STATION: 768+96

HORIZ.DATUM: NAD83 (2011)


GEOID: NAVD88-2018

GRID: NORTHING: 578620.258


EASTING: 1835595.787

LDP: NORTHING: 347750.526

EASTING: 209862.473

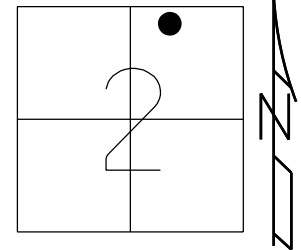

RECORD:
STA. 259+00
FD IPIN
4" BELOW
SET P.K./WASHER
8/29/90, BARBOUR
FD P.K./WASHER
2/7/05, SAH
REF65
6/30/09, DCH
SET MAG/WASHER
NEWREF65
10-07-09, DH
FD MAG/WASHER
REF65
6/16/16, JFO
9/12/17, JMR
REF65
12/12/23, TDN
FD TONE. DID NOT
UNCOVER. PAINTED
8/7/24, JAM

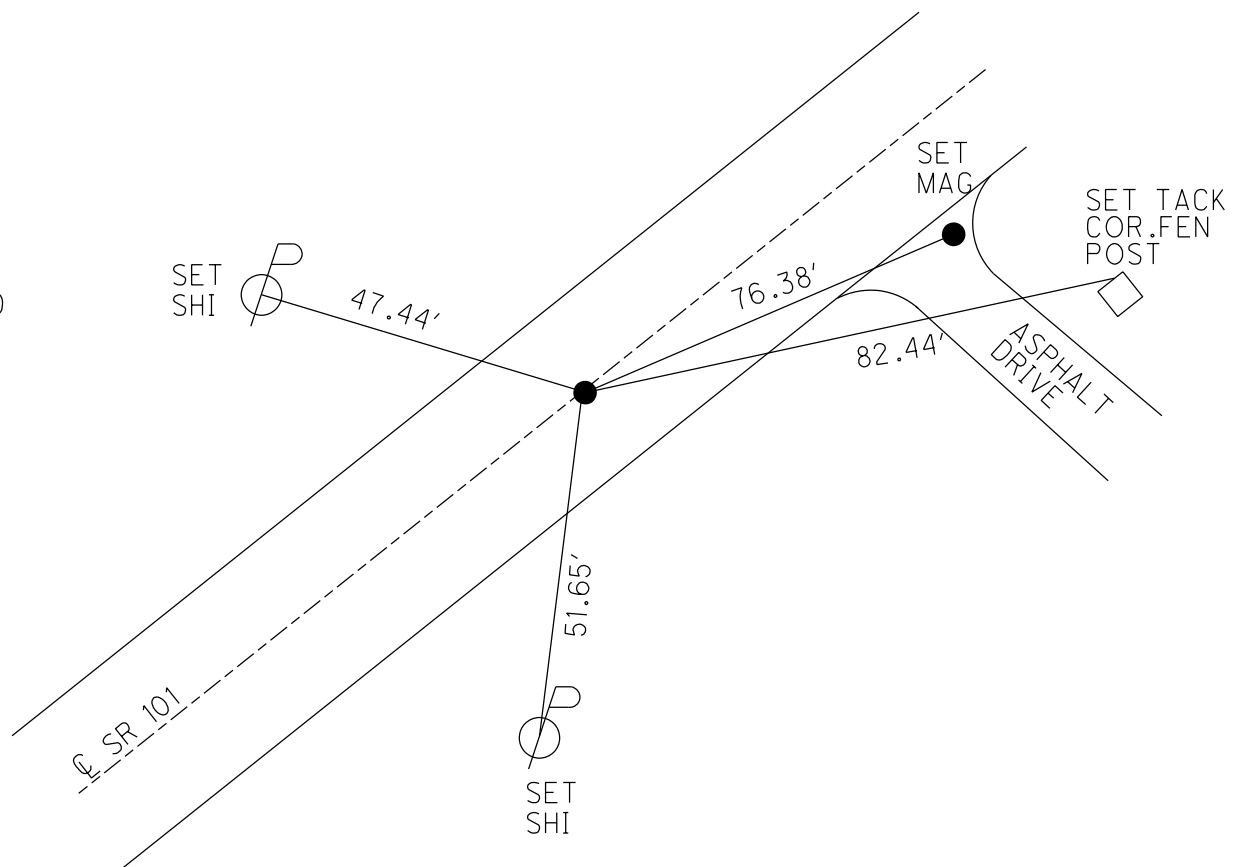

O.D.O.T. DISTRICT 2 SURVEY OFFICE (USE ONLY)

PERSONNEL

REFERENCE NO. 65

SHEET 45 OF 46

NOTES HOMAN

DATE 6-30-09

ROUTE SR 101

H.C. HOMAN

WEATHER CLOUDY

COUNTY SENECA

R.C. ROUSOS

TEMP. 70°F

TOWNSHIP ADAMS

DWG BY MAHLER

PID 100787

SECTION 2

T 3 N R 16 E

TYPE MONUMENT P.K./WASHER

ON SURFACE - ~~BELOW~~ ON

OFFSET CL PAVEMENT 1' LT : RT

- TO - EDGE PAVEMENT


STATION: 768+96

HORZ.DATUM: NAD83 (2011)


GEOID: NAVD88-2012A

GRID: NORTHING: 578620.258

EASTING: 1835595.787

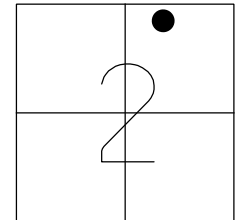


RECORD:
STA. 259+00
FD IPIN
4" BELOW
SET P.K./WASHER
8/29/90, BARBOUR
FD P.K./WASHER
2/7/05, SAH
FD P.K./WASHER
REF65
6/30/09, DCH
SET MAG/WASHER
NEWREF65
10-07-09, DH
FD MAG/WASHER
REF65
6/16/16, JFO
9/12/17, JMR

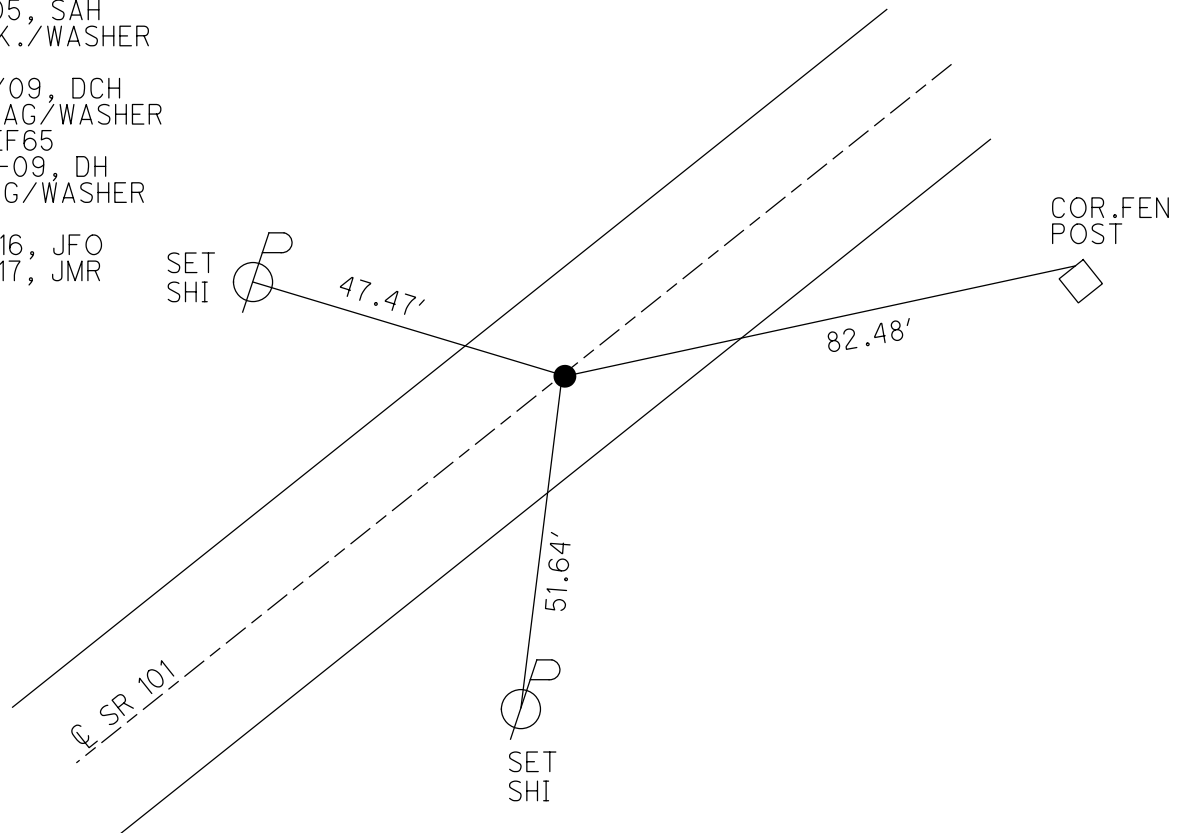

O.D.O.T. DISTRICT 2 SURVEY OFFICE (USE ONLY)


PERSONNEL	REFERENCE NO. <u>65</u>	SHEET <u>45</u> OF <u>46</u>
NOTES	DATE <u>6/30/09</u>	ROUTE <u>SR 101</u>
H.C. <u>HOMAN</u>	WEATHER <u>CLOUDY</u>	COUNTY <u>SENECA</u>
R.C. <u>ROUSOS</u>	TEMP. <u>70°</u>	TOWNSHIP <u>ADAMS</u>
		SECTION <u>2</u>
		T <u>3</u> N R <u>16</u> E

TYPE MONUMENT P.K./WASHER
~~ON SURFACE~~ - BELOW ON
 LEFT - Q PAV'T - ~~RIGHT~~ 1'
- TO - EDGE PAVEMENT
 S.L.M. 768+96

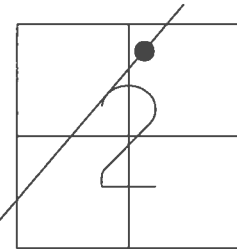

GRID: NORTHING: 578620.258 EASTING: 1835595.787

RECORD:
 STA. 259+00
 FD IPIN
 4" BELOW
 SET P.K./WASHER
 8/29/90
 FD P.K./WASHER
 2/7/05, SAH
 SET MAG/WASHER
 10-07-09, DH
 FD MAG/WASHER
 REF65
 6/16/16, JFO
 UNCOVERED
 9/12/17, JMR

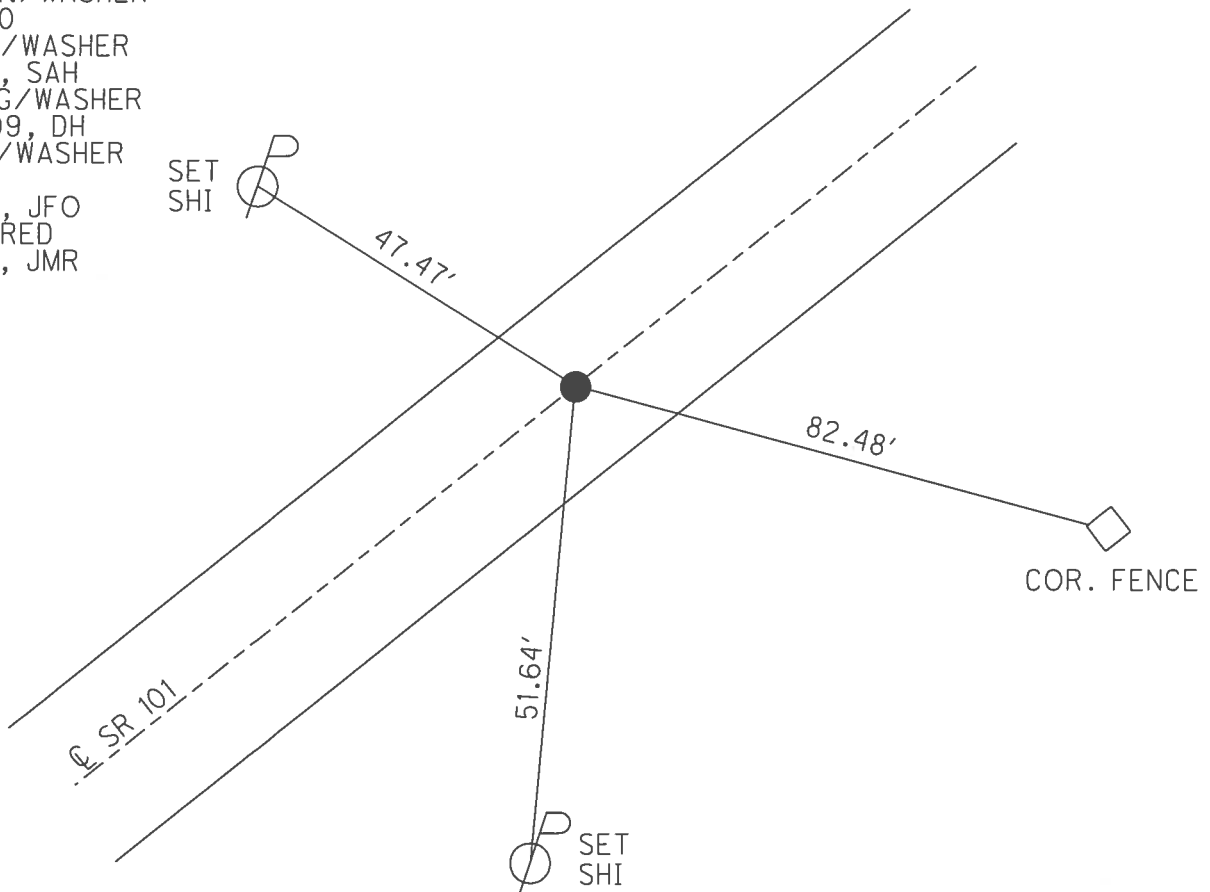


O.D.O.T. DISTRICT 2 SURVEY OFFICE (USE ONLY)


PERSONNEL _____ REFERENCE NO. 65 SHEET 45 OF 46
 NOTES HOMAN DATE 6/30/09 ROUTE SR 101
 H.C. HOMAN WEATHER CLOUDY COUNTY SENECA
 R.C. ROUSOS TEMP. 70° TOWNSHIP ADAMS
 _____ SECTION 2
 _____ T 3 N R 16 E

TYPE MONUMENT _____ P.K./WASHER
~~ON SURFACE~~ - BELOW _____ ON _____
 LEFT - ℄ PAV'T - ~~RIGHT~~ 1'
 _____ TO _____ EDGE PAVEMENT
 S.L.M. 768+96

GRID: NORTHING: 578620.349 EASTING: 1835595.738

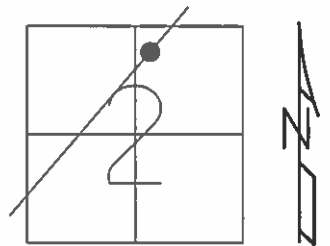

RECORD:
 STA. 259+00
 FD IPIN
 4" BELOW
 SET P.K./WASHER
 8/29/90
 FD P.K./WASHER
 2/7/05, SAH
 SET MAG/WASHER
 10-07-09, DH

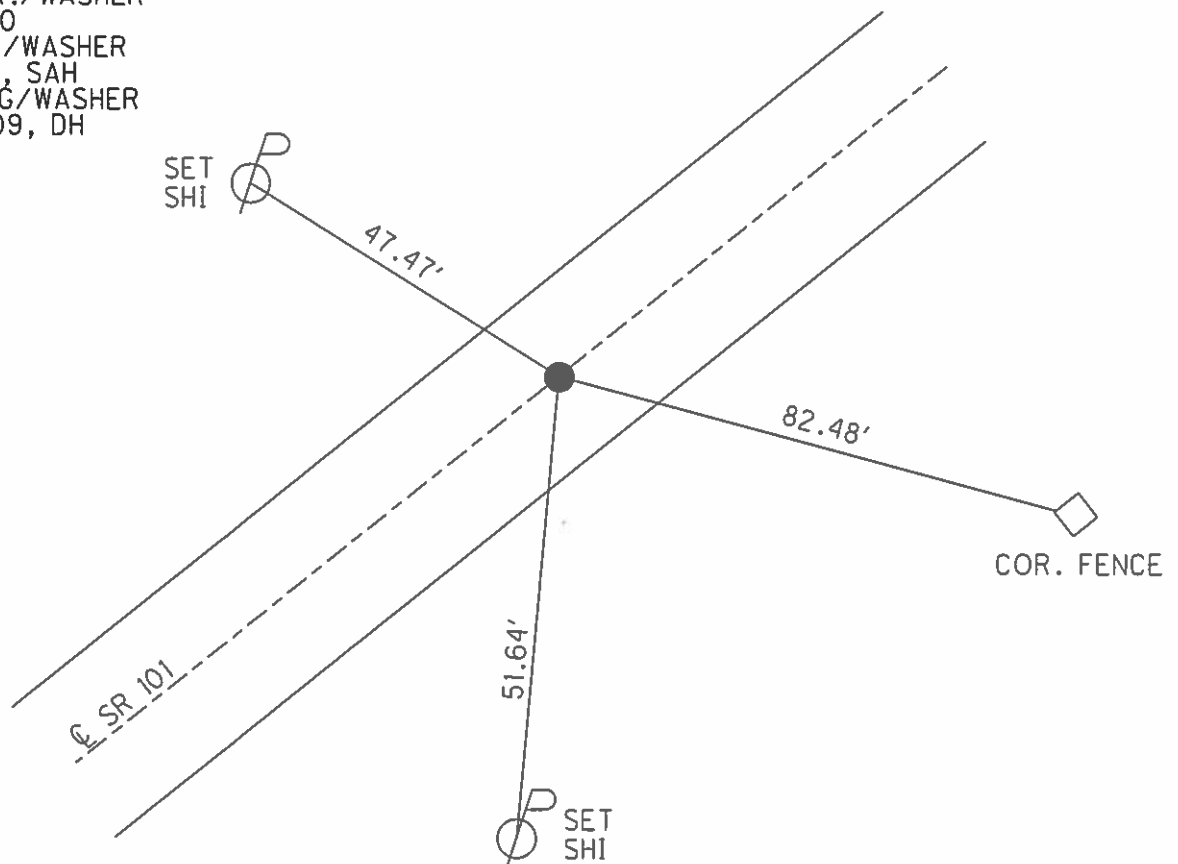

O.D.O.T. DISTRICT 2 SURVEY OFFICE

PERSONNEL

REFERENCE NO. 65

SHEET 40 OF 41

NOTES Ripple

H.C. Barbour

R.C. Geyman

DATE 8-29-90

WEATHER Cloudy

TEMP. 79°

ROUTE 101


COUNTY Sen.

TOWNSHIP Adams

SECTION 2


T 3 N R 16 E

TYPE MONUMENT Set P.K. ~ Washer
ON SURFACE - BELOW I. Pin 4" below
LEFT- & PAW'T. - RIGHT 1' Left
____ TO ____ EDGE PAVEMENT
S.L.M. _____

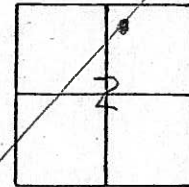

768+96

STA. 259+00

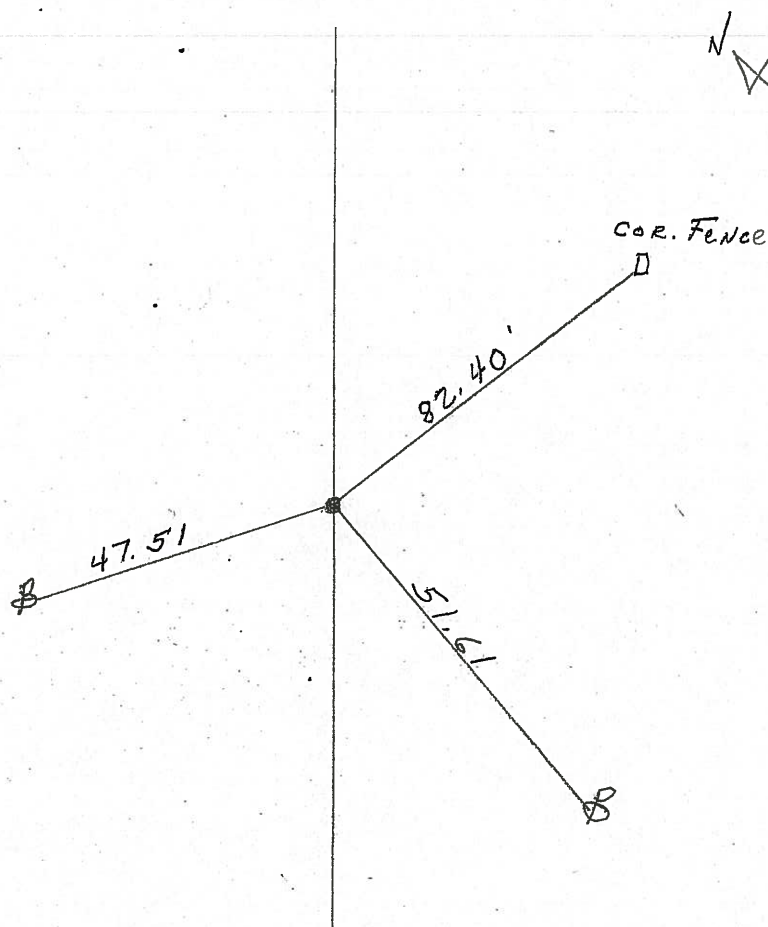

fd

2-7-05

SAH

O.D.O.T. DISTRICT 2 SURVEY OFFICE

PERSONNEL

REFERENCE NO. 65

SHEET 40 OF 41

NOTES Pipile

H.C. BARBOUR

DATE 8-29-90

ROUTE 101

R.C. GEYMAN

WEATHER Cloudy

COUNTY SEN.


TEMP. 79°

TOWNSHIP Adams


SECTION 2

T3 N R 16 E

TYPE MONUMENT Set P.K. - Washer
 ON SURFACE - BELOW I. Pin 4" below
 LEFT- & PAV'T. - RIGHT 1' Left
 TO EDGE PAVEMENT
 S.L.M.

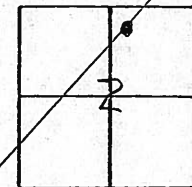

STA. 259+00

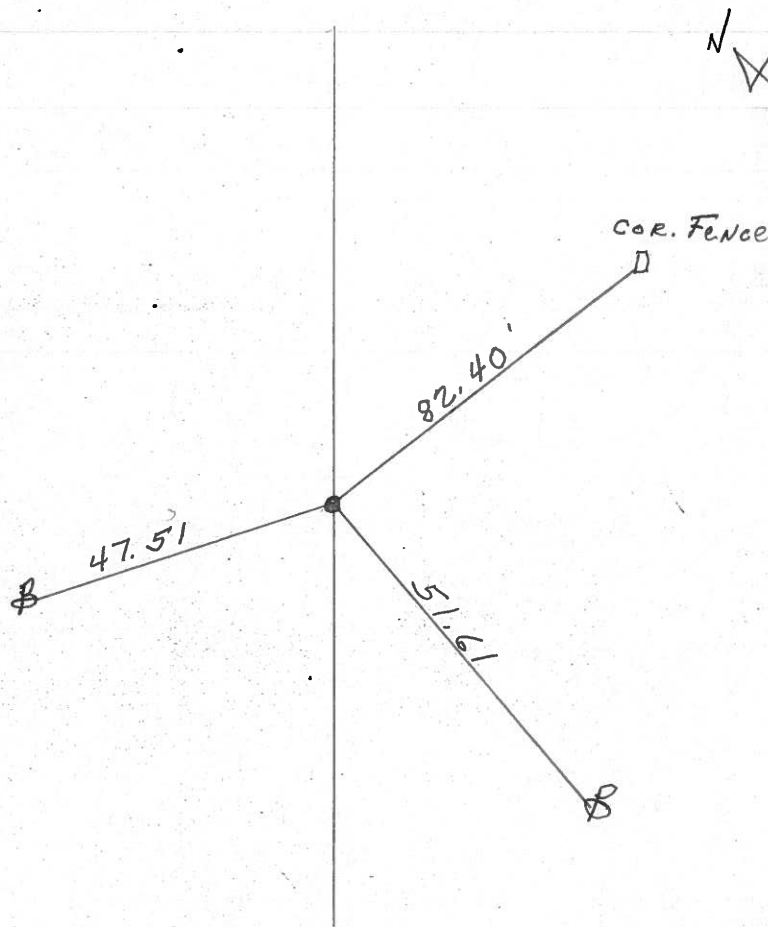

PERSONNEL TITLE PERSONNEL TITLE

COUNTY Seneca DATE 2-14-64

Krabill

Kowaleski

S. R. # 101

WEATHER

Geyman

SEC.

TEMP.

Bruggeman

DESCRIPTION S. R. # 101 Tiffin to Sen. Co. line

JOB NO.


LEFT

CENTER LINE

RIGHT


(64)

STA. 249+00

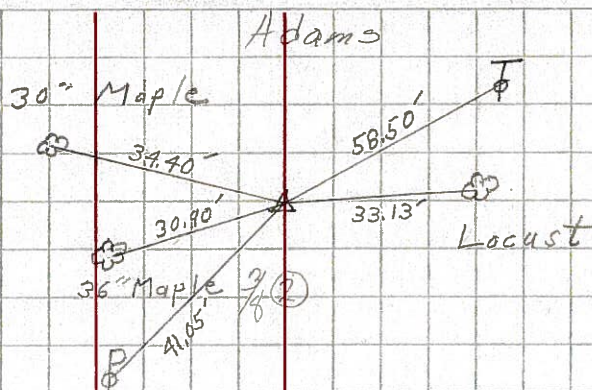Iron Pin
414

(65)

STA. 259+00

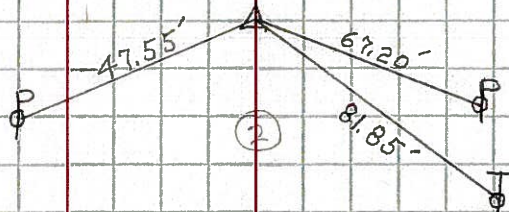Iron Pin
415

STA. 272+14.70

Iron Pin
Sen. - Seneca Co. Line
416