

O.D.O.T. DISTRICT 2 SURVEY OFFICE (USE ONLY)

PERSONNEL

REFERENCE NO. 66

SHEET 45 OF 46

NOTES MILLER

DATE 8/7/24

ROUTE SR 101

H.C. MILLER

WEATHER SUNNY

COUNTY SENECA

R.C. BARRIERE

TEMP. 43°F

TOWNSHIP ADAMS

BLUBAUGH, ASTON, PRESTON-COLVIN

SECTION 2

DWG BY BLUBAUGH

PID 114849

T 3 N R 16 E

TYPE MONUMENT 5/8" IPIN

~~ON SURFACE~~ - BELOW 6.5"

OFFSET $\oslash$ PAVEMENT 10.5' LT : RT

-- TO -- EDGE PAVEMENT

STATION: 782+25

HORIZ.DATUM: NAD83 (2011)


GEOID: NAVD88-2018

GRID: NORTHING: 579407.932

EASTING: 1836662.427


LDP: NORTHING: 348546.110

EASTING: 210923.317

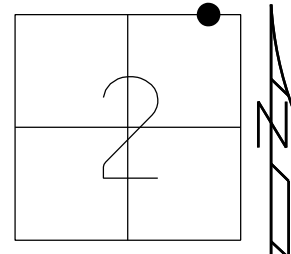

RECORD: P.I.
STA. 782+00
FD IPIN
5" DOWN
SET P.K./WASHER
10/1/92, BARBOUR
FD P.K./WASHER
REF66
10/7/09, DCH
FD 5/8" IPIN
6.5" DOWN
REF1
6/16/16, JFO
9/12/17, JMR
REF1
12/11/23, JAM
FD TONE. DID NOT
UNCOVER. PAINTED
8/7/24, JAM

NOTE: REF 66 SEN CO.

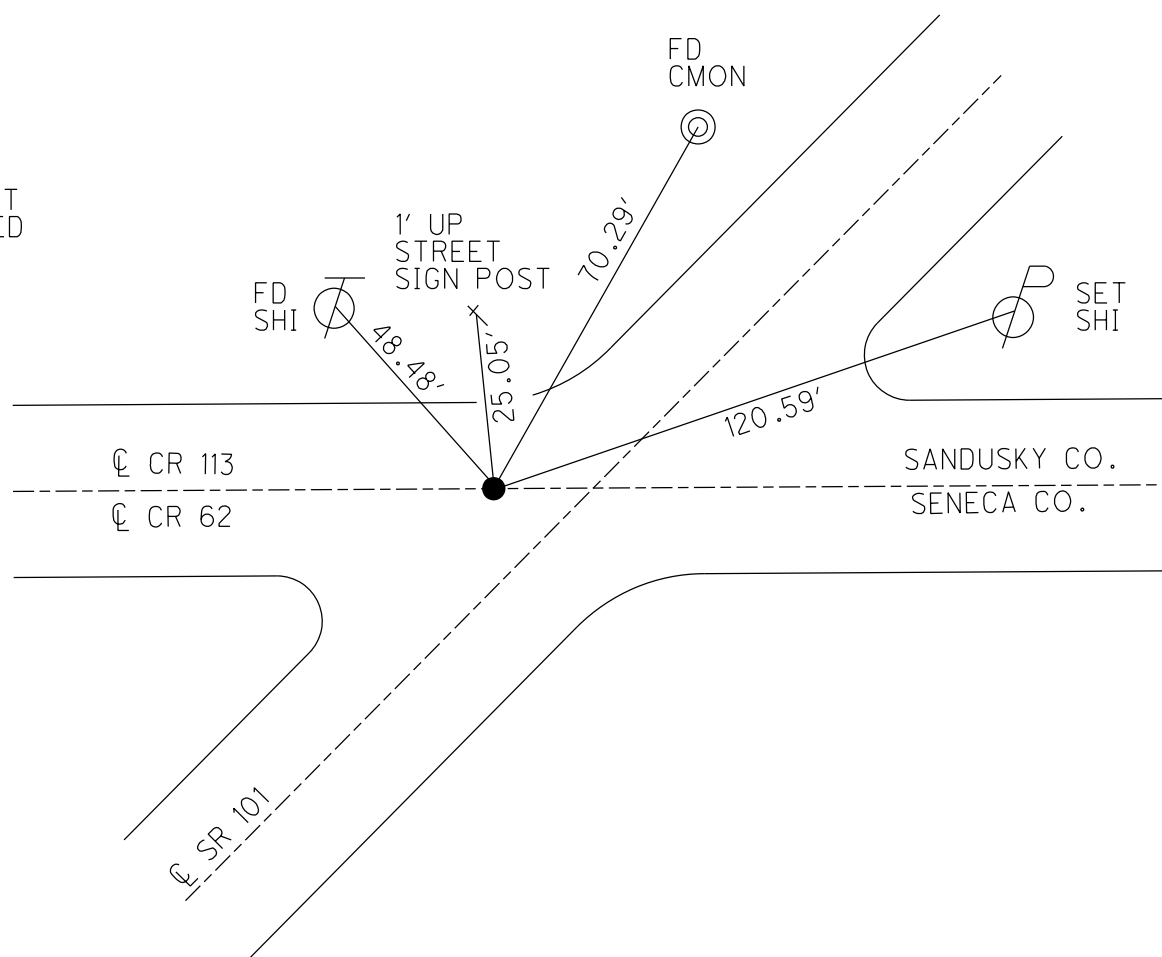

O.D.O.T. DISTRICT 2 SURVEY OFFICE (USE ONLY)

PERSONNEL

REFERENCE NO. 66

SHEET 46 OF 46

NOTES RHOADES

DATE 3-28-17

ROUTE SR 101

H.C. O'DONNELL

WEATHER CLOUDY

COUNTY SENECA

R.C. RHOADES

TEMP. 43°F

TOWNSHIP ADAMS

DWG BY MAHLER PID 100787

SECTION 2

T 3 N R 16 E

TYPE MONUMENT 5/8" IPIN

~~ON SURFACE~~ - BELOW 6.5"

OFFSET $\oslash$ PAVEMENT 10.5' LT : ~~RT~~

- TO - EDGE PAVEMENT


STATION: 782+25

HORIZ.DATUM: NAD83 (2011)

GEOID: NAVD88-2012A


GRID: NORTHING: 579407.932

EASTING: 1836662.427

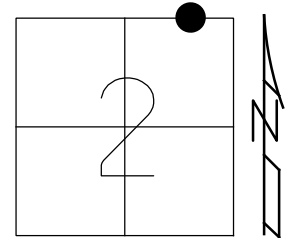

RECORD: P.I.
STA. 782+00
FD IPIN
5" DOWN
SET P.K./WASHER
10/1/92, BARBOUR
FD P.K./WASHER
REF66
10/7/09, DCH
FD 5/8" IPIN
6.5" DOWN
REF1
6/16/16, JFO
9/12/17, JMR


NOTE: SAN 101 REF 1

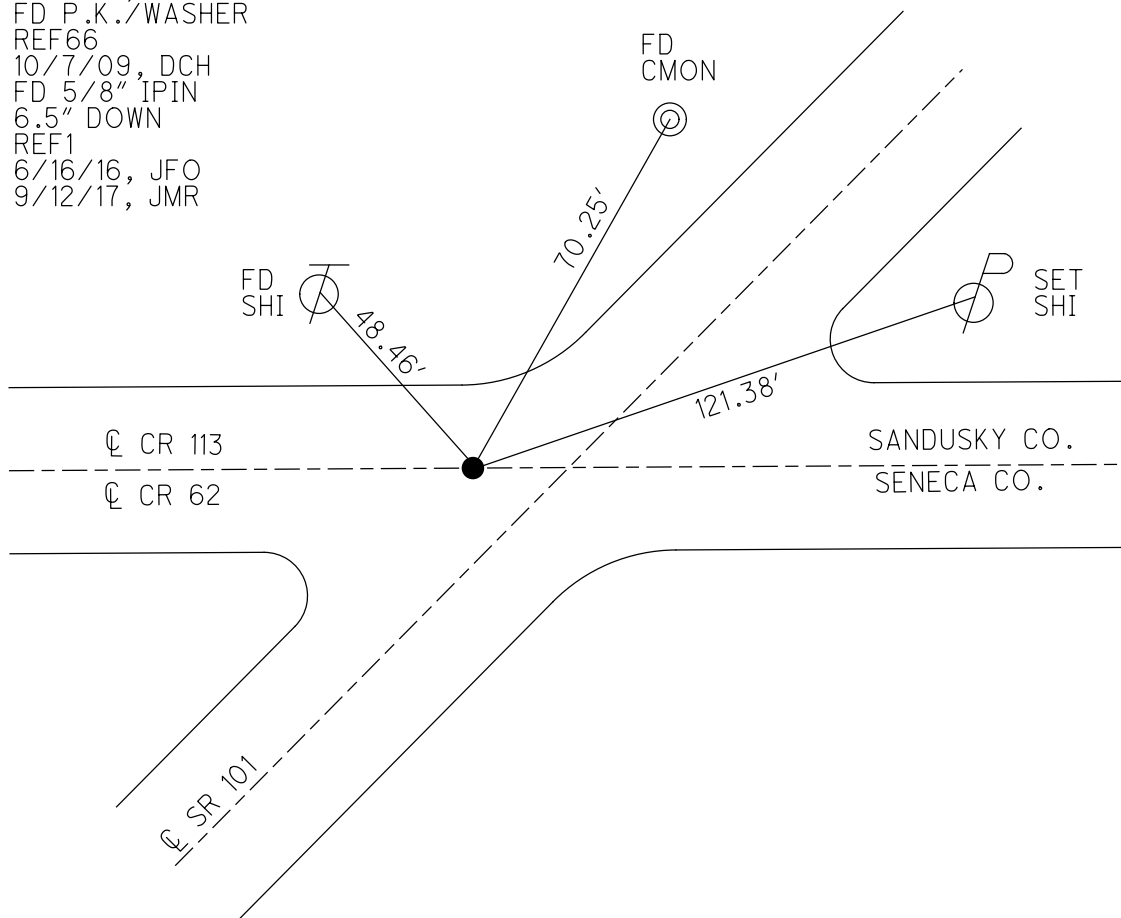

O.D.O.T. DISTRICT 2 SURVEY OFFICE (USE ONLY)

PERSONNEL	REFERENCE NO. <u>66</u>	SHEET <u>46</u> OF <u>46</u>
NOTES	DATE <u>3/28/17</u>	ROUTE <u>SR 101</u>
H.C. <u>RHOADES</u>	WEATHER <u>CLOUDY</u>	COUNTY <u>SENECA</u>
R.C. <u>HELDMAN</u>	TEMP. <u>43°</u>	TOWNSHIP <u>ADAMS</u>
		SECTION <u>2</u>
		T <u>3</u> N R <u>16</u> E


TYPE MONUMENT 5/8" IPIN
~~ON SURFACE~~ - BELOW 6.5"
 LEFT - ℄ PAV'T - ~~RIGHT~~ 10.5'
- TO - EDGE PAVEMENT
 S.L.M. 782+25

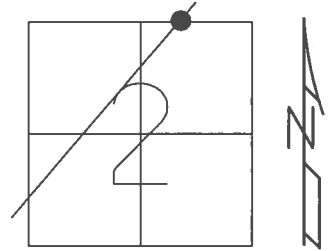

GRID: NORTHING: 579407.932 EASTING: 1836662.427

RECORD:
 P.I. STA. 782+00
 FD IPIN
 5" DOWN
 SET P.K./WASHER
 10/1/92
 SET MAG/WASHER
 10/15/08, DCH
 FD P.K./WASHER ATOP
 IPIN, 5" DOWN
 10/7/09, DCH
 FD 5/8" IPIN
 6.5" DOWN
 REF1
 6/16/16, JFO
 FD HOLE W/IPIN
 9/12/17, JMR


NOTE: REF 1 SAN CO.

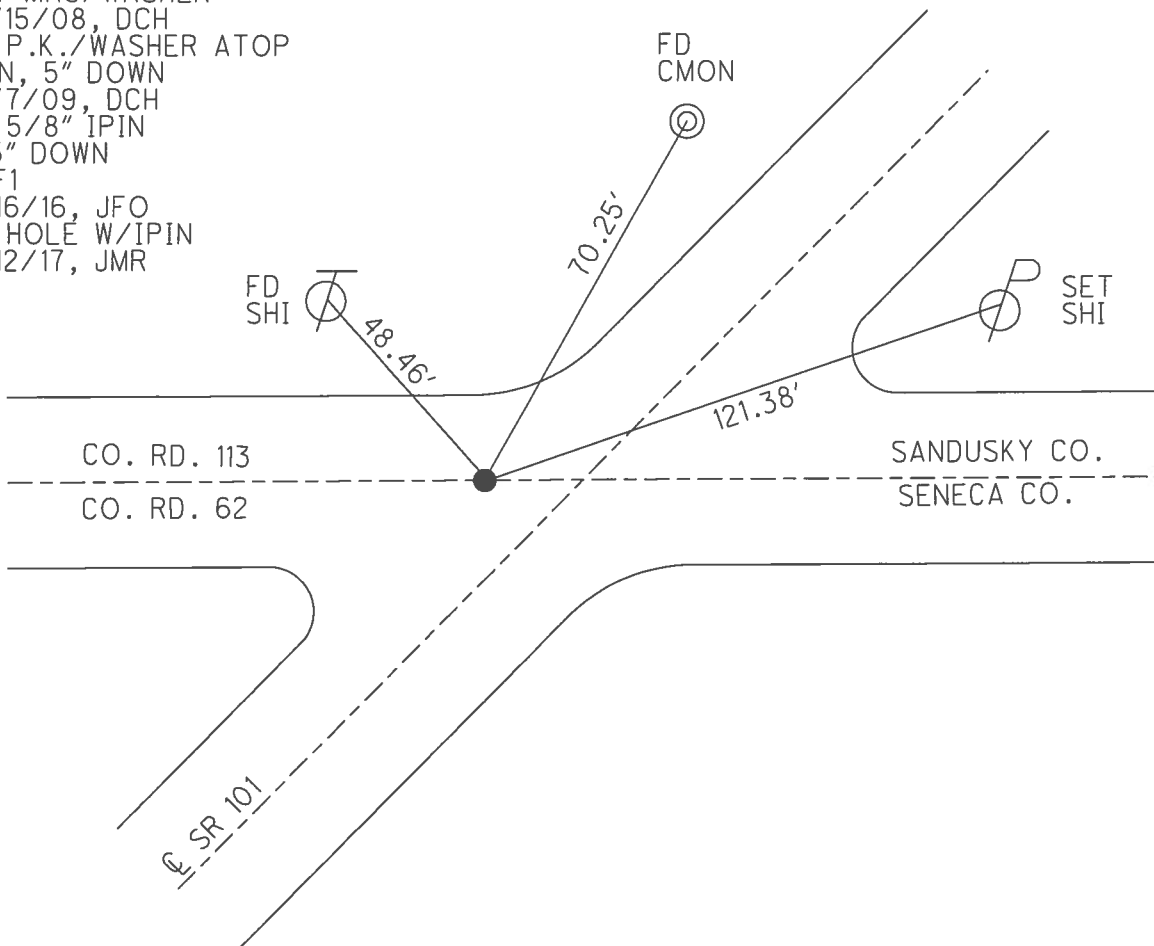

O.D.O.T. DISTRICT 2 SURVEY OFFICE (USE ONLY)


PERSONNEL	REFERENCE NO.	<u>66</u>	SHEET	<u>46</u>	OF	<u>46</u>
NOTES	HOMAN	DATE	<u>10/07/09</u>	ROUTE	<u>SR 101</u>	
H.C.	HOMAN	WEATHER	<u>CLOUDY</u>	COUNTY	<u>SENECA</u>	
R.C.	ROUSOS	TEMP.	<u>70°</u>	TOWNSHIP	<u>ADAMS</u>	
				SECTION	<u>2</u>	
				T	<u>3</u>	N
				R	<u>16</u>	E

TYPE MONUMENT P.K./WASHER
~~ON SURFACE~~ - BELOW ON
 LEFT - ℄ PAV'T - ~~RIGHT~~ 10"
- TO - EDGE PAVEMENT
 S.L.M. 782+25

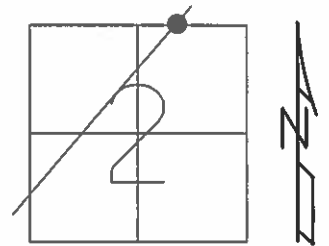

GRID: NORTHING: 550346.310 EASTING: 1805897.663

RECORD:
 STA. 782+24
 FD IPIN
 5" DOWN
 SET P.K./WASHER
 8/29/90
 FD P.K./WASHER
 2/7/05, SAH

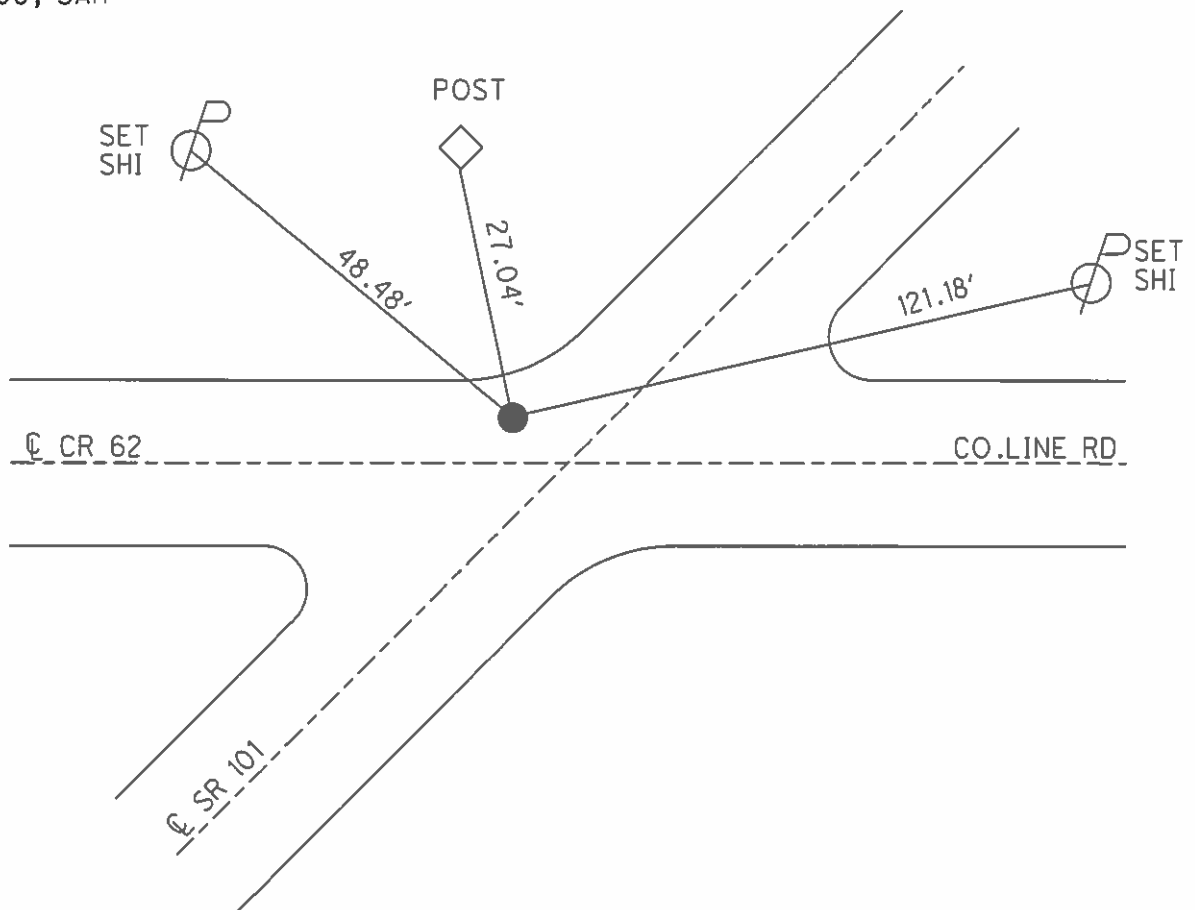

O.D.O.T. DISTRICT 2 SURVEY OFFICE

PERSONNEL

REFERENCE NO. 66

SHEET 41 OF 41

NOTES Ripple

H.C. BARBOUR

DATE 8-29-90

ROUTE 101

R.C. GEYMAN

WEATHER CLOUDY

COUNTY SEN

TEMP. 80°


TOWNSHIP ADAMS

SECTION 2


T3 N R 16 E

TYPE MONUMENT P.K. & WASHER TOP
ON SURFACE - BELOW 5" DOWN I. PIN
LEFT- & PAV'T. - RIGHT 10' LT.
TO EDGE PAVEMENT
S.L.M. _____

3	2
10	11

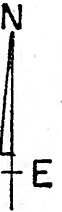

782+25

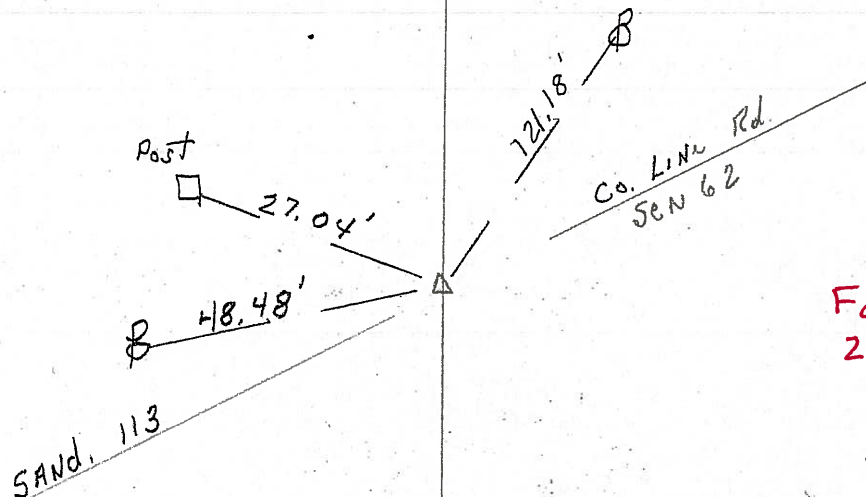

Fd
2-7-05
SAH

STA. 782+

O.D.O.T. DISTRICT 2 SURVEY OFFICE

PERSONNEL

REFERENCE NO. 66

SHEET 41 OF 41

NOTES Ripple

H.C. Barbour

DATE 8-29-90

ROUTE 101

R.C. Geyman

WEATHER Cloudy

COUNTY Sen

TEMP. 80°

TOWNSHIP Adams

SECTION 2

T3 N R16 E

TYPE MONUMENT P.K. & Washer Top
 ON SURFACE - BELOW 5" down I. Pin
 LEFT - & PAV'T. - RIGHT 10' Lt.
 TO EDGE PAVEMENT
 S.L.M.

3	2
10	11

