



O.D.O.T. DISTRICT 2 SURVEY OFFICE (USE ONLY)

PERSONNEL	REFERENCE NO.	59	SHEET	17	OF	19
NOTES	HOMAN	DATE	9/8/14	ROUTE	SR 224	
H.C.	LEU	WEATHER	FAIR	COUNTY	SENECA	
R.C.	HOMAN	TEMP.	70°	TOWNSHIP	BLOOM	
				SECTION	6	
				T	1	N
				R	16	E

TYPE MONUMENT P.K.NAIL
 ON SURFACE - ~~BELOW~~ ON _____
 LEFT - ☉ PAV'T - RIGHT ON _____
10' TO LT EDGE PAVEMENT
 S.L.M. 1024+07.88

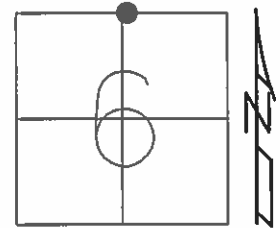

Grid: Northing: 515721.202 Easting: 1812995.161

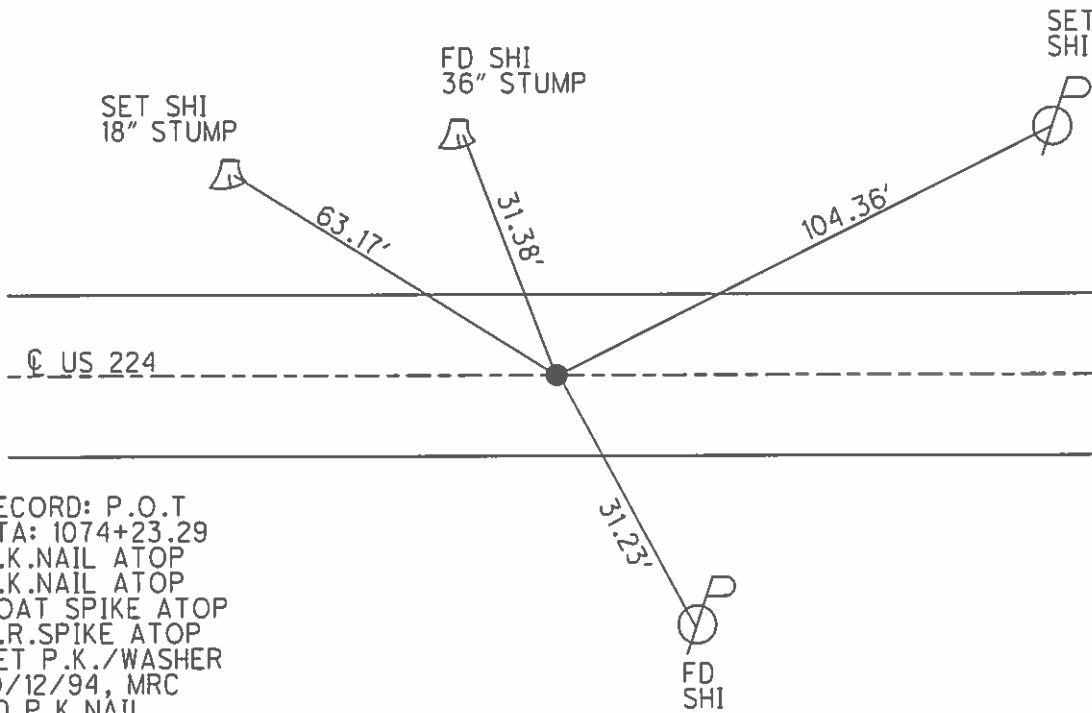

RECORD: P.O.T
 STA: 1074+23.29
 P.K.NAIL ATOP
 P.K.NAIL ATOP
 BOAT SPIKE ATOP
 R.R.SPIKE ATOP
 SET P.K./WASHER
 10/12/94, MRC
 FD P.K.NAIL
 1/15/13, SDC
 GPS, REF59
 1/16/13, DCH
 SET MAG/WASHER
 12/15/14
 GPS, NEWREF59
 7/13/15, JFO

O.D.O.T. DISTRICT 2 SURVEY OFFICE

PERSONNEL _____

REFERENCE NO. 59

SHEET 13 OF 16

NOTES CHANEY

H.C. RIPPLE

R.C. BARBOUR

DATE 5-2-94

WEATHER FAIR

TEMP. +62

ROUTE S.R. 224

COUNTY SENECA

TOWNSHIP Bloom

SECTION 6

T1 N R 16 E

TYPE MONUMENT P.K. WASHER

ON SURFACE - ~~BELOW~~ Yes

~~LEFT - & PAV'T. - RIGHT~~ Yes


10' TO Lt EDGE PAVEMENT

S.L.M. 1024+60

Reset

10-12-94


M.R.C.

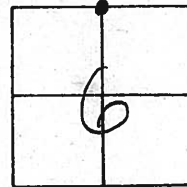

Rec POT Sta. 1074+23.29

P.K. atop P.K. atop BOAT SPIKE

atop R.R. SPIKE

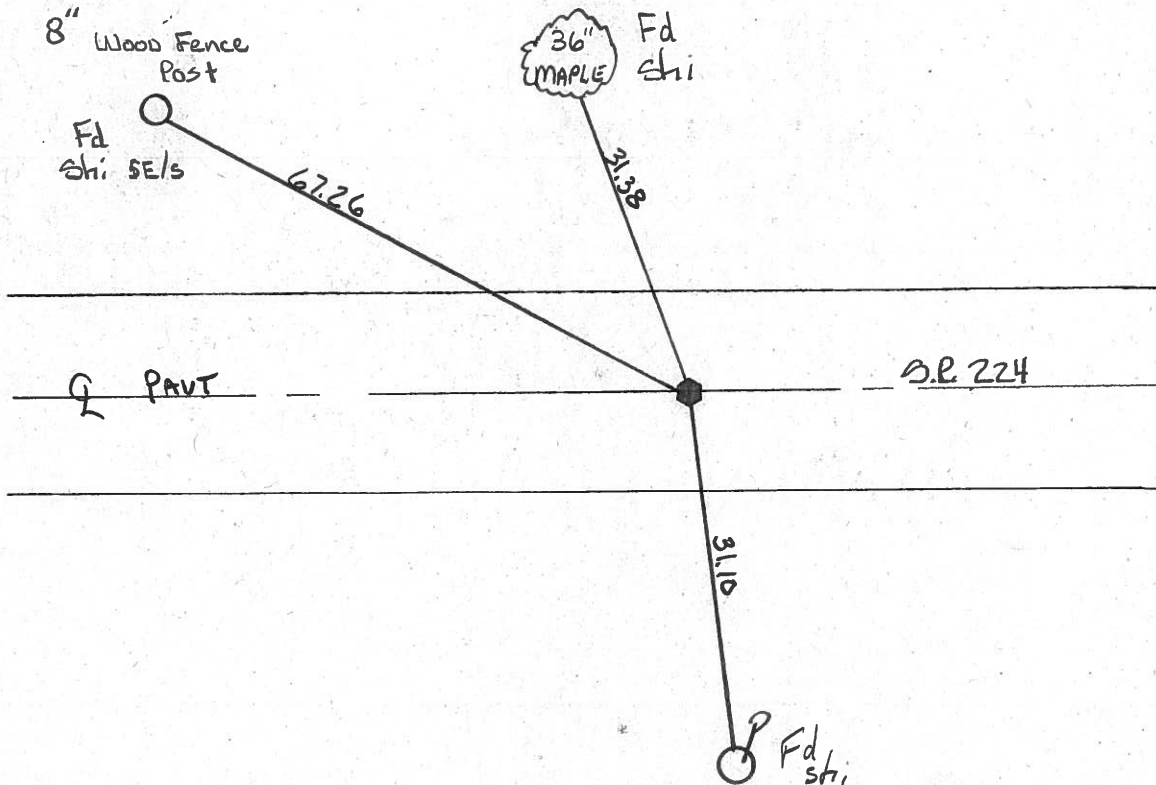

County Seneca S.R. #224

Date 6/24/82

Township Bloom

Weather sunny

Section 6

Temp. 67°

T1N, R16E

Personnel Cronin


Ripple

Geyman

Mosser

Barbour


#59

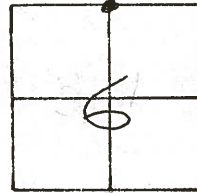

P.O.T.

1074+23.29

Set P.K. & washer atop boat spike, washer atop R.R. spike

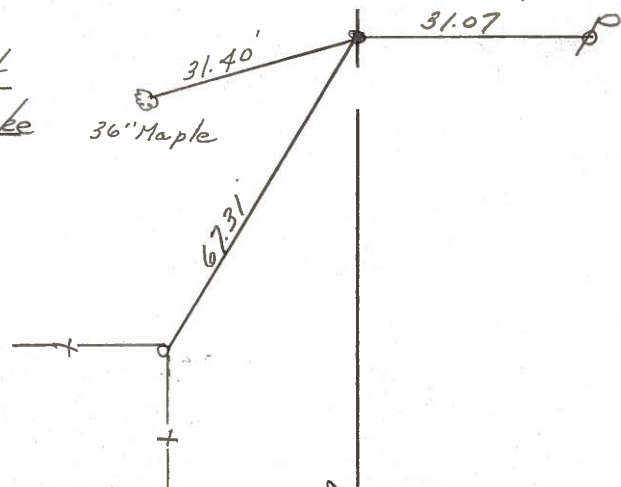

U.S. # 2247

PERSONNEL TITLE PERSONNEL TITLE COUNTY Seneca DATE 7-30-68
 Schneider Potts S. R. U.S. #224 to Attica WEATHER Cloudy
 Mosser _____ SEC. S.R.#100 to Attica TEMP. Rain
 Barbour _____
 Redding _____

DESCRIPTION Ties for Control Points JOB NO.

LEFT CENTER LINE RIGHT

4/5/3/82
 sunny 70°

60

P.I. 1076+37.09 R/w Mon. 30.27 29.98 R/w Mon.
 Iron Pin
 Reset small spk.

8606

59

P.O.T. 1074+23.29 R.R. spk. 3" down
 Reset small spk. 18" Maple boat & washer
 36" Maple 31.40
 67.3'
 31.01'
 1/2 Sec. Line
 18" Ash
 Car. fence post

8605

58

P.I. 1048+20± R/w Mon. 29.82 29.72 R/w Mon.
 RR spk. 5" down
 Reset small spk. washer
 52.06
 steel sign Post @ ground
 SURV Kap on surface
 51.53
 0.85
 0.92

8604

PERSONNEL	TITLE	PERSONNEL	TITLE	COUNTY	DATE	WEATHER	TEMP.
Krabiell				Seneca			
Kowaleski				224			
Brooks							

DESCRIPTION _____ LEFT _____ CENTER LINE _____ RIGHT _____ JOB NO. _____

