

O.D.O.T. DISTRICT 2 SURVEY OFFICE (USE ONLY)

PERSONNEL

REFERENCE NO. 23B

SHEET _____ OF _____

NOTES NIESE

DATE 6/15/23

ROUTE SR 587

H.C. _____

WEATHER _____

COUNTY SENECA

R.C. _____

TEMP. _____

TOWNSHIP LOUDON

DWG BY BARRIERE

PID 110912

SECTION 34

T 2 N R 13 E

TYPE MONUMENT MONBOX W/ 3/4" IPIN

ON SURFACE - BELOW ON

OFFSET Q PAVEMENT LT LT : RT


TO EDGE PAVEMENT

STATION: 431+99.16

HORIZ.DATUM: NAD83-2011/SEN LDP GEOID: 18

GRID: NORTHING: 519933.575 EASTING: 1733243.494

LDP: NORTHING: 288297.149 EASTING: 107941.003

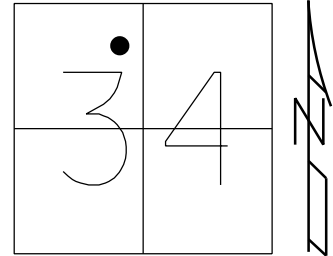

RECORD: P.I.
FD MONBOX
W/ 3/4" IPIN
REF23B
SET DURING SEN-224-3.64

