


O.D.O.T. DISTRICT 2 SURVEY OFFICE (USE ONLY)


PERSONNEL _____ REFERENCE NO. 20 SHEET 15 OF 19
 NOTES AUBLE DATE 9/4/19 ROUTE US 6
 H.C. LEU WEATHER SUNNY COUNTY WILLIAMS
 R.C. NASON TEMP. 65° TOWNSHIP PULASKI
 _____ NIESE SECTION 36
 DWG BY NIESE PID 95792 T 6 N R 3 E

TYPE MONUMENT R.R. SPIKE
~~ON SURFACE~~ - BELOW 4"
 OFFSET Q PAVEMENT ON LT : RT
11.9' TO RT EDGE PAVEMENT
 STATION: 959+36.50

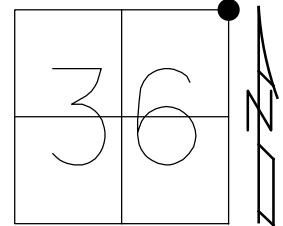

HORIZ. DATUM: NAD83(2011) GEOID: 2012A
 GRID: NORTHING: 652716.171 EASTING: 1431444.697

RECORD:
 FD LG RRSPK
 4" DOWN
 5/30/86
 FD PK & WASHER
 4/29/02, MB
 SET MAG/WASHER
 8/28/03, MB
 FD RRSPK
 4" BELOW
 REF20
 2/13/18, JFO
 SET MAG/WASHER
 11/13/19, JFO

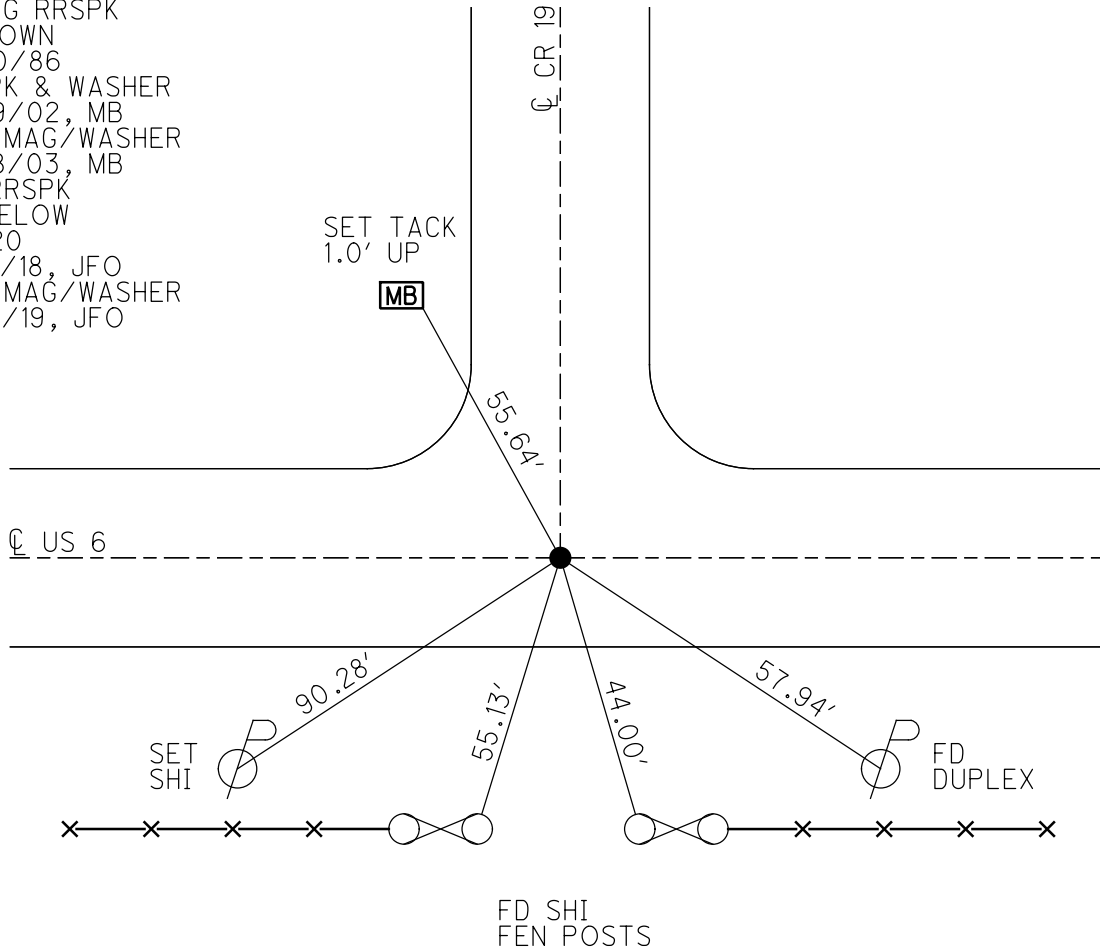

O.D.O.T. DISTRICT 2 SURVEY OFFICE

PERSONNEL _____

REFERENCE NO. 20

SHEET 15 OF 20

NOTES Bacnhisel

H.C. Canterbury

DATE 4-29-02

ROUTE U.S. 6

R.C. Moser

WEATHER cloudy

COUNTY WILLIAMS

TEMP. +45°

TOWNSHIP PULASKI

SECTION 36

T 6 N R 3 E


TYPE MONUMENT PK + Washer

ON SURFACE - BELOW on surface

LEFT - Q PAV'T. - RIGHT _____


11.7' TO RT. EDGE PAVEMENT

S.L.M. 960+04

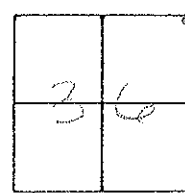

RECORD: 5-30-86
Fd. L.G. R.R. SPIKE 4" DOWN

SET MAG NAIL & WASHER
8-28-03
MB

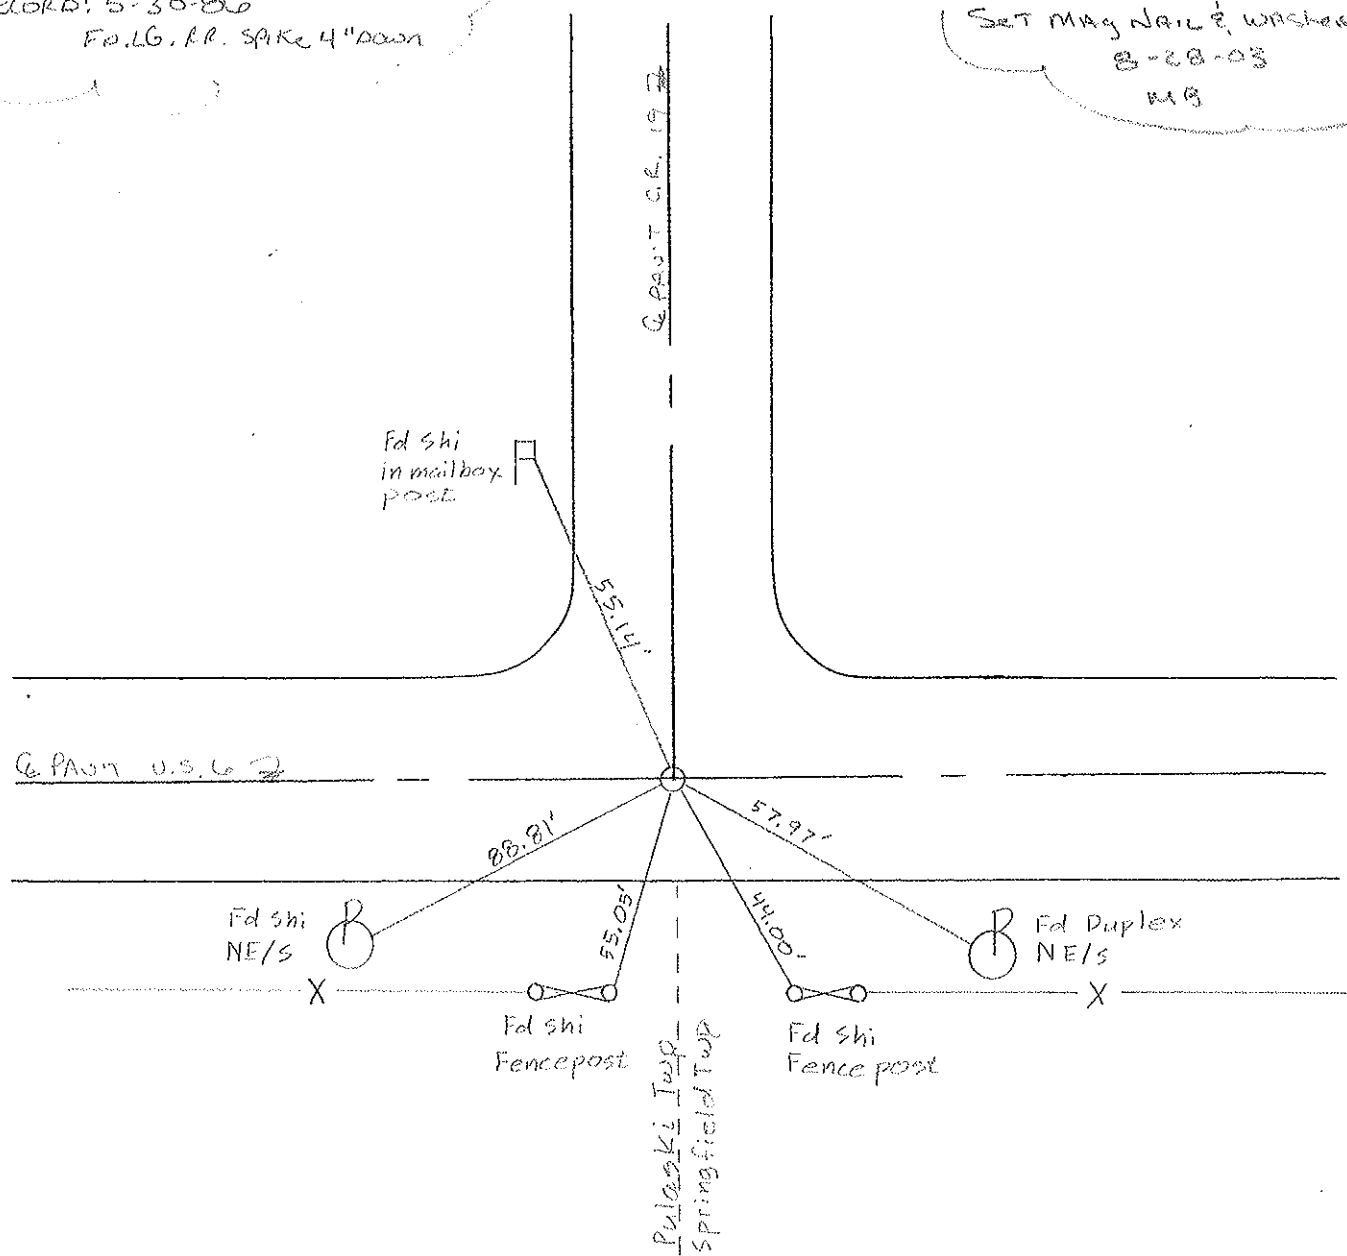

O.D.O.T. DISTRICT 2 SURVEY OFFICE

PERSONNEL

REFERENCE NO. 20

SHEET 16 OF 22

NOTES VAN DUSEN

H.C. KUSZ

DATE 20 July 1992

ROUTE US 6

R.C. MCCORMICK

WEATHER RAIN

COUNTY Williams

TEMP. 75°

TOWNSHIP SPRINGFIELD / Pulaski

SECTION 25, 30, 31, 36

T 6 N R E


TYPE MONUMENT PK & WASHER

ON SURFACE - ~~BELOW~~ YES

~~LEFT - & PAV'T. - RIGHT~~ YES

11.9 TO RT EDGE PAVEMENT


S.L.M. 960+04

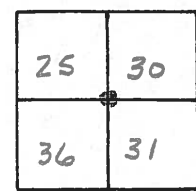

Fd. RR. SPK IN CENTER
OF 24' CONC. PVMT.
SEC. COF. - TWPLINE

SET PK & WASHER
10-26-92
MB

Fd. RR. SPK 4" DEEP
5-30-86

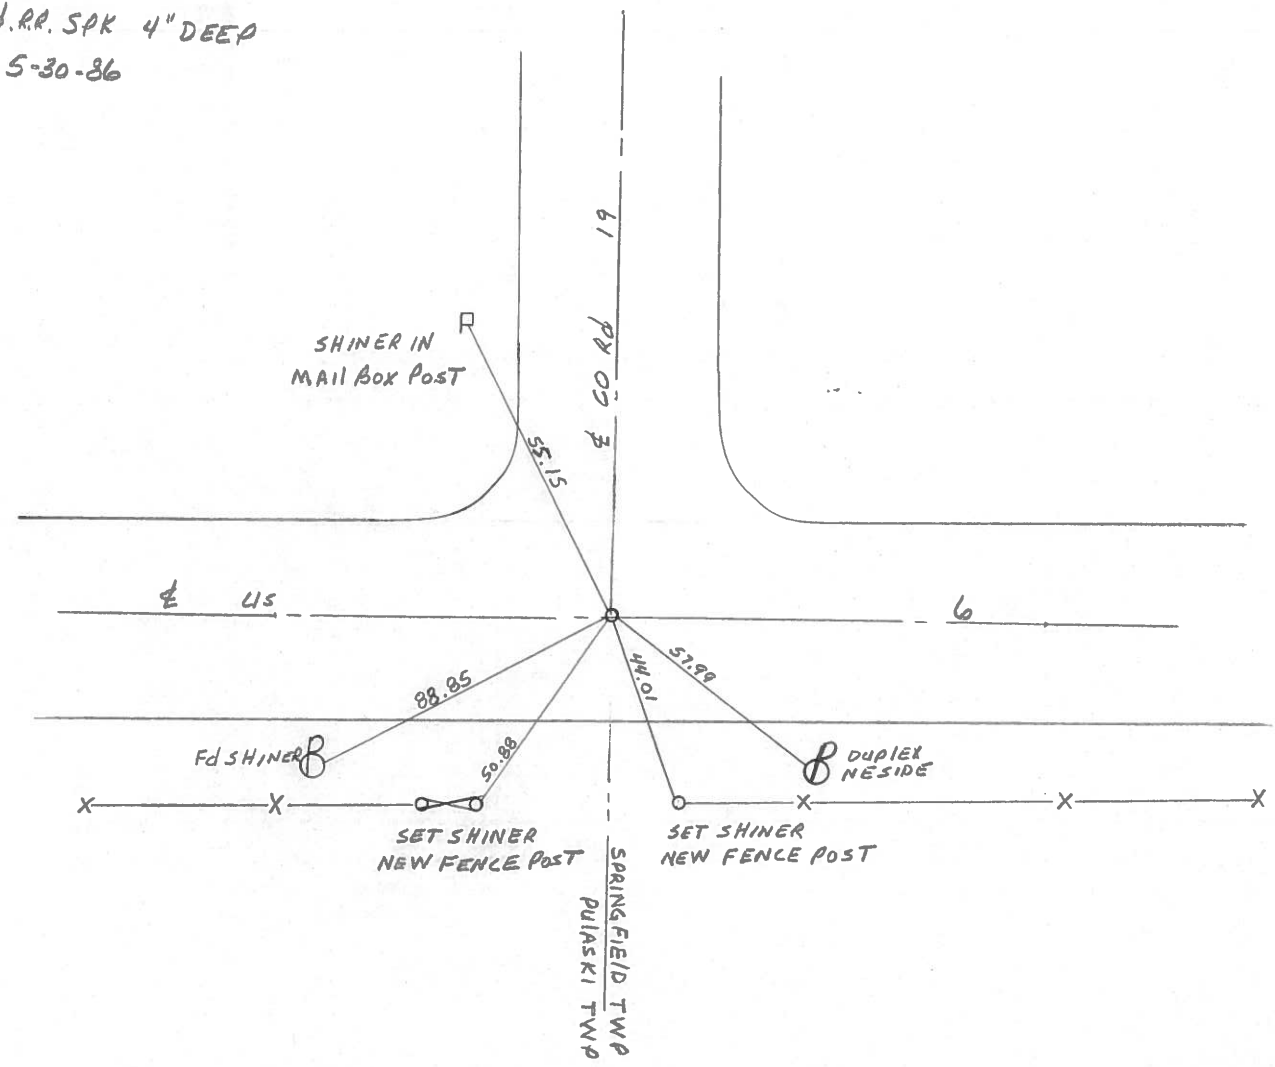

OD.O.T. DISTRICT 2 SURVEY OFFICE

SHEET 17 OF

County Williams S.R. #6

Township Pulaski

Section 36

T N, R E

Personnel I. Stone

P. Nouseur

R. Michalak

J. Curtis

Date 9 May 84


Weather Cloudy

Temp. 44°

25	30
36	31



REF. NO. 20

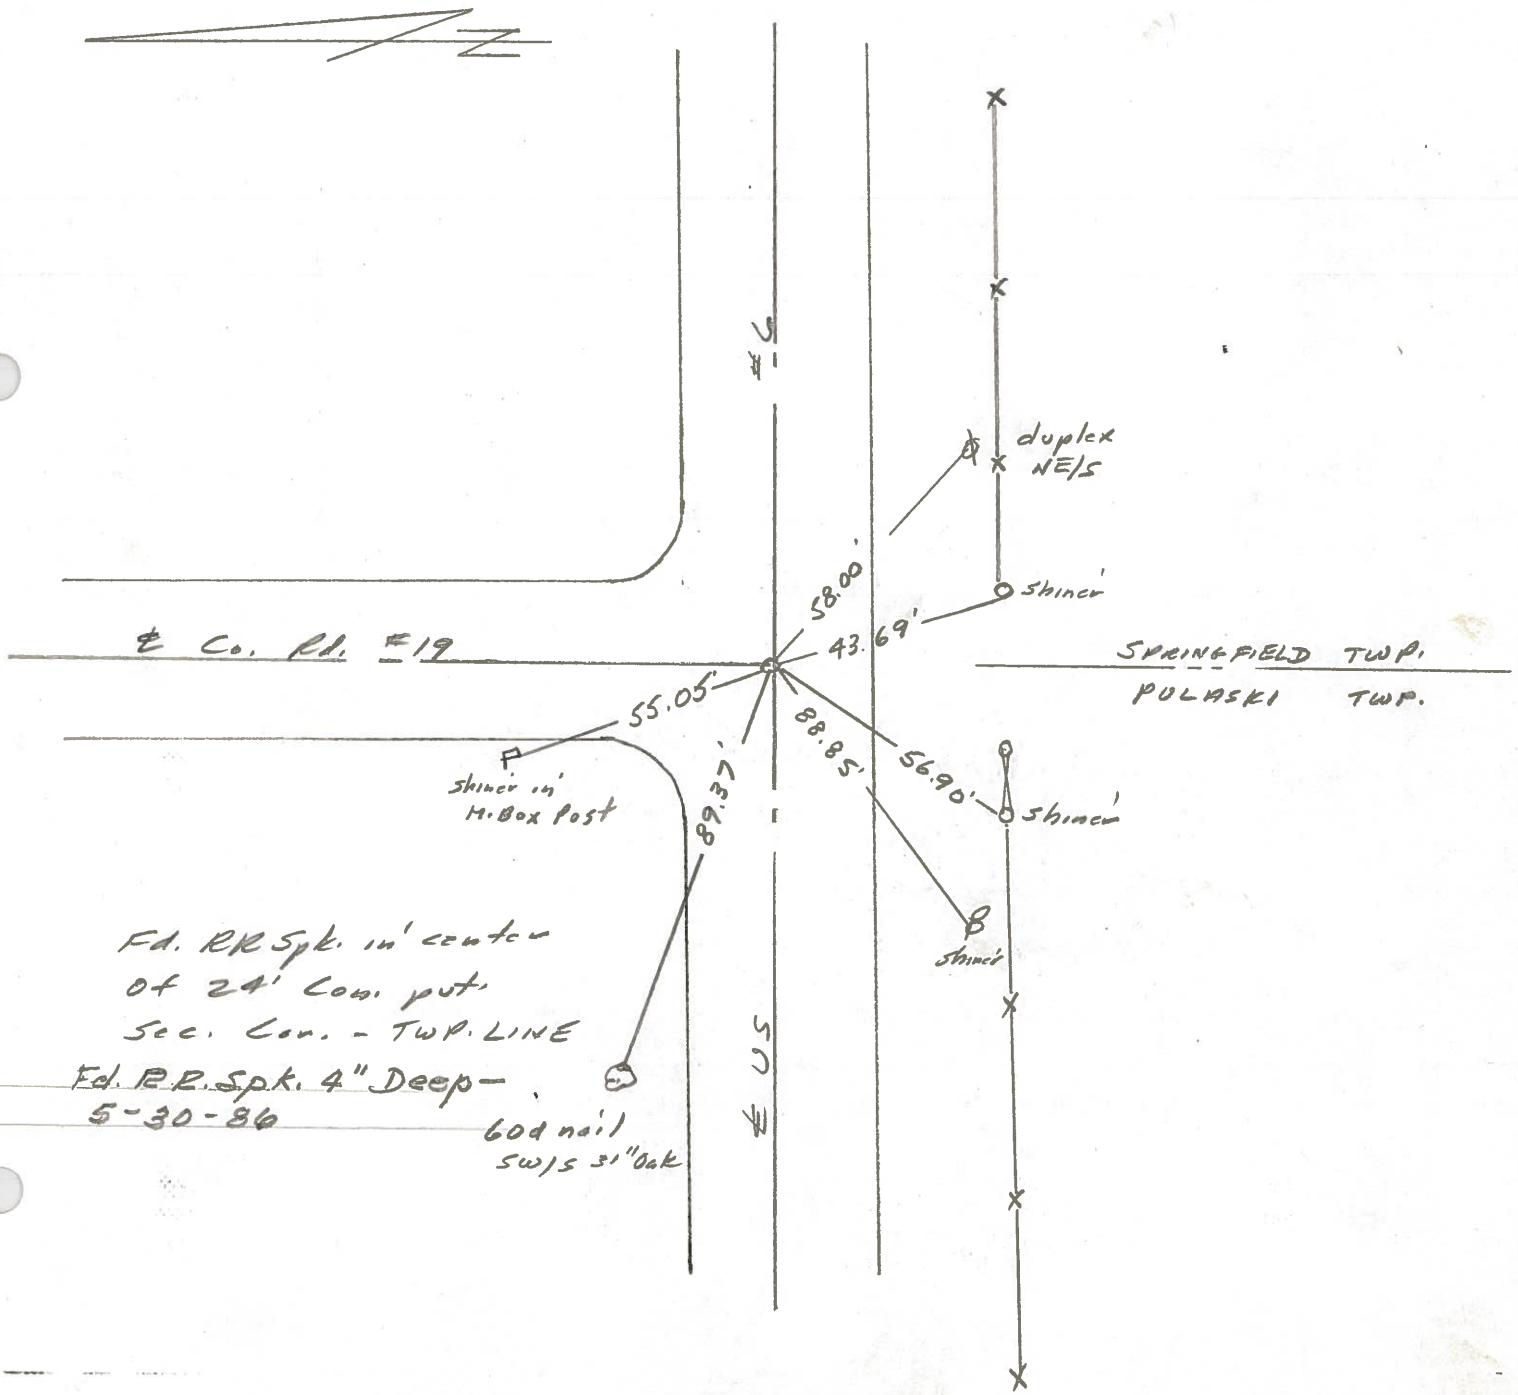

PERSONNEL TITLE PERSONNEL TITLE

Red Beach
W. Knape



COUNTY Williams DATE Nov 1975

S. R. US 6 WEATHER

SEC. Springfield Twp. TEMP

DESCRIPTION control points

JOB NO.

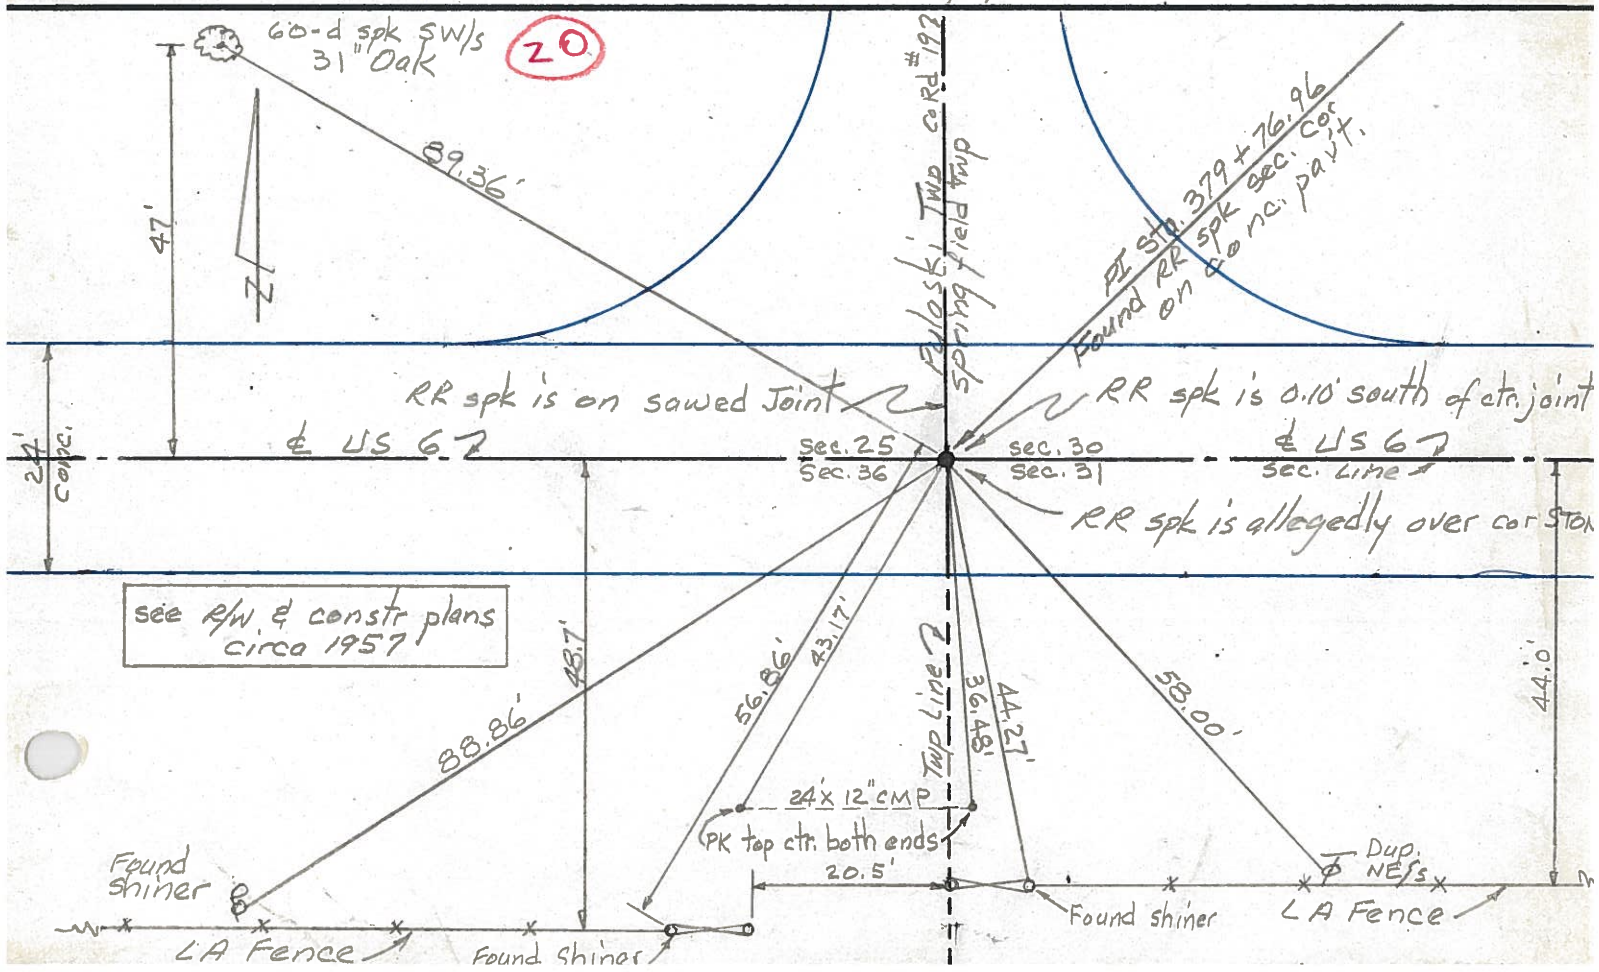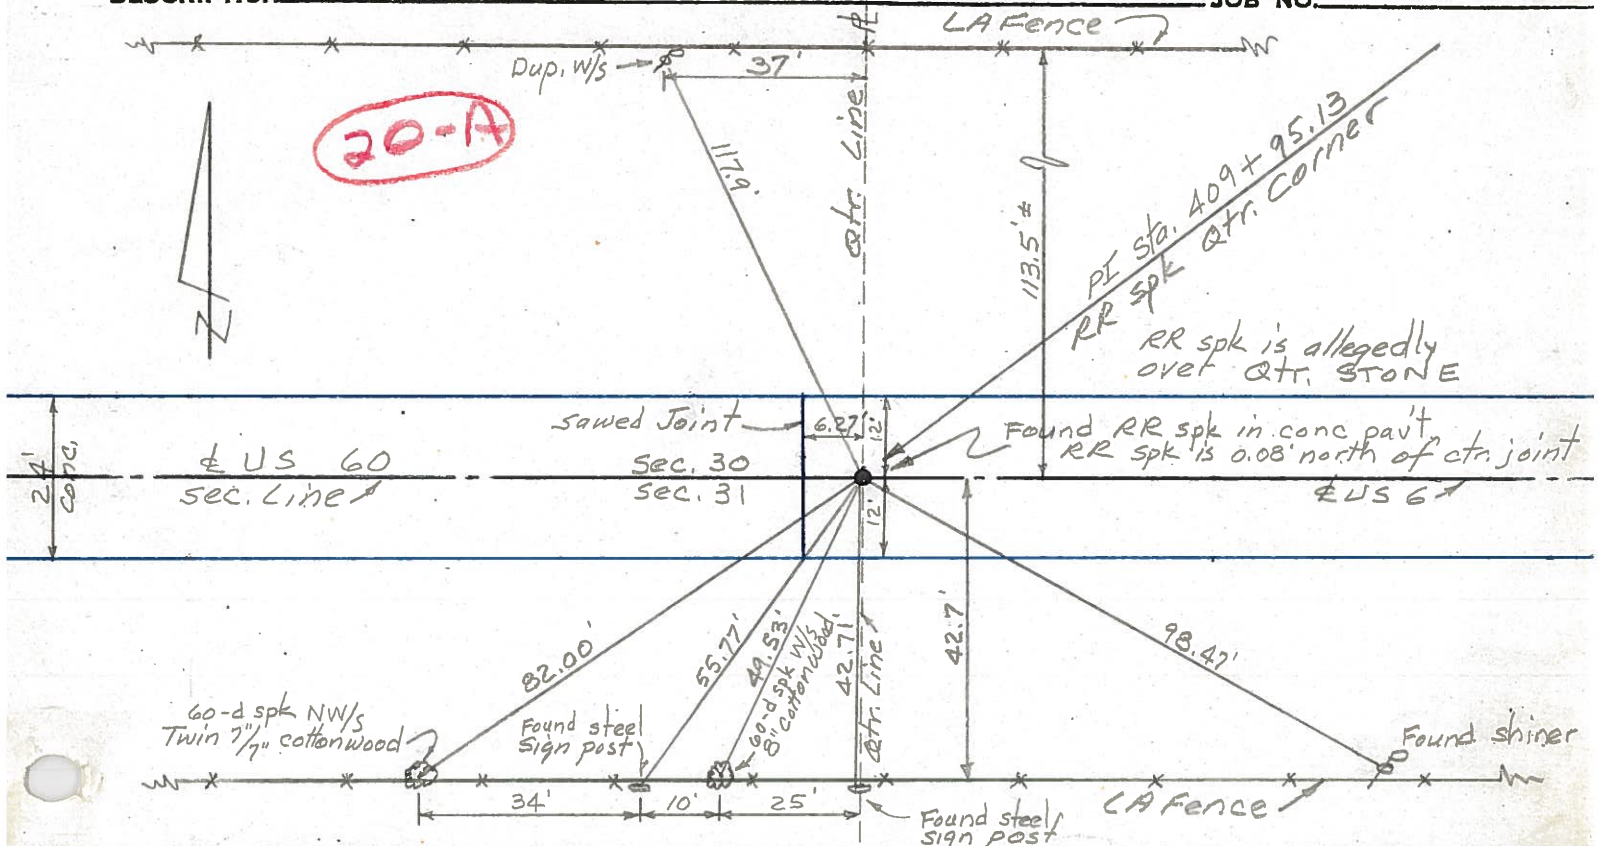


PERSONNEL	TITLE	PERSONNEL	TITLE	COUNTY	DATE	WEATHER	TEMP.
Hoover		Young		Williams	12-8-60	Ptly. Cloudy	30°
Ruffer		Mohler		S. R. <u>6</u>			
Hoff				SEC.			
Delventhal							

DESCRIPTION	LEFT	CENTER LINE	RIGHT	JOB NO.
-------------	------	-------------	-------	---------


127.

(20)

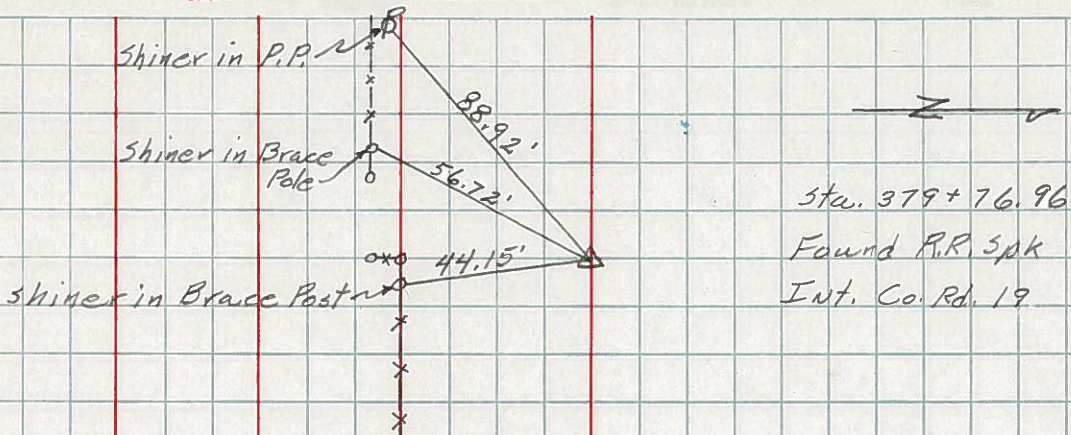


136.

(22)

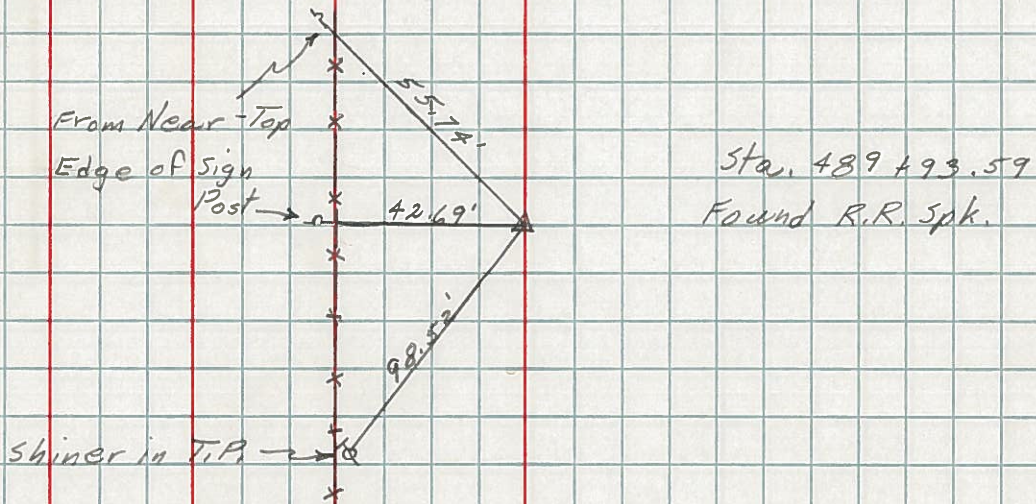


131.

(20-B)

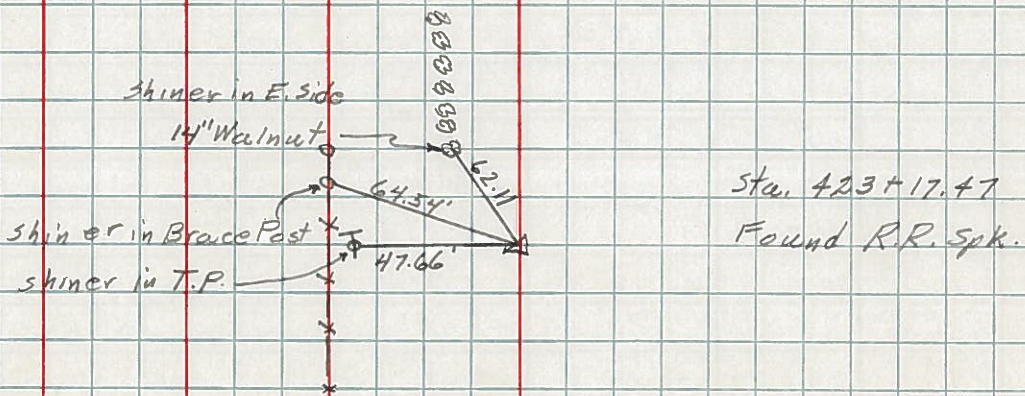

PERSONNEL TITLE PERSONNEL TITLE COUNTY Wi. DATE 2-28-58
 Louys _____ S. R. 6 WEATHER _____
 _____ SEC. Relocation over Rt. #384 TEMP. 40°
 DESCRIPTION Witnesses to Control Points JOB NO. _____

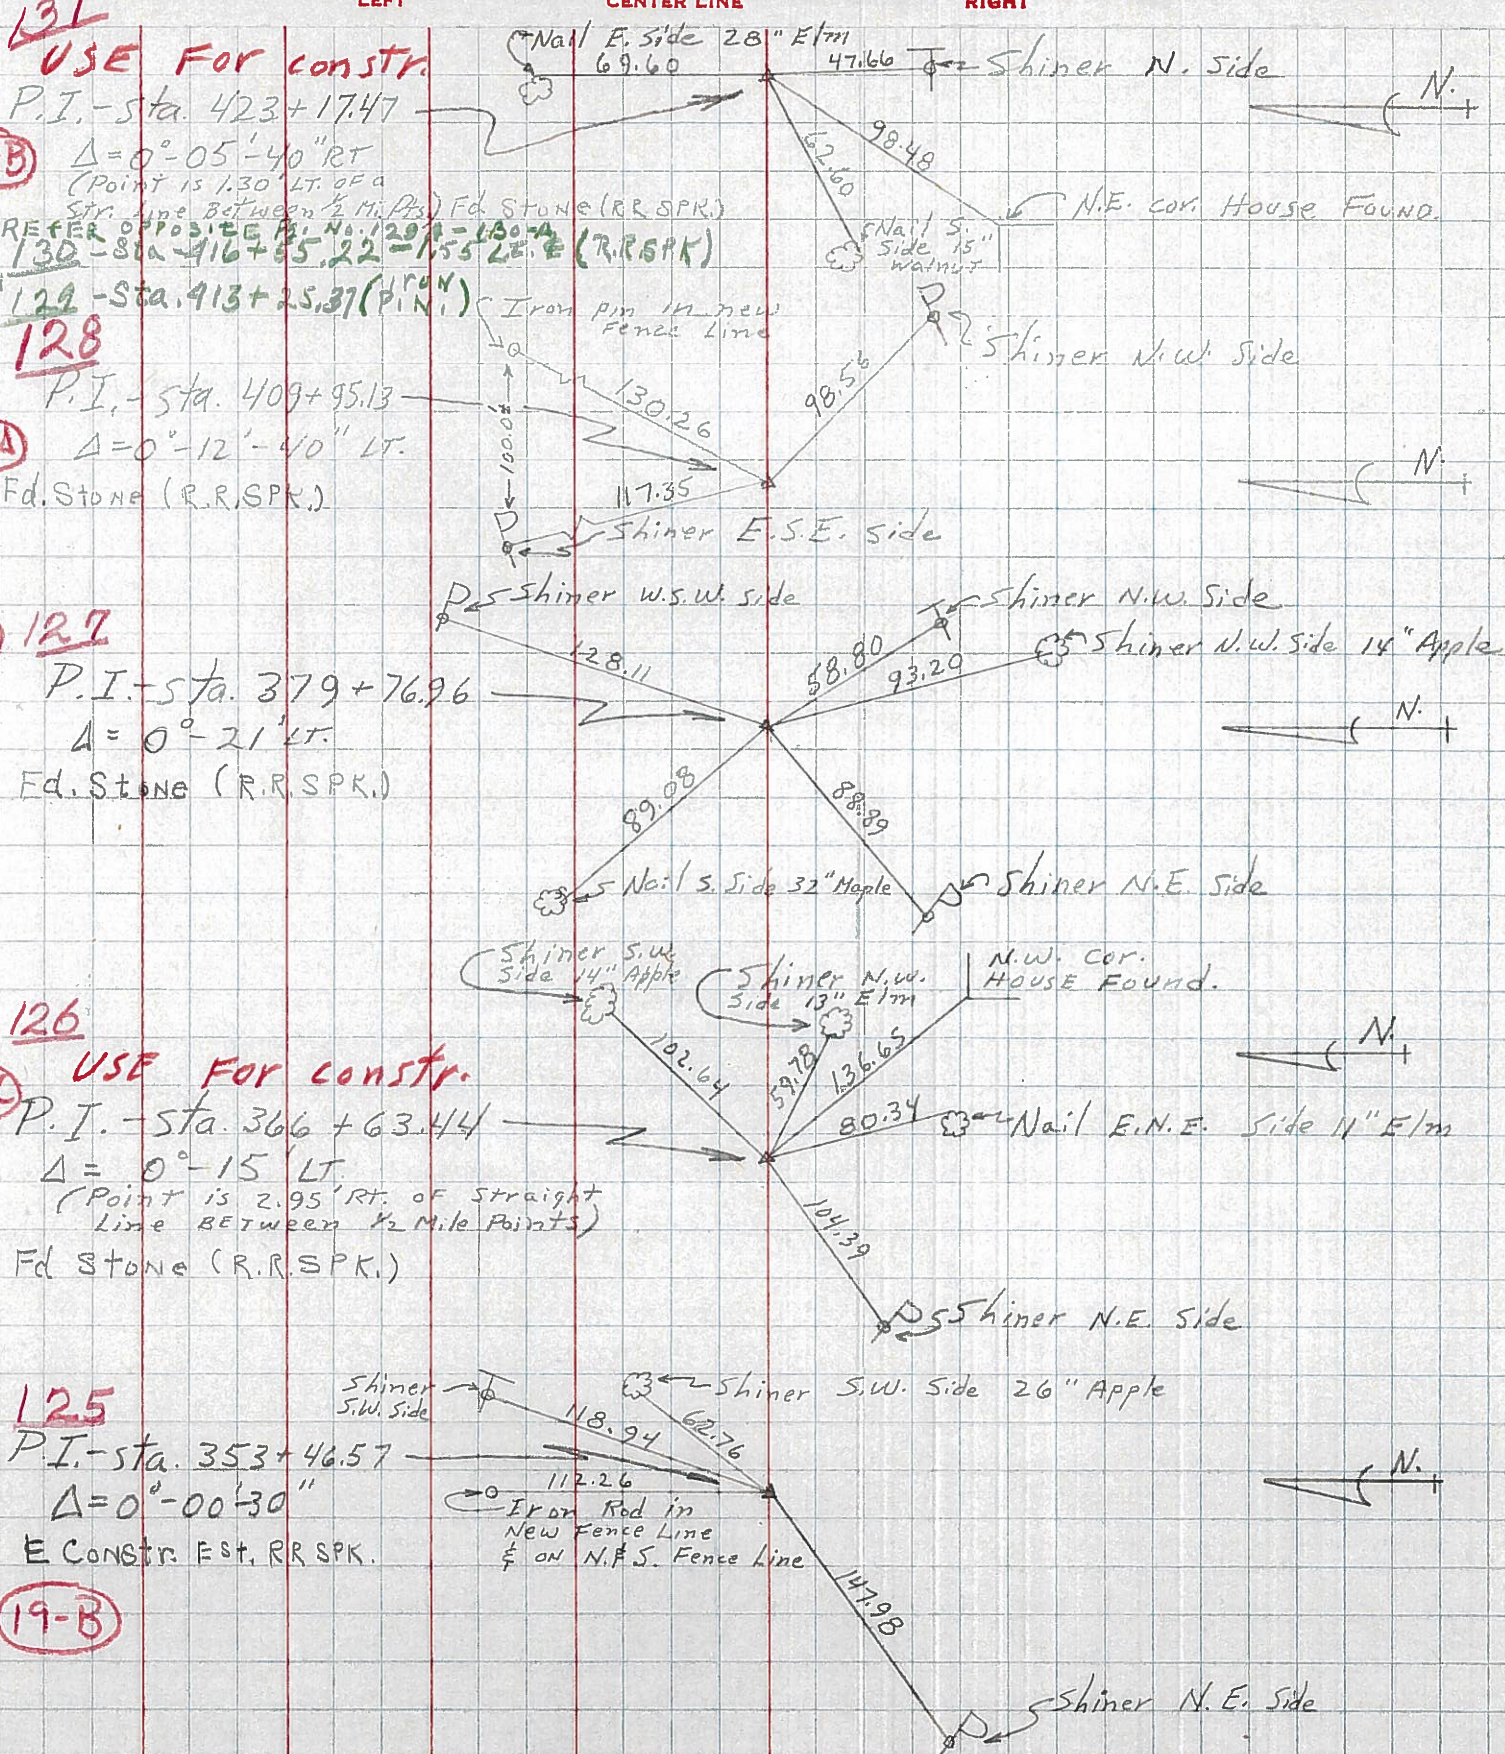

131

20-B

20-A

20

19-C

19-B

USE FOR CONSTR.

P.I. - Sta. 423+17.47
 Δ = 0°-05'-40" RT
 (Point is 130' LT. OF a
 Str. Line Between 1/2 Mile Points)
 Fd. Stone (R.R. SPK.)
 REFER OPPOSITE Pg. No. 129 - 130 - 131 - 132 - 999 - 1000

P.I. - Sta. 409+95.13

Δ = 0°-12'-40" LT.

Fd. Stone (R.R. SPK.)

P.I. - Sta. 379+76.96

Δ = 0°-21' LT.

Fd. Stone (R.R. SPK.)

USE FOR CONSTR.

P.I. - Sta. 366+63.44

Δ = 0°-15' LT.

(Point is 2.95' RT. OF STRAIGHT
Line BETWEEN 1/2 Mile Points)

Fd. Stone (R.R. SPK.)

P.I. - Sta. 353+46.57

Δ = 0°-00'-30"

E CONST. Est. RR SPK.