

O.D.O.T. DISTRICT 2 SURVEY OFFICE (USE ONLY)

PERSONNEL

REFERENCE NO. 12

SHEET 15 OF 40

NOTES NIESE
H.C. AUBLE
R.C. PARADYZ

DATE 4/28/22
WEATHER SUNNY
TEMP. 38°

ROUTE SR 15
COUNTY WILLIAMS
TOWNSHIP MADISON
SECTION 28

DWG BY BARRIERE PID NO PID

T 9 N R 2 W

TYPE MONUMENT MAG NAIL/WASHER

ON SURFACE - BELOW ON

OFFSET $\mathcal{C}$ PAVEMENT 1' RT LT : RT

TO EDGE PAVEMENT

STATION: 133+92.88

HORIZ.DATUM: NAD83 2011/WIL LDP


GEOID: 18

GRID: NORTHING: 734860.237


EASTING: 1407464.125

LDP: NORTHING: 388405.073

EASTING: 163088.774

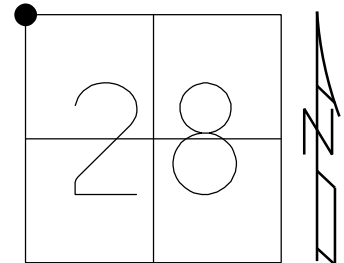

RECORD:
STA.136+32.7
 $\Delta = 0^\circ 16.1' \text{ LT}$
FD BOAT SPIKE
ATOP 3/4" IPIPE
ATOP BRASS R/W DISK
5/13/82, CL
ALL ANGLES MEASURED
FROM PERTINENT QTR.
POSTS BY RED BEACH, 1972
FD P.K./WASHER
5/13/82, CL
5/30/07, RGN
SET MAG/WASHER
8/29/07, RGN
FD MAG/WASHER
REF12
3/24/20, JLL
4/28/22
9/20/22, DSA
FD MAG/WASH
REF12
9/18/24, TDN

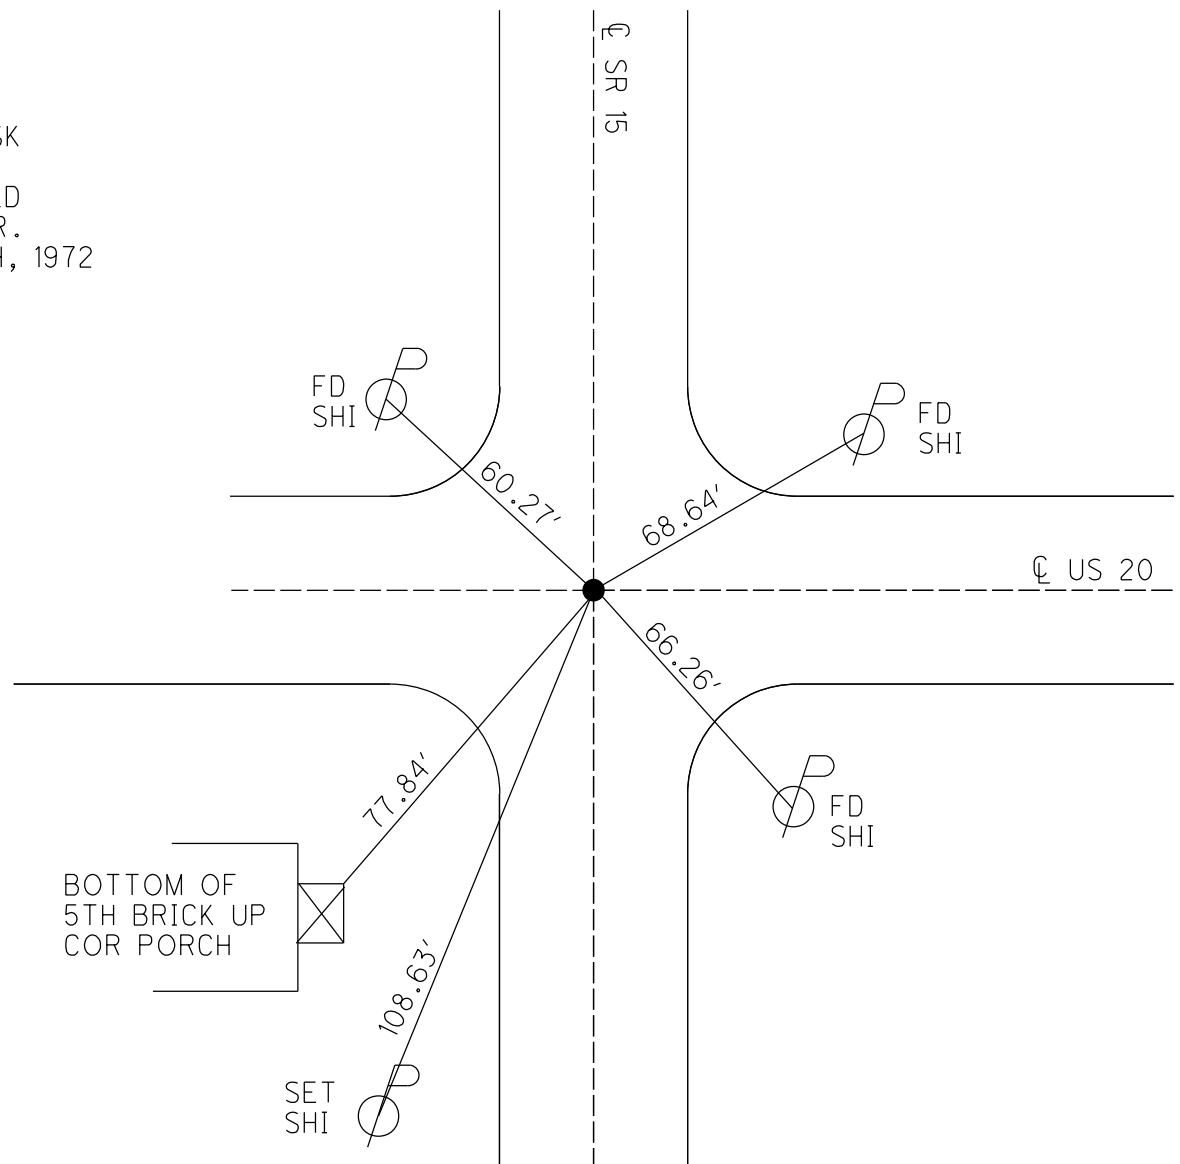


O.D.O.T. DISTRICT 2 SURVEY OFFICE (USE ONLY)

PERSONNEL _____ REFERENCE NO. 12 SHEET 15 OF 40
NOTES NIESE DATE 4/28/22 ROUTE SR 15
H.C. AUBLE WEATHER SUNNY COUNTY WILLIAMS
R.C. PARADYZ TEMP. 38° TOWNSHIP MADISON
DWG BY RHOADES PID 95786 SECTION 28
T 9 S R 2 W


TYPE MONUMENT MAG/WASHER
ON SURFACE - ~~BELOW~~ ON
OFFSET CL PAVEMENT 1' LT : RT
- TO - EDGE PAVEMENT
STATION: 133+92.88

HORZ.DATUM: NAD83 2011 GEOID: NAVD88 2012B
GRID: NORTHING: 734860.263 EASTING: 1407464.081

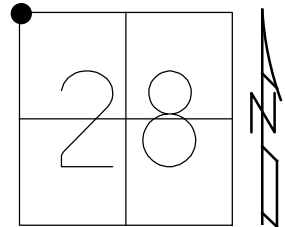

RECORD:
STA.136+32.7
 $\Delta = 0^\circ 16.1' \text{ LT}$
FD BOAT SPIKE
ATOP 3/4" IPIPE
ATOP BRASS R/W DISK
5/13/82, CL
ALL ANGLES MEASURED
FROM PERTINENT QTR.
POSTS BY RED BEACH, 1972
FD P.K./WASHER
5/13/82, CL
5/30/07, RGN
SET MAG/WASHER
8/29/07, RGN
FD MAG/WASHER
REF12
3/24/20, JLL
4/28/22
9/20/22, DSA


NOTE: REF 41 US 20

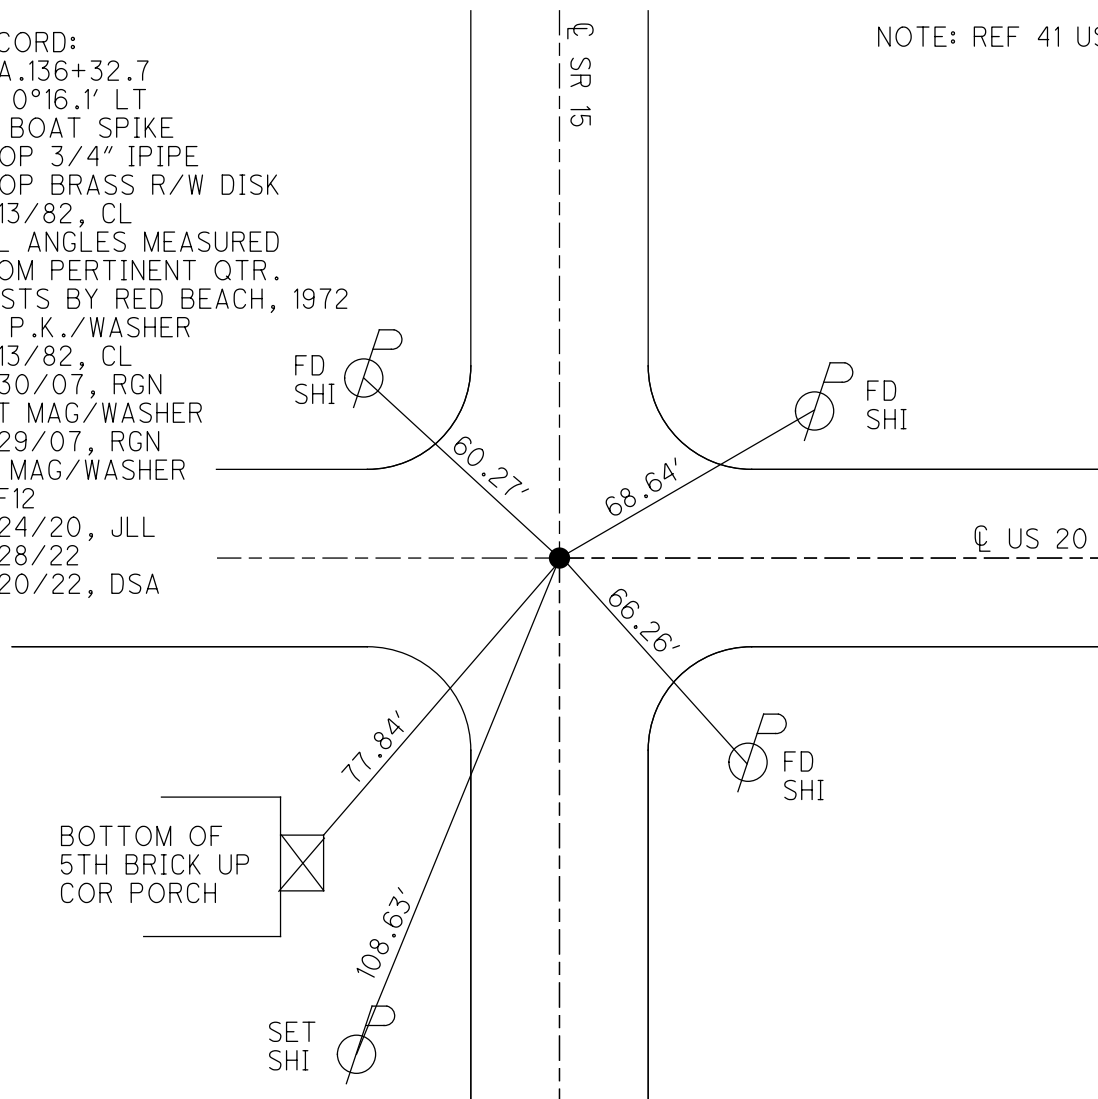

O.D.O.T. DISTRICT 2 SURVEY OFFICE (USE ONLY)

PERSONNEL _____ REFERENCE NO. 12 SHEET 14 OF 39
 NOTES NUHFER _____ DATE 5/30/07 ROUTE SR 15
 H.C. HUSS _____ WEATHER SUNNY COUNTY WILLIAMS
 R.C. HOUDSHELL _____ TEMP. 92° TOWNSHIP MADISON
 _____ SECTION 28
 _____ T 9 S R 2 W


TYPE MONUMENT P.K./WASHER
 ON SURFACE - ~~BELOW~~ ON _____
~~LEFT~~ - CL PAV'T - RIGHT 1' WEST
 - TO - EDGE PAVEMENT
 S.L.M. 134+00

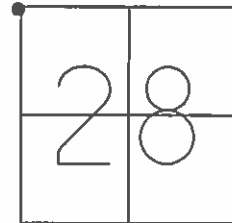

GRID: NORTHING: 734860.287 EASTING: 1407464.101


FD PK/WASHER
 5/13/82, CL
 SET MAG/WASHER
 8-29-07 RGN

NOTE: SR 15
 $\Delta = 0^{\circ}16.1' \text{ LT}$
 FD BOAT SPIKE
 ATOP 3/4" IPIPE
 ATOP BRASS R/W DISK
 5/13/82, CL
 ALL ANGLES MEASURED
 FROM PERTINENT QTR.
 POSTS BY RED BEACH, 1972

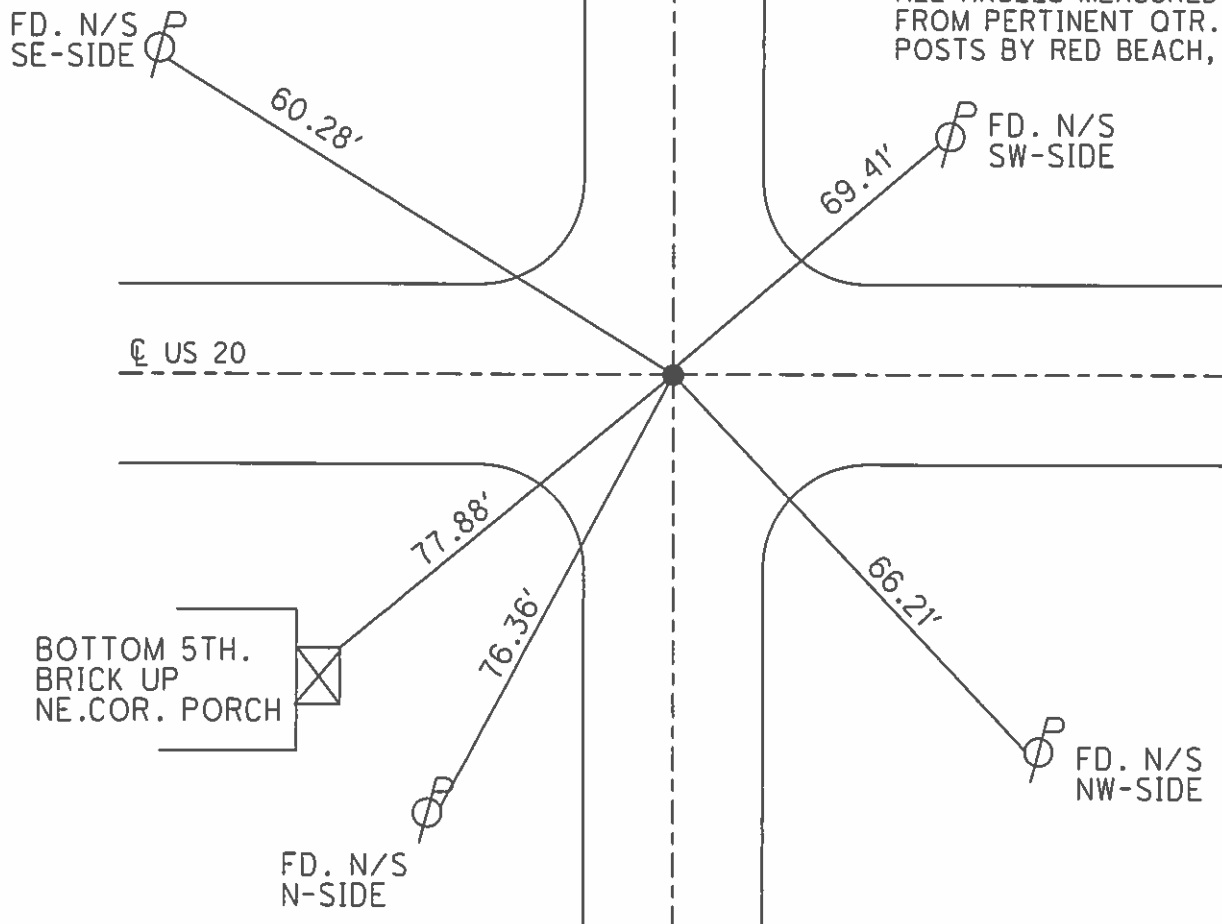

County WILLIAMS S.R. 15Township MADISONSection N.W. COR. SEC. 28

T9S, R2E

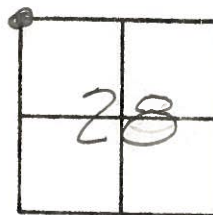
Personnel HOFFMANLOERKEHOUSEHOLDERDate 5-13-82Weather CLEARTemp. +75

38 (12)

A = S.R. 15 = 0°-16.1' LT.

FD. BOAT SPK. @ SURFACE
IN CTR. PAVEMENTS.SAID SPK. SET ON TOP
3/4" I. PIPE, OVER BRASS
P/W DISC.ALL ANGLES MEA. FROM
PERTINENT QTR. POSTS.
BY RED BEACH 1972

S.L.M. ± 133+95

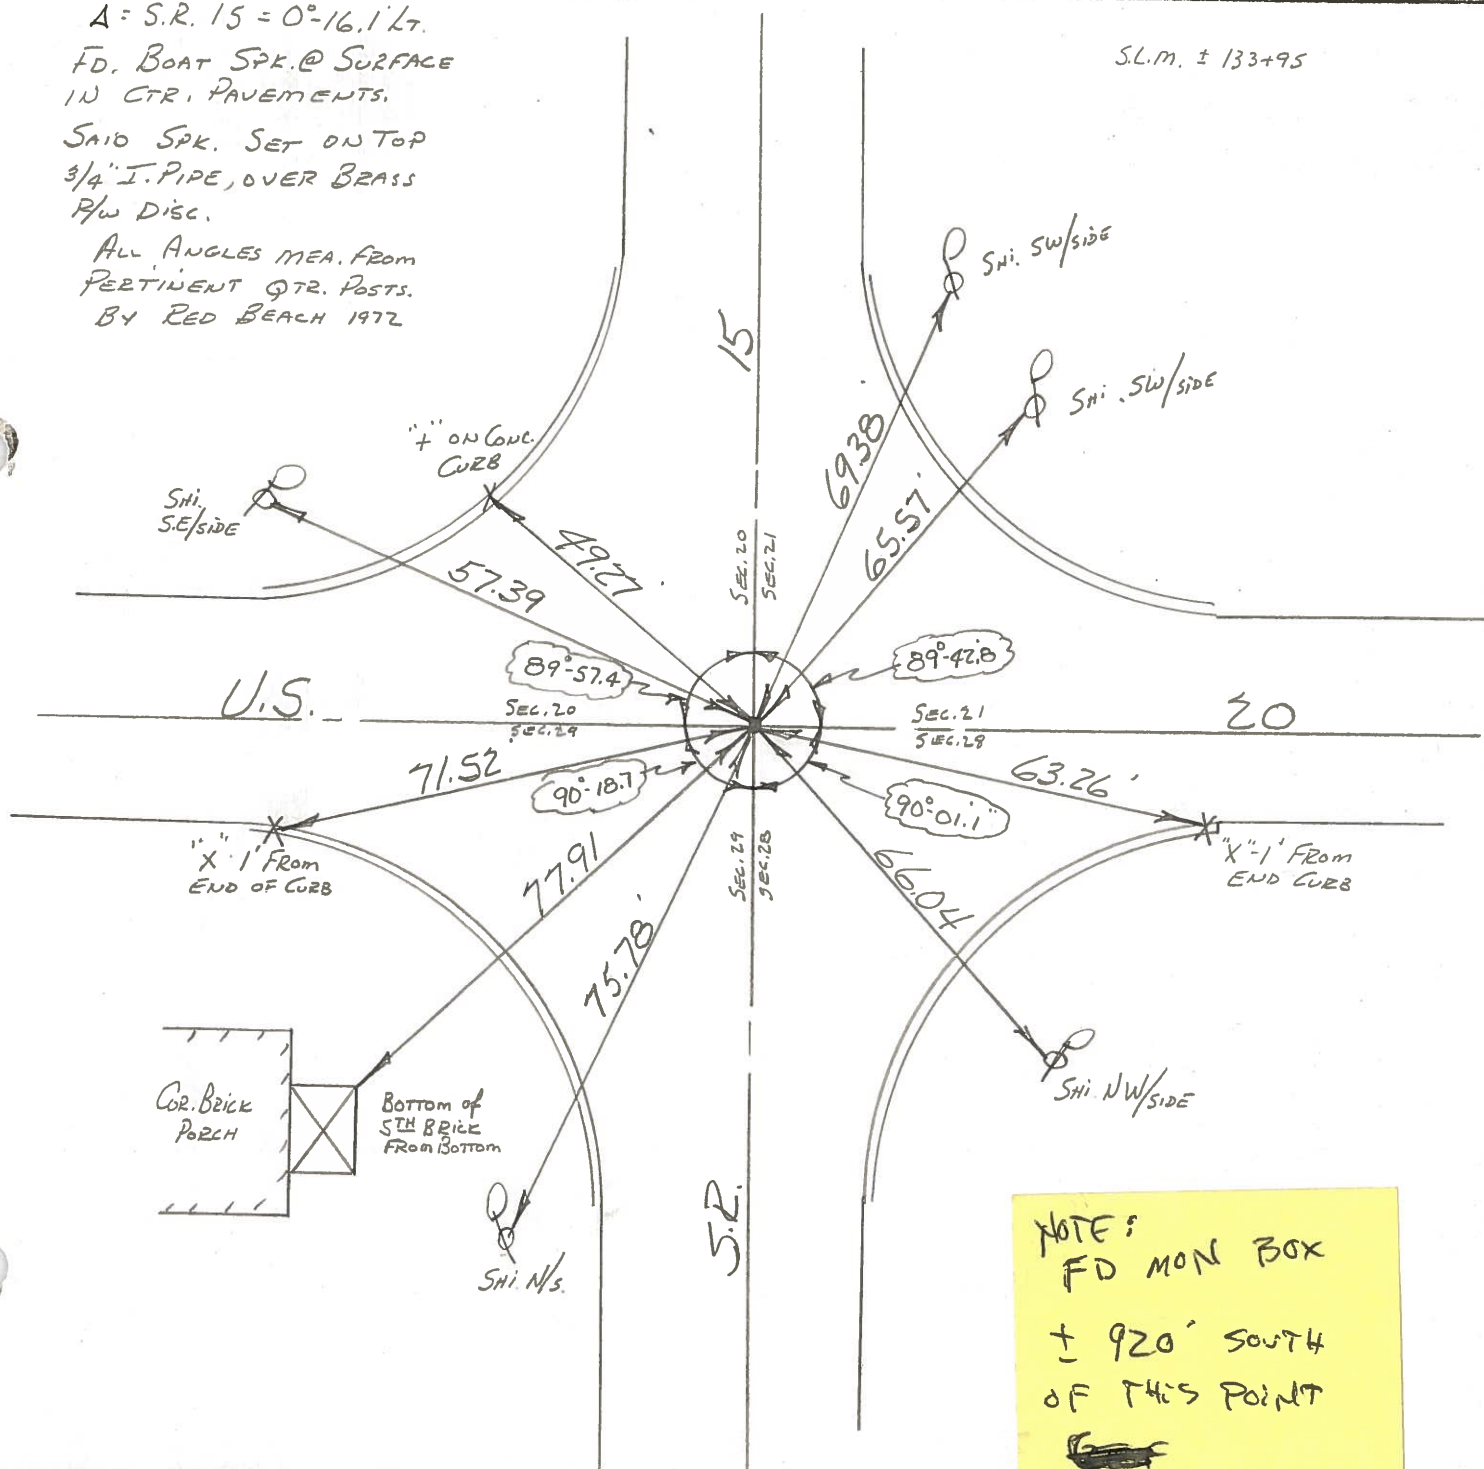

Q.D.O.T. DISTRICT 2 SURVEY OFFICE

Sht. 29 of 35

County Williams S.R. 15

Township MADISON

Section N.W. COR. SEC. 28

T9S, R2E✓

Personnel BURNSIDE


SMITH

MEAD

Date 11-29-79 5-1382

Weather Cloudy LT. Snow clear

Temp. +30° +75°

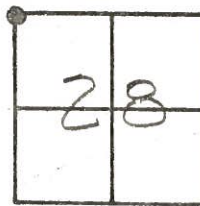

$$\Delta - S.P. 15 = 0^{\circ} - 16.1' LT.$$

FD. BOAT STR @ SURFACE
IN CTIP. PAVEMENTS.

SAID BOAT SPK. SET ON TOP
OF 3/4" I. PIPE OVER BRASS
P/W DISC.

ALL ANGLES MEAS. FROM
PERTINENT QTR. POSTS
BY RED BEACH

1972

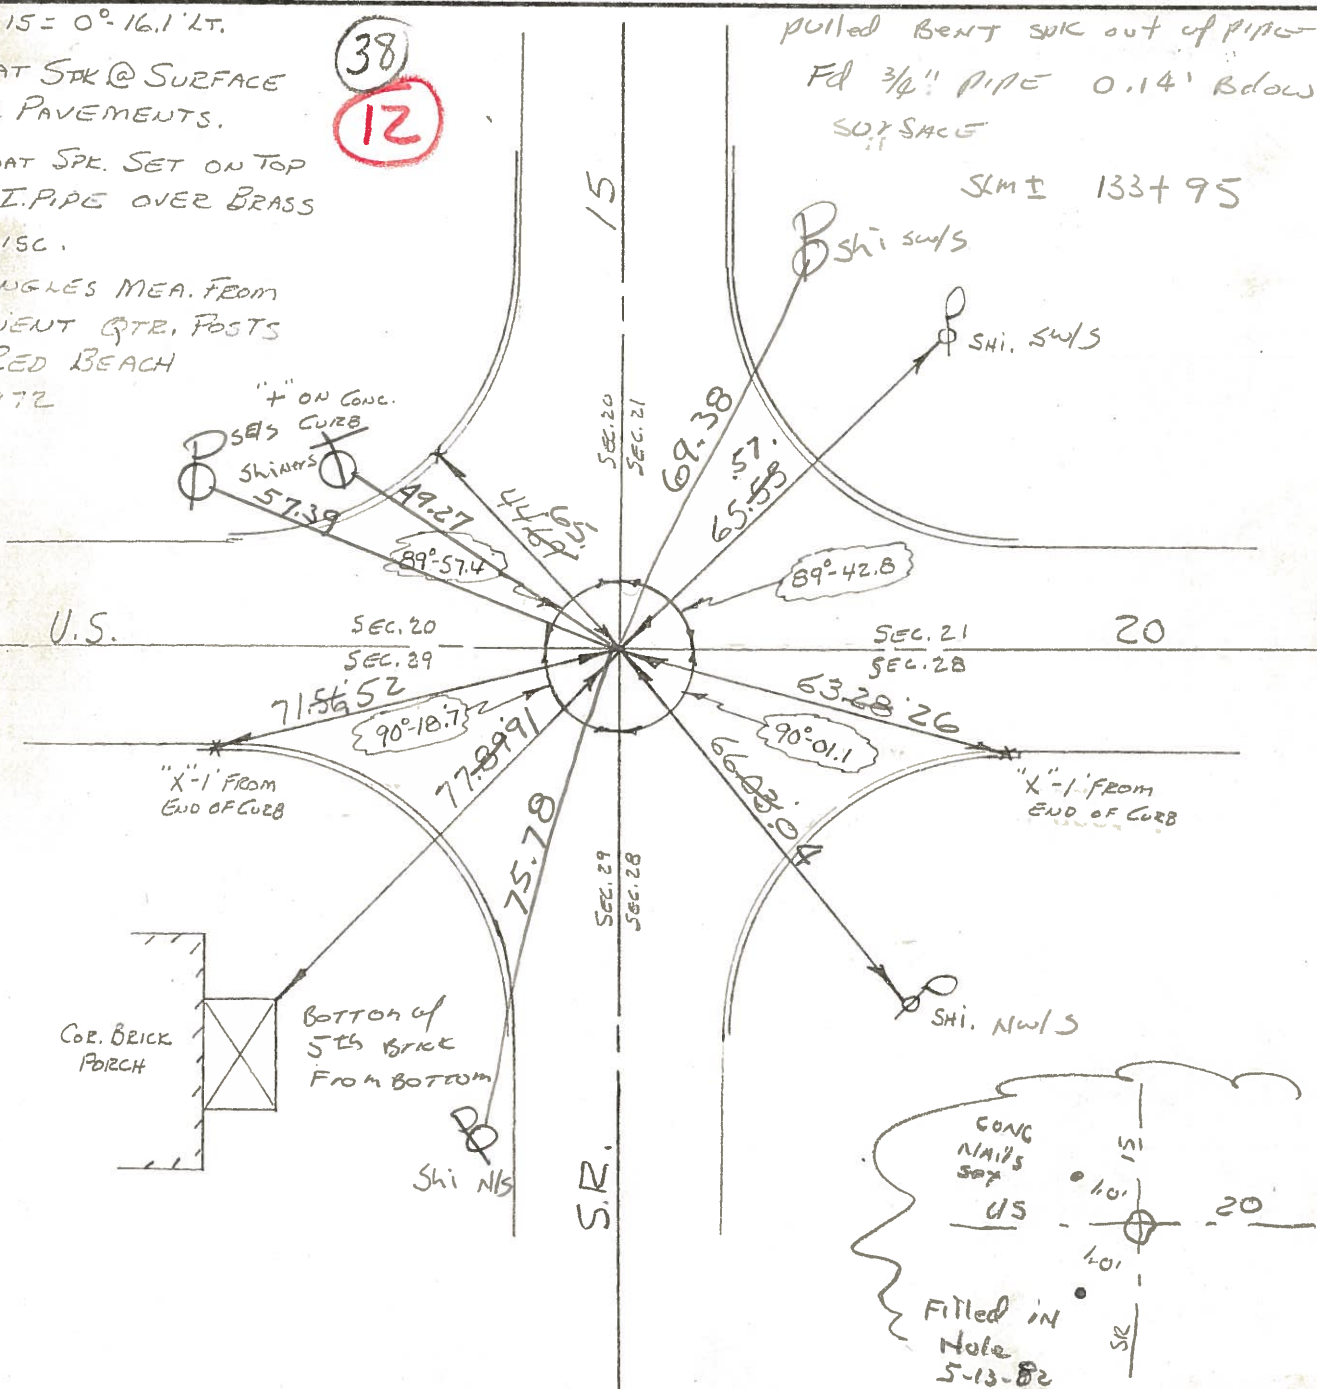

Sht. 29 of 35

Date 11-29-79

Weather Cloudy Lt. Snow

Temp. + 30°

2	8


NA

MEAD

~~38~~ 12

SAID BOAT SPL. SET ON TOP
OF 3/4" I.P. PIPE OVER BRASS
R/W DISC.

ALL ANGLES MEA. FROM
PERTINENT QTR. POSTS
BY RED BEACH
1972


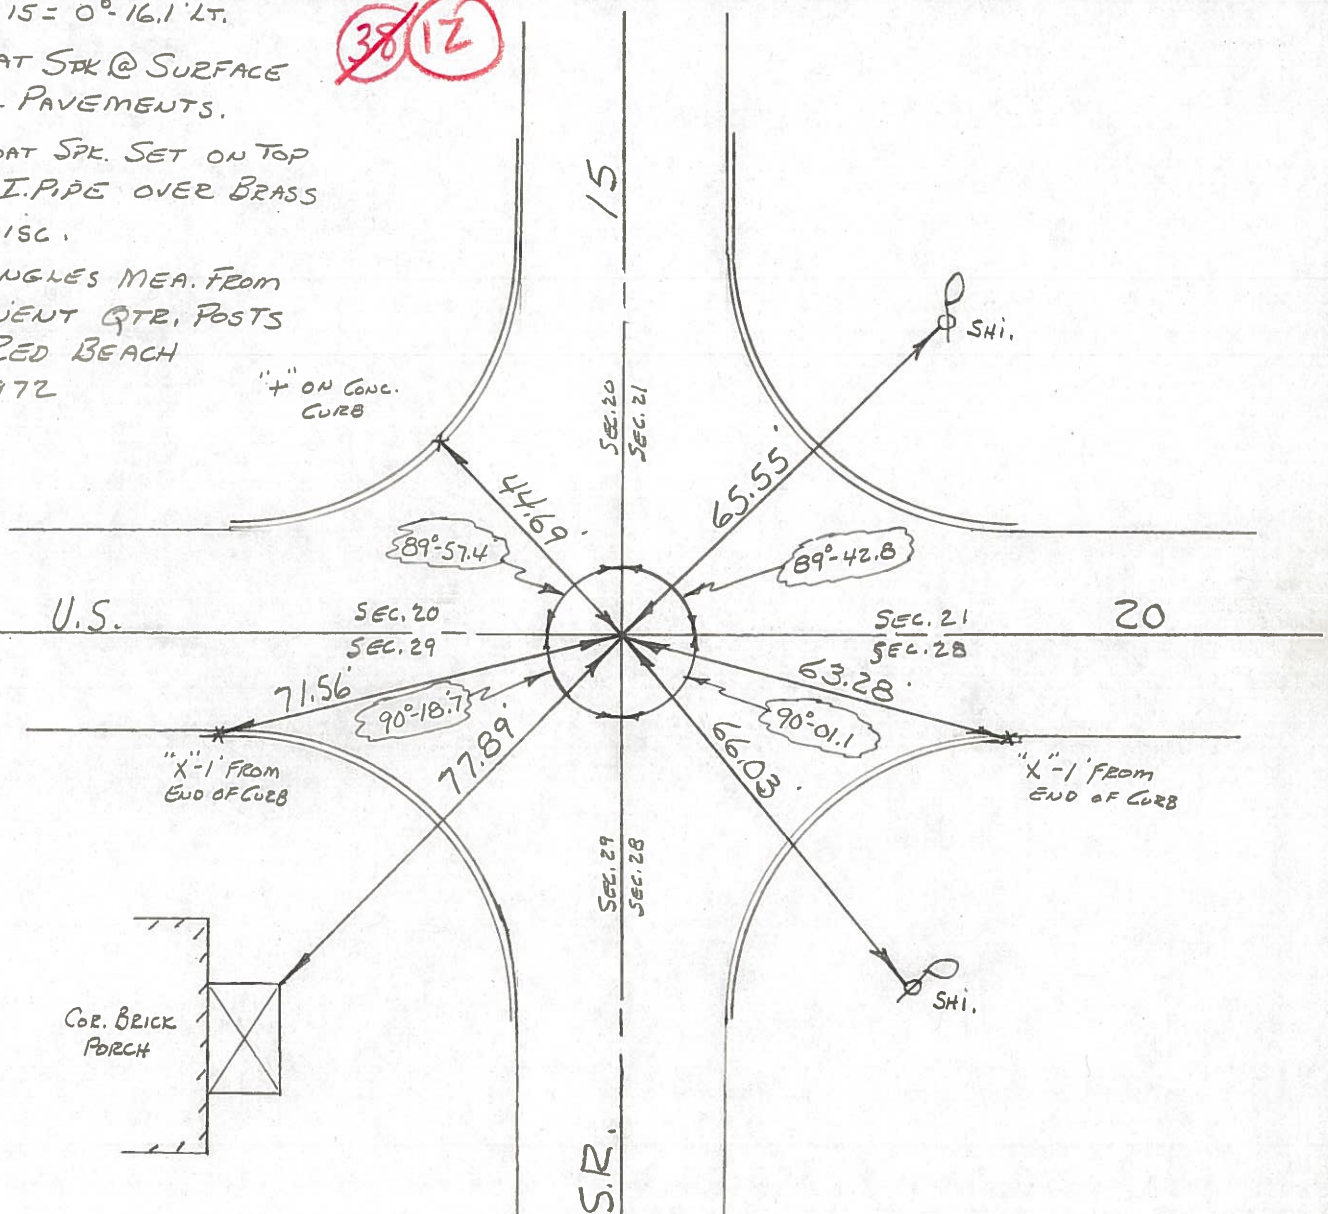


COUNTY Williams DATE Nov 72

S. R. US 20 WEATHER

SEC. Madison Twp. TEMP

DESCRIPTION	CONTROL POINTS	JOB NO

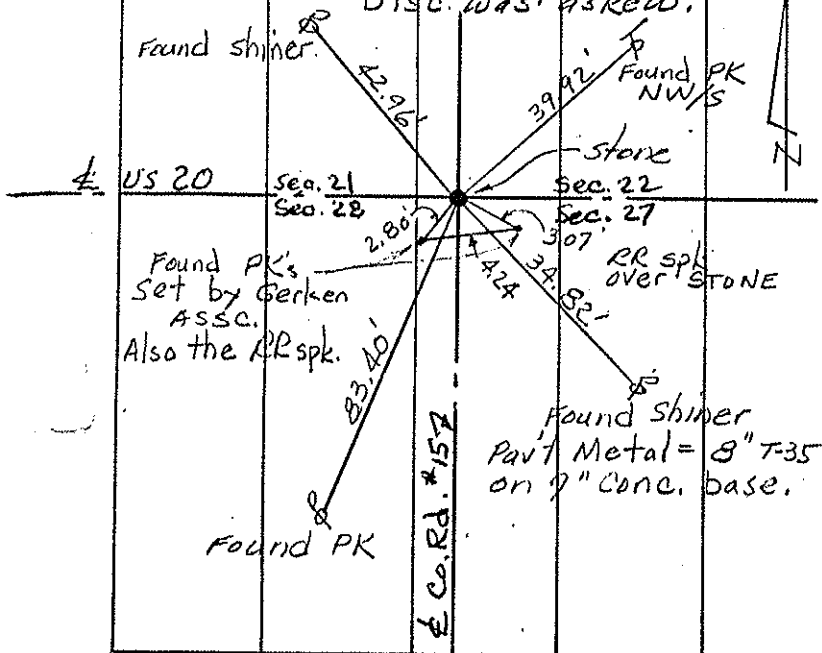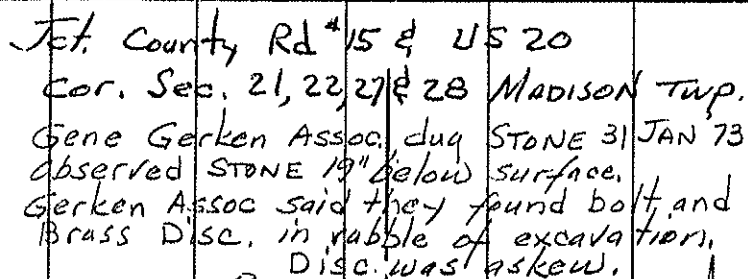


COUNTY Williams DATE Oct. 1972

S. R. 15 WEATHER

SEC. Madison Twp. TEMP. _____


DESCRIPTION	CONTROL POINTS	JOB NO.

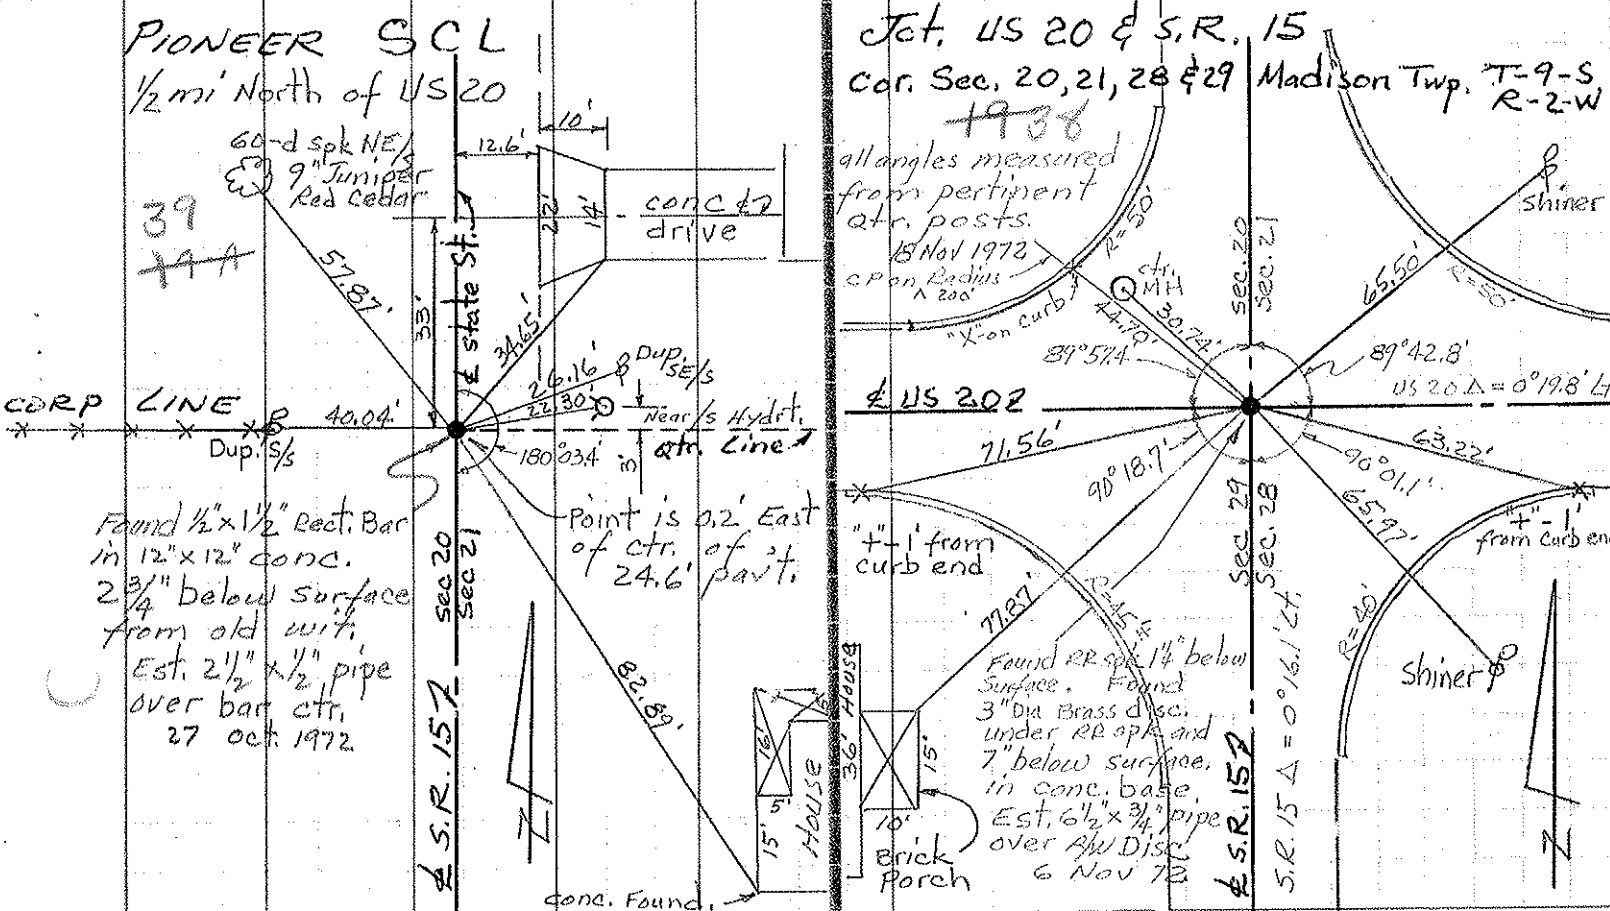

(4)

W11-15
W11-20

(12)

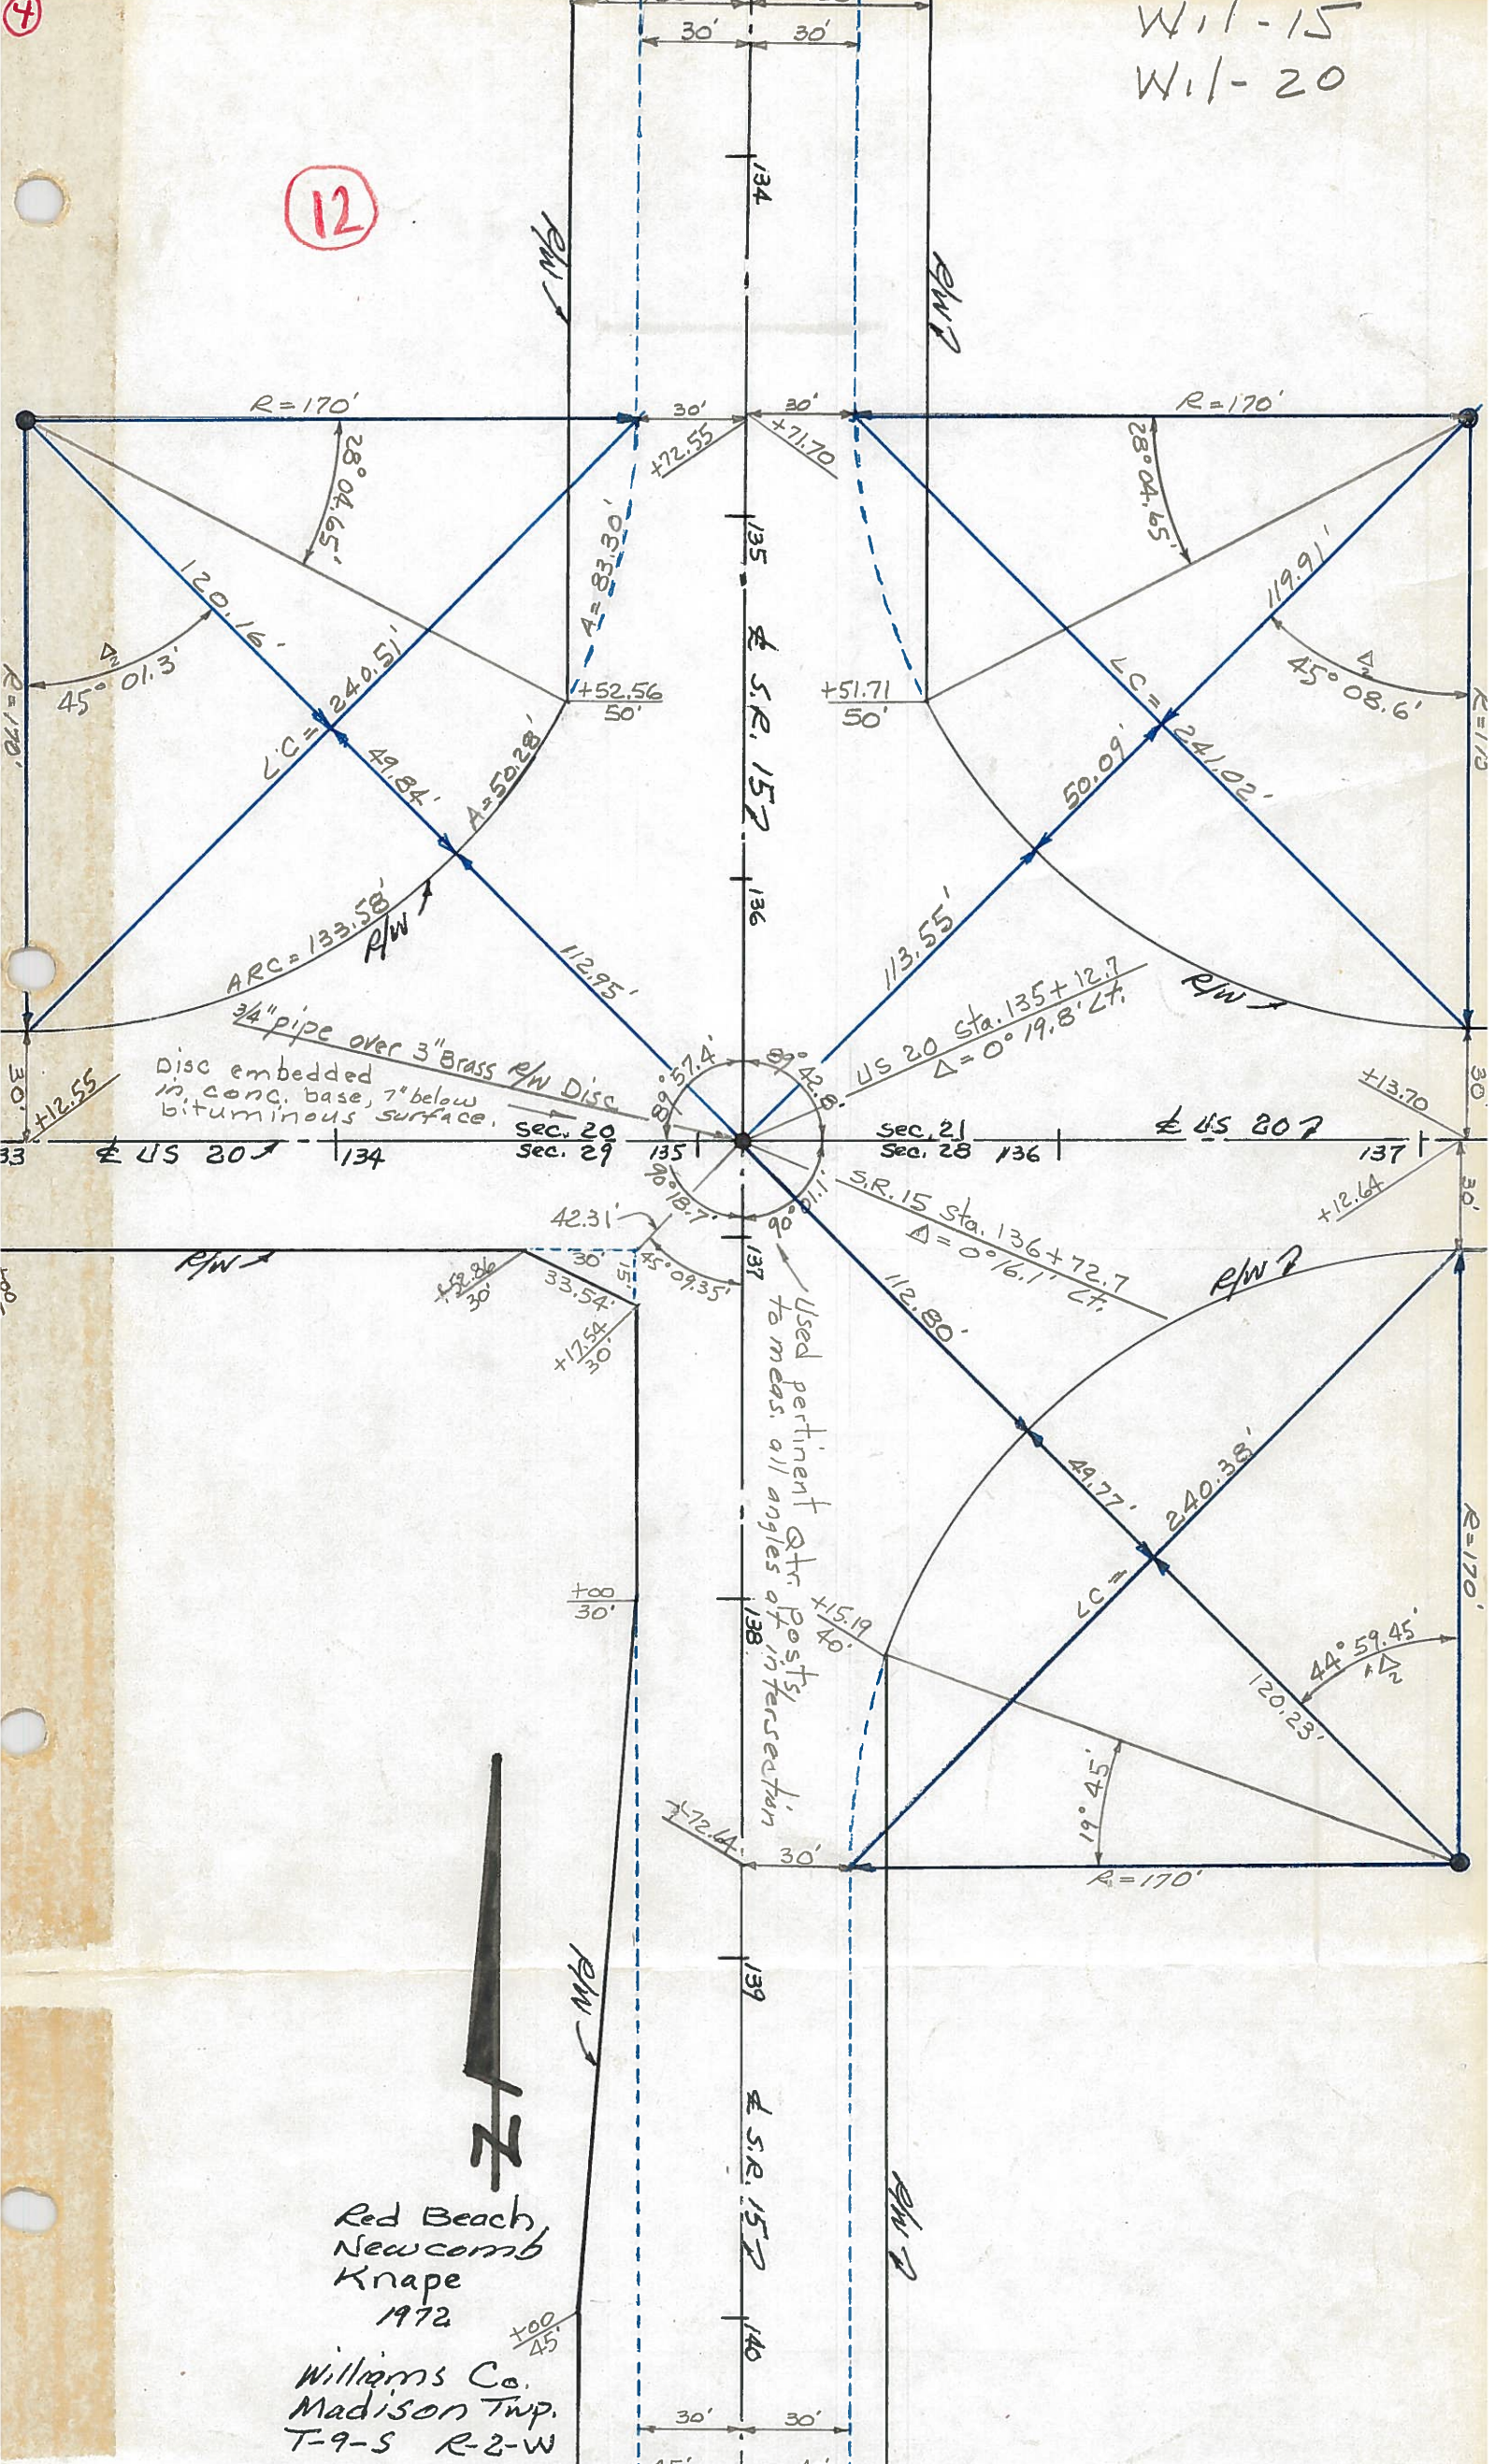

PERSONNEL	TITLE	PERSONNEL	TITLE	COUNTY	DATE	WEATHER	TEMP.
Louys				Wi.	7-22-58	Cloudy	75°
Persefall							
Wise				S. R. 15			
Krohn				From Mich LINE			
				SEC TO U.S. Rt. # 20			


DESCRIPTION Re-check of witnesses

LEFT CENTER LINE RIGHT JOB NO. _____

217 (12)
 P.I. Sta 136+72.7 =
 Int. X'N. U.S. Rt. 20
 & Ohio S.R. #15

For REFERENCES see P.15 sect.
 From Rt. 20 to Bryan
 N. Corp. LINE.

216 (11)
 P.I. Sta 140+18.16
 P.K. Nail
 Pioneer S. Corp. Lim
 $\Delta = 0^{\circ} 02' 30''$ RT

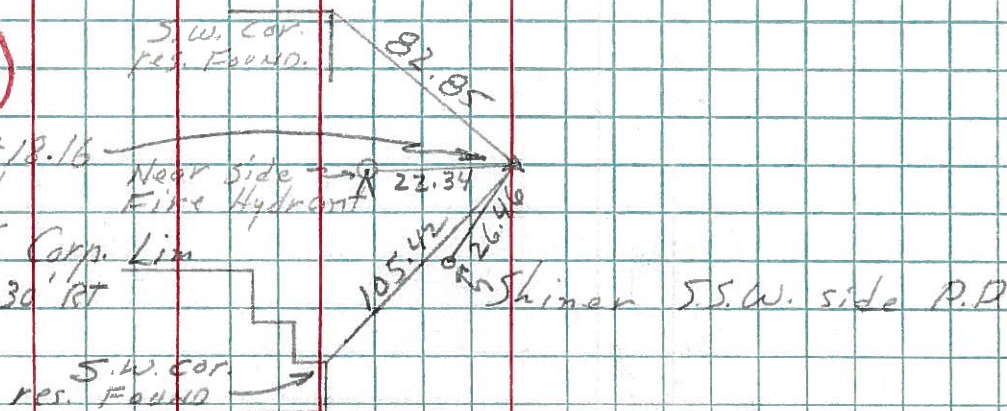

PERSONNEL TITLE PERSONNEL TITLE

COUNTY WiDATE 7-22-58LouysPessetallWiseKrohnS. R. 15WEATHER Cloudy

From Rt. #20 to

SEC. Bryan N. Corp. LineTEMP. 75°

DESCRIPTION


Re-check of witnesses.

JOB NO.

LEFT

CENTER LINE

RIGHT

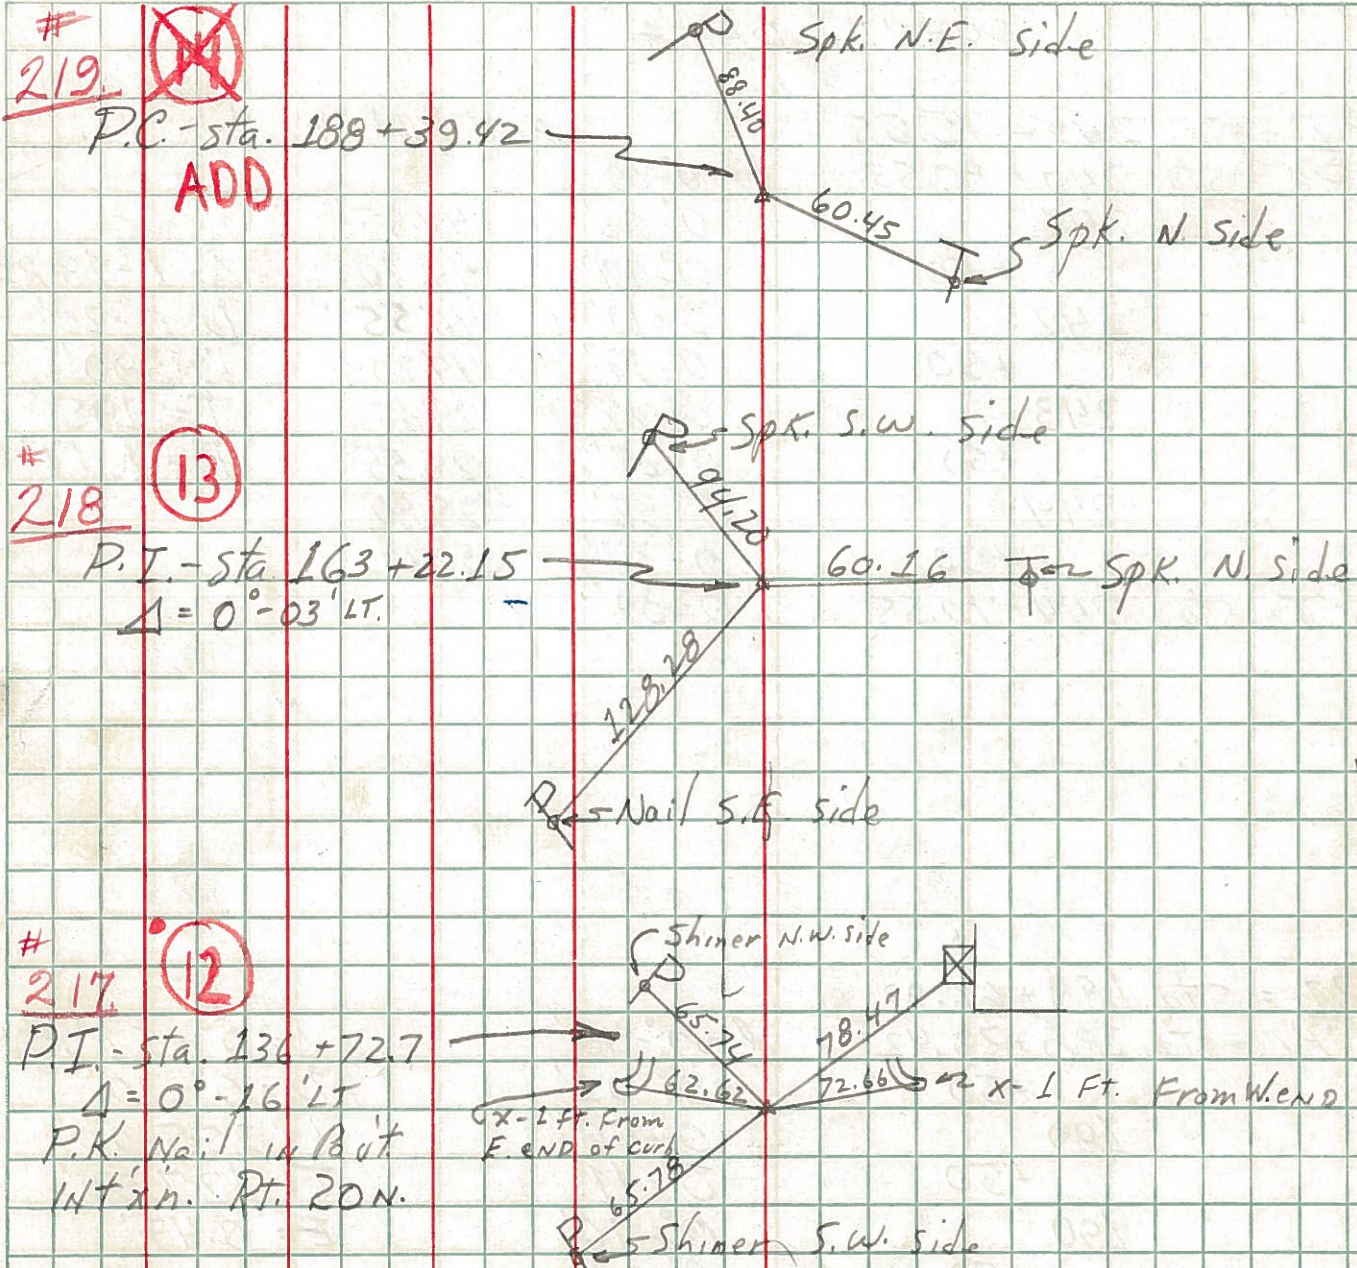

PERSONNEL TITLE PERSONNEL TITLE

COUNTY W.I.

DATE _____

S. R. 15

WEATHER _____

SEC. _____

TEMP. _____

DESCRIPTION Witnesses to Control Points

JOB NO. _____

LEFT

CENTER LINE

RIGHT

Sta 163+22.15 (R.R. Spk) ^{see survey dated 1953} NE. cor. Porch Found.

Sta 136+72.7 (Insect Rt #20)

Found P.K. Nail

⑫

$\Delta = 0^{\circ} 14' \text{ Lt.}$

Shiner S.W. side T.P. Shiner S.E. side T.P.

S.W. Cor. House Found.

⑪

Sta 110+18.16 (Pioneer "S" Corp Line)

Found I.P. (in 12"x12" conc)

$\Delta = 0^{\circ} 02' 30" \text{ Rt.}$

Near side base of Fire Hyd. Shiner S.W. side P.P.

⑦

Sta 80+87.17 (back)

Sta 83+66.40 (ahead)

Found I.P. (in 12"x12" conc)

$\Delta = 0^{\circ} 20' \text{ Lt.}$

Note - Ties are to corners of Business Bldgs @ sidewalk level

④

Sta 54+36.52 (Pioneer "N" Corp Line)

Found I.P. (in 12"x12" conc)

$\Delta = 0^{\circ} 13' \text{ Rt.}$

Shiner N. side T.P.

Shiner N. side T.P.

Shiner S.E. side T.P.