

O.D.O.T. DISTRICT 2 SURVEY OFFICE (USE ONLY)

PERSONNEL

REFERENCE NO. 12 A

SHEET 16 OF 40

NOTES NIESE

DATE 4/28/22

ROUTE SR 15

H.C. AUBLE

WEATHER SUNNY

COUNTY WILLIAMS

R.C. PARADYZ

TEMP. 38°

TOWNSHIP MADISON

DWG BY RHOADES

PID 95786

SECTION 28

T 9 S R 2 W

TYPE MONUMENT MONBOX W/ 1" IPIN

ON SURFACE - ~~BELOW~~ ON

OFFSET 0.5' LT : RT

- TO - EDGE PAVEMENT


STATION: 143+19.27

HORZ.DATUM: NAD83 2011

GEOID: NAVD88 2012B

GRID: NORTHING: 733933.253

EASTING: 1407446.964

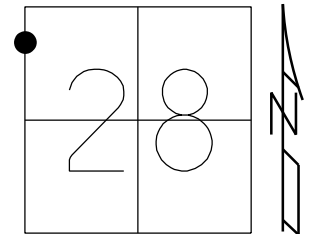

RECORD:

FD MONBOX

5/29/07, RGN

FD MONBOX

W/ 1" IPIN

REFA12

3/24/20, JLL


4/28/22

9/20/22, DSA

FD MONBOX W/ 1" IPIN

REF 12A

9/18/24, TDN

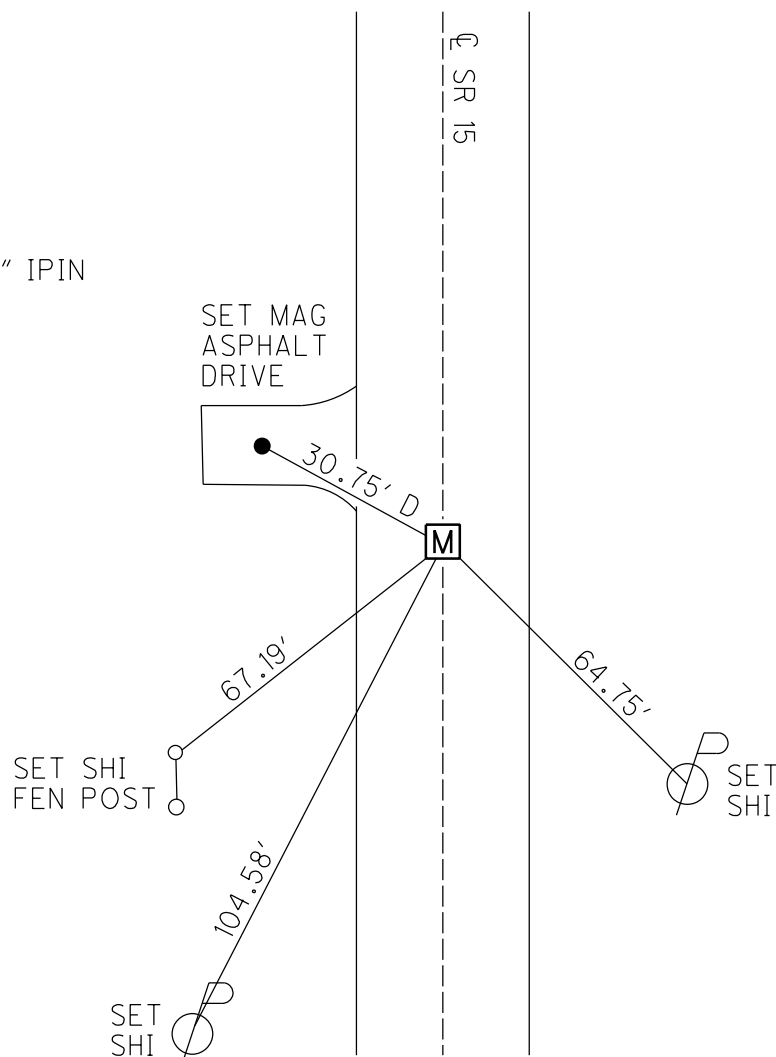

O.D.O.T. DISTRICT 2 SURVEY OFFICE (USE ONLY)

PERSONNEL

REFERENCE NO. 12 A

SHEET 16 OF 40

NOTES NIESE

DATE 4/28/22

ROUTE SR 15

H.C. AUBLE

WEATHER SUNNY

COUNTY WILLIAMS

R.C. PARADYZ

TEMP. 38°

TOWNSHIP MADISON

DWG BY RHOADES

PID 95786

SECTION 28

T 9 S R 2 W

TYPE MONUMENT MONBOX W/ 1" IPIN

ON SURFACE - ~~BELOW~~ ON

OFFSET Q PAVEMENT 0.5' ~~LT~~ : RT

- TO - EDGE PAVEMENT


STATION: 143+19.27

HORZ.DATUM: NAD83 2011


GEOID: NAVD88 2012B

GRID: NORTHING: 733933.233

EASTING: 1407446.911

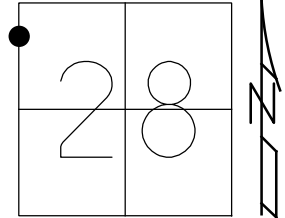

RECORD:
FD MONBOX
5/29/07, RGN
FD MONBOX
W/ 1" IPIN
REFA12
3/24/20, JLL
4/28/22
9/20/22, DSA

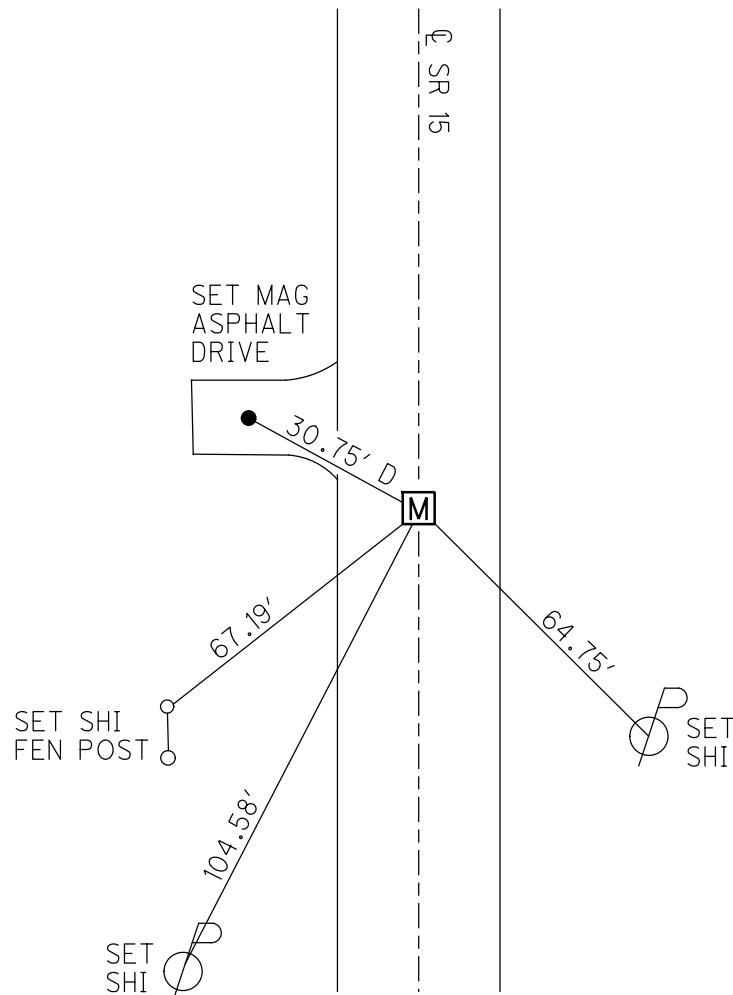


O.D.O.T. DISTRICT 2 SURVEY OFFICE (USE ONLY)

PERSONNEL _____ REFERENCE NO. 12 A SHEET 15 OF 39
NOTES NUHFER DATE 5/29/07 ROUTE SR 15
H.C. HUSS WEATHER SUNNY COUNTY WILLIAMS
R.C. HOUDSHELL TEMP. 74° TOWNSHIP MADISON
SECTION 21
T 9 S R 2 W

TYPE MONUMENT _____ IPIN IN MON.BOX _____
ON SURFACE - ~~BELOW~~ ON _____
LEFT - Q PAV'T - RIGHT ON _____
- TO - EDGE PAVEMENT _____
S.L.M. 143+27

GRID: NORTHING: 733933.371 EASTING: 1407446.932

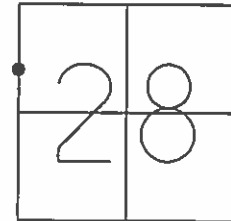

NOTE: ESTABLISHED WIL-15-2.78 PLAN

