

O.D.O.T. DISTRICT 2 SURVEY OFFICE (USE ONLY)

PERSONNEL

REFERENCE NO. 13

SHEET 18 OF 40

NOTES NIESE

DATE 4/28/22

ROUTE SR 15

H.C. AUBLE

WEATHER SUNNY

COUNTY WILLIAMS

R.C. PARADYZ

TEMP. 40°

TOWNSHIP MADISON

SECTION 28

DWG BY RHOADES PID 95786

T 9 S R 2 W

TYPE MONUMENT MAG/WASHER

ON SURFACE - ~~BELOW~~ ON

OFFSET ℄ PAVEMENT ON LT : RT

12.7' TO RT EDGE PAVEMENT


STATION: 160+40.39

HORZ.DATUM: NAD83 2011

GEOID: NAVD88 2012B

GRID: NORTHING: 732212.423

EASTING: 1407414.938

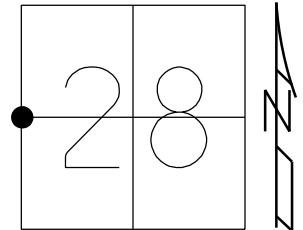

RECORD:

STA. 163+22.15

$\Delta = 0^\circ 03' \text{ LT}$

1955

FD P.K./WASHER

8/31/88, MB

5/30/07, RGN

SET MAG/WASHER

8/28/07, RGN

FD MAG/WASHER

REF13

3/24/20, JLL

SET MAG/WASHER

9/20/22, DSA FD SHI

FD MAG/WASH #PNGGN8

REF13

9/18/24, TDN

FD  
NAIL



60.00'

55.14'

℄ SR 15

125.37'



FD  
SHI

60.01'



SET SHI  
6"

97.24'



FD  
SHI

O.D.O.T. DISTRICT 2 SURVEY OFFICE (USE ONLY)

PERSONNEL

REFERENCE NO. 13

SHEET 18 OF 40

NOTES NIESE

DATE 4/28/22

ROUTE SR 15

H.C. AUBLE

WEATHER SUNNY

COUNTY WILLIAMS

R.C. PARADYZ

TEMP. 40°

TOWNSHIP MADISON

SECTION 28

DWG BY RHOADES

PID 95786

T 9 S R 2 W

TYPE MONUMENT MAG/WASHER

ON SURFACE - ~~BELOW~~ ON

OFFSET CL PAVEMENT ON LT : RT

12.7' TO RT EDGE PAVEMENT



STATION: 160+40.39

HORZ.DATUM: NAD83 2011

GEOID: NAVD88 2012B

GRID: NORTHING: 732212.406

EASTING: 1407414.900

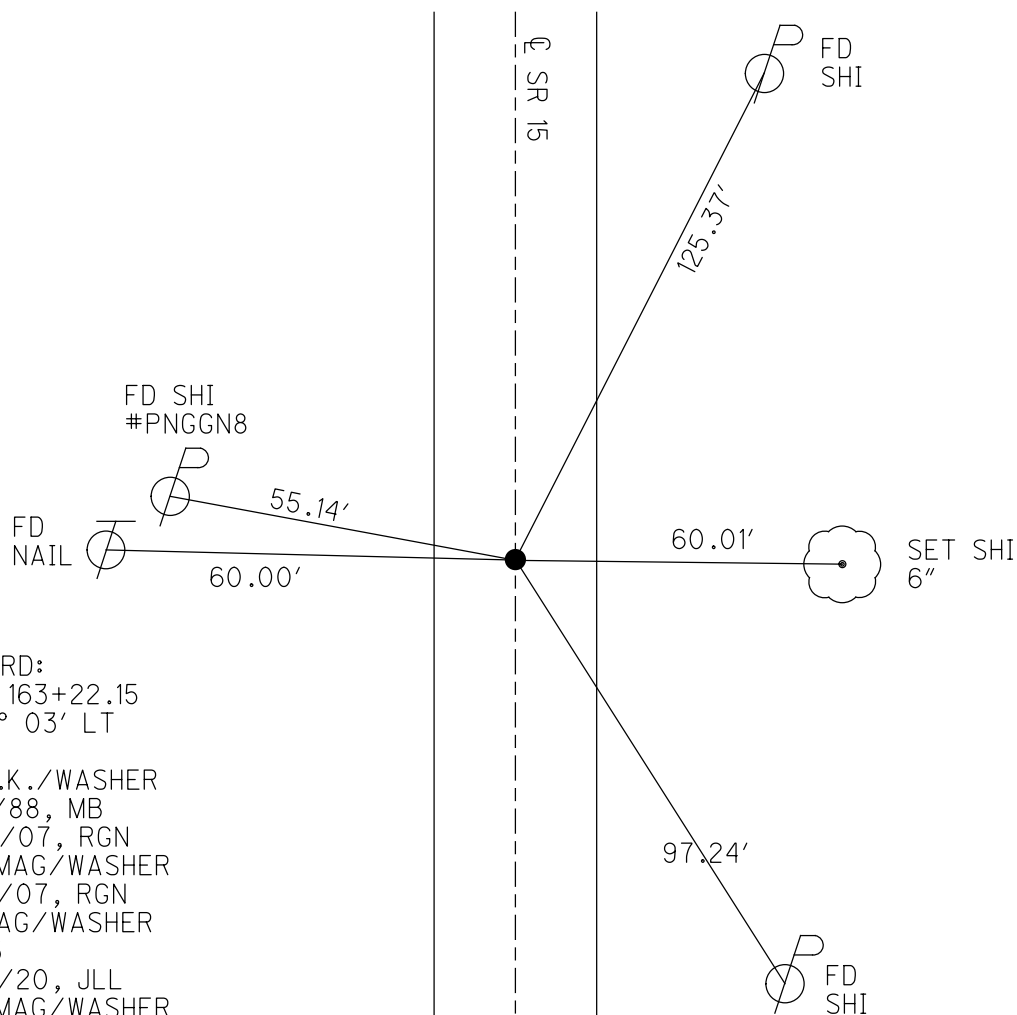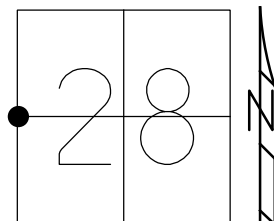

RECORD:

STA. 163+22.15

$\Delta = 0^\circ 03' \text{ LT}$

1955

FD P.K./WASHER

8/31/88, MB

5/30/07, RGN

SET MAG/WASHER

8/28/07, RGN

FD MAG/WASHER

REF13

3/24/20, JLL



SET MAG/WASHER

9/20/22, DSA

# O.D.O.T. DISTRICT 2 SURVEY OFFICE (USE ONLY)

PERSONNEL \_\_\_\_\_ REFERENCE NO. 13 SHEET 17 OF 39  
 NOTES NUHFER \_\_\_\_\_ DATE 5/30/07 ROUTE SR 15  
 H.C. HUSS WEATHER SUNNY COUNTY WILLIAMS  
 R.C. HOUDSHELL TEMP. 92° TOWNSHIP MADISON  
 \_\_\_\_\_ SECTION 28  
 \_\_\_\_\_ T 9 S R 2 W

TYPE MONUMENT \_\_\_\_\_ P.K./WASHER \_\_\_\_\_  
 ON SURFACE - ~~BELOW~~ ON \_\_\_\_\_  
~~LEFT~~ - Q PAV'T - ~~RIGHT~~ ON \_\_\_\_\_  
12.7' TO RT EDGE PAVEMENT  
 S.L.M. 160+48  
 GRID: NORTHING: 732212.453 EASTING: 1407414.866

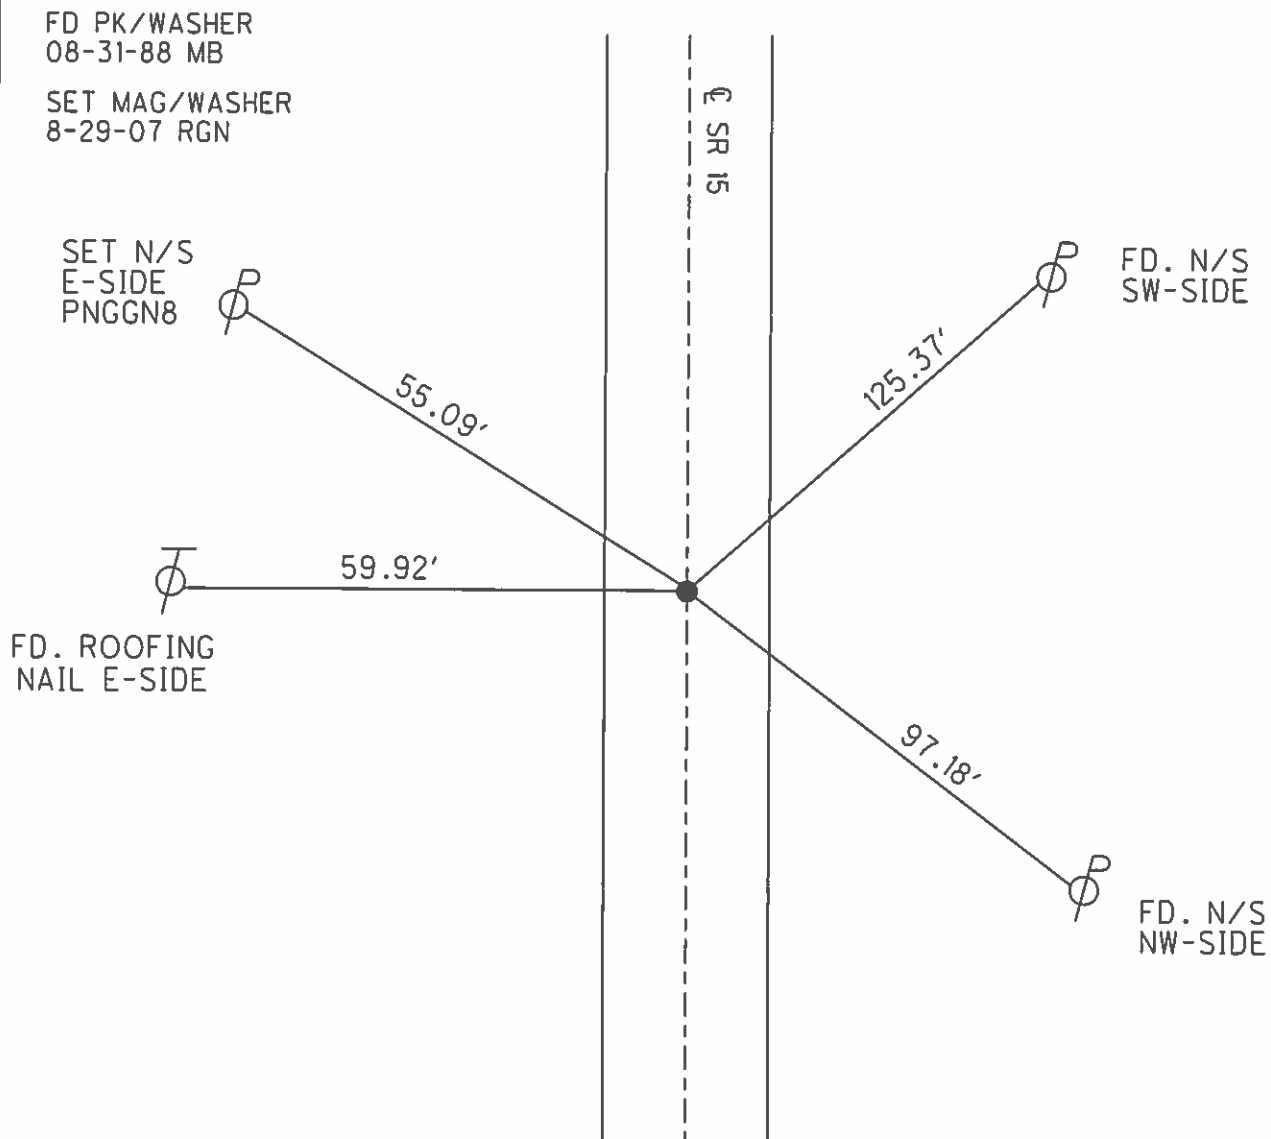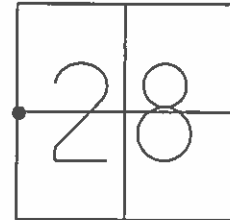

# O.D.O.T. DISTRICT 2 SURVEY OFFICE

PERSONNEL

REFERENCE NO. 13

SHEET      OF     

NOTES BARNHISEL

H.C. Loehcke

R.C. Reed

DATE 8-5-88

WEATHER Sunny

TEMP. +96°

ROUTE 15

COUNTY Williams

TOWNSHIP Madison

SECTION 28

T 9 S R 2 W


TYPE MONUMENT Sm RR Spk

ON SURFACE - ~~BELOW~~ yes


LEFT - & PAV'T. - RIGHT yes

12.3 TO R+ EDGE PAVEMENT

S.L.M. 160 + 48

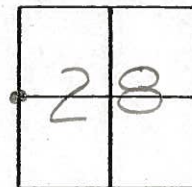

Set P.K. & Washer  
8-31-88  
m.B.

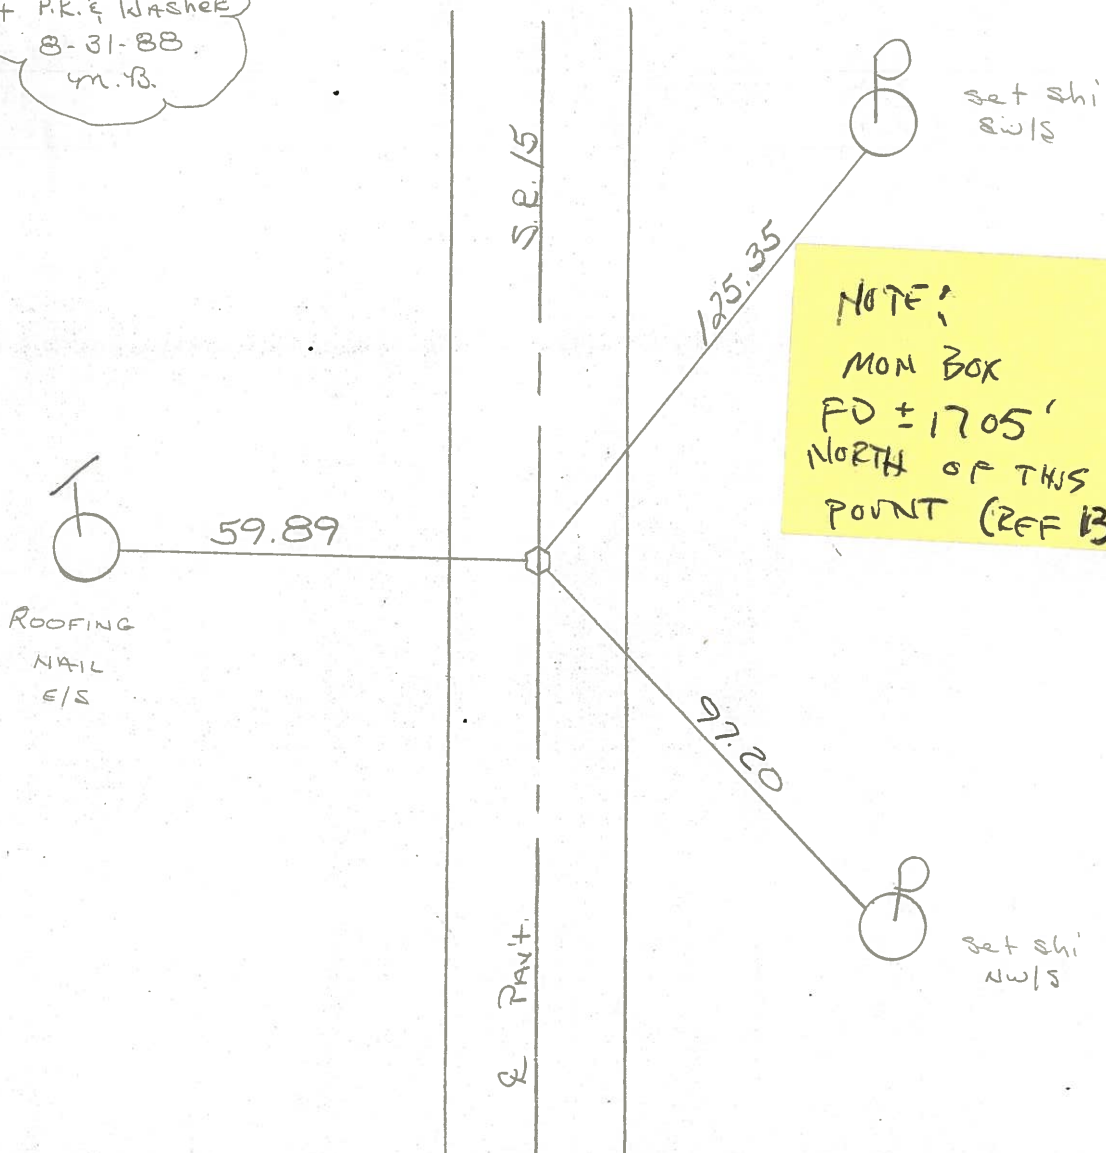


NOTE!  
MON BOX  
FD ± 1705'  
NORTH OF THIS  
POINT (REF 13)

County WILLIAMS S.R. 15Township MADISONSection W 1/4 Post SEC. 28

T9S, R2E


Personnel HOFMANLOEHRKEHOUSEHOLDER

# 37 (13)

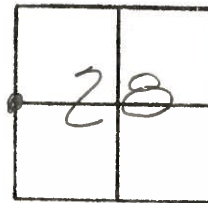Date 5-13-82Weather CLEARTemp. +80°FD. 3/4" IRON PIPE  
@ SURFACE & IN  
CTR PAVE.

P.I. STA. 163+22.15

PROJ. STA 100+43

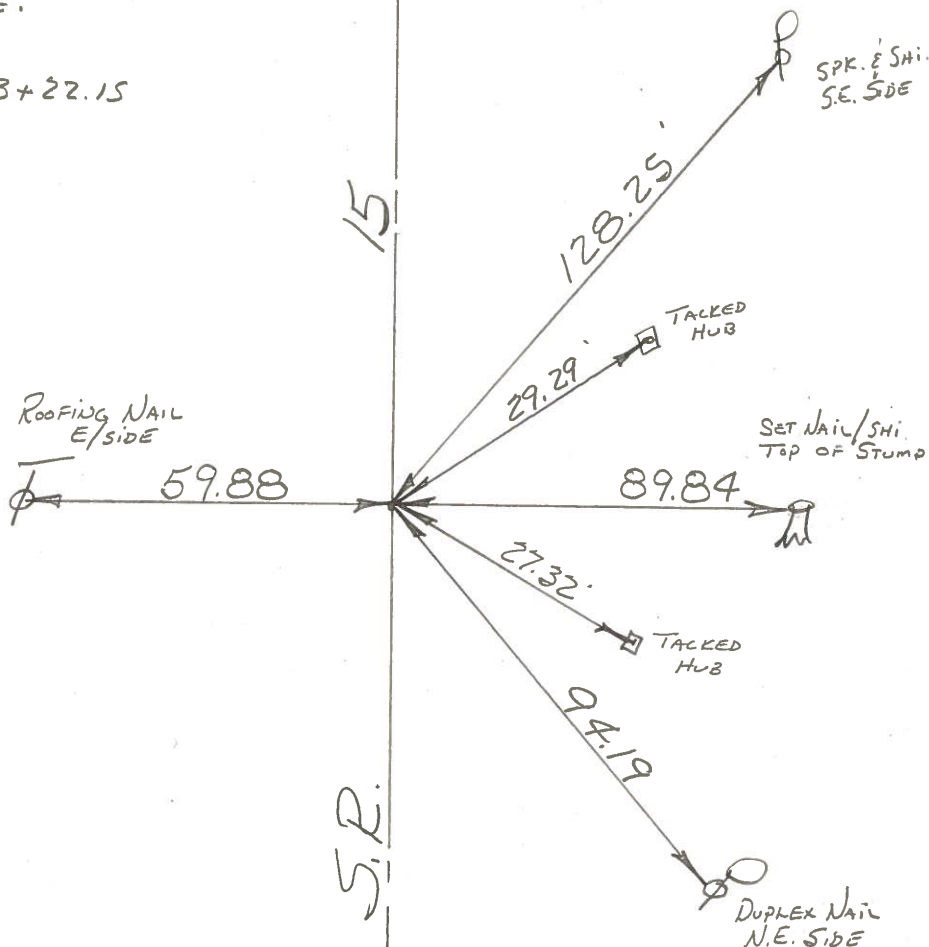

# Q.D.O.T. DISTRICT 2 SURVEY OFFICE

Sht. 28 of 35

County WILLIAMS S.R. 15

Date 11-29-79 5-13-82

Township MADISON

Weather PT. CLEAR clear

Section W 1/4 Post. SEC. 28


Temp. +28° +80°

T. 10, R. 21

Personnel BURNSIDE

SMITH

MEAD

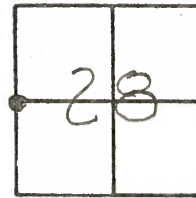

✓  
FD 3/4" IRON PIPE  
@ SURFACE & IN  
CTR. PAVE.

P.I. STA. 163+22.15

37

13

SLM sta ± 160+43  
12.1 TO WEP  
11.9 TO EWP

✓  
SPK. & SHI  
S.E. SIDE

E. & W. INTERIOR  
LINE SEC. 29

Fd Roofing Nail E/S  
59.80

60.22

~~DUPLEX NAIL~~  
~~N. SIDE~~

29.29  
T. HUB

89.50  
89.84

Set Nail/Shi  
TOP of STUMP  
E & W. INTERIOR  
LINE SEC. 28

T. HUB  
27.32

~~SPK. S. SIDE~~  
~~10" HICK BERRY~~


Set small R.R. spk  
6-21-82  
SWN

94.25  
19

✓  
DUPLEX NAIL  
N.E. SIDE

County WILLIAMS S.R. 15Township MADISONSection W 1/4 Post. SEC. 28

T9N, R2E

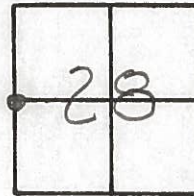Personnel BURNSIDESMITHMEADDate 11-29-79Weather PT. CLEARTemp. +28°FD 3/4" IRON PIPE  
@ SURFACE & IN  
CTR. PAVE.

P.I. STA. 163+22.15

~~(31)~~ (13)E. & W. INTERIOR  
LINE SEC. 29

60.22'

DUPLEX NAIL  
N. SIDE

89.50'

E & W. INTERIOR  
LINE SEC. 28SPK. S. SIDE  
10' HACKBERRY

94.25'

DUPLEX NAIL  
N.E. SIDE

15

S.R.

SPK. & SHI.  
S.E. SIDE

128.32'




| PERSONNEL | TITLE | PERSONNEL | TITLE |
|-----------|-------|-----------|-------|
| 1         |       | 1         |       |
| 2         |       | 2         |       |
| 3         |       | 3         |       |
| 4         |       | 4         |       |
| 5         |       | 5         |       |
| 6         |       | 6         |       |
| 7         |       | 7         |       |
| 8         |       | 8         |       |
| 9         |       | 9         |       |
| 10        |       | 10        |       |
| 11        |       | 11        |       |
| 12        |       | 12        |       |
| 99        |       | 99        |       |
| 100       |       | 100       |       |

COUNTY Williams DATE Sept. '72

S. R. 15 WEATHER \_\_\_\_\_

SEC. Madison Twp. TEMP. \_\_\_\_\_

| DESCRIPTION    | JOB NO. |
|----------------|---------|
| CONTROL POINTS |         |

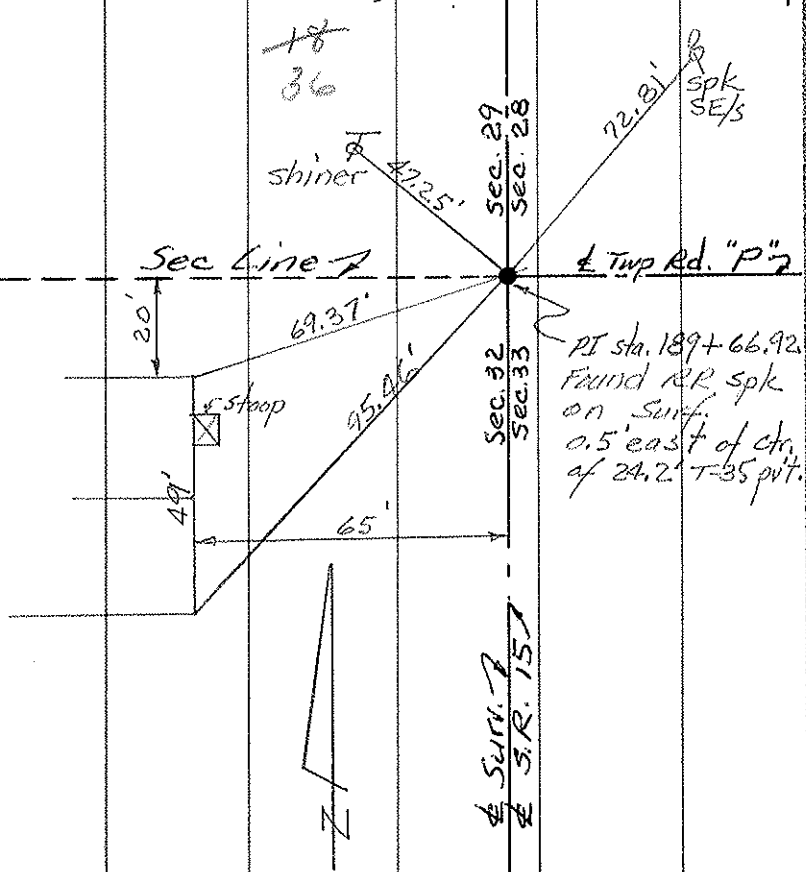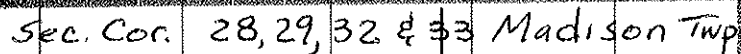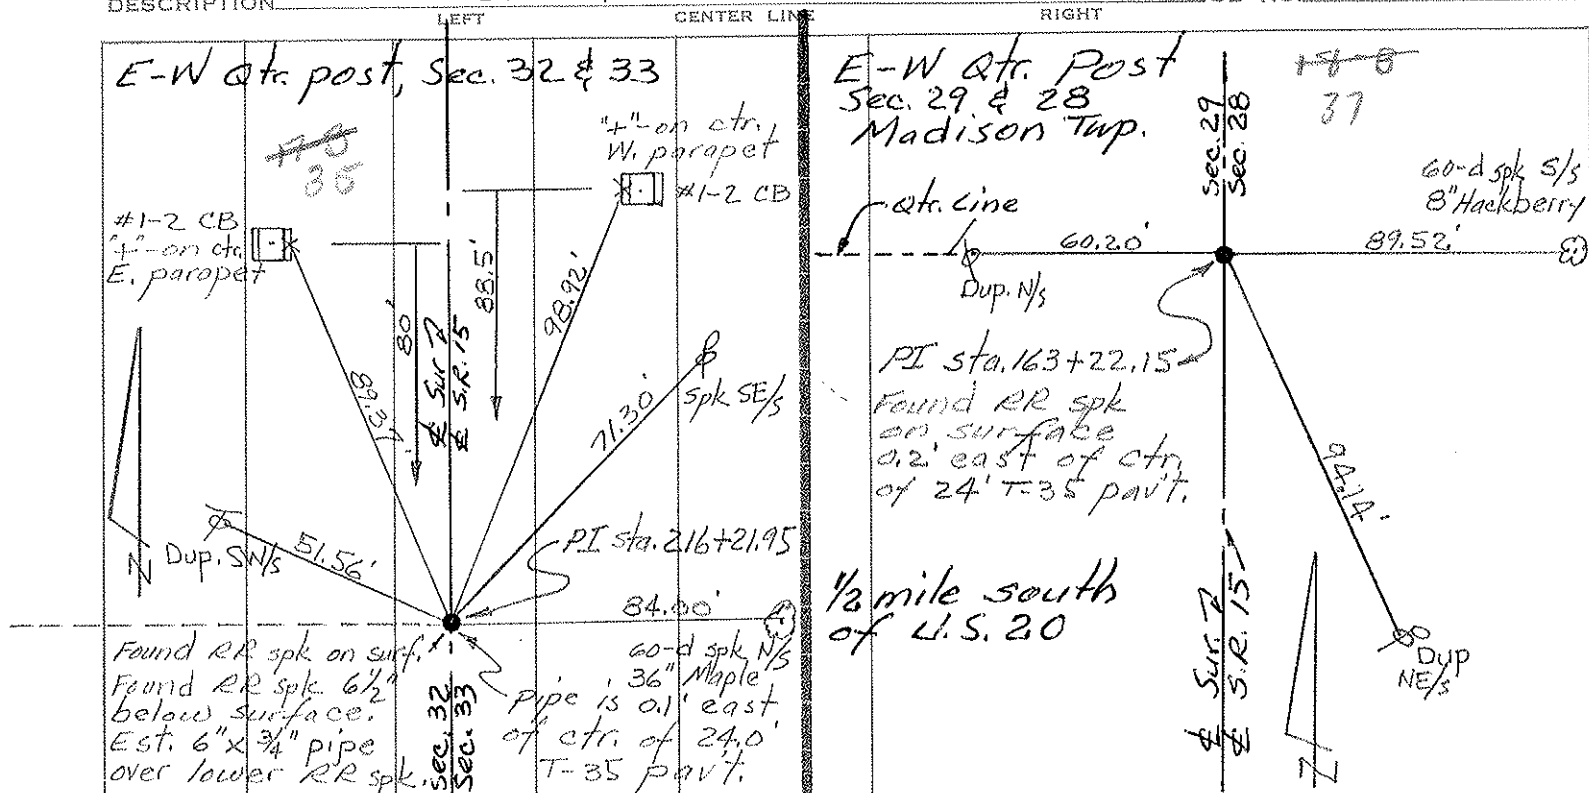

| PERSONNEL   | TITLE | PERSONNEL   | TITLE | COUNTY                 | DATE    | WEATHER | TEMP. |
|-------------|-------|-------------|-------|------------------------|---------|---------|-------|
| Lovys       |       |             |       | Wi                     | 7-22-58 | Cloudy  | 75°   |
| Pessafall   |       |             |       | S. R. 15               |         |         |       |
| Wise        |       |             |       | From Rt. #20 to        |         |         |       |
| Krohn       |       |             |       | Bryan N. Corp. Line    |         |         |       |
| DESCRIPTION |       |             |       | Re-check of witnesses. |         |         |       |
| LEFT        |       | CENTER LINE |       | RIGHT                  |         | JOB NO. |       |

