

O.D.O.T. DISTRICT 2 SURVEY OFFICE (USE ONLY)

PERSONNEL

REFERENCE NO. 1

SHEET 1 OF 4

NOTES RHOADES

DATE 3/22/19

ROUTE SR 66

H.C. O'DONNELL

WEATHER WINDY

COUNTY WILLIAMS

R.C. MILLER

TEMP. 36°

TOWNSHIP SPRINGFIELD

DWG BY NIESE PID 101344

SECTION 36

T 6 N R 4 E

TYPE MONUMENT MONBOX W/ 1" IPIN

ON SURFACE - ~~BELOW~~ ON

OFFSET Q PAVEMENT ON LT : RT

- TO - EDGE PAVEMENT


STATION: 0+00

HORZ. DATUM: NAD83(2011)


GEOID: 2012A

GRID: NORTHING: 646992.655

EASTING: 1458195.682

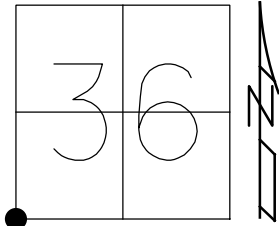

RECORD:
 FD 1" SUARE IPIPE
 5/6/99, MC
 SET P.K./WASHER
 10-22-99, MDB
 FD RR SPIKE
 REF1
 4-2-18, JFO
 FD MONBOX
 W/ 1" IPIN
 NEWREF1
 3-22-19, JFO

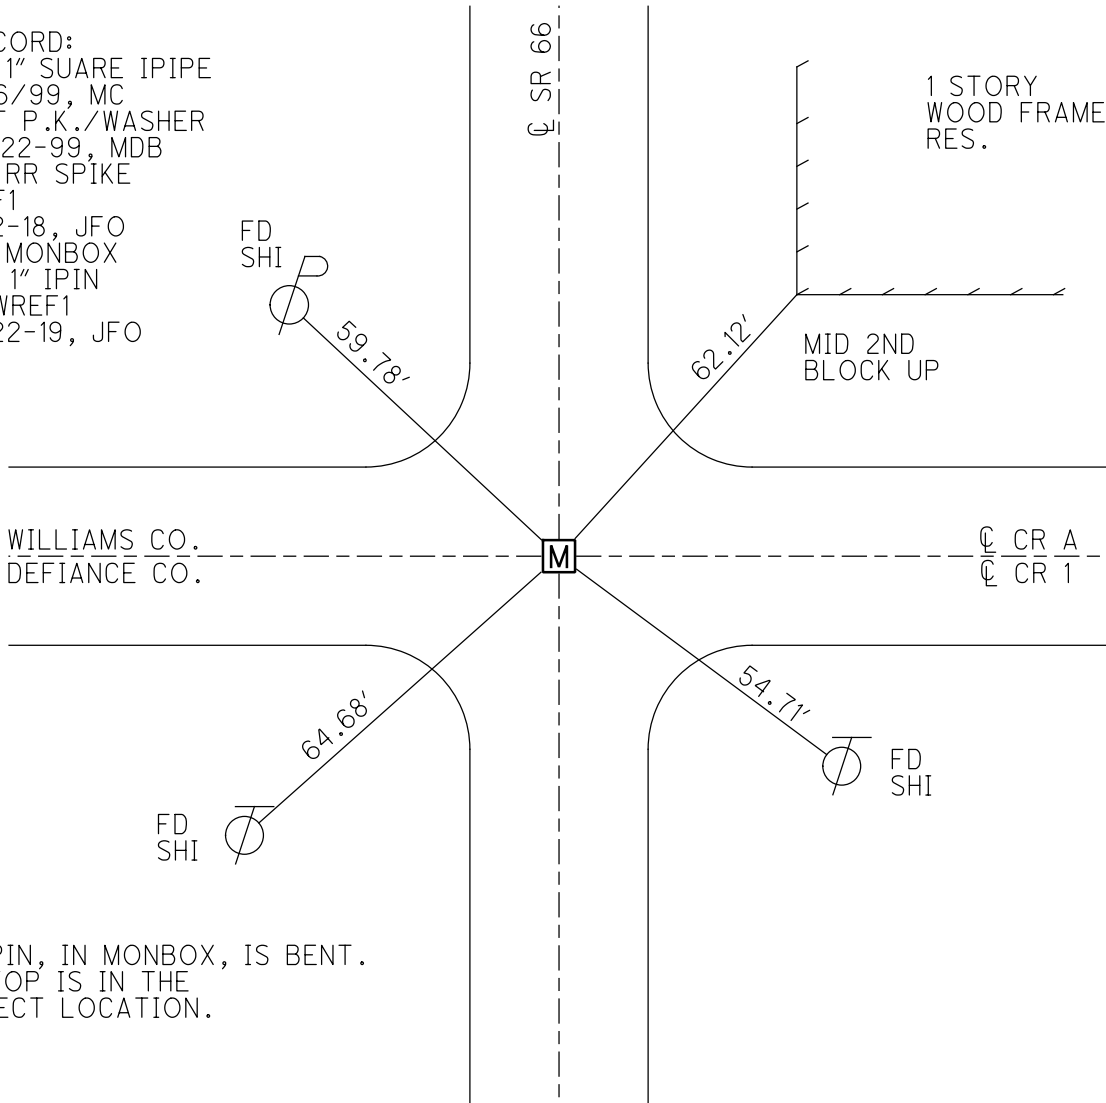

NOTE:
 NEW PIN, IN MONBOX, IS BENT.
 THE TOP IS IN THE
 CORRECT LOCATION.

O.D.O.T. DISTRICT 2 SURVEY OFFICE (USE ONLY)

PERSONNEL

REFERENCE NO. 2

SHEET 2 OF 4

NOTES RHOADES
 H.C. O'DONNELL
 R.C. MILLER

DATE 3/22/19
 WEATHER WINDY
 TEMP. 36°

ROUTE SR 66
 COUNTY WILLIAMS
 TOWNSHIP SPRINGFIELD
 SECTION 36
 T 6 N R 4 E

DWG BY NIESE PID 101344

TYPE MONUMENT MAG/WASHER

ON SURFACE - ~~BELOW~~ ON

OFFSET \varnothing PAVEMENT ON LT : RT

13.1 TO RT EDGE PAVEMENT


STATION: 13+19

HORZ.DATUM: NAD83(2011)


GEOID: 2012A

GRID: NORTHING: 648312.805

EASTING: 1458222.029

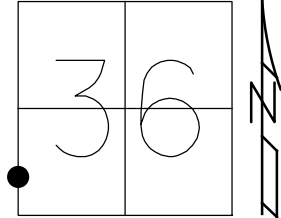

RECORD: P.O.T.
 1961 PLAN:
 STA 13+00
 SET SM.R.R.SPIKE
 6-24-85, SWH
 FD SM.R.R.SPIKE
 ATOP P.K.NAIL
 5/10/99, MB
 SET P.K./WASHER
 10-22-99, MDB
 D.N.F.
 4/2/18, JFO
 SET MAG/WASHER
 NEWREF2
 3-22-19, JFO

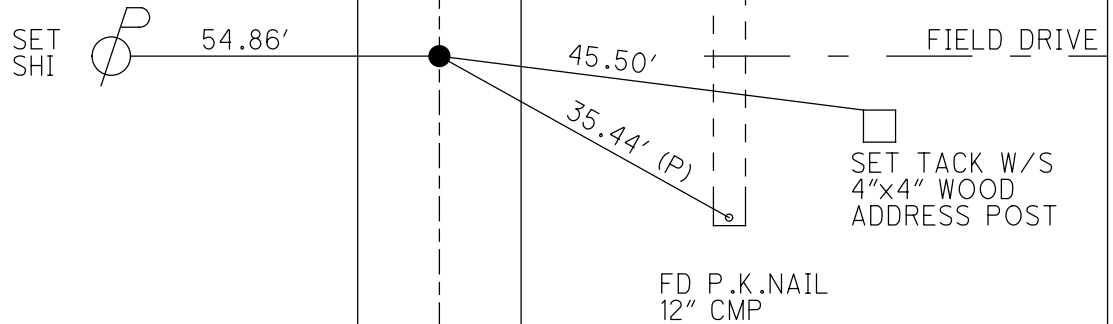

O.D.O.T. DISTRICT 2 SURVEY OFFICE (USE ONLY)

PERSONNEL

REFERENCE NO. 3

SHEET 3 OF 4

NOTES RHOADES
 H.C. O'DONNELL
 R.C. SEAMAN

DATE 4-2-18
 WEATHER SUNNY
 TEMP. 31°

ROUTE SR 66
 COUNTY WILLIAMS
 TOWNSHIP SPRINGFIELD
 SECTION 36
 T 6 N R 4 E

DWG BY NIESE PID 101344

TYPE MONUMENT P.K./WASHER

ON SURFACE - ~~BELOW~~ ON

OFFSET 12.5' TO RT PAVEMENT 1.0' ~~LT~~ : RT

12.5' TO RT EDGE PAVEMENT



STATION: 26+41

HORZ.DATUM: NAD83(2011)

GEOID: 2012A

GRID: NORTHING: 649632.708

EASTING: 1458248.307

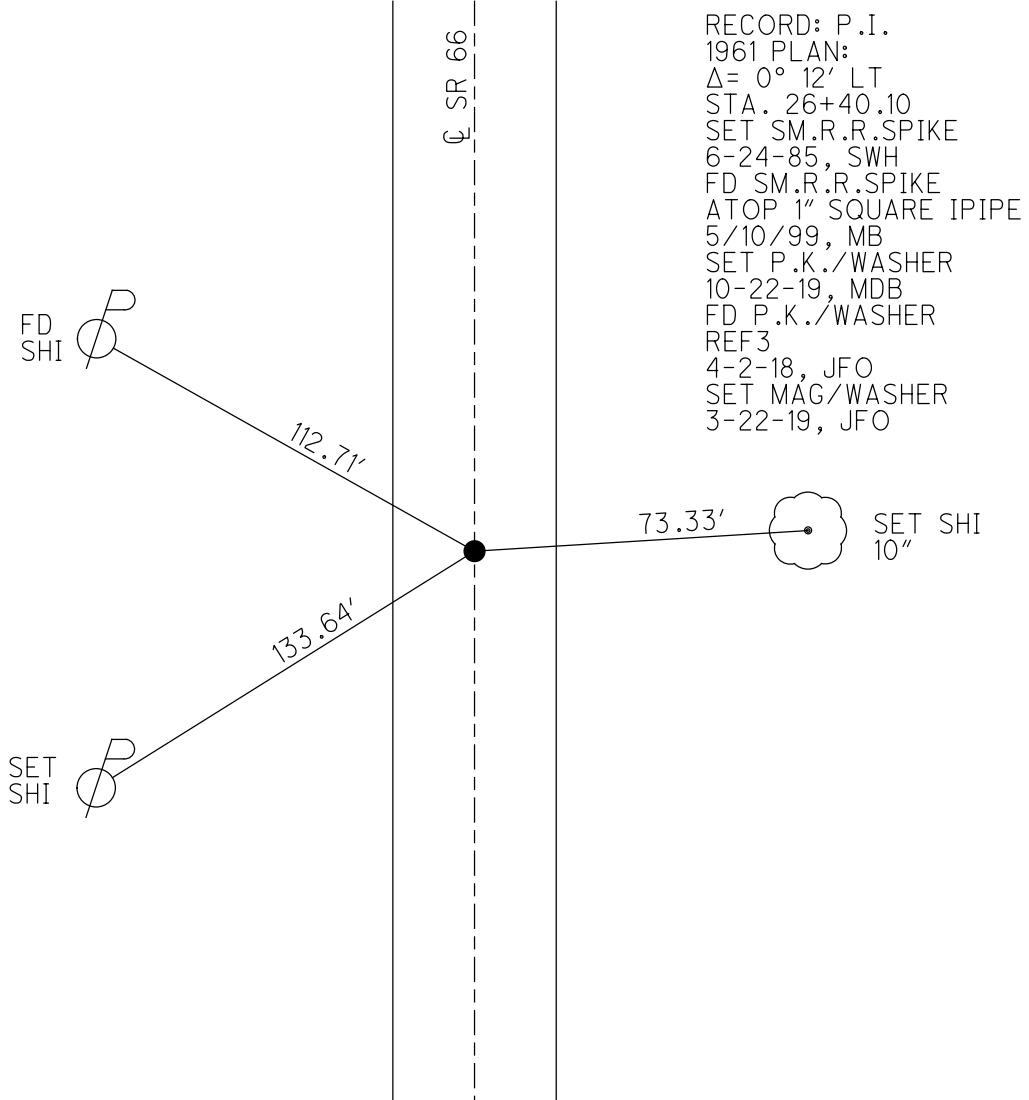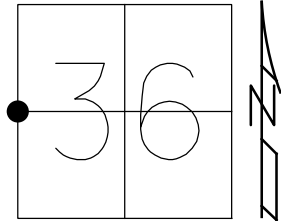

RECORD: P.I.
 1961 PLAN:
 $\Delta = 0^\circ 12' \text{ LT}$
 STA. 26+40.10
 SET SM.R.R.SPIKE
 6-24-85, SWH
 FD SM.R.R.SPIKE
 ATOP 1" SQUARE IPIPE
 5/10/99, MB
 SET P.K./WASHER
 10-22-19, MDB
 FD P.K./WASHER
 REF3
 4-2-18, JFO
 SET MAG/WASHER
 3-22-19, JFO

O.D.O.T. DISTRICT 2 SURVEY OFFICE (USE ONLY)

PERSONNEL _____

REFERENCE NO. 4


SHEET 4 OF 4

NOTES CANTERBURY DATE 5-10-99
 H.C. ROUSOS WEATHER FAIR
 R.C. BARNHISEL TEMP. 75°

ROUTE SR 66
 COUNTY WILLIAMS
 TOWNSHIP SPRINGFIELD
 SECTION 36
 T 6 N R 4 E

DWG BY NIESE PID 101344

TYPE MONUMENT SM. R.R. SPK. ATOP P.K. SHANK
 ON SURFACE - ~~BELOW~~ ON
 OFFSET ☉ PAVEMENT ON ~~LT~~ : RT
13.1' TO RT EDGE PAVEMENT
 STATION: 37+01

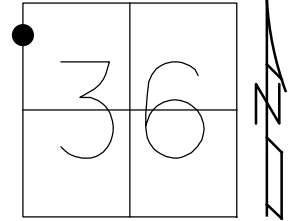

HORZ.DATUM: NAD83(2011)

GEOID: 2012A

GRID: NORTHING: 650692.289

EASTING: 1458265.452

