

O.D.O.T. DISTRICT 2 SURVEY OFFICE (USE ONLY)

PERSONNEL

REFERENCE NO. 20 A

SHEET 5 OF 52

NOTES ASTON

DATE 5/23/24

ROUTE SR 18

H.C. NIESE

WEATHER WINDY

COUNTY WOOD

R.C. PRESTON-COLVIN

TEMP. 80°F

TOWNSHIP HENRY

SECTION 30

DWG BY BARRIERE

PID 101290

T 3 N R 10 E

TYPE MONUMENT MONBOX W/ 1" IPIN

ON SURFACE - BELOW ON

OFFSET Q PAVEMENT LT : RT

 TO EDGE PAVEMENT

STATION: 449+14.34

HORIZ.DATUM: WOOD LDP


GEOID: 18

GRID: NORTHING: 554828.910


EASTING: 1625571.963

LDP: NORTHING: 376317.714

EASTING: 137640.832

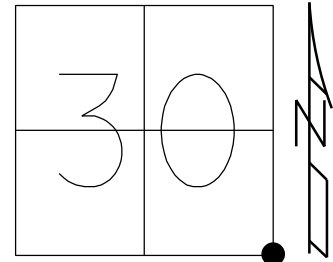

RECORD:
FD MONBOX
W/1" IPIN
5/5/21, JFO
1/21/22, TDN
REF20A
5/23/24, TDN

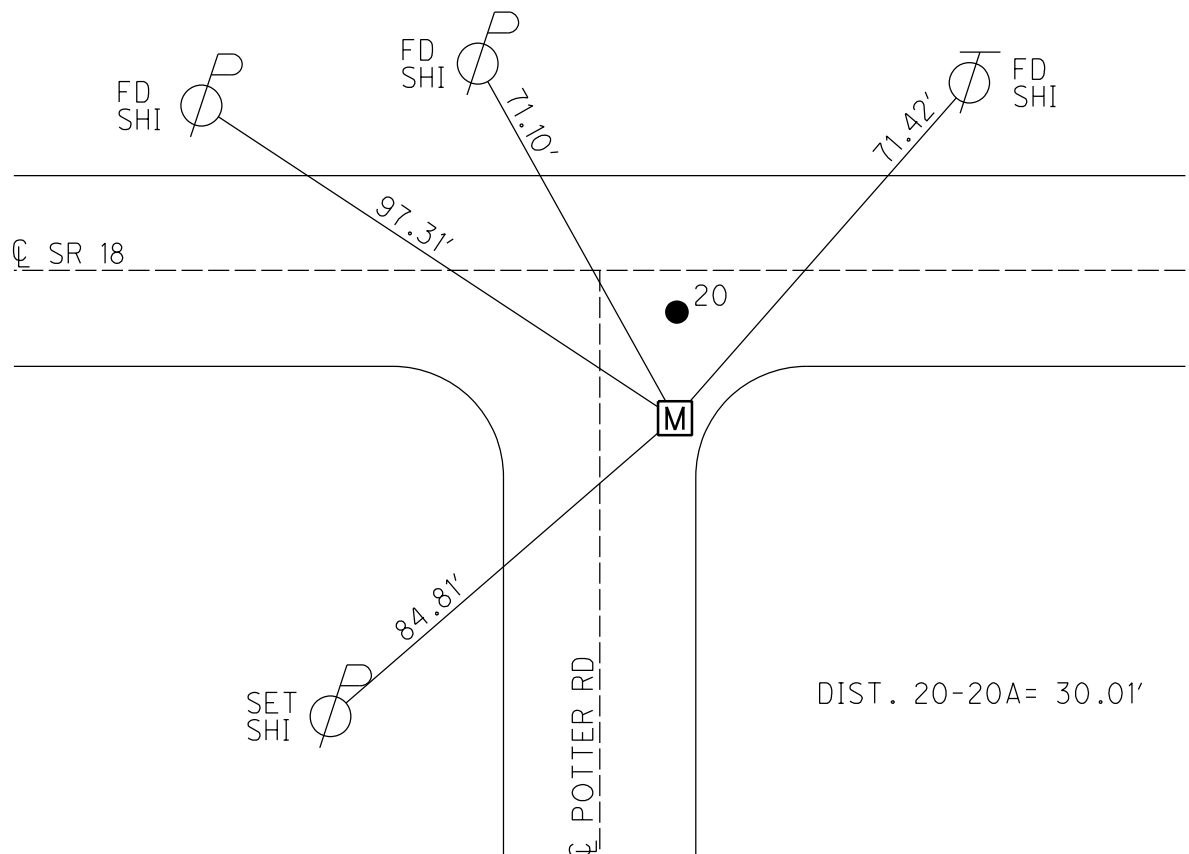

O.D.O.T. DISTRICT 2 SURVEY OFFICE (USE ONLY)

PERSONNEL

REFERENCE NO. 20 A

SHEET 15 OF 52

NOTES AUBLE

DATE 5/5/21

ROUTE SR 18

H.C. NIESE

WEATHER CLOUDY

COUNTY WOOD

R.C. O'DONNELL

TEMP. 46°

TOWNSHIP HENRY

SECTION 30

DWG BY NIESE PID PAVETRAIN

T 3 N R 10 E

TYPE MONUMENT MONBOX W/1" IPIN

ON SURFACE - ~~BELOW~~ ON

OFFSET CL PAVEMENT 34.2' ~~LT~~ : RT

- TO - EDGE PAVEMENT


STATION: 449+14.34

HORIZ.DATUM: NAD83(2011)

GEOID: NAVD88 2012A

GRID: NORTHING: 554828.910

EASTING: 1625571.963

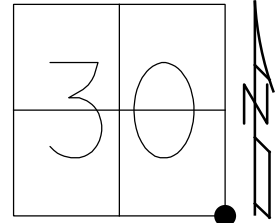

RECORD:
FD MONBOX
W/1" IPIN
5/5/21, JFO
1/21/22, TDN

