

O.D.O.T. DISTRICT 2 SURVEY OFFICE (USE ONLY)

PERSONNEL

REFERENCE NO. 1 AA

SHEET 2 OF 46

NOTES RHOADES DATE 7/15/19

ROUTE US 23

H.C. O'DONNELL WEATHER SUNNY

COUNTY WOOD

R.C. RHOADES TEMP. 73°

TOWNSHIP PERRY

SECTION 36

DWG BY NIESE PID 105306

T 3 N R 12 E

TYPE MONUMENT P.K./WASHER

ON SURFACE - ~~BELOW~~ ON

OFFSET ☐ PAVEMENT ON LT : RT

22.1' TO RT EDGE PAVEMENT


STATION: 10+09

HORZ.DATUM: NAD83(2011)

GEOID: 18

GRID: NORTHING: 548870.269

EASTING: 1714945.051

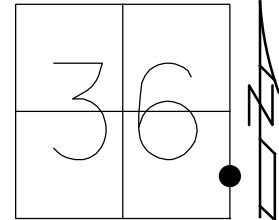

RECORD:
 SET P.K./WASHER
 11/26/97, MB
 FD P.K./WASHER
 REF3
 7/21/17, JFO
 SET MAG/WASHER
 NEWREF2
 10/9/17, JFO

WOOD CO

SENECA CO

MID 2ND
 BRICK UP
 F.O.E. 'EAGLES'

☐ PARK AVE


SET
 SHI

SET
 SHI

SET
 SHI

WOOD LDP:
 N: 371537.762
 E: 227092.332


☐ US 23

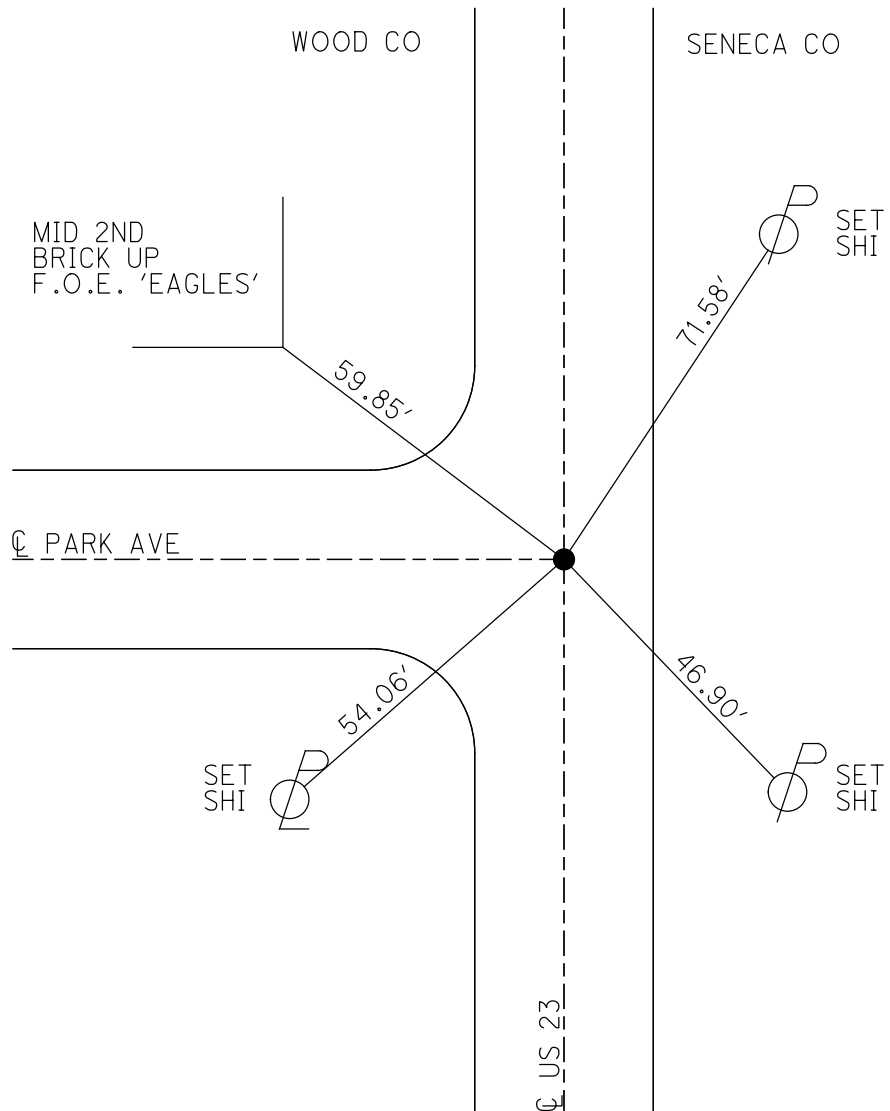

O.D.O.T. DISTRICT 2 SURVEY OFFICE (USE ONLY)


PERSONNEL _____ REFERENCE NO. 1 AA SHEET 2 OF 3
 NOTES RHOADES DATE 7/15/19 ROUTE US 23
 H.C. O'DONNELL WEATHER SUNNY COUNTY WOOD
 R.C. RHOADES TEMP. 73° TOWNSHIP PERRY
 SECTION 36
 DWG BY NIESE PID 105306 T 3 N R 12 E

TYPE MONUMENT P.K./WASHER
 ON SURFACE - ~~BELOW~~ ON
 OFFSET Q PAVEMENT ON LT : RT
22.1' TO RT EDGE PAVEMENT
 STATION: 10+09

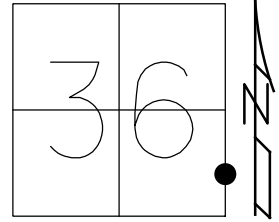

HORZ. DATUM: NAD83(2011) GEOID: 2012A
 GRID: NORTHING: 548870.269 EASTING: 1714945.051

RECORD:
 SET P.K./WASHER
 11/26/97, MB
 FD P.K./WASHER
 REF3
 7/21/17, JFO
 SET MAG/WASHER
 NEWREF2
 10/9/17, JFO

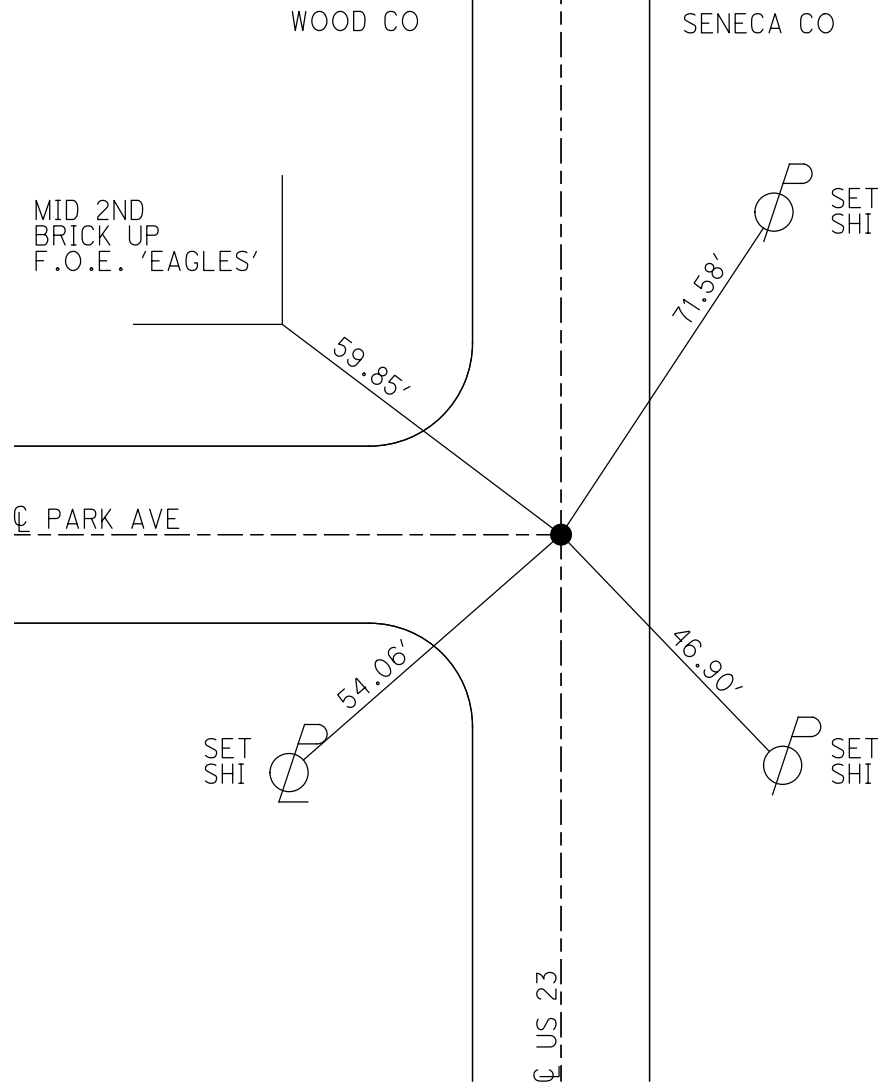

O.D.O.T. DISTRICT 2 SURVEY OFFICE

PERSONNEL _____

REFERENCE NO. _____

SHEET 3 OF 4
U.S. 23 - S.R. 199

NOTES BARNHISEL

H.C. CANTERBURY

DATE 7-10-99

ROUTE US 23 + SR 199

R.C. LEAVEN

WEATHER Sunny

COUNTY _____

Rousos

TEMP. 70

TOWNSHIP _____

Drawn By Rousos

SECTION _____

T _____ R _____


TYPE MONUMENT P.K. NAIL

~~ON SURFACE~~ - BELOW 2"

~~LEFT - &~~ PAV'T. - RIGHT &


22.1 TO RT. EDGE PAVEMENT

S.L.M. 0+307.4

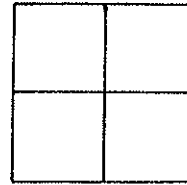

SET P.K. & WASHER
11-26-97
M.B.

Corner Brick
Middle 2nd Brick up
Front F.O.E. EACHES'

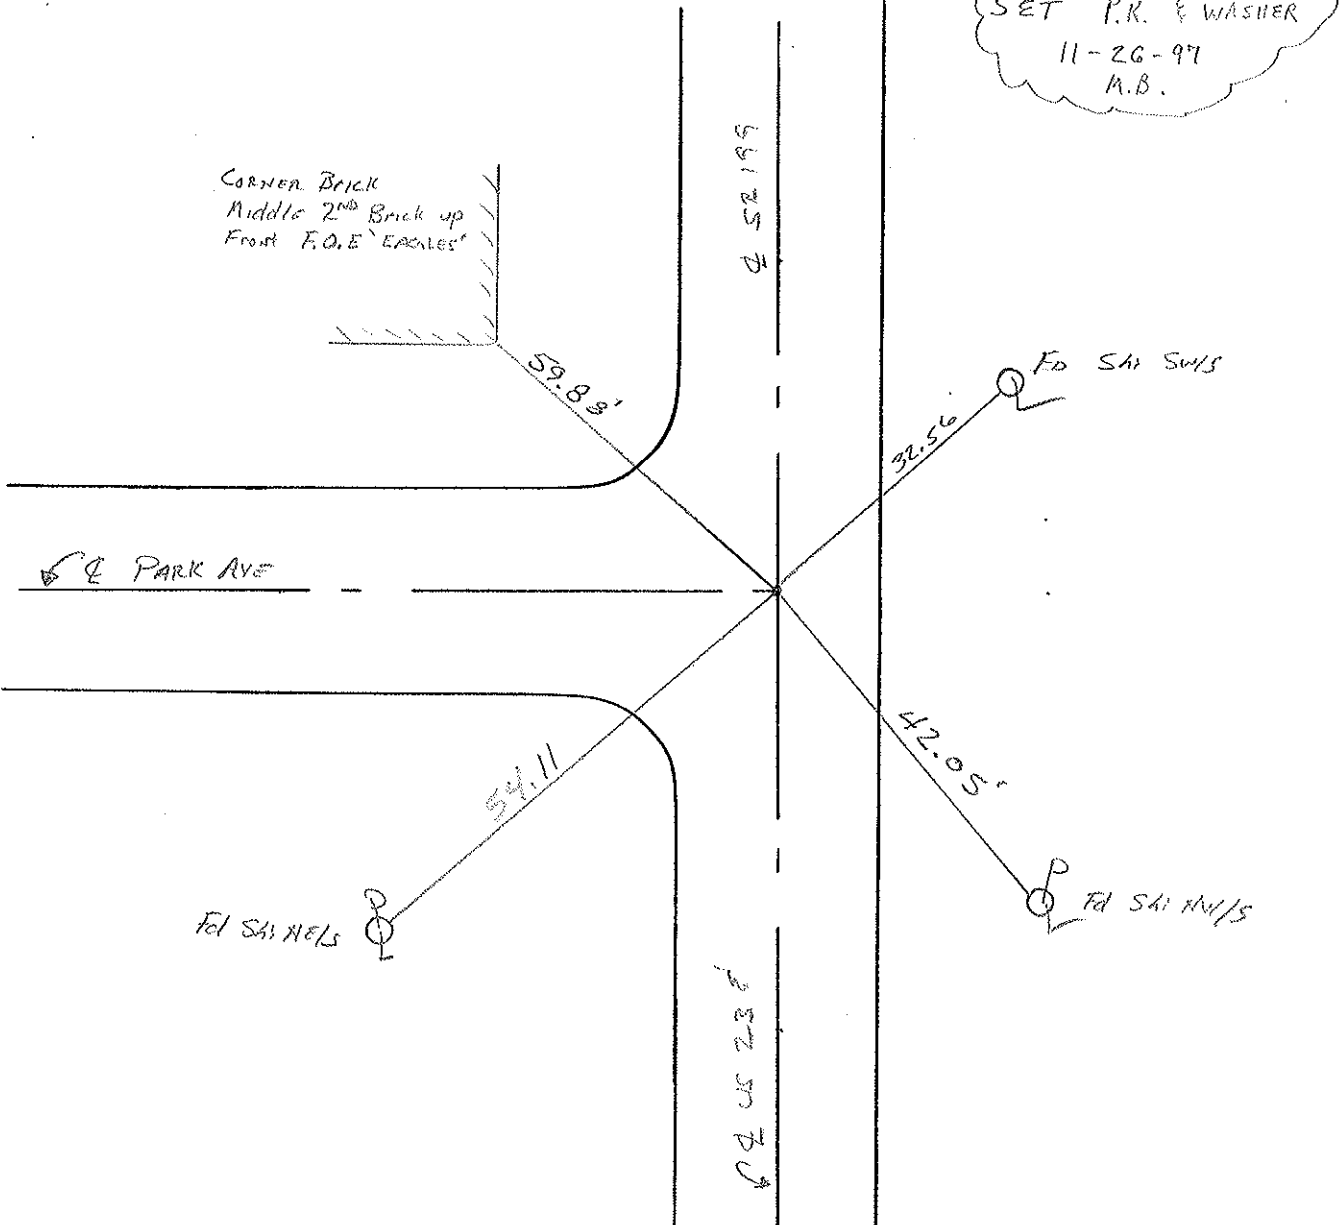

O.D.O.T. DISTRICT 2 SURVEY OFFICE

Sht. 3 of 6
U.S. 23-S.R. 199

County SENECA-WOOD

Township _____

Section _____

T N, R E

Personnel BURNSIDE

BOWERS

KNAPP

MEAD

Date 7-20-78

Weather CLEAR

Temp. +92°

