


O.D.O.T. DISTRICT 2 SURVEY OFFICE (USE ONLY)


PERSONNEL	REFERENCE NO.	38	SHEET	3	OF	22
NOTES	RHOADES	DATE	4-21-14	ROUTE	US 23	
H.C.	ROUSOS	WEATHER	CLOUDY	COUNTY	WOOD	
R.C.	GABLE	TEMP.	62°	TOWNSHIP	FREEDOM	
	HOMAN			SECTION	36	
				T	5	N
				R	12	E

TYPE MONUMENT _____ PK/SAH _____
~~ON SURFACE~~ - BELOW _____ 3" _____
~~LEFT~~ - C PAV'T - ~~RIGHT~~ _____ ON _____
12.6 TO RT EDGE PAVEMENT
 S.L.M. _____ 662+55.29 _____

Grid: Northing: 614069.310 Easting: 1716692.958

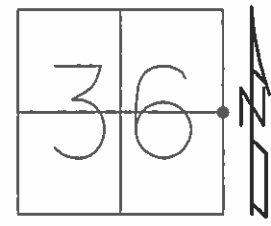

POT 662+54.96 RECORD
 $\Delta=0^{\circ}-0'-0''$
 SET PK & WASHER
 9-9-91, MB
 FD, GPS SHOT REF38
 11-30-12, SHH
 NEWREF38
 FD MONBOX W/ 3/4"
 IPIN
 10-17-16, JLL

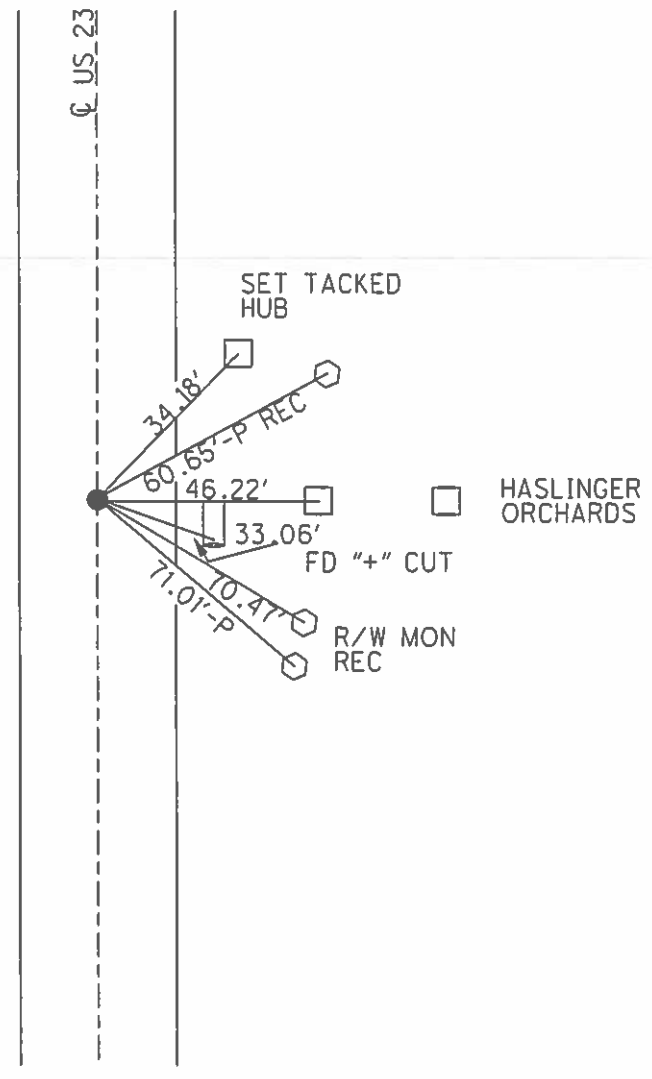

O.D.O.T. DISTRICT 2 SURVEY OFFICE

PERSONNEL

REFERENCE NO. 38

SHEET 1 OF 11

NOTES VAN DUSEN

H.C. VAN DUSEN

R.C. BARNHISEL

KUSZ

DATE 7-19-91

WEATHER CLEAR

TEMP. +90°F

ROUTE U.S. 23

COUNTY WOOD

TOWNSHIP FREEDOM

SECTION 36

T5 N R 12 E


TYPE MONUMENT SM. RR SPIKE

ON SURFACE - BELOW yes

LEFT - C PAV'T. - RIGHT yes

12.6 ORT. EDGE PAVEMENT

S.L.M. 662+70

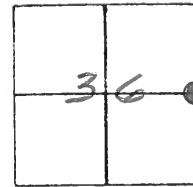


P.O.T. 662+54.96 RECORD

A = 0°-0'-0"

SET PK & WASHER
9-9-91

Set P.K. & Washer
9-9-91
MB

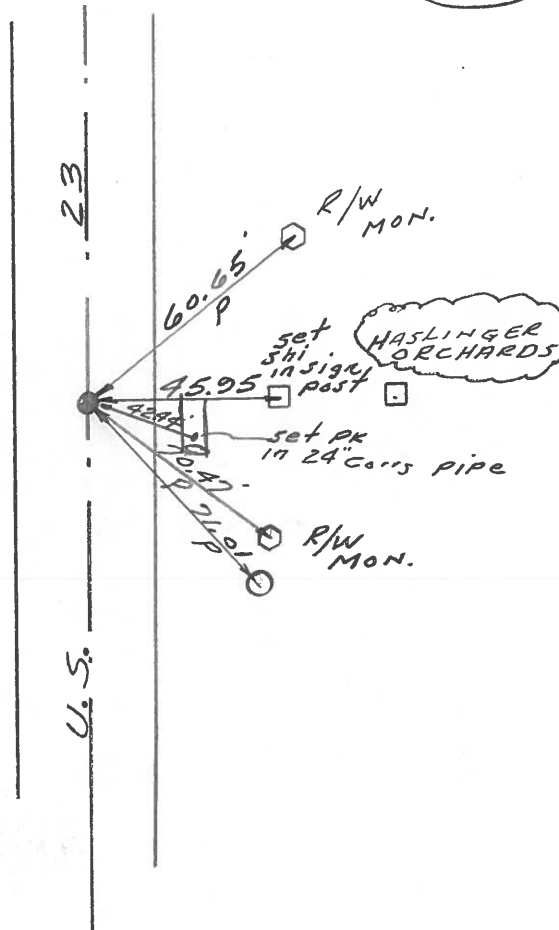

O.D.O.T. DISTRICT 2 SURVEY OFFICE

SHEET _____ OF _____

County WOOD ^{U.S.} S.R. 23

Date 2-5-70

Township FREEDOM


Weather FAIR

Section 36

Temp. 35°

T5N, R12E

Personnel SCHNEIDER
MOSSER
BARBOUR
POTTS

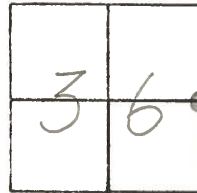


#38

P.O.T.

662+54.96

SMALL R.R. SPK.

$\Delta = 0^{\circ}0'$

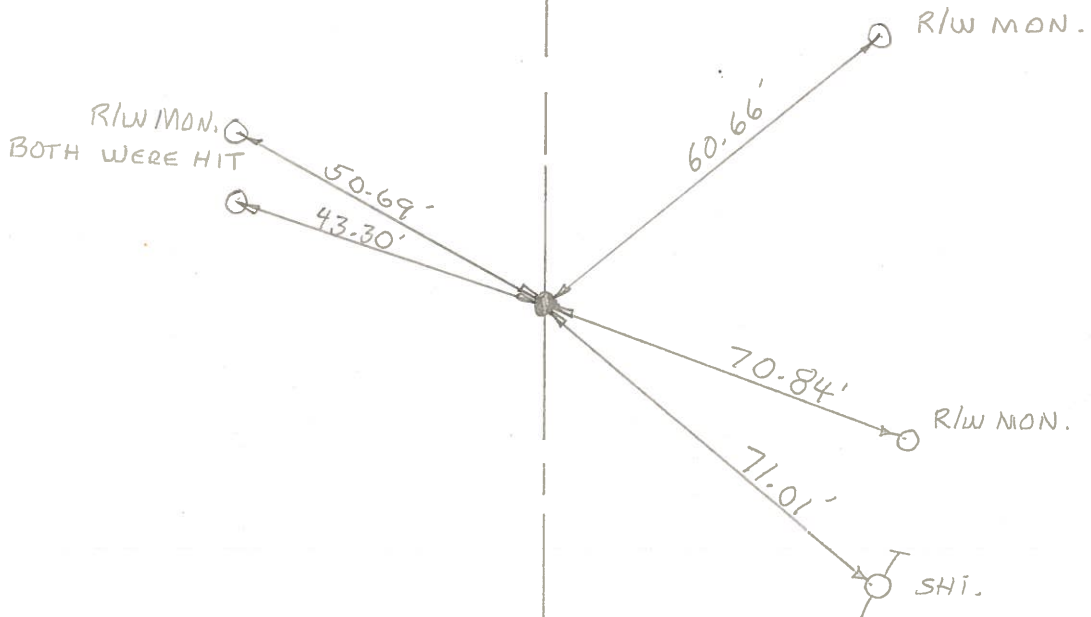

PERSONNEL	TITLE	PERSONNEL	TITLE	COUNTY	San. Woo	DATE	6/29/60
<u>Sworden</u>	<u>Notes</u>	<u>Rice</u>		S. R.	#199	WEATHER	Cloudy
<u>Cromin</u>				SEC.	U.S.#6 North to U.S.#20	TEMP.	+ 80
<u>Holcombe</u>							
<u>Sage</u>							

DESCRIPTION Ties for Control Points JOB NO. _____

