

O.D.O.T. DISTRICT 2 SURVEY OFFICE (USE ONLY)

PERSONNEL

REFERENCE NO. A0

SHEET OF

NOTES NIESE
H.C. AUBLE
R.C. NIESE

DATE 11/16/23
WEATHER CLEAR
TEMP. 65°

ROUTE SR 25
COUNTY WOOD
TOWNSHIP HENRY
SECTION 1

DWG BY BARRIERE PID 92133

T 3 N R 10 E

TYPE MONUMENT MONBOX W/ 1" IPIN

ON SURFACE - BELOW ON

OFFSET $\varnothing$ PAVEMENT ON LT : RT


 TO EDGE PAVEMENT

STATION: 0+94.21


HORIZ.DATUM: NAD83(11)/WOOD LDP GEOID: 18

GRID: NORTHING: 575581.525 EASTING: 1650699.559

LDP: NORTHING: 397401.566 EASTING: 162494.689

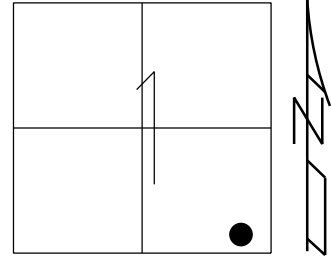

RECORD: P.C.
PLAN STA 0+90
SLM 0.54= 28+51
3-22-91
FD MONBOX
4/12/01, DCH
FD MONBOX (NO LID)
W/ 3/4" IPIN
REFAO
3/17/22, JFO
FD NEW MONBOX
W/ 1" IPIN
SHOT WITH GPS,
DID NOT PULL TIES
NEWREFAO
11/16/23, TDN

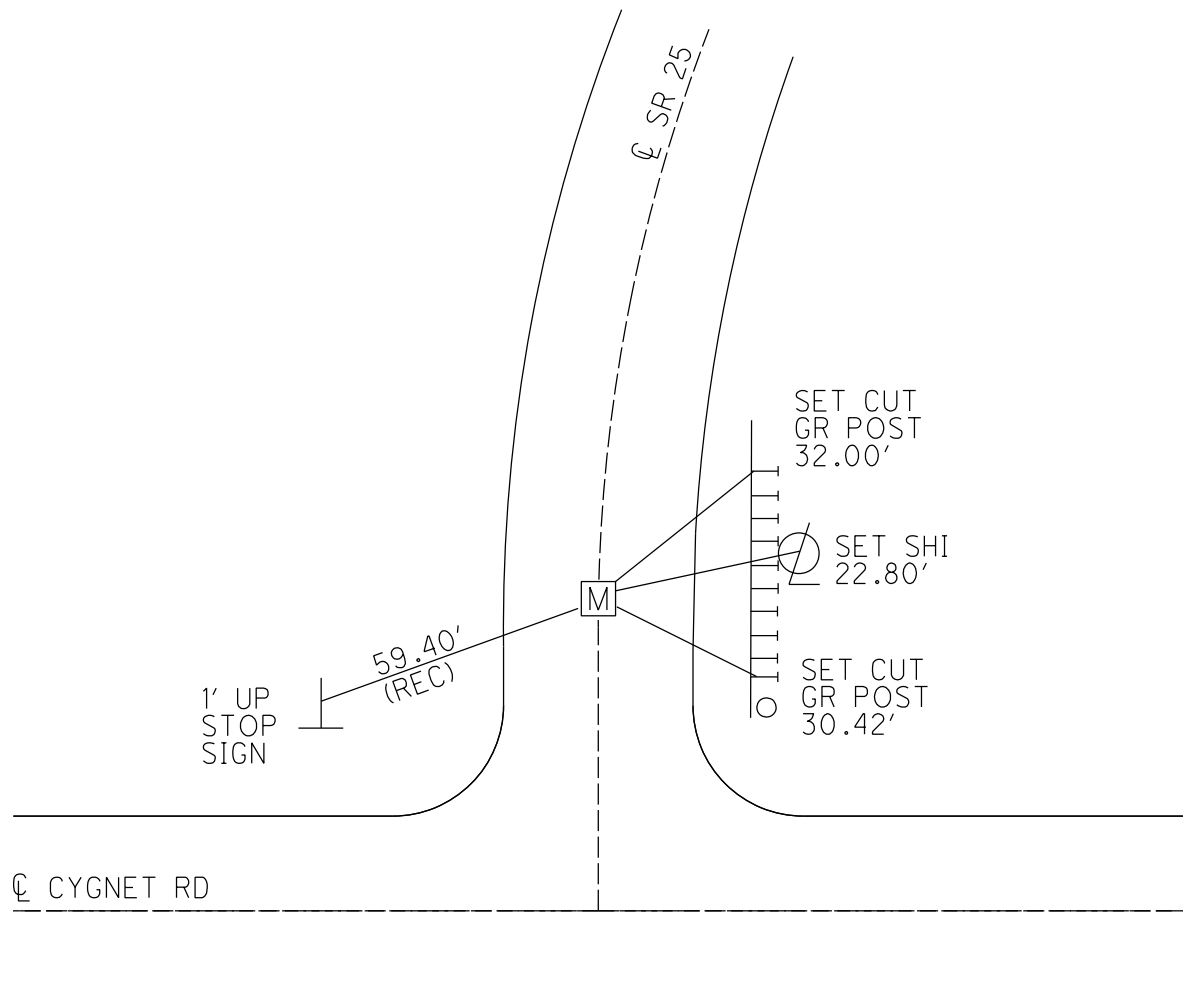

O.D.O.T. DISTRICT 2 SURVEY OFFICE (USE ONLY)

PERSONNEL

REFERENCE NO. B0

SHEET OF

NOTES NIESE

DATE 11/16/23

ROUTE SR 25

H.C. AUBLE

WEATHER CLEAR

COUNTY WOOD

R.C. NIESE

TEMP. 65°

TOWNSHIP HENRY

DWG BY BARRIERE

PID 92133

SECTION 1

T 3 N R 10 E

TYPE MONUMENT MONBOX W/ 1" IPIN

ON SURFACE - BELOW ON

OFFSET Q PAVEMENT ON LT : RT


 TO EDGE PAVEMENT

STATION: 3+04.53


HORIZ.DATUM: NAD83(11)/WOOD LDP GEOID: 18

GRID: NORTHING: 575762.525 EASTING: 1650793.206

LDP: NORTHING: 397583.683 EASTING: 162585.951

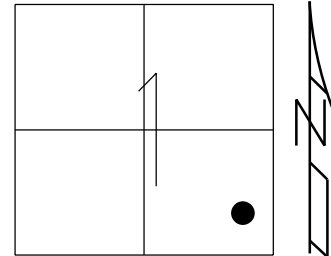

RECORD: P.T.
PLAN STA 3+00.02
SLM 0.58=30+62
3-22-91
FD MONBOX
4/12/01, DCH
FD MONBOX (NO LID)
W/ 3/4" IPIN
REFB0
3/17/22, JFO
FD NEW MONBOX
W/ 1" IPIN
SHOT WITH GPS,
DID NOT PULL TIES
NEWREFB0
11/16/23, TDN

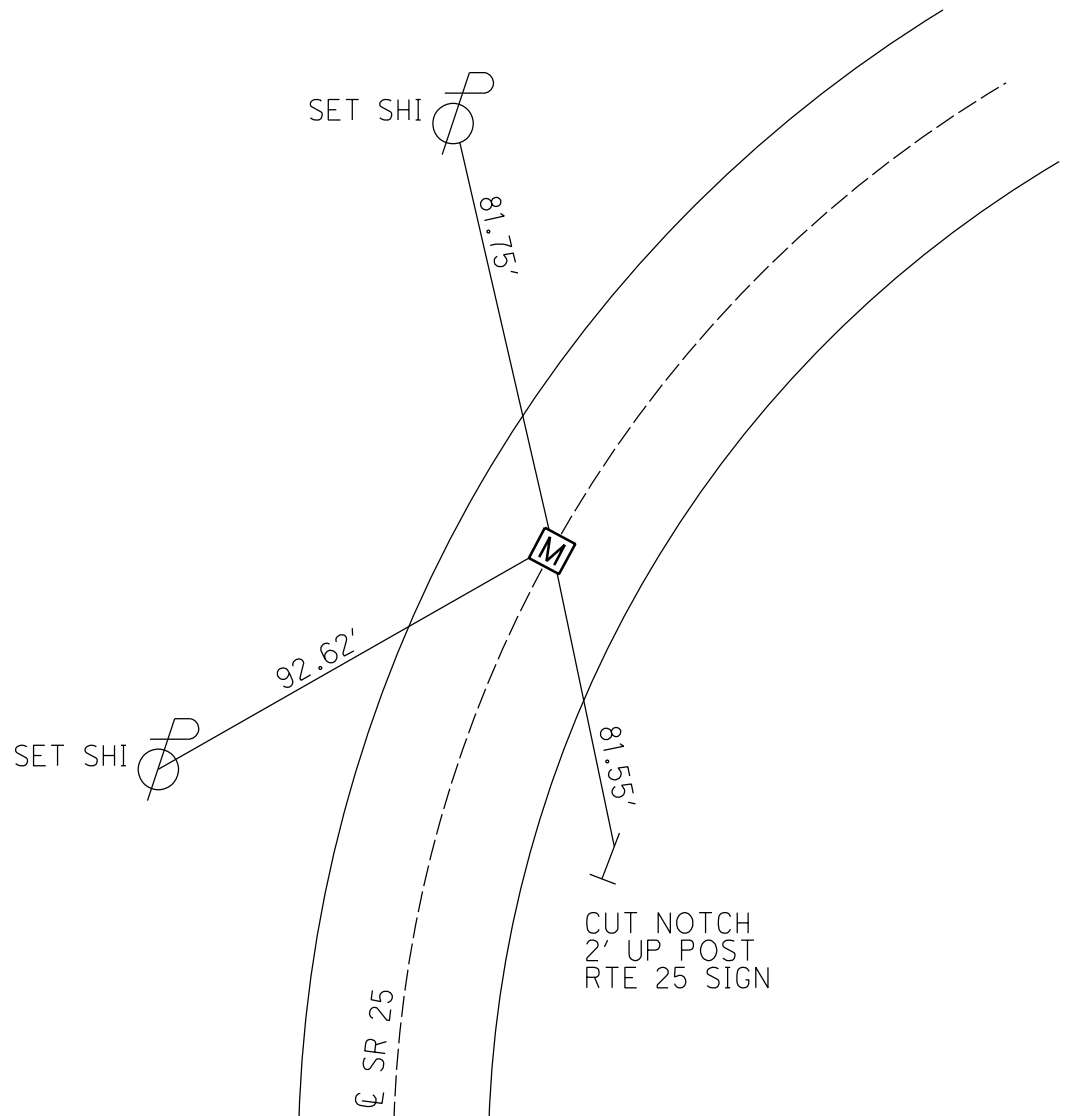

O.D.O.T. DISTRICT 2 SURVEY OFFICE (USE ONLY)

PERSONNEL

REFERENCE NO. CO

SHEET OF

NOTES NIESE
H.C. AUBLE
R.C. NIESE

DATE 11/16/23
WEATHER CLEAR
TEMP. 65°

ROUTE SR 25
COUNTY WOOD
TOWNSHIP HENRY
SECTION 1
T 3 N R 10 E

DWG BY BARRIERE PID 92133

TYPE MONUMENT MONBOX W/ 1" IPIN

ON SURFACE - BELOW ON

OFFSET $\varnothing$ PAVEMENT ON LT : RT


 TO EDGE PAVEMENT

STATION: 8+97.36


HORIZ.DATUM: NAD83(11)/WOOD LDP GEOID: 18

GRID: NORTHING: 576131.386 EASTING: 1651255.999

LDP: NORTHING: 397958.762 EASTING: 163043.876

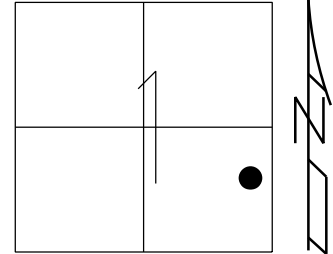

RECORD: P.C.
PLAN STA. 8+92.10
FD MONBOX
4/12/01, TMR
FD MONBOX (NO LID)
W/ 3/4" IPIN
REFCO
3/17/22, JFO
FD NEW MONBOX
W/ 1" IPIN
SHOT WITH GPS,
DID NOT PULL TIES
NEWREFCO
11/16/23, TDN

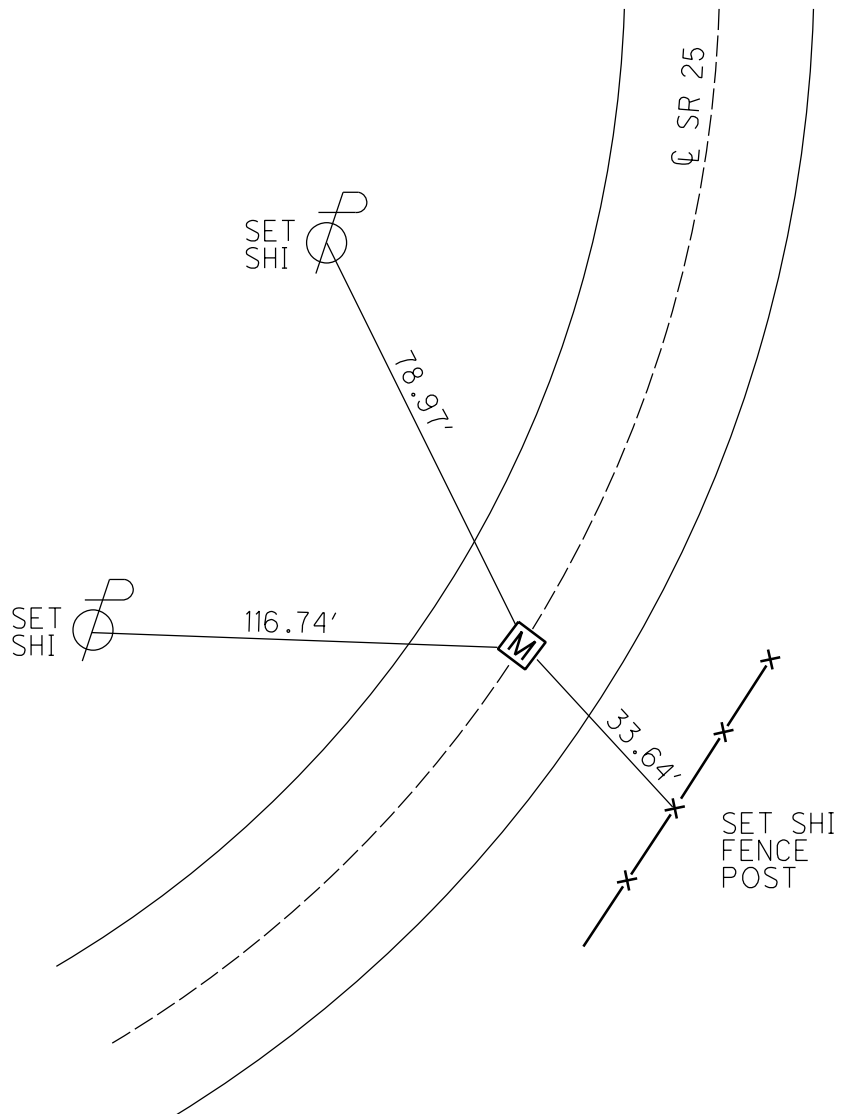

O.D.O.T. DISTRICT 2 SURVEY OFFICE (USE ONLY)

PERSONNEL

REFERENCE NO. D0

SHEET OF

NOTES NIESE

DATE 11/16/23

ROUTE SR 25

H.C. AUBLE

WEATHER CLEAR

COUNTY WOOD

R.C. NIESE

TEMP. 65°

TOWNSHIP HENRY

DWG BY BARRIERE

PID 92133

SECTION 1

T 3 N R 10 E

TYPE MONUMENT MONBOX W/ 1" IPIN

ON SURFACE - BELOW ON

OFFSET $\varnothing$ PAVEMENT ON LT : RT


 TO EDGE PAVEMENT

STATION: 16+51.70


HORIZ.DATUM: NAD83(11)/WOOD LDP GEOID: 18

GRID: NORTHING: 576725.210 EASTING: 1651709.299

LDP: NORTHING: 398558.560 EASTING: 163489.343

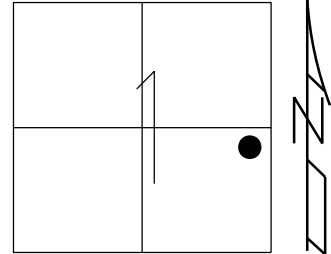

RECORD: P.C.
PLAN STA.16+47.10
FD MONBOX
4/12/01, TMR
FD MONBOX (NO LID)
W/ 3/4" IPIN
REFDO
3/17/22, JFO
FD NEW MONBOX
W/ 1" IPIN
SHOT WITH GPS,
DID NOT PULL TIES
NEWREFDO
11/16/23, TDN

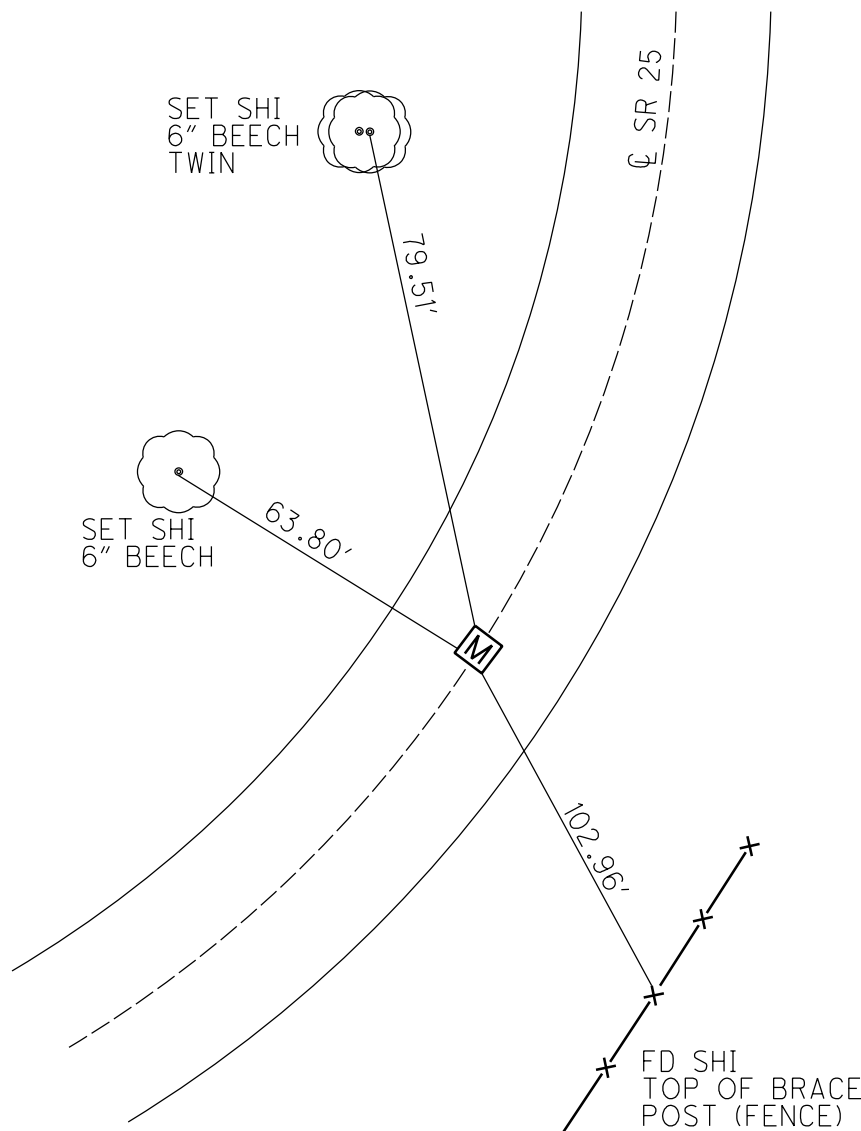

O.D.O.T. DISTRICT 2 SURVEY OFFICE (USE ONLY)

PERSONNEL

REFERENCE NO. E0

SHEET OF

NOTES ASTON

DATE 5/15/24

ROUTE SR 25

H.C. NIESE

WEATHER WINDY

COUNTY WOOD

R.C. PRESTON-COLVIN

TEMP. 65°

TOWNSHIP HENRY

DWG BY BARRIERE

PID 92133

SECTION 1

T 3 N R 10 E

TYPE MONUMENT MONBOX W/ 1" IPIN

ON SURFACE - BELOW 11" BELOW

OFFSET Q PAVEMENT 34' LT : RT


 TO EDGE PAVEMENT

STATION: 27+62.50


HORIZ.DATUM: NAD83(11)/WOOD LDP GEOID: 18

GRID: NORTHING: 577745.261 EASTING: 1652147.685

LDP: NORTHING: 399584.385 EASTING: 163914.276

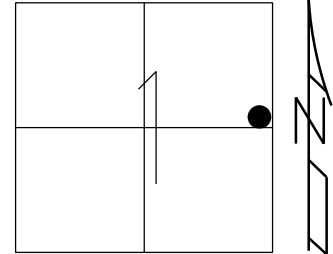

RECORD: P.C.
PLAN STA.27+57.77
FD MONBOX
4/12/01, TMR
FD MONBOX (NO LID)
W/ 3/4" IPIN
REFEO
3/17/22, JFO
FD NEW MONBOX
W/ 1" IPIN
SHOT WITH GPS,
DID NOT PULL TIES
NEWREFEO
11/16/23, TDN

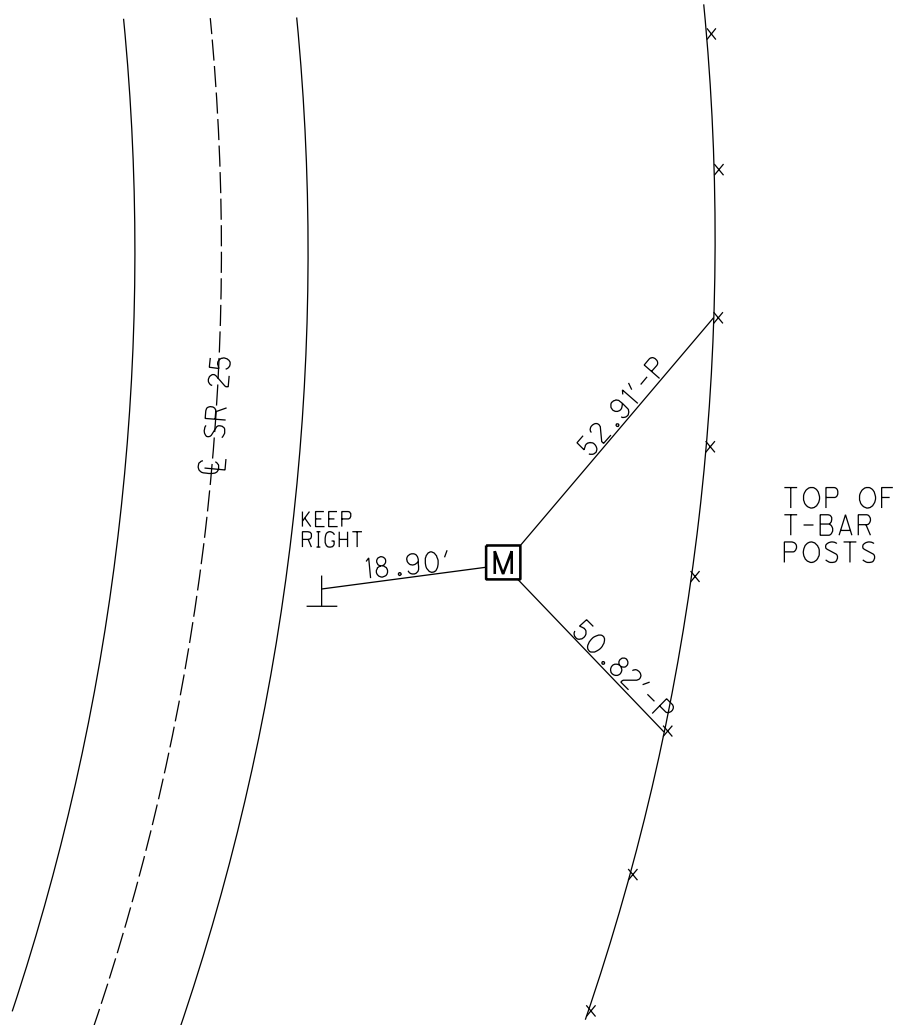

O.D.O.T. DISTRICT 2 SURVEY OFFICE (USE ONLY)

PERSONNEL

REFERENCE NO. F0

SHEET OF

NOTES NIESE

DATE 11/16/23

ROUTE SR 25

H.C. NIESE

WEATHER CLEAR

COUNTY WOOD

R.C. NIESE

TEMP. 65°

TOWNSHIP HENRY

DWG BY BARRIERE

PID 92133

SECTION 1

T 3 N R 10 E

TYPE MONUMENT 5/8' IPID

ON SURFACE - BELOW ON

OFFSET Q PAVEMENT ON (?) LT : RT


 TO EDGE PAVEMENT

STATION: 32+03.74


HORIZ.DATUM: NAD83(11)/WOOD LDP GEOID: 18

GRID: NORTHING: 578172.939 EASTING: 1652240.682

LDP: NORTHING: 400013.288 EASTING: 164001.633

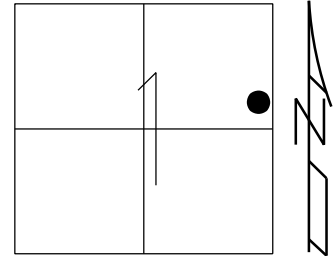

RECORD: P.T.
PLAN STA. 31+97.77
FD MONBOX
4/12/01, SAH
FD MONBOX (NO LID)
W/ 3/4" IPIN
REFFO
3/17/22, JFO
D.N.F.
SET 5/8" IPID
"ODOT CL"
11/16/23, TDN

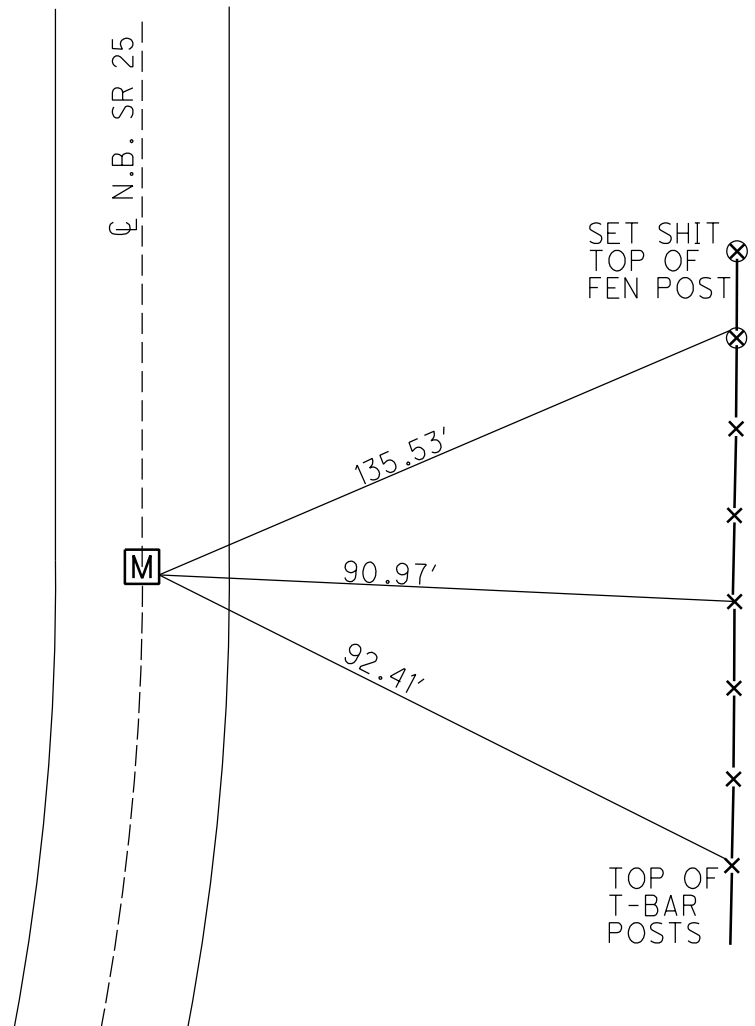

O.D.O.T. DISTRICT 2 SURVEY OFFICE (USE ONLY)

PERSONNEL

REFERENCE NO. 1

SHEET OF

NOTES ASTON

DATE 5/15/24

ROUTE SR 25

H.C. NIESE

WEATHER BREEZY

COUNTY WOOD

R.C. PRESTON-COLVIN

TEMP. 65°

TOWNSHIP BLOOM

DWG BY BARRIERE

PID 92133

SECTION 6

T 3 N R 11 E

TYPE MONUMENT MONBOX W/ 1" IPIN

ON SURFACE - BELOW ON

OFFSET $\varnothing$ PAVEMENT ON LT : RT


 TO EDGE PAVEMENT

STATION: 54+00.29


HORIZ.DATUM: NAD83(11)/WOOD LDP GEOID: 18

GRID: NORTHING: 580369.977 EASTING: 1652283.680

LDP: NORTHING: 402210.879 EASTING: 164015.659

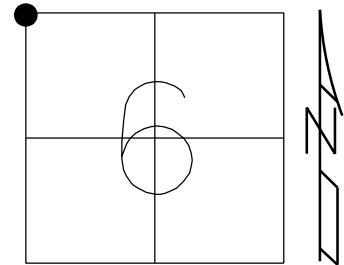

RECORD:
 $\varnothing$ PAVEMENT
 1958
 FD P.K./WASHER
 4/12/01, TMR
 SET PK/WASHER
 10-29-01, SAH
 FD P.K.NAIL
 REF1
 5-30-18
 10-1-18, JFO
 FD MAG NAIL ATOP
 BRASS DISK
 REF1
 3/17/22, JFO
 ORIGIN UNKNOWN
 FD NEW MONBOX
 W/ 1" IPIN
 NEWREF1
 CHECKED WITH GPS
 DID NOT PULL TIES
 11/16/23, TDN
 FD MONBOX
 W/ 1" IPIN
 CKREF1
 5/15/24, TDN

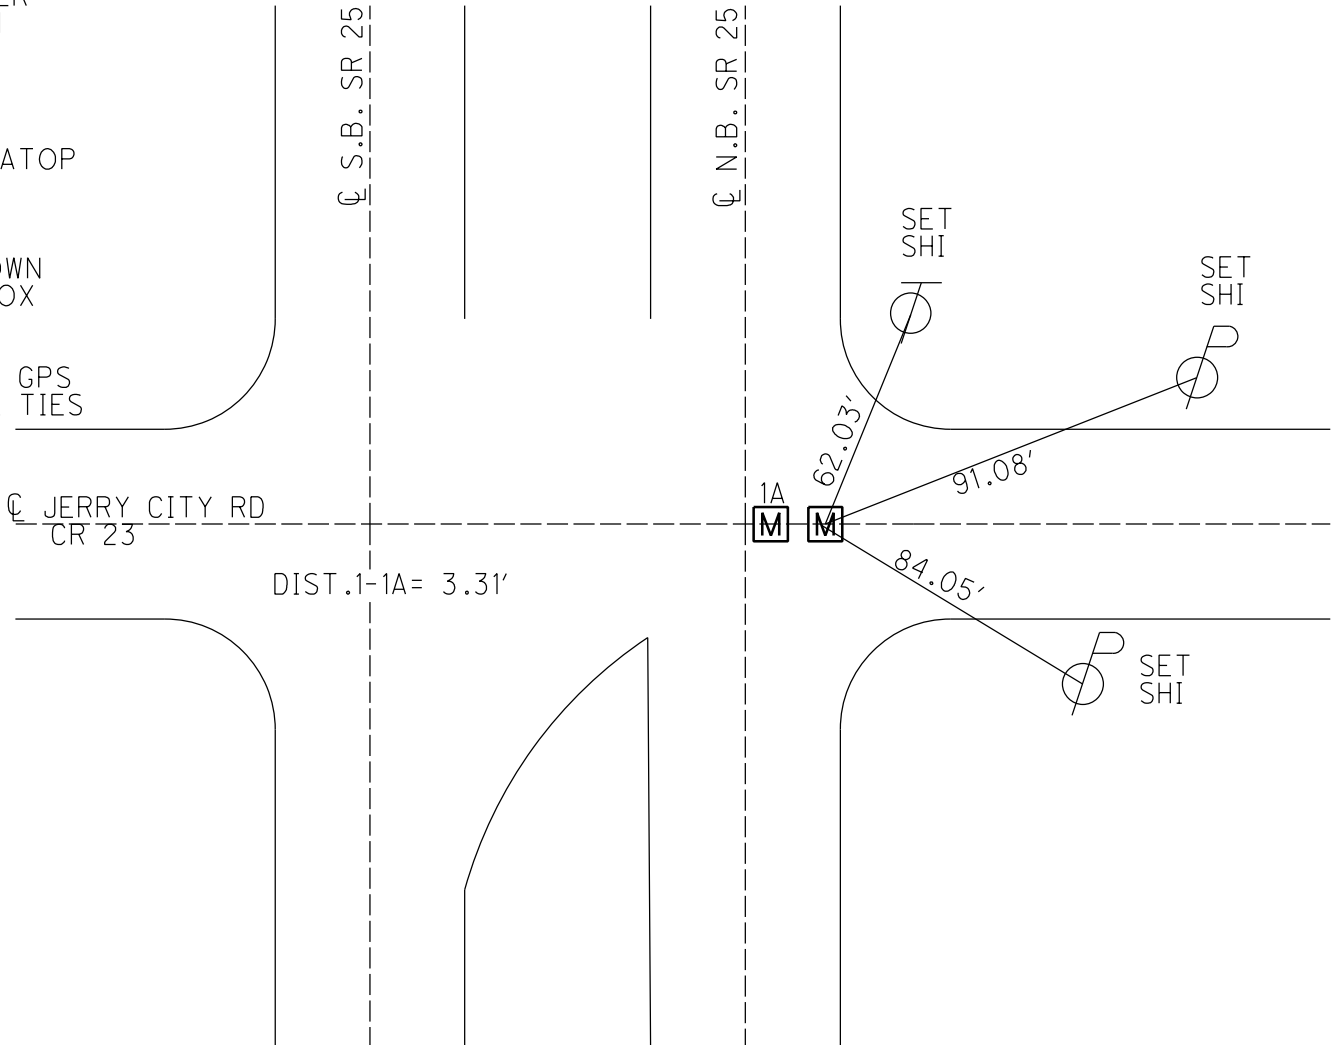

O.D.O.T. DISTRICT 2 SURVEY OFFICE (USE ONLY)

PERSONNEL

REFERENCE NO. 1A

SHEET OF

NOTES NIESE
H.C. NIESE
R.C. AUBLE

DATE 11/16/23
WEATHER BREEZY
TEMP. 65°

ROUTE SR 25
COUNTY WOOD
TOWNSHIP HENRY
SECTION 1
T 3 N R 10 E

DWG BY BARRIERE PID 92133

TYPE MONUMENT MONBOX W/ 1" IPIN

ON SURFACE - BELOW ON

OFFSET $\varnothing$ PAVEMENT ON LT : RT


 TO EDGE PAVEMENT

STATION: 54+00.29

HORIZ.DATUM: NAD83(11)/WOOD LDP GEOID: 18


GRID: NORTHING: 580369.979 EASTING: 1652280.427

LDP: NORTHING: 402210.838 EASTING: 164012.406

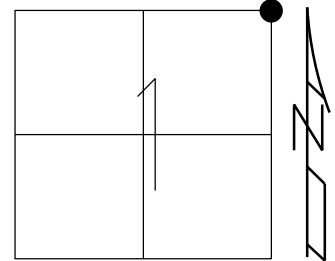

RECORD:

$\varnothing$ R/W,
36 SEC COR
FD P.K./WASHER
4/12/01, TMR
SET PK/WASHER
10-29-01, SAH
FD HOLE
REFA1
5-30-18, JFO
10-1-18, JFO
FD BRASS DISK
3 1/2" DOWN
REFA1
3/17/22, JFO
FD NEW MONBOX
W/ 1" IPIN
NEWREF1
CHECKED WITH GPS
DID NOT PULL TIES
11/16/23, TDN
FD MONBOX
W/ 1" IPIN
CKREFA1
11/16/23, TDN

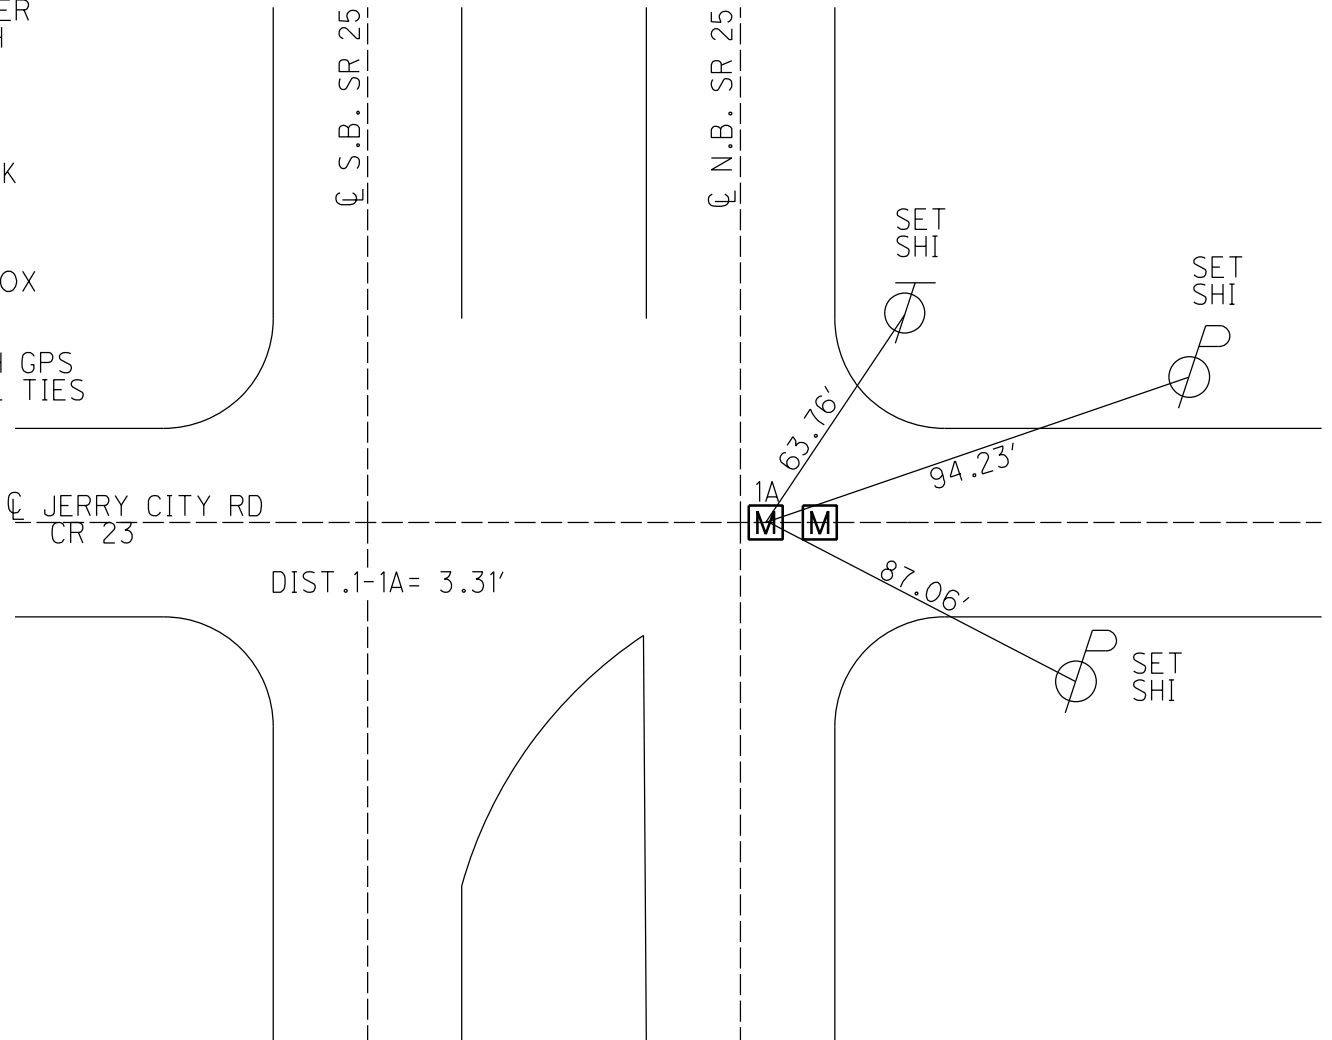

O.D.O.T. DISTRICT 2 SURVEY OFFICE (USE ONLY)

PERSONNEL

REFERENCE NO. 2/2A

SHEET _____ OF _____

NOTES NIESE
H.C. NIESE
R.C. AUBLE

DATE 11/16/23
WEATHER CLEAR
TEMP. 65°

ROUTE SR 25
COUNTY WOOD
TOWNSHIP HENRY
SECTION 36

DWG BY BARRIERE PID 92133

T 4 N R 10 E

TYPE MONUMENT MONBOX W/ 1" IPIN

ON SURFACE - BELOW ON

OFFSET $\varnothing$ PAVEMENT 15.5' RT LT : RT


TO EDGE PAVEMENT

STATION: 80+34.92

HORIZ.DATUM: NAD83(11)/WOOD LDP GEOID: 18

GRID: NORTHING: 583004.226 EASTING: 1652316.766

LDP: NORTHING: 404845.547 EASTING: 164014.008

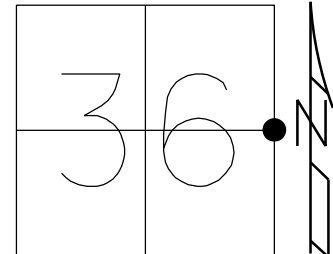

RECORD: P.I.
E 1/4 COR. SEC 36

FD P.K./WASHER
4/12/01, TMR
SET P.K./WASHER
10-29-01, SAH
FD P.K./WASHER
REF2
5-30-18, JFO
10-1-18, JFO
FD P.K. NAIL
REF2
3/17/22, JFO
FD MAG NAIL
REFA2
FD NEW MONBOX W/ 1" IPIN
CHECKED W/ GPS
DID NOT PULL TIES
NEWREF2
11/16/23, TDN
FD NEW MONBOX W/ 1" IPIN
CHECKED W/ GPS
POINT ESTABLISHED PER
PID 92133 PLANS
NEWREF2A
11/16/23, TDN

FD
SHI 

$\varnothing$ S.B. SR 25

$\varnothing$ N.B. SR 25

SET MAG NAIL
BY GPS
(ORIGIN UNKNOWN)

DIST. 2-2B= 65.62'

FD MONBOX
W/ 1" IPIN

FD MONBOX
W/ 1" IPIN



O.D.O.T. DISTRICT 2 SURVEY OFFICE (USE ONLY)

PERSONNEL

REFERENCE NO. 3

SHEET OF

NOTES ASTON

DATE 5/21/24

ROUTE SR 25

H.C. NIESE

WEATHER CLEAR

COUNTY WOOD

R.C. PRESTON-COLVIN

TEMP. 85°

TOWNSHIP HENRY

SECTION 36

DWG BY BARRIERE

PID 92133

T 4 N R 10 E

TYPE MONUMENT MONBOX W/ 1" IPIN

ON SURFACE - BELOW ON

OFFSET $\oslash$ PAVEMENT 15.5' RT LT : RT


 TO EDGE PAVEMENT

STATION: 106+73.29

HORZ.DATUM: NAD83(11)/WOOD LDP GEOID: 18


GRID: NORTHING: 585642.045 EASTING: 1652353.558

LDP: NORTHING: 407483.832 EASTING: 164016.016

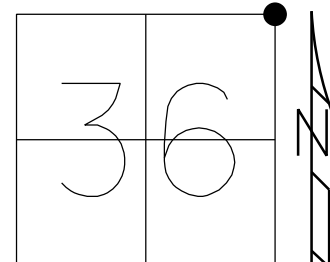

RECORD: P.I.
N.E. COR. SEC 36

FD P.K./WASHER
4/12/01, TMR
SET P.K./WASHER
10-31-01, SAH
FD P.K.NAIL
REF3
5-30-18
10-1-18, JFO
FD BRASS DISK
FD MAG NAIL
REF3
3/17/22, JFO
FD NEW MONBOX
W/ 1" IPIN
CHECKED W/ GPS
DID NOT PULL TIES
NEWREF3
11/16/23, TDN
CHECKED TIES
5/21/24, TDN

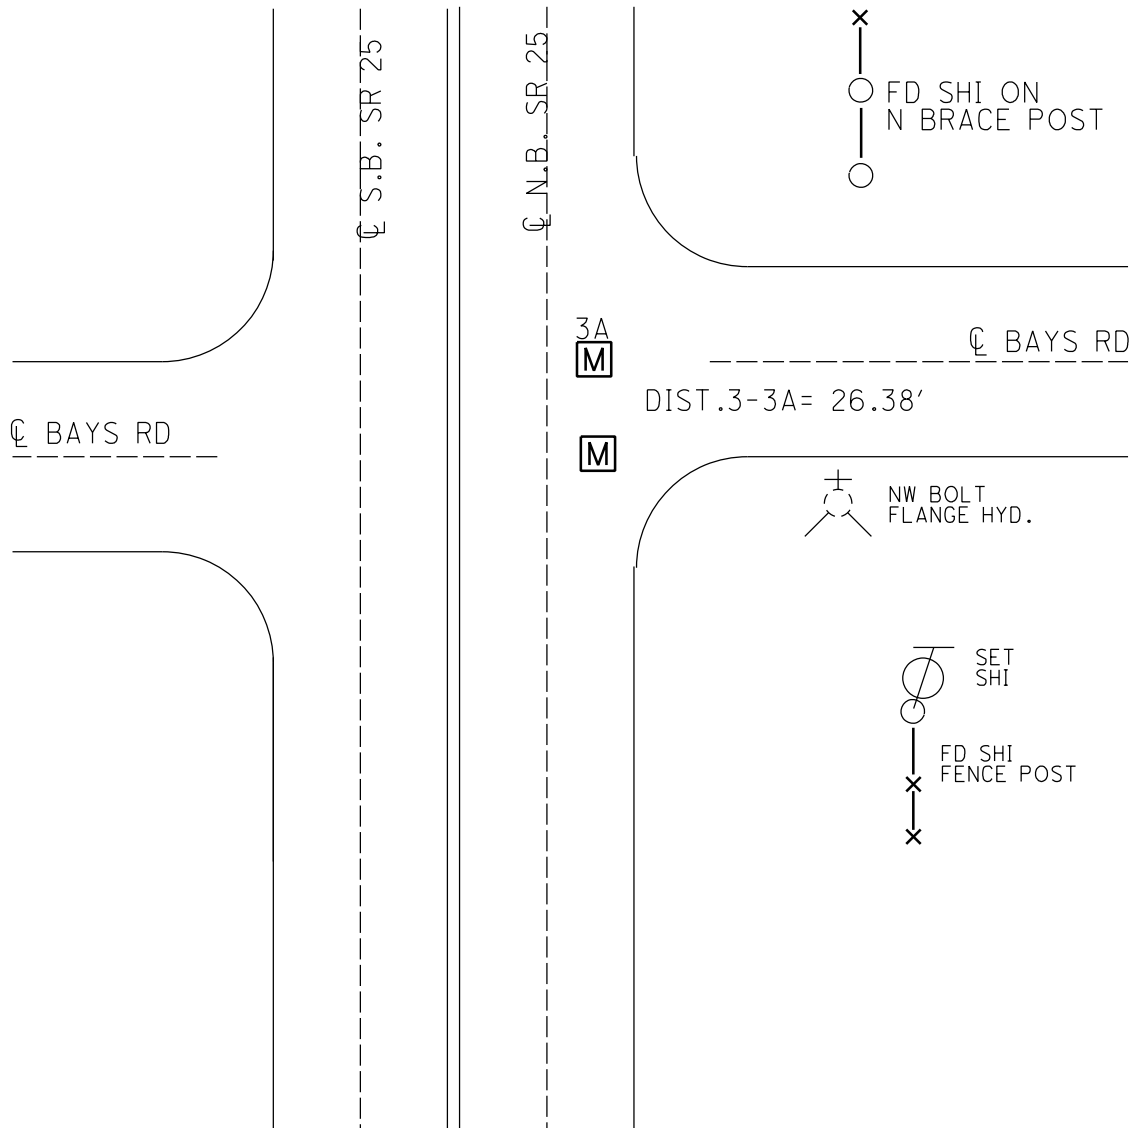

O.D.O.T. DISTRICT 2 SURVEY OFFICE (USE ONLY)

PERSONNEL

REFERENCE NO. 3A

SHEET OF

NOTES NIESE
H.C. NIESE
R.C. AUBLE

DATE 11/16/23
WEATHER WINDY
TEMP. 65°

ROUTE SR 25
COUNTY WOOD
TOWNSHIP PORTAGE
SECTION 36

DWG BY BARRIERE PID 92133

T 4 N R 11 E

TYPE MONUMENT MONBOX W/ 1" IPIN

ON SURFACE - BELOW ON

OFFSET $\varnothing$ PAVEMENT 1' RT OF EP LT : RT


 TO EDGE PAVEMENT

STATION: 106+99.59

HORIZ.DATUM: NAD83(11)/WOOD LDP GEOID: 18


GRID: NORTHING: 585668.432 EASTING: 1652353.638

LDP: NORTHING: 407510.220 EASTING: 164015.749

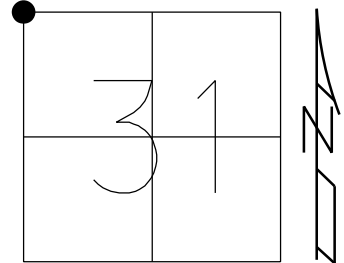

RECORD:
N.W. COR. SEC 31

SET PK/WASHER
10-31-01, SAH
FD PK NAIL
RECA3
5-30-18, JFO
FD PK
REFA3
10-1-18, JFO
FD BRASS DISK
FD MAG NAIL
REFA3
3-17-22, JFO
FD NEW MONBOX
W/ 1" IPIN
NEWREFA3
11/16/23, TDN

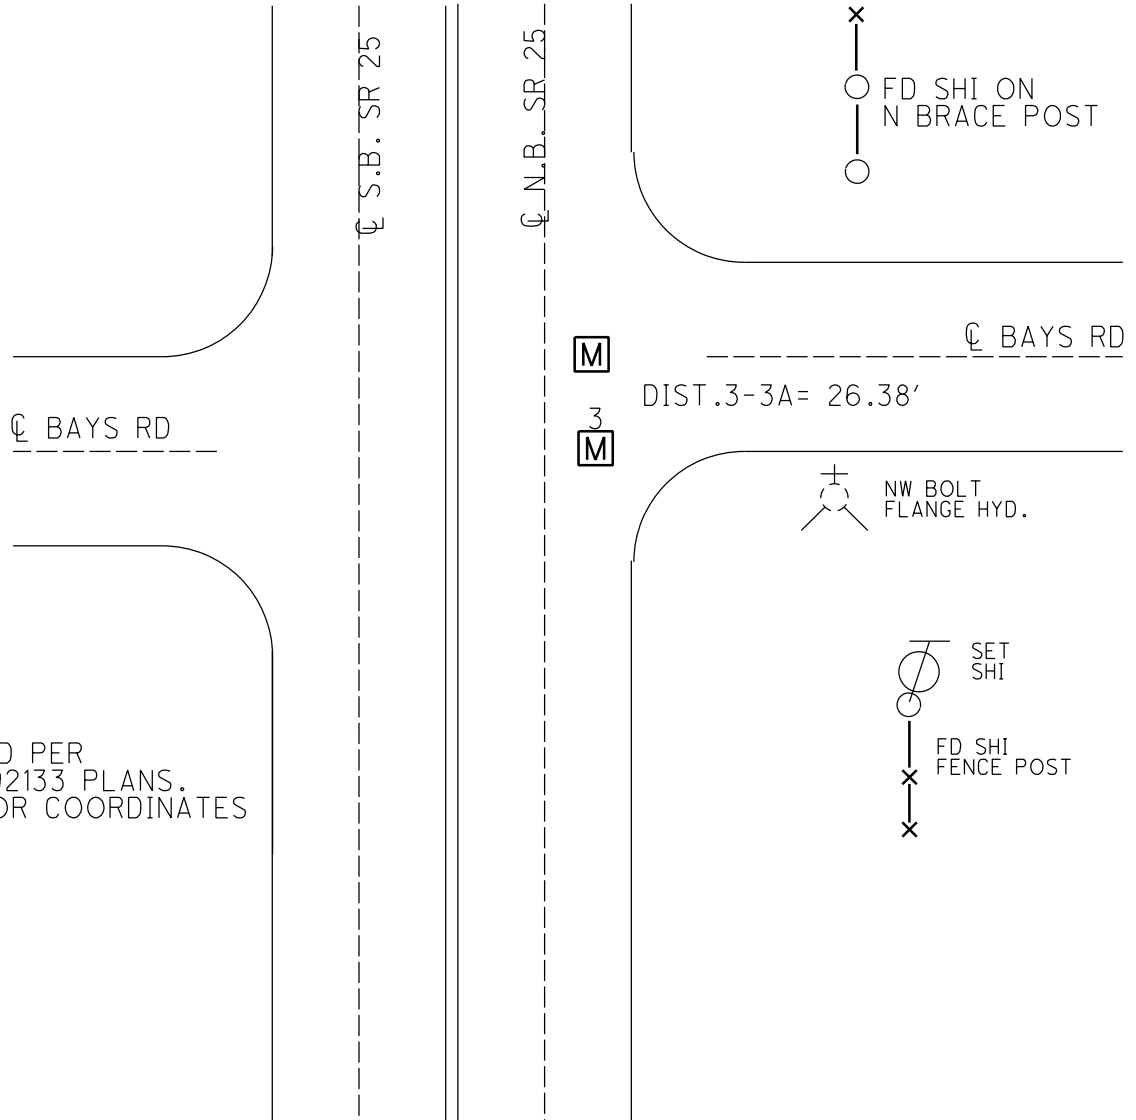

****NOTE****
POINT WAS ADJUSTED PER
WOO-25-0.75, PID 92133 PLANS.
SEE PLANS FOR PRIOR COORDINATES
AND INFORMATION.
**** ****

O.D.O.T. DISTRICT 2 SURVEY OFFICE (USE ONLY)

PERSONNEL

REFERENCE NO. 4

SHEET OF

NOTES ASTON
H.C. NIESE
R.C. MILLER

DATE 11/15/23
WEATHER CLEAR
TEMP. 60°

ROUTE SR 25
COUNTY WOOD
TOWNSHIP LIBERTY
SECTION 25

DWG BY BARRIERE PID 92133

T 4 N R 10 E

TYPE MONUMENT MAG NAIL/WASHER

ON SURFACE - BELOW ON

OFFSET $\varnothing$ PAVEMENT 19' RT LT : RT


 TO EDGE PAVEMENT

STATION: 128+56.31

HORZ.DATUM: NAD83(11)/WOOD LDP GEOID: 18

GRID: NORTHING: EASTING:


LDP: NORTHING: 409666.841 EASTING: 164001.557

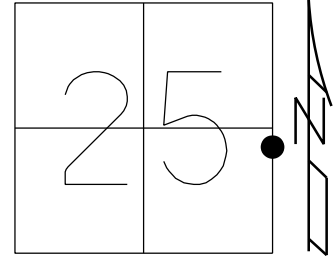

RECORD:

FD P.K./WASHER
4/12/01, TMR
SET P.K./WASHER
10-31-01, SAH
FD P.K./SHANK
REF 4
5-30-18, JFO
SET MAG/WASHER
10-1-18, JFO
FD MAG NAIL
REF 4
3/17/22, JFO
SET MAG/WASHER
11/15/23, TDN

TOP BONNET
BOLT HYD

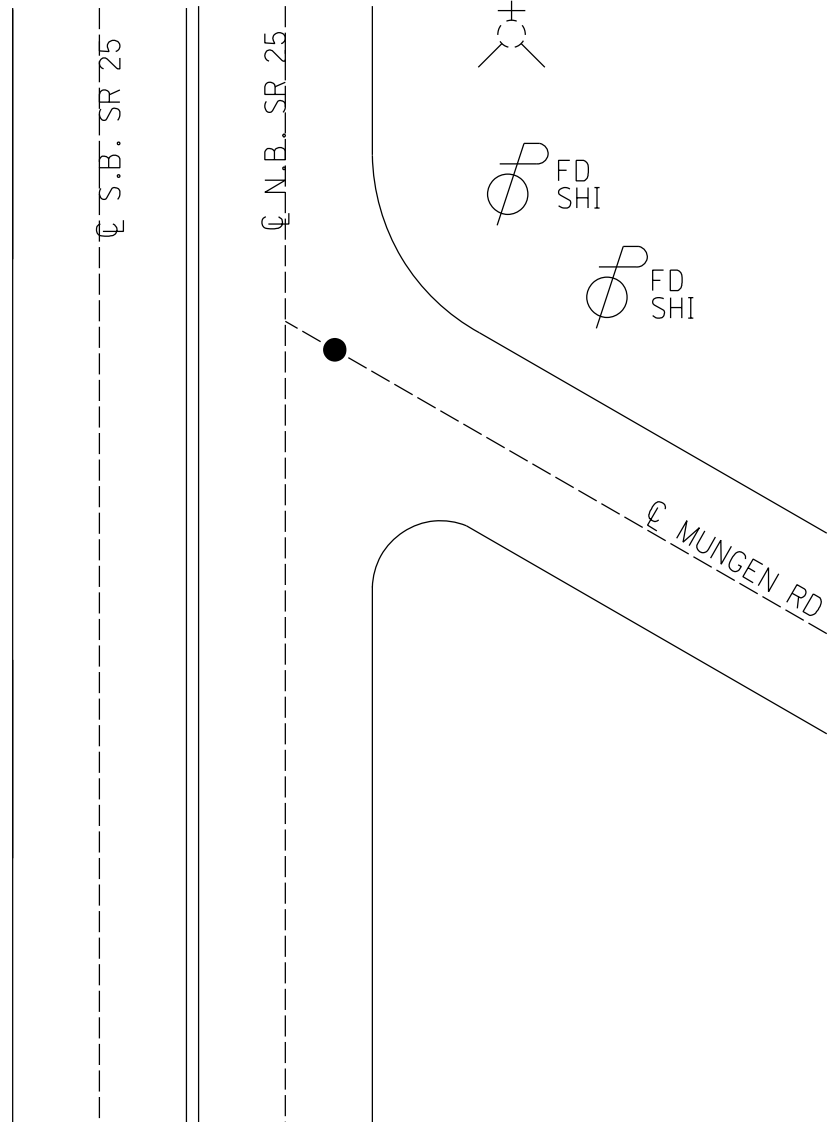

O.D.O.T. DISTRICT 2 SURVEY OFFICE (USE ONLY)

PERSONNEL

REFERENCE NO. 5

SHEET OF

NOTES NIESE
H.C. ASTON
R.C. ASTON

DATE 11/20/23
WEATHER CLEAR
TEMP. 37°

ROUTE SR 25
COUNTY WOOD
TOWNSHIP PORTAGE
SECTION 25

DWG BY BARRIERE PID 92133

T 4 N R 11 E

TYPE MONUMENT MONBOX W/ 1" IPIN

ON SURFACE - BELOW ON

OFFSET Q PAVEMENT 19.6' RT LT : RT


 TO EDGE PAVEMENT

STATION: 133+25.93

HORIZ.DATUM: NAD83(11)/WOOD LDP GEOID: 18

GRID: NORTHING: 588294.446 EASTING: 1652370.907

LDP: NORTHING: 410136.442 EASTING: 163998.389

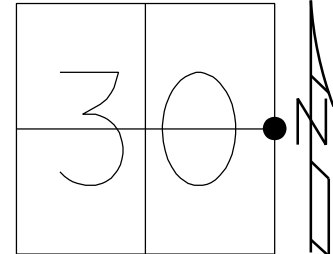

RECORD: P.I.
E 1/4 SEC 25

STA.403+07.8
FD BRASS MON
FD P.K./WASHER
4/12/01, TMR
SET P.K./WASHER
10-31-01, SAH
D.N.F POINT
FD HOLE
REF5
5-30-18
10-1-18, JFO
FD BRASS DISK
FD MAG NAIL
REF5
3/17/22, JFO
FD NEW MONBOX
W/ 1" IPIN
CHECKED W/ GPS
DID NOT PULL TIES
NEWREF5
11/20/23, TDN

FD SHI
FENCE POST

GRAVEL DRIVE

Q S.B. SR 25

Q N.B. SR 25

SET MAG NAIL
BY GPS
(ORIGIN UNKNOWN)

FD MONBOX
W/ 1" IPIN

DIST. 5-5A=5.30'

FD MONBOX
W/ 1" IPIN



O.D.O.T. DISTRICT 2 SURVEY OFFICE (USE ONLY)

PERSONNEL

REFERENCE NO. 5A

SHEET OF

NOTES NIESE
H.C. NIESE
R.C. ASTON

DATE 11/20/23
WEATHER CLEAR
TEMP. 37°

ROUTE SR 25
COUNTY WOOD
TOWNSHIP LIBERTY
SECTION 25

DWG BY BARRIERE PID 92133

T 4 N R 10 E

TYPE MONUMENT MONBOX W/ 1" IPIN

ON SURFACE - BELOW ON

OFFSET Q PAVEMENT 19.6' RT LT : RT


 TO EDGE PAVEMENT

STATION: 133+20.64

HORIZ.DATUM: NAD83(11)/WOOD LDP GEOID: 18

GRID: NORTHING: 588289.188 EASTING: 1652370.795

LDP: NORTHING: 410131.183 EASTING: 163998.347

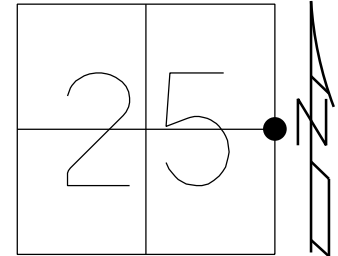

RECORD:
W 1/4 SEC 30

ORIGIN UNKNOWN
FD P.K.NAIL
4/12/01, TMR
SET P.K./WASHER
10-31-01, SAH
D.N.F POINT
FD HOLE
REFA5
5-30-18
10-1-18, JFO
FD PK NAIL
FD MAG NAIL
REFA5
3-17-22, JFO
FD NEW MONBOX
W/ 1" IPIN
POINT WAS ADJUSTED
PER WOO-25-0.75, PID 92133 PLANS.
SEE PLANS FOR PRIOR COORD.
AND INFORMATION
NEWREF5A
11/20/23, TDN

FD SHI
FENCE POST

GRAVEL DRIVE

Q S.B. SR 25

Q N.B. SR 25

SET MAG NAIL
BY GPS
(ORIGIN UNKNOWN)

FD MONBOX
W/ 1" IPIN

DIST. 5-5A=5.30'

FD MONBOX
W/ 1" IPIN

****NOTE****
NEW LOCATION.
REFERENCE TIES DO NOT MATCH

O.D.O.T. DISTRICT 2 SURVEY OFFICE (USE ONLY)

PERSONNEL

REFERENCE NO. 6

SHEET OF

NOTES NIESE

DATE 11/16/23

ROUTE SR 25

H.C. NIESE

WEATHER WINDY

COUNTY WOOD

R.C. AUBLE

TEMP. 65°

TOWNSHIP PORTAGE

DWG BY BARRIERE

PID 92133

SECTION 19

T 4 N R 11 E

TYPE MONUMENT MONBOX W/ 1" IPIN

ON SURFACE - BELOW ON

OFFSET $\varnothing$ PAVEMENT 30' RT LT : RT


 TO EDGE PAVEMENT

STATION: 159+52.39

HORIZ.DATUM: NAD83(11)/WOOD LDP GEOID: 18

GRID: NORTHING: 590920.704 EASTING: 1652388.808


LDP: NORTHING: 412762.916 EASTING: 163981.659

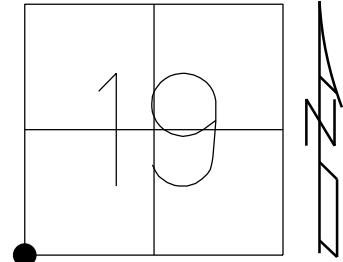

RECORD:
NW COR. SEC. 30

STA.429+39.2
FD BRASS MON
FD P.K./WASHER
4/12/01, TMR
SET P.K./WASHER
10-31-01, SAH
D.N.F
SHOT CNTR TIES
REF6
5-30-18
10-1-18, JFO
FD BRASS DISK
FD NEW MONBOX
W/ 1" IPIN
NEWREF6
11/20/23, TDN $\varnothing$ CR 281

****NOTE****
POINT WAS ADJUSTED PER
WOO-25-0.75, PID 92133
PLANS. SEE PLANS FOR
PRIOR COORDINATES
AND INFORMATION.
**** ****

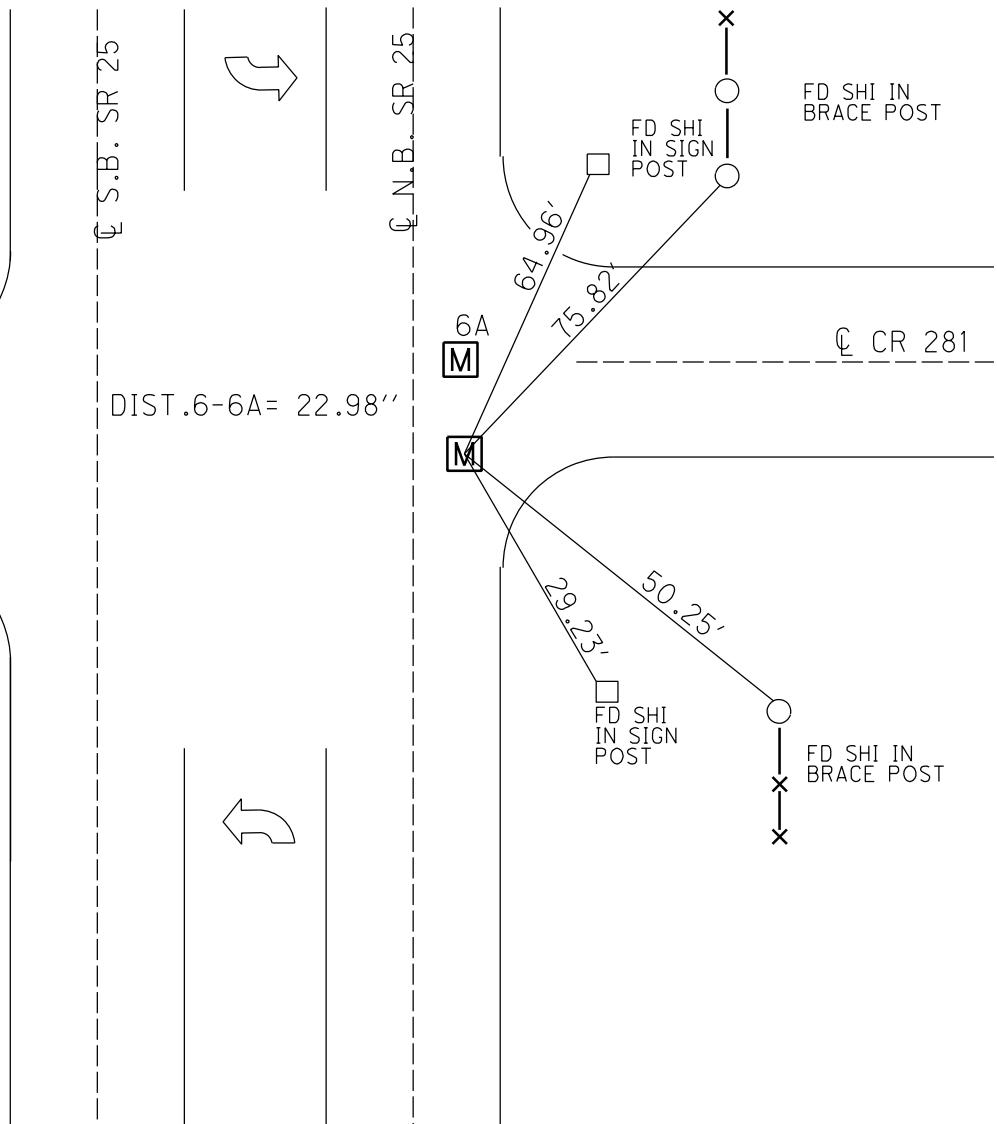

O.D.O.T. DISTRICT 2 SURVEY OFFICE (USE ONLY)

PERSONNEL

REFERENCE NO. A6

SHEET OF

NOTES NIESE

DATE 11/16/23

ROUTE SR 25

H.C. NIESE

WEATHER WINDY

COUNTY WOOD

R.C. AUBLE

TEMP. 65°

TOWNSHIP PORTAGE

DWG BY BARRIERE

PID 92133

SECTION 19

T 4 N R 11 E

TYPE MONUMENT MONBOX W/ 1" IPIN

ON SURFACE - BELOW ON

OFFSET $\varnothing$ PAVEMENT 30' RT LT : RT


 TO EDGE PAVEMENT

STATION: 159+75.34

HORZ.DATUM: NAD83(11)/WOOD LDP GEOID: 18


GRID: NORTHING: 590943.642 EASTING: 1652388.969

LDP: NORTHING: 412785.856 EASTING: 163981.517

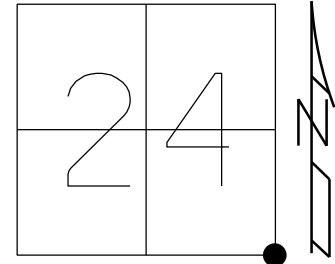

RECORD: P.I.
NE COR. SEC. 25

STA.429+61.952
FD BRASS MON
FD P.K./WASHER
4/12/01, TMR
SET P.K./WASHER
10-31-01, SAH
D.N.F
SHOT CNTR TIES
REFA6
5-30-18
10-1-18, JFO
FD BRASS DISK
FD NEW MONBOX
W/ 1" IPIN
CHECKED W/ GPS
DID NOT PULL TIES
NEWREFA6
11/20/23, TDN

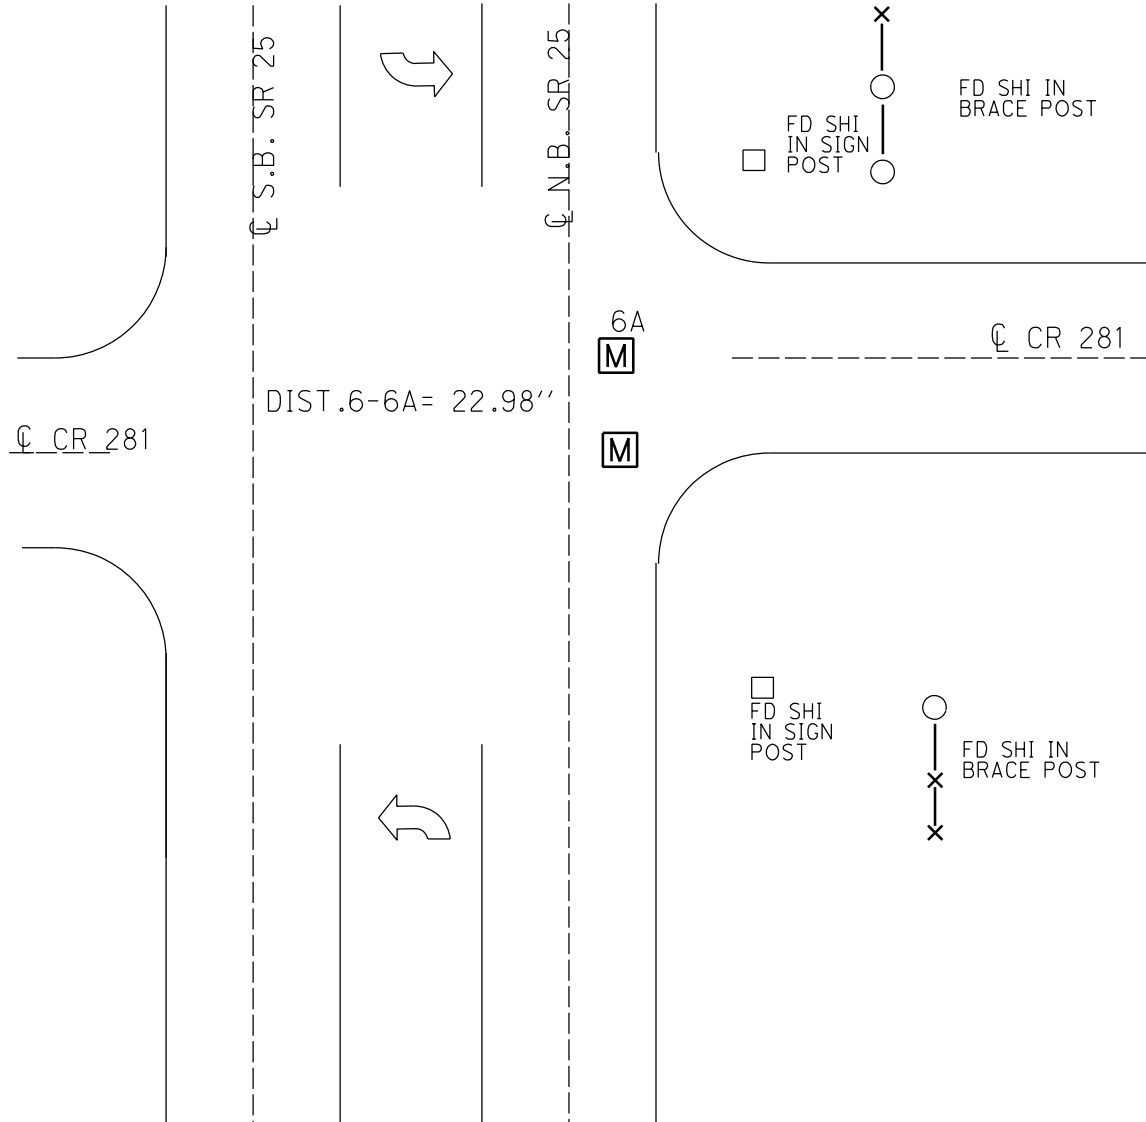

****NOTE****
POINT WAS ADJUSTED PER
WOO-25-0.75, PID 92133
PLANS. SEE PLANS FOR
PRIOR COORDINATES
AND INFORMATION.
**** ****

O.D.O.T. DISTRICT 2 SURVEY OFFICE (USE ONLY)

PERSONNEL

REFERENCE NO. 7/B6

SHEET OF

NOTES NIESE
H.C. NIESE
R.C. ASTON

DATE 11/20/23
WEATHER CLEAR
TEMP. 37°

ROUTE SR 25
COUNTY WOOD
TOWNSHIP LIBERTY
SECTION 25

DWG BY BARRIERE PID 92133

T 4 N R 10 E

TYPE MONUMENT MONBOX W/ 1" IPIN

ON SURFACE - BELOW ON

OFFSET Q PAVEMENT 23.8' RT LT : RT


 TO EDGE PAVEMENT

STATION: 185+87.60

HORIZ.DATUM: NAD83(11)/WOOD LDP GEOID: 18

GRID: NORTHING: 593555.721 EASTING: 1652404.879

LDP: NORTHING: 415398.123 EASTING: 163962.983

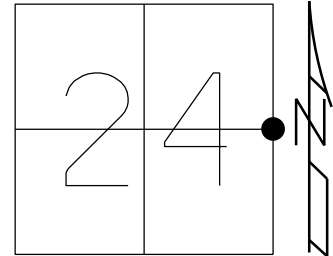


RECORD: P.I.
E 1/4 SEC 24

RECORD:

STA.466+74.5
FD BRASS MON
FD P.K./WASHER
4/12/01, TMR
SET P.K./WASHER
10-31-01, SAH
FD HOLE
REF7
5-30-18, JFO
FD MAG NAIL
SET BY OTHERS
NEWREF7
10-1-18, JFO
FD BRASS DISK
FD MAG NAIL
REF 7
3-17-22, JFO
FD NEW MONBOX
W/ 1" IPIN
CHECKED W/ GPS
DID NOT PULL TIES
NEWREF7
11/20/23, TDN

WOOD LDP
N 415325.176
E 163963.500

FD NEW MONBOX
W/ 1" IPIN
NEWREFB6
11/20/23, TDN

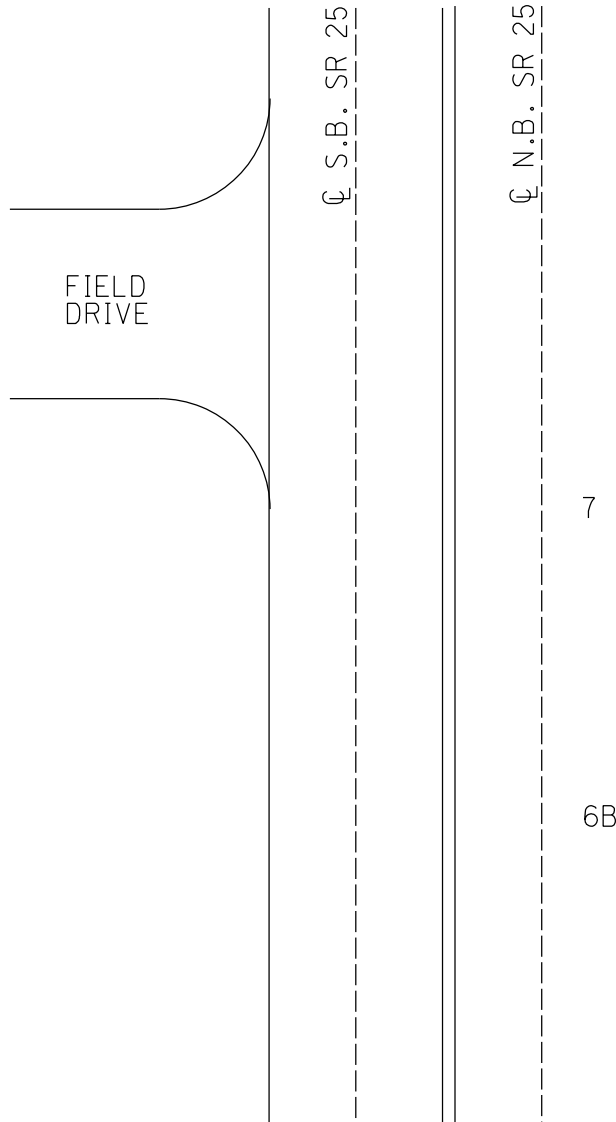

O.D.O.T. DISTRICT 2 SURVEY OFFICE (USE ONLY)

PERSONNEL

REFERENCE NO. 8

SHEET OF

NOTES NIESE

DATE 11/20/23

ROUTE SR 25

H.C. NIESE

WEATHER CLEAR

COUNTY WOOD

R.C. ASTON

TEMP. 37°

TOWNSHIP PORTAGE

DWG BY BARRIERE

PID 92133

SECTION 13

T 4 N R 10 E

TYPE MONUMENT MONBOX W/ 1" IPIN

ON SURFACE - BELOW ON

OFFSET $\varnothing$ PAVEMENT 30' RT LT : RT


 TO EDGE PAVEMENT

STATION: 212+84.79

HORIZ.DATUM: NAD83(11)/WOOD LDP GEOID: 18


GRID: NORTHING: 596252.573 EASTING: 1652424.557

LDP: NORTHING: 418095.210 EASTING: 163947.099

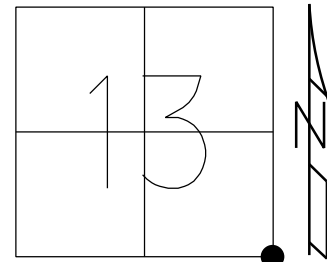

RECORD: P.I.
STA.482+71.65

FD BRASS MON
FD P.K./WASHER
4/12/01, TMR
SET P.K./WASHER
10-31-01, SAH
TIES DID NOT "x"
D.N.F.
5-30-18, JFO
FD BRASS DISK
4" DOWN
REF8
3-17-22, JFO
FD NEW MONBOX
W/ 1" IPIN
CHECKED W/ GPS
DID NOT PULL TIES
NEWREF8
11/20/23, TDN

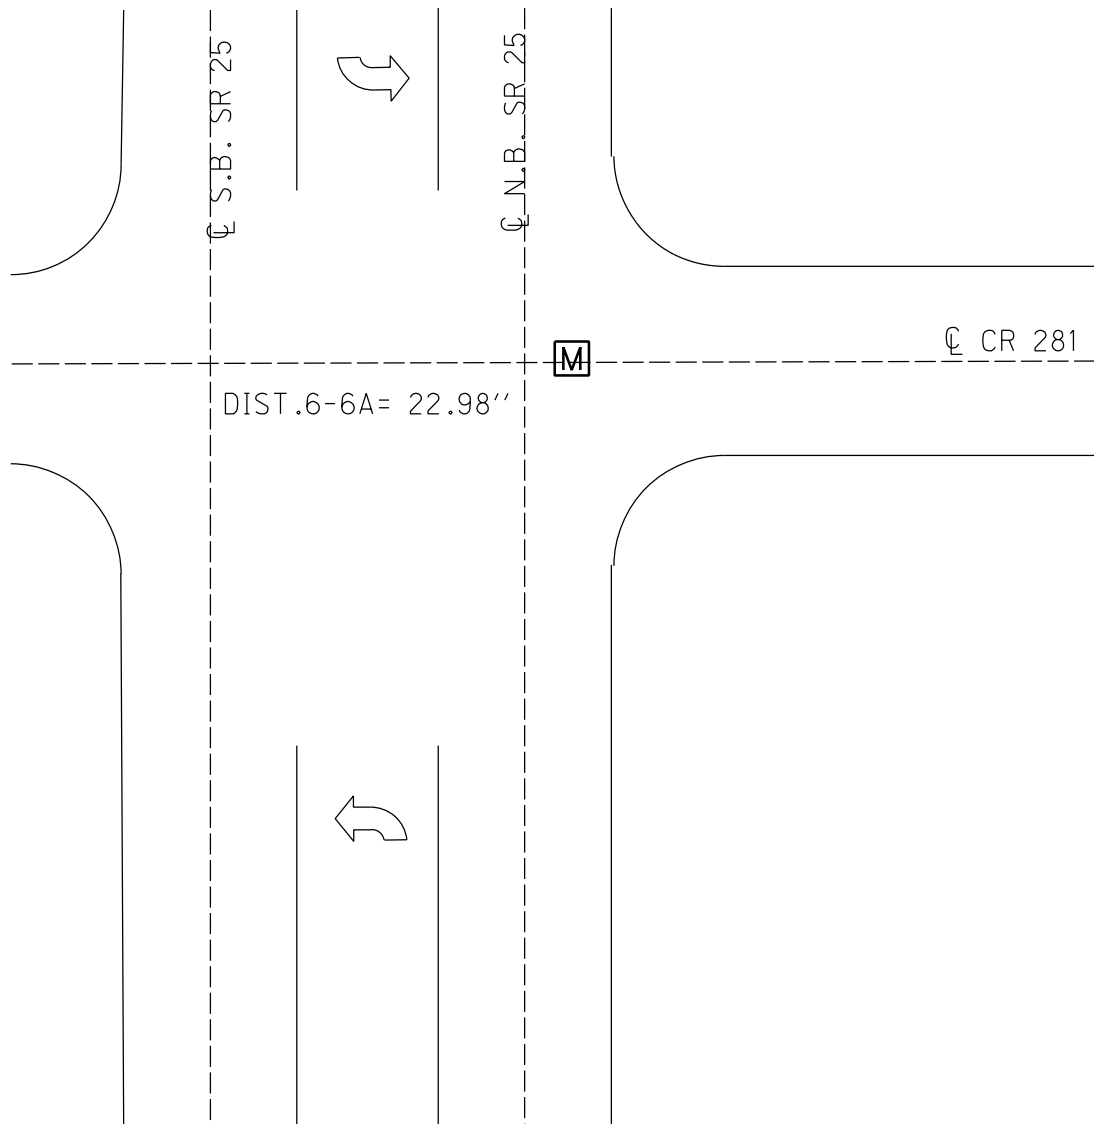

O.D.O.T. DISTRICT 2 SURVEY OFFICE (USE ONLY)

PERSONNEL

REFERENCE NO. 9

SHEET OF

NOTES NIESE
H.C. NIESE
R.C. ASTON

DATE 11/20/23
WEATHER CLEAR
TEMP. 37°

ROUTE SR 25
COUNTY WOOD
TOWNSHIP PORTAGE
SECTION 18

DWG BY BARRIERE PID 92133

T 4 N R 11 E

TYPE MONUMENT MONBOX W/ 1" IPIN

ON SURFACE - BELOW ON

OFFSET $\varnothing$ PAVEMENT 28' RT LT : RT


 TO EDGE PAVEMENT

STATION: 264+67

HORIZ.DATUM: NAD83(11)/WOOD LDP GEOID: 18

GRID: NORTHING: 598685.769 EASTING: 1652458.121

LDP: NORTHING: 420528.826 EASTING: 163948.578

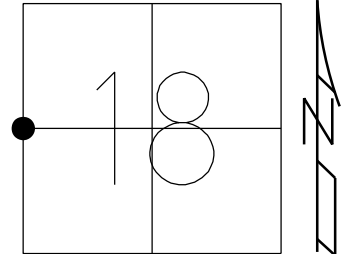

RECORD:
STA. 507+07
FD BRASS MON
FD P.K./WASHER
4/12/01, TMR
SET P.K./WASHER
10-31-01, SAH
FD P.K./WASHER
(SHOT AS REFA9)
5-30-18, JFO
DRAWING CORRECTED
11/16/23, TDN
FD MONBOX
W/ 1" IPIN
CHECKED W/ GPS
NEWREF9
11/15/23, TDN

****NOTE****
POINT WAS ADJUSTED PER
WOO-25-0.75, PID 92133
PLANS. SEE PLANS FOR
PRIOR COORDINATES
AND INFORMATION.
**** ****

$\varnothing$ S.B. SR 25

$\varnothing$ N.B. SR 25

FD MONBOX
W/ 1" IPIN



DIST. 9-A9=0.7'

****NOTE****
A9 IS 0.7' WEST OF PIN
INSIDE MONBOX.
**** ****

O.D.O.T. DISTRICT 2 SURVEY OFFICE (USE ONLY)

PERSONNEL

REFERENCE NO. A9

SHEET OF

NOTES NIESE

DATE 11/20/23

ROUTE SR 25

H.C. NIESE

WEATHER CLEAR

COUNTY WOOD

R.C. ASTON

TEMP. 37°

TOWNSHIP PORTAGE

DWG BY BARRIERE

PID 92133

SECTION 18

T 4 N R 11 E

TYPE MONUMENT MONBOX W/ 1" IPIN

ON SURFACE - BELOW ON

OFFSET $\odot$ PAVEMENT 28' RT LT : RT


 TO EDGE PAVEMENT

STATION: 264+67

HORIZ.DATUM: NAD83(11)/WOOD LDP GEOID: 18

GRID: NORTHING: EASTING:

LDP: NORTHING: 420528.869 EASTING: 163948.611

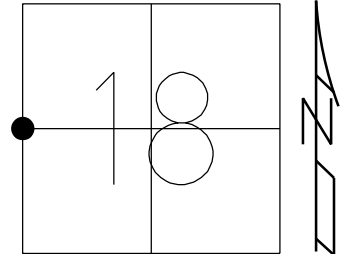

RECORD:
FD P.K. NAIL
(SHOT AS REF9)
5-30-18, JFO
DRAWING CORRECTED
11/16/23, TDN
POINT LANDS WITHIN MONBOX
DID NOT RE-ESTABLISH
11/20/23, TDN

C S.B. SR 25

C N.B. SR 25

FD MONBOX
W/ 1" IPIN

M₉

DIST. 9-A9=0.7'

****NOTE****
A9 IS 0.7' WEST OF PIN
INSIDE MONBOX.
**** ****

O.D.O.T. DISTRICT 2 SURVEY OFFICE (USE ONLY)

PERSONNEL

REFERENCE NO. 10

SHEET OF

NOTES NIESE

DATE 11/20/23

ROUTE SR 25

H.C. NIESE

WEATHER CLEAR

COUNTY WOOD

R.C. ASTON

TEMP. 37°

TOWNSHIP PORTAGE

DWG BY BARRIERE

PID 92133

SECTION 13

T 4 N R 10 E

TYPE MONUMENT MONBOX W/ 1" IPIN

ON SURFACE - BELOW ON

OFFSET Q PAVEMENT 28.5' RT LT : RT


 TO EDGE PAVEMENT

STATION: 239+43.01

HORIZ.DATUM: NAD83(11)/WOOD LDP GEOID: 18

GRID: NORTHING: 598910.304 EASTING: 1652461.229

LDP: NORTHING: 420753.400 EASTING: 163948.725

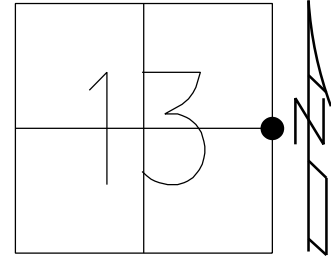

RECORD:
E 1/4 SEC 13

STA. 509+31.4
FD BRASS MON
FD P.K./WASHER
4/12/01, TMR
SET P.K./WASHER
10-31-01, SAH
FD HOLE
REF10
5-30-18, JFO
FD BRASS DISK
FD MAG NAIL
3/17/22, JFO
FD NEW MONBOX
W/ 1" IPIN
CHECKED W/ GPS
DID NOT PULL TIES
NEWREF10
11/20/23, TDN

Q S.B. SR 25

Q N.B. SR 25

FD MONBOX
W/ 1" IPIN



O.D.O.T. DISTRICT 2 SURVEY OFFICE (USE ONLY)

PERSONNEL

REFERENCE NO. 11

SHEET OF

NOTES ASTON
H.C. NIESE
R.C. ASTON

DATE 11/20/23
WEATHER WINDY
TEMP. 37°

ROUTE SR 25
COUNTY WOOD
TOWNSHIP PORTAGE
SECTION 18

DWG BY BARRIERE PID 92133

T 4 N R 11 E

TYPE MONUMENT MONBOX W/ 1 1/4" IPIN

ON SURFACE - BELOW ON

OFFSET $\oslash$ PAVEMENT 10' RT LT : RT


 TO EDGE PAVEMENT

STATION: 263+75.51

HORIZ.DATUM: NAD83(11)/WOOD LDP GEOID: 18

GRID: NORTHING: 601340.476 EASTING: 1652486.055


LDP: NORTHING: 423183.875 EASTING: 163941.505

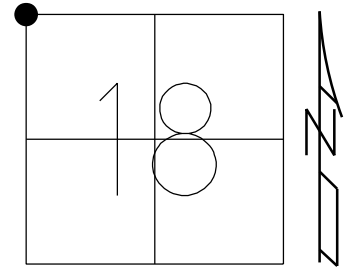

RECORD:
NW COR SEC 18

STA.533+62.85
FD BRASS PLUG
FD P.K./WASHER
4/16/01, TMR
SET P.K./WASHER
10-31-01, SAH
SET MAG NAIL
REF11
5-30-18, JFO
10-1-18, JFO
FD BRASS DISK
FD MAG NAIL
3/17/22, JFO
FD NEW MONBOX
W/ 1 1/4" IPIN
NEWREF11
11/20/23, TDN

$\oslash$ GREENSBURG PIKE

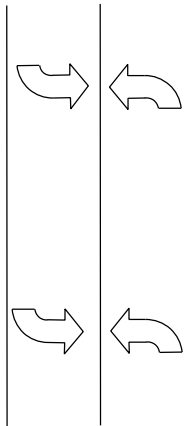

$\oslash$ GREENSBURG PIKE

****NOTE****
POINT WAS ADJUSTED PER
WOO-25-0.75, PID 92133 PLANS.
SEE PLANS FOR PRIOR COORDINATES
AND INFORMATION.

**** ****

O.D.O.T. DISTRICT 2 SURVEY OFFICE (USE ONLY)

PERSONNEL

REFERENCE NO. 12

SHEET OF

NOTES ASTON

DATE 11/20/23

ROUTE SR 25

H.C. NIESE

WEATHER WINDY

COUNTY WOOD

R.C. ASTON

TEMP. 37°

TOWNSHIP PORTAGE

DWG BY BARRIERE

PID 92133

SECTION 18

T 4 N R 11 E

TYPE MONUMENT MONBOX W/ 1" IPIN

ON SURFACE - BELOW ON

OFFSET Q PAVEMENT 3' RT LT : RT


 TO EDGE PAVEMENT

STATION: 266+02.54

HORIZ.DATUM: NAD83(11)/WOOD LDP GEOID: 18


GRID: NORTHING: 601569.521 EASTING: 1652488.428

LDP: NORTHING: 423412.950 EASTING: 163940.858

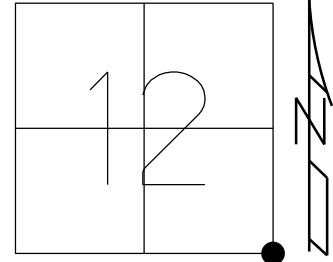

RECORD:

STA. 535+91.8
FD BRASS PLUG
FD P.K./WASHER
4/16/01, TMR
SET P.K./WASHER
10-31-01, SAH
SET MAG/WASHER
REF12
5-30-18
10-1-18, JFO
10-1-18, JFO
FD BRASS DISK
FD MAG NAIL
3/17/22, JFO
FD NEW MONBOX
W/ 1" IPIN
CHECKED WITH GPS
DID NOT PULL TIES
NEWREF12
11/20/23, TDN

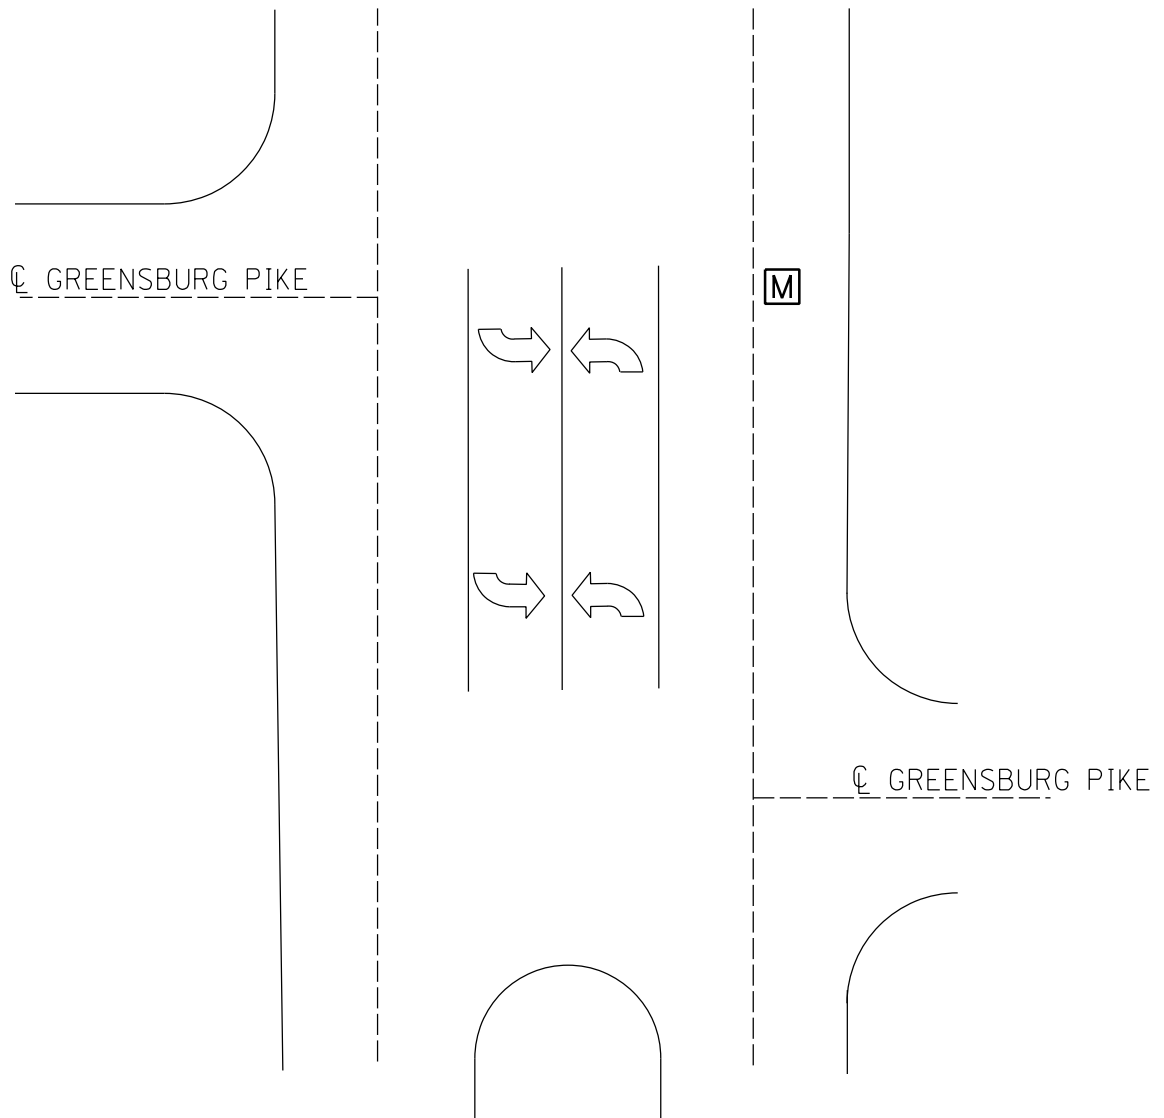

O.D.O.T. DISTRICT 2 SURVEY OFFICE (USE ONLY)

PERSONNEL

REFERENCE NO. 12A/13

SHEET _____ OF _____

NOTES NIESE
H.C. NIESE
R.C. AUBLE

DATE 11/20/23
WEATHER CLEAR
TEMP. 37°

ROUTE SR 25
COUNTY WOOD
TOWNSHIP PORTAGE
SECTION 7

DWG BY BARRIERE PID 92133

T 4 N R 11 E

TYPE MONUMENT MONBOX W/ 1" IPIN

ON SURFACE - BELOW ON

OFFSET $\odot$ PAVEMENT 28.5' RT LT : RT


TO EDGE PAVEMENT

STATION: 290+16.33

HORIZ.DATUM: NAD83(11)/WOOD LDP GEOID: 18


GRID: NORTHING: 603983.008 EASTING: 1652514.331

LDP: NORTHING: 425826.753 EASTING: 163934.935

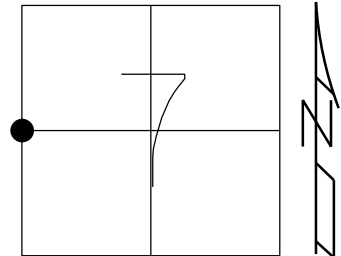

RECORD:
STA. 571+29.6
FD BRASS MON
FD P.K./WASHER
4/16/01, TMR
SET P.K./WASHER
10-31-01, SAH
FD P.K. SHANK/WASHER
REF13
5-30-18
10-1-18, JFO
FD P.K. NAIL
FD MAG NAIL
REFA12
FD MAG NAIL
REF13
3/18/22, JFO
FD NEW MONBOX
W/ 1" IPIN
NEWREF13
11/20/23, TDN

RECORD:
SET MAGNAIL
UNKNOWN ORIGIN
REFA12
11/20/23, TDN

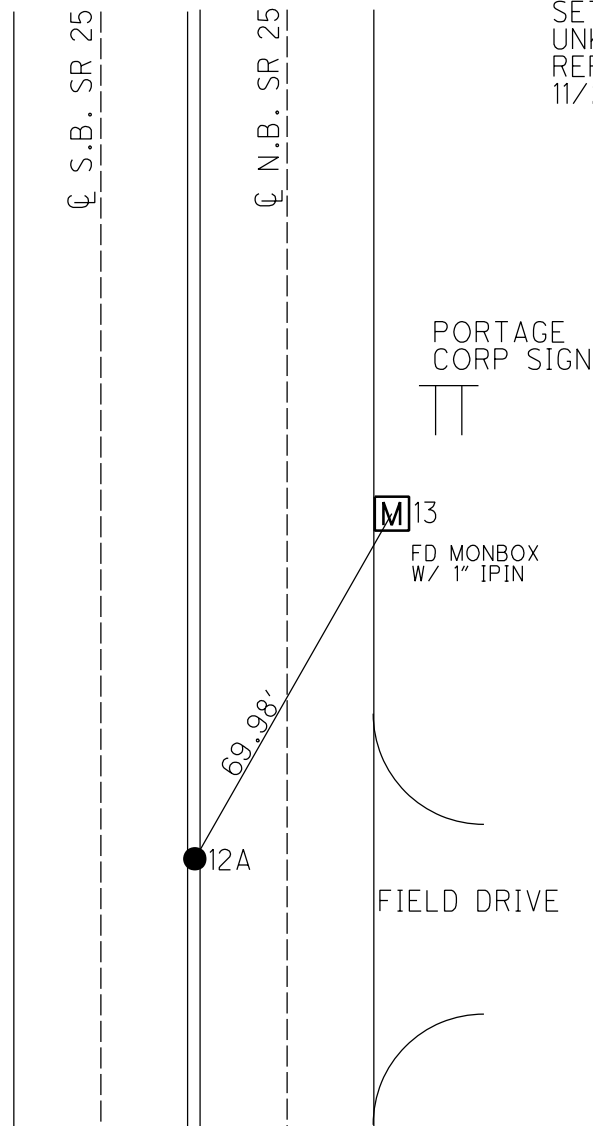

****NOTE****
POINT WAS ADJUSTED PER
WOO-25-0.75, PID 92133 PLANS.
SEE PLANS FOR PRIOR COORDINATES
AND INFORMATION.
**** ****

O.D.O.T. DISTRICT 2 SURVEY OFFICE (USE ONLY)

PERSONNEL

REFERENCE NO. 14

SHEET OF

NOTES NIESE
H.C. NIESE
R.C. ASTON

DATE 11/20/23
WEATHER CLEAR
TEMP. 37°

ROUTE SR 25
COUNTY WOOD
TOWNSHIP PORTAGE
SECTION 12

DWG BY BARRIERE PID 92133

T 4 N R 10 E

TYPE MONUMENT MONBOX W/ 1" IPIN

ON SURFACE - BELOW ON

OFFSET $\varnothing$ PAVEMENT 22.8' RT LT : RT


 TO EDGE PAVEMENT

STATION: 292+55.22

HORIZ.DATUM: NAD83(11)/WOOD LDP GEOID: 18

GRID: NORTHING: 604221.814 EASTING: 1652516.956

LDP: NORTHING: 426065.591 EASTING: 163934.411

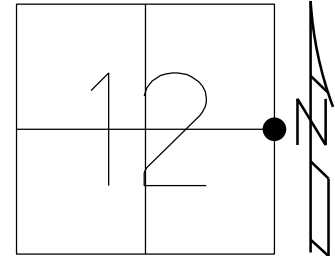

RECORD:
FD BRASS MON
FD P.K./WASHER
4/16/01, TMR
SET P.K./WASHER
10-31-01, SAH
FD P.K./WASHER
REF14
5-30-18
10-1-18, JFO
FD BRASS DISK
FD MAG NAIL
REF14
3/18/22, JFO
FD NEW MONBOX
W/ 1" IPIN
CHECKED W/ GPS
DID NOT PULL TIES
NEWREF14
11/20/23, TDN

PORTAGE
CORP SIGN



$\varnothing$ S.B. SR 25

$\varnothing$ N.B. SR 25



FD MONBOX
W/ 1" IPIN

O.D.O.T. DISTRICT 2 SURVEY OFFICE (USE ONLY)

PERSONNEL

REFERENCE NO. 14A

SHEET OF

NOTES NIESE

DATE 11/20/23

ROUTE SR 25

H.C. NIESE

WEATHER CLEAR

COUNTY WOOD

R.C. ASTON

TEMP. 37°

TOWNSHIP LIBERTY

DWG BY BARRIERE

PID 92133

SECTION 12

T 4 N R 10 E

TYPE MONUMENT MAG NAIL/WASHER

ON SURFACE - BELOW ON

OFFSET $\varnothing$ PAVEMENT 2.5' RT LT : RT


 TO EDGE PAVEMENT

STATION: 315+10.26


HORZ.DATUM: NAD83(11)/WOOD LDP GEOID: 18

GRID: NORTHING: 606476.483 EASTING: 1652545.697

LDP: NORTHING: EASTING:

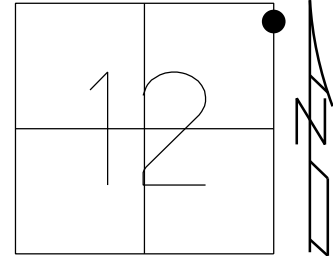

RECORD:
ORIGIN UNKOWN
FD RR SPIKE
5-18-78
FD P.K./WASHER
4/16/01, TMR
SET P.K./WASHER
10-31-01, SAH
SET MAG/WASHER
REFA14
5-30-18
10-1-18, JFO
FD MAG NAIL
FD MAG/WASHER
REFA14
3/18/22, JFO
FD MAG/WASHER
11/15/23, TDN

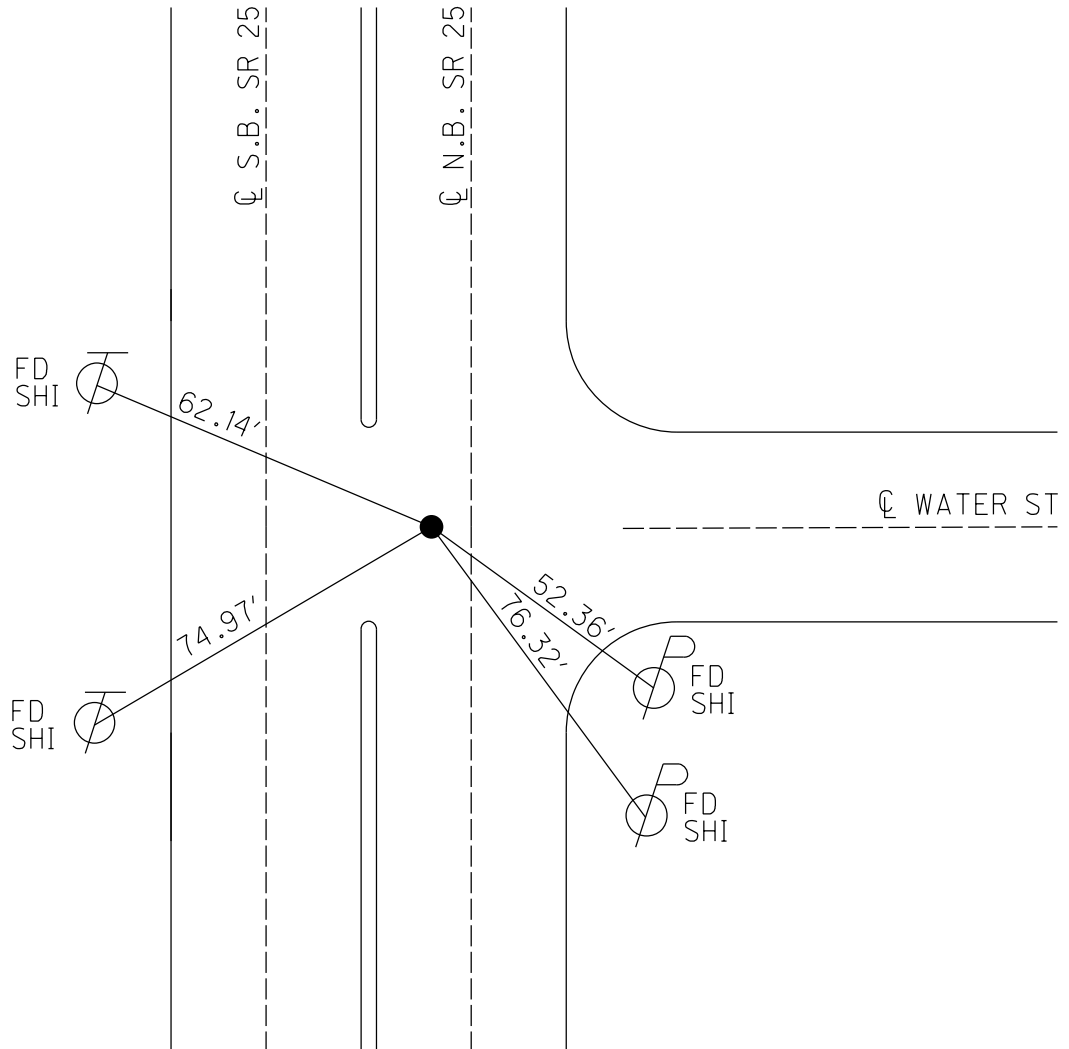

O.D.O.T. DISTRICT 2 SURVEY OFFICE (USE ONLY)

PERSONNEL

REFERENCE NO. 15

SHEET OF

NOTES NIESE

DATE 11/20/23

ROUTE SR 25

H.C. NIESE

WEATHER CLEAR

COUNTY WOOD

R.C. ASTON

TEMP. 37°

TOWNSHIP LIBERTY

DWG BY BARRIERE

PID 92133

SECTION 12

T 4 N R 10 E

TYPE MONUMENT MAG NAIL/WASHER

ON SURFACE - BELOW ON

OFFSET $\varnothing$ PAVEMENT ' RT LT : RT


 TO EDGE PAVEMENT

STATION: 319+05.07

HORIZ.DATUM: NAD83(11)/WOOD LDP GEOID: 18

GRID: NORTHING: 606871.234 EASTING: 1652550.794


LDP: NORTHING: 428715.428 EASTING: 163933.312

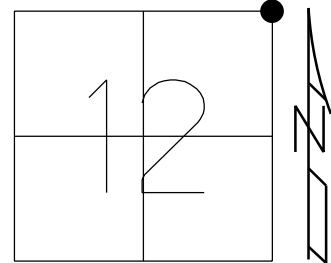

RECORD:P.I.

NE COR SEC 12

FD P.K./WASHER
OVER BRASS MON
FD P.K./WASHER
4/16/01, TMR
SET P.K./WASHER
10-31-01, SAH
FD MAG NAIL
REF15
5-30-18, JFO
10-1-18, JFO
FD MAG NAIL
NEWREF15
3/1/23, TDN
FD MAG NAIL
IN GORE AREA
W/ STRATTLERS
11/17/23, TDN

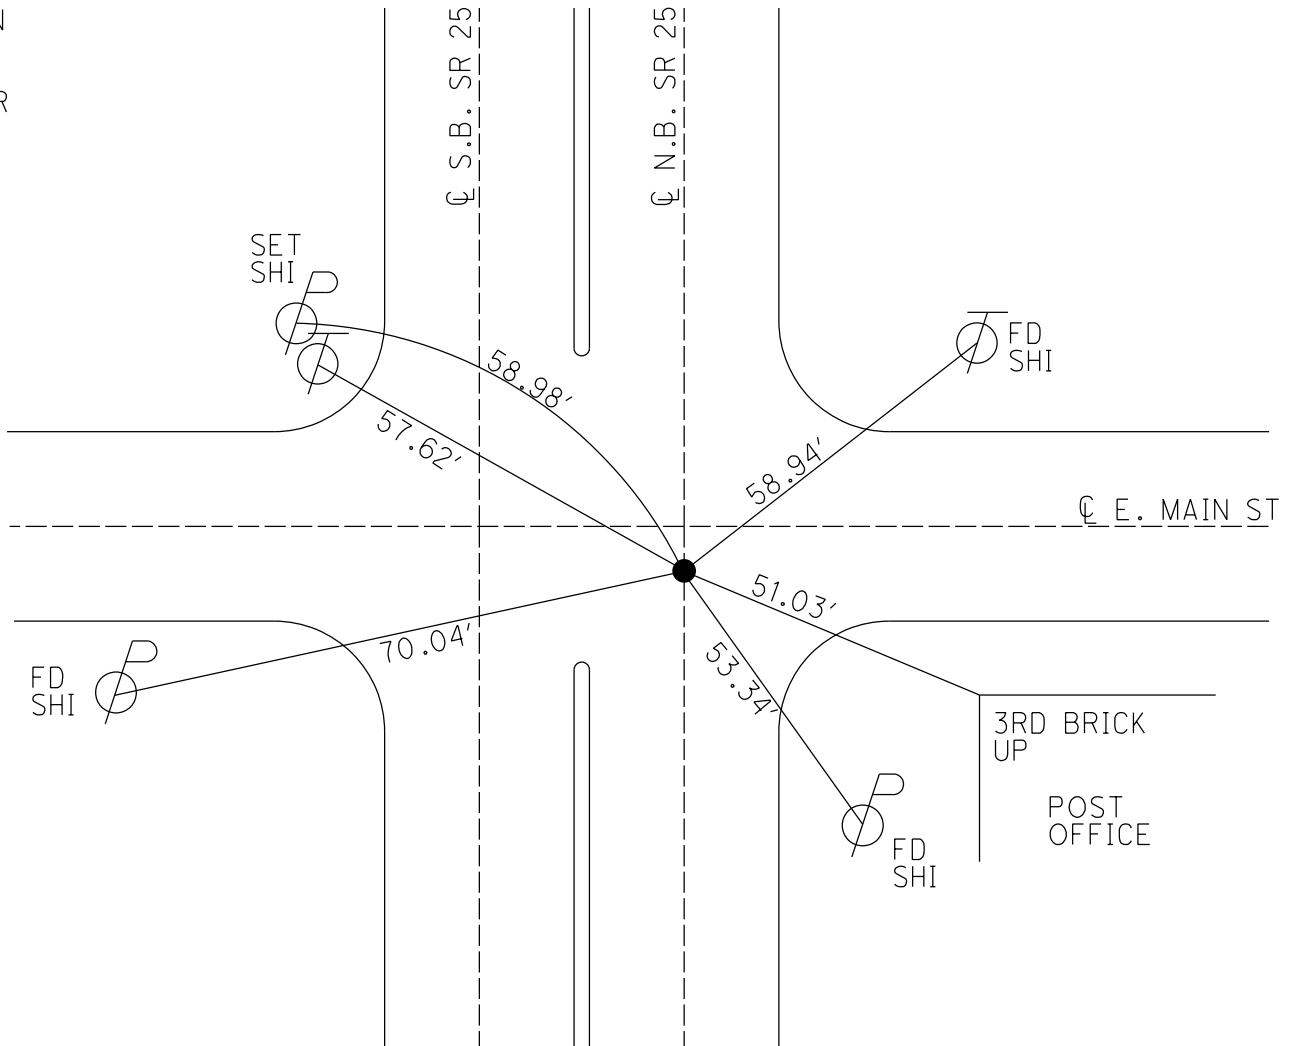

O.D.O.T. DISTRICT 2 SURVEY OFFICE (USE ONLY)

PERSONNEL

REFERENCE NO. A15

SHEET OF

NOTES RHOADES
H.C. NIESE
R.C. AUBLE

DATE 3/1/23
WEATHER CLEAR
TEMP. 37°

ROUTE SR 25
COUNTY WOOD
TOWNSHIP LIBERTY
SECTION 1

DWG BY BARRIERE PID 92133

T 4 N R 10 E

TYPE MONUMENT MAG NAIL

ON SURFACE - BELOW ON

OFFSET $\odot$ PAVEMENT 0.56' RT LT : RT


 TO EDGE PAVEMENT

STATION: 322+97.88


HORIZ.DATUM: NAD83(11)/WOOD LDP GEOID: 18

GRID: NORTHING: 607264.039 EASTING: 1652556.265

LDP: NORTHING: 429108.304 EASTING: 163933.608

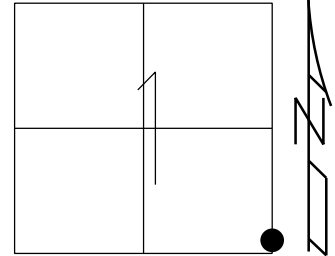

RECORD:
FD HOLE
REFA15
5-30-18, JFO
FD MAG NAIL
NEWREFA15
3/1/23, TDN

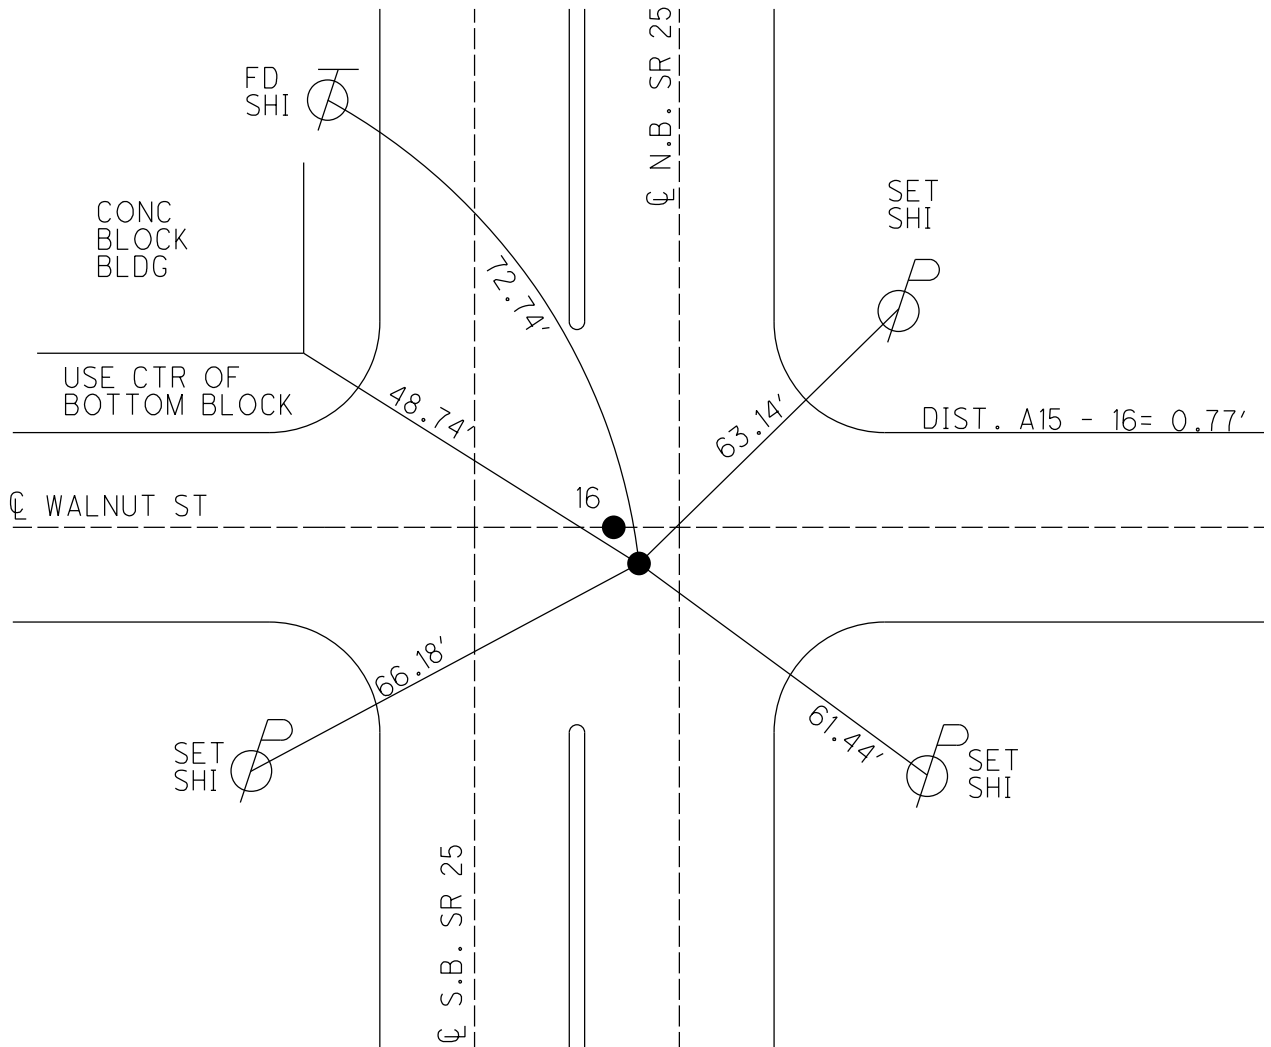

O.D.O.T. DISTRICT 2 SURVEY OFFICE (USE ONLY)

PERSONNEL

REFERENCE NO. 16

SHEET OF

NOTES RHOADES

DATE 3/1/23

ROUTE SR 25

H.C. NIESE

WEATHER CLEAR

COUNTY WOOD

R.C. AUBLE

TEMP. 37°

TOWNSHIP LIBERTY

DWG BY BARRIERE PID 92133

SECTION 1

T 4 N R 10 E

TYPE MONUMENT MAG NAIL

ON SURFACE - BELOW ON

OFFSET $\varnothing$ PAVEMENT 0.17 LT LT : RT


 TO EDGE PAVEMENT

STATION: 322+97.88


HORIZ.DATUM: NAD83(11)/WOOD LDP GEOID: 18

GRID: NORTHING: 607264.264 EASTING: 1652555.529

LDP: NORTHING: 429108.530 EASTING: 163932.869

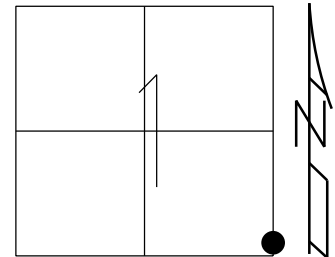

RECORD:
P.K./WASHER
ATOP P.K.NAIL
THAT DATES BACK
TO PRE-1964
FD P.K./WASHER
4/16/01, BVD
SET P.K./WASHER
10-31-01, SAH
FD MAG NAIL
REF16
5-30-18
10-1-18, JFO
FD MAG NAIL
NEWREF16
3/1/23, TDN

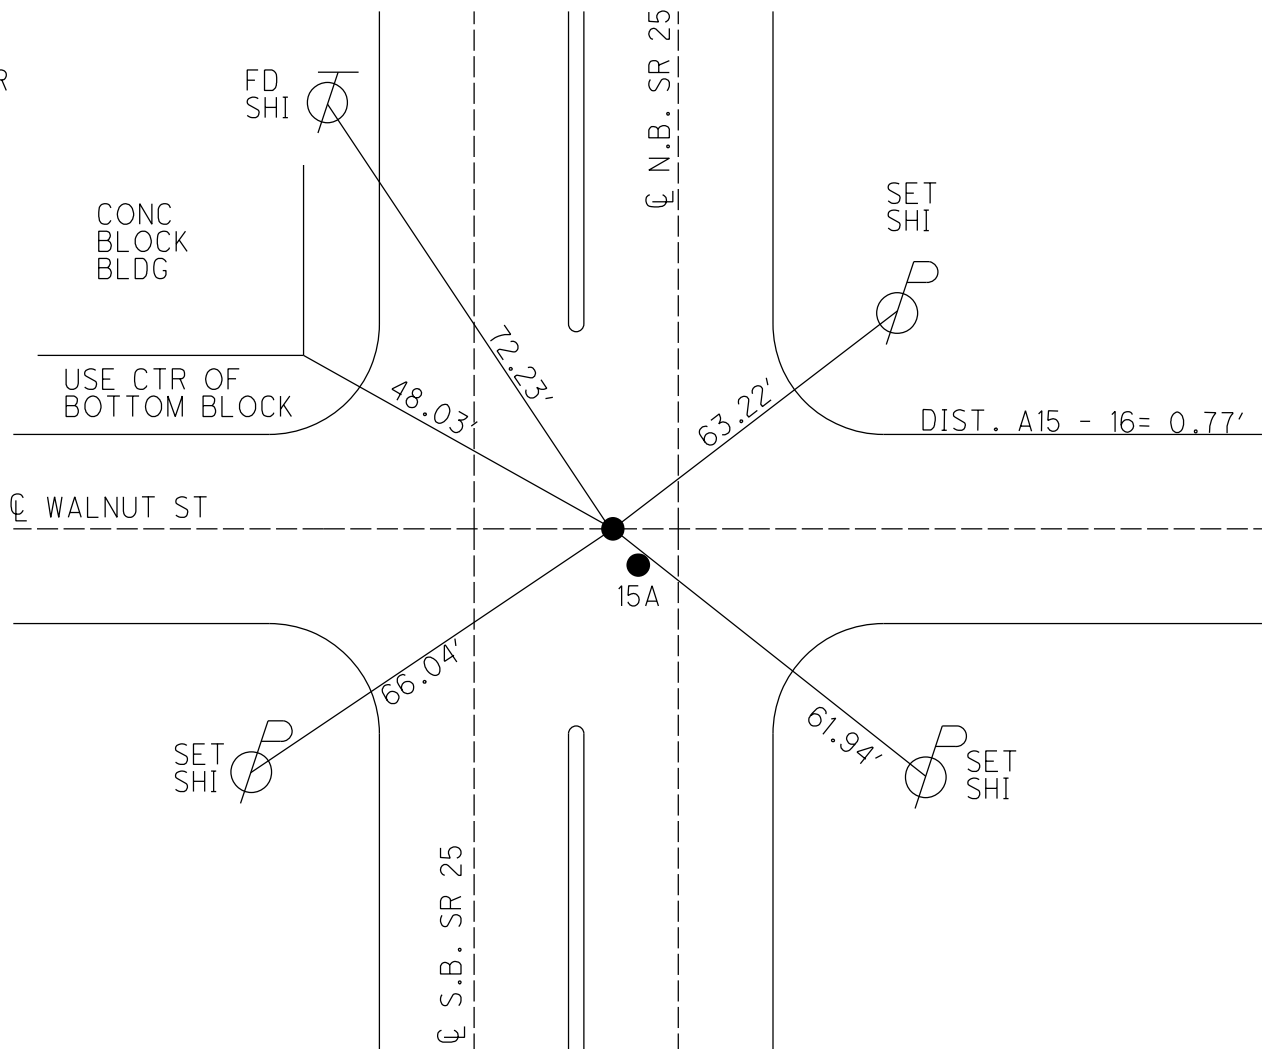

O.D.O.T. DISTRICT 2 SURVEY OFFICE (USE ONLY)

PERSONNEL

REFERENCE NO. A16

SHEET OF

NOTES RHOADES
H.C. NIESE
R.C. AUBLE

DATE 3/1/23
WEATHER CLEAR
TEMP. 37°

ROUTE SR 25
COUNTY WOOD
TOWNSHIP LIBERTY
SECTION 1

DWG BY BARRIERE PID 92133

T 4 N R 10 E

TYPE MONUMENT PK SHANK

ON SURFACE - BELOW ON

OFFSET $\varnothing$ PAVEMENT 2.6' RT LT : RT


 TO EDGE PAVEMENT

STATION: 330+00.51


HORIZ.DATUM: NAD83(11)/WOOD LDP GEOID: 18


GRID: NORTHING: 607966.553 EASTING: 1652564.305

LDP: NORTHING: 429810.912 EASTING: 163932.380

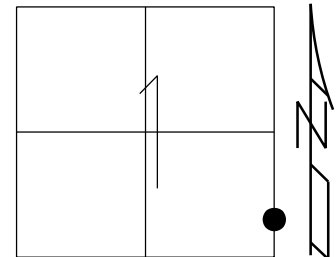

RECORD:
FD P.K./WASHER
4/16/01, BVD
SET P.K./WASHER
10-31-01, SAH
FD P.K./WASHER
REFA16
5-30-18
10-1-18, JFO
FD PK SHANK
NEWREFA16
3/1/23, TDN
FD SHANK
11/17/23, TDN

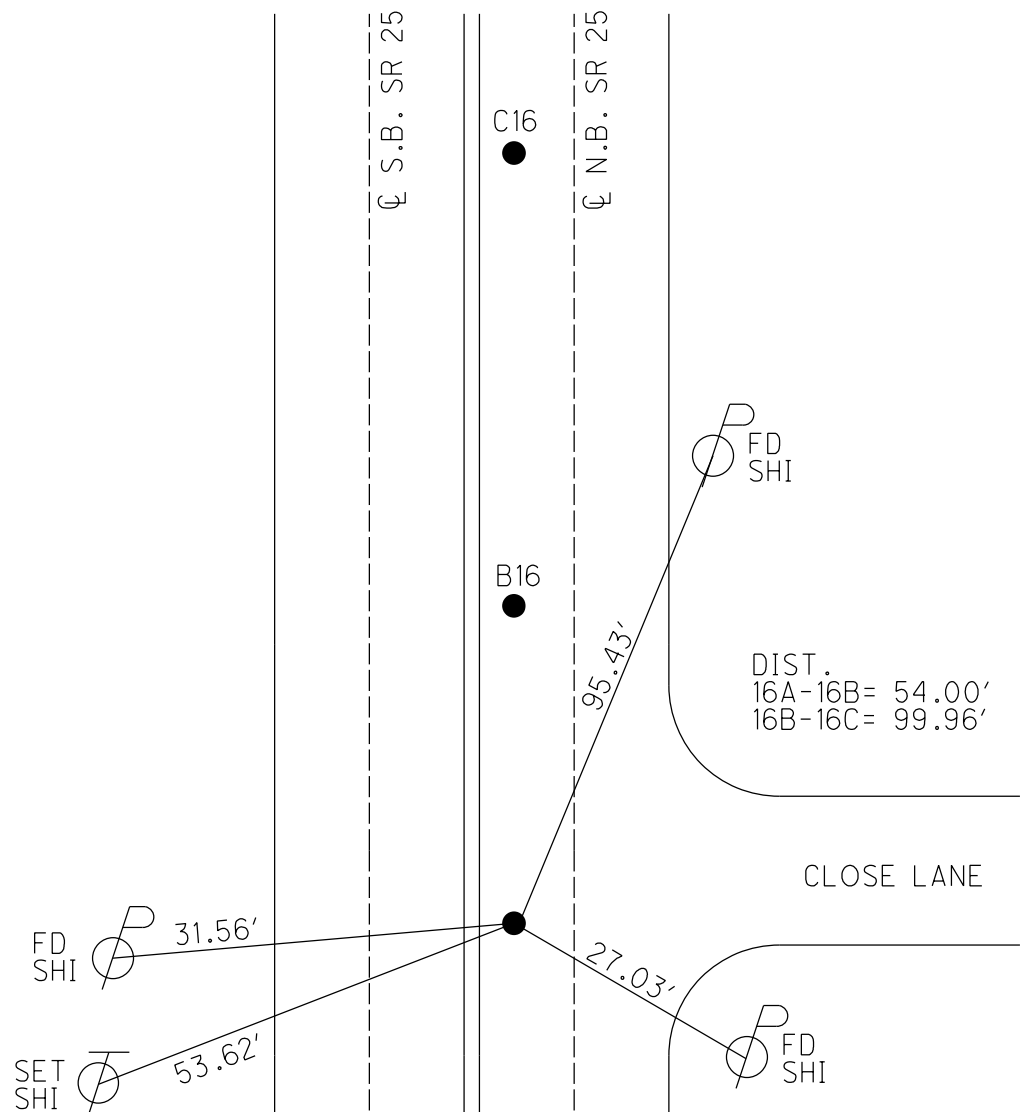

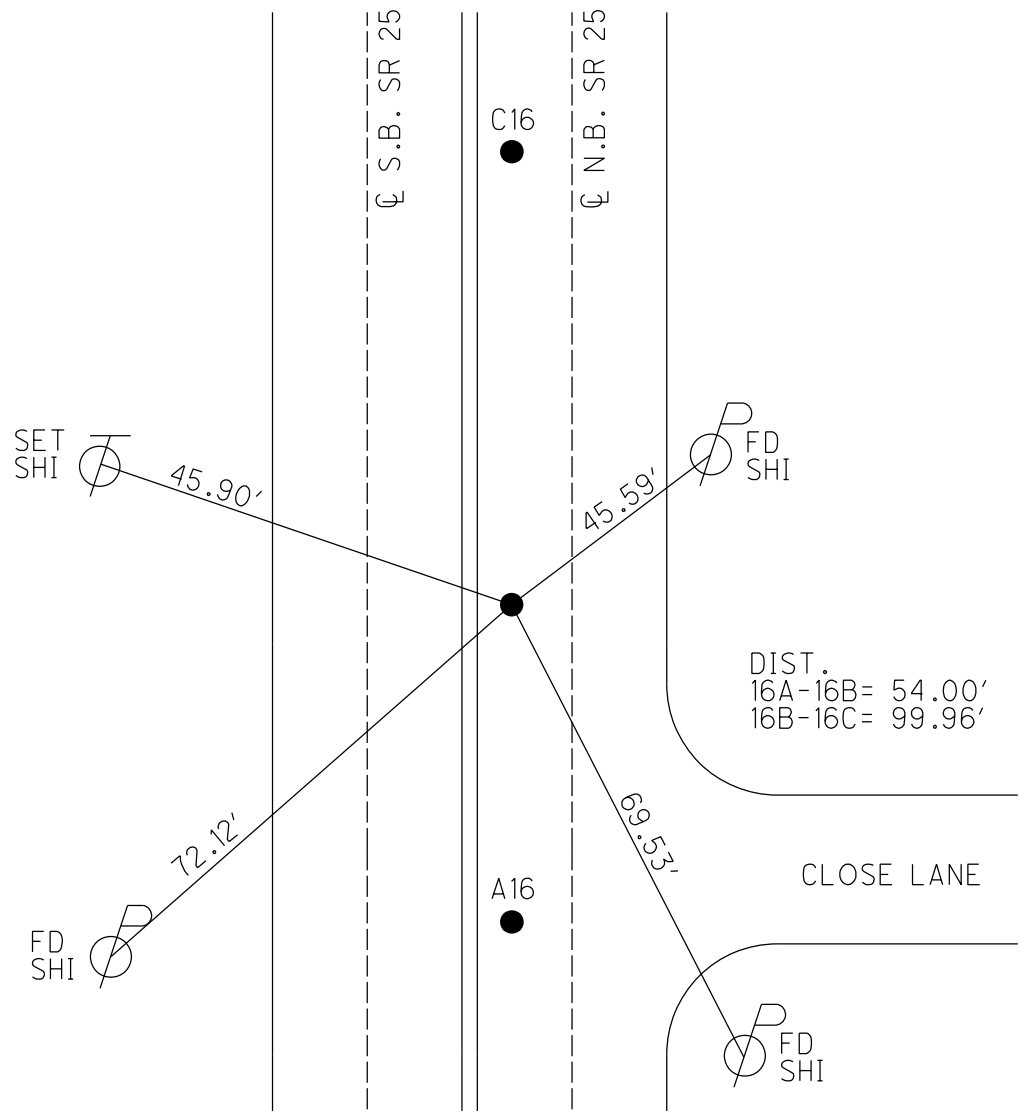

O.D.O.T. DISTRICT 2 SURVEY OFFICE (USE ONLY)

PERSONNEL

REFERENCE NO. C16

SHEET OF

NOTES RHOADES

DATE 3/1/23

ROUTE SR 25

H.C. NIESE

WEATHER CLEAR

COUNTY WOOD

R.C. AUBLE

TEMP. 37°

TOWNSHIP LIBERTY

DWG BY BARRIERE

PID 92133

SECTION 1

T 4 N R 10 E

TYPE MONUMENT PK SHANK

ON SURFACE - BELOW ON

OFFSET $\varnothing$ PAVEMENT 2.6' RT LT : RT


 TO EDGE PAVEMENT

STATION: 331+54.42


HORIZ.DATUM: NAD83(11)/WOOD LDP GEOID: 18

GRID: NORTHING: 608120.430 EASTING: 1652566.244

LDP: NORTHING: 429964.814 EASTING: 163932.290

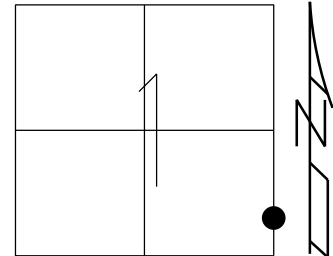

RECORD:
FD P.K./WASHER
4/16/01, BVD
SET P.K./WASHER
10-31-01, SAH
FD HOLE
REFC16
5-30-18
10-1-18, JFO
FD PK SHANK
NEWREFC16
3/1/23, TDN
FD SHANK
11/17/23, TDN

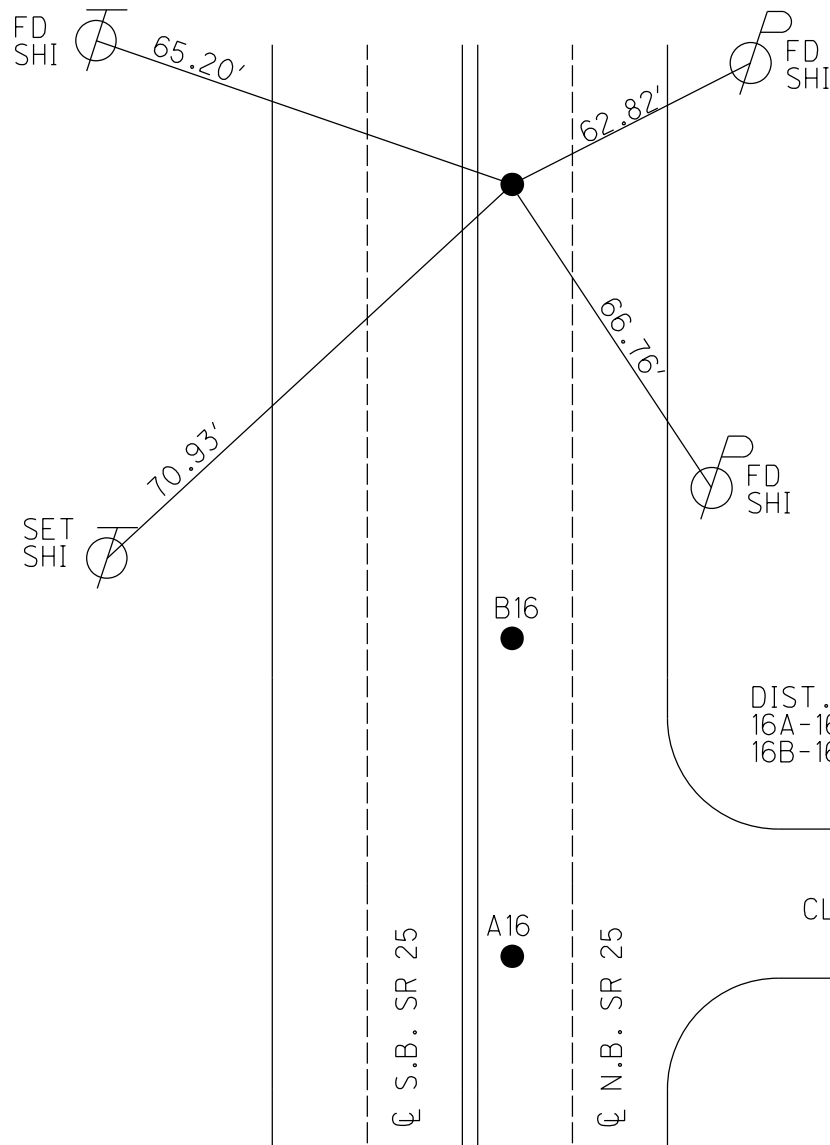

DIST.
16A-16B= 54.00'
16B-16C= 99.96'

CLOSE LANE

O.D.O.T. DISTRICT 2 SURVEY OFFICE (USE ONLY)

PERSONNEL _____

REFERENCE NO. 17

SHEET _____ OF _____

NOTES RHOADES

DATE 11/20/23

ROUTE SR 25

H.C. NIESE

WEATHER CLEAR

COUNTY WOOD

R.C. AUBLE

TEMP. 37°

TOWNSHIP PORTAGE

DWG BY BARRIERE

PID 92133

SECTION 6

T 4 N R 11 E

TYPE MONUMENT MONBOX W/ 1" IPIN

ON SURFACE - BELOW ON

OFFSET $\varnothing$ PAVEMENT 7.4' RT (SB LANE) LT : RT


TO EDGE PAVEMENT

STATION: 343+06.76

HORIZ.DATUM: NAD83(11)/WOOD LDP GEOID: 18


GRID: NORTHING: 609272.516 EASTING: 1652580.826

LDP: NORTHING: 431117.079 EASTING: 163931.680

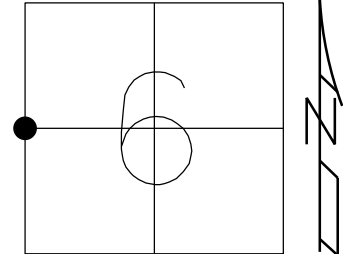

RECORD:
W 1/4 SEC 6

PORTAGE CORP LINE EAST
FD BRASS MON
FD SM.R.R.SPIKE
4/16/01, BVD
SET P.K./WASHER
6-12-91, MB
SET P.K./WASHER
10-31-01, SAH
FD HOLE
5-30-18, JFO
FD MAG NAIL
PREREF17
3/1/23, TDN
FD NEW MONBOX
W/ 1" IPIN
NEWREF17
11/20/23, TDN

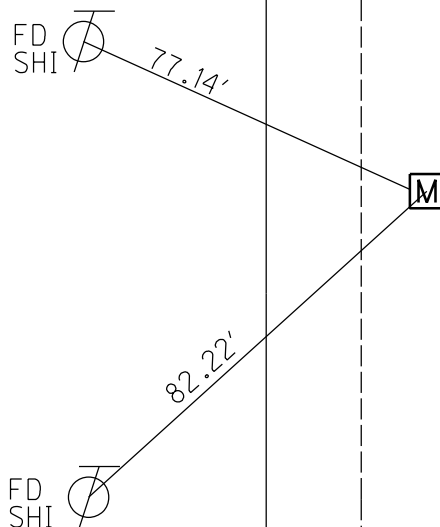

$\varnothing$ S.B. SR 25

$\varnothing$ N.B. SR 25

****NOTE****
POINT WAS ADJUSTED PER
WOO-25-0.75, PID 92133 PLANS.
SEE PLANS FOR PRIOR COORDINATES
AND INFORMATION.

**** ****

O.D.O.T. DISTRICT 2 SURVEY OFFICE (USE ONLY)

PERSONNEL

REFERENCE NO. A17

SHEET OF

NOTES ASTON
H.C. NIESE
R.C. MILLER

DATE 11/15/23
WEATHER CLEAR
TEMP. 60°

ROUTE SR 25
COUNTY WOOD
TOWNSHIP LIBERTY
SECTION 1

DWG BY BARRIERE PID 92133

T 4 N R 10 E

TYPE MONUMENT MAG/WASHER

ON SURFACE - BELOW ON

OFFSET $\varnothing$ PAVEMENT 1' RT (SB LANE) LT : RT


 TO EDGE PAVEMENT

STATION: 345+52.92


HORIZ.DATUM: NAD83(11)/WOOD LDP GEOID: 18

GRID: NORTHING: 609518.698 EASTING: 1652583.630

LDP: NORTHING: 431363.294 EASTING: 163931.238

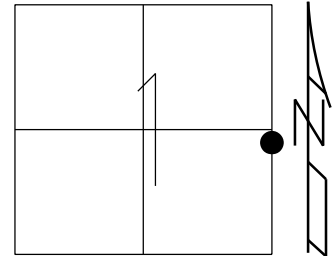

RECORD:
PORTAGE CORP LINE WEST
SECTION 1
EAST $\frac{1}{4}$ COR
STA. 615+42.12
1950
FD P.K./NAIL
1 1/2" DOWN
FD P.K./WASHER
4/16/01, BVD
SET P.K./WASHER
10-31-01, SAH
FD HOLE
5-30-18, JFO
FD P.K. SHANK
NEWREFA17
3/1/23, TDN
SET MAG/WASHER
11/15/23, TDN

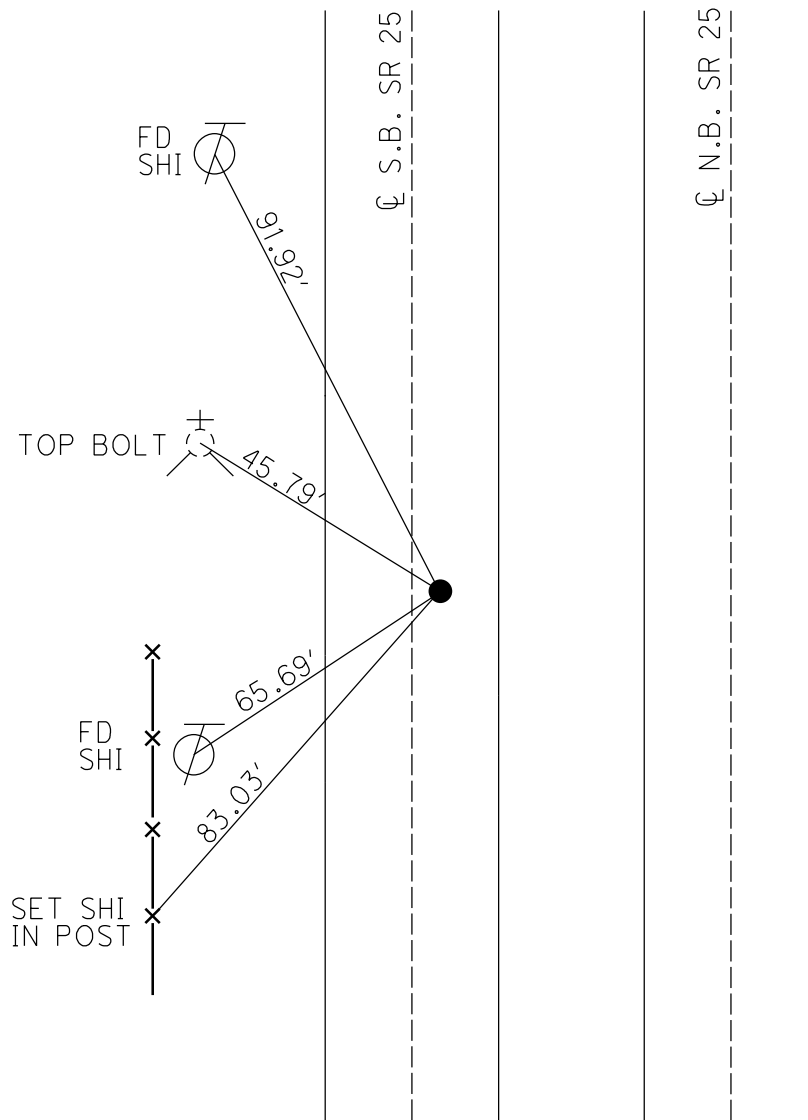

O.D.O.T. DISTRICT 2 SURVEY OFFICE (USE ONLY)

PERSONNEL

REFERENCE NO. 18

SHEET OF

NOTES ASTON
H.C. NIESE
R.C. PRESTON-COLVIN

DATE 5/15/24
WEATHER CLEAR
TEMP. 65°

ROUTE SR 25
COUNTY WOOD
TOWNSHIP LIBERTY
SECTION 1

DWG BY BARRIERE PID 92133

T 4 N R 10 E

TYPE MONUMENT MONBOX W/ 1" IPIN

ON SURFACE - BELOW ON

OFFSET $\varnothing$ PAVEMENT 2.7' LT (SB LANE) LT : RT


 TO EDGE PAVEMENT

STATION: 347+46.67

HORIZ.DATUM: NAD83(11)/WOOD LDP GEOID: 18

GRID: NORTHING: 609712.442 EASTING: 1652586.313


LDP: NORTHING: 431557.071 EASTING: 163931.365

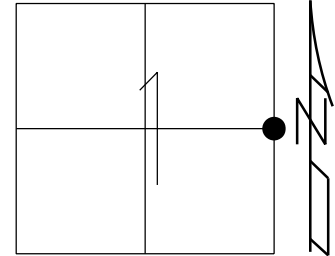

RECORD: P.I.

E 1/4 SEC 1

STA. 617+37.14
FD BRASS MON
1950
FD SM.R.R.SPIKE
3-27-91, SWH
FD P.K./WASHER
4/16/01, BVD
SET P.K./WASHER
10-31-01, SAH
FD MAG NAILS
REF18
5-30-18
10-1-18, JFO
FD BRASS DISK
FD MAG NAIL
NEWREF18
3/1/23, TDN
FD NEW MONBOX
W/ 1" IPIN
CHECKED WITH GPS
DID NOT PULL TIES
11/20/23, TDN
FD MONBOX
CKREF18
5/15/24, TDN

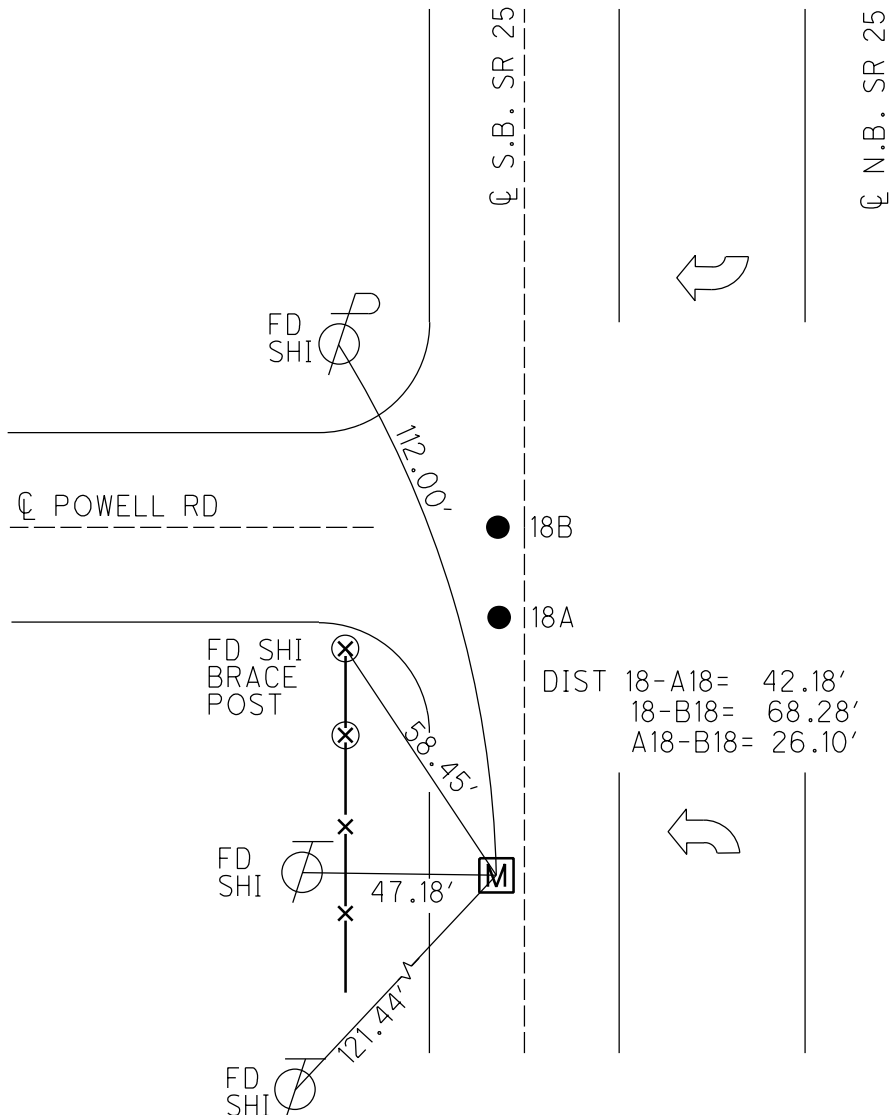

O.D.O.T. DISTRICT 2 SURVEY OFFICE (USE ONLY)

PERSONNEL

REFERENCE NO. A18/B18

SHEET OF

NOTES ASTON
H.C. NIESE
R.C. PRESTON-COLVIN

DATE 5/15/24
WEATHER CLEAR
TEMP. 65°

ROUTE SR 25
COUNTY WOOD
TOWNSHIP LIBERTY
SECTION 1

DWG BY BARRIERE PID 92133

T 4 N R 10 E

TYPE MONUMENT MAG NAIL/WASHER

ON SURFACE - BELOW ON


OFFSET Q PAVEMENT 2.7' LT (SB LANE) LT : RT
 TO EDGE PAVEMENT

STATION: 348+14.90

HORIZ.DATUM: NAD83(11)/WOOD LDP GEOID: 18


GRID: NORTHING: 609754.543 EASTING: 1652586.790

LDP: NORTHING: 431599.178 EASTING: 163931.287

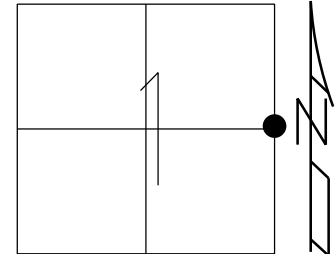

RECORD:(18A)
ORIGIN UNKNOWN
FD P.K.NAIL
3-27-91, SWH
FD P.K./WASHER
4/16/01, BDV
SET P.K./WASHER
10-31-01, SAH
FD MAG NAILS
REFA18
5-30-18
10-1-18, JFO
FD P.K. SHANK
NEWREFA18
3/1/23, TDN
SET MAG/WASHER
11/15/23

RECORD:(18B)
ORIGIN UNKNOWN
FD P.K.SHANK
NEW REFB18
SET MAG/WASHER
11/15/23, TDN

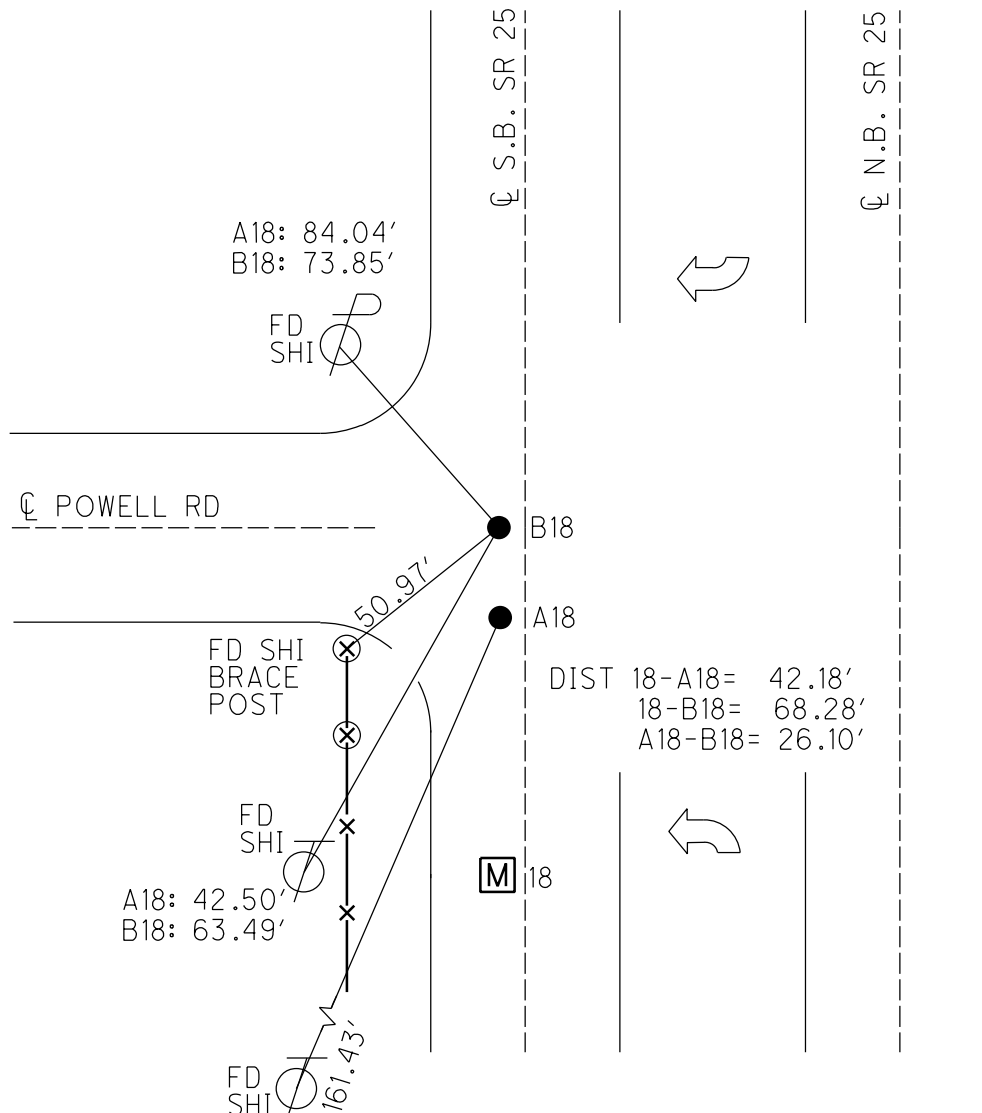

O.D.O.T. DISTRICT 2 SURVEY OFFICE (USE ONLY)

PERSONNEL

REFERENCE NO. 19

SHEET OF

NOTES RHOADES

DATE 3/1/23

ROUTE SR 25

H.C. NIESE

WEATHER CLEAR

COUNTY WOOD

R.C. AUBLE

TEMP. 37°

TOWNSHIP LIBERTY

DWG BY BARRIERE

PID 92133

SECTION 1

T 4 N R 10 E

TYPE MONUMENT MONBOX W/ 1" IPIN

ON SURFACE - BELOW ON

OFFSET $\varnothing$ PAVEMENT 5.7' LT LT : RT


 TO EDGE PAVEMENT

STATION: 375+43.33

HORIZ.DATUM: NAD83(11)/WOOD LDP GEOID: 18

GRID: NORTHING: 612508.547 EASTING: 1652623.652

LDP: NORTHING: 434353.635 EASTING: 163931.834

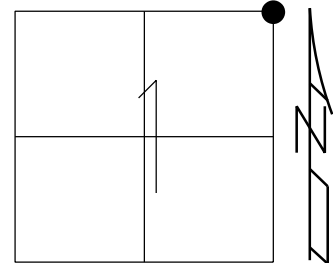

RECORD: P.I.

NE COR SEC 1

BRASS MON
FD SM RR SPIKE
3-27-91, SWH
SET PK/WASHER
6-13-91, MB
SET PK/WASHER
11-01-01, BVD
GPS, RT25KRAMER
8-27-13
POINT DESTROYED
5-30-18, JFO
PULLED TIES
DID NOT CROSS
10-1-18, JFO
FD MAG NAIL
NEWREF19
3/1/23, TDN
FD MONBOX
W/ 1" IPIN
REF19
5/15/24, TDN

$\varnothing$ KRAMER RD



$\varnothing$ N.B. SR 25

$\varnothing$ KRAMER RD

$\varnothing$ S.B. SR 25

O.D.O.T. DISTRICT 2 SURVEY OFFICE (USE ONLY)

PERSONNEL

REFERENCE NO. 20/A20

SHEET _____ OF _____

NOTES RHOADES
H.C. NIESE
R.C. AUBLE

DATE 3/1/23
WEATHER CLEAR
TEMP. 37°

ROUTE SR 25
COUNTY WOOD
TOWNSHIP LIBERTY
SECTION 1

DWG BY BARRIERE PID 92133

T 4 N R 10 E

TYPE MONUMENT MONBOX W/ 1" IPIN

ON SURFACE - BELOW ON

OFFSET $\varnothing$ PAVEMENT 5.7' LT LT : RT


TO EDGE PAVEMENT

STATION: 401+82.69

HORZ. DATUM: NAD83(11)/WOOD LDP GEOID: 18

GRID: NORTHING: 615147.441 EASTING: 1652659.660

LDP: NORTHING: 436992.970 EASTING: 163933.044

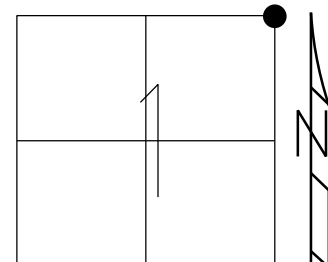


RECORD: (20)
W 1/4 SEC 31

BRASS MON
SET PK/WASHER
6-13-91, MB
SET PK/WASHER
11-01-01, BVD
FD PK SHANK
GPS, CNTRL9
10-01-13
D.N.F
5-30-18, JFO
PULLED TIES
DID NOT CROSS
10-1-18, JFO
FD MAG NAIL
PREREF20
3/1/23, TDN
FD NEW MONBOX
W/ 1" IPIN
NEWREF20
11/20/23, TDN

RECORD: (A20)


FD NEW MONBOX
W/ 1" IPIN
NEWREF A20
11/20/23, TDN

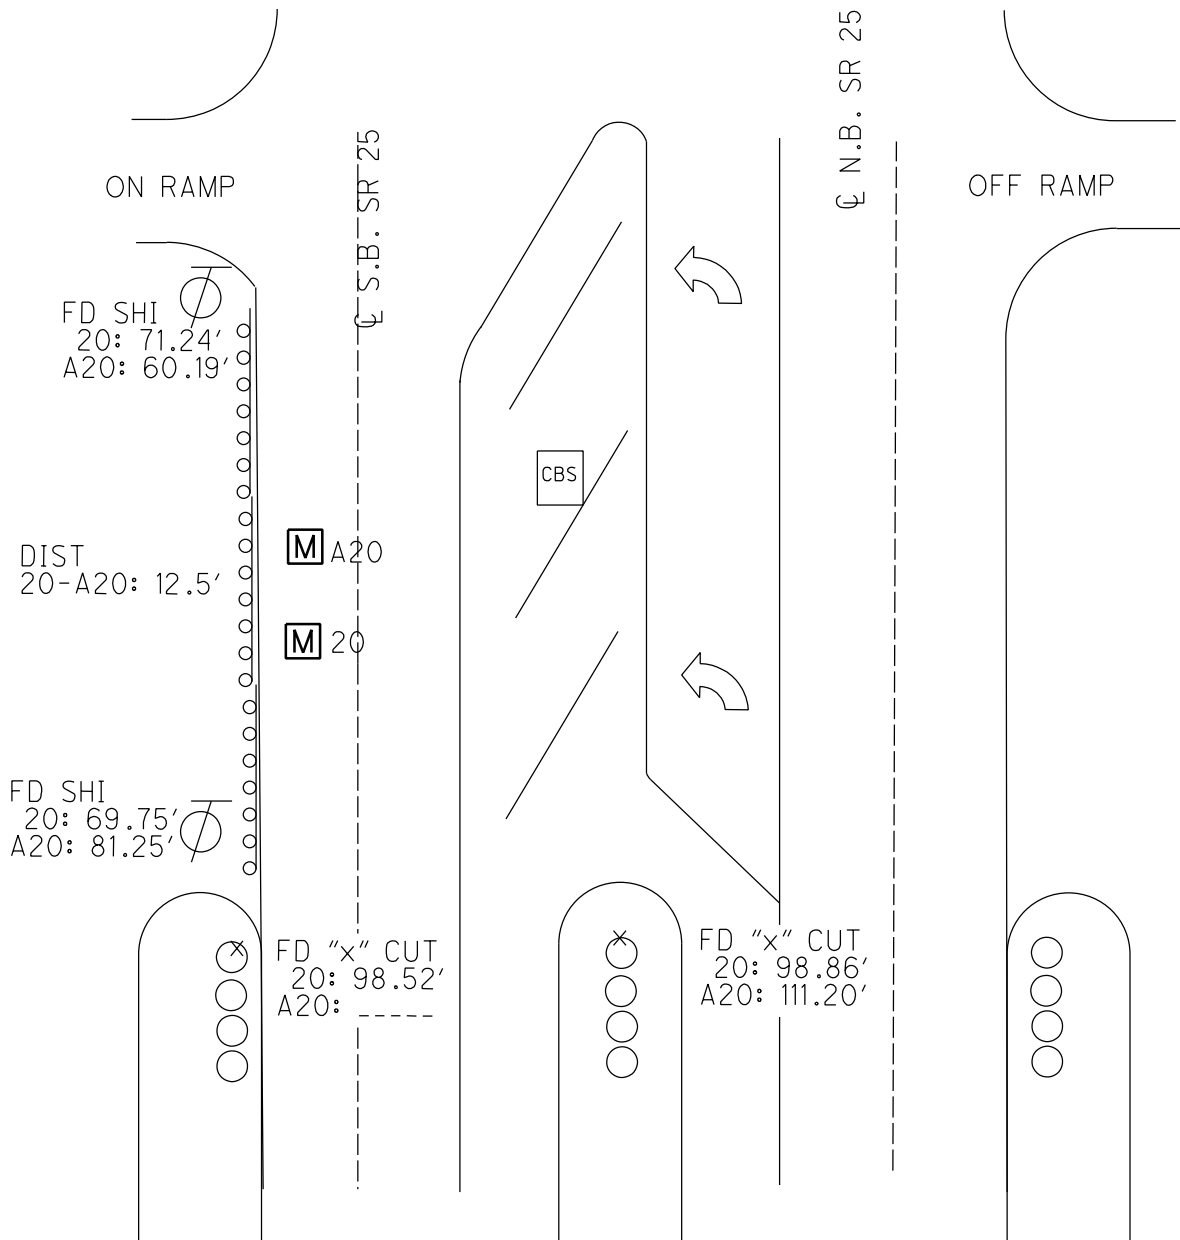

O.D.O.T. DISTRICT 2 SURVEY OFFICE (USE ONLY)

PERSONNEL	REFERENCE NO.	<u>21</u>	SHEET	<u>3</u>	OF	<u>4</u>
NOTES	<u>BARNHISEL</u>	DATE	<u>6-10-92</u>	ROUTE	<u>US 25</u>	
H.C.	<u>VAN DUSEN</u>	WEATHER	<u>SUNNY</u>	COUNTY	<u>WOOD</u>	
R.C.	<u>BURNETT</u>	TEMP.	<u>55°F</u>	TOWNSHIP	<u>PLAIN</u>	
				SECTION	<u>25</u>	
				T	<u>5</u>	N
				R	<u>10</u>	E

TYPE MONUMENT SM RR SPIKE
 ON SURFACE - ~~BELOW~~ ON
 LEFT - ℄ PAV'T - RIGHT ON, 1.5' S. OF ℄ E.
- TO - EDGE PAVEMENT
 S.L.M. 456+39

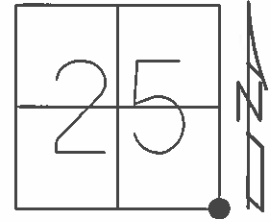


Grid: Northing: 617786.8940 Easting: 1652693.3580

RECORD:
 SET PK/WASHER
 8-20-92, BVD

FD MAG NAIL
 GPS, CNTRL7
 10-01-13

DIST. 21-21A = 24.46'

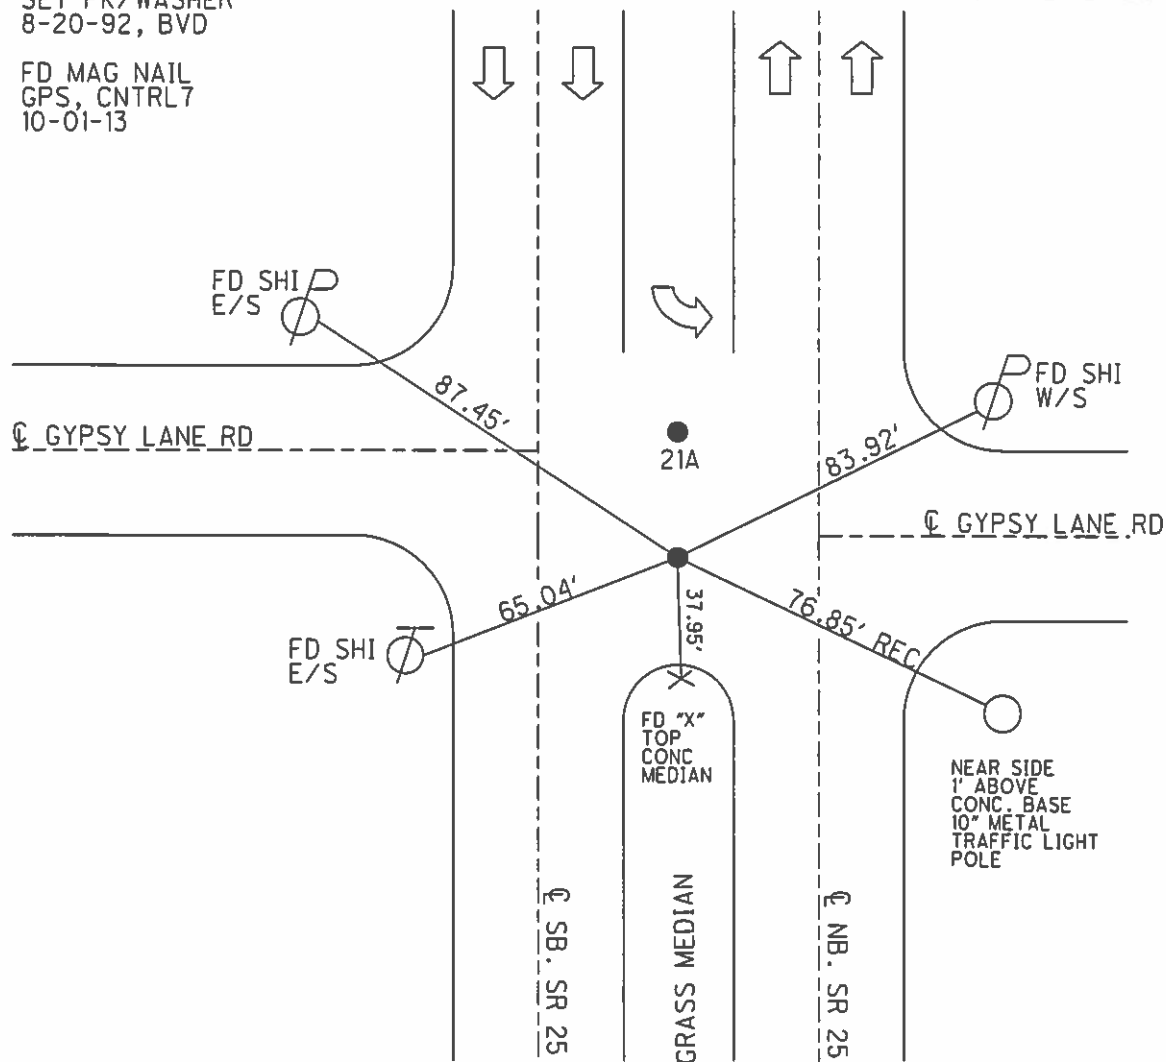

O.D.O.T. DISTRICT 2 SURVEY OFFICE (USE ONLY)

PERSONNEL

REFERENCE NO. 21 A

SHEET 4 OF 4

NOTES BARNHISEL

DATE 6-10-92

ROUTE US 25

H.C. VAN DUSEN

WEATHER SUNNY

COUNTY WOOD

R.C. BURNETT

TEMP. 55°F

TOWNSHIP PLAIN

SECTION 25

T 5 N R 10 E

TYPE MONUMENT SM RR SPIKE


ON SURFACE - ~~BELOW~~ ON

LEFT - ℄ PAV'T - RIGHT ON, 2' N. OF ℄ W.

- TO - EDGE PAVEMENT

S.L.M. 456+63

Grid: Northing: 617811.2525 Easting: 1652693.6627

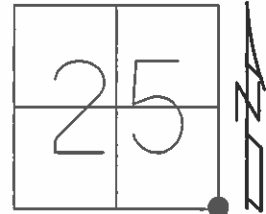


RECORD:
BRASS MONUMENT
STA 698+38.3

SET PK/WASHER
8-20-92, BVD

FD RR SPIKE
GPS, CNTRL8
10-01-13

DIST. 21-21A = 24.46'

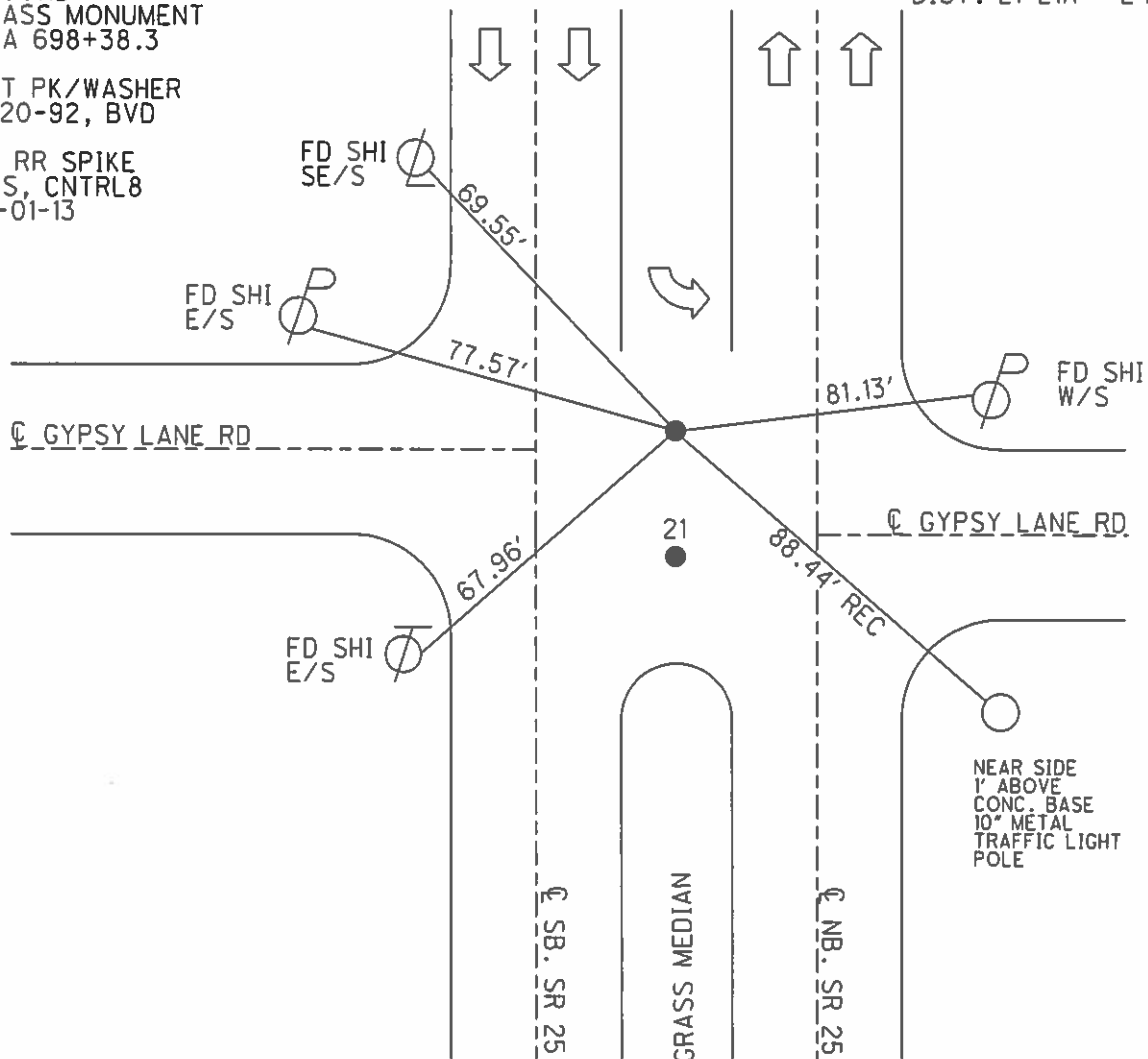

O.D.O.T. DISTRICT 2 SURVEY OFFICE (USE ONLY)

PERSONNEL

REFERENCE NO. 22

SHEET 5 OF 35

NOTES BARNHISEL

DATE 6/10/92

ROUTE US 25

H.C. VAN DUSEN

WEATHER SUNNY

COUNTY WOOD

R.C. BURNETT

TEMP. 55°

TOWNSHIP PLAIN

SECTION 25

DWG BY RHOADES

PID _____

T 5 N R 10 E

TYPE MONUMENT HOB NAIL

ON SURFACE - ~~BELOW~~ ON _____

OFFSET CL PAVEMENT 1.0' ~~LT~~ : RT

- TO - EDGE PAVEMENT


STATION: 482+86

HORIZ.DATUM: _____


GEOID: _____

GRID: NORTHING: _____

EASTING: _____

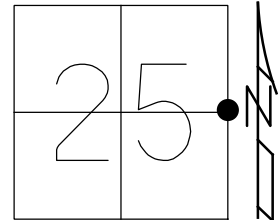

RECORD:
STA. 724+61.35
FD HOB NAIL
6/10/92, MB
SET P.K./WASHER
8/20/92, MB

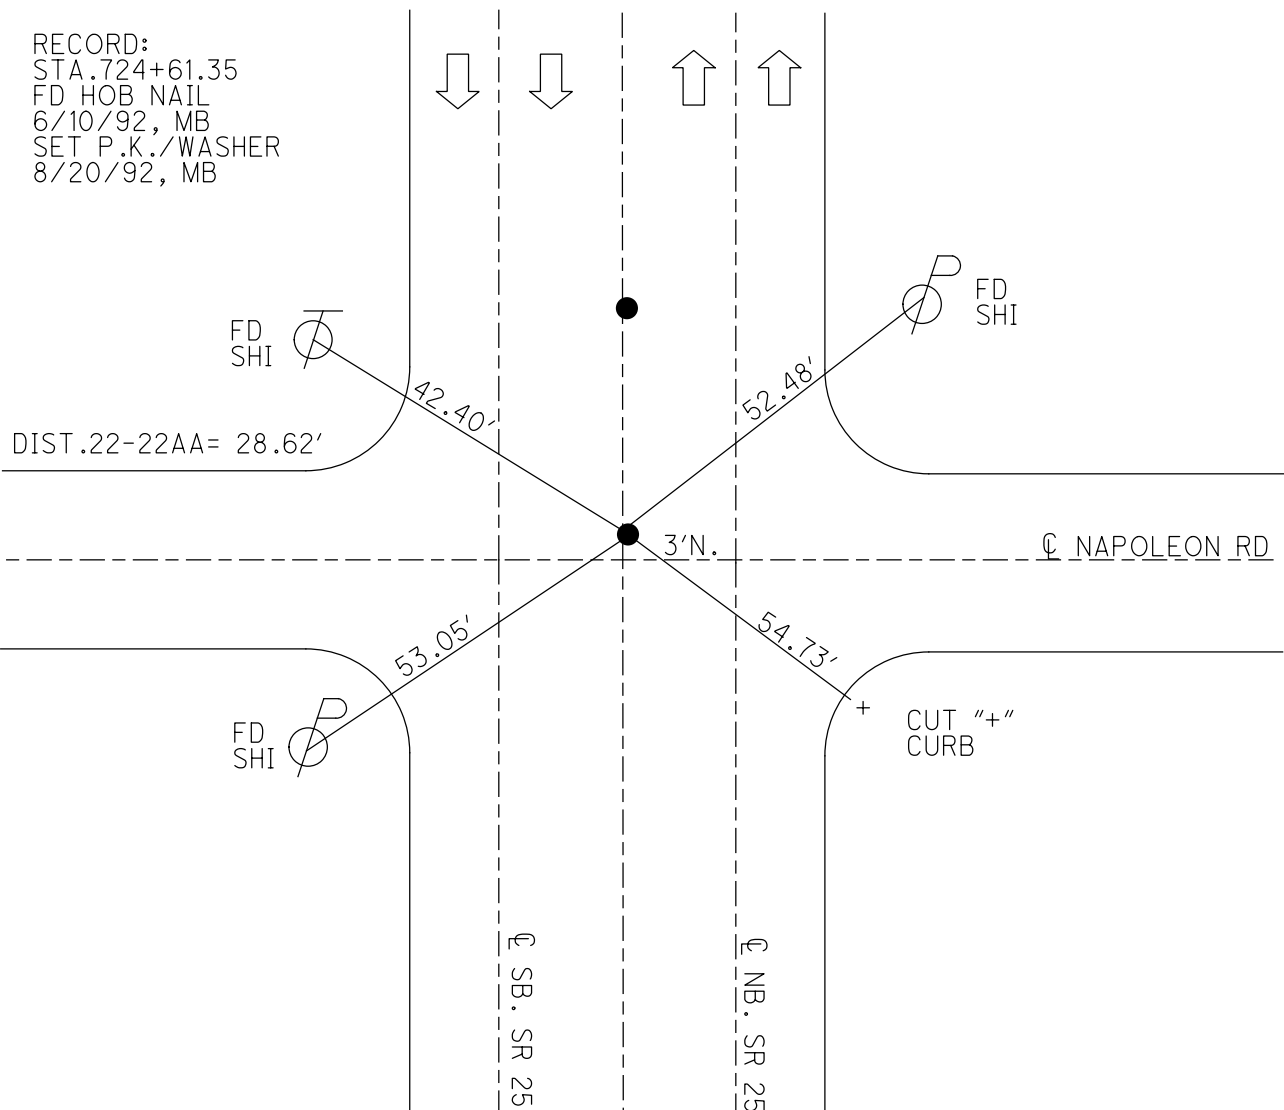

O.D.O.T. DISTRICT 2 SURVEY OFFICE (USE ONLY)

PERSONNEL

REFERENCE NO. 22 AA

SHEET 6 OF 35

NOTES BARNHISEL

DATE 6/10/92

ROUTE US 25

H.C. VAN DUSEN

WEATHER SUNNY

COUNTY WOOD

R.C. BURNETT

TEMP. 55°

TOWNSHIP PLAIN

DWG BY RHOADES PID

SECTION 25

T 5 N R 10 E

TYPE MONUMENT BRASS MON

~~ON SURFACE~~ - BELOW 1 1/2"


OFFSET ℄ PAVEMENT 1.0' ~~LT~~ : RT

- TO - EDGE PAVEMENT


STATION: 483+15

HORIZ.DATUM: GEOID:

GRID: NORTHING: EASTING:

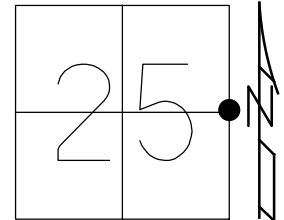

RECORD:
STA. 724+90.05
FD BRASS MON
1 1/2" DOWN
6/10/92, MB
SET P.K./WASHER
8/20/92, MB

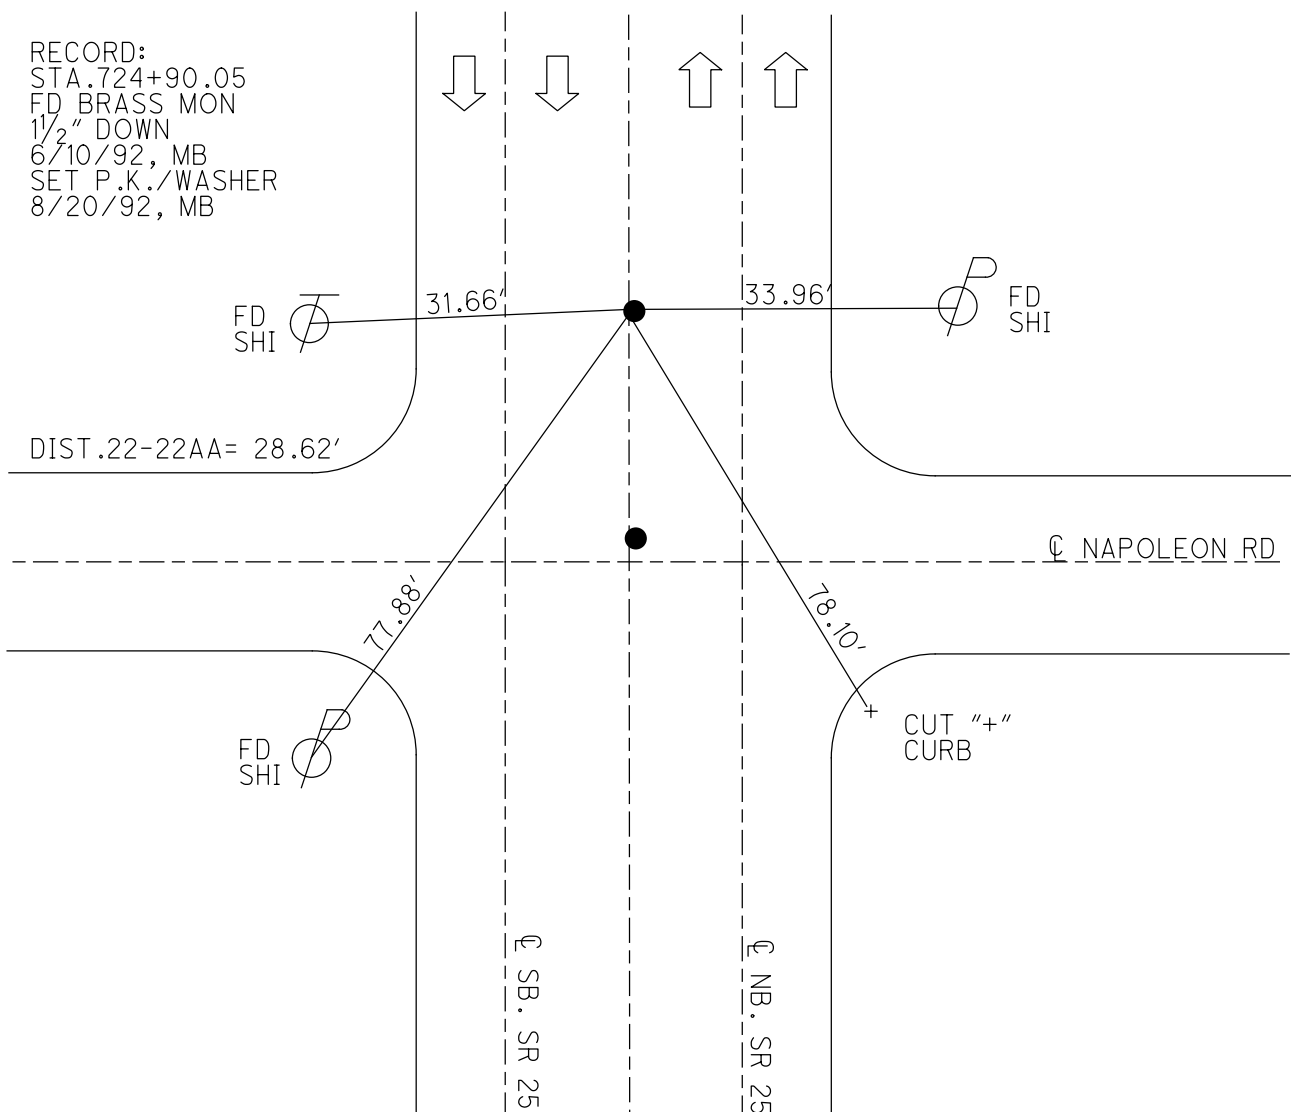

O.D.O.T. DISTRICT 2 SURVEY OFFICE (USE ONLY)

PERSONNEL

REFERENCE NO. 22 A

SHEET 7 OF 35

NOTES BARNHISEL

DATE 4/14/92

ROUTE US 25

H.C. VAN DUSEN

WEATHER CLOUDY

COUNTY WOOD

R.C. BARNHISEL

TEMP. 40°

TOWNSHIP PLAIN

DWG BY RHOADES PID

SECTION 25

T 5 N R 10 E

TYPE MONUMENT P.K.NAIL

ON SURFACE - ~~BELOW~~ ON



OFFSET CL PAVEMENT ON LT : RT

22.6' TO LT EDGE PAVEMENT

STATION: 490+47

HORZ.DATUM: GEOID:

GRID: NORTHING: EASTING:

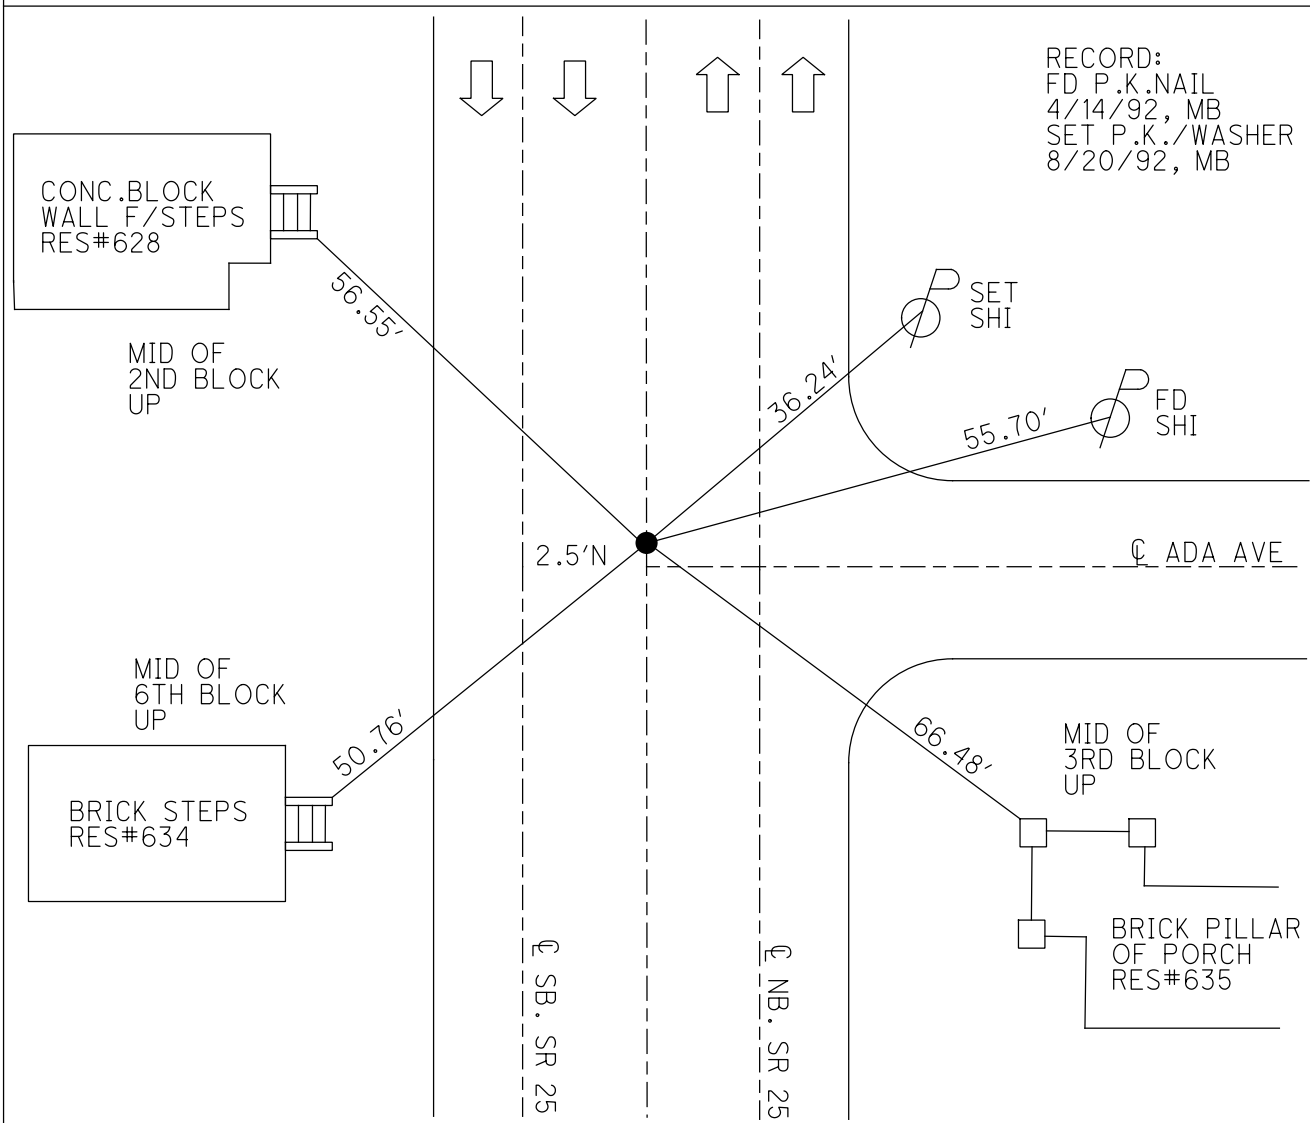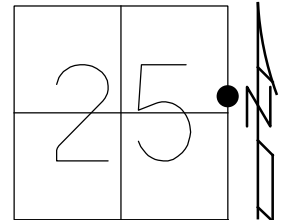

O.D.O.T. DISTRICT 2 SURVEY OFFICE (USE ONLY)

PERSONNEL

REFERENCE NO. 22 B

SHEET 8 OF 35

NOTES BARNHISEL

DATE 4/14/92

ROUTE US 25

H.C. VAN DUSEN

WEATHER CLOUDY

COUNTY WOOD

R.C. BARNHISEL

TEMP. 40°

TOWNSHIP PLAIN

SECTION 25

DWG BY RHOADES

PID _____

T 5 N R 10 E

TYPE MONUMENT P.K.NAIL

ON SURFACE - ~~BELOW~~ ON _____

OFFSET Q PAVEMENT ON _____ LT : RT

- TO - EDGE PAVEMENT


STATION: 493+51

HORIZ.DATUM: _____

GEOID: _____

GRID: NORTHING: _____

EASTING: _____

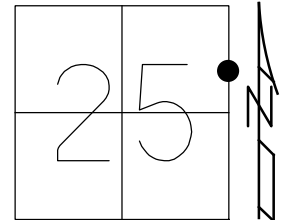

RECORD:
FD P.K.NAIL
4/14/92, MB
SET P.K./WASHER
8/20/92, MB



DIST.22B-22BC= 110.00'

COR.BRICK
PORCH POST

50.12'

RES#602

COR.FDN

58.75'

SET
SHI

RES#539

CONC. BLOCK
1ST BRICK UP

35.70'

67.60'

Q GEORGIA AVE

70.46'

BRICK
PORCH FDN
2ND BRICK UP

RES#605

Q SB. SR 25

Q NB. SR 25

O.D.O.T. DISTRICT 2 SURVEY OFFICE (USE ONLY)

PERSONNEL

REFERENCE NO. 22 BC

SHEET 9 OF 35

NOTES BARNHISEL DATE 4/14/92

ROUTE US 25

H.C. VAN DUSEN WEATHER CLOUDY

COUNTY WOOD

R.C. BARNHISEL TEMP. 40°

TOWNSHIP PLAIN

PLoS ONE | <https://doi.org/10.1371/journal.pone.0221455> g001

SECTION 25

DWG BY RHOADES PID

T_5_N R_10_E

TYPE MONUMENT P.K.NAIL

ON SURFACE - ~~BELOW~~ ON _____

OFFSET C PAVEMENT ON LT : RT

22.7' TO RT CURB


STATION: 494+61

HORZ.DATUM: _____


GEOID: _____

GRID: NORTHING:_____ EASTING:_____

EASTING: _____

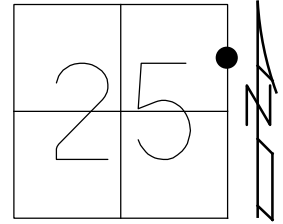

RECORD:
STA.736+28.77
FD P.K.NAIL
4/14/92, MB
SET P.K./WASHER
8/20/92, MB

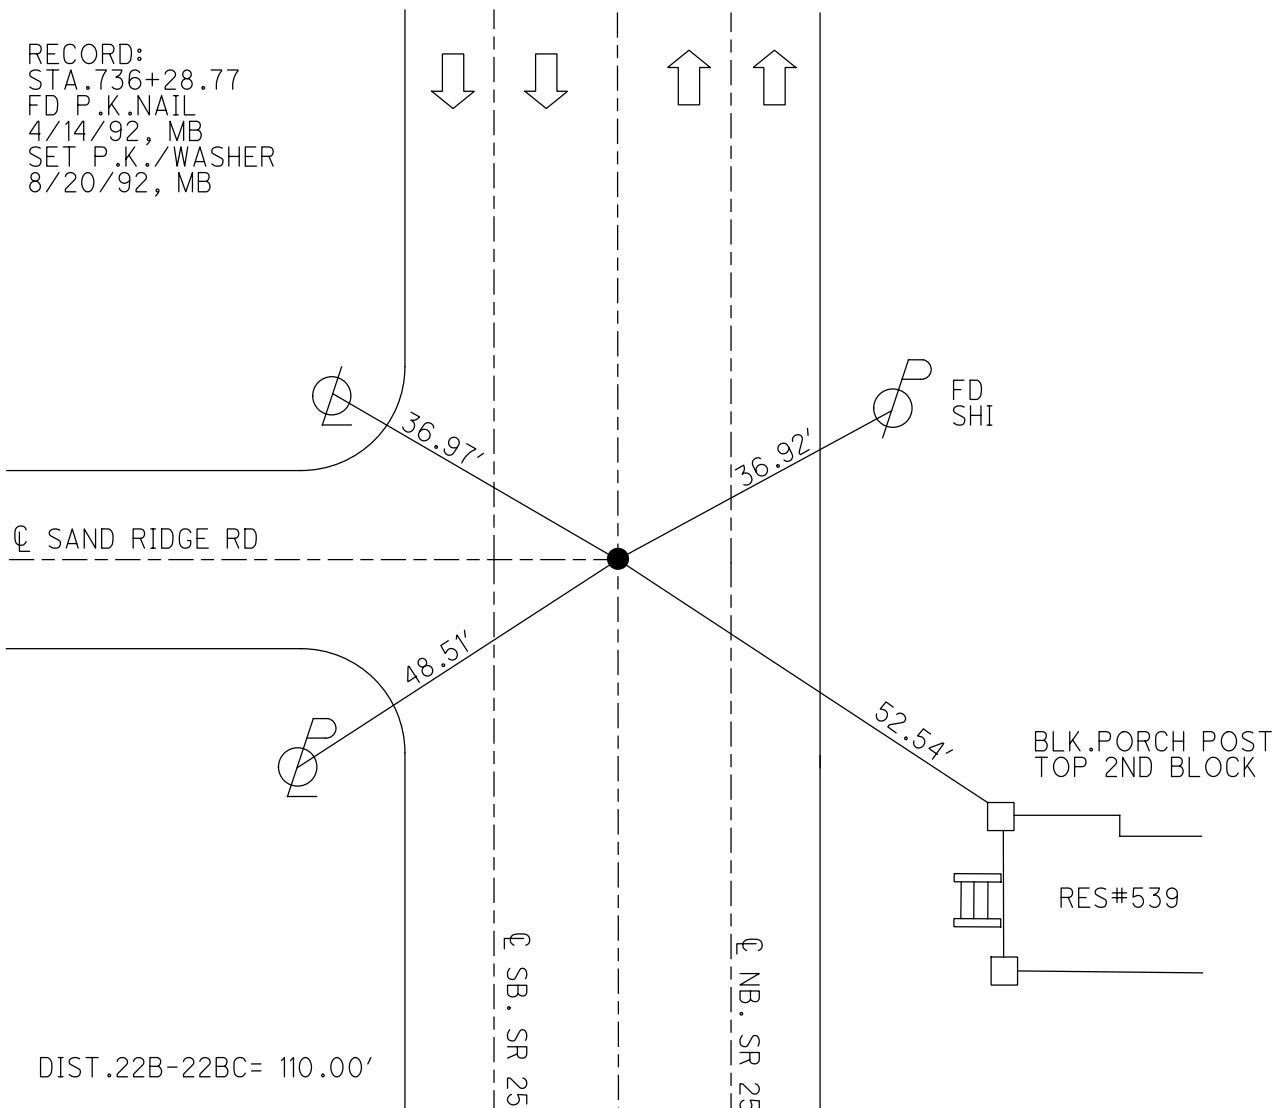

DIST.22B-22BC= 110.00'

O.D.O.T. DISTRICT 2 SURVEY OFFICE (USE ONLY)

PERSONNEL

REFERENCE NO. 22 C

SHEET 10 OF 35

NOTES BARNHISEL

DATE 4/14/92

ROUTE US 25

H.C. VAN DUSEN

WEATHER CLOUDY

COUNTY WOOD

R.C. BARNHISEL

TEMP. 40°

TOWNSHIP PLAIN

SECTION 25

DWG BY RHOADES PID _____

T 5 N R 10 E

TYPE MONUMENT P.K.NAIL

ON SURFACE - ~~BELOW~~ ON

OFFSET CL PAVEMENT ON LT : RT

22.3' TO LT CURB


STATION: 496+51

HORIZ.DATUM: _____

GEOID: _____

GRID: NORTHING: _____

EASTING: _____

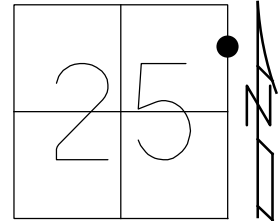

RECORD:
FD P.K.NAIL
4/14/92, MB
SET P.K./WASHER
9/18/92, MB

SET SHI
CONC.WALK
JOINT
0.8' FR/EDGE



24.45'

CL SB. SR 25

CL NB. SR 25

41.62'

33.03'

38.21'

81.73'

COR.
CURB
INLET

FD "+"
CURB

SET
SHI

SET
SHI

O.D.O.T. DISTRICT 2 SURVEY OFFICE (USE ONLY)

PERSONNEL

REFERENCE NO. 22 D

SHEET 11 OF 35

NOTES BARNHISEL

DATE 4/14/92

ROUTE US 25

H.C. VAN DUSEN

WEATHER CLOUDY

COUNTY WOOD

R.C. BARNHISEL

TEMP. 40°

TOWNSHIP PLAIN

SECTION 25

DWG BY RHOADES PID

T 5 N R 10 E

TYPE MONUMENT P.K.NAIL

ON SURFACE - ~~BELOW~~ ON


OFFSET CL PAVEMENT ON LT : RT

22.3' TO LT CURB

STATION: 499+53

HORZ.DATUM: GEOID:


GRID: NORTHING: EASTING:

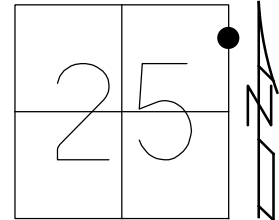


RECORD:
FD P.K.NAIL
4/14/92, MB
SET P.K./WASHER
9/18/92, MB



COR.CONC.
BLOCK PORCH
TOP 2ND BLK
UP

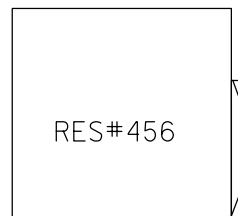

COR.CONC.
BLOCK PORCH
TOP 2ND BLK
UP

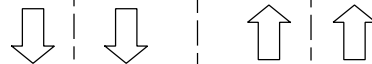

66.55'

73.59'

34.35'

59.29'

FD
SHI

SET
SHI

CL PALMER AVE

CL SB. SR 25

CL NB. SR 25

O.D.O.T. DISTRICT 2 SURVEY OFFICE (USE ONLY)

PERSONNEL

REFERENCE NO. 22 E

SHEET 12 OF 35

NOTES BARNHISEL

DATE 4/14/92

ROUTE US 25

H.C. VAN DUSEN

WEATHER CLOUDY

COUNTY WOOD

R.C. BARNHISEL

TEMP. 40°

TOWNSHIP PLAIN

SECTION 25

DWG BY RHOADES PID

T 5 N R 10 E

TYPE MONUMENT P.K.NAIL

ON SURFACE - ~~BELOW~~ ON


OFFSET CL PAVEMENT ON LT : RT

22.3' TO LT CURB


STATION: 501+75

HORZ.DATUM: GEOID:

GRID: NORTHING: EASTING:

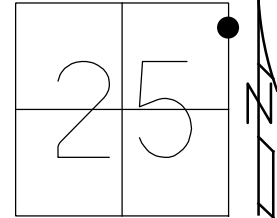

RECORD:
FD P.K.NAIL
4/14/92, MB
SET P.K./WASHER
9/18/92, MB

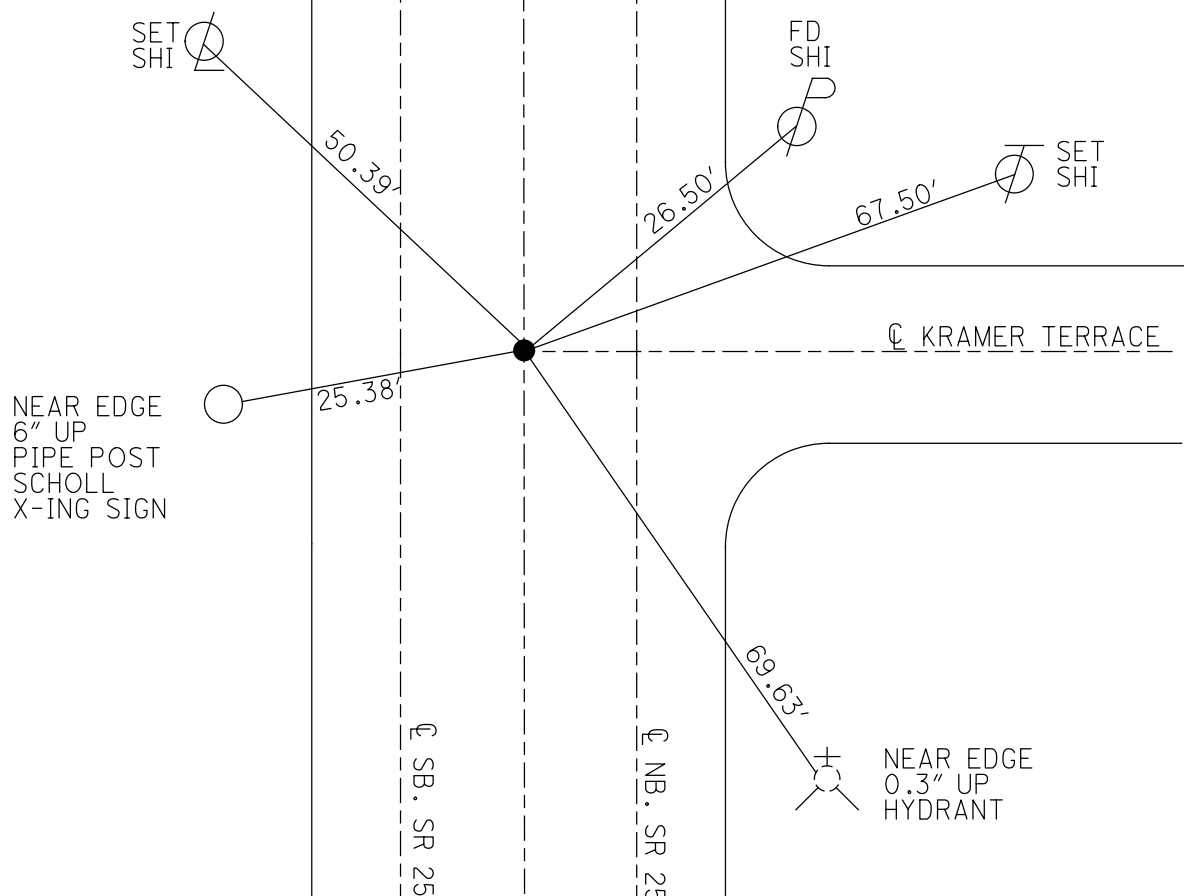

O.D.O.T. DISTRICT 2 SURVEY OFFICE (USE ONLY)

PERSONNEL

REFERENCE NO. 22 F

SHEET 13 OF 35

NOTES BARNHISEL

DATE 6/10/92

ROUTE US 25

H.C. VAN DUSEN

WEATHER SUNNY

COUNTY WOOD

R.C. BURNETT

TEMP. 55°

TOWNSHIP PLAIN

SECTION 25

DWG BY RHOADES

PID _____

T 5 N R 10 E

TYPE MONUMENT P.K./WASHER

ON SURFACE - ~~BELOW~~ ON

OFFSET ℄ PAVEMENT ON LT : RT

22.0' TO LT EDGE PAVEMENT


STATION: 505+68

HORZ.DATUM: _____

GEOID: _____

GRID: NORTHING: _____

EASTING: _____

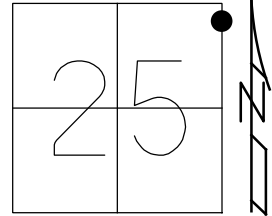

RECORD:
FD POINT DESTROYED
SET P.K./WASHER
6/10/92, MB
SET P.K./WASHER
9/18/92, MB
FD DESTROYED
6/14/01



COR. STONE
BLDG.

63.34'

#344
BEAUTY
SALON

℄ LEHMAN AVE

℄ SB. SR 25

℄ NB. SR 25

O.D.O.T. DISTRICT 2 SURVEY OFFICE (USE ONLY)

PERSONNEL

REFERENCE NO. 23

SHEET 14 OF 35

NOTES BARNHISEL

DATE 6/14/01

ROUTE US 25

H.C. CANTERBURY

WEATHER SUNNY

COUNTY WOOD

R.C. MOSER

TEMP. 90°

TOWNSHIP PLAIN

SECTION 25

DWG BY RHOADES

PID

T 5 N R 10 E

TYPE MONUMENT IPIN

ON SURFACE - ~~BELOW~~ ON

OFFSET CL PAVEMENT 1.0' ~~LT~~ : RT

30.3' TO RT EDGE PAVEMENT



STATION: 509+73

HORZ.DATUM:

GEOID:

GRID: NORTHING:

EASTING:

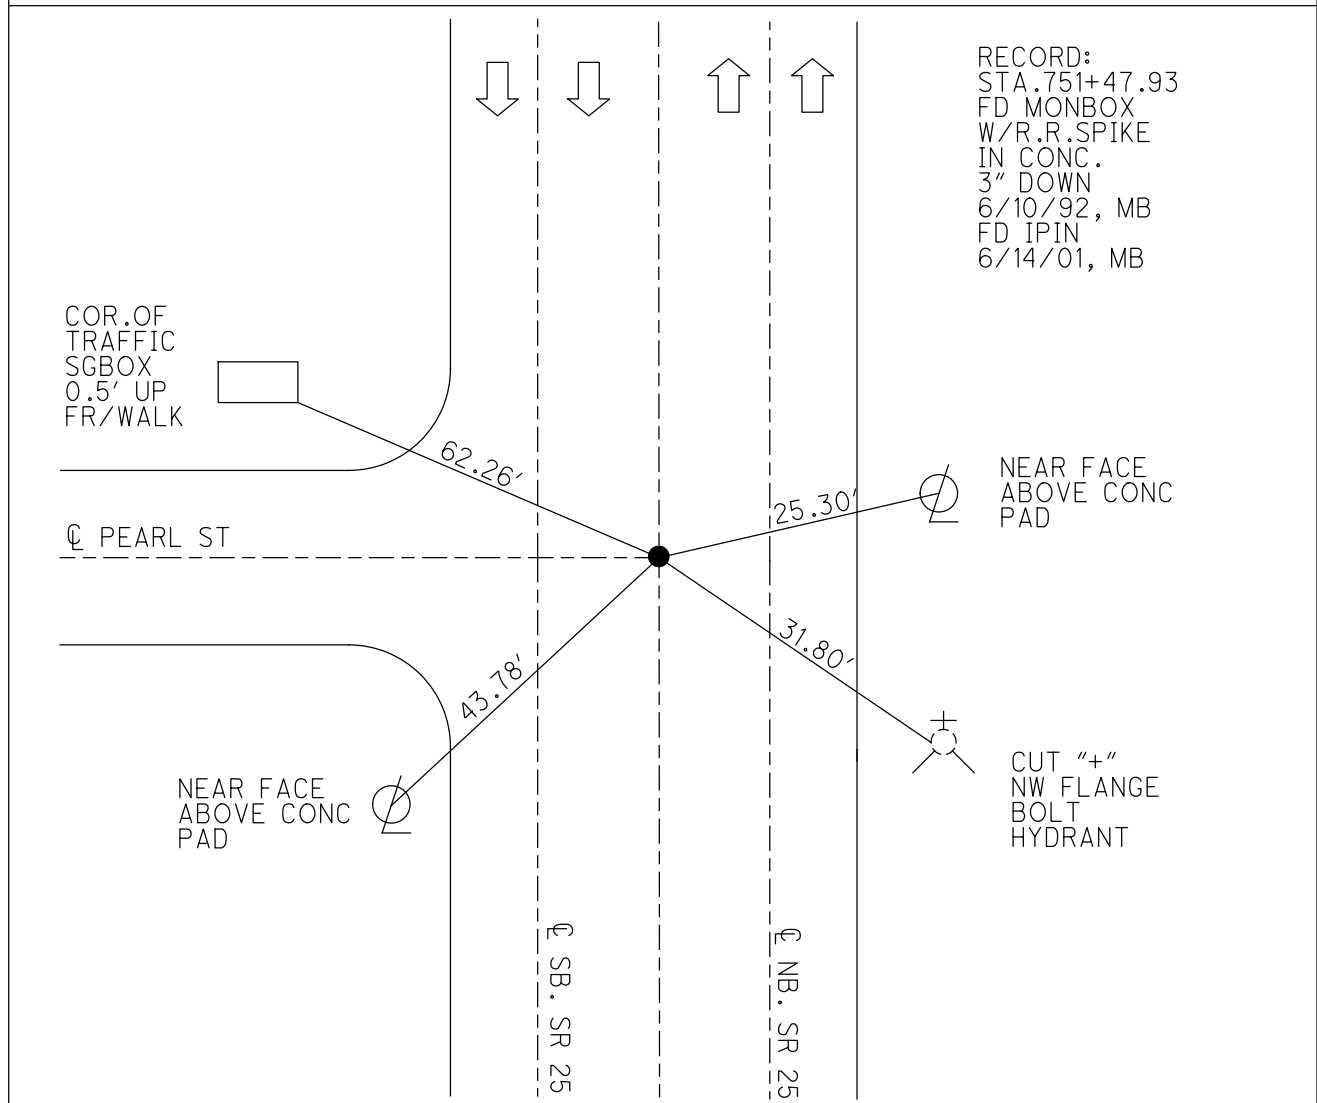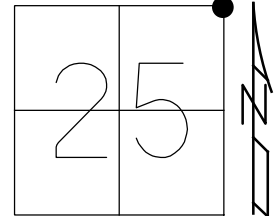

O.D.O.T. DISTRICT 2 SURVEY OFFICE (USE ONLY)

PERSONNEL

REFERENCE NO. 24

SHEET 15 OF 35

NOTES BARNHISEL

DATE 6/14/01

ROUTE US 25

H.C. CANTERBURY

WEATHER SUNNY

COUNTY WOOD

R.C. MOSER

TEMP. 90°

TOWNSHIP PLAIN

SECTION 24

DWG BY RHOADES

PID

T 5 N R 10 E

TYPE MONUMENT P.K./WASHER

ON SURFACE - ~~BELOW~~ ON

OFFSET CL PAVEMENT 2.5' LT : RT

- TO - EDGE PAVEMENT


STATION: 522+90

HORIZ.DATUM:

GEOID:

GRID: NORTHING:

EASTING:

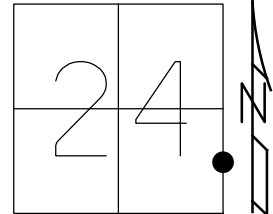

RECORD:
FD R.R.SPIKE
6/10/92, MB
SET P.K./WASHER
9/18/92, MB
FD P.K./WASHER
6/14/01, MB

CHILDREN'S
CLOTHING STORE

MID.OF
DOOR JAM

62.77'



TRAVEL AGENCY

50.41'

MID.3RD
BRICK

CL SR 64-WOOSTER ST

1.3'S.

MID.2ND
BRICK

52.21'

RAYLE & STEARNS
ATTORNEYS

CL SB. SR 25

CL NB. SR 25

BOTTOM
COLUMN ABOVE
CROWN MOLDING

50.16'

UHLMAN'S CLOTHING
STORE

O.D.O.T. DISTRICT 2 SURVEY OFFICE (USE ONLY)

PERSONNEL

REFERENCE NO. 24 AA

SHEET 16 OF 35

NOTES BARNHISEL

DATE 6/14/01

ROUTE US 25

H.C. CANTERBURY

WEATHER SUNNY

COUNTY WOOD

R.C. MOSER

TEMP. 90°

TOWNSHIP PLAIN

SECTION 24

DWG BY RHOADES

PID

T 5 N R 10 E

TYPE MONUMENT P.K.NAIL

ON SURFACE - ~~BELOW~~ ON

OFFSET $\mathcal{C}$ PAVEMENT 1.0' ~~LT~~ : RT

- TO - EDGE PAVEMENT


STATION: 526+91

HORZ.DATUM:

GEOID:

GRID: NORTHING:

EASTING:

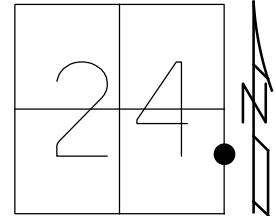

RECORD:
FD P.K.NAIL
6/10/92, MB
SET P.K./WASHER
9/18/92, MB
FD P.K.NAIL
6/14/01, MB



CORNER
GRILL

COR.CONC.
FRONT ENT.
3" UP

$\mathcal{C}$ E.COURT ST

COR.BRICK
PILLAR
3" UP

DOWNTOWN
ATHLETIC
CLUB

$\mathcal{C}$ SB. SR 25

$\mathcal{C}$ NB. SR 25



48.71'

46.88'

O.D.O.T. DISTRICT 2 SURVEY OFFICE (USE ONLY)

PERSONNEL

REFERENCE NO. 24 A

SHEET 17 OF 35

NOTES BARNHISEL

DATE 6/14/01

ROUTE US 25

H.C. CANTERBURY

WEATHER SUNNY

COUNTY WOOD

R.C. MOSER

TEMP. 90°

TOWNSHIP PLAIN

SECTION 24

DWG BY RHOADES PID

T 5 N R 10 E

TYPE MONUMENT P.K.NAIL

ON SURFACE - ~~BELOW~~ ON


OFFSET CL PAVEMENT 1.0' ~~LT~~ : RT

27.7' TO LT EDGE PAVEMENT

STATION: 529+65

HORIZ.DATUM: GEOID:

GRID: NORTHING: EASTING:

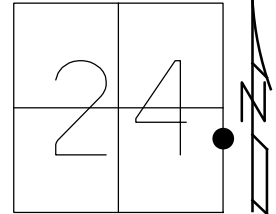

RECORD:
FD P.K.NAIL
6/10/92
SET P.K./WASHER
9/18/92, MB
D.N.F.
6/14/01, MB



CL W.OAK ST

CL SB. SR 25

CL NB. SR 25

O.D.O.T. DISTRICT 2 SURVEY OFFICE (USE ONLY)

PERSONNEL

REFERENCE NO. 24 AB

SHEET 18 OF 35

NOTES BARNHISEL

DATE 6/14/01

ROUTE US 25

H.C. CANTERBURY

WEATHER SUNNY

COUNTY WOOD

R.C. MOSER

TEMP. 90°

TOWNSHIP PLAIN

SECTION 24

DWG BY RHOADES

PID

T 5 N R 10 E

TYPE MONUMENT MONBOX

ON SURFACE - ~~BELOW~~ ON

OFFSET CL PAVEMENT 1.0' ~~LT~~ : RT

27.6' TO RT EDGE PAVEMENT


STATION: 530+39

HORZ. DATUM:

GEOID:

GRID: NORTHING:

EASTING:

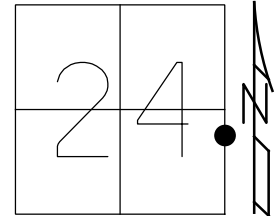

RECORD:
FD MONBOX
6/10/92, MB
6/14/01, MB

NEAR FACE
LPOLES
ABOVE CONC.

53.11' P

47.18' P

M

38.00' P

38.73' P

CUT "+"
SW FLANGE
BOLT
HYDRANT

CL E.OAK ST

CL SB. SR 25

CL NB. SR 25



O.D.O.T. DISTRICT 2 SURVEY OFFICE (USE ONLY)

PERSONNEL

REFERENCE NO. 24 B

SHEET 19 OF 35

NOTES BARNHISEL

DATE 6/14/01

ROUTE US 25

H.C. CANTERBURY

WEATHER SUNNY

COUNTY WOOD

R.C. MOSER

TEMP. 90°

TOWNSHIP PLAIN

SECTION 24

DWG BY RHOADES

PID _____

T 5 N R 10 E

TYPE MONUMENT MONBOX

ON SURFACE - ~~BELOW~~ ON

OFFSET CL PAVEMENT ON LT : RT

- TO - EDGE PAVEMENT


STATION: 534+70

HORIZ.DATUM: _____

GEOID: _____

GRID: NORTHING: _____

EASTING: _____

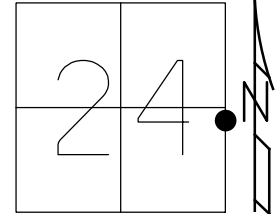

DIST. 24B-24BA= 96.98' P

CUT "+"
SE/S BOTTOM
FLANGE
HYDRANT

CL CLAY ST

RECORD:
STA. 776+44.25
FD BOLT SPIKE
IN CONC.
6" DOWN
FD MONBOX
W/DRILLH
IN CONC.
6/10/92
6/14/01, MB

SET
SHI

NEAR FACE
LPOLE
ABOVE CONC.

FD
SHI

53.60' P

36.95' P

73.35' P

37.34' P

CL SB. SR 25

CL NB. SR 25



O.D.O.T. DISTRICT 2 SURVEY OFFICE (USE ONLY)

PERSONNEL

REFERENCE NO. 24 BA

SHEET 20 OF 35

NOTES BARNHISEL

DATE 6/14/01

ROUTE US 25

H.C. CANTERBURY

WEATHER SUNNY

COUNTY WOOD

R.C. MOSER

TEMP. 90°

TOWNSHIP PLAIN

DWG BY RHOADES

PID _____

SECTION 24

T 5 N R 10 E

TYPE MONUMENT MONBOX W/IPIN

ON SURFACE - ~~BELOW~~ ON

OFFSET CL PAVEMENT ON LT : RT

- TO - EDGE PAVEMENT



STATION: 535+66.98

HORZ.DATUM: _____

GEOID: _____

GRID: NORTHING: _____

EASTING: _____

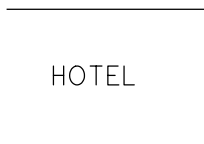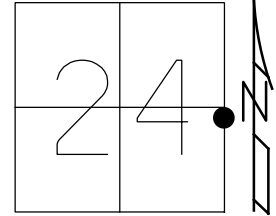

0.3' UP
CONC. WALK



M 24BB

RECORD:
STA. 777+41.21
FD MONBOX
W/IPIN
FD MONBOX
W/IPIN
2" DOWN
6/10/92
6/14/01, MB

CUT "+"
SW FLANGE
BOLT
HYDRANT

SET
SHI

28.75' P

M

43.22' P

CL RIDGE ST


40.97' P

FD
SHI

DIST.
24B-24BA= 96.98' P
24BA-24BB= 58.67' P

CL SB. SR 25

CL NB. SR 25

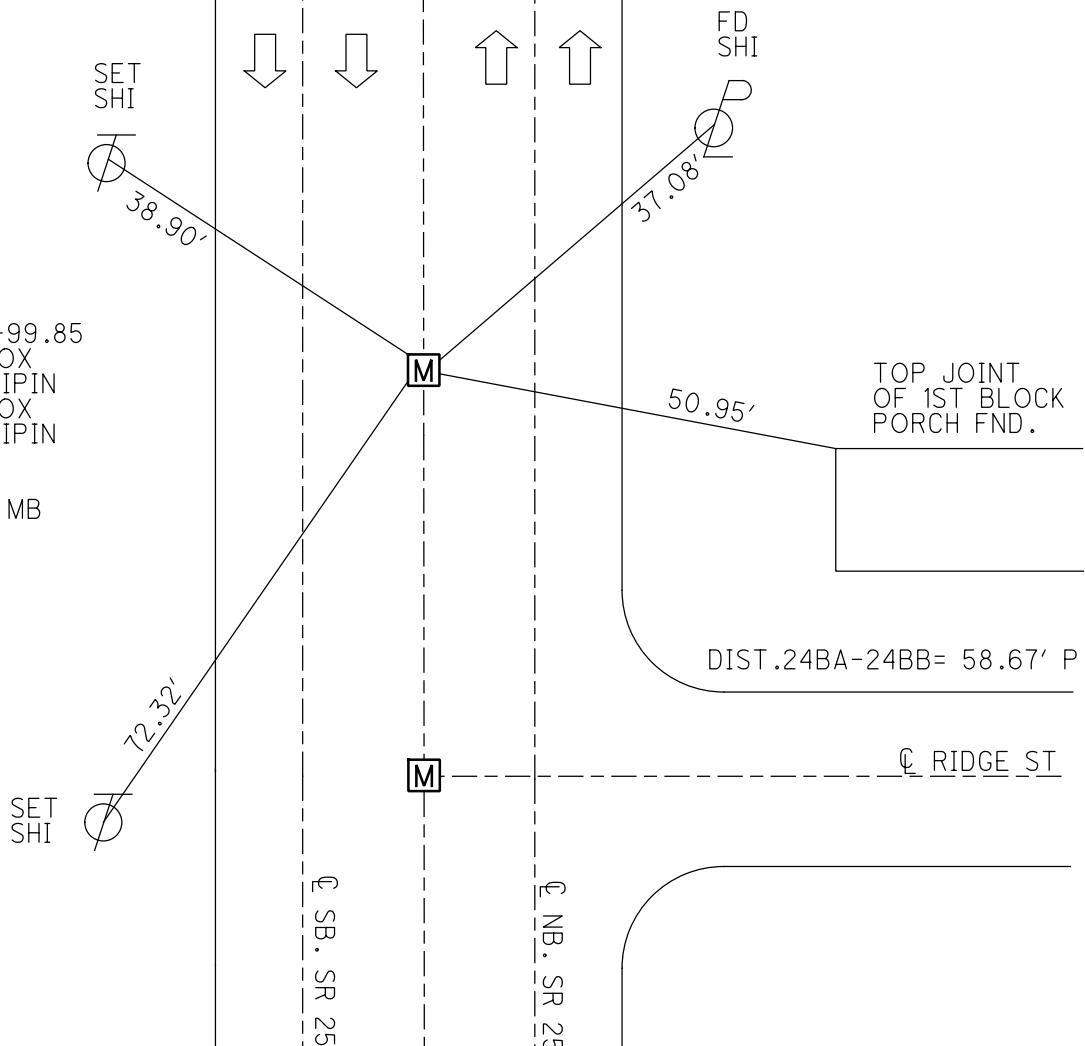

O.D.O.T. DISTRICT 2 SURVEY OFFICE (USE ONLY)

PERSONNEL

REFERENCE NO. 24 C

SHEET 22 OF 35

NOTES BARNHISEL

DATE 6/10/92

ROUTE US 25

H.C. VAN DUSEN

WEATHER SUNNY

COUNTY WOOD

R.C. BARNHISEL

TEMP. 65°

TOWNSHIP PLAIN

SECTION 24

DWG BY RHOADES PID

T 5 N R 10 E

TYPE MONUMENT MONBOX

~~ON SURFACE~~ - BELOW 5"

OFFSET CL PAVEMENT ON LT : RT

26.3' TO RT EDGE PAVEMENT



STATION: 537+83

HORIZ.DATUM:

GEOID:

GRID: NORTHING:

EASTING:

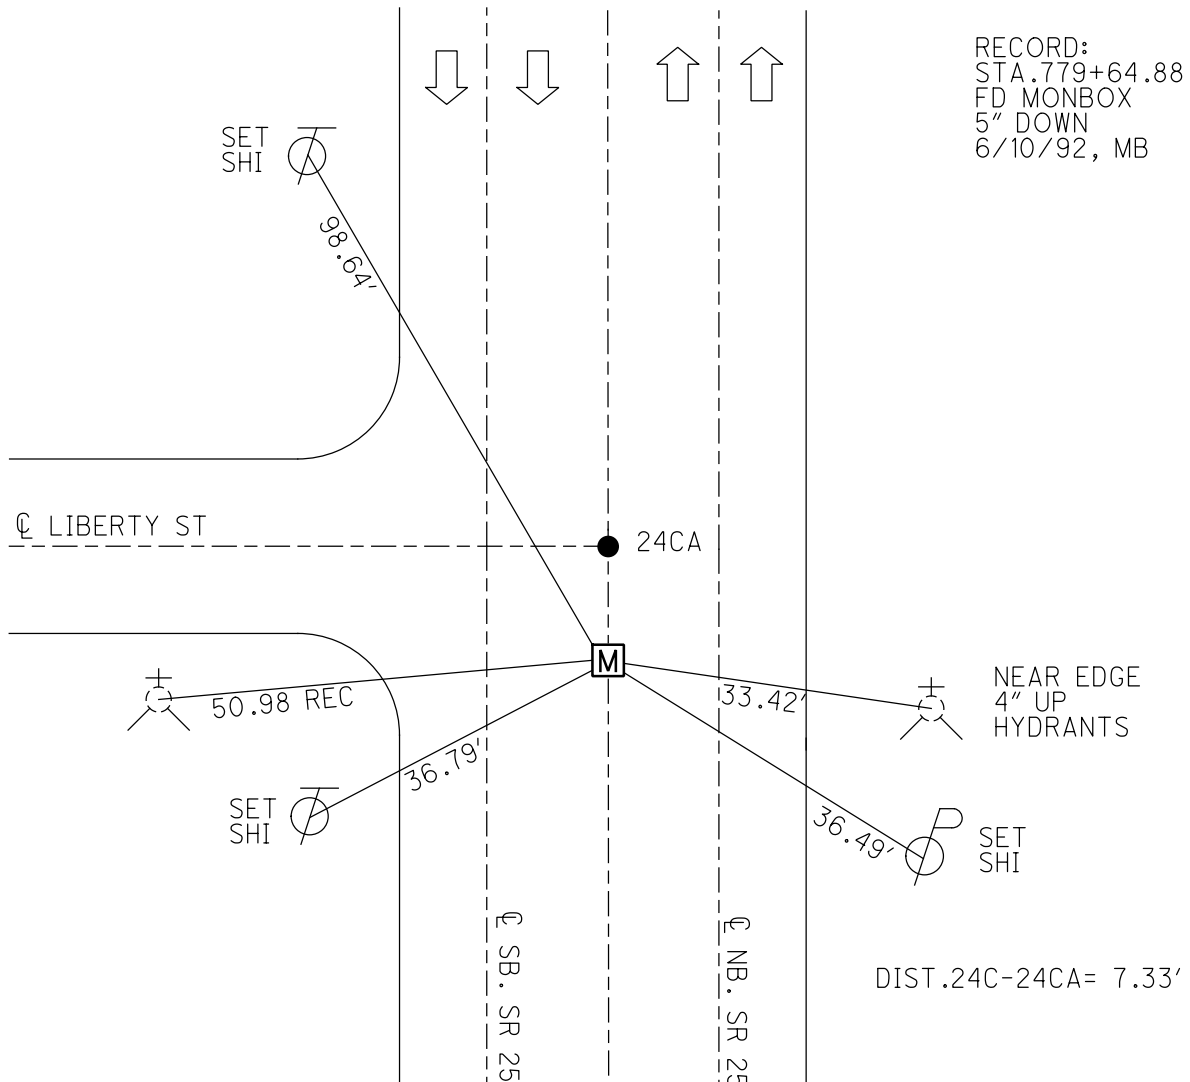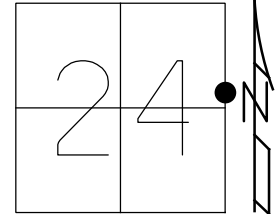

O.D.O.T. DISTRICT 2 SURVEY OFFICE (USE ONLY)

PERSONNEL

REFERENCE NO. 24 CA

SHEET 23 OF 35

NOTES BARNHISEL

DATE 6/10/92

ROUTE US 25

H.C. VAN DUSEN

WEATHER SUNNY

COUNTY WOOD

R.C. BARNHISEL

TEMP. 65°

TOWNSHIP PLAIN

SECTION 24

DWG BY RHOADES

PID _____

T 5 N R 10 E

TYPE MONUMENT P.K.NAIL

ON SURFACE - ~~BELOW~~ ON

OFFSET CL PAVEMENT ON LT : RT

26.3' TO RT EDGE PAVEMENT


STATION: 537+90

HORIZ.DATUM: _____

GEOID: _____

GRID: NORTHING: _____

EASTING: _____

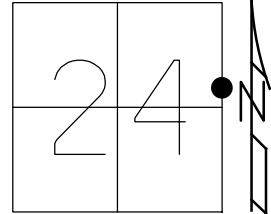

RECORD:
D.N.F. P.K.NAIL
6/10/92
SET P.K./WASHER
9/18/92, MB

CL LIBERTY ST

NEAR EDGE
4" UP
HYDRANT

51.77'

M
24C

CL SB. SR 25

CL NB. SR 25

27.29'

FD "+"
TOP CURB

DIST. 24C-24CA= 7.33'

O.D.O.T. DISTRICT 2 SURVEY OFFICE (USE ONLY)

PERSONNEL

REFERENCE NO. 24 CB

SHEET 24 OF 35

NOTES BARNHISEL

DATE 6/10/92

ROUTE US 25

H.C. VAN DUSEN

WEATHER SUNNY

COUNTY WOOD

R.C. BARNHISEL

TEMP. 65°

TOWNSHIP PLAIN

SECTION 24

DWG BY RHOADES

PID

T 5 N R 10 E

TYPE MONUMENT P.K.NAIL

ON SURFACE - ~~BELOW~~ ON

OFFSET CL PAVEMENT ON LT : RT

26.3' TO RT EDGE PAVEMENT


STATION: 540+98

HORIZ.DATUM:


GEOID:

GRID: NORTHING:

EASTING:

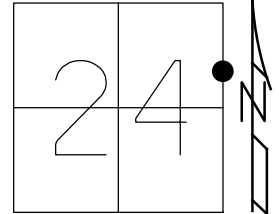

RECORD:
STA. 782+69.58
FD P.K.NAIL
6/10/92
SET P.K./WASHER
9/18/92, MB

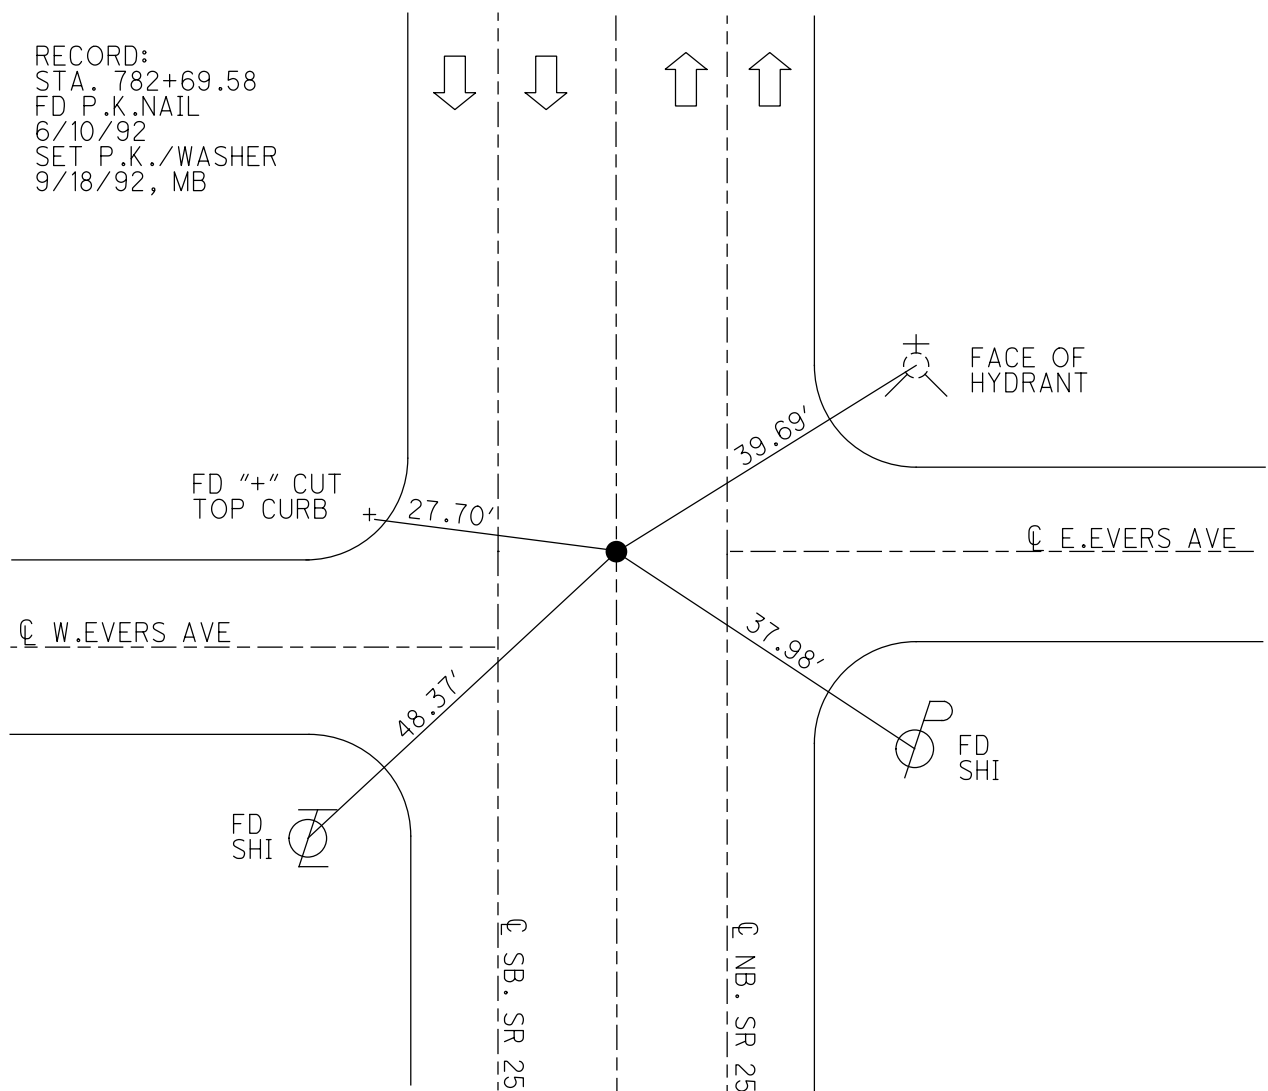

O.D.O.T. DISTRICT 2 SURVEY OFFICE (USE ONLY)

PERSONNEL

REFERENCE NO. 24 CB

SHEET 25 OF 35

NOTES BARNHISEL

DATE 6/11/92

ROUTE US 25

H.C. VAN DUSEN

WEATHER SUNNY

COUNTY WOOD

R.C. BARNHISEL

TEMP. 60°

TOWNSHIP PLAIN

SECTION 24

DWG BY RHOADES

PID _____

T 5 N R 10 E

TYPE MONUMENT P.K.NAIL

ON SURFACE - ~~BELOW~~ ON

OFFSET Q PAVEMENT ON LT : RT

- TO - EDGE PAVEMENT



STATION: 545+11

HORZ.DATUM: _____

GEOID: _____

GRID: NORTHING: _____

EASTING: _____

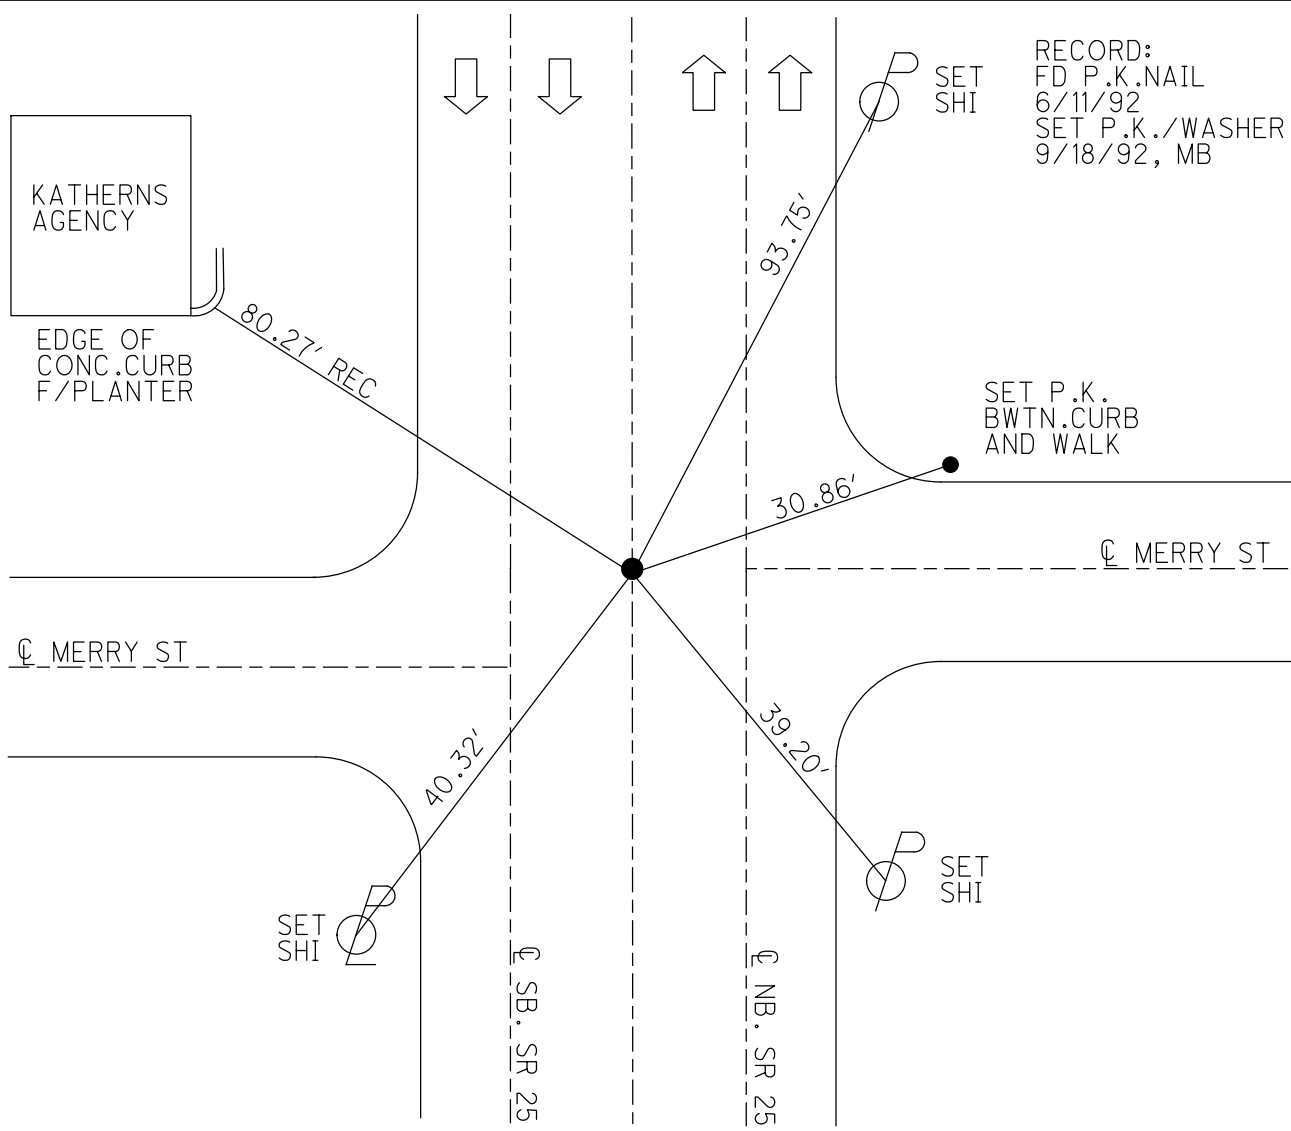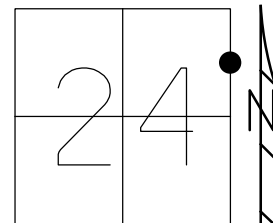

O.D.O.T. DISTRICT 2 SURVEY OFFICE (USE ONLY)

PERSONNEL

REFERENCE NO. 24 D

SHEET 26 OF 35

NOTES BARNHISEL

DATE 6/11/92

ROUTE US 25

H.C. VAN DUSEN

WEATHER SUNNY

COUNTY WOOD

R.C. BARNHISEL

TEMP. 60°

TOWNSHIP PLAIN

SECTION 24

DWG BY RHOADES

PID _____

T 5 N R 10 E

TYPE MONUMENT P.K.NAIL

ON SURFACE - ~~BELOW~~ ON _____

OFFSET Q PAVEMENT ON _____ LT : RT

_____ TO _____ EDGE PAVEMENT


STATION: 548+38

HORZ.DATUM: _____


GEOID: _____

GRID: NORTHING: _____

EASTING: _____

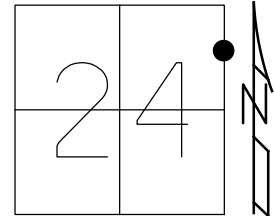

RECORD:
STA. 790+11.22
D.N.F. P.K.NAIL
SET P.K./WASHER
9/22//92, MB

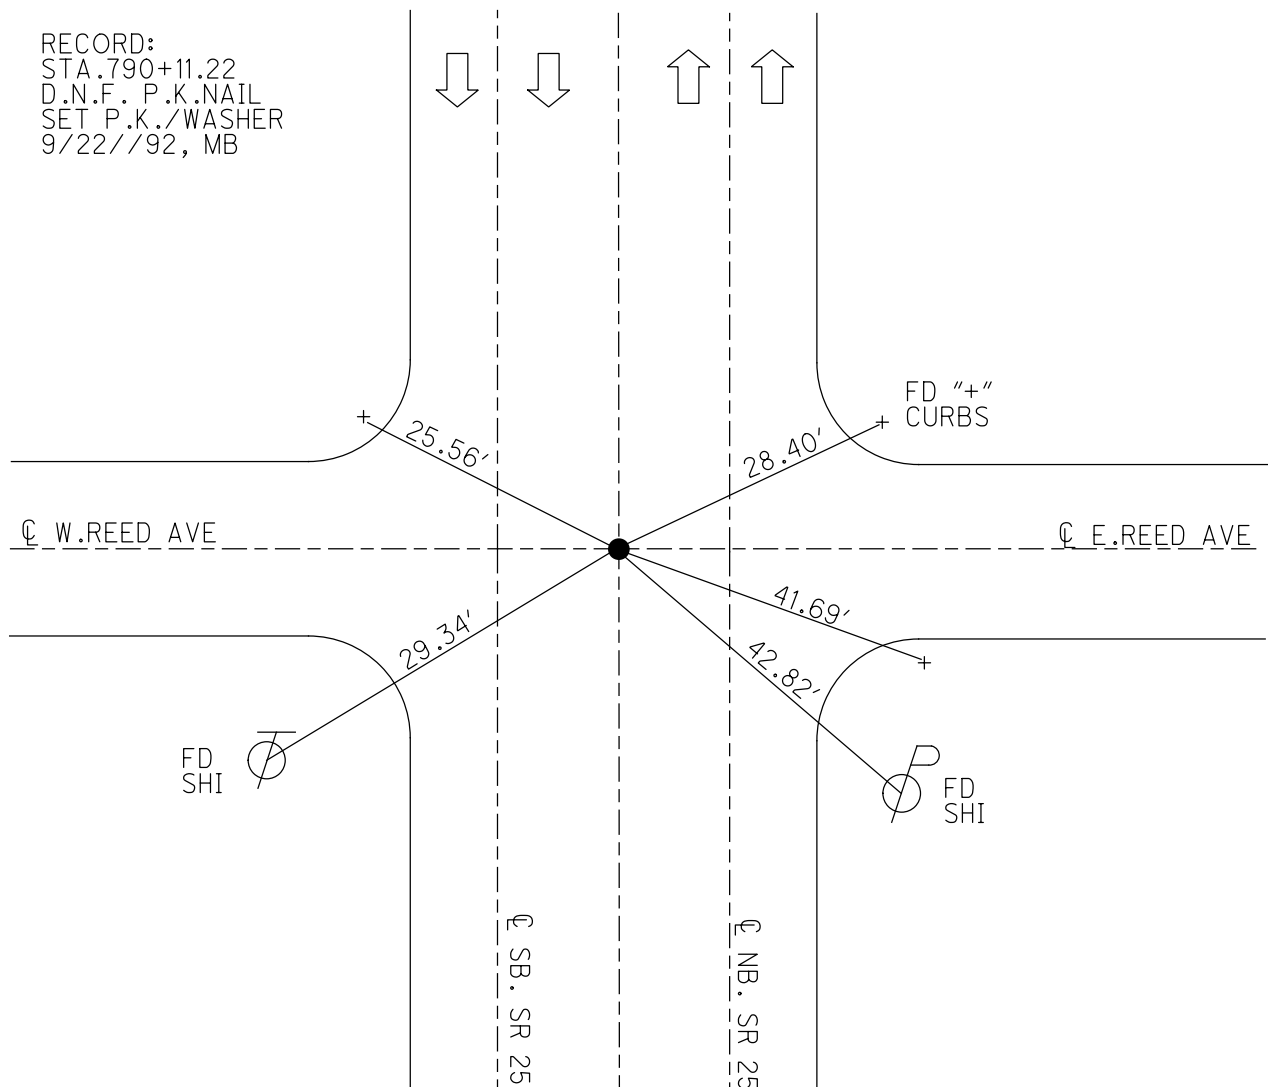

O.D.O.T. DISTRICT 2 SURVEY OFFICE (USE ONLY)

PERSONNEL

REFERENCE NO. 24 E

SHEET 27 OF 35

NOTES BARNHISEL

DATE 6/11/92

ROUTE US 25

H.C. VAN DUSEN

WEATHER SUNNY

COUNTY WOOD

R.C. BARNHISEL

TEMP. 60°

TOWNSHIP PLAIN

SECTION 24

DWG BY RHOADES

PID _____

T 5 N R 10 E

TYPE MONUMENT P.K.NAIL

ON SURFACE - ~~BELOW~~ ON _____

OFFSET CL PAVEMENT ON _____ LT : RT

22.8' TO RT EDGE PAVEMENT


STATION: 551+16

HORZ.DATUM: _____


GEOID: _____

GRID: NORTHING: _____

EASTING: _____

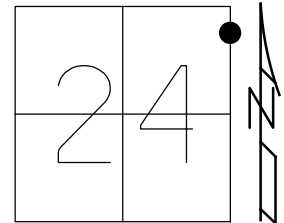

RECORD:
STA. 793+37.09
D.N.F.
6/11/92
SET P.K./WASHER
9/22/92, MB

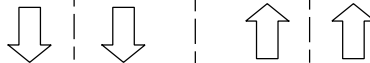

DIST. 24E-24EA= 47.14'

● 24EA

CL E. LEROY AVE

FD
SHI



34.72'

CL WOLFY AVE

32.42'



FD
SHI

58.75'

BLK.COR.
PORCH FDN.

RES#721

CL SB. SR 25

CL NB. SR 25

58.00'

BLK.COR.
PORCH FDN.

RES#720

O.D.O.T. DISTRICT 2 SURVEY OFFICE (USE ONLY)

PERSONNEL

REFERENCE NO. 24 EA

SHEET 28 OF 35

NOTES BARNHISEL

DATE 6/11/92

ROUTE US 25

H.C. VAN DUSEN

WEATHER SUNNY

COUNTY WOOD

R.C. BARNHISEL

TEMP. 60°

TOWNSHIP PLAIN

SECTION 24

DWG BY RHOADES

PID

T 5 N R 10 E

TYPE MONUMENT P.K.NAIL

ON SURFACE - ~~BELOW~~ ON

OFFSET CL PAVEMENT ON LT : RT

22.5' TO LT EDGE PAVEMENT


STATION: 551+63

HORIZ.DATUM:


GEOID:

GRID: NORTHING:

EASTING:

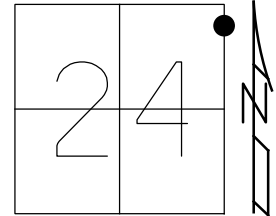

RECORD:
FD P.K.NAIL
6/11/92
SET P.K./WASHER
9/22/92, MB

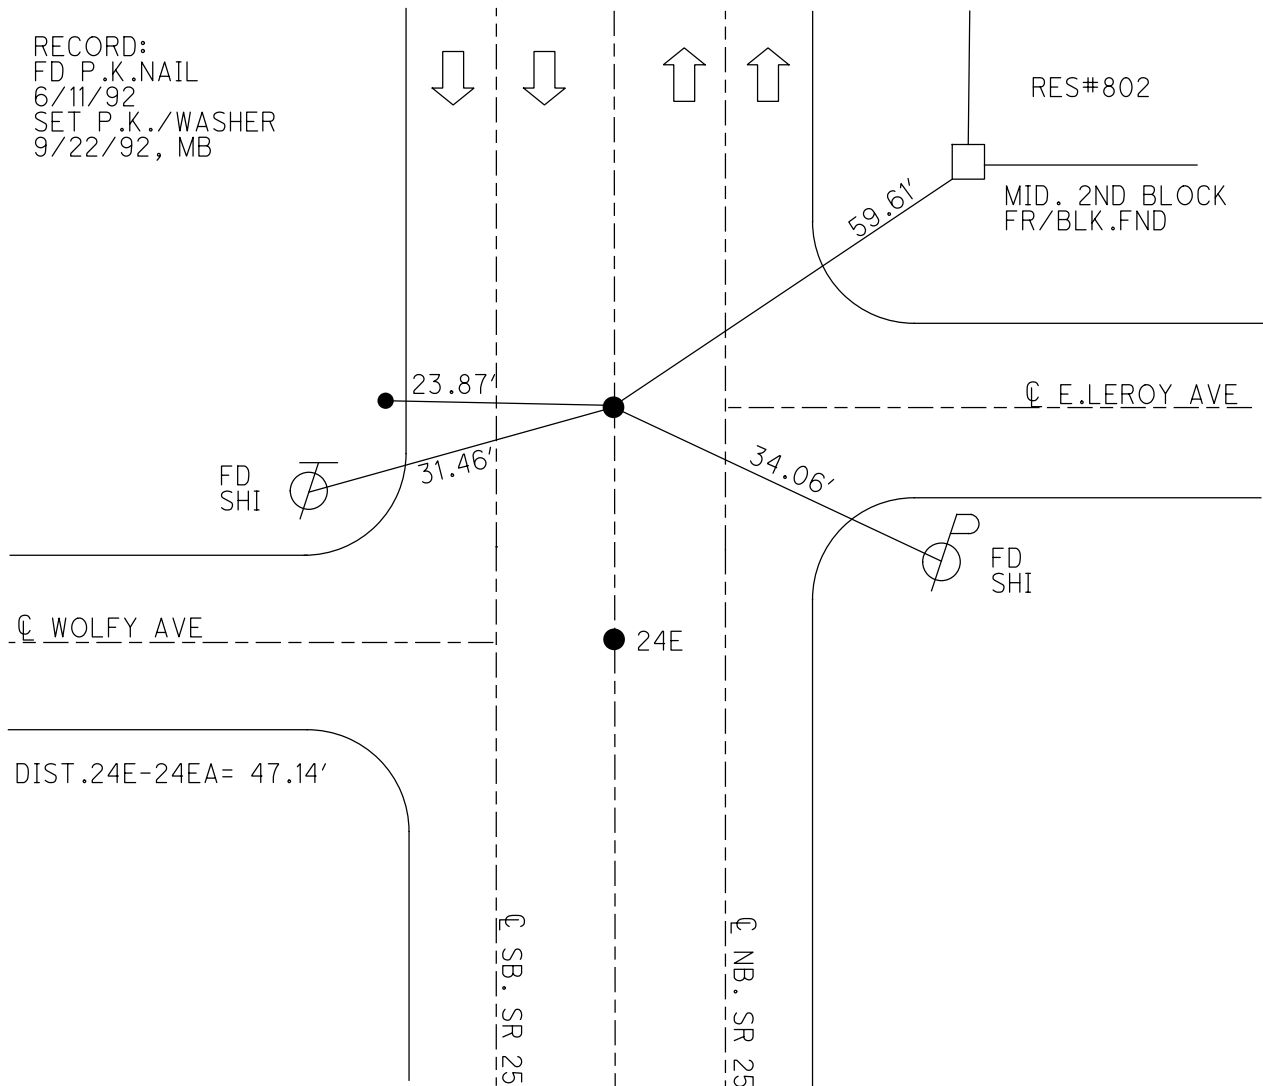

O.D.O.T. DISTRICT 2 SURVEY OFFICE (USE ONLY)

PERSONNEL

REFERENCE NO. 24 EB

SHEET 29 OF 35

NOTES BARNHISEL

DATE 6/11/92

ROUTE US 25

H.C. VAN DUSEN

WEATHER SUNNY

COUNTY WOOD

R.C. BARNHISEL

TEMP. 60°

TOWNSHIP PLAIN

SECTION 24

DWG BY RHOADES PID

T 5 N R 10 E

TYPE MONUMENT P.K./WASHER

ON SURFACE - ~~BELOW~~ ON

OFFSET CL PAVEMENT ON LT : RT

22.6' TO LT EDGE PAVEMENT


STATION: 554+90

HORIZ.DATUM:


GEOID:

GRID: NORTHING:

EASTING:

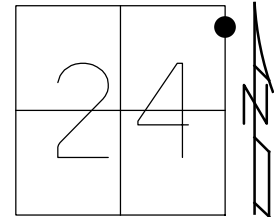

RECORD:
STA. 796+62.96
D.N.F.
SET P.K./WASHER
6/11/92
SET P.K./WASHER
9/22/92, MB

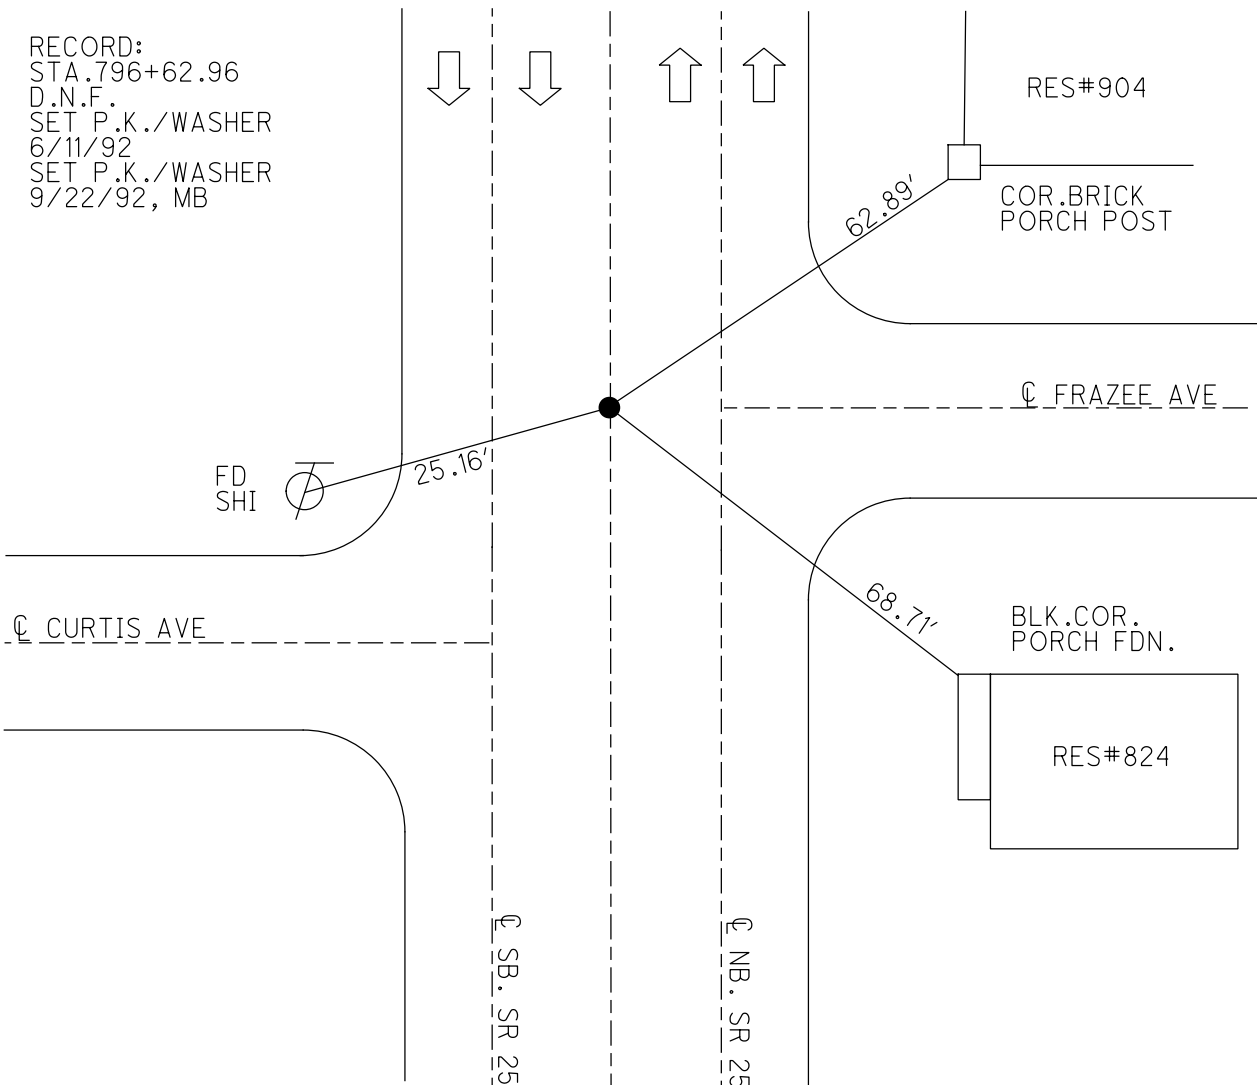

O.D.O.T. DISTRICT 2 SURVEY OFFICE (USE ONLY)

PERSONNEL

REFERENCE NO. 25

SHEET 30 OF 35

NOTES BARNHISEL

DATE 6/11/92

ROUTE US 25

H.C. VAN DUSEN

WEATHER SUNNY

COUNTY WOOD

R.C. KUSZ

TEMP. 65°

TOWNSHIP PLAIN

BURNETT

SECTION 24

DWG BY RHOADES

PID _____

T 5 N R 10 E

TYPE MONUMENT MONBOX

ON SURFACE - ~~BELOW~~ ON

OFFSET ℄ PAVEMENT ON LT : RT

- TO - EDGE PAVEMENT


STATION: 561+97

HORIZ.DATUM: _____


GEOID: _____

GRID: NORTHING: _____

EASTING: _____

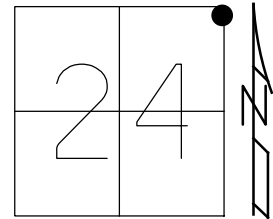

RECORD:
FD MONBOX
6/11/92, MB

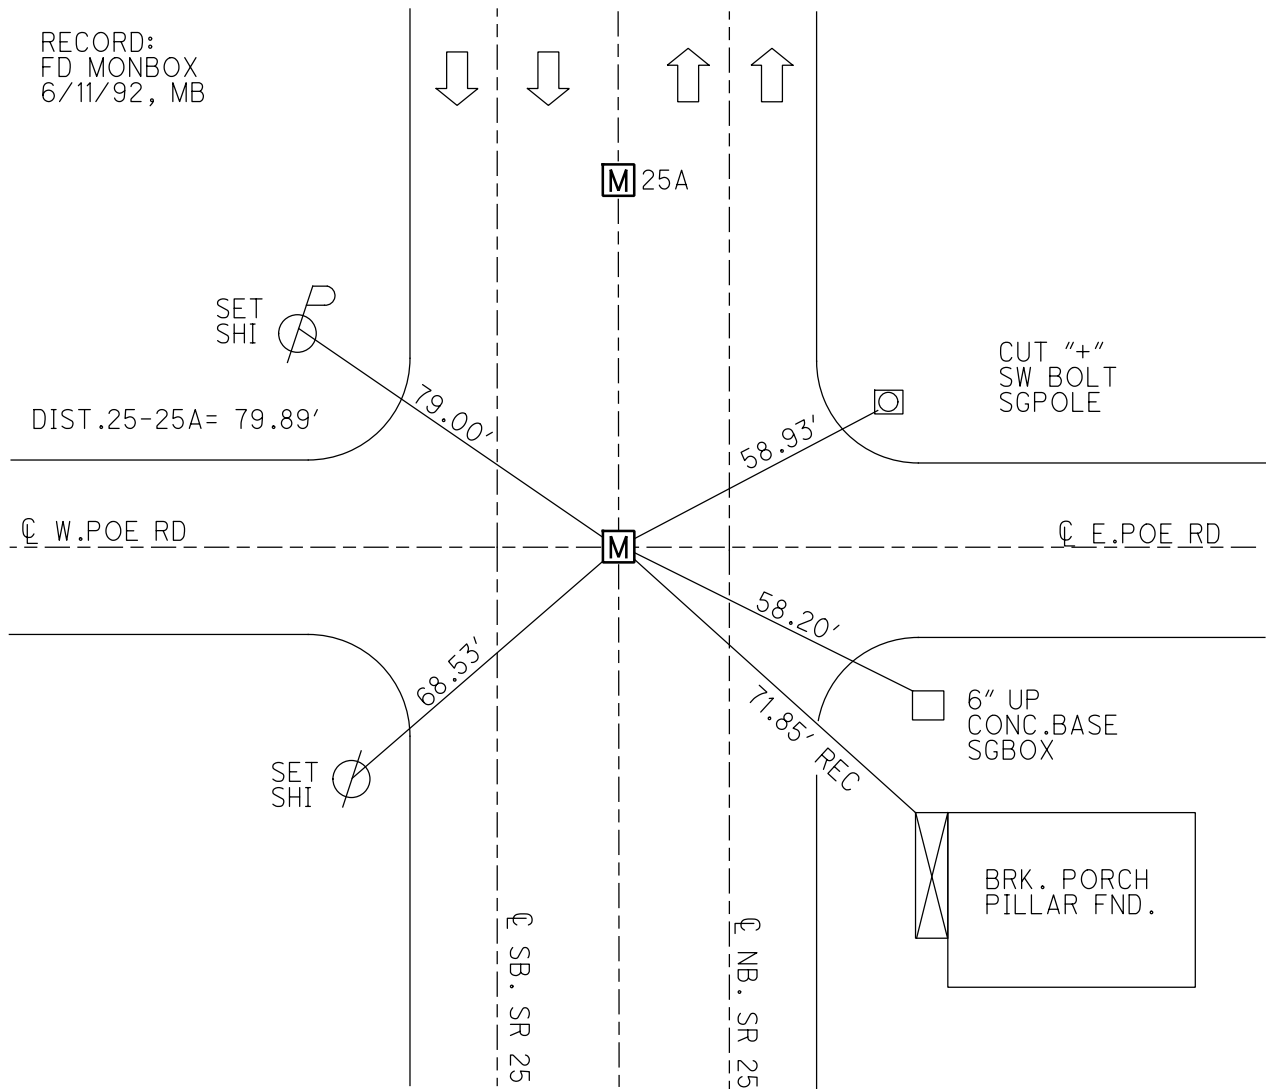

O.D.O.T. DISTRICT 2 SURVEY OFFICE (USE ONLY)

PERSONNEL

REFERENCE NO. 25 A

SHEET 31 OF 35

NOTES BARNHISEL

DATE 6/11/92

ROUTE US 25

H.C. VAN DUSEN

WEATHER SUNNY

COUNTY WOOD

R.C. KUSZ

TEMP. 65°

TOWNSHIP PLAIN

BURNETT

SECTION 24

DWG BY RHOADES

PID _____

T 5 N R 10 E

TYPE MONUMENT MONBOX

ON SURFACE - ~~BELOW~~ ON _____

OFFSET CL PAVEMENT ON _____ LT : RT

22.4' TO RT EDGE PAVEMENT


STATION: 562+77

HORIZ.DATUM: _____


GEOID: _____

GRID: NORTHING: _____

EASTING: _____

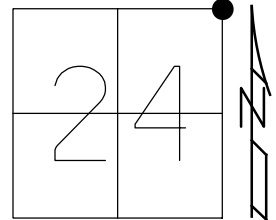

RECORD:
FD MONBOX
6/11/92, MB

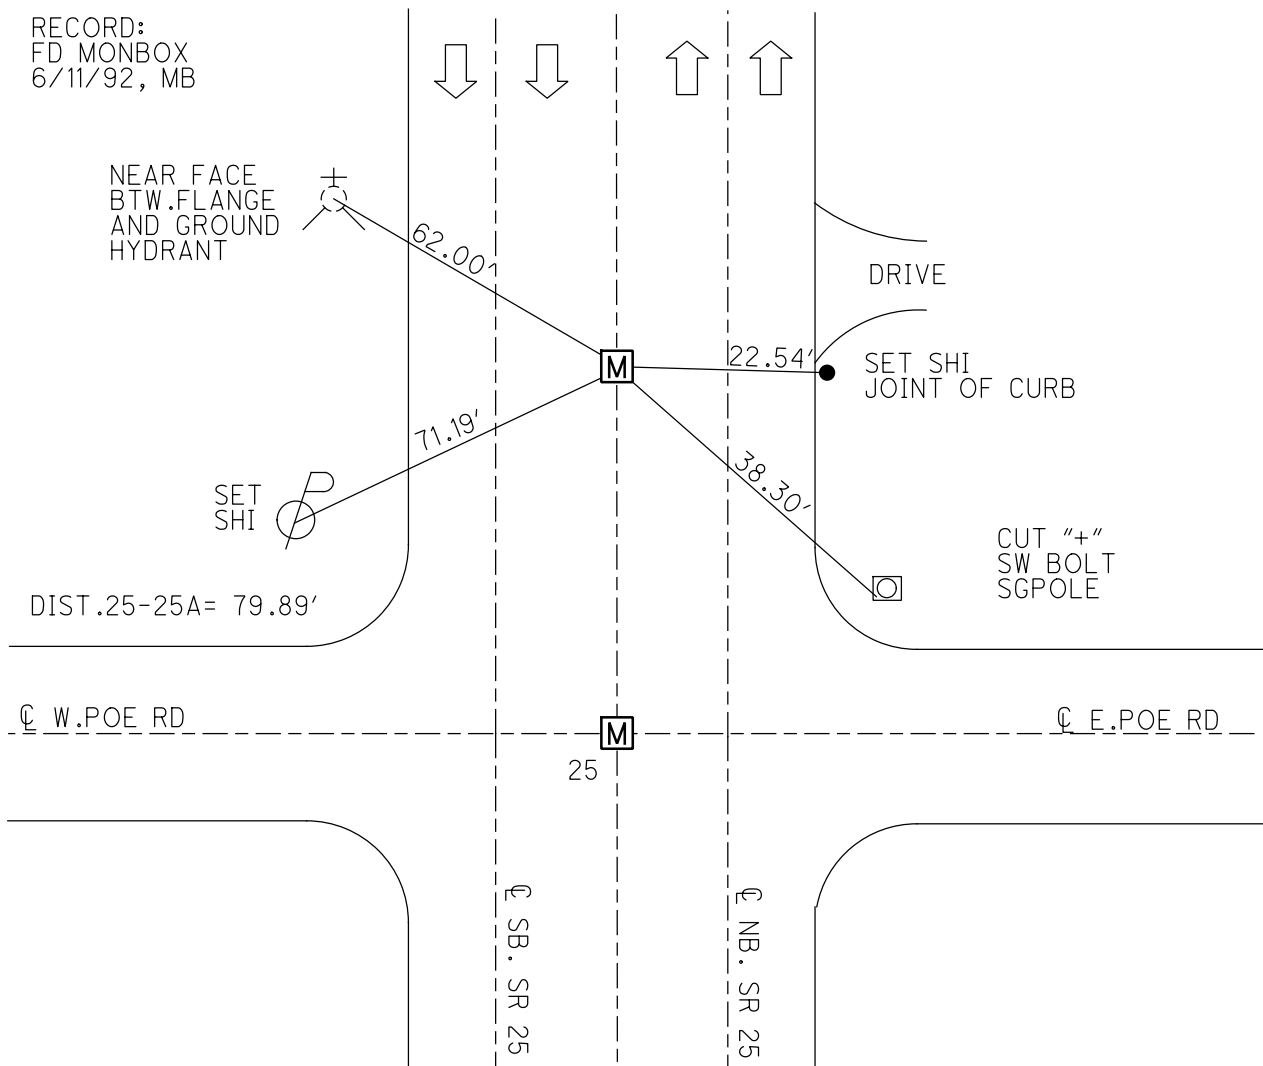

O.D.O.T. DISTRICT 2 SURVEY OFFICE (USE ONLY)

PERSONNEL

REFERENCE NO. 26

SHEET 32 OF 35

NOTES BARNHISEL

DATE 6/11/92

ROUTE US 25

H.C. VAN DUSEN

WEATHER SUNNY

COUNTY WOOD

R.C. KUSZ

TEMP. 65°

TOWNSHIP PLAIN

BURNETT

SECTION 13

DWG BY RHOADES

PID

T 5 N R 10 E

TYPE MONUMENT COPPERWELD MARKER

~~ON SURFACE~~ - BELOW 2"

OFFSET CL PAVEMENT 7.2' ~~LT~~ : RT

15.2' TO RT EDGE PAVEMENT


STATION: 575+00

HORZ.DATUM:


GEOID:

GRID: NORTHING:

EASTING:

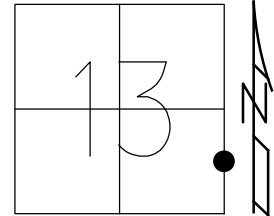

RECORD:
OLD B.G.
CORP.LINE EAST
FD COPPERWELD MARKER
2" DOWN
6/11/92
SET P.K./WASHER
9/24/92, MB

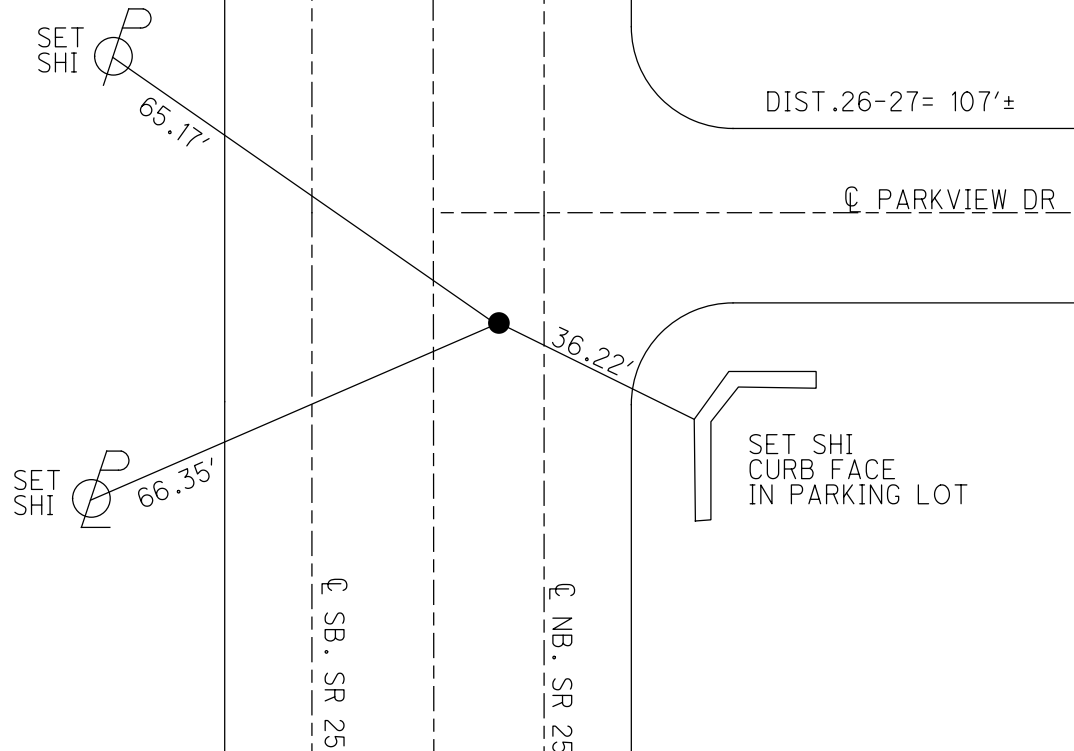

O.D.O.T. DISTRICT 2 SURVEY OFFICE (USE ONLY)

PERSONNEL

REFERENCE NO. 27

SHEET 33 OF 35

NOTES BARNHISEL

DATE 6/11/92

ROUTE US 25

H.C. VAN DUSEN

WEATHER SUNNY

COUNTY WOOD

R.C. KUSZ

TEMP. 65°

TOWNSHIP PLAIN

BURNETT

SECTION 13

DWG BY RHOADES

PID

T 5 N R 10 E

TYPE MONUMENT BRASS MON.

~~ON SURFACE~~ - BELOW ON

OFFSET $\varnothing$ PAVEMENT 7.2' ~~LT~~ : RT

14.4' TO RT EDGE PAVEMENT


STATION: 576+07

HORZ.DATUM:

GEOID:


GRID: NORTHING:

EASTING:

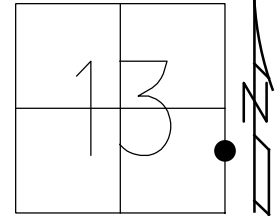

NEAR EDGE
24" CONC.
SIGN BASE
NORTHMAN
CAR WASH

54.33'

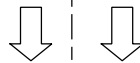

46.82'



COR.CONC.
SIGN BASE
HUNTINGTON
BANK

+14.57' FD "+"s
CURB

63.45'

+28.94'



NEAR EDGE
6" STEEL
FLAG POLE

DIST.26-27= 107'±

RECORD:
OLD B.G.
CORP.LINE WEST
FD BRASS MON.
9/63, SILVESTER
D.N.F.
4/15/75, BURNSIDE
6/11/92
SET P.K./WASHER
9/24/92, MB

$\varnothing$ SB. SR 25

27 ●

$\varnothing$ NB. SR 25

$\varnothing$ PARKVIEW DR

O.D.O.T. DISTRICT 2 SURVEY OFFICE (USE ONLY)

PERSONNEL

REFERENCE NO. 28

SHEET 34 OF 35

NOTES BARNHISEL

DATE 6/11/92

ROUTE US 25

H.C. VAN DUSEN

WEATHER SUNNY

COUNTY WOOD

R.C. BURNETT

TEMP. 69°

TOWNSHIP PLAIN

DWG BY RHOADES PID

SECTION 13

T 5 N R 10 E

TYPE MONUMENT COPPERWELD MON.

~~ON SURFACE~~ - BELOW 2"


OFFSET CL PAVEMENT 4.3' LT : ~~RT~~

33.8' TO LT EDGE PAVEMENT


STATION: 589+32

HORZ.DATUM: GEOID:

GRID: NORTHING: EASTING:

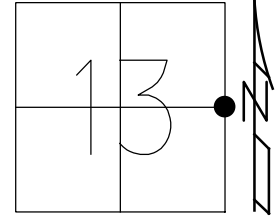

RECORD:
FD COPPERWELD MON.
2" DOWN
6/11/92, MB
SET P.K./WASHER
7/14/92, MB

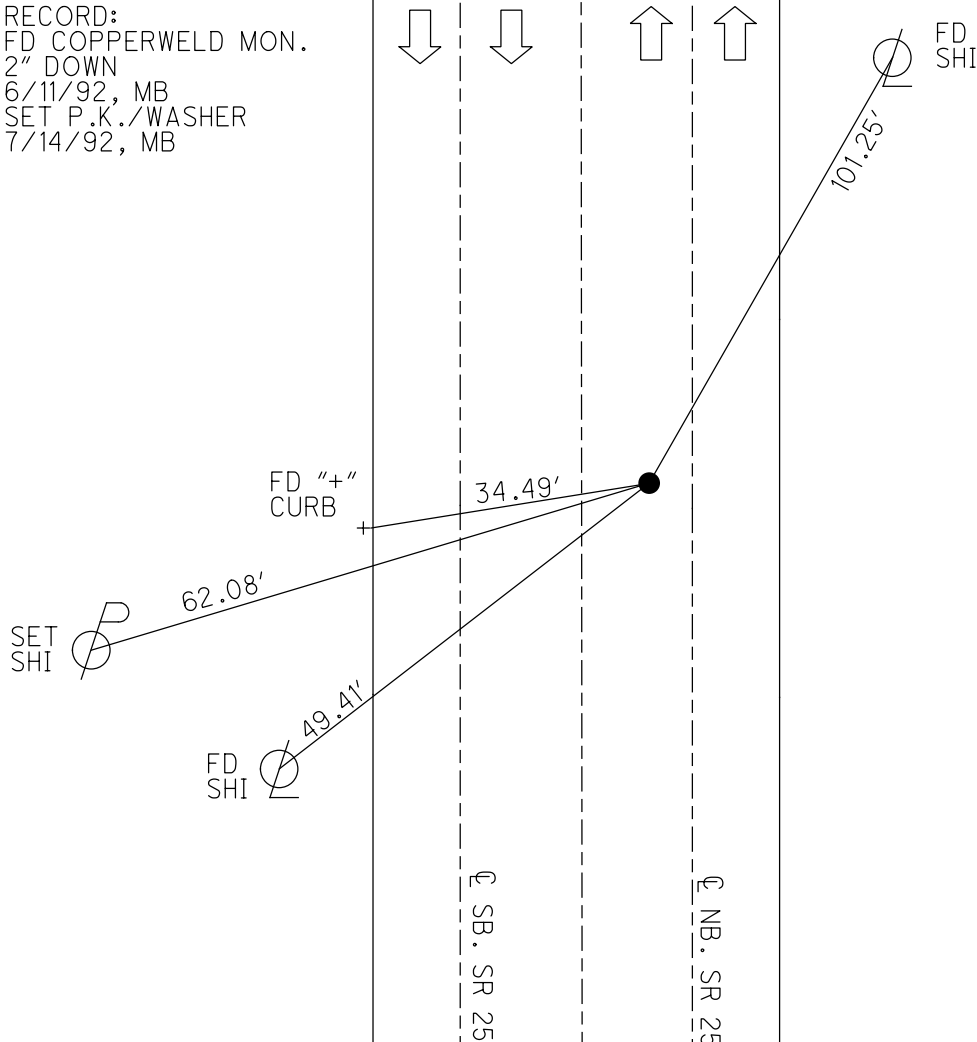

O.D.O.T. DISTRICT 2 SURVEY OFFICE (USE ONLY)

PERSONNEL

REFERENCE NO. 29

SHEET 35 OF 35

NOTES AUBLE

DATE 6/11/92

ROUTE SR 25

H.C. NIESE

WEATHER BREEZY

COUNTY WOOD

R.C. WHITAKER

TEMP. 58°

TOWNSHIP PLAIN

SECTION 13

DWG BY RHOADES

PID 110037

T 5 N R 10 E

TYPE MONUMENT MONBOX W/1" IPIN

ON SURFACE - ~~BELOW~~ ON

OFFSET CL PAVEMENT ON LT : RT

- TO - EDGE PAVEMENT


STATION: 614+23.98

HORIZ.DATUM: NAD83 2011

GEOID: NAVD88 2018

GRID: NORTHING: 632402.472

EASTING: 1652832.145

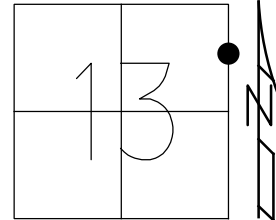

RECORD:
STA.602+57
FD COPPERWELD MON.
1 1/2" DOWN
6/11/92, MB
SET P.K./WASHER
7/14/92, MB
FD MONBOX
W/ 1" IPIN
REF29
12/22/20, JFO

CL VAN CAMP RD

M

80.28'
SET "+"
CONC.FND

55.26'
SET "+"
CONC.FND
X-ING SIGN

63.92'
SET "+"
CURB

60.37'
SET "+"
CONC.FND

PREMIER
BANK

CL SB SR 25

CL NB SR 25

O.D.O.T. DISTRICT 2 SURVEY OFFICE (USE ONLY)

PERSONNEL

REFERENCE NO. 30

SHEET 1 OF 19

NOTES AUBLE

DATE 10/27/23

ROUTE SR 25

H.C. NIESE

WEATHER BREEZY

COUNTY WOOD

R.C. AUBLE

TEMP. 73°

TOWNSHIP PLAIN

RHOADES

SECTION 18

DWG BY RHOADES

PID NO PID

T 5 N R 10 E

TYPE MONUMENT MAG/WASHER

ON SURFACE - ~~BELOW~~ ON

OFFSET ℄ PAVEMENT ON LT : RT

19' TO RT EDGE PAVEMENT 17.7' S ℄ NEWTON RD


STATION: 626+02.43

HORIZ.DATUM: NAD83 2011

GEOID: NAVD88 2012A

GRID: NORTHING: 633580.891

EASTING: 1652837.779

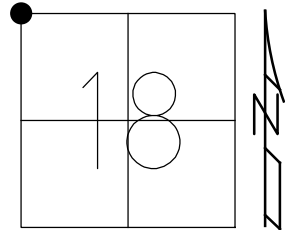

RECORD:
STA.614+72
COR. STONE 33' N.
OF N.W. COR.SEC.18
FD BRASS MON
9-4-85, HOFFMAN
SET P.K./WASHER
9-30-94
FD MAG NAIL
SV6035
4-30-09, DCH
FD MAG NAIL
REF30
12/22/20, JFO
5/23/22, TDN
SET MAG/WASHER
10/27/23, TDN

℄ SB SR 25




30A

℄ NB SR 25

DIST.30-30A= 147.56

℄ NEWTON RD

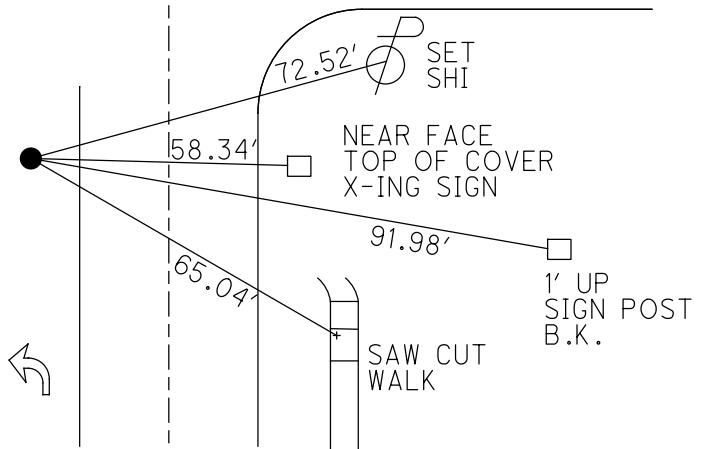

O.D.O.T. DISTRICT 2 SURVEY OFFICE (USE ONLY)

PERSONNEL

REFERENCE NO. 30 A

SHEET 2 OF 19

NOTES AUBLE

DATE 10/27/23

ROUTE SR 25

H.C. NIESE

WEATHER BREEZY

COUNTY WOOD

R.C. AUBLE

TEMP. 73°

TOWNSHIP PLAIN

RHOADES

SECTION 18

DWG BY RHOADES PID NO PID

T 5 N R 11 E

TYPE MONUMENT MAG/WASHER

ON SURFACE - ~~BELOW~~ ON

OFFSET CL PAVEMENT ON LT : RT

- TO - EDGE PAVEMENT



STATION: 627+49.99

HORZ.DATUM: NAD83 2011

GEOID: NAVD88 2012A

GRID: NORTHING: 633728.457

EASTING: 1652838.878

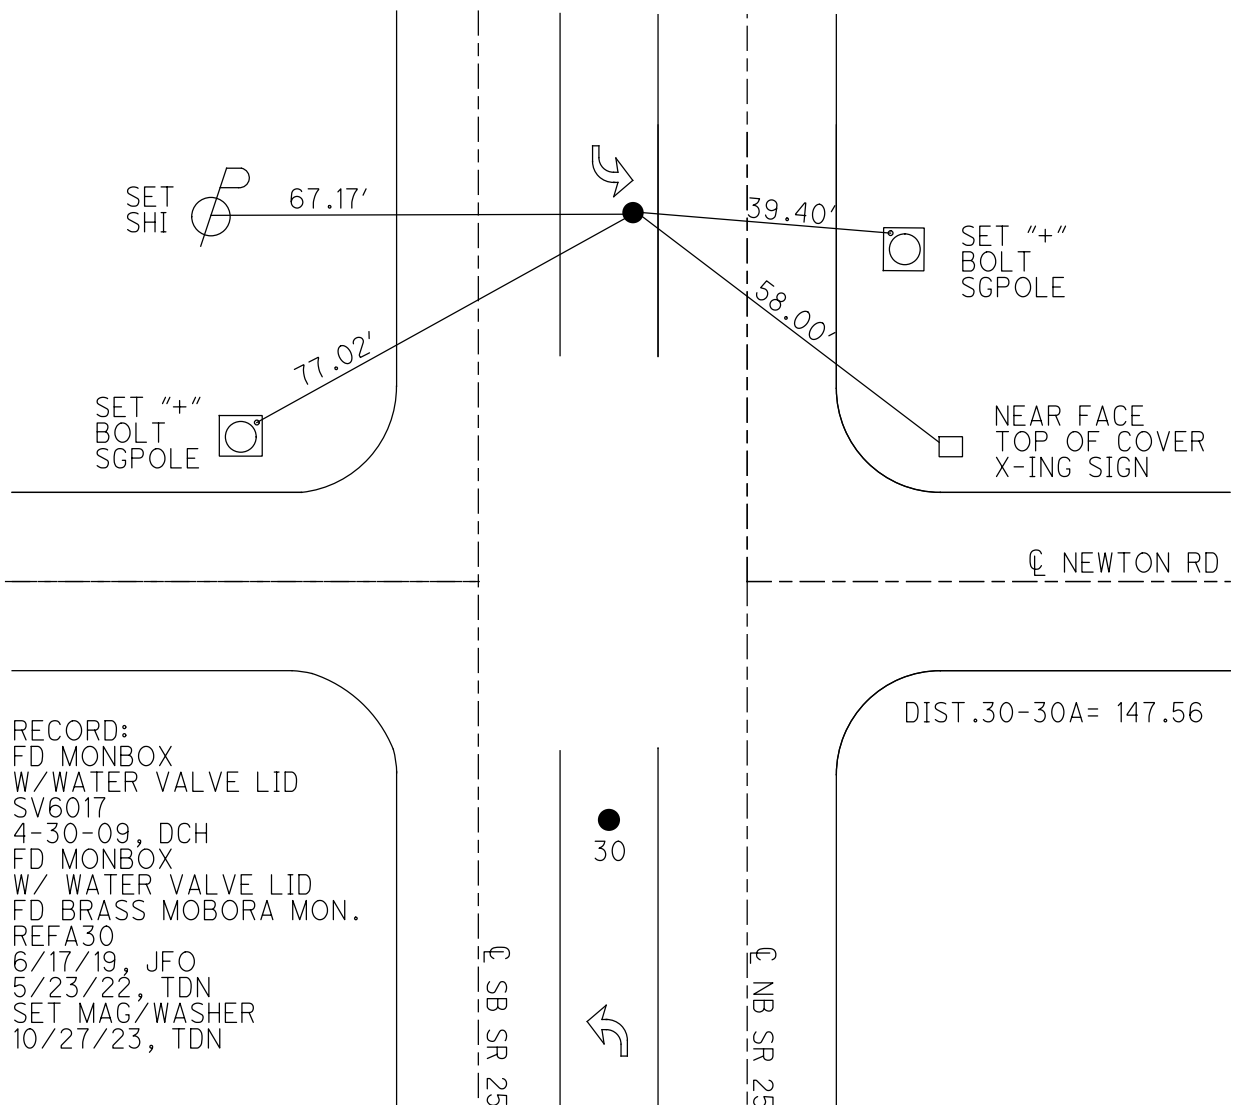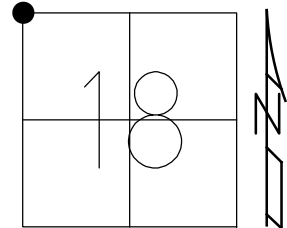

O.D.O.T. DISTRICT 2 SURVEY OFFICE (USE ONLY)

PERSONNEL

REFERENCE NO. 31

SHEET 3 OF 19

NOTES AUBLE

DATE 5/24/22

ROUTE SR 25

H.C. NIESE

WEATHER CLEAR

COUNTY WOOD

R.C. WHITAKER

TEMP. 55°

TOWNSHIP PLAIN

SECTION 12

DWG BY RHOADES

PID 110037

T 5 N R 10 E

TYPE MONUMENT MAG NAIL

ON SURFACE - BELOW ON

OFFSET $\varnothing$ PAVEMENT - LT : RT

- TO - EDGE PAVEMENT


STATION: 652+57.63

HORZ.DATUM: NAD83 2011


GEOID: NAVD88 2018

GRID: NORTHING: 636236.096

EASTING: 1652854.236

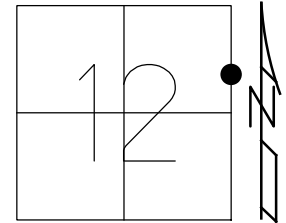

RECORD:
STA.644+98
FD P.K.NAIL
5/1/09, DCH
FD MAG NAIL
REF31
12/22/20, JFO
SET MAG/WASHER
9/8/22, TDN

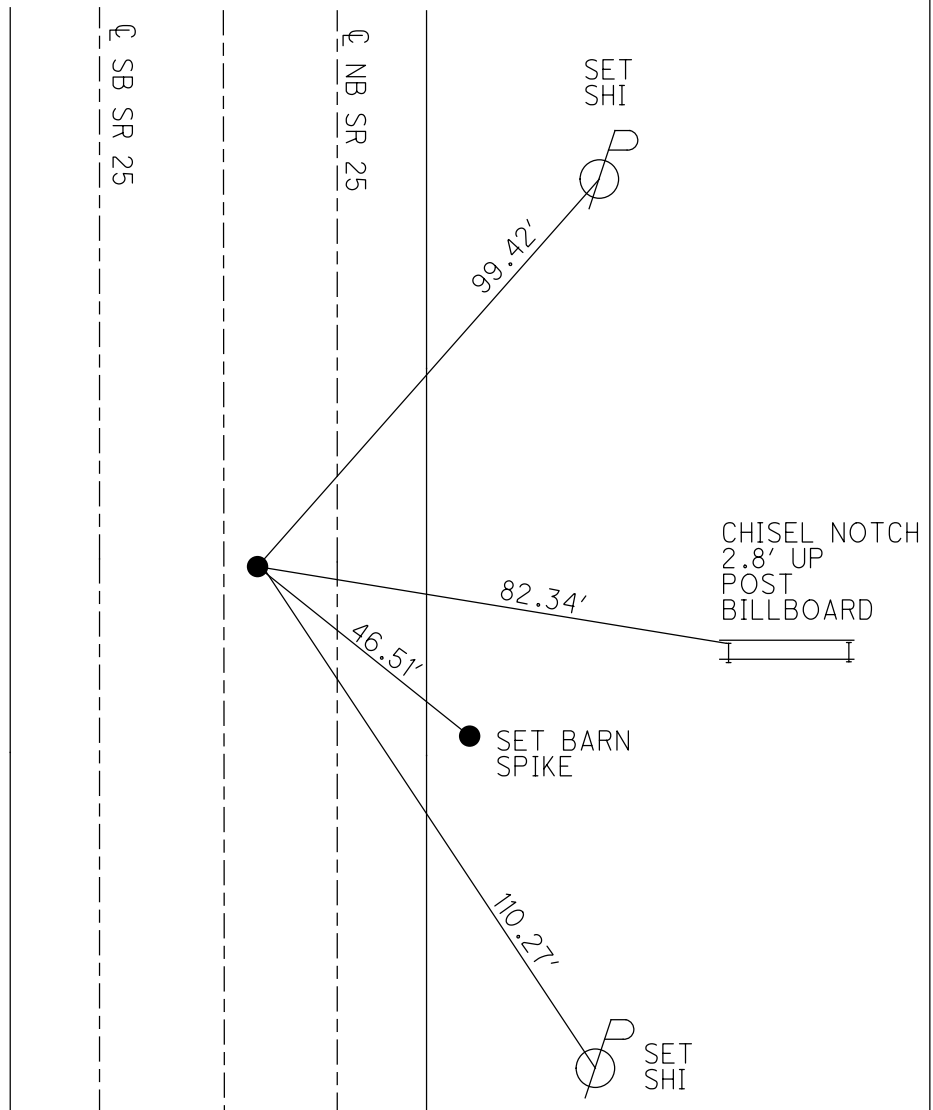

O.D.O.T. DISTRICT 2 SURVEY OFFICE (USE ONLY)

PERSONNEL

REFERENCE NO. 31 A

SHEET 4 OF 19

NOTES AUBLE

DATE 5/24/22

ROUTE SR 25

H.C. NIESE

WEATHER CLEAR

COUNTY WOOD

R.C. WHITAKER

TEMP. 55°

TOWNSHIP PLAIN

DWG BY RHOADES

PID 110037

SECTION 12

T 5 N R 10 E

TYPE MONUMENT P.K.NAIL

~~ON SURFACE~~ - BELOW 1"

OFFSET $\angle$ PAVEMENT - LT : RT

- TO - EDGE PAVEMENT


STATION: 656+54.08

HORIZ.DATUM: NAD83 2011


GEOID: NAVD88 2018

GRID: NORTHING: 636632.494

EASTING: 1652856.606

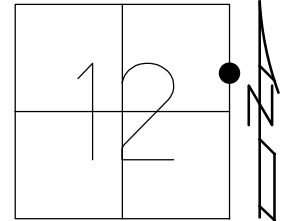

RECORD:
BRASS MON.
STA. 82+90.85
9-4-85, HOFFMAN
SET PK/WASHER
9-30-94
FD P.K.NAIL
5/1/09, DCH
FD P.K.NAIL
1" DOWN
REFA31
12/22/20, JFO
SET MAG/WASHER
9/8/22, TDN

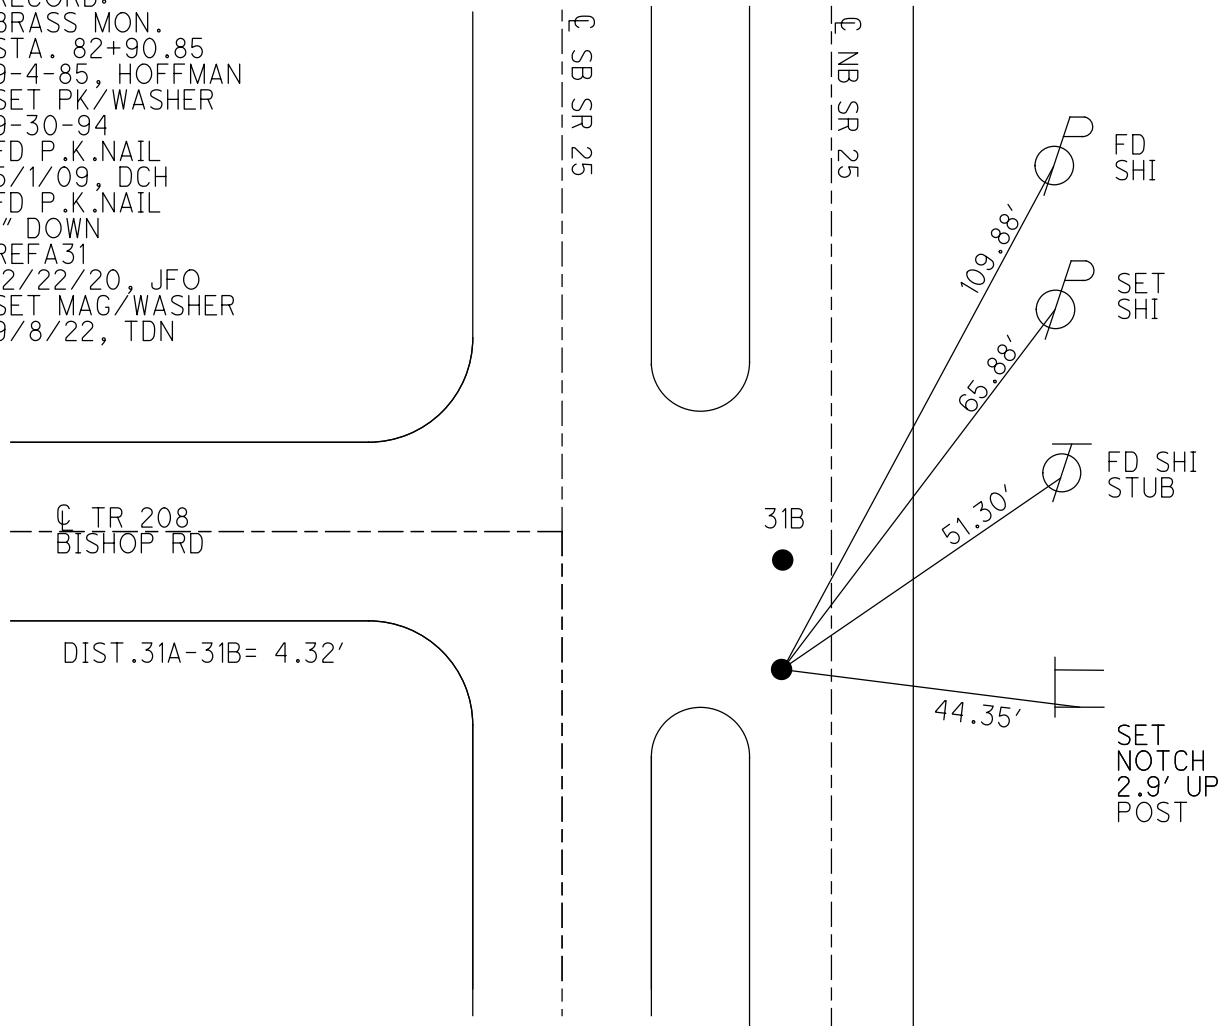

O.D.O.T. DISTRICT 2 SURVEY OFFICE (USE ONLY)

PERSONNEL

REFERENCE NO. 31 B

SHEET 5 OF 19

NOTES AUBLE

DATE 5/24/22

ROUTE SR 25

H.C. NIESE

WEATHER CLEAR

COUNTY WOOD

R.C. WHITAKER

TEMP. 55°

TOWNSHIP PLAIN

SECTION 12

DWG BY RHOADES PID 110037

T 5 N R 10 E

TYPE MONUMENT MAG NAIL

ON SURFACE - ~~BELOW~~ ON

OFFSET Q PAVEMENT - LT : RT

- TO EDGE PAVEMENT


STATION: 656+58.4

HORZ.DATUM: NAD83 2011


GEOID: NAVD88 2018

GRID: NORTHING: 636636.800

EASTING: 1652856.774

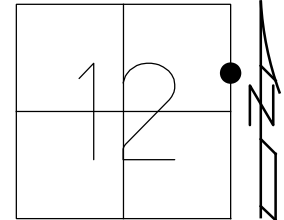

RECORD:
FD MAG NAIL
5/1/09, DCH
REFB31
12/22/20, JFO
SET MAG/WASHER
9/8/22, TDN

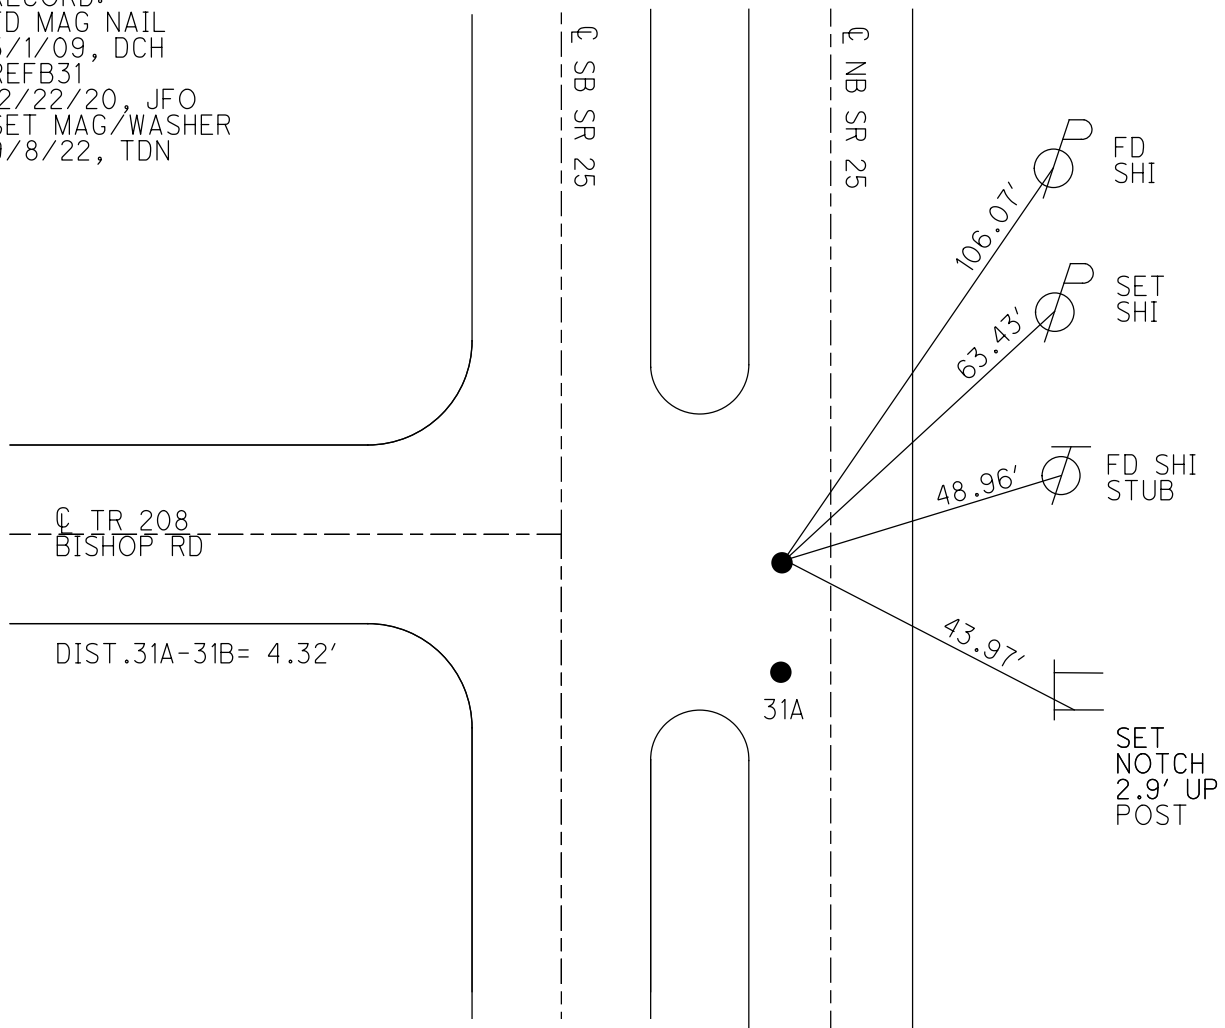

O.D.O.T. DISTRICT 2 SURVEY OFFICE (USE ONLY)

PERSONNEL

REFERENCE NO. 32

SHEET 6 OF 19

NOTES WHITAKER

DATE 5/25/22

ROUTE SR 25

H.C. NIESE

WEATHER CLOUDY

COUNTY WOOD

R.C. WHITAKER

TEMP. 60°

TOWNSHIP PLAIN

SECTION 12

DWG BY RHOADES

PID 110037

T 5 N R 10 E

TYPE MONUMENT MAG/WASHER

ON SURFACE - ~~BELOW~~ ON

OFFSET CL PAVEMENT 1.7', NB CL LT : ~~RT~~

- TO - EDGE PAVEMENT


STATION: 665+71.19

HORIZ.DATUM: NAD83 2011


GEOID: NAVD88 2018

GRID: NORTHING: 637549.586

EASTING: 1652862.135

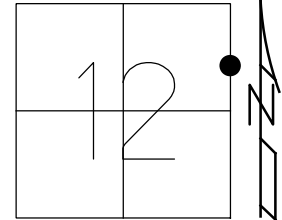

RECORD:
STA. 92+14.00
FD BRASS MON
9-4-85, HOFFMAN
SET P.K./WASHER
9-30-94, MB
SET MAG/WASHER
11-02-09, DCH
SET MAG/WASHER
REF32
12/22/20, JFO
SET MAG/WASHER
9/8/22, TDN

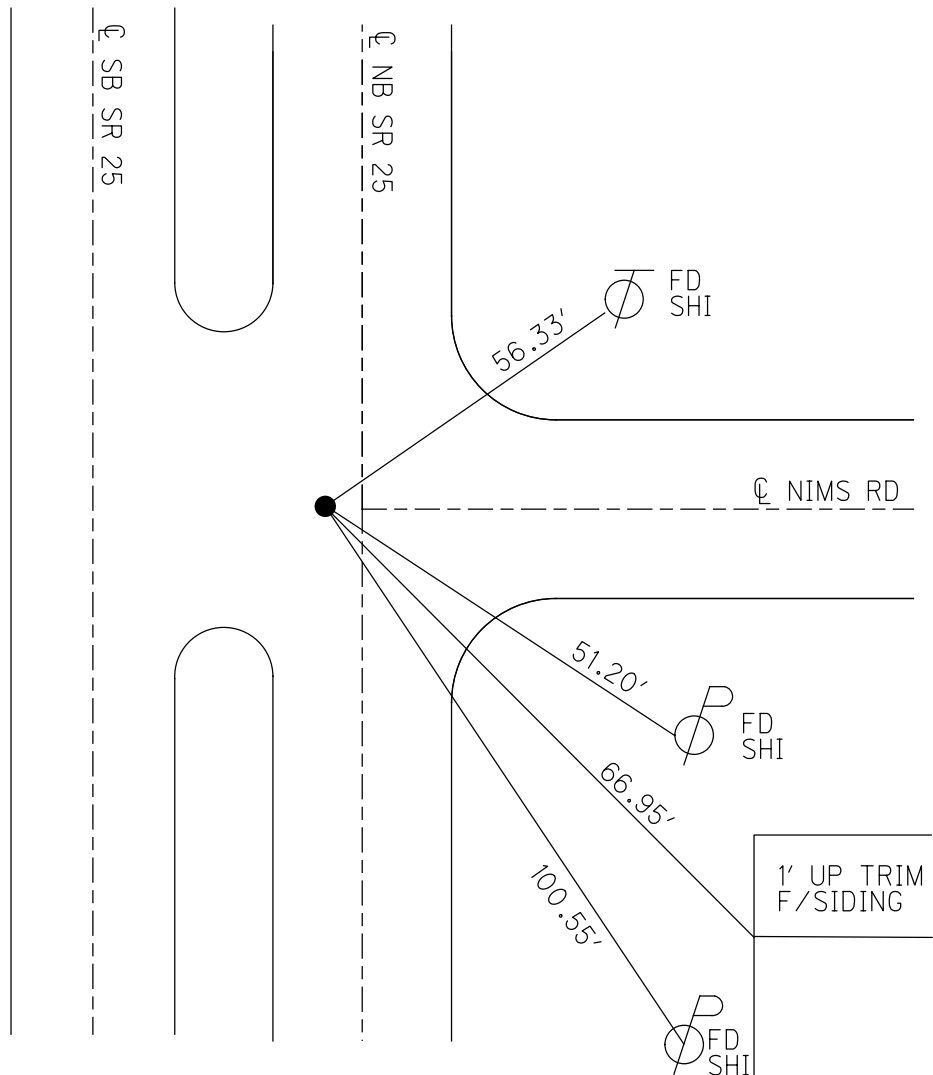

O.D.O.T. DISTRICT 2 SURVEY OFFICE (USE ONLY)

PERSONNEL

REFERENCE NO. 33

SHEET 7 OF 19

NOTES WHITAKER

DATE 5/25/22

ROUTE SR 25

H.C. NIESE

WEATHER CLOUDY

COUNTY WOOD

R.C. WHITAKER

TEMP. 60°

TOWNSHIP PLAIN

SECTION 12

DWG BY RHOADES

PID 110037

T 5 N R 10 E

TYPE MONUMENT MAG NAIL

ON SURFACE - ~~BELOW~~ ON

OFFSET CL PAVEMENT 4.5' NB CL LT : ~~RT~~

- TO - EDGE PAVEMENT


STATION: 680+49.71

HORZ.DATUM: NAD83 2011

GEOID: NAVD88 2018

GRID: NORTHING: 639028.084

EASTING: 1652871.185

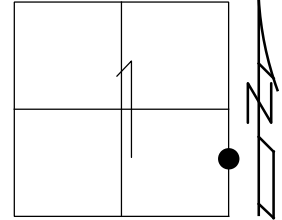

RECORD:

STA.106+92.75
FD BRASS MON.
9-4-85, HOFFMAN
SET P.K./WASHER
9-30-94, MB
FD P.K.NAIL
5/1/09, DCH
SET MAG/WASHER
11-2-09, DCH
FD MAG NAIL
REF33
12/22/20, JFO
SET MAG/WASHER
9/8/22, TDN


GREAT LAKES FORD

CL SB SR 25

CL NB SR 25

FD
SHI



44.87'

SET BARN
SPIKES

22.14'

48.08'

SET
SHI



O.D.O.T. DISTRICT 2 SURVEY OFFICE (USE ONLY)

PERSONNEL

REFERENCE NO. 34

SHEET 8 OF 19

NOTES WHITAKER

DATE 5/25/22

ROUTE SR 25

H.C. NIESE

WEATHER CLOUDY

COUNTY WOOD

R.C. WHITAKER

TEMP. 60°

TOWNSHIP PLAIN

SECTION 1

DWG BY RHOADES

PID 110037

T 5 N R 11 E

TYPE MONUMENT MAG NAIL

ON SURFACE - ~~BELOW~~ ON

OFFSET CL PAVEMENT 4.5', NB CL LT : ~~RT~~

- TO - EDGE PAVEMENT


STATION: 705+37.9

HORIZ.DATUM: NAD83 2011


GEOID: NAVD88 2018

GRID: NORTHING: 641516.281

EASTING: 1652894.478

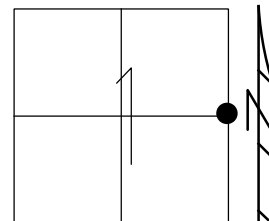

RECORD:
FD BRASS MON.
9-4-85
SET P.K./WASHER
9-30-94
FD MAG NAIL
11-02-09, DCH
FD MAG NAIL
REF34
12/22/20, JFO
SET MAG/WASHER
9/8/22, TDN

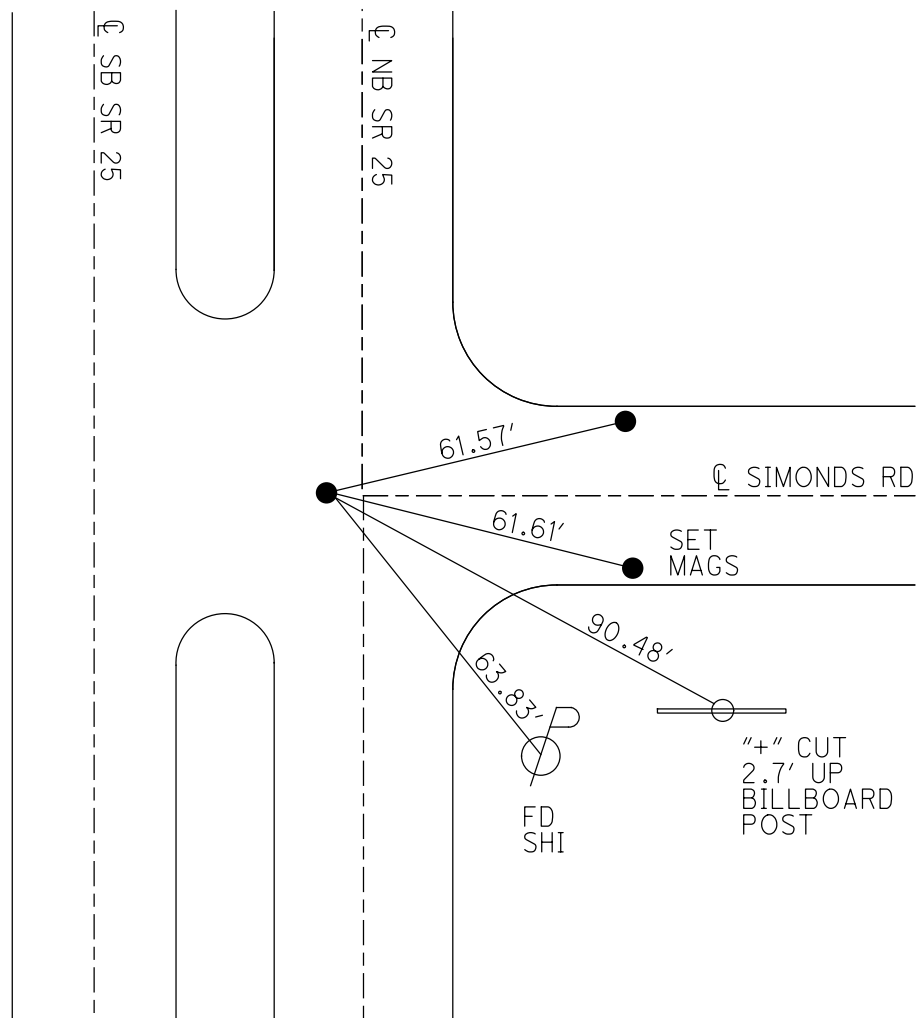

O.D.O.T. DISTRICT 2 SURVEY OFFICE (USE ONLY)

PERSONNEL

REFERENCE NO. 35

SHEET 9 OF 19

NOTES AUBLE

DATE 5/27/22

ROUTE SR 25

H.C. NIESE

WEATHER BREEZY

COUNTY WOOD

R.C. WHITAKER

TEMP. 65°

TOWNSHIP PLAIN

DWG BY RHOADES

PID 110037

SECTION 1

T 5 N R 10 E

TYPE MONUMENT BRASS MON

~~ON SURFACE~~ - BELOW 5"

OFFSET CL PAVEMENT 4.4' NB CL LT : RT

- TO - EDGE PAVEMENT


STATION: 720+24.98

HORIZ.DATUM: NAD83 2011

GEOID: NAVD88 2018

GRID: NORTHING: 643003.365

EASTING: 1652908.252

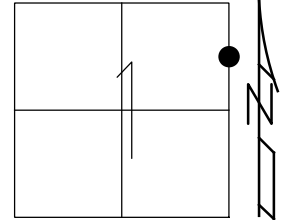

RECORD:
FD BRASS MON
SET SM.R.R.SPIKE
11-1-85, SWH
SET P.K./WASHER
9-30-94, MB
FD P.K.NAIL
5/2/09, DCH
FD MAG NAIL
SET BY OTHERS
SET MAG/WASHER
11-02-09, DCH
FD MAG NAIL
REF35
12/22/20, JFO
SET MAG/WASHER
9/12/22, TDN

CL UNION HILL RD

CL SB SR 25

CL NB SR 25

SET BARN SPIKE
FIELD DRIVE

55.39'

49.74'

95.70'

SET SHI
NW/S

TOP CENTER
END POST
CHAIN LINK

O.D.O.T. DISTRICT 2 SURVEY OFFICE (USE ONLY)

PERSONNEL

REFERENCE NO. 36

SHEET 10 OF 19

NOTES AUBLE

DATE 5/27/22

ROUTE SR 25

H.C. NIESE

WEATHER BREEZY

COUNTY WOOD

R.C. WHITAKER

TEMP. 65°

TOWNSHIP PLAIN

DWG BY RHOADES

PID 110037

SECTION 1

T 5 N R 10 E

TYPE MONUMENT BRASS MON.

~~ON SURFACE~~ - BELOW 5"

OFFSET CL PAVEMENT 3.6' NB CL LT : ~~RT~~

- TO - EDGE PAVEMENT


STATION: 733+47.35

HORZ.DATUM: NAD83 2011


GEOID: NAVD88 2018

GRID: NORTHING: 644325.471

EASTING: 1652920.494

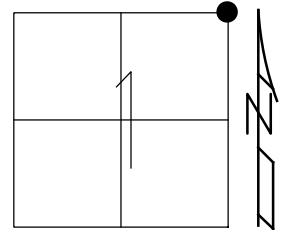

RECORD:
FD BRASS MON.
SET SM.R.R.SPIKE
11-1-85, SWH
SET P.K./WASHER
9-30-94, MB
FD SM.R.R.SPIKE
1.5" DOWN
5/3/09, DCH
SET MAG/WASHER
11-02-09, DCH
FD SPIKE SHANK
1" DOWN
REF36
12/23/20, JFO
FD BRASS MON.
5" DOWN
REF 36
5/27/22, DSA
SET MAG/WASHER
9/12/22, TDN

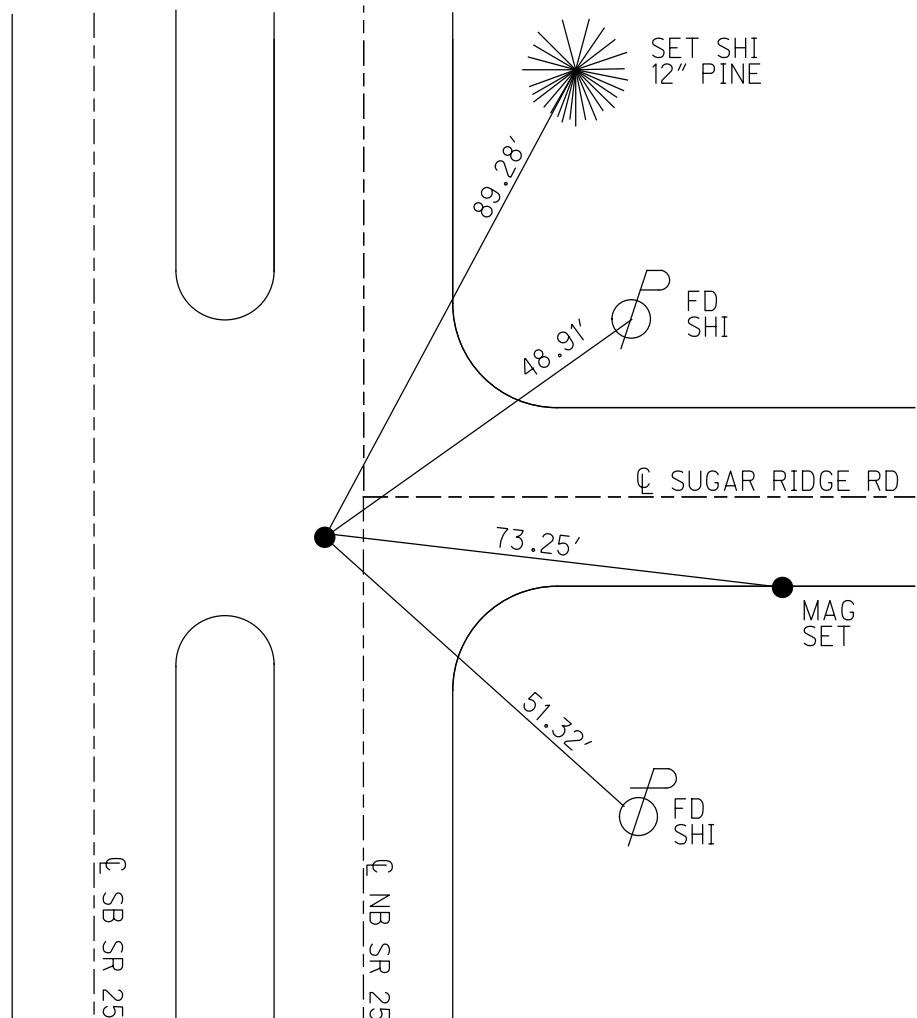

O.D.O.T. DISTRICT 2 SURVEY OFFICE (USE ONLY)

PERSONNEL

REFERENCE NO. 37

SHEET 11 OF 19

NOTES WHITAKER

DATE 5/25/22

ROUTE SR 25

H.C. NIESE

WEATHER CLOUDY

COUNTY WOOD

R.C. WHITAKER

TEMP. 65°

TOWNSHIP PLAIN

SECTION 36

DWG BY RHOADES PID 110037

T 5 N R 10 E

TYPE MONUMENT MAG/WASHER

ON SURFACE - ~~BELOW~~ ON

OFFSET Q PAVEMENT 3.8' NB Q LT : ~~RT~~

- TO - EDGE PAVEMENT


STATION: 759+96.12

HORZ.DATUM: NAD83 2011


GEOID: NAVD88 2018

GRID: NORTHING: 646974.198

EASTING: 1652939.021

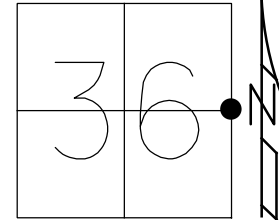

RECORD:
E 1/4 POST SEC. 36
PLAIN TWP.
 $\Delta = 0^\circ 12' \text{ RT}$
STA. 186+40.25
BRASS MON
SET SM.R.R.SPIKE
11-1-85, SWH
SET P.K./WASHER
9-30-94, MB
FD P.K.NAIL
5/3/09
SET MAG/WASHER
11-02-09, DCH
FD MAG/WASHER
REF37
12/22/20, JFO
SET MAG/WASHER
9/12/22, TDN

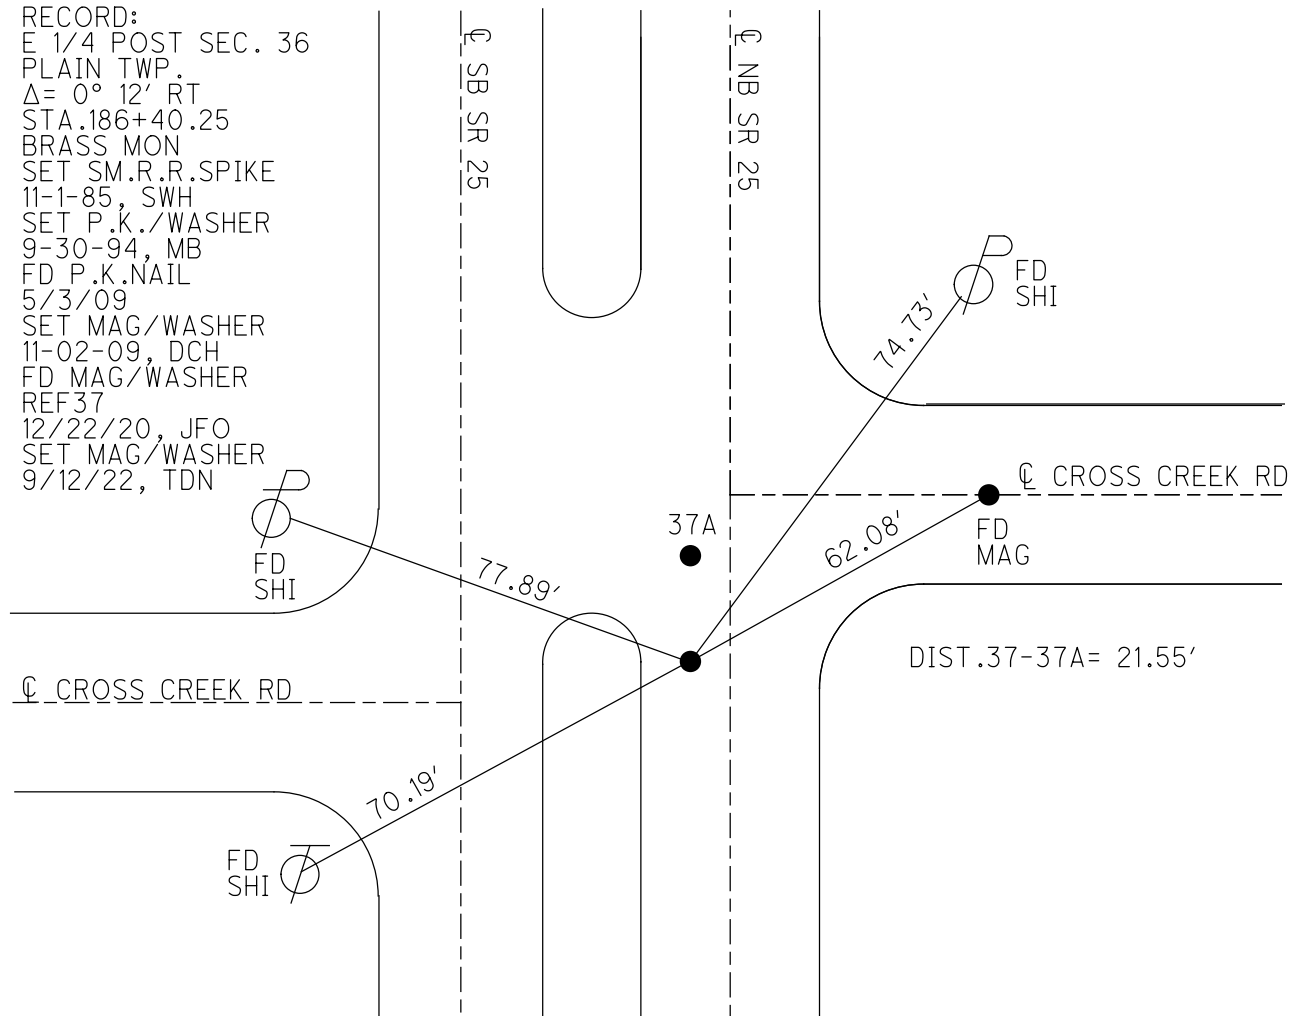

O.D.O.T. DISTRICT 2 SURVEY OFFICE (USE ONLY)

PERSONNEL

REFERENCE NO. 37 A

SHEET 12 OF 19

NOTES AUBLE

DATE 5/27/22

ROUTE SR 25

H.C. NIESE

WEATHER BREEZY

COUNTY WOOD

R.C. WHITAKER

TEMP. 65°

TOWNSHIP MIDDLETON

SECTION 31

DWG BY RHOADES

PID 110037

T 5 N R 10 E

TYPE MONUMENT MAG SHANK

~~ON SURFACE~~ - BELOW 0.5"

OFFSET CL PAVEMENT 3.8' NB CL LT : ~~RT~~

- TO - EDGE PAVEMENT


STATION: 760+17.67

HORIZ.DATUM: NAD83 2011

GEOID: NAVD88 2018

GRID: NORTHING: 646995.753

EASTING: 1652939.038

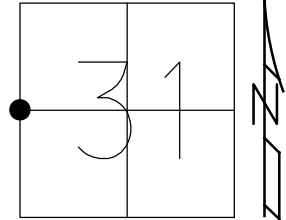

RECORD:

W 1/4 POST

SEC. 31 CENTER TWP.

STA.186+62.70

FD R.R.SPIKE

SET SM.R.R.SPIKE

11-1-85, SWH

SET P.K./WASHER

9-30-94, MB

FD P.K.NAIL

5/3/09

SET MAG/WSAHER

11-02-09, DCH


FD MAG SHANK

REFA37

12/23/20, JFO

SET MAG/WASHER

9/12/22, TDN

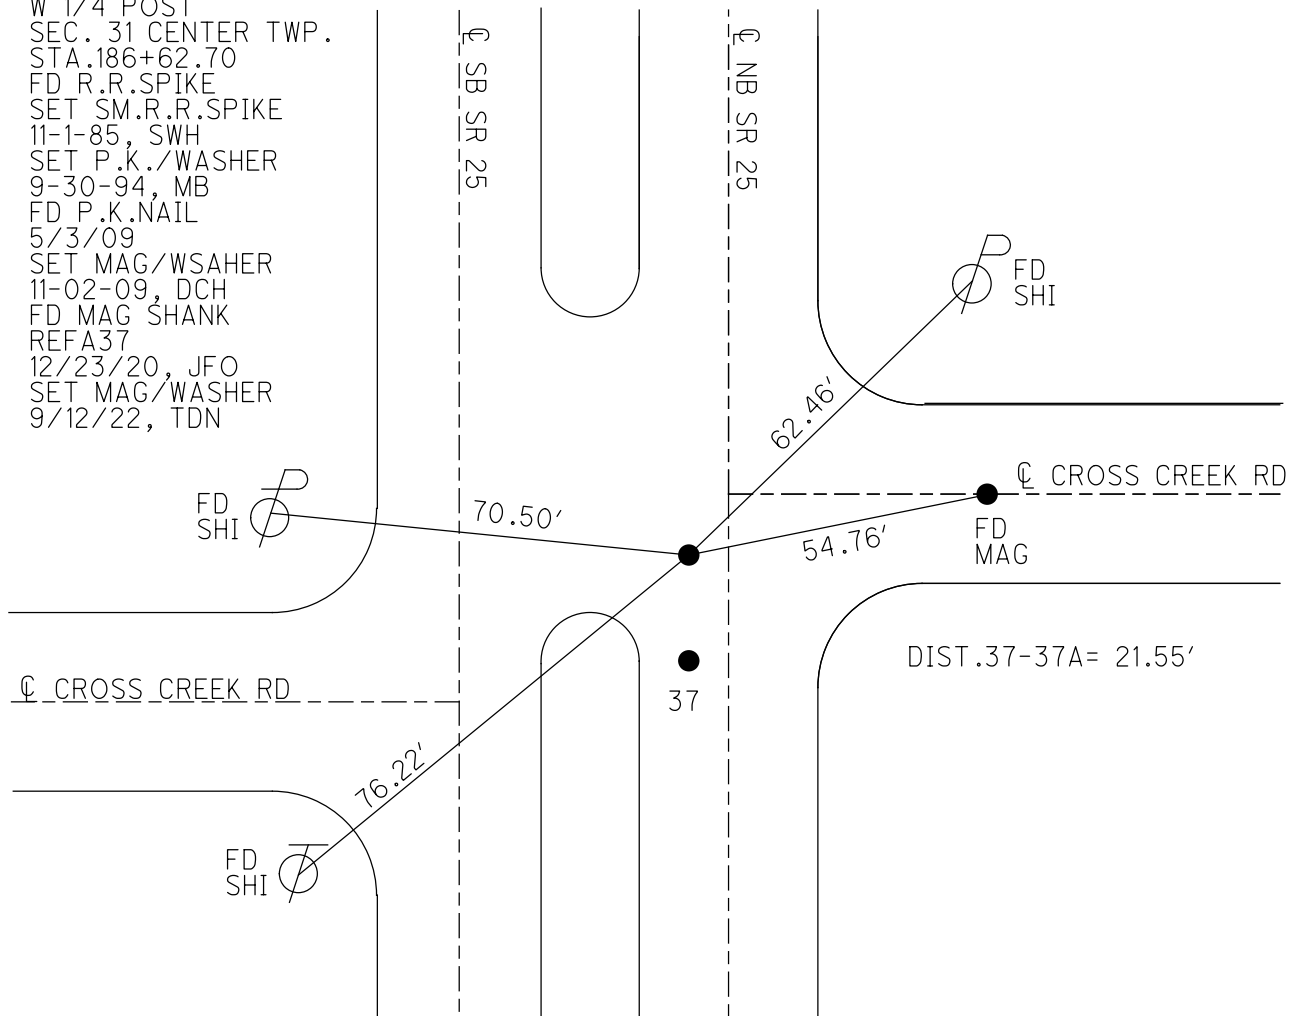

O.D.O.T. DISTRICT 2 SURVEY OFFICE (USE ONLY)

PERSONNEL

REFERENCE NO. 38

SHEET 13 OF 19

NOTES AUBLE

DATE 5/27/22

ROUTE SR 25

H.C. NIESE

WEATHER BREEZY

COUNTY WOOD

R.C. WHITAKER

TEMP. 65°

TOWNSHIP MIDDLETON

SECTION 25

DWG BY RHOADES PID 110037

T 5 N R 11 E

TYPE MONUMENT MAG/WASHER

ON SURFACE - ~~BELOW~~ ON

OFFSET Q PAVEMENT 8.0' ~~LT~~ : RT

2.7' TO LT EDGE PAVEMENT


STATION: 786+52.11

HORIZ.DATUM: NAD83 2011

GEOID: NAVD88 2018

GRID: NORTHING: 649630.041

EASTING: 1652966.625

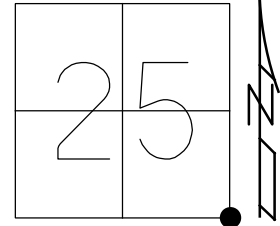

RECORD:

$\Delta = 0^{\circ} 9' \text{ LT}$
STA. 212+97.95
FD BRASS MON
SET P.K./WASHER
9-30-94, MB
FD P.K.NAIL
5/3/09, DCH
SET MAG/WASHER
11-02-09, DCH
FD MAG/WASHER
REF38
3-8-19, JFO
SET MAG/WASHER
9/12/22, TDN

NOTE: S.E.COR.SEC.25

DIST. 38-38A = 47.38'

Q DEVILS HOLE RD

Q SB SR 25

Q NB SR 25

38A

110.63'

93.99'

Q DEVILS HOLE RD

113.28'

64.14'

MB

SET TACK
MB POST

SET SHI
12" PINE

SET SHI

SET SHI

O.D.O.T. DISTRICT 2 SURVEY OFFICE (USE ONLY)

PERSONNEL

REFERENCE NO. 38 A

SHEET 14 OF 19

NOTES AUBLE

DATE 5/25/22

ROUTE SR 25

H.C. NIESE

WEATHER CLOUDY

COUNTY WOOD

R.C. WHITAKER

TEMP. 70°

TOWNSHIP MIDDLETON

SECTION 30

DWG BY RHOADES PID 110037

T 5 N R 11 E

TYPE MONUMENT MAG SHANK

ON SURFACE - ~~BELOW~~ ON

OFFSET Q PAVEMENT 8.5' ~~LT~~ : RT

2.7' TO LT EDGE PAVEMENT


STATION: 786+99.49

HORZ.DATUM: NAD83 2011

GEOID: NAVD88 2018

GRID: NORTHING: 649677.379

EASTING: 1652966.945

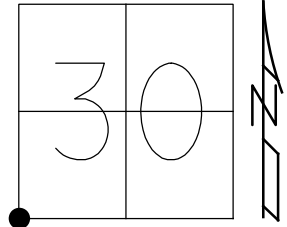

NOTE: S.E.COR.SEC.30


RECORD:
STA. 213+45.48
SET SM.R.R.SPIKE
11-1-85, SWH
SET P.K./WASHER
9-30-94, MB
FD P.K.NAIL
5/3/09, DCH
SET MAG/WASHER
11-02-09, DCH
FD MAG/WASHER
REFA38
3-8-19, JFO
FD MAG SHANK
5/25/22, TDN
SET MAG/WASHER
9/12/22, TDN

DIST. 38-38A = 47.38'

Q DEVILS HOLE RD

Q SB SR 25

Q NB SR 25

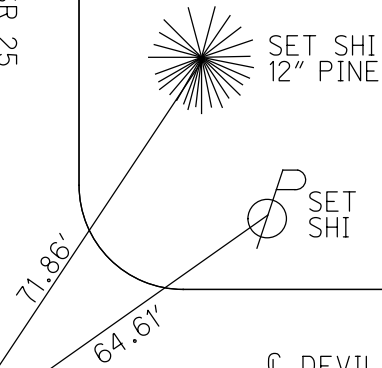

SET TACK
MB POST

38

O.D.O.T. DISTRICT 2 SURVEY OFFICE (USE ONLY)

PERSONNEL

REFERENCE NO. 39

SHEET 15 OF 19

NOTES AUBLE

DATE 5/24/22

ROUTE SR 25

H.C. NIESE

WEATHER CLEAR

COUNTY WOOD

R.C. WHITAKER

TEMP. 55°

TOWNSHIP MIDDLETON

DWG BY RHOADES

PID 110037

SECTION 30

T 6 N R 10 E

TYPE MONUMENT BRASS MON.

~~ON SURFACE~~ - BELOW 5"

OFFSET CL PAVEMENT 8.2' LT : ~~RT~~

2.4' TO LT EDGE PAVEMENT



STATION: 830+80.54

HORZ.DATUM: NAD83 2011

GEOID: NAVD88 2018

GRID: NORTHING: 654057.408

EASTING: 1653002.424

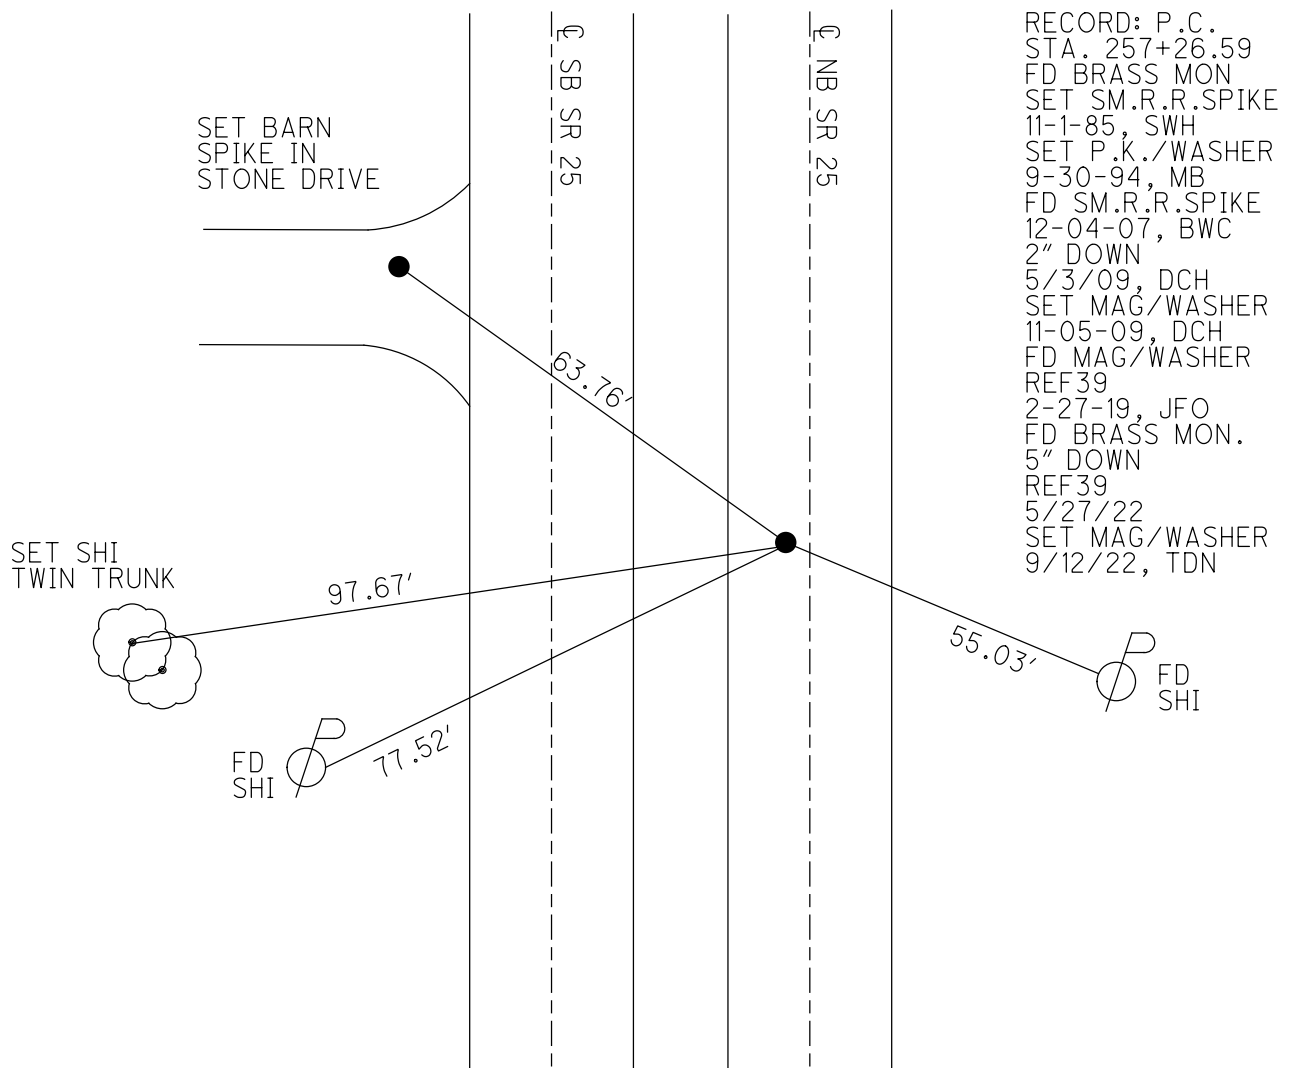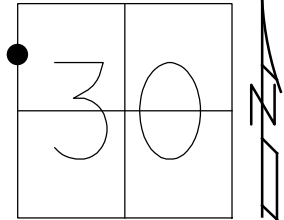

O.D.O.T. DISTRICT 2 SURVEY OFFICE (USE ONLY)

PERSONNEL

REFERENCE NO. 39 A

SHEET 16 OF 19

NOTES LEU

DATE 5/28/2020

ROUTE SR 25

H.C. O'DONNELL

WEATHER CLOUDY

COUNTY WOOD

R.C. AUBLE

TEMP. 72°

TOWNSHIP MIDDLETON

RHOADES

SECTION 30

DWG BY GARRETT

PID 95722

T 6 N R 10 E

TYPE MONUMENT MAG SHANK

ON SURFACE - ~~BELOW~~ ON

OFFSET Q PAVEMENT 1.6' LT : ~~RT~~

9.5' TO LT EDGE PAVEMENT



STATION: 836+90.20

HORZ.DATUM: NAD83 (2011)

GEOID: 2012A

GRID: NORTHING: 654664.989

EASTING: 1653056.034

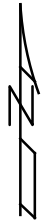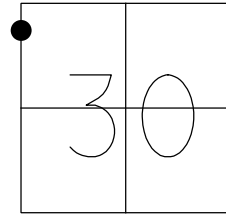

RECORD: P.T.
STA. 263+37.90
FD BRASS MON
SET SM.R.R.PIKE
11-1-85, SWH
SET P.K./WASHER
9-30-94, MB
FD SM.R.R.SPIKE
12-4-07, BWC
FD SM.R.R.SPIKE
2" DOWN
5/3/09, DCH
SET MAG/WASHER
11-02-09, DCH
FD MAG/WASHER
REFA39
2-27-19, JFO

SET SHI
G.R. POST

S.B.L. US 25

N.B.L. US 25

FD CUT "+"
STEEL POLE
3.5' UP

MOTEL
DRIVEWAY

FD
SHI

SET SHI
12" TREE

73.53'

82.38'

71.69'

85.87'

O.D.O.T. DISTRICT 2 SURVEY OFFICE (USE ONLY)

PERSONNEL

REFERENCE NO. 40

SHEET 17 OF 19

NOTES HOMAN

DATE 5/3/09

ROUTE SR 25

H.C. ROUSOS

WEATHER CLEAR

COUNTY WOOD

R.C. HOMAN

TEMP. 70°

TOWNSHIP MIDDLETON

SECTION 30

DWG BY RHOADES

PID 25519

T 6 N R 11 E

TYPE MONUMENT IPIPE

ON SURFACE - ~~BELOW~~ ON

OFFSET Q PAVEMENT 17.7' LT : ~~RT~~

- TO - EDGE PAVEMENT


STATION: 827+80

HORIZ.DATUM: NAD 83

GEOID: NAVD88 2003

GRID: NORTHING: 654861.262

EASTING: 1653009.159

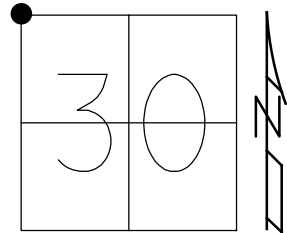

NOTE: NW.COR.SEC.30

Q SR 582

Q SR 582

CUT "+"
CBS



53.11' P

10.92' P

CUT "+"
CBS



Q SB SR 25

Q NB SR 25

RECORD:
SET 1" IPIPE
4/7/03, MB
FD 1" IPIPE
LEANING NORTH
12/4/07
CP2
5/3/09, DCH

PERSONNEL

REFERENCE NO. 40 A

SHEET 18 OF 19

NOTES LEU

DATE 5/28/20

ROUTE SR 25

H.C. O'DONNELL

WEATHER CLOUDY

COUNTY WOOD

R.C. AUBLE

TEMP. 72°

TOWNSHIP MIDDLETON

RHOADES

DWG BY GARRETT

PID 95722

T₆S R₁₁E

TYPE MONUMENT MAG/WASHER

ON SURFACE - ~~BELOW~~ ON

OFFSET C PAVEMENT 1.2' LT : RT

10.0' TO LT EDGE PAVEMENT


STATION: 827+76

HORZ.DATUM: NAD83 (2011)

GEOID: 2012A

GRID: NORTHING: 654858.861

EASTING: 1653088.897

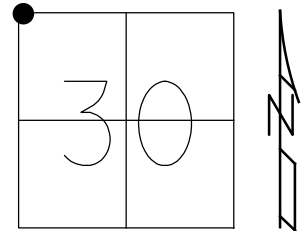

RECORD:
RESET P.K./WASHER
9/30/94, MB
FD MAG/WASHER
REFA40
2-28-19, JFO

℄ SR 582

M
17

RECORD: REF 17
N.E.COR.SEC.25
STA.266+10.60
SET SM.R.R.SPIKE
11/1/85, SWH
FD MONBOX
4/28/11, RJL
N: 654937.194
E: 1653009.502

40

CD-11C-05

N.B.L. US 25

41

Q SR 582

SET
MAG

SET
SHI

111.51' REC

$$75.16'$$

64.53

83.90

79.49' REC

TOP N.W. COR. TOP
BLOCK OF PORCH
ROOF SUPPORT

READY
HOTEL

O.D.O.T. DISTRICT 2 SURVEY OFFICE (USE ONLY)

PERSONNEL

REFERENCE NO. 41

SHEET 19 OF 19

NOTES LEU

DATE 5/28/20

ROUTE SR 25

H.C. O'DONNELL

WEATHER CLOUDY

COUNTY WOOD

R.C. AUBLE

TEMP. 72°

TOWNSHIP MIDDLETON

RHOADES

SECTION 30

DWG BY GARRETT

PID 95722

T 6 S R 11 E

TYPE MONUMENT MAG/WASHER

ON SURFACE - ~~BELOW~~ ON

OFFSET CL PAVEMENT 1.2' LT : ~~RT~~

10.0' TO LT EDGE PAVEMENT


STATION: 828+52

HORIZ.DATUM: NAD83 (2011)

GEOID: 2012A


GRID: NORTHING: 654933.983

EASTING: 1653101.598

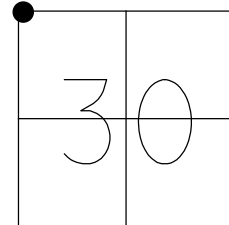

RECORD:
SET P.K./WASHER
9/30/94, MB
FD R.R.SPIKE
5/9/11, RJL
FD MAG/WASHER
REF41
2-28-19, JFO

NOTE: REF 17A SR 582

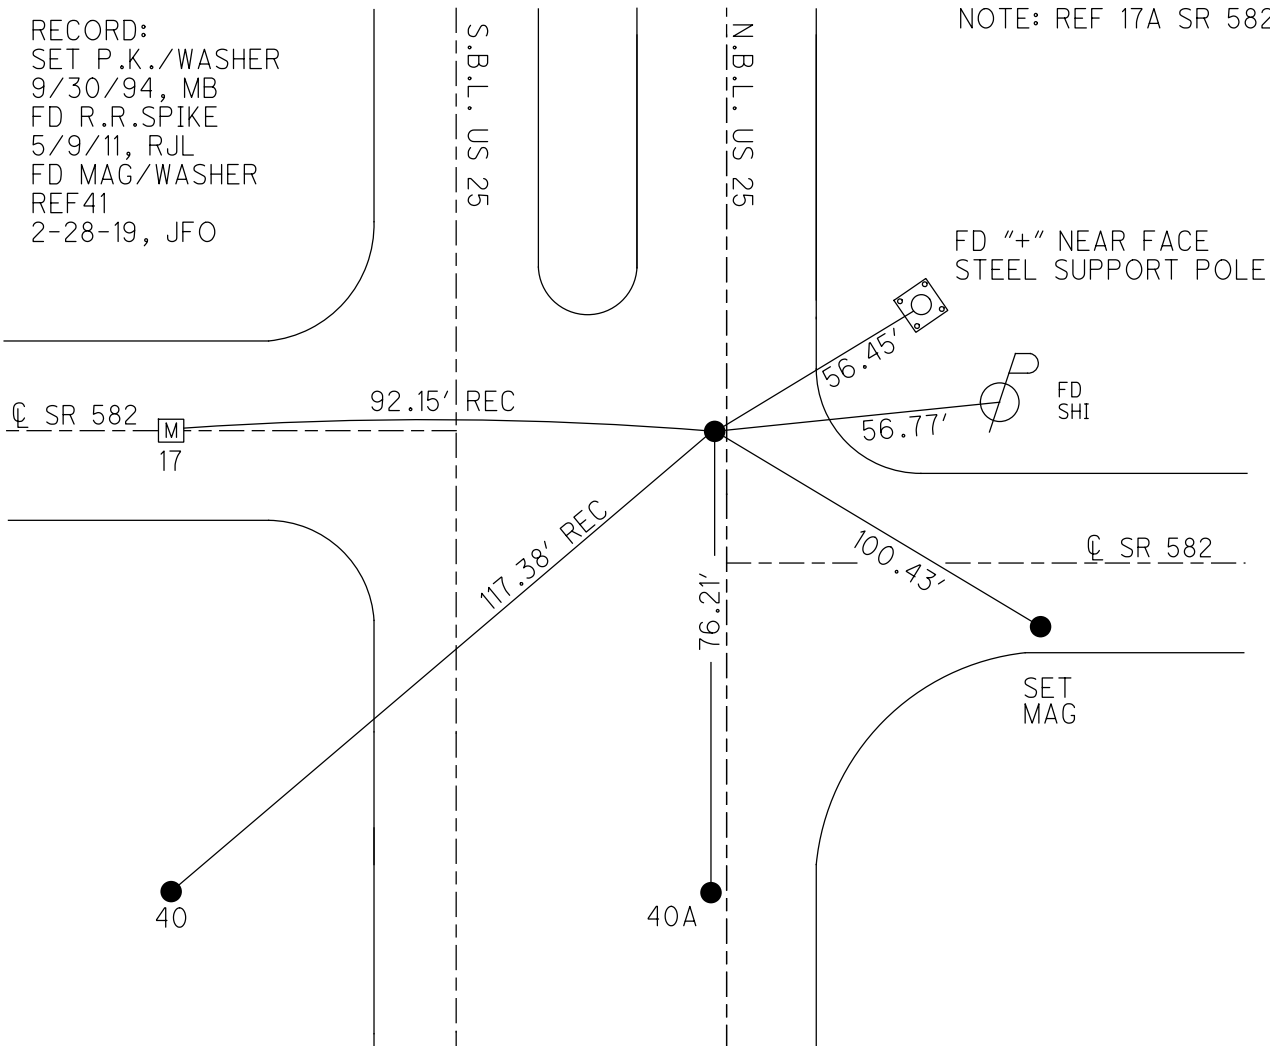

O.D.O.T. DISTRICT 2 SURVEY OFFICE (USE ONLY)

PERSONNEL

REFERENCE NO. 42

SHEET 1 OF 19

NOTES LEU

DATE 5/28/20

ROUTE SR 25

H.C. O'DONNELL

WEATHER CLOUDY

COUNTY WOOD

R.C. AUBLE

TEMP. 73°

TOWNSHIP MIDDLETON

RHOADES

SECTION 19

DWG BY RHOADES PID 95722

T 6 N R 11 E

TYPE MONUMENT MAG/WASHER

ON SURFACE - ~~BELOW~~ ON

OFFSET CL PAVEMENT 5.6' LT : ~~RT~~

5.7' TO LT EDGE PAVEMENT


STATION: 892+78.51

HORZ.DATUM: NAD83 (2011)


GEOID: 2012A

GRID: NORTHING: 660174.902

EASTING: 1653988.789

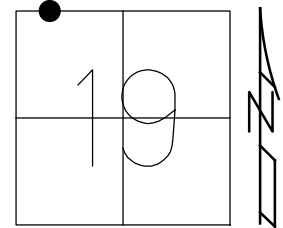

RECORD:
SET SM.R.R.SPIKE
6/14/91, DC
FD R.R.SPIKE
5/14/03, MB
SET MAG NAIL
7/14/03, DCH
FD MAG/WASHER
REF42
2/27/19, JFO
SET MAG/WASHER
10/16/20, JFO

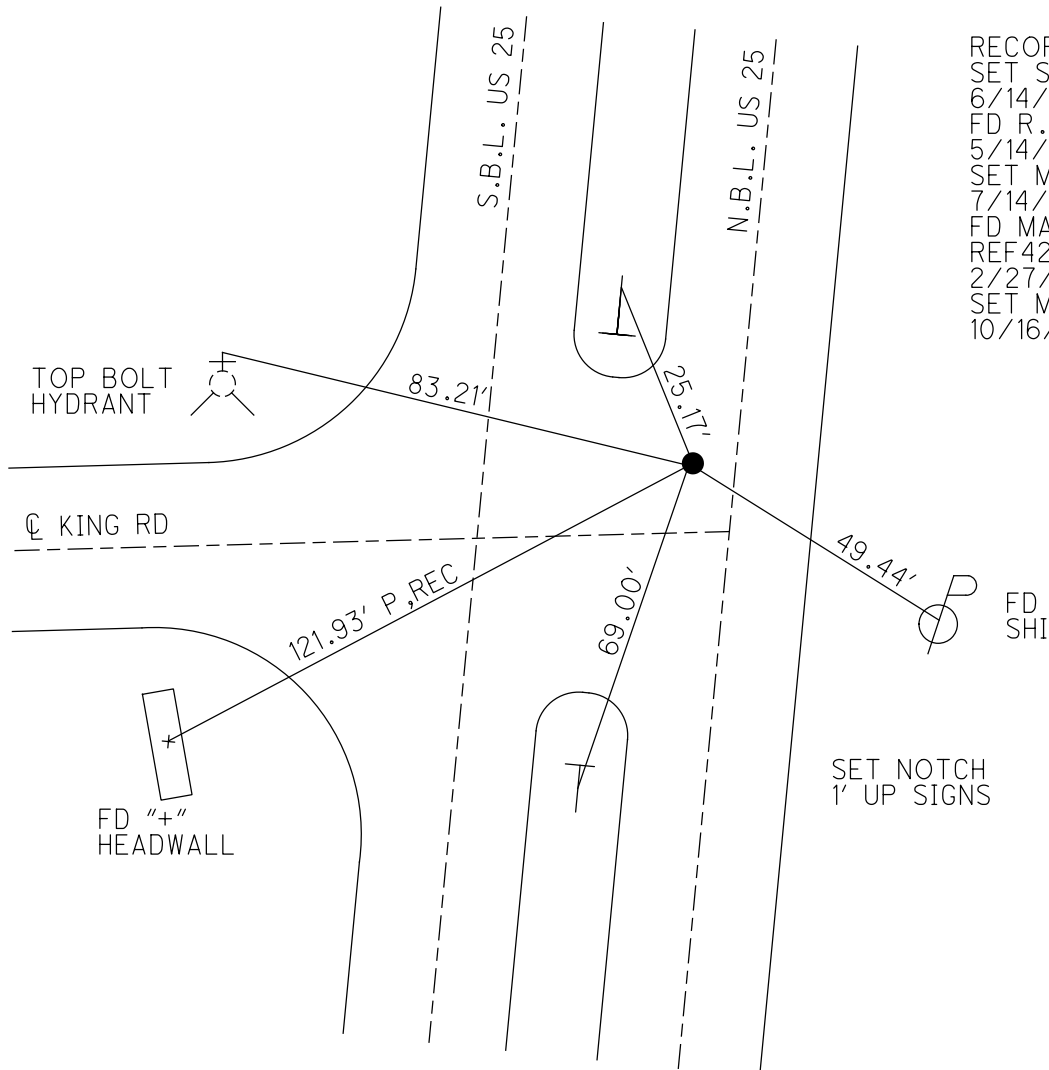

O.D.O.T. DISTRICT 2 SURVEY OFFICE (USE ONLY)

PERSONNEL

REFERENCE NO. 43

SHEET 2 OF 19

NOTES LEU

DATE 5/28/20

ROUTE SR 25

H.C. O'DONNELL

WEATHER CLOUDY

COUNTY WOOD

R.C. AUBLE

TEMP. 74°

TOWNSHIP MIDDLETON

RHOADES

SECTION 18

DWG BY RHOADES PID 95722

T 6 N R 11 E

TYPE MONUMENT MAG/WASHER

ON SURFACE - ~~BELOW~~ ON

OFFSET Q PAVEMENT 6.4' LT : ~~RT~~

4.6' TO LT EDGE PAVEMENT


STATION: 905+56.03

HORZ.DATUM: NAD83 (2011)


GEOID: 2012A

GRID: NORTHING: 661434.474

EASTING: 1654202.199

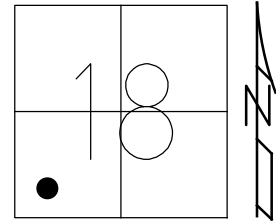

RECORD: P.I.
STA. 332+04.19
 $\Delta=0^{\circ}40'$ LT
SET SM.R.R.SPIKE
6/14/91, DC
FD BRASS MON
5" DOWN
5/14/03, MB
SET MAG NAIL
7/14/03, DCH
FD MAG/WASHER
REF43
2/27/19, JFO
SET MAG/WASHER
10/16/20, JFO

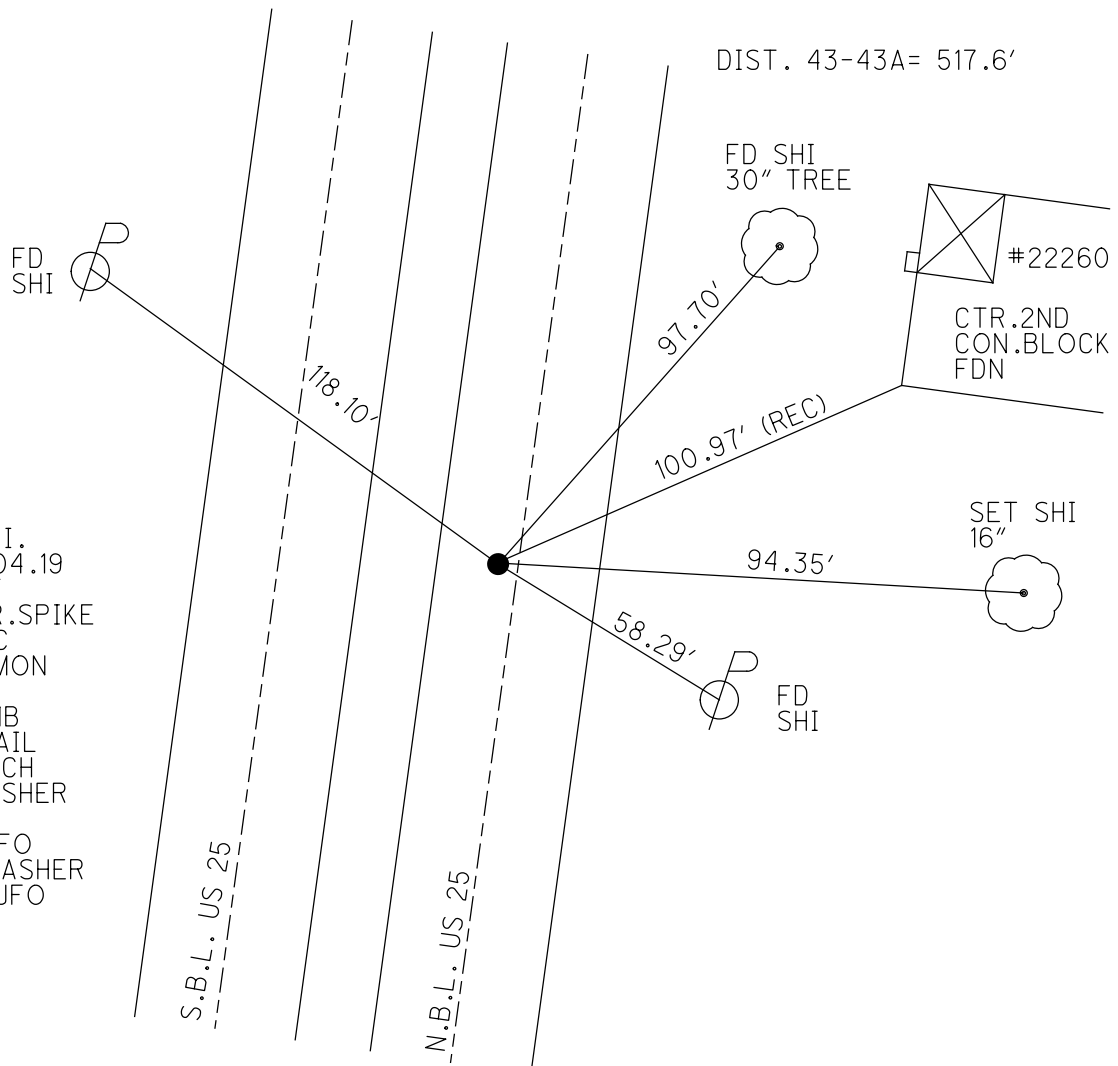

O.D.O.T. DISTRICT 2 SURVEY OFFICE (USE ONLY)

PERSONNEL

REFERENCE NO. 43 A

SHEET 3 OF 19

NOTES LEU
H.C. O'DONNELL
R.C. AUBLE
RHOADES

DATE 5/28/20
WEATHER CLOUDY
TEMP. 74°

ROUTE SR 25
COUNTY WOOD
TOWNSHIP MIDDLETON
SECTION 18

DWG BY RHOADES PID 95722

T 6 N R 11 E

TYPE MONUMENT MAG NAIL

ON SURFACE - ~~BELOW~~ ON

OFFSET Q PAVEMENT 6.8' LT : ~~RT~~

3.7' TO LT EDGE PAVEMENT


STATION: 910+73.67

HORIZ.DATUM: NAD83 (2011)

GEOID: NAVD88 2012A


GRID: NORTHING: 661945.809

EASTING: 1654282.771

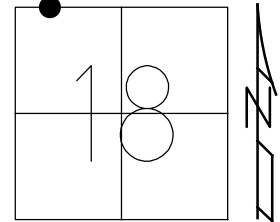

RECORD:
FD P.K.NAIL
5/14/03, MB
SET MAG NAIL
7/14/03, DCH
FD MAG NAIL
REFA43
2/27/19, JFO
SET MAG/WASHER
10/16/20, JFO

DIST. 43A-44= 182.31'

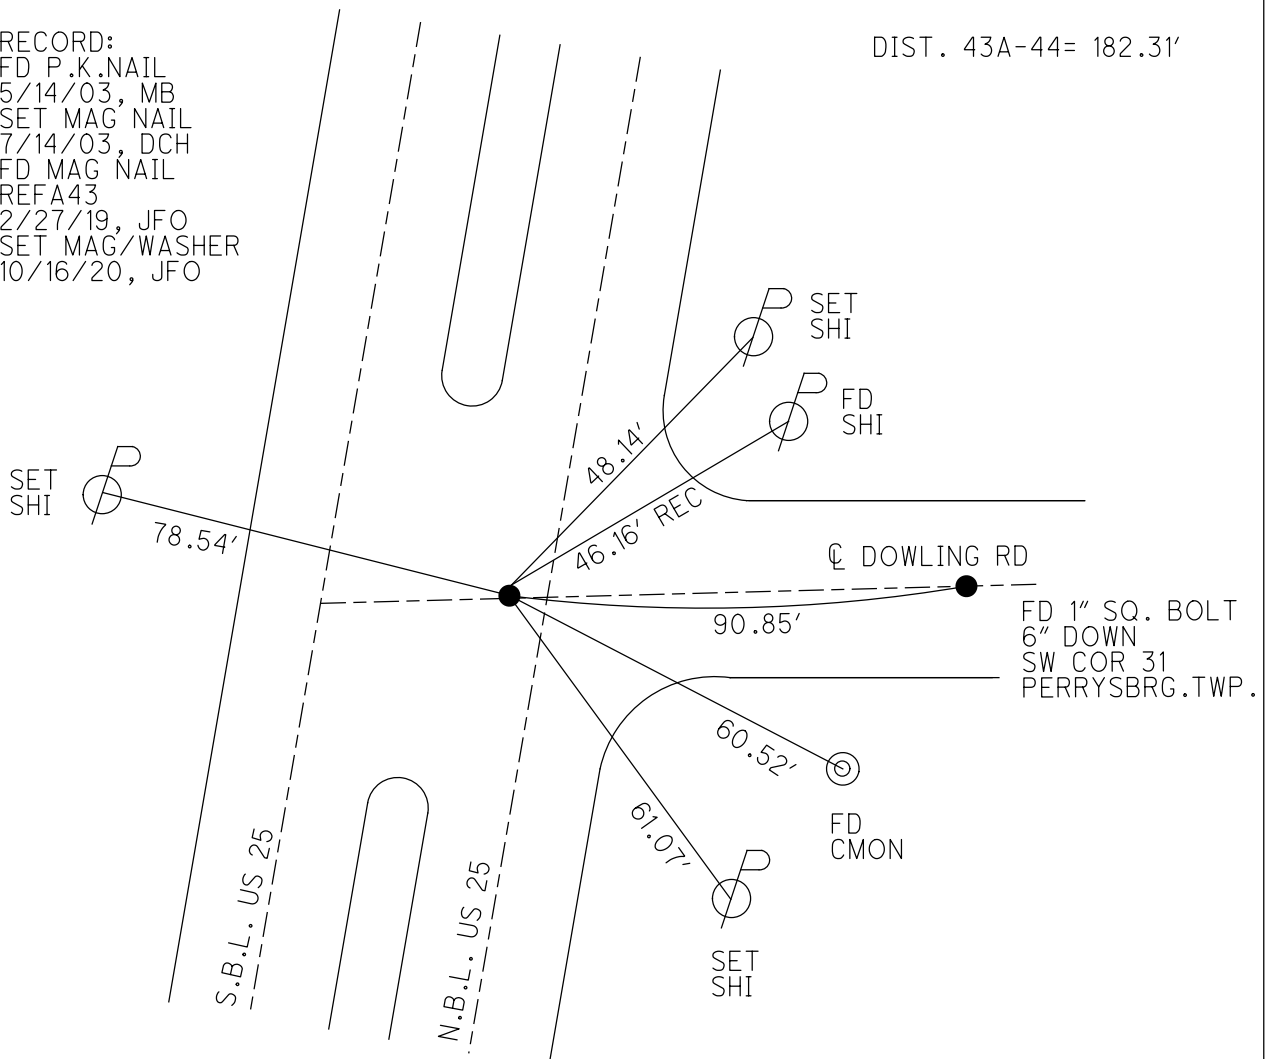

O.D.O.T. DISTRICT 2 SURVEY OFFICE (USE ONLY)

PERSONNEL

REFERENCE NO. 44

SHEET 4 OF 19

NOTES LEU

DATE 5/28/20

ROUTE SR 25

H.C. O'DONNELL

WEATHER CLOUDY

COUNTY WOOD

R.C. AUBLE

TEMP. 74°

TOWNSHIP MIDDLETON

RHOADES

SECTION 36

DWG BY RHOADES

PID 95722

T 6 N R 11 E

TYPE MONUMENT MAG/WASHER

ON SURFACE - ~~BELOW~~ ON

OFFSET CL PAVEMENT 7.4' LT : ~~RT~~

4.1' TO LT EDGE PAVEMENT


STATION: 912+55.97

HORZ.DATUM: NAD83 (2011)

GEOID: NAVD88 2012A


GRID: NORTHING: 662125.926

EASTING: 1654310.870

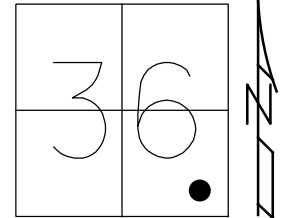

RECORD: P.I.
STA. 334+04.60
 $\Delta = 0^\circ 15' \text{ RT}$
FD BRASS MON
4" DOWN
5/14/06, MB
FD MAG/WASHER
REF44
2/27/19, JFO
SET MAG/WASHER
10/16/20, JFO

DIST. 43A-44= 182.31'

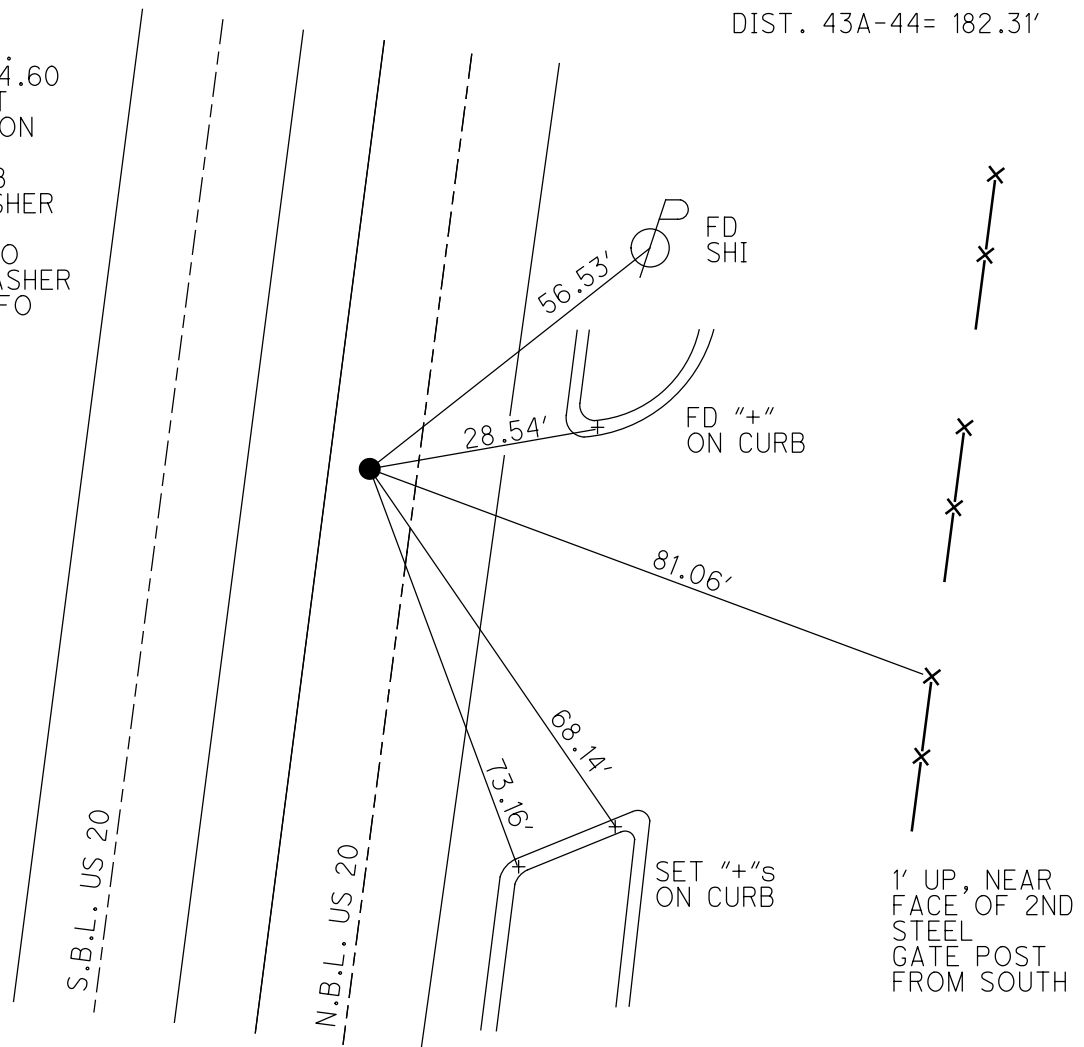

O.D.O.T. DISTRICT 2 SURVEY OFFICE (USE ONLY)

PERSONNEL

REFERENCE NO. 45

SHEET 5 OF 19

NOTES _____ LEU _____

DATE 5/28/20ROUTE SR 25

H.C. O'DONNELL

WEATHER LIGHT RAIN

COUNTY WOOD

R.C. AUBLE

TEMP. 74°

TOWNSHIP MIDDLETON

RHOADES

SECTION 36DWG BY RHOADES PID 95722

T_6_N R_11_E

TYPE MONUMENT MAG/WASHER

ON SURFACE - ~~BELOW~~ ON _____

OFFSET C PAVEMENT 6.4' LT : ~~RT~~


5.1' TO LT EDGE PAVEMENT

STATION: 937+81.48


HORZ.DATUM: NAD83 (2011)

GEOID: NAVD88 2012A

GRID: NORTHING: 664618.866

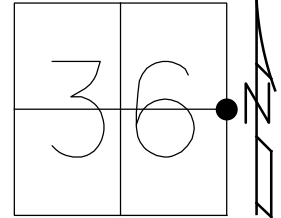EASTING: 1654715.190

RECORD:
SET SM.R.R.SPIKE
6/14/91, DJC
FD BRASS MON
4.5" DOWN
5/14/03, MB
SET MAG NAIL
7/14/03, DCH
FD MAG/WASHER
REF45
2/27/19, JFO
SET MAG/WASHER
10/16/20, JFO

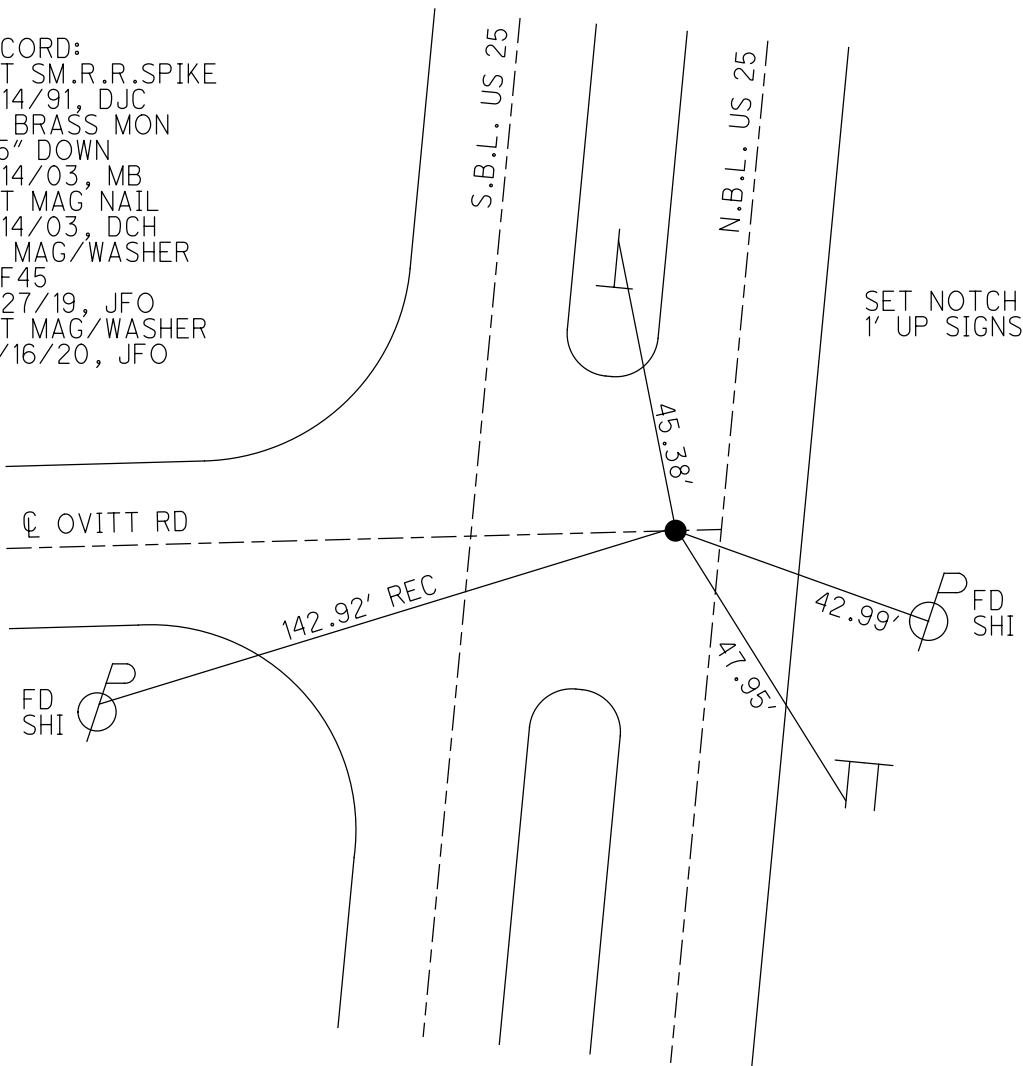

O.D.O.T. DISTRICT 2 SURVEY OFFICE (USE ONLY)

PERSONNEL

REFERENCE NO. 46

SHEET 6 OF 19

NOTES LEU

DATE 5/28/20

ROUTE SR 25

H.C. O'DONNELL

WEATHER LIGHT RAIN

COUNTY WOOD

R.C. AUBLE

TEMP. 74°

TOWNSHIP MIDDLETON

RHOADES

SECTION 30

DWG BY RHOADES PID 95722

T 6 N R 11 E

TYPE MONUMENT MAG/WASHER

ON SURFACE - ~~BELOW~~ ON

OFFSET CL PAVEMENT 5.2' LT : ~~RT~~

5.9' TO LT EDGE PAVEMENT



STATION: 965+22.66

HORZ.DATUM: NAD83 (2011)

GEOID: NAVD88 2012A

GRID: NORTHING: 667324.625

EASTING: 1655154.430

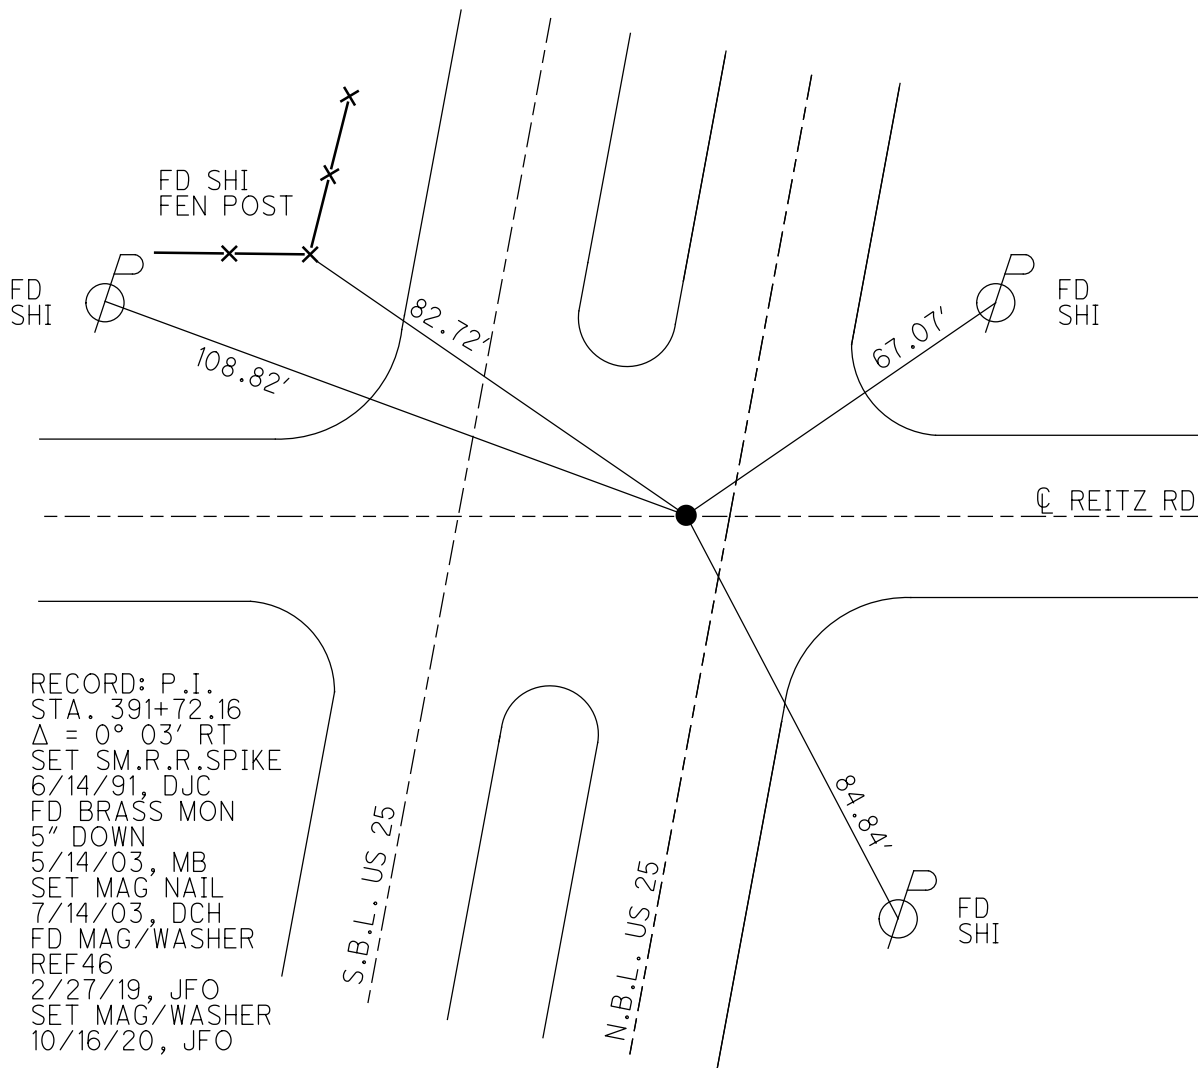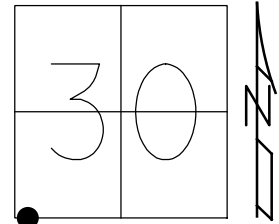

RECORD: P.I.
STA. 391+72.16
 $\Delta = 0^{\circ} 03' RT$
SET SM.R.R.SPIKE
6/14/91, DJC
FD BRASS MON
5" DOWN
5/14/03, MB
SET MAG NAIL
7/14/03, DCH
FD MAG/WASHER
REF46
2/27/19, JFO
SET MAG/WASHER
10/16/20, JFO

O.D.O.T. DISTRICT 2 SURVEY OFFICE (USE ONLY)

PERSONNEL

REFERENCE NO. 47

SHEET 7 OF 19

NOTES LEU

DATE 5/28/20

ROUTE SR 25

H.C. O'DONNELL

WEATHER CLOUDY

COUNTY WOOD

R.C. AUBLE

TEMP. 74°

TOWNSHIP PERRYSBURG

RHOADES

SECTION 30

DWG BY RHOADES PID 102808

T 6 N R 11 E

TYPE MONUMENT BRASS MON

ON SURFACE - ~~BELOW~~ 4"

OFFSET C PAVEMENT 5.8" LT : ~~RT~~

5.7' TO LT EDGE PAVEMENT


STATION: 991+66.9

HORIZ.DATUM: NAD83 (2011)

GEOID: NAVD88 2012A


GRID: NORTHING: 669934.335

EASTING: 1655980.694

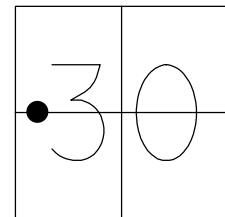

RECORD:
SET R.R.SPIKE
6/6/91, DJC
FD BRASS MON.
5" DOWN
5/14/03, MB
SET MAG NAIL
7/14/03, DCH
FD MAG/WASHER
REF47
10/27/15, JFO
FD MAG/WASHER
REF47
2/27/19, JFO
FD BRASS MON
4" DOWN
NEWREF47
5/28/20, JLL
SET MAG/WASHER
10/16/20, JFO

FD "+"
27" DOWN
6" IRON POST

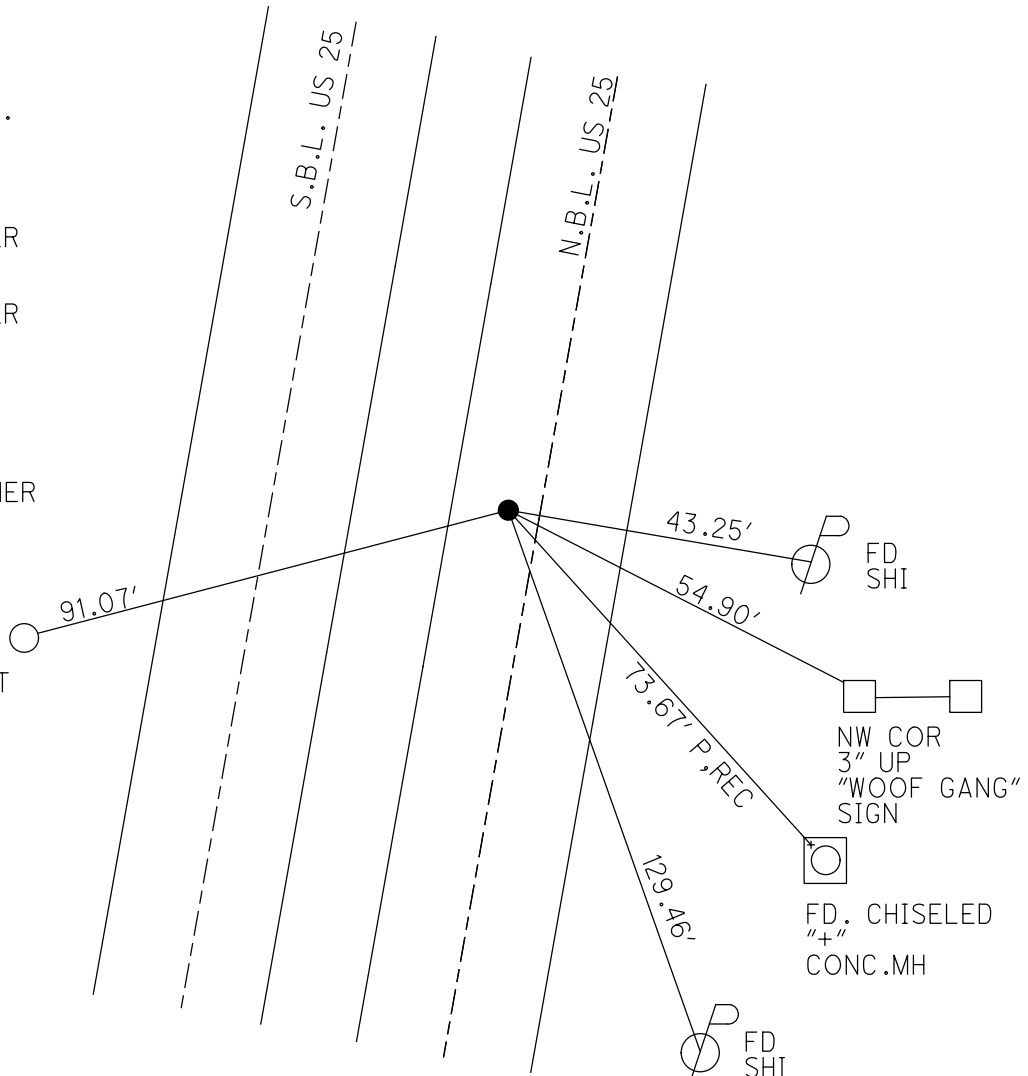

O.D.O.T. DISTRICT 2 SURVEY OFFICE (USE ONLY)

PERSONNEL

REFERENCE NO. 48

SHEET 8 OF 19

NOTES LEU

DATE 5/28/20

ROUTE SR 25

H.C. O'DONNELL

WEATHER CLOUDY

COUNTY WOOD

R.C. AUBLE

TEMP. 75°

TOWNSHIP PERRYSBURG

RHOADES

SECTION 30

DWG BY RHOADES PID 102808

T 6 N R 11 E

TYPE MONUMENT MAG/WASHER

ON SURFACE ~~BELOW~~ ON

OFFSET CL PAVEMENT 4.7' LT : ~~RT~~

6.5' TO LT EDGE PAVEMENT


STATION: 1005+58.7

HORIZ.DATUM: NAD83 2011


GEOID: NAVD88 2012A

GRID: NORTHING: 671307.888

EASTING: 1655805.047

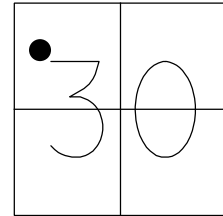

RECORD:
SET R.R.SPIKE
6/6/91, DJC
FD SM.R.R.SPIKE
5/14/03, MB
SET MAG NAIL
7/14/03, DCH
FD MAG/WASHER
REF 48
10/27/15, JFO
FD MAG/WASHER
REF 48
2/27/19, JFO
SET MAG/WASHER
10/16/20, JFO

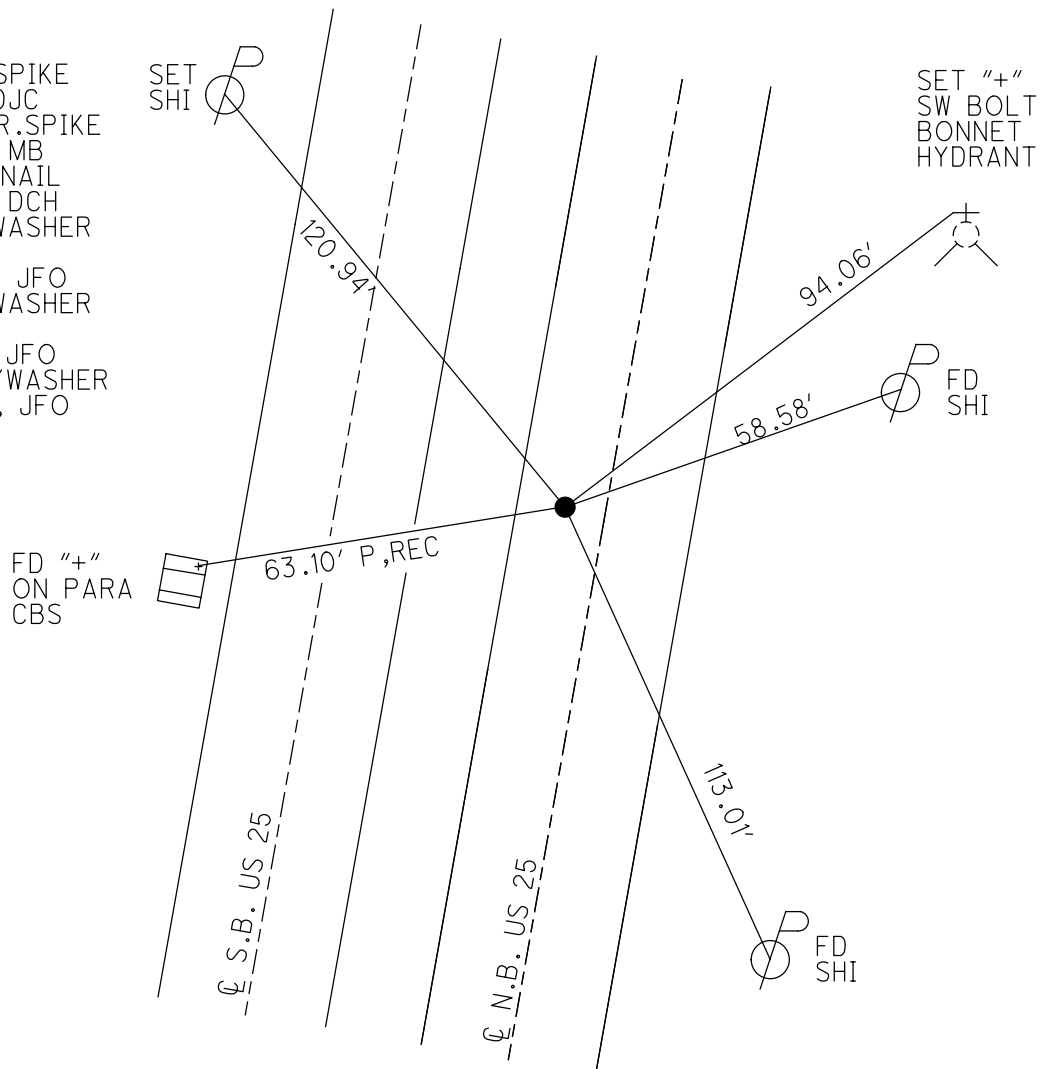

O.D.O.T. DISTRICT 2 SURVEY OFFICE (USE ONLY)

PERSONNEL

REFERENCE NO. 49

SHEET 9 OF 19

NOTES LEU

DATE 3/8/19

ROUTE SR 25

H.C. O'DONNELL

WEATHER SUNNY

COUNTY WOOD

R.C. LEU

TEMP. 32°

TOWNSHIP PERRYSBURG

SECTION 30

DWG BY RHOADES

PID 102808

T 6 N R 11 E

TYPE MONUMENT BRASS MON. W/ DIMPLE

~~ON SURFACE~~ - BELOW 4"

OFFSET Q PAVEMENT 5.1' LT : ~~RT~~

6' TO LT EDGE PAVEMENT


STATION: 1019+04

HORIZ.DATUM: NAD83 2011


GEOID: NAVD88 2012A

GRID: NORTHING: 672635.541

EASTING: 1656021.981

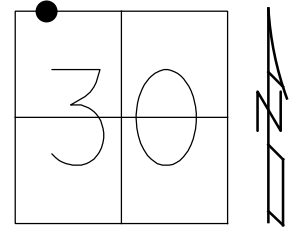

RECORD: P.I.
STA. 445+54.15
25#64 = 0° 07" LT
SET R.R.SPIKE
6/6/91, DJC
FD BRASS MON
5" DOWN
5/14/03, MB
SET MAG NAIL
7/14/03, DCH
FD MAG/WASHER
REF49
10/27/15, JFO
SET MAG/WASHER
10/16/20, JFO

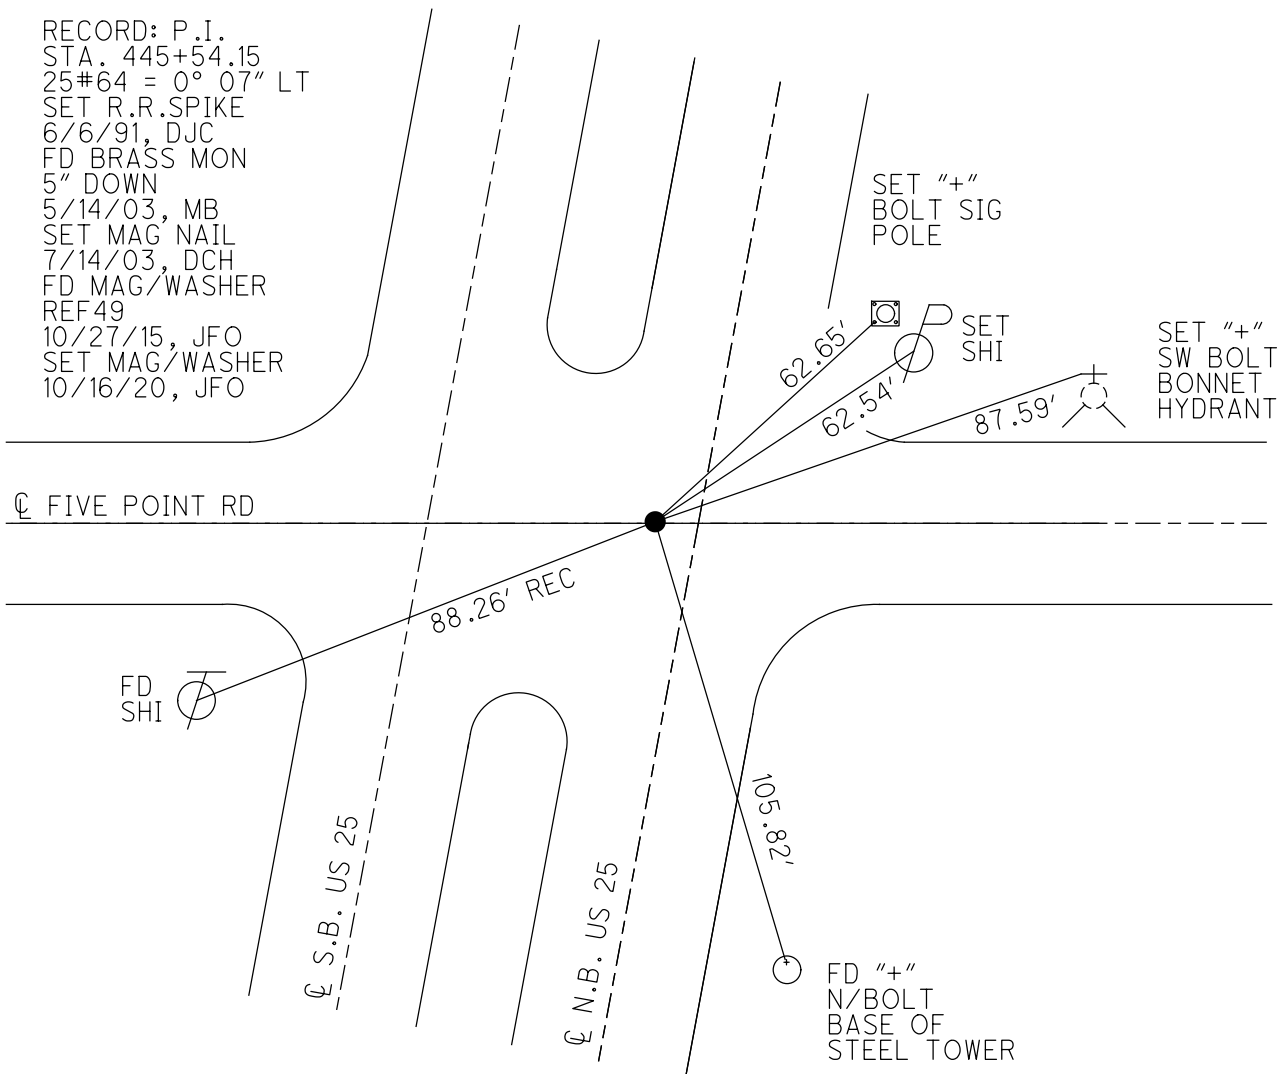

O.D.O.T. DISTRICT 2 SURVEY OFFICE (USE ONLY)

PERSONNEL

REFERENCE NO. 50

SHEET 10 OF 19

NOTES STONE DATE 4/10/91
H.C. CURTIS WEATHER COLD
R.C. HOUSEHOLDER TEMP. 38°

ROUTE SR 25
COUNTY WOOD
TOWNSHIP PERRYSBURG
SECTION 19
T 6 N R 11 E

DWG BY RHOADES PID 102808

TYPE MONUMENT SM.R.R.SPIKE

ON SURFACE - ~~BELOW~~ ON

OFFSET Q PAVEMENT - LT : RT

- TO - EDGE PAVEMENT


STATION: 1073+33.51

HORZ.DATUM: NAD83 2011


GEOID: NAVD88 2012A

GRID: NORTHING: 677995.994

EASTING: 1656885.364

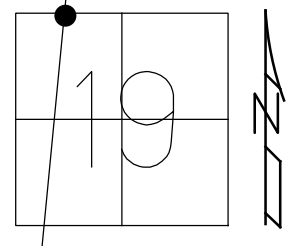

RECORD:
FD SM.R.R.SPIKE
4/10/91, IRS
SET SM.R.R.SPIKE
6/6/91, DJC
FD MONBOX
W/1" IPIN
REF50
3/26/18, JFO

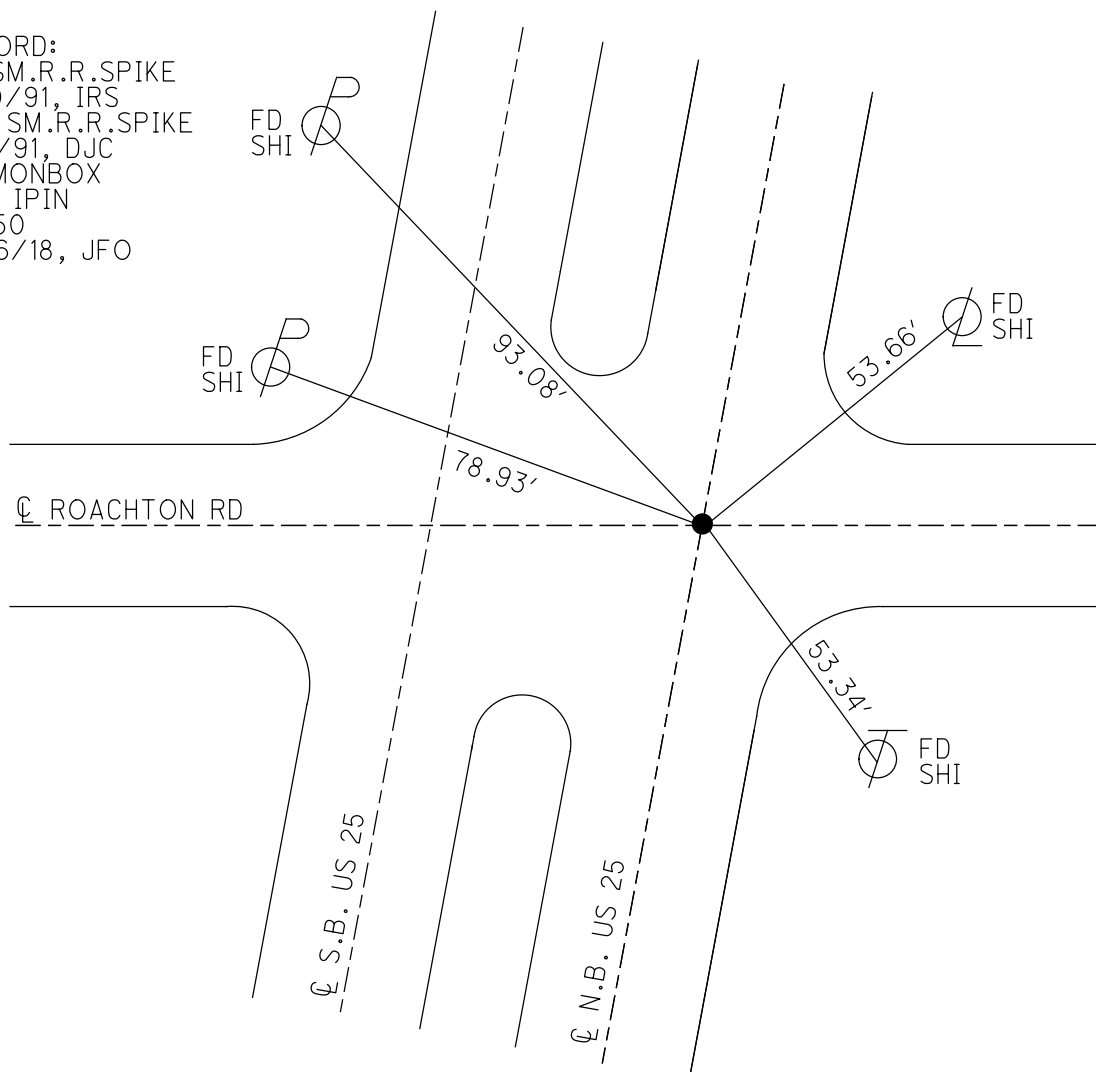

O.D.O.T. DISTRICT 2 SURVEY OFFICE (USE ONLY)

PERSONNEL

REFERENCE NO. 50 A

SHEET 5 OF 13

NOTES RHOADES

DATE 3/26/18

ROUTE SR 25

H.C. O'DONNELL

WEATHER SUNNY

COUNTY WOOD

R.C. SEAMAN

TEMP. 31°

TOWNSHIP PERRYSBURG

SECTION 18

DWG BY RHOADES PID 102808

T 6 N R 11 E

TYPE MONUMENT MAG/WASHER

ON SURFACE - ~~BELOW~~ ON

OFFSET CL PAVEMENT ON LT : RT

- TO - EDGE PAVEMENT


STATION: 1064+33

HORIZ.DATUM: NAD83 2011


GEOID: NAVD88 2012A

GRID: NORTHING: 679251.419

EASTING: 1656925.695

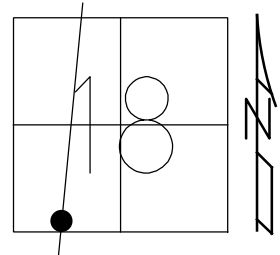

RECORD:
FD P.K.NAIL
4/10/91, IRS
SET P.K.NAIL
6/6/91, DJC
FD MAG/WASHER
REFA50
3/26/18, JFO
SET MAG/WASHER
2/4/19, JFO

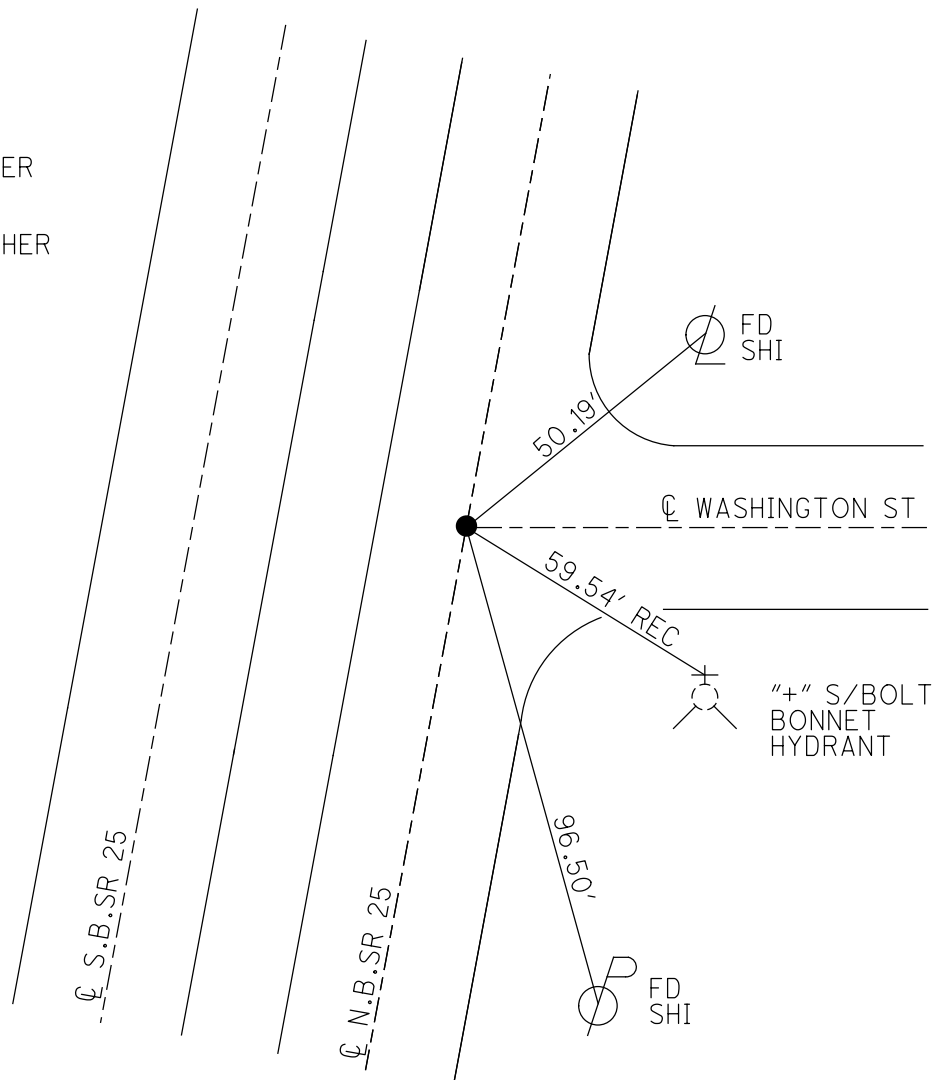

O.D.O.T. DISTRICT 2 SURVEY OFFICE (USE ONLY)

PERSONNEL

REFERENCE NO. 50 B

SHEET 6 OF 13

NOTES RHOADES
H.C. O'DONNELL
R.C. SEAMAN

DATE 3/26/18
WEATHER SUNNY
TEMP. 35°

ROUTE SR 25
COUNTY WOOD
TOWNSHIP PERRYSBURG
SECTION 18
T 6 N R 11 E

DWG BY RHOADES PID 102808

TYPE MONUMENT MAG/WASHER

ON SURFACE - ~~BELOW~~ ON

OFFSET Q PAVEMENT ON LT : RT
- TO - EDGE PAVEMENT


STATION: 1066+77

HORZ.DATUM: NAD83 2011


GEOID: NAVD88 2012A

GRID: NORTHING: 678492.418

EASTING: 165963.352

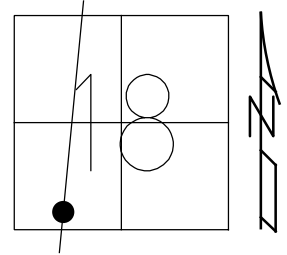

RECORD:
FD P.K.NAIL
4/10/91, IRS
SET P.K.NAIL
6/6/91, DJC
FD MAG/WASHER
REFB50
3/26/18, JFO
SET MAG/WASHER
2/4/19, JFO

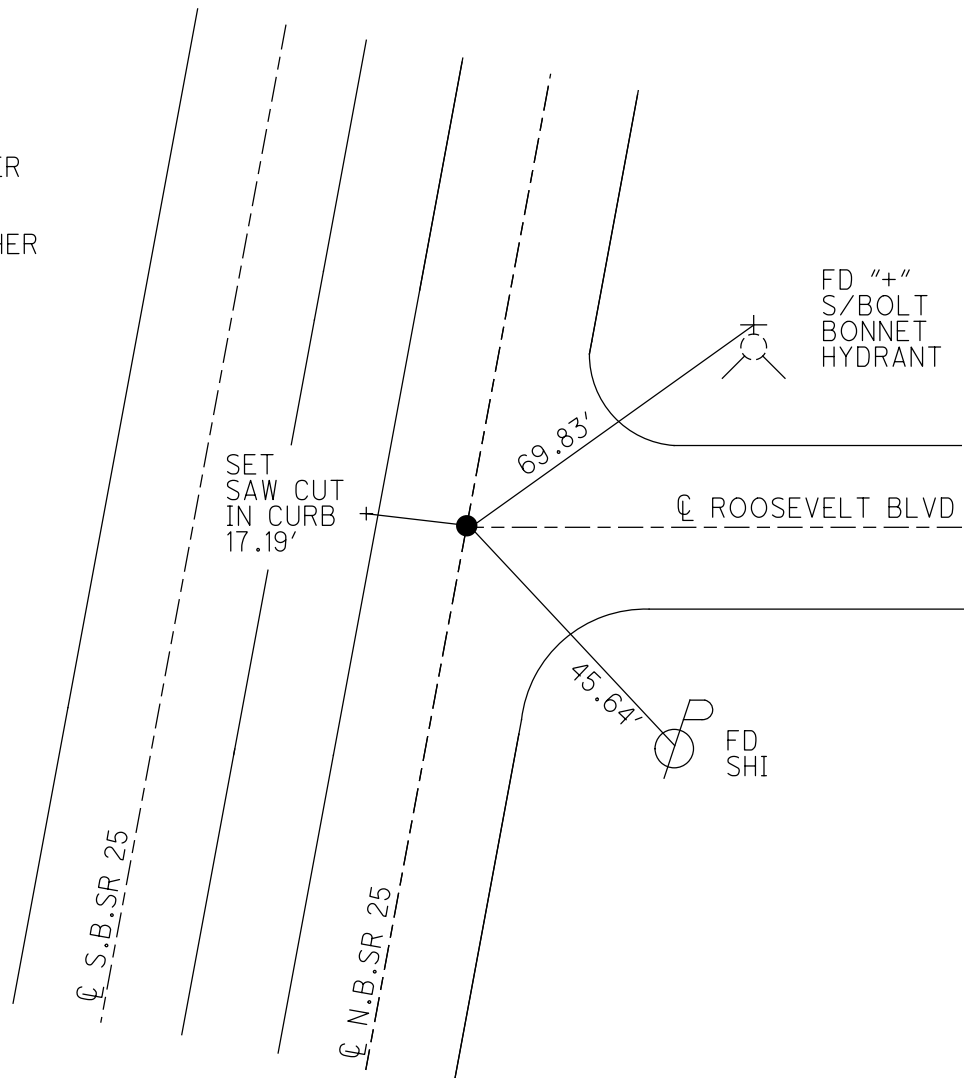

O.D.O.T. DISTRICT 2 SURVEY OFFICE (USE ONLY)

PERSONNEL

REFERENCE NO. 50 C

SHEET 7 OF 13

NOTES RHOADES

DATE 3/26/18

ROUTE SR 25

H.C. O'DONNELL

WEATHER SUNNY

COUNTY WOOD

R.C. SEAMAN

TEMP. 35°

TOWNSHIP PERRYSBURG

SECTION 18

DWG BY RHOADES PID 102808

T 6 N R 11 E

TYPE MONUMENT MAG/WASHER

ON SURFACE - ~~BELOW~~ ON

OFFSET CL PAVEMENT ON LT : RT

- TO - EDGE PAVEMENT


STATION: 1066+77

HORIZ.DATUM: NAD83 2011

GEOID: NAVD88 2012A

GRID: NORTHING: 678735.006

EASTING: 1657001.404

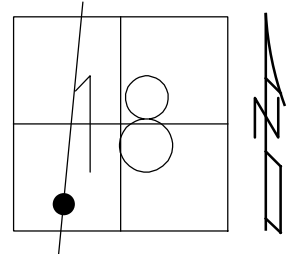


RECORD:

SET P.K.NAIL
6/6/91, DJC
FD P.K.NAIL
7/16/07, DCH
SET MAG/WASHER
11/13/07, SAH
SET MAG/WASHER
REFC50
3/26/18, JFO
SET MAG/WASHER
2/4/19, JFO

1' UP
475/23
SIGN
SW/COR
I-BEAM

SET
SHI

FD "+"
S/BOLT
BONNET
HYDRANT

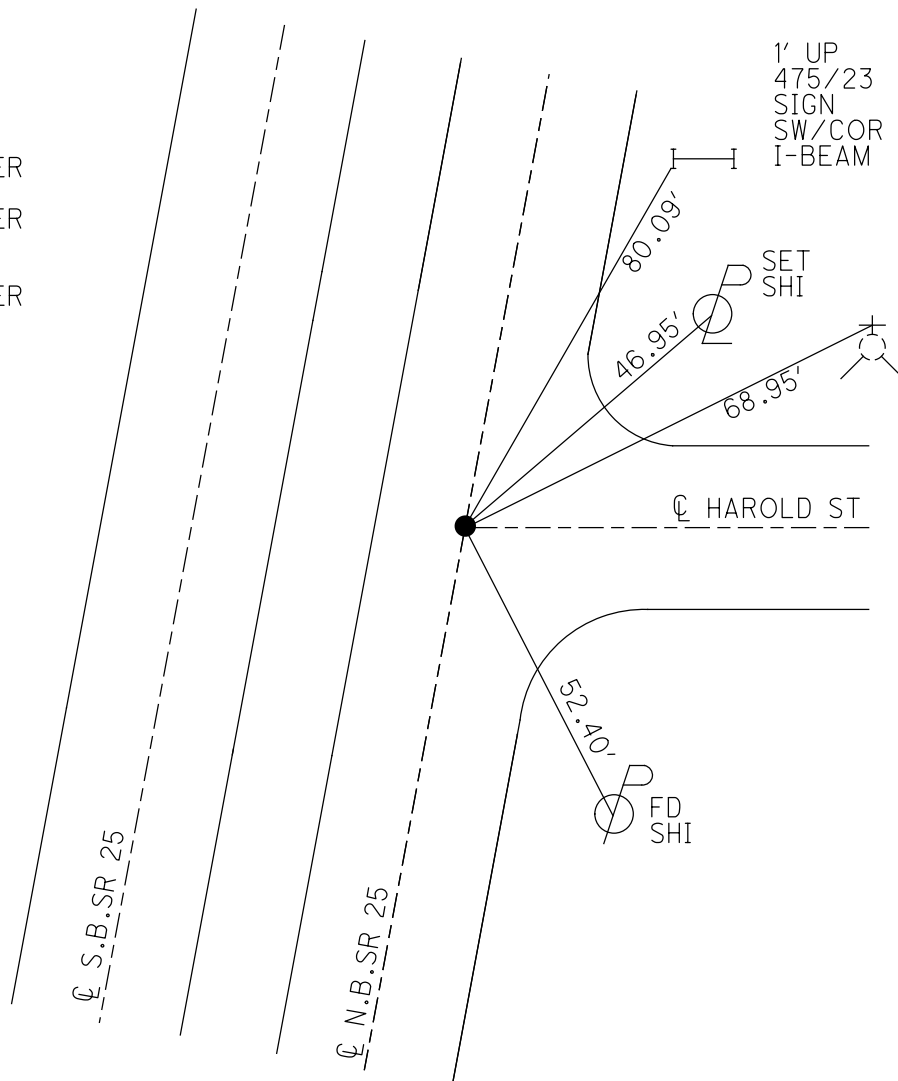

O.D.O.T. DISTRICT 2 SURVEY OFFICE (USE ONLY)

PERSONNEL

REFERENCE NO. 50 D

SHEET 8 OF 13

NOTES RHOADES DATE 3/26/18

H.C. O'DONNELL WEATHER SUNNY

R.C. SEAMAN TEMP. 35°

ROUTE SR 25

COUNTY WOOD

TOWNSHIP PERRYSBURG

SECTION 18

DWG BY RHOADES PID 102808

T 6 N R 11 E

TYPE MONUMENT MAG/WASHER

ON SURFACE - ~~BELOW~~ ON

OFFSET CL PAVEMENT ON LT : RT

- TO - EDGE PAVEMENT


STATION: 1071+85

HORIZ.DATUM: NAD83 2011


GEOID: NAVD88 2012A

GRID: NORTHING: 678995.850

EASTING: 1657042.213

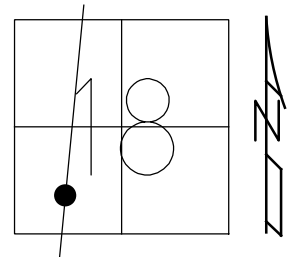

RECORD:
SET P.K.NAIL
6/6/91, DJC
FD P.K.NAIL
7/16/07, DCH
SET MAG/WASHER
11/13/07, SAH
FD MAG/WASHER
REFD50
3/26/18, JFO
SET MAG/WASHER
2/4/19, JFO

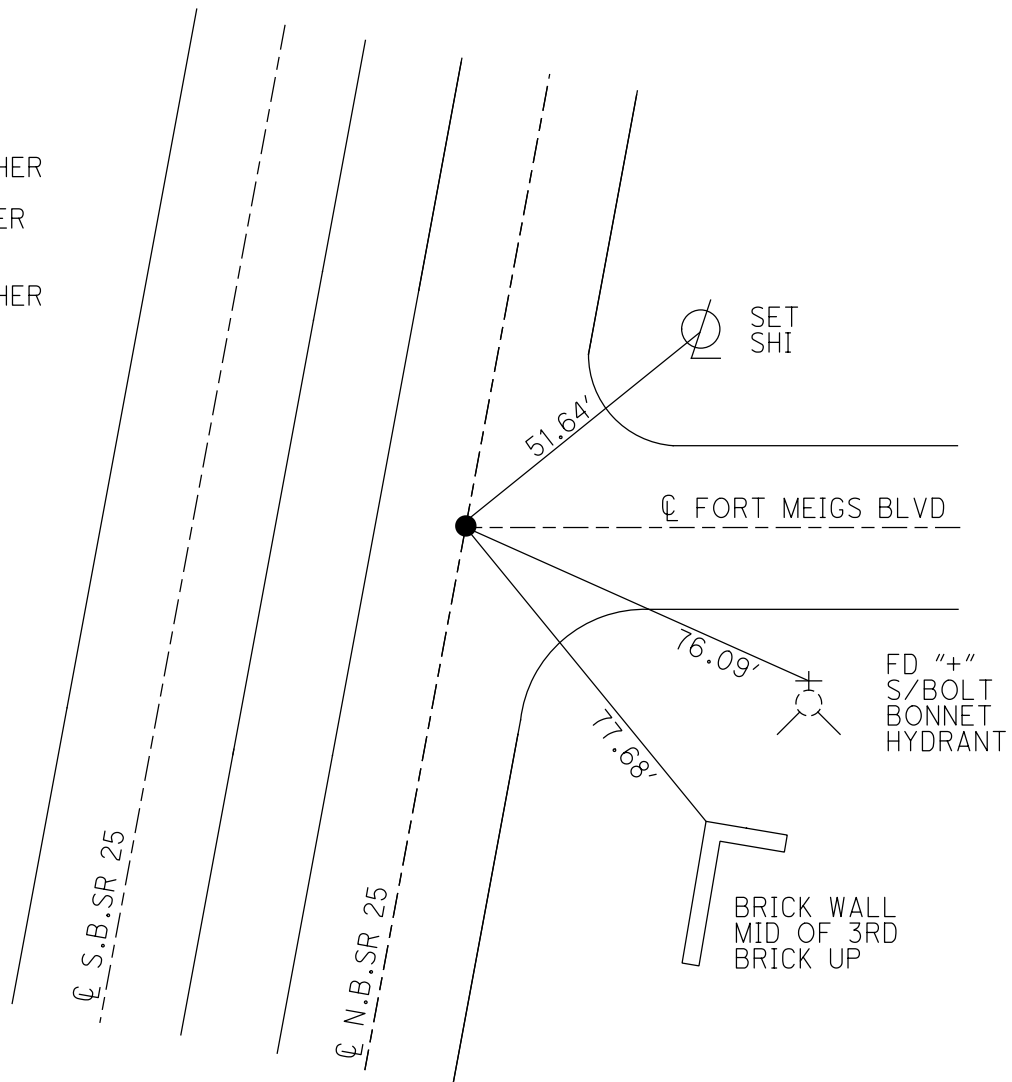

O.D.O.T. DISTRICT 2 SURVEY OFFICE (USE ONLY)

PERSONNEL

REFERENCE NO. 50 E

SHEET 9 OF 13

NOTES RHOADES

DATE 3/26/18

ROUTE SR 25

H.C. O'DONNELL

WEATHER SUNNY

COUNTY WOOD

R.C. SEAMAN

TEMP. 35°

TOWNSHIP PERRYSBURG

SECTION 18

DWG BY RHOADES

PID 102808

T 6 N R 11 E

TYPE MONUMENT MAG/WASHER

ON SURFACE - ~~BELOW~~ ON

OFFSET CL PAVEMENT ON LT : RT

- TO - EDGE PAVEMENT


STATION: 1074+49

HORIZ.DATUM: NAD83 2011


GEOID: NAVD88 2012A

GRID: NORTHING: 679255.276

EASTING: 1657082.957

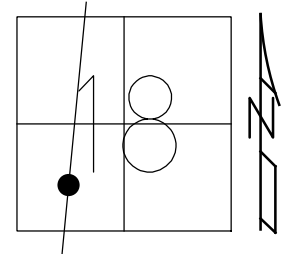

RECORD:
SET P.K.NAIL
6/6/91, DJC
FD P.K.NAIL
7/16/07, DCH
SET MAG/WASHER
11/13/07, SAH
FD MAG/WASHER
REFE50
3/26/18, JFO
SET MAG/WASHER
2/4/19, JFO

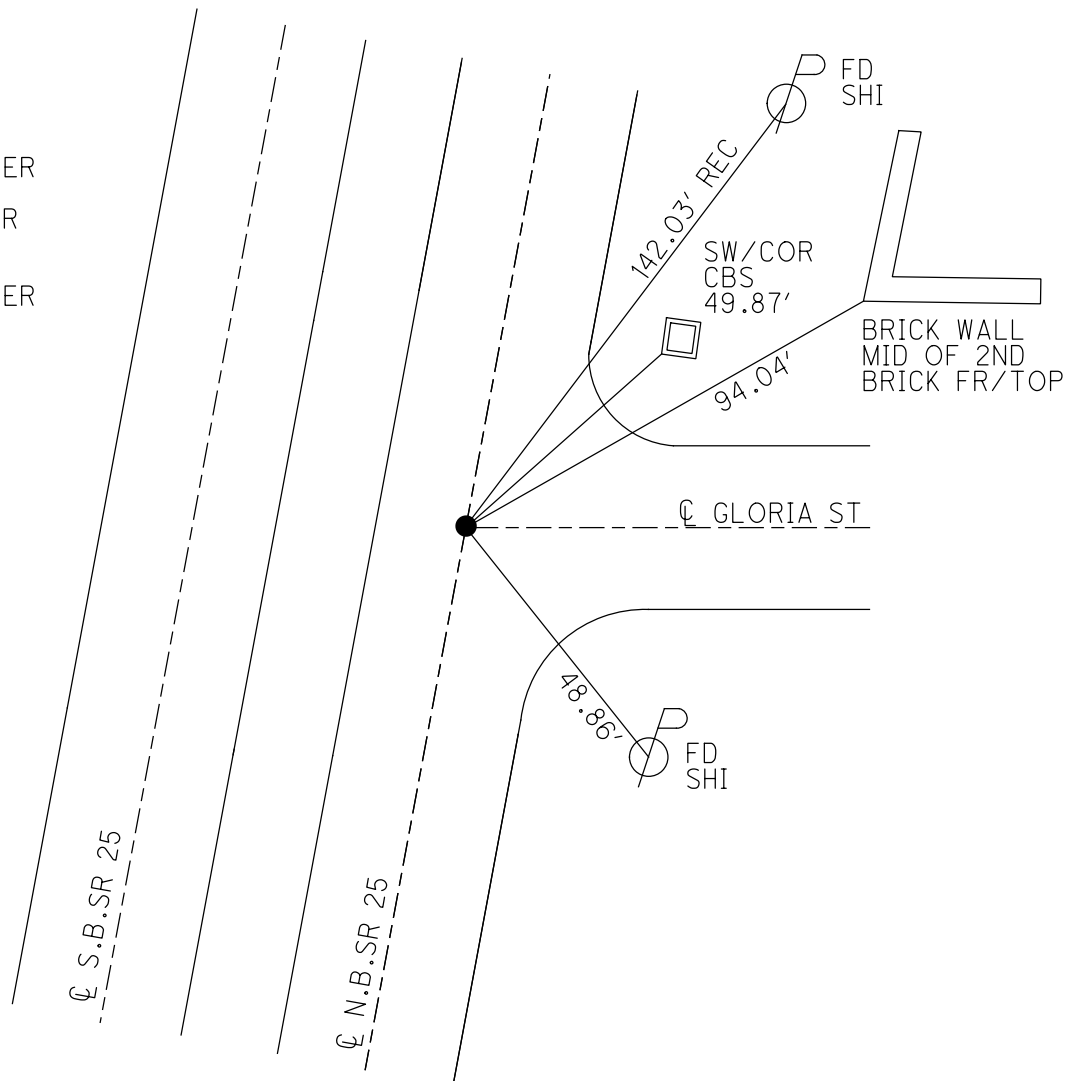

O.D.O.T. DISTRICT 2 SURVEY OFFICE (USE ONLY)

PERSONNEL

REFERENCE NO. 50 F

SHEET 10 OF 13

NOTES STONE DATE 4/11/91
H.C. CURTIS WEATHER COOL
R.C. HOUSEHOLDER TEMP. 45°

ROUTE SR 25
COUNTY WOOD
TOWNSHIP PERRYSBURG
SECTION 18
T 6 N R 11 E

DWG BY RHOADES PID 102808

TYPE MONUMENT P.K.NAIL


ON SURFACE - ~~BELOW~~ ON

OFFSET Q PAVEMENT ON LT : RT
- TO - EDGE PAVEMENT


STATION: 1076+99

HORIZ.DATUM: _____ GEOID: _____

GRID: NORTHING: _____ EASTING: _____

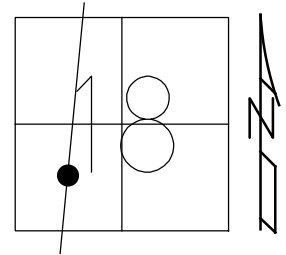

RECORD:
FD P.K.NAIL
4/11/91, IRS
SET P.K.NAIL
6/6/91, DJC
D.N.F.
NO TIES
3/26/18, JFO

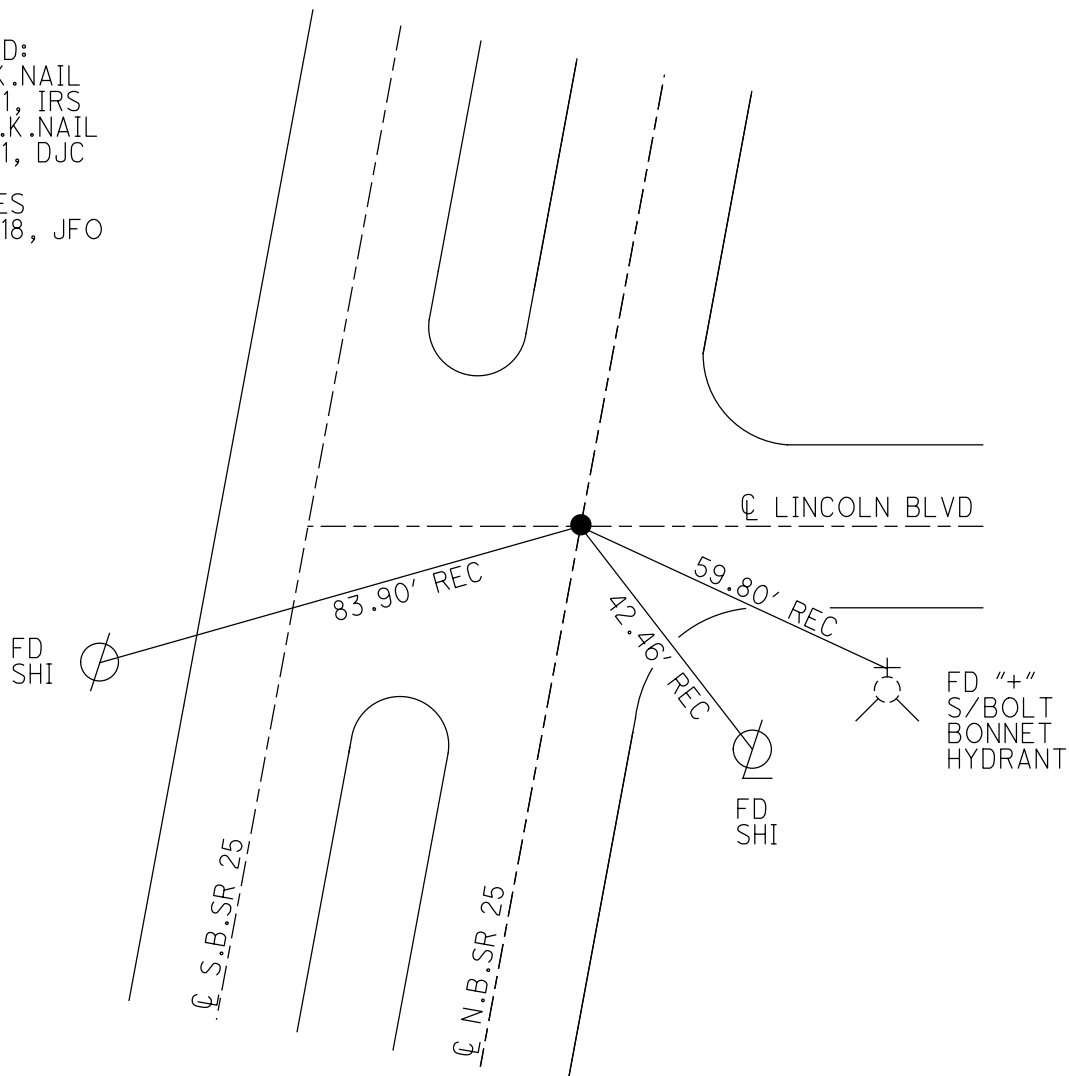

O.D.O.T. DISTRICT 2 SURVEY OFFICE (USE ONLY)

PERSONNEL

REFERENCE NO. 50 G

SHEET 11 OF 13

NOTES RHOADES DATE 3/26/18
H.C. O'DONNELL WEATHER SUNNY
R.C. SEAMAN TEMP. 35°

ROUTE SR 25
COUNTY WOOD
TOWNSHIP PERRYSBURG
SECTION 18
T 6 N R 11 E

DWG BY RHOADES PID 102808

TYPE MONUMENT MAG/WASHER

ON SURFACE - ~~BELOW~~ ON

OFFSET CL PAVEMENT ON LT : RT

- TO - EDGE PAVEMENT


STATION: 1079+44

HORZ.DATUM: NAD83 2011


GEOID: NAVD88 2012A

GRID: NORTHING: 679743.918

EASTING: 1657159.165

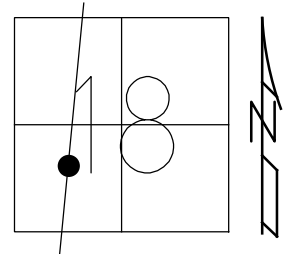

RECORD:
FD P.K.NAIL
4/11/91, IRS
SET P.K.NAIL
6/6/91, DJC
SET MAG/WASHER
REFG50
3/26/18, JFO
SET MAG/WASHER
2/4/19, JFO

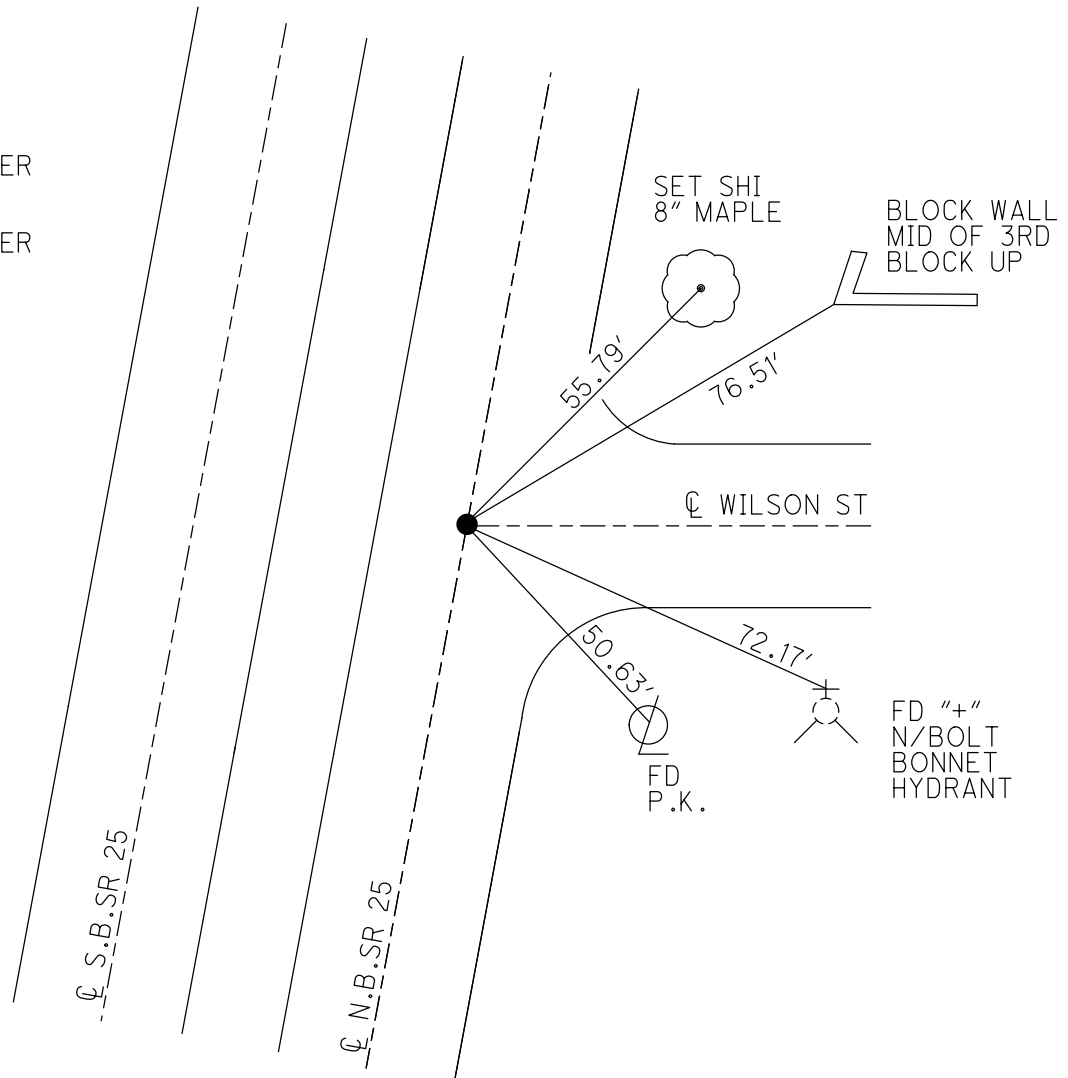

O.D.O.T. DISTRICT 2 SURVEY OFFICE (USE ONLY)

PERSONNEL

REFERENCE NO. 51

SHEET 12 OF 13

NOTES STONE
H.C. CURTIS
R.C. HOUSEHOLDER

DATE 4/11/91
WEATHER COOL
TEMP. 49°

ROUTE SR 25
COUNTY WOOD
TOWNSHIP PERRYSBURG
SECTION 18
T 6 N R 11 E

DWG BY RHOADES PID 102808

TYPE MONUMENT P.K.NAIL

ON SURFACE - BELOW ON


OFFSET $\varnothing$ PAVEMENT ON LT : RT

- TO - EDGE PAVEMENT


STATION: 1081+96

HORIZ.DATUM: _____ GEOID: _____

GRID: NORTHING: _____ EASTING: _____

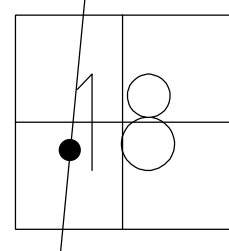

RECORD:
FD P.K.NAIL
4/11/91, IRS
SET P.K.NAIL
6/6/91, DJC
D.N.F.
3/26/18, JFO

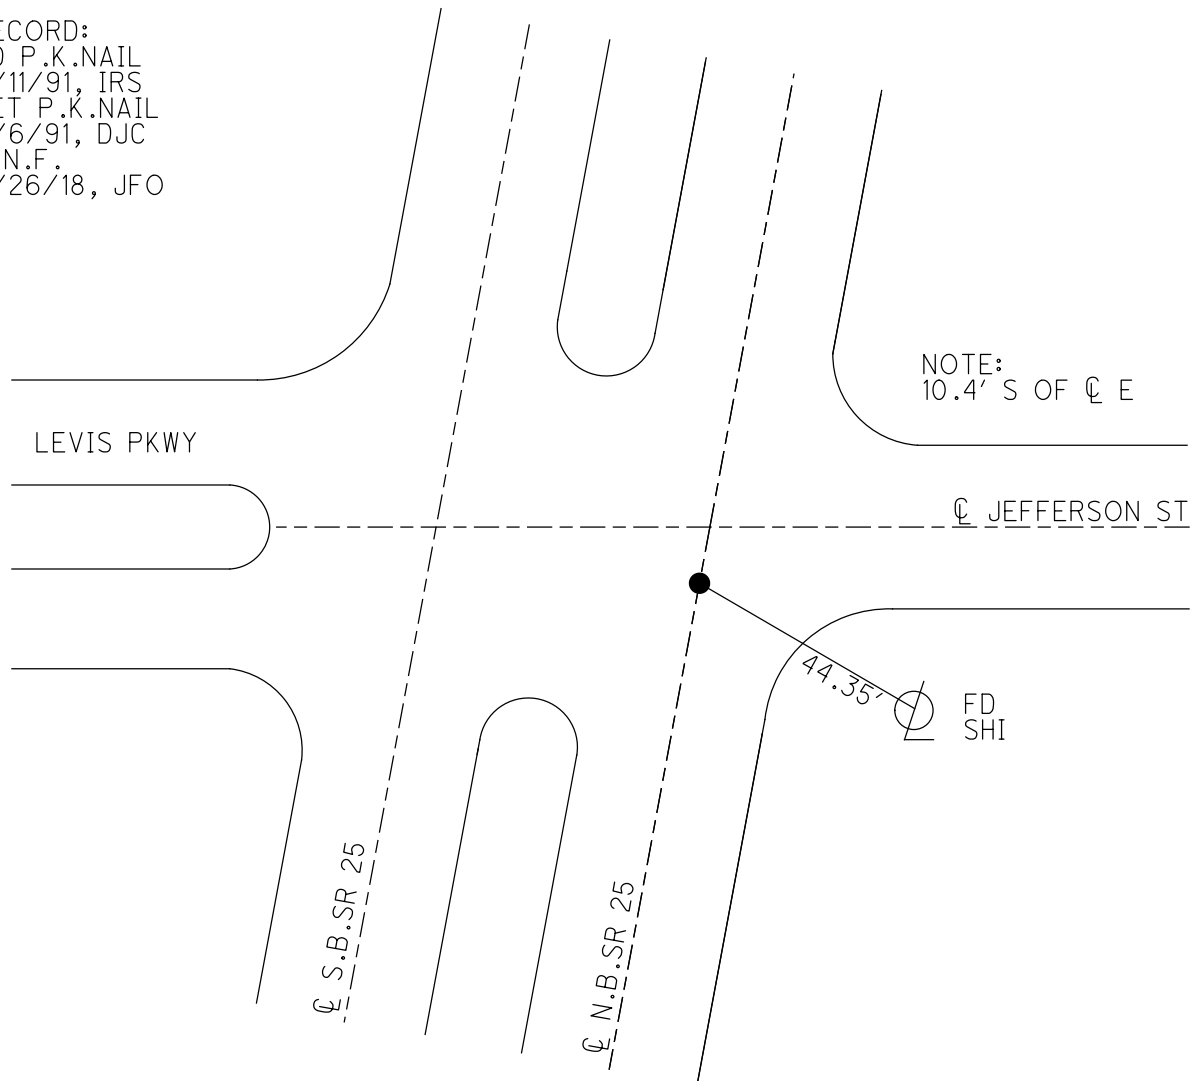

O.D.O.T. DISTRICT 2 SURVEY OFFICE (USE ONLY)

PERSONNEL

REFERENCE NO. 51 A

SHEET 13 OF 13

NOTES STONE

DATE 4/11/91

ROUTE SR 25

H.C. CURTIS

WEATHER COOL

COUNTY WOOD

R.C. HOUSEHOLDER

TEMP. 48°

TOWNSHIP PERRYSBURG

SECTION 18

DWG BY RHOADES

PID 102808

T 6 N R 11 E

TYPE MONUMENT P.K.NAIL

ON SURFACE - BELOW ON

OFFSET $\varnothing$ PAVEMENT ON LT : RT

- TO - EDGE PAVEMENT


STATION: 1087+88

HORIZ.DATUM: _____


GEOID: _____

GRID: NORTHING: _____

EASTING: _____

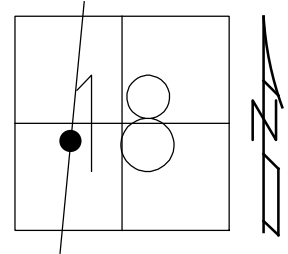

RECORD:
FD P.K.NAIL
4/11/91, IRS
SET P.K.NAIL
6/6/91, DJC
D.N.F.
3/26/18, JFO

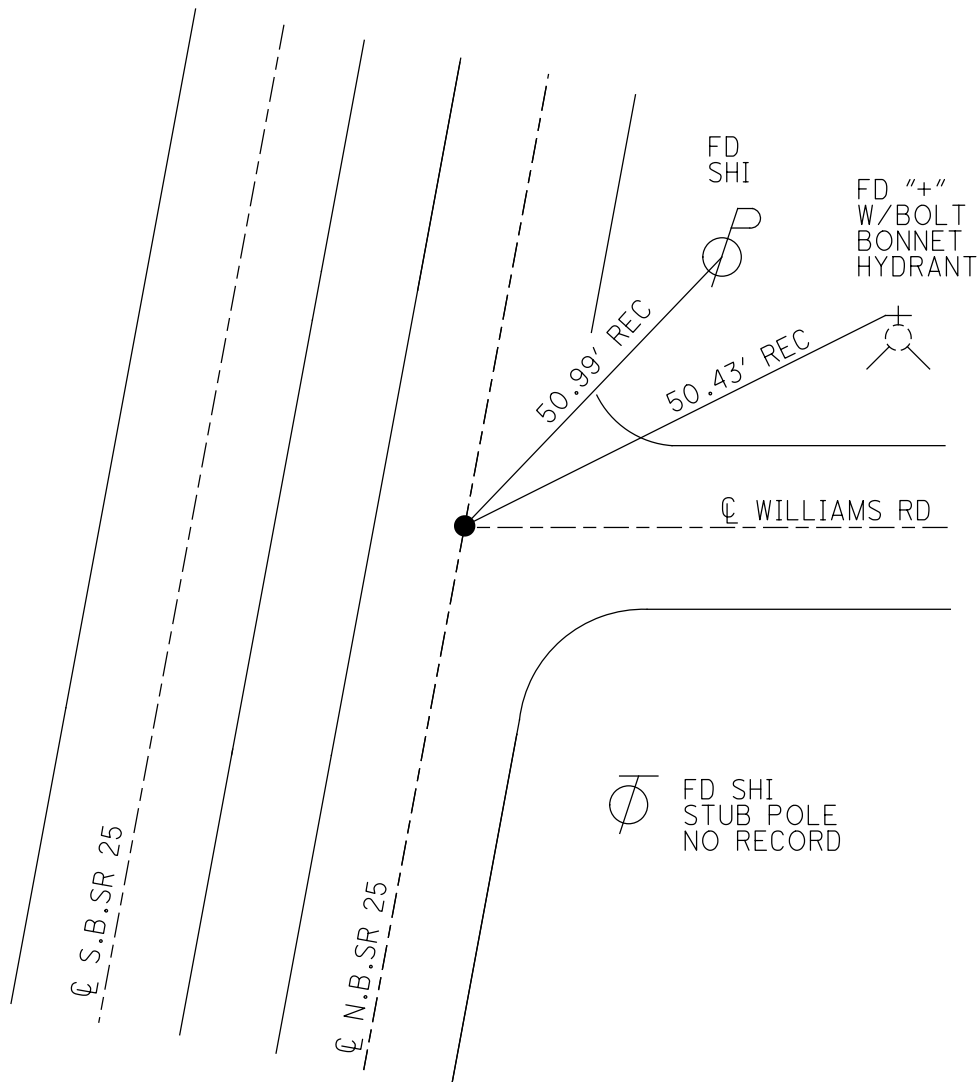

O.D.O.T. DISTRICT 2 SURVEY OFFICE (USE ONLY)

PERSONNEL

REFERENCE NO. 51 B

SHEET 1 OF 13

NOTES STONE
H.C. CURTIS
R.C. HOUSEHOLDER

DATE 4/11/91
WEATHER COOL
TEMP. 49°

ROUTE SR 25
COUNTY WOOD
TOWNSHIP 12 MILE RESERVE
SECTION 18
T 4 US R E

DWG BY NIESE PID

TYPE MONUMENT P.K. NAIL

ON SURFACE - ~~BELOW~~ ON


OFFSET $\varnothing$ PAVEMENT LT : RT

 TO EDGE PAVEMENT


STATION: 1100+66

HORZ. DATUM: GEOID:

GRID: NORTHING: EASTING:

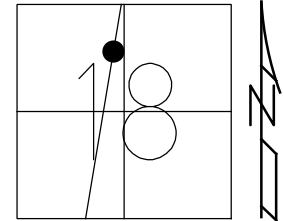

RECORD:
BRIDGE NO.
WO.25-2084
FD P.K. NAIL
4/11/91, DFC
SET P.K. NAIL
6/6/91, DFC

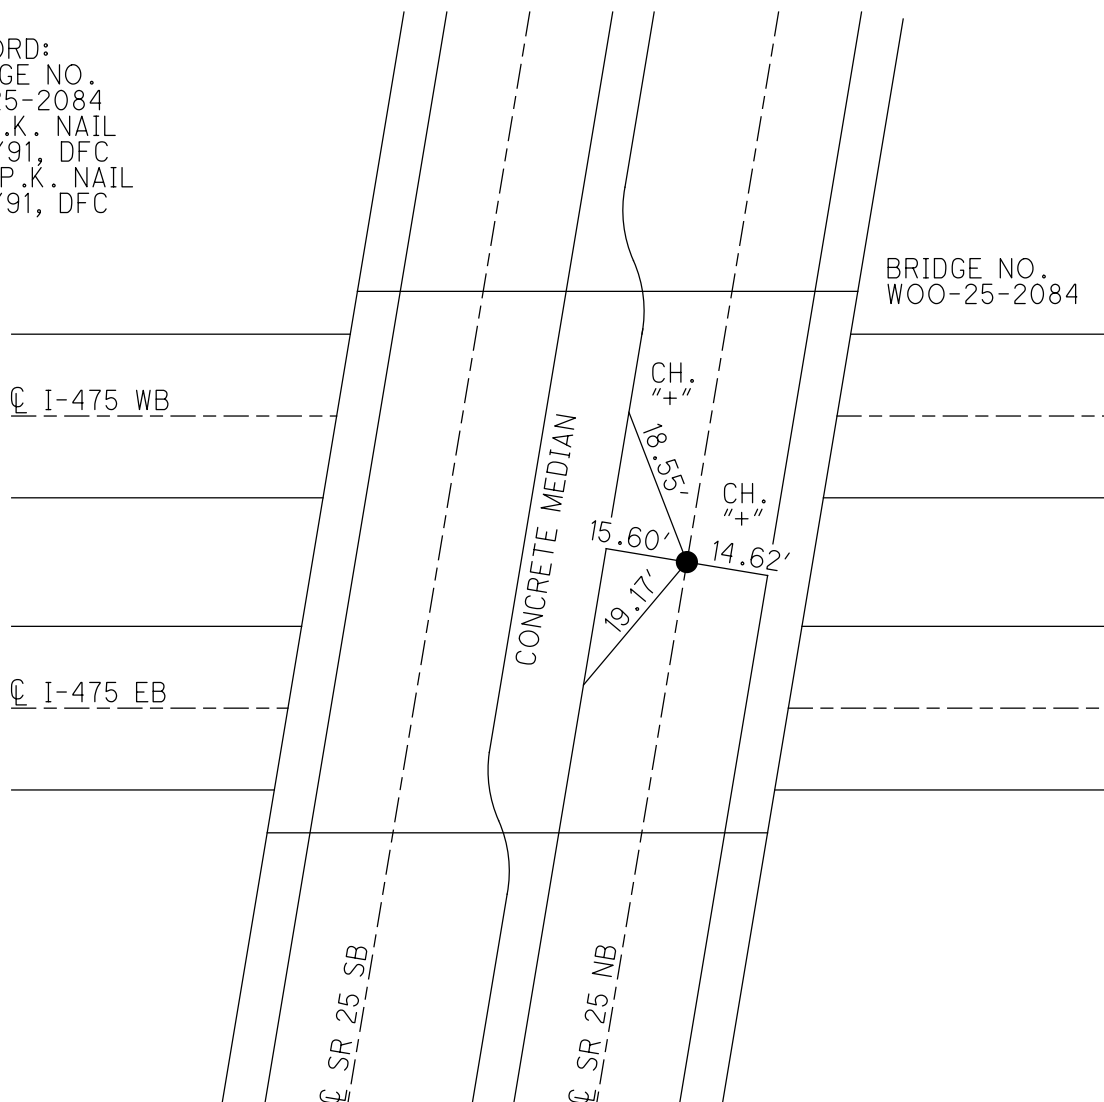

O.D.O.T. DISTRICT 2 SURVEY OFFICE (USE ONLY)

PERSONNEL

REFERENCE NO. 51 C

SHEET 2 OF 13

NOTES STONE

DATE 4/11/91

ROUTE SR 25

H.C. CURTIS

WEATHER COOL

COUNTY WOOD

R.C. HOUSEHOLDER

TEMP. 49°

TOWNSHIP 12 MILE RESERVE

SECTION 18

DWG BY NIESE PID

T 4 US R E

TYPE MONUMENT P.K. NAIL

ON SURFACE - ~~BELOW~~ ON


OFFSET CL PAVEMENT LT : RT

- TO - EDGE PAVEMENT


STATION: 1115+97

HORZ.DATUM: GEOID:

GRID: NORTHING: EASTING:

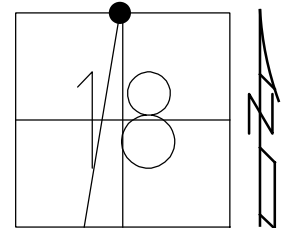

RECORD:
FD P.K. NAIL
4/11/91, DFC
SET P.K. NAIL
6/6/91, DFC

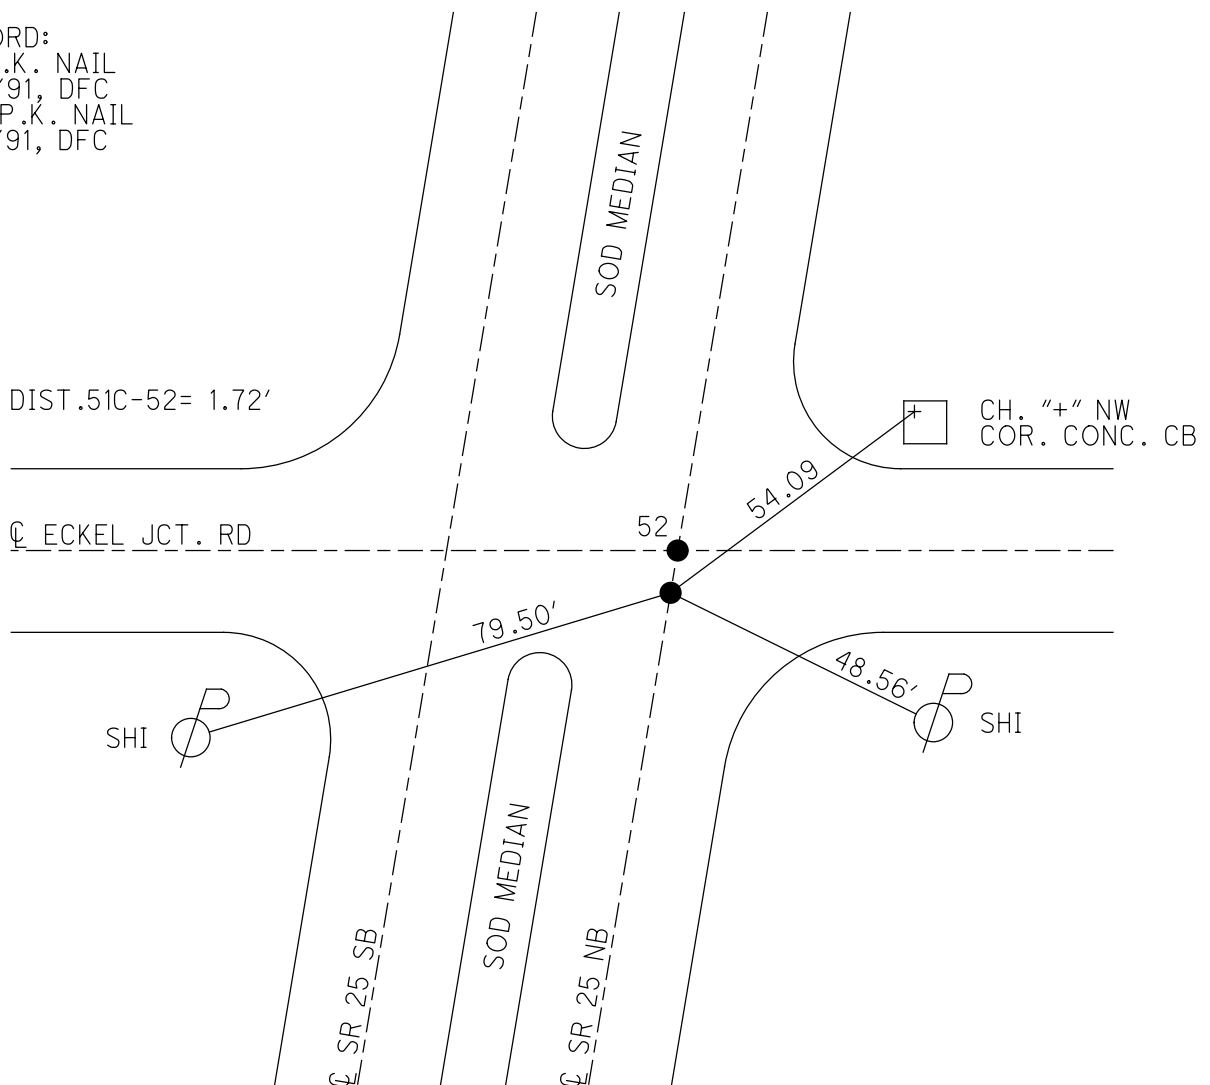

O.D.O.T. DISTRICT 2 SURVEY OFFICE (USE ONLY)

PERSONNEL

REFERENCE NO. 52

SHEET 3 OF 13

NOTES STONE

DATE 4/11/91

ROUTE SR 25

H.C. CURTIS

WEATHER COOL

COUNTY WOOD

R.C. HOUSEHOLDER

TEMP. 49°

TOWNSHIP 12 MILE RESERVE

SECTION 18

DWG BY NIESE

PID

T 4 US R E

TYPE MONUMENT P.K. NAIL

ON SURFACE - ~~BELOW~~ ON

OFFSET Q PAVEMENT LT : RT

- TO - EDGE PAVEMENT


STATION: 1115+99

HORZ.DATUM:


GEOID:

GRID: NORTHING:

EASTING:

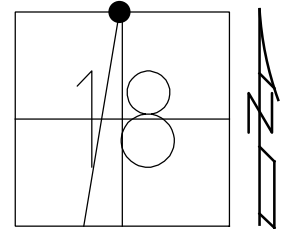

RECORD:
FD P.K. NAIL
4/11/91, DFC
SET P.K. NAIL
6/6/91, DFC

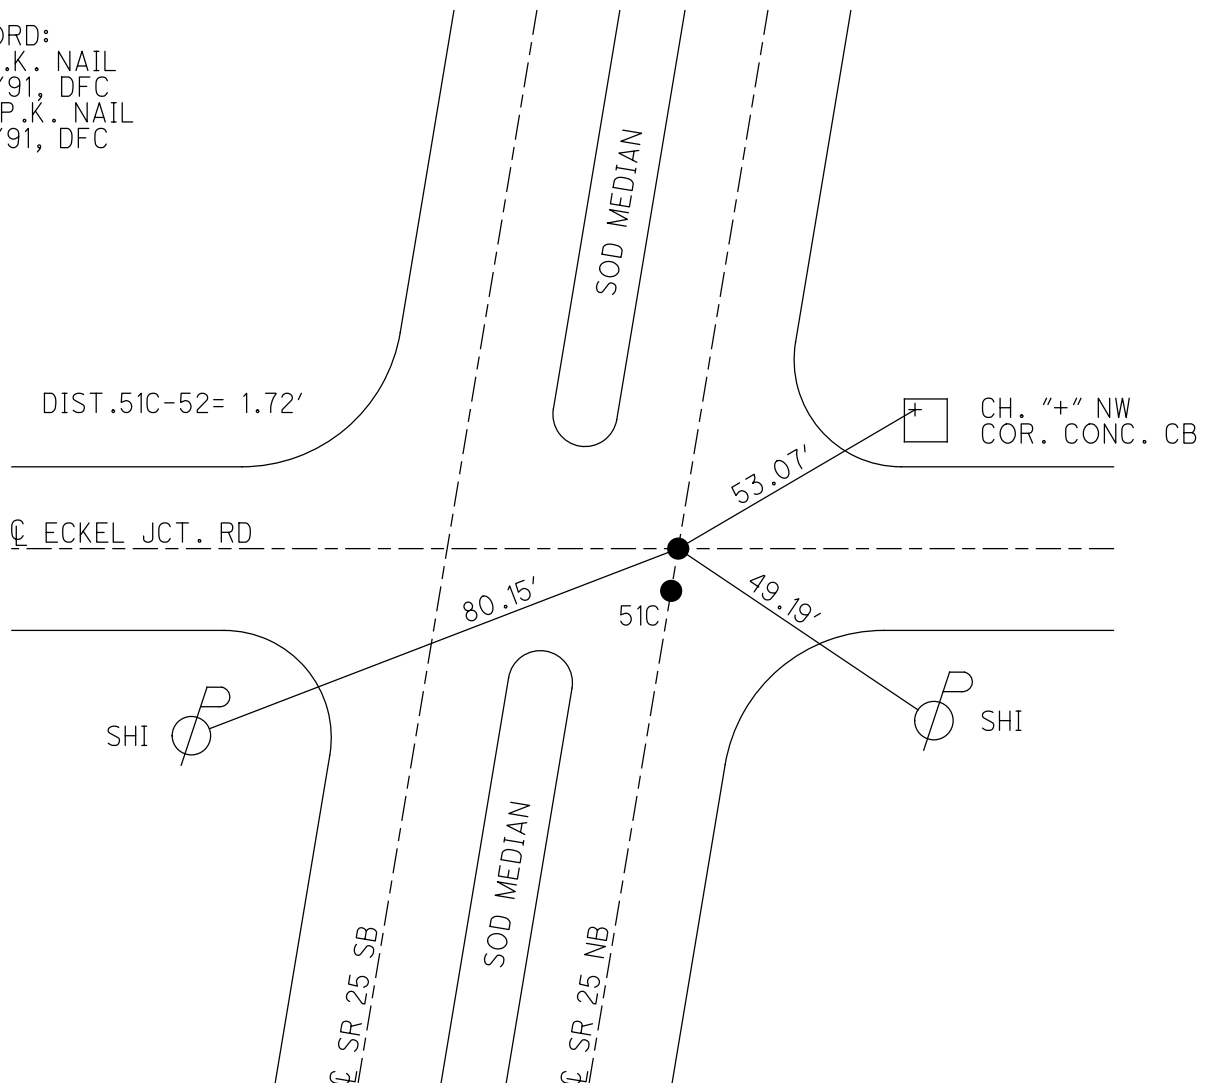

O.D.O.T. DISTRICT 2 SURVEY OFFICE (USE ONLY)

PERSONNEL

REFERENCE NO. 52 A

SHEET 4 OF 13

NOTES STONE

DATE 4/22/91

ROUTE SR 25

H.C. CURTIS

WEATHER CLOUDY

COUNTY WOOD

R.C. HOUSEHOLDER

TEMP. 44°

TOWNSHIP 12 MILE RESERVE

SECTION 7

DWG BY NIESE PID

T 4 US R E

TYPE MONUMENT P.K. NAIL

ON SURFACE - ~~BELOW~~ ON


OFFSET Q PAVEMENT LT : RT

- TO - EDGE PAVEMENT


STATION: 1129+25

HORZ.DATUM: GEOID:

GRID: NORTHING: EASTING:

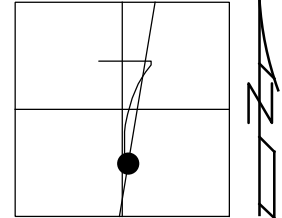

RECORD:
FD P.K. NAIL
4/11/91, DFC
SET P.K. NAIL
6/6/91, DFC

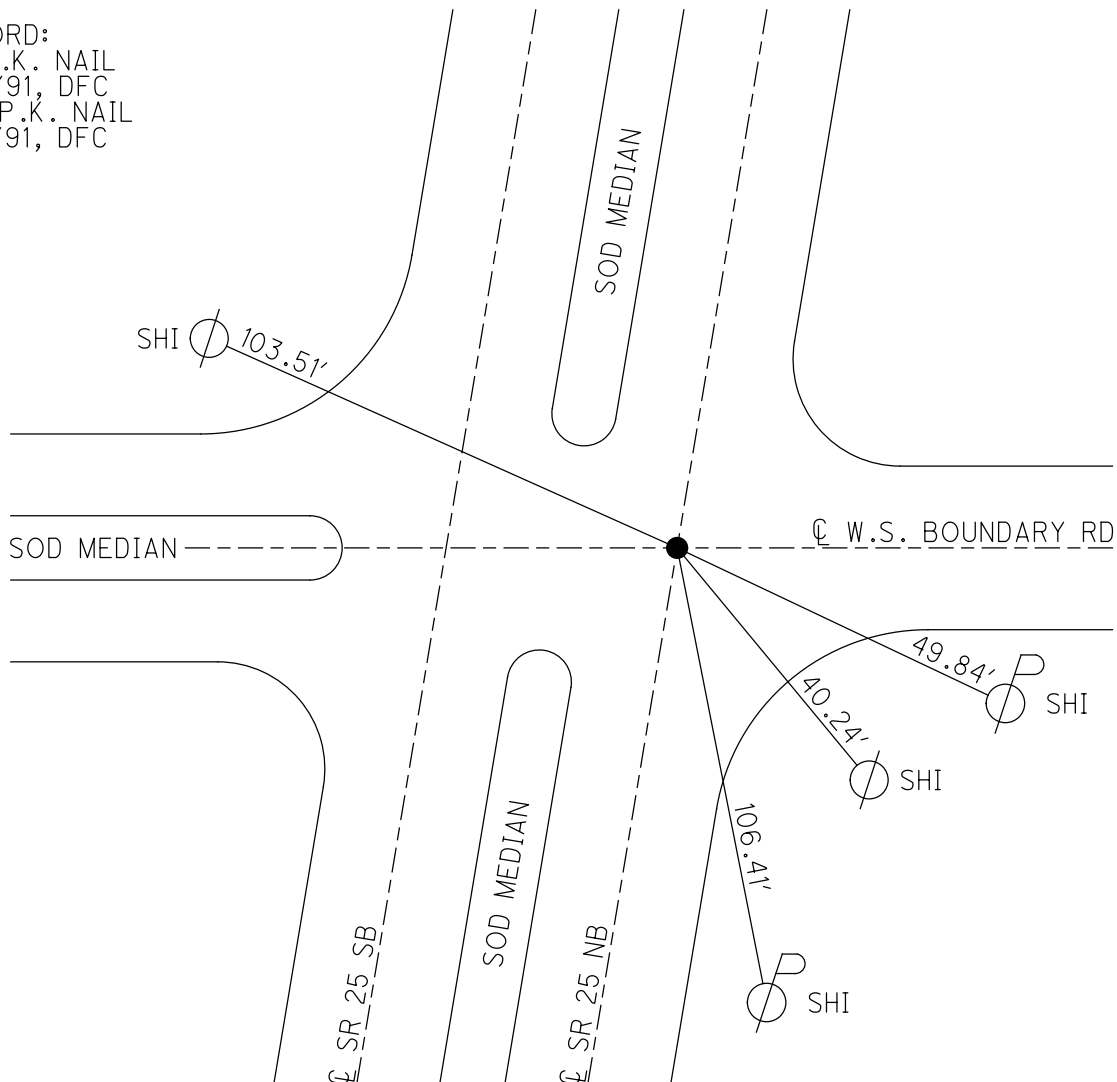

O.D.O.T. DISTRICT 2 SURVEY OFFICE (USE ONLY)

PERSONNEL

REFERENCE NO. 53

SHEET 1 OF 6


NOTES RHOADES
H.C. ROUSOS
R.C. HOMAN
GABLE

DATE 4/9/14
WEATHER CLEAR
TEMP. 41°


ROUTE SR 25
COUNTY WOOD
TOWNSHIP PERRYSBURG
SECTION 7
T 4 N R 11 E

TYPE MONUMENT P.K.NAIL
ON SURFACE - ~~BELOW~~ ON
LEFT - Q PAV'T - RIGHT -
- TO - EDGE PAVEMENT
S.L.M. 1133+29.35

Grid: Northing: 685229.101 Easting: 1658000.461

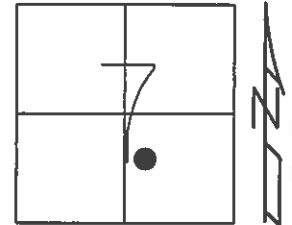

RECORD:
FD P.K.NAIL
4/22/91, I.S.
SET P.K.NAIL
6/6/91, DJC
GPS, REF53
4/9/14, DCH

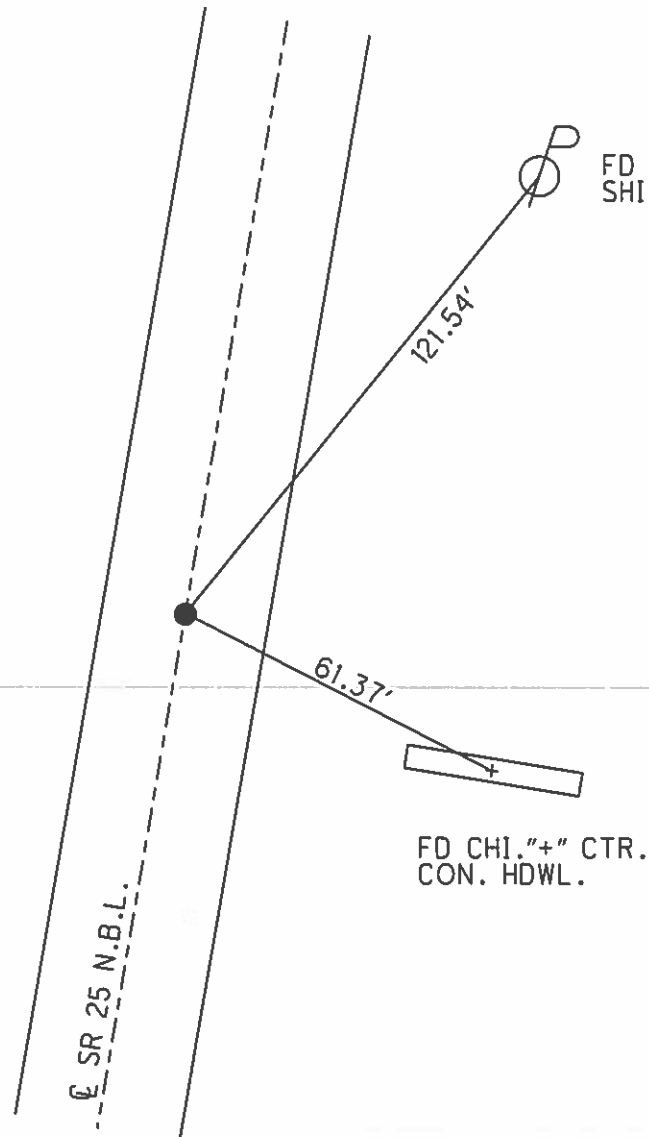

O.D.O.T. DISTRICT 2 SURVEY OFFICE (USE ONLY)

PERSONNEL

REFERENCE NO. 54

SHEET 2 OF 6

NOTES RHOADES

DATE 4/9/14

ROUTE SR 25

H.C. ROUSOS

WEATHER CLEAR

COUNTY WOOD

R.C. HOMAN

TEMP. 41°

TOWNSHIP PERRYSBURG

GABLE

SECTION 7

T 4 N R 11 E

TYPE MONUMENT BRASS MON.


~~ON SURFACE~~ - BELOW 3"

LEFT - Q PAV'T - RIGHT -

3.4' TO LT EDGE PAVEMENT-FINDLAY ST.

S.L.M. 1141+59.49

Grid: Northing: 686050.891 Easting: 1658118.039

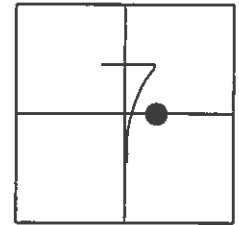

RECORD: P.I.
 $\Delta = 34^{\circ} 20'$ LT
 STA. 581+34.42
 FD BRASS MON.
 AT SURFACE
 3.4' E. OF W.E.P.
 FINDLAY ST.
 GPS, REF54
 4/9/14, DCH

FINDLAY ST S.B.

Q SR 25 N.B.L.

Q FINDLAY ST NB

SET
SHI

66.40'

55.71' REC

FD SHI 30"
HOCKBERRY

74.02'

73.61'

SET
SHI'S

WESTBROOK DR

O.D.O.T. DISTRICT 2 SURVEY OFFICE (USE ONLY)

PERSONNEL

REFERENCE NO.

54 A

SHEET

3

OF 6

NOTES RHOADES

H.C. ROUSOS

R.C. HOMAN

GABLE

DATE

4/9/14

WEATHER

CLEAR

TEMP.

41°

ROUTE

SR 25

COUNTY

WOOD

TOWNSHIP

PERRYSBURG

SECTION

7

T 4 N

R 11 E

TYPE MONUMENT SM.R.R.SPIKE

ON SURFACE - ~~BELOW~~ ON


LEFT - C PAV'T - RIGHT -

- TO - EDGE PAVEMENT


S.L.M. 1154+12.36

Grid: Northing: 687178.215

Easting: 1657571.422

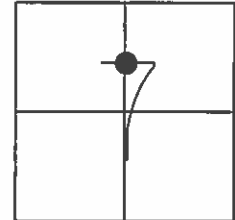

RECORD:
FD SM.R.R.SPIKE
4/22/91, I.S.
SET SM.R.R.SPIKE
6/6/91, DJC
SET MAG/WASHER
GPS, REFA54
6/19/15, DCH

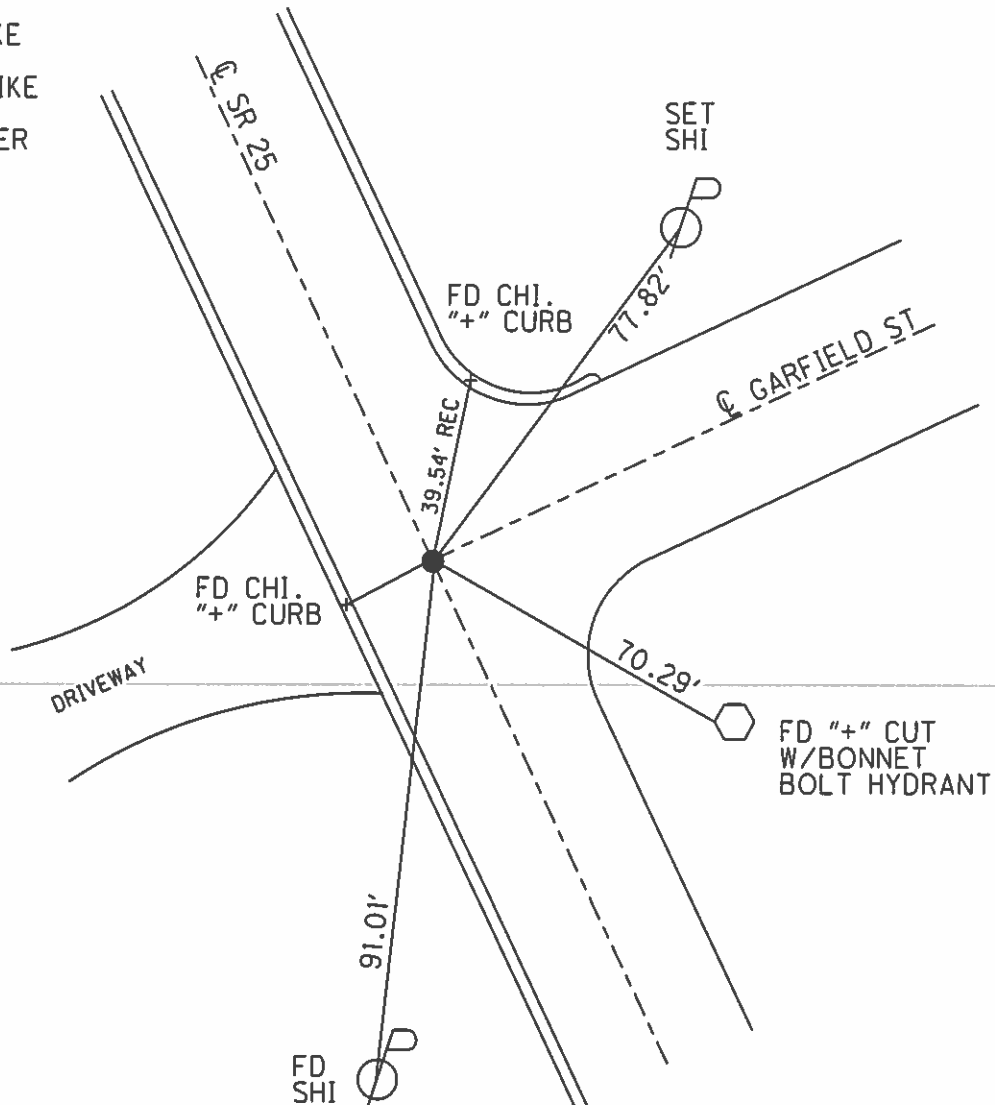


O.D.O.T. DISTRICT 2 SURVEY OFFICE (USE ONLY)


PERSONNEL	REFERENCE NO. <u>54 B</u>	SHEET <u>4</u> OF <u>6</u>	
NOTES <u>RHOADES</u>	DATE <u>4/9/14</u>	ROUTE <u>SR 25</u>	
H.C. <u>ROUSOS</u>	WEATHER <u>CLEAR</u>	COUNTY <u>WOOD</u>	
R.C. <u>HOMAN</u>	TEMP. <u>41°</u>	TOWNSHIP <u>PERRYSBURG</u>	
<u>GABLE</u>		SECTION <u>7</u>	
		T <u>4</u> N R <u>11</u> E	

TYPE MONUMENT SM.R.R.SPIKE
 ON SURFACE - ~~BELOW~~ ON
 LEFT - Q PAV'T - RIGHT -
- TO - EDGE PAVEMENT
 S.L.M. 1158+43.20

Grid: Northing: 687565.917 Easting: 1657383.378

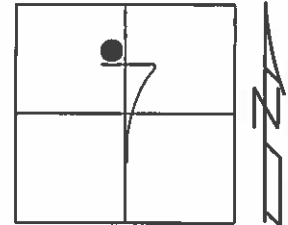

RECORD:
 FD SM.R.R.SPIKE
 4/22/91, I.S.
 SET SM.R.R.SPIKE
 6/6/91, DJC
 SET MAG/WASHER
 GPS, REFB54
 6/19/15, DCH

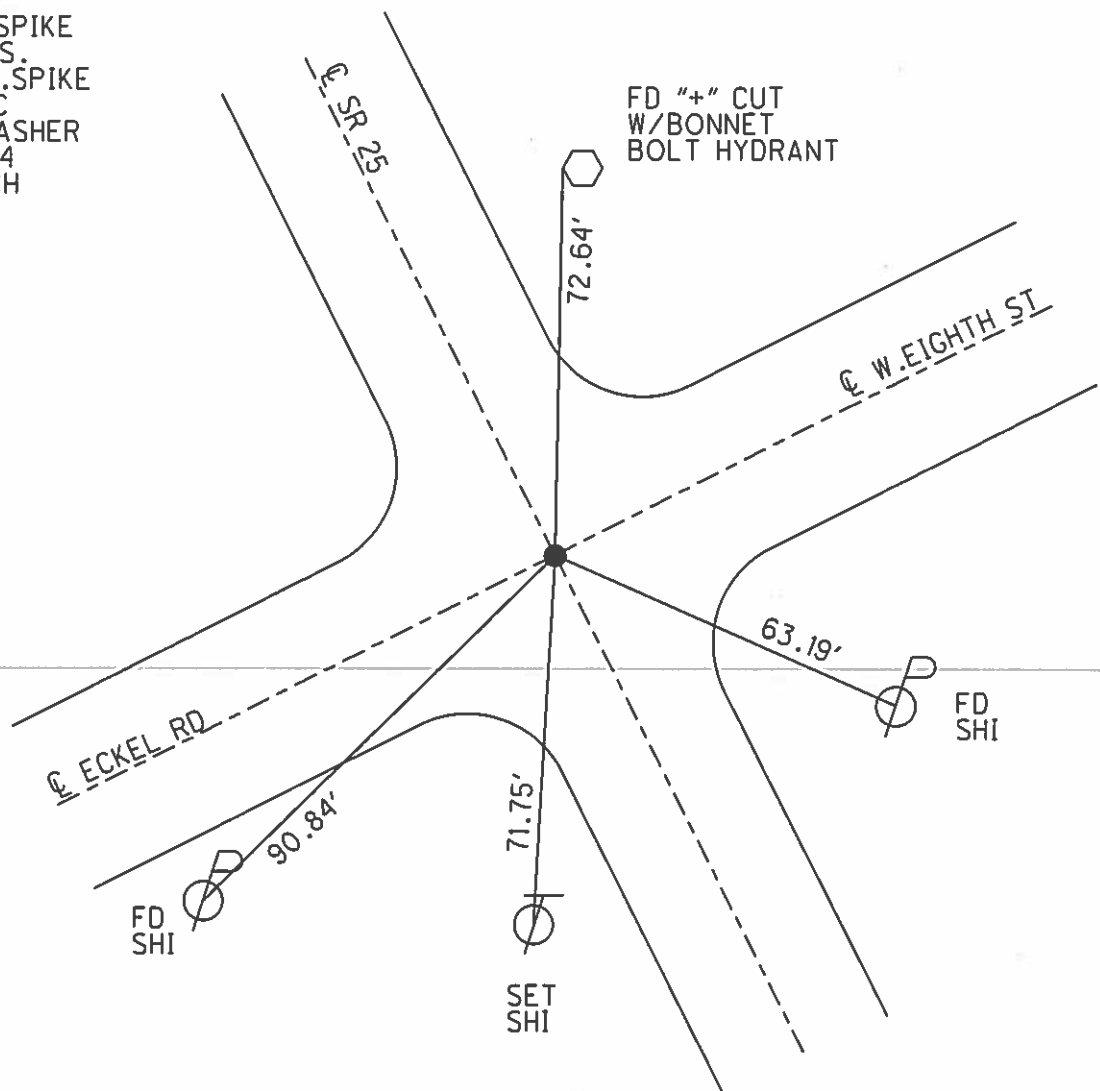

O.D.O.T. DISTRICT 2 SURVEY OFFICE (USE ONLY)

PERSONNEL

REFERENCE NO. 54 C

SHEET 9 OF 13

NOTES STONE

DATE 4/22/91

ROUTE SR 25

H.C. CURTIS

WEATHER COOL

COUNTY WOOD

R.C. HOUSEHOLDER

TEMP. 47°

TOWNSHIP PERRYSBURG

SECTION 12 MILE RESERVE

DWG BY NIESE PID

T 4 US R E

TYPE MONUMENT SM.R.R. SPIKE

ON SURFACE - ~~BELOW~~ ON

OFFSET Q PAVEMENT ON LT : RT

- TO - EDGE PAVEMENT


STATION: 1165+62

HORIZ.DATUM:


GEOID:

GRID: NORTHING:

EASTING:

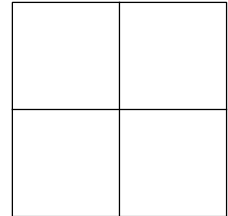

RECORD:
FD SM.R.R. SPIKE
4/22/91, DFC
SET SM.R.R. SPIKE
6/6/91, DFC

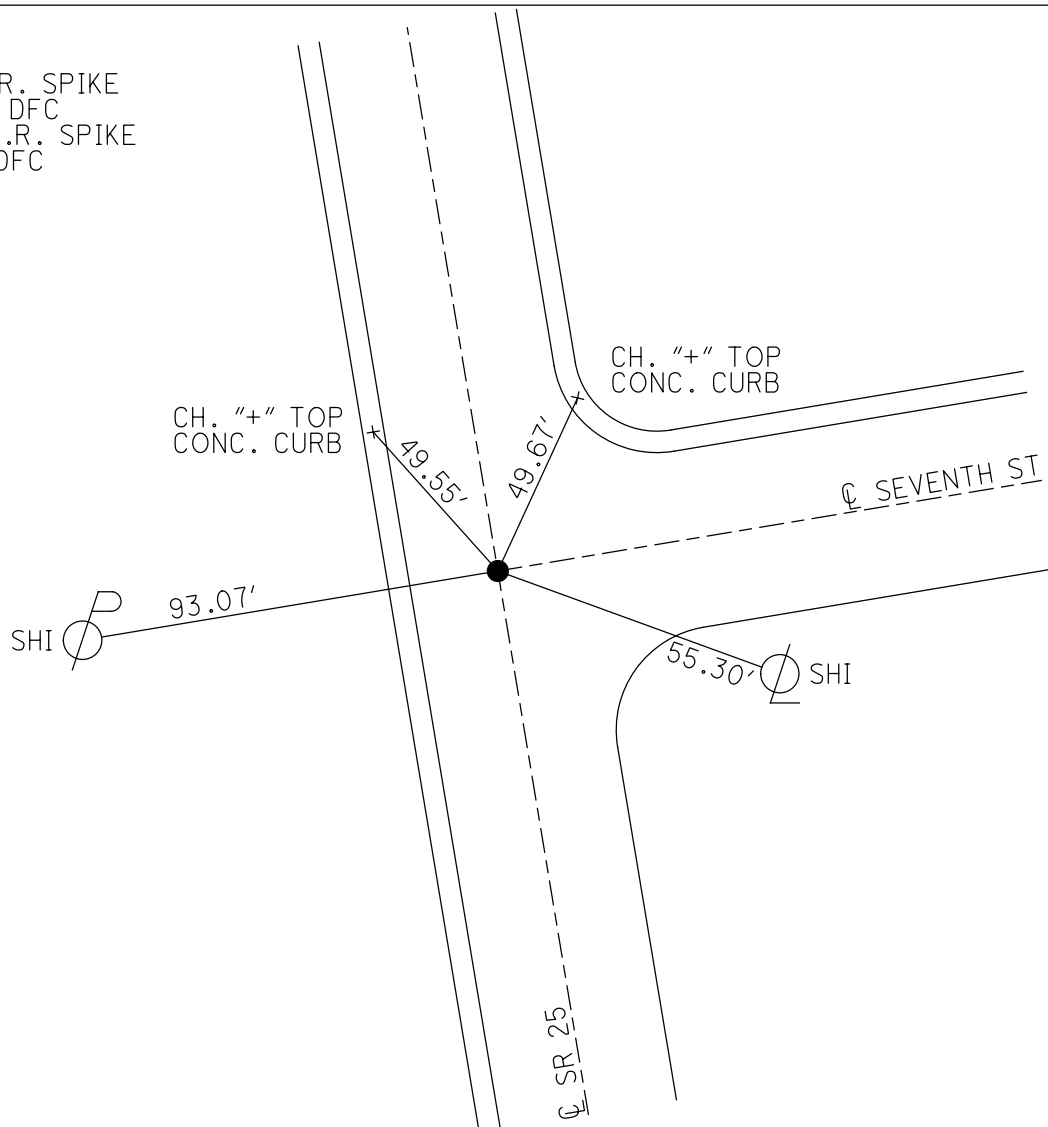

O.D.O.T. DISTRICT 2 SURVEY OFFICE (USE ONLY)

PERSONNEL

REFERENCE NO. 54 D

SHEET 10 OF 13

NOTES STONE

DATE 4/22/91

ROUTE SR 25

H.C. CURTIS

WEATHER COOL

COUNTY WOOD

R.C. HOUSEHOLDER

TEMP. 48°

TOWNSHIP PERRYSBURG

SECTION 12 MILE RESERVE

DWG BY NIESE PID

T 4 US R E

TYPE MONUMENT SMALL R.R. SPIKE

ON SURFACE - ~~BELOW~~ ON


OFFSET CL PAVEMENT ON LT : RT

- TO - EDGE PAVEMENT


STATION: 1170+07

HORIZ.DATUM: GEOID:

GRID: NORTHING: EASTING:

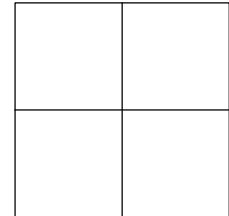

RECORD:
FD SM.R.R. SPIKE
4/22/91, DFC
SET SM.R.R. SPIKE
6/6/91, DFC

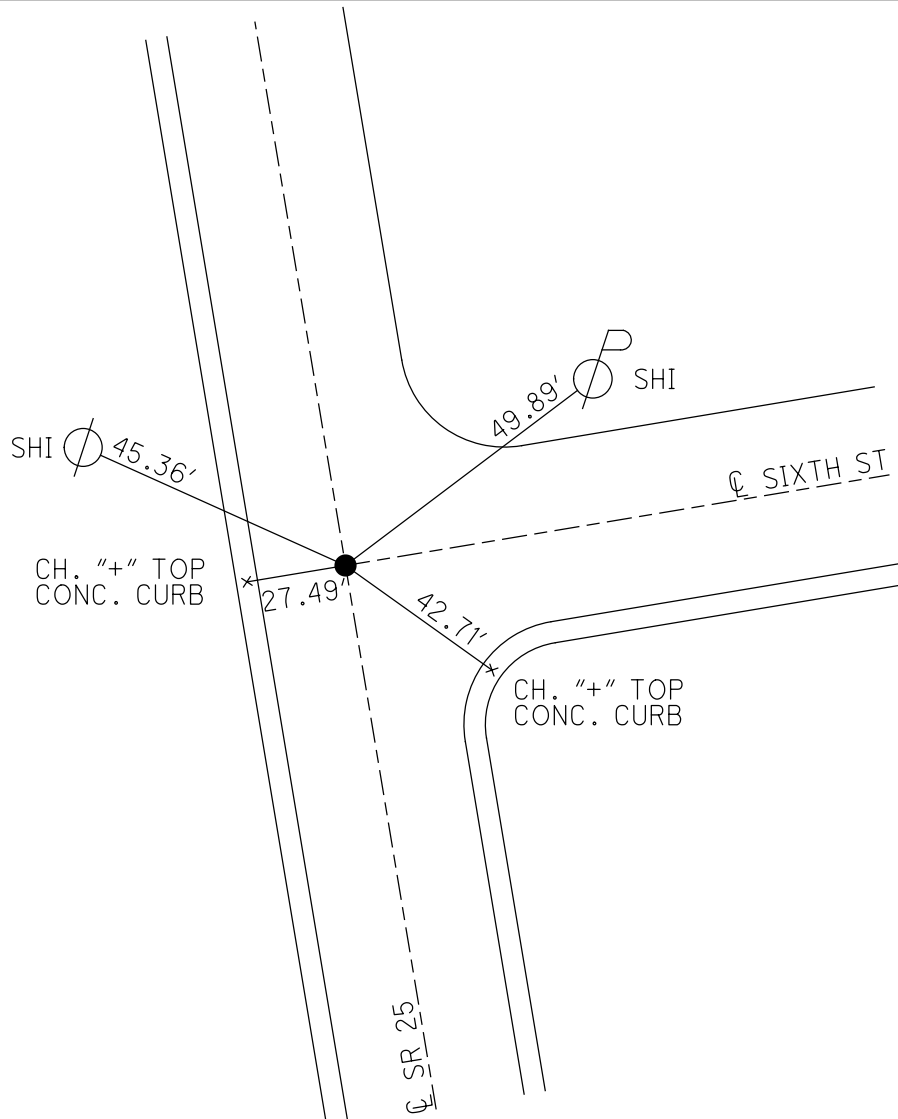

O.D.O.T. DISTRICT 2 SURVEY OFFICE (USE ONLY)

PERSONNEL

REFERENCE NO.

54 E

SHEET 5 OF 6

NOTES RHOADES

DATE 4/9/14

ROUTE SR 25

H.C. ROUSOS

WEATHER CLEAR

COUNTY WOOD

R.C. HOMAN

TEMP. 41°

TOWNSHIP PERRYSBURG

GABLE

SECTION 6

T 4 N R 11 E

TYPE MONUMENT SM.R.R.SPIKE


ON SURFACE - ~~BELOW~~ ON

LEFT - C PAV'T - RIGHT -

- TO - EDGE PAVEMENT

S.L.M. 1176+43.73

Grid: Northing: 689187.351 Easting: 1656600.601

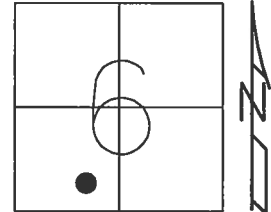

RECORD:

FD SM.R.R.SPIKE

4/22/91, I.S.

SET SM.R.R.SPIKE

6/6/91, DJC

FD SM.R.R.SPIKE

REFE54


9/24/12, SAH

SET MAG/WASHER

GPS, REFE54

6/19/15, DCH

NOTE: REF 27 SR 65

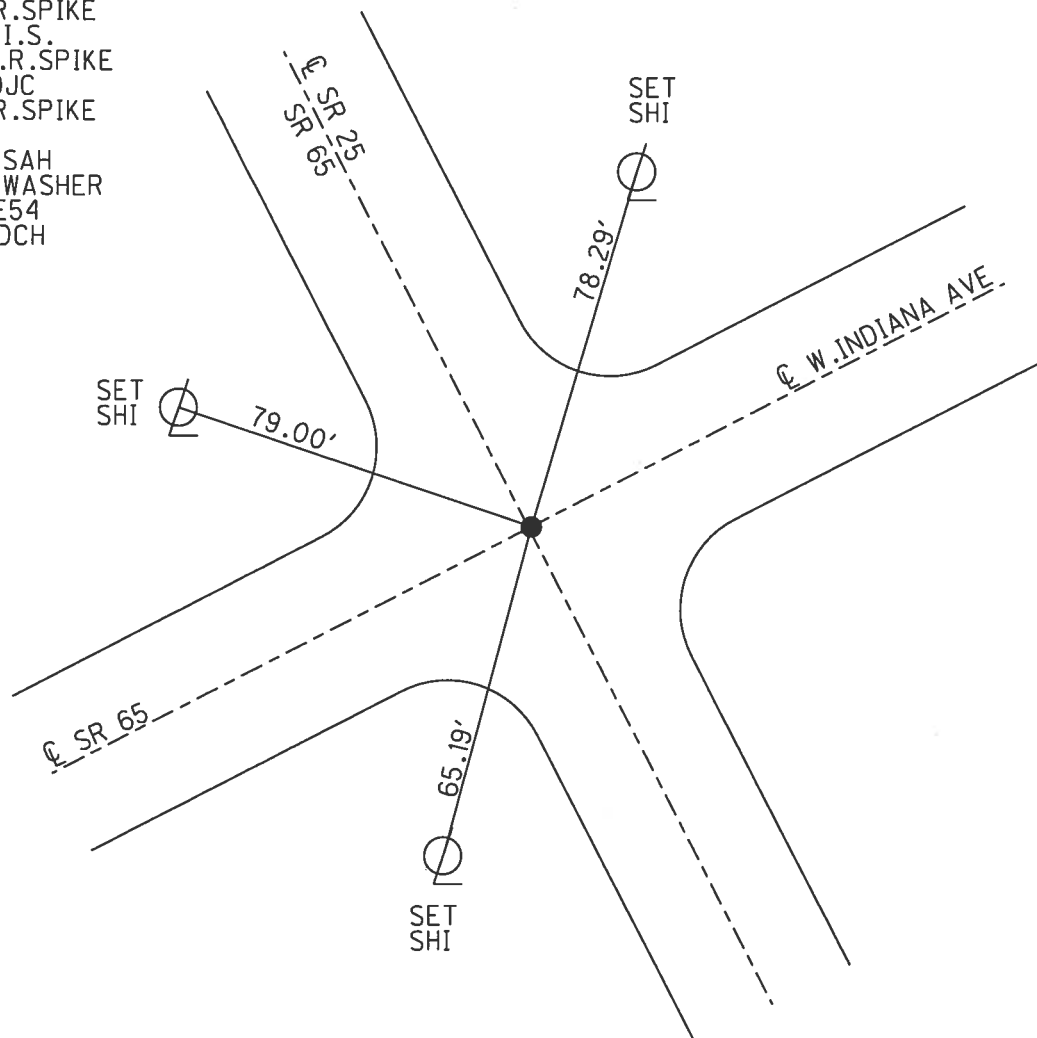

O.D.O.T. DISTRICT 2 SURVEY OFFICE (USE ONLY)

PERSONNEL

REFERENCE NO. 54 F

SHEET 12 OF 13

NOTES STONE

DATE 4/22/91

ROUTE SR 25

H.C. CURTIS

WEATHER COOL

COUNTY WOOD

R.C. HOUSEHOLDER

TEMP. 50°

TOWNSHIP PERRYSBURG

SECTION 12 MILE RESERVE

DWG BY NIESE PID

T 4 US R E

TYPE MONUMENT SM.R.R. SPIKE

ON SURFACE - ~~BELOW~~ ON

OFFSET Q PAVEMENT ON LT : RT

- TO - EDGE PAVEMENT



STATION: 1188+23

HORZ.DATUM:

GEOID:

GRID: NORTHING:

EASTING:

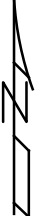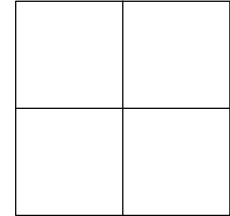

RECORD:
FD SM.R.R. SPIKE
4/22/91, DFC
SET SM.R.R. SPIKE
6/6/91, DFC

SHI
STRAIN
POLE

55.28'

CH. "+" TOP
CONC. CURB

39.46'

SR 25

63.16'

SHI

Q SECOND ST

65.77'



SHI

O.D.O.T. DISTRICT 2 SURVEY OFFICE (USE ONLY)

PERSONNEL	REFERENCE NO. <u>54 G</u>	SHEET <u>6</u> OF <u>6</u>	
NOTES <u>RHOADES</u>	DATE <u>4/9/14</u>	ROUTE <u>SR 25</u>	
H.C. <u>ROUSOS</u>	WEATHER <u>CLEAR</u>	COUNTY <u>WOOD</u>	
R.C. <u>HOMAN</u>	TEMP. <u>41°</u>	TOWNSHIP <u>PERRYSBURG</u>	
<u>GABLE</u>		SECTION <u>6</u>	
		<u>T 4 N R 11 E</u>	

TYPE MONUMENT MON.BOX
 ON SURFACE - ~~BELOW~~ ON
 LEFT - ℄ PAV'T - RIGHT - ℄
℄ TO ℄ - EDGE PAVEMENT
 S.L.M. 1189+96.35

Grid: Northing: 690404.886 Easting: 1656011.473

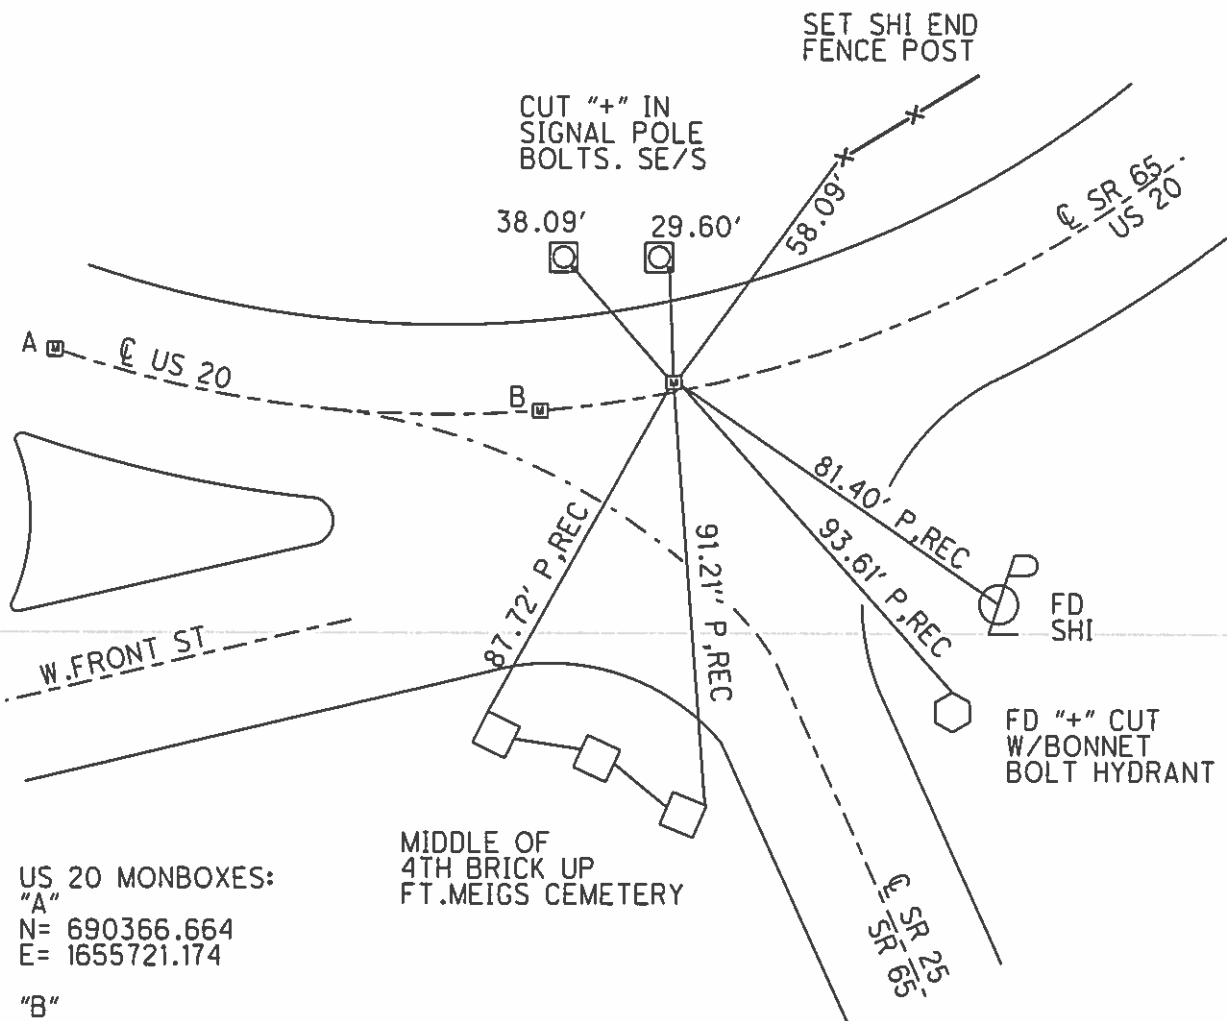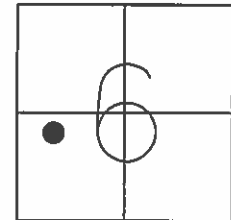

US 20 MONBOXES:

"A"
 N= 690366.664
 E= 1655721.174

"B"
 N= 690395.111
 E= 1655991.073