

O.D.O.T. DISTRICT 2 SURVEY OFFICE (USE ONLY)

PERSONNEL

REFERENCE NO. B0

SHEET OF

NOTES NIESE

DATE 11/16/23

ROUTE SR 25

H.C. AUBLE

WEATHER CLEAR

COUNTY WOOD

R.C. NIESE

TEMP. 65°

TOWNSHIP HENRY

DWG BY BARRIERE

PID 92133

SECTION 1

T 3 N R 10 E

TYPE MONUMENT MONBOX W/ 1" IPIN

ON SURFACE - BELOW ON

OFFSET Q PAVEMENT ON LT : RT


 TO EDGE PAVEMENT

STATION: 3+04.53


HORIZ.DATUM: NAD83(11)/WOOD LDP GEOID: 18

GRID: NORTHING: 575762.525 EASTING: 1650793.206

LDP: NORTHING: 397583.683 EASTING: 162585.951

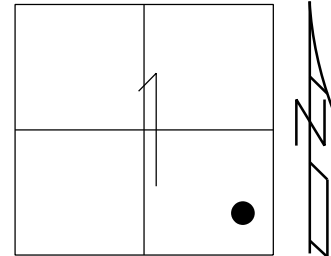

RECORD: P.T.
PLAN STA 3+00.02
SLM 0.58=30+62
3-22-91
FD MONBOX
4/12/01, DCH
FD MONBOX (NO LID)
W/ 3/4" IPIN
REFB0
3/17/22, JFO
FD NEW MONBOX
W/ 1" IPIN
SHOT WITH GPS,
DID NOT PULL TIES
NEWREFB0
11/16/23, TDN

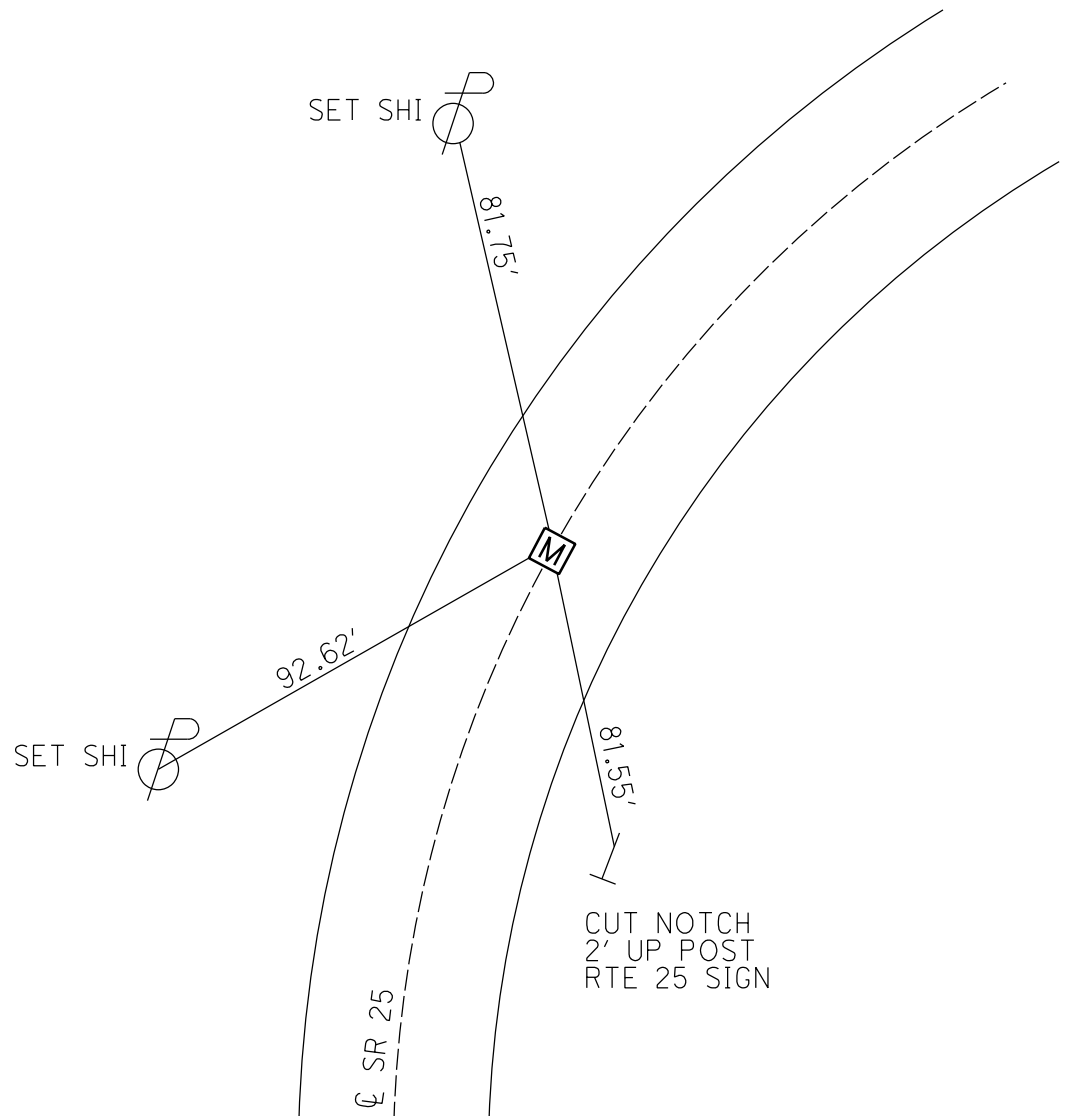

O.D.O.T. DISTRICT 2 SURVEY OFFICE (USE ONLY)

PERSONNEL

REFERENCE NO. B

SHEET 2 OF 36

NOTES HUSS
H.C. ROUSOS
R.C. VAN DUSEN

DATE 4/12/01
WEATHER CLOUDY/WINDY
TEMP. 72°

ROUTE SR 25
COUNTY WOOD
TOWNSHIP HENRY
SECTION 1

DWG BY MILLER PID

T 3 N R 10 E

TYPE MONUMENT MONBOX

ON SURFACE - ~~BELOW~~ ON


OFFSET CL PAVEMENT ON ~~LT~~ : ~~RT~~

11.7' TO RT EDGE PAVEMENT


STATION: 30+62.40

HORZ.DATUM: GEOID:

GRID: NORTHING: EASTING:

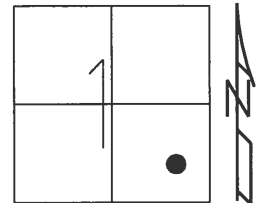

RECORD: P.T.
PLAN STA 3+00.02
SLM 0.58=30+62
3-22-91
FD MONBOX
4/12/01, DCH

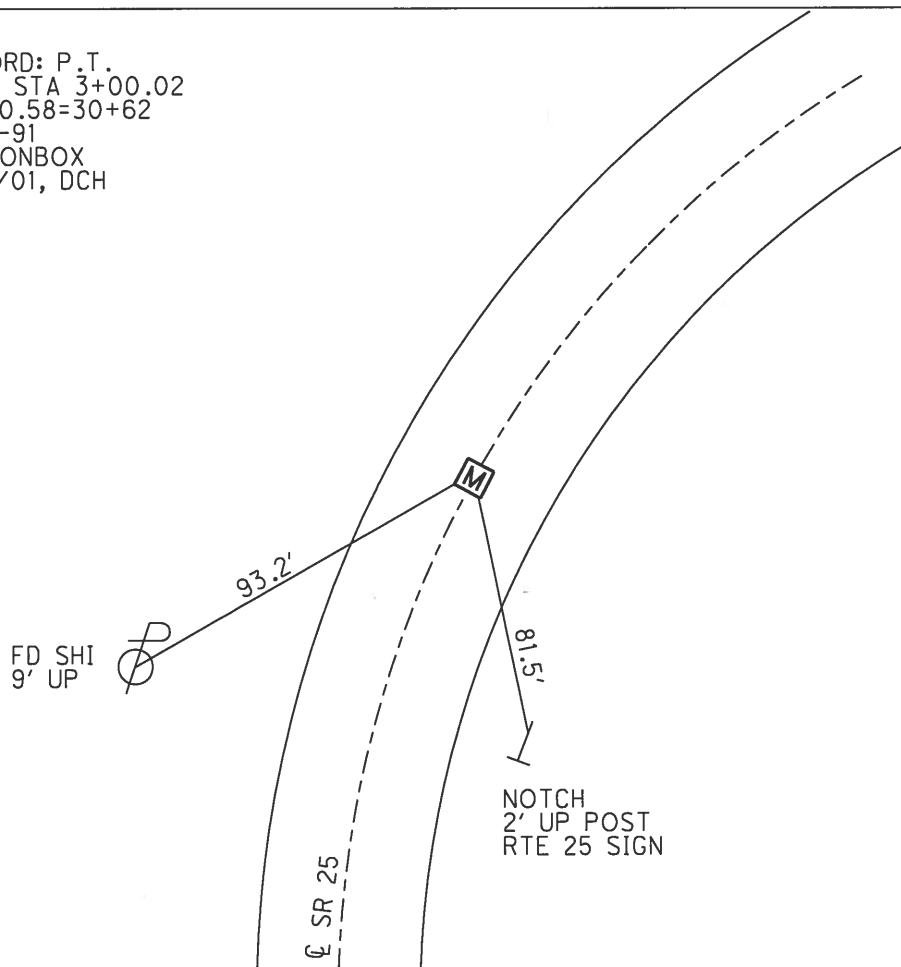

O.D.O.T. DISTRICT 2 SURVEY OFFICE

PERSONNEL

REFERENCE NO. 7

SHEET 1 OF 23

NOTES Huss

H.C. Roussos

R.C. VanNusen

DATE 4-12-01

WEATHER Pt Cldy - Windy

TEMP. 72°F

ROUTE SR-25

COUNTY Wood

TOWNSHIP Henry

SECTION 1

T 3 N R 10 E


TYPE MONUMENT Mon Box

ON SURFACE - BELOW Surface

LEFT - E PAV T - RIGHT E Pav.

11.3 11.7 TO RT EDGE PAVEMENT

S.L.M. (A) 28+51.20 (B) 30+62.40

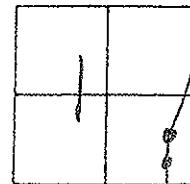

A = Plan PC - (3-22-91)

Plan Sta 0+90

SLM - 0.540 = 28+51

B Plan = PT (3-22-91)

Plan Sta 3+00.02

SLM = 0.580 = 30+62

Fd N/Shi
9' up E/S

North 25
2' up W/S
post (Notch)

Fd N/Shi
w/s

Fd N/Shi
1st Wood Post

1' up Stop
E/S Stop Sign

E Pav.
Cygnat Rd

Resurfaced 2001

O.D.O.T. DISTRICT 2 SURVEY OFFICE

PERSONNEL

REFERENCE NO. _____

SHEET 1 OF 23

NOTES HOFFMAN

H.C. LOEHKE

R.C. BARNHISEL

DATE 3-22-91

WEATHER CLOUDY

TEMP. 55°

ROUTE SR 25

COUNTY WOOD

TOWNSHIP HENRY

SECTION 1

T 3 N R 10 E

TYPE MONUMENT Mon. Box

ON SURFACE - BELOW YES


LEFT - C PAV'T. - RIGHT YES

11.9' & 11.7' TO RT. EDGE PAVEMENT

S.L.M. 28 + 51.20 & 30 + 62.40

(A)

(B)

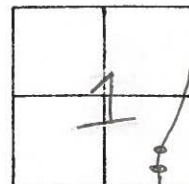

MONUMENT BOX - DID NOT OPEN

PLAN: P.T. 3+00.02

SLM: 30+62.40 (0.580)

93.2'
Set shi 9' up
E/S

CUT NOTCH
2' UP SIGN

NORTH
25

MONUMENT BOX - DID NOT OPEN

PLAN: P.C. STA 0+90.00

SLM: 28+51.20 (0.540)

22.8' Set shi w/s

32.1'

Set shi N/W SIDE
FIRST WOOD POST

C PAV'T

SR 25

CYGNET RD.