

O.D.O.T. DISTRICT 2 SURVEY OFFICE (USE ONLY)

PERSONNEL

REFERENCE NO. CO

SHEET OF

NOTES NIESE
H.C. AUBLE
R.C. NIESE

DATE 11/16/23
WEATHER CLEAR
TEMP. 65°

ROUTE SR 25
COUNTY WOOD
TOWNSHIP HENRY
SECTION 1
T 3 N R 10 E

DWG BY BARRIERE PID 92133

TYPE MONUMENT MONBOX W/ 1" IPIN

ON SURFACE - BELOW ON

OFFSET $\varnothing$ PAVEMENT ON LT : RT


 TO EDGE PAVEMENT

STATION: 8+97.36


HORIZ.DATUM: NAD83(11)/WOOD LDP GEOID: 18

GRID: NORTHING: 576131.386 EASTING: 1651255.999

LDP: NORTHING: 397958.762 EASTING: 163043.876

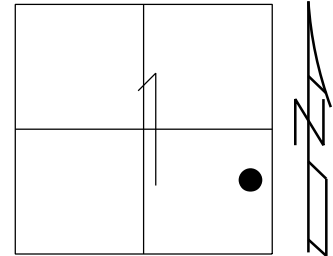

RECORD: P.C.
PLAN STA. 8+92.10
FD MONBOX
4/12/01, TMR
FD MONBOX (NO LID)
W/ 3/4" IPIN
REFCO
3/17/22, JFO
FD NEW MONBOX
W/ 1" IPIN
SHOT WITH GPS,
DID NOT PULL TIES
NEWREFCO
11/16/23, TDN

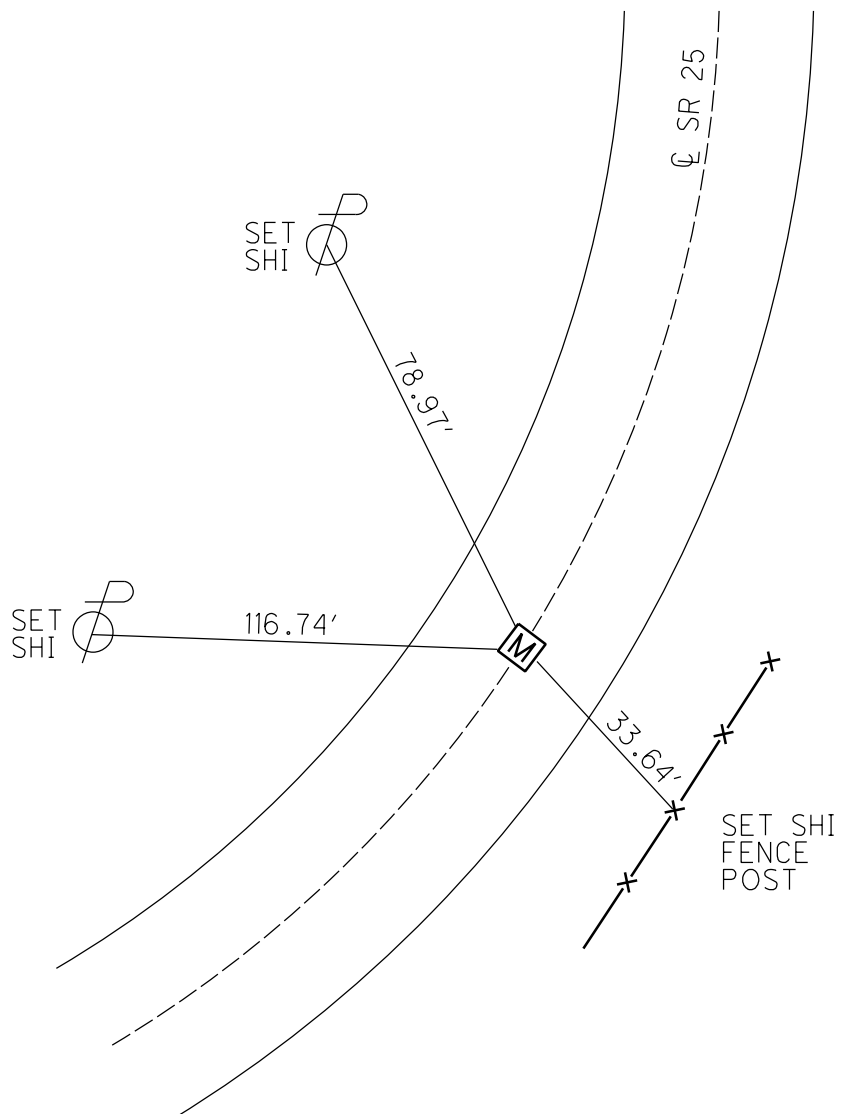

O.D.O.T. DISTRICT 2 SURVEY OFFICE (USE ONLY)

PERSONNEL

REFERENCE NO. C

SHEET 3 OF 36

NOTES HUSS

DATE 4/12/01

ROUTE SR 25

H.C. ROUSOS

WEATHER CLOUDY/WINDY

COUNTY WOOD

R.C. VAN DUSEN

TEMP. 72°

TOWNSHIP HENRY

DWG BY MILLER

PID _____

SECTION 1

T 3 N R 10 E

TYPE MONUMENT MONBOX

ON SURFACE - ~~BELOW~~ ON

OFFSET Q PAVEMENT ON LT: RT

11.3' TO RT EDGE PAVEMENT


STATION: 36+48.48

HORZ.DATUM: _____


GEOID: _____

GRID: NORTHING: _____

EASTING: _____

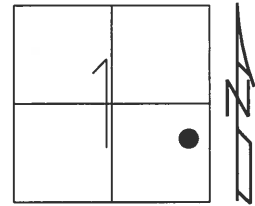

RECORD: P.C.
PLAN STA. 8+92.10
FD MONBOX
4/12/01, TMR

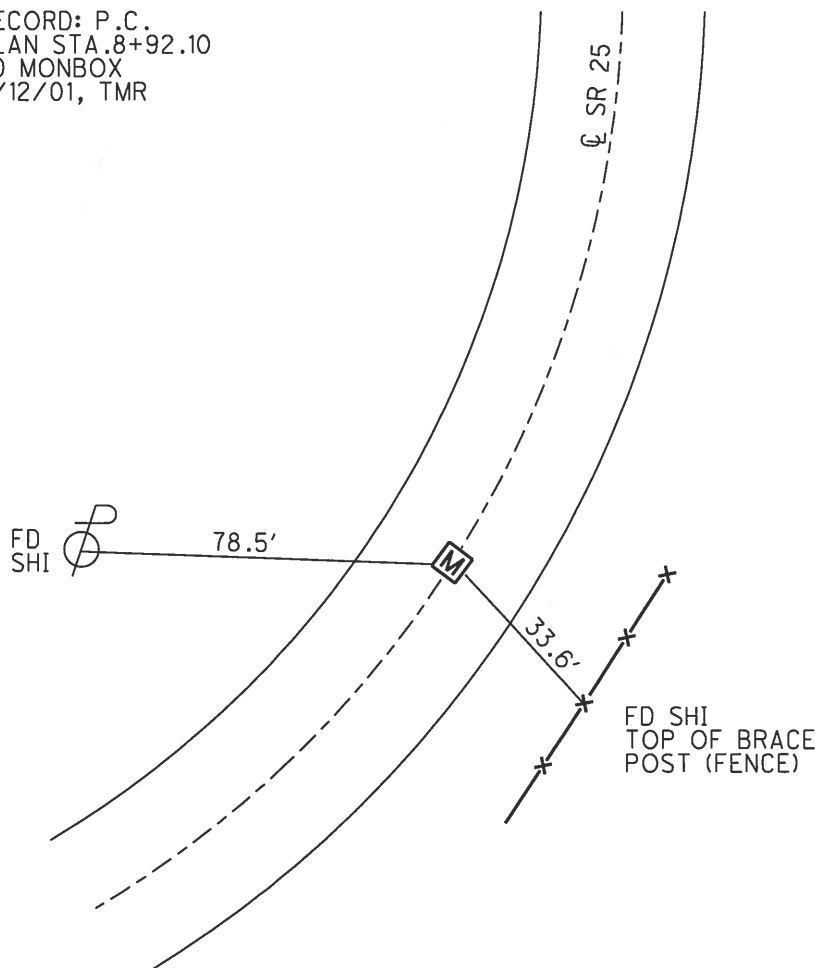

O.D.O.T. DISTRICT 2 SURVEY OFFICE

PERSONNEL

REFERENCE NO. _____

SHEET 2 OF 23

NOTES Huss

H.C. Rousos

R.C. Van Dusen

DATE 4-12-01

WEATHER Pt Cloudy - Windy

TEMP. 72°F

ROUTE SR-25

COUNTY Wood

TOWNSHIP Henry

SECTION 1

T 3 N R 10 E


TYPE MONUMENT Mon Box

ON SURFACE - ~~BELOW~~ Surface

LEFT - E PAV'T - RIGHT

11.3, 11.7 TO RT EDGE PAVEMENT

S.L.M. (A) 86+48.48 (B) 44+08.80

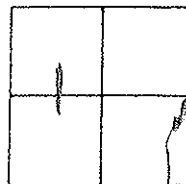

Record:

(A) R.B. Plan Sta: PC
8+92.10 (0.691) SLM

(B) MVB Plan Sta: PT
16+47.10 (0.835) SLM


Fd
N/Shi

Fd
N/Shi
5' up

Fd
Nail/Shi
Top of N.
Bucc Post
Fence

Fd N/Shi
Top of N. Bucc
Post (Fence)

SR-25

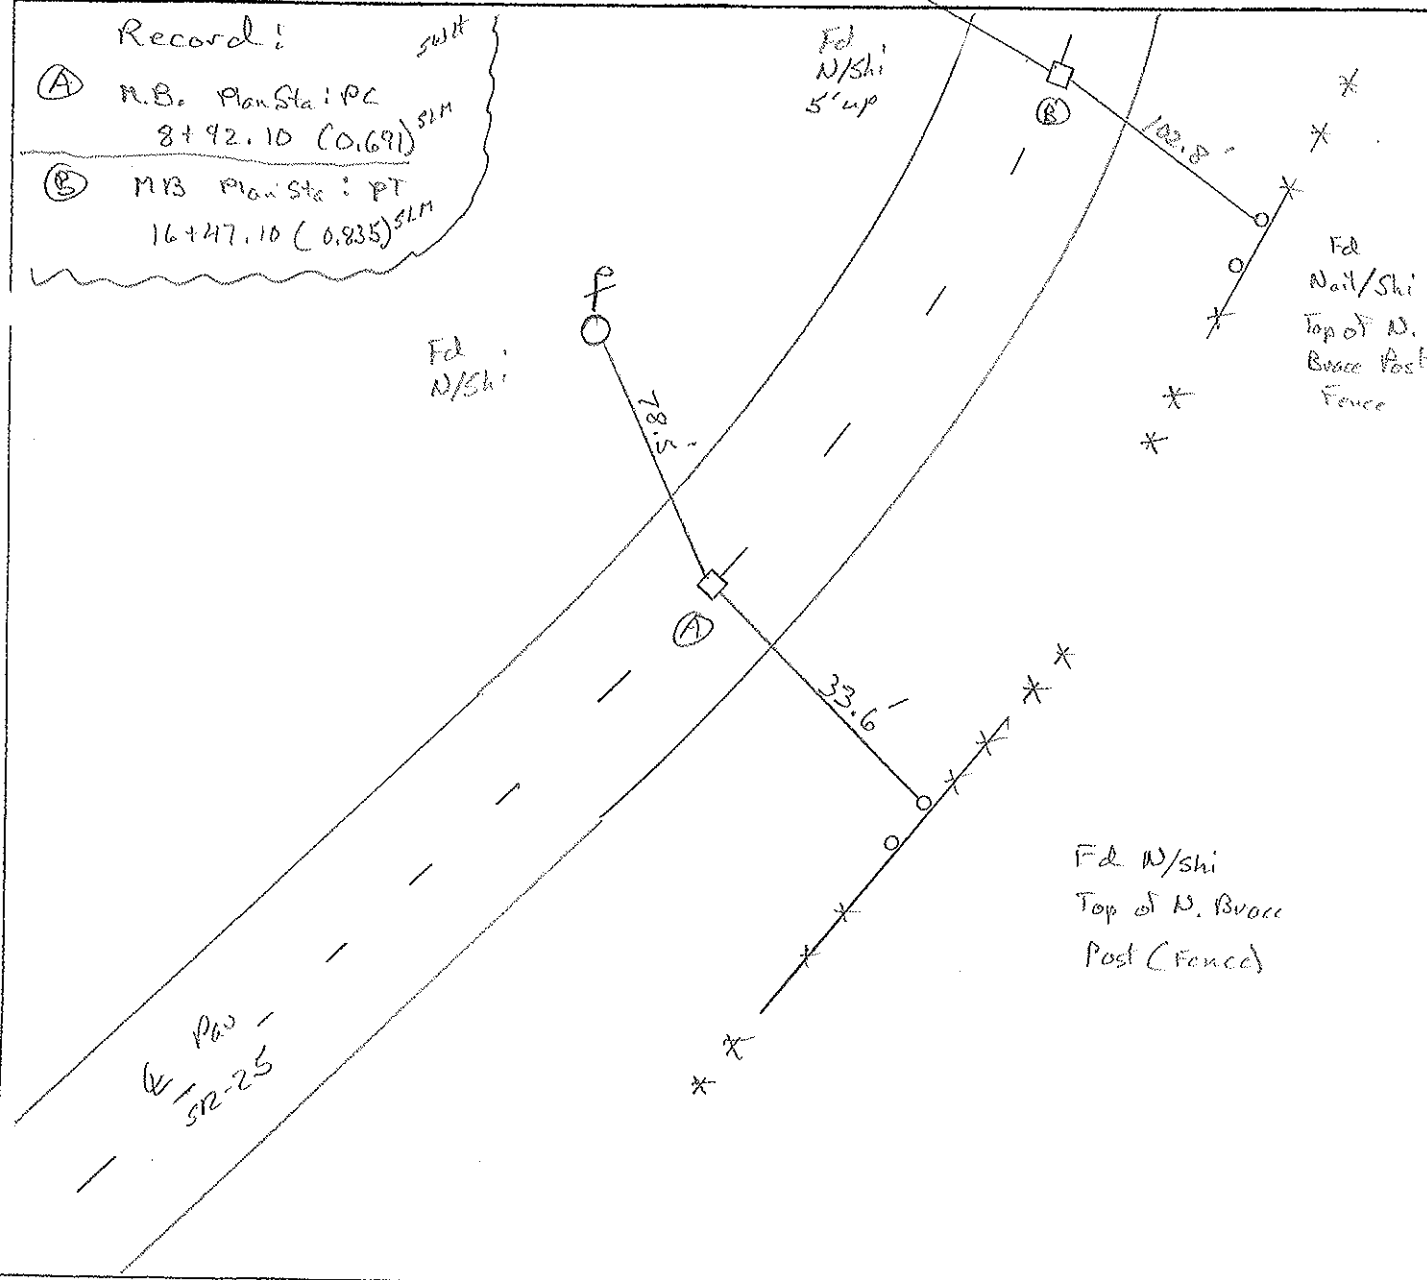

O.D.O.T. DISTRICT 2 SURVEY OFFICE

PERSONNEL

REFERENCE NO. _____

SHEET 2 OF 23

NOTES HOFFMAN

H.C. LOEHLE

R.C. BARNHISEL

DATE 3-22-91

WEATHER CLOUDY

TEMP. 55°

ROUTE SR 25

COUNTY WOOD

TOWNSHIP HENRY

SECTION 1

T 3 N R 10 E

TYPE MONUMENT Mon. Box


ON SURFACE - BELOW yes

LEFT - & PAW'T. - RIGHT yes

11.3' & 11.7' TO RT. EDGE PAVEMENT

S.L.M. 36+48.48 & 44+08.80

(C) (D)

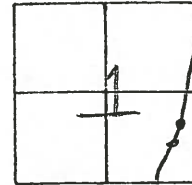

68.4'

Set shi
5' up sets

103.8'

MONUMENT
BOX - DID NOT OPEN
PLAN STA: P.T. 16+47.10
S.L.M.: 44+08.80
(0.835)

Set
shi
TOP Post

Set shi s/s
78.5'

33.6'
Set
shi
N/S

MONUMENT BOX - DID NOT
OPEN
PLAN STA: P.C. 8+92.10
S.L.M.: 36+48.48
(0.691)

PAVT - SR 25