


O.D.O.T. DISTRICT 2 SURVEY OFFICE (USE ONLY)

PERSONNEL	REFERENCE NO.	<u>54 E</u>	SHEET	<u>5</u>	OF	<u>6</u>
NOTES	<u>RHOADES</u>	DATE	<u>4/9/14</u>	ROUTE	<u>SR 25</u>	
H.C.	<u>ROUSOS</u>	WEATHER	<u>CLEAR</u>	COUNTY	<u>WOOD</u>	
R.C.	<u>HOMAN</u>	TEMP.	<u>41°</u>	TOWNSHIP	<u>PERRYSBURG</u>	
	<u>GABLE</u>			SECTION	<u>6</u>	
				T	<u>4</u>	N
				R	<u>11</u>	E


TYPE MONUMENT SM.R.R.SPIKE
 ON SURFACE - ~~BELOW~~ ON
 LEFT - ☉ PAV'T - RIGHT -
- TO - EDGE PAVEMENT
 S.L.M. 1176+43.73

Grid: Northing: 689187.351 Easting: 1656600.601

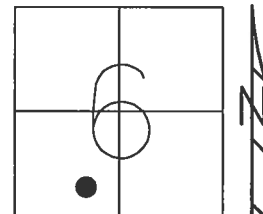

NOTE: REF 27 SR 65

RECORD:
 FD SM.R.R.SPIKE
 4/22/91, I.S.
 SET SM.R.R.SPIKE
 6/6/91, DJC
 FD SM.R.R.SPIKE
 REF54
 9/24/12, SAH
 SET MAG/WASHER
 GPS, REF54
 6/19/15, DCH

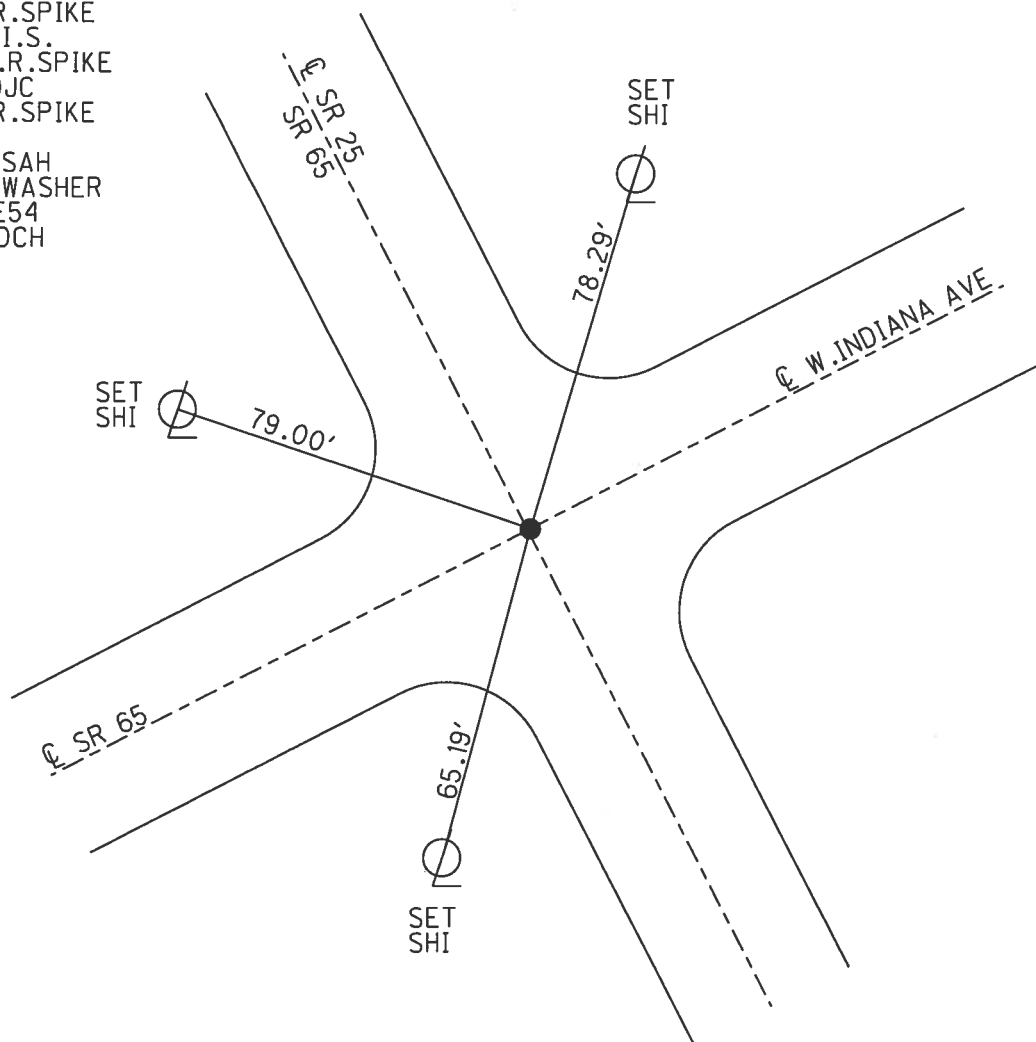

O.D.O.T. DISTRICT 2 SURVEY OFFICE

91 of 91 sheets

PERSONNEL

REFERENCE NO. 54-E

SHEET 28 OF 29

NOTES 1. Stone

H.C. D. Curtis

R.C. J. Householder

DATE 22 April 91

WEATHER Cool

TEMP. 43°

ROUTE SR # 25

COUNTY Wood

TOWNSHIP Perrysburg

SECTION _____

T _____ R _____


TYPE MONUMENT 5m. RR Spk.

ON SURFACE - BELOW Surface

LEFT - & PAV'T. - RIGHT _____

TO _____ EDGE PAVEMENT


S.L.M. 1179+15

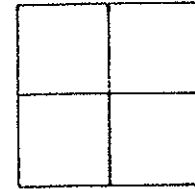

SET SM. R. R. SPK. TO SURFACE

6-6-91

AJC

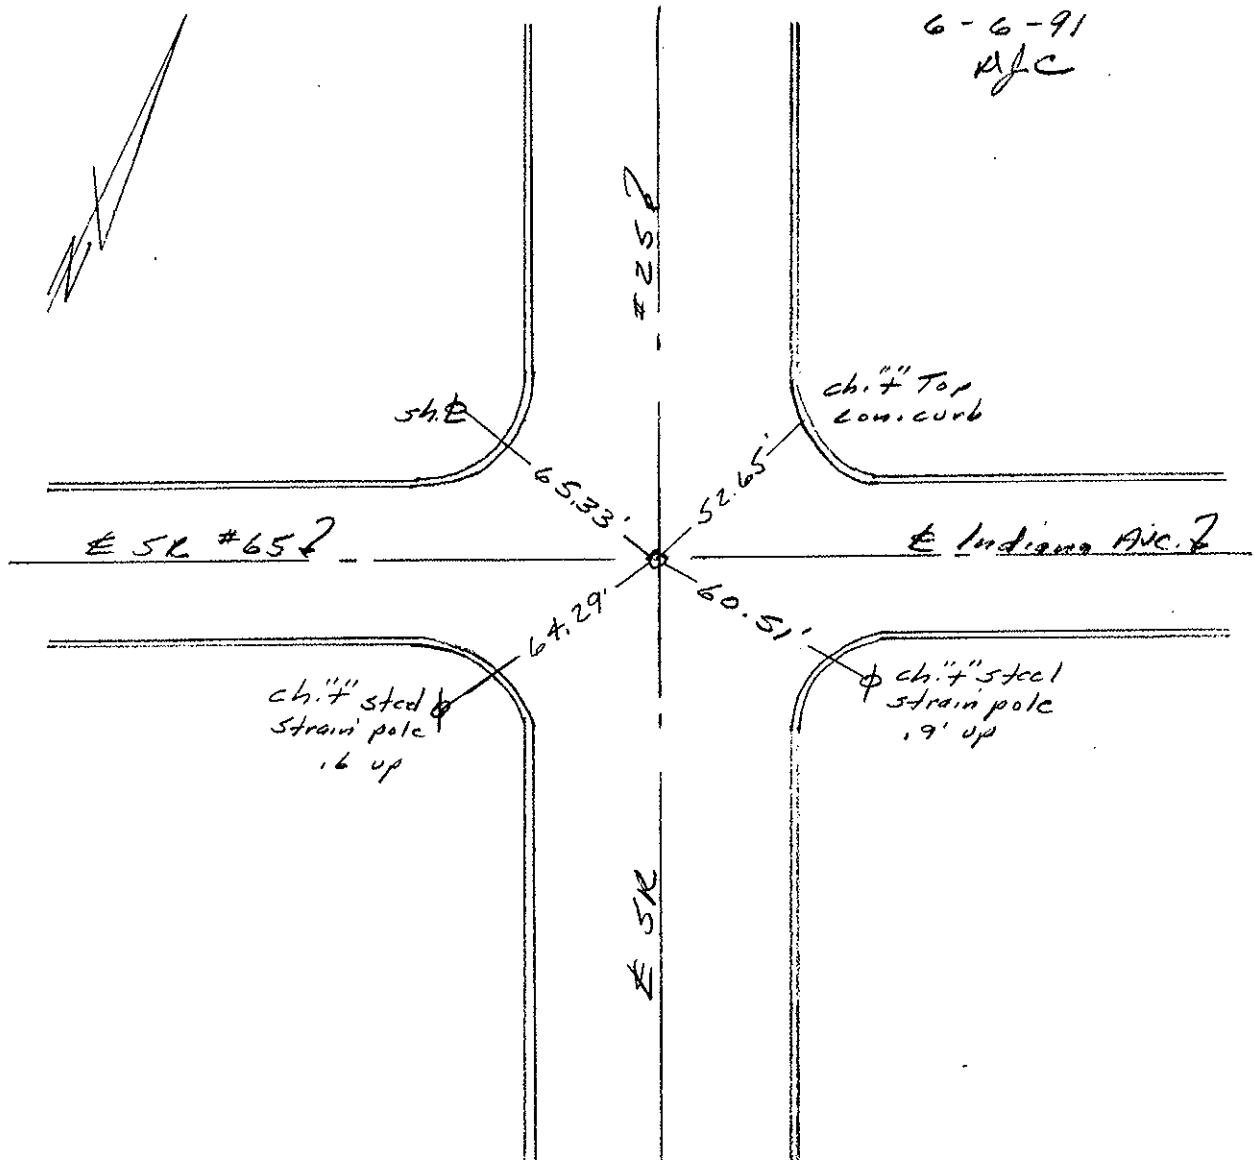

PERSONNEL TITLE PERSONNEL TITLE


Stone
Michaelde
Dennis
Curtis

COUNTY Wood DATE 9 April '75

S. R. # 25 WEATHER Cloudy

SEC. Percys bog TEMP. 33°

DESCRIPTION References to Control Points JOB NO.

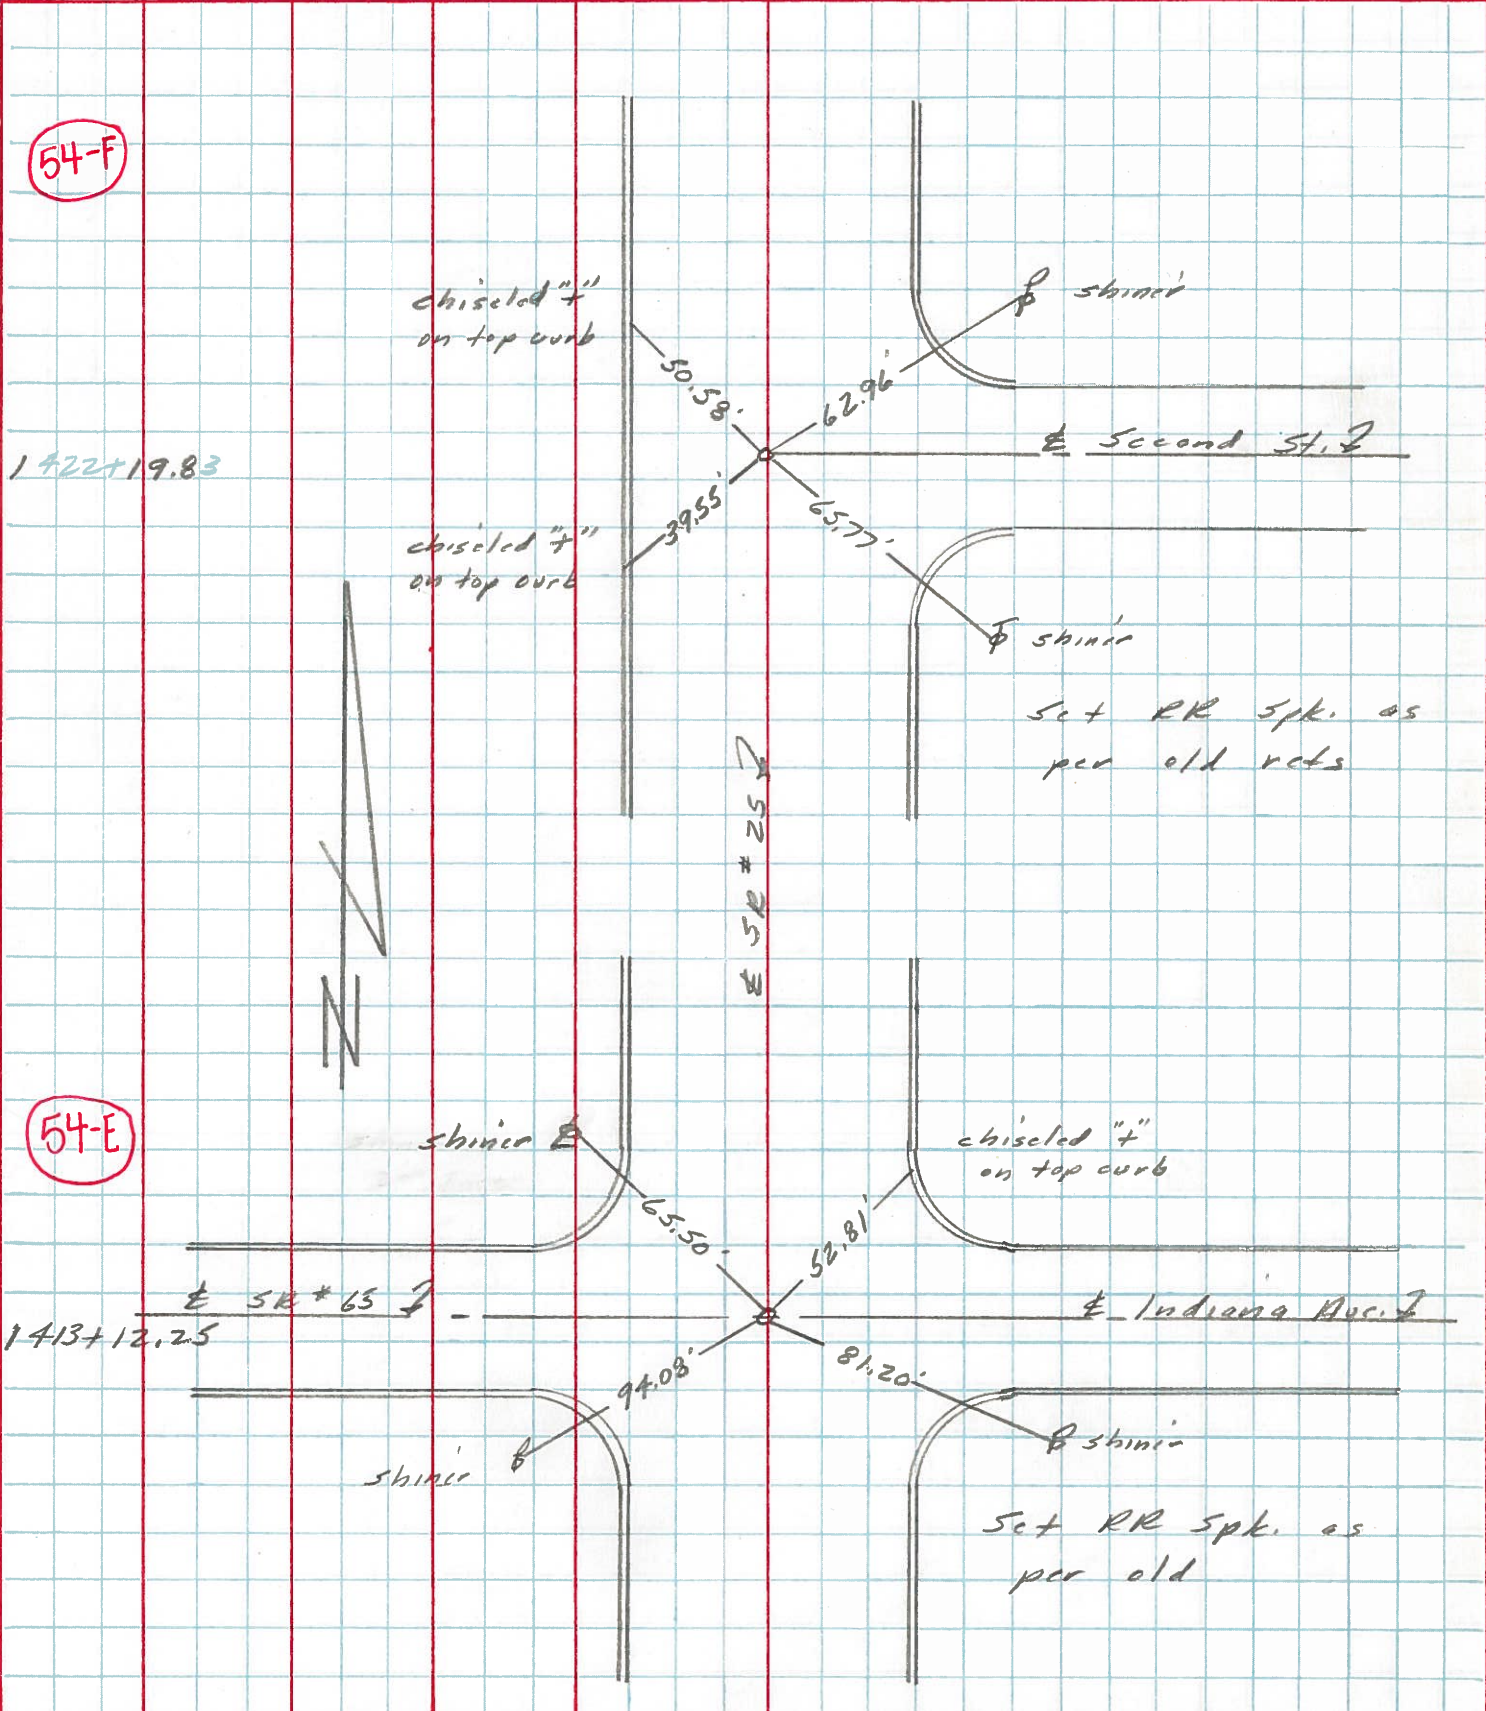

54-F

54-E

PERSONNEL TITLE PERSONNEL TITLE

Silvester

COUNTY Wood

DATE 6-28-56

S. R. U.S. #25

WEATHER

SEC.

TEMP.

DESCRIPTION

West Boundary St. Ferrysburg

JOB NO.


LEFT

CENTER LINE

RIGHT


Sta. 1395+11.60
W. Boundary & 8th
Mon.

54-B #910

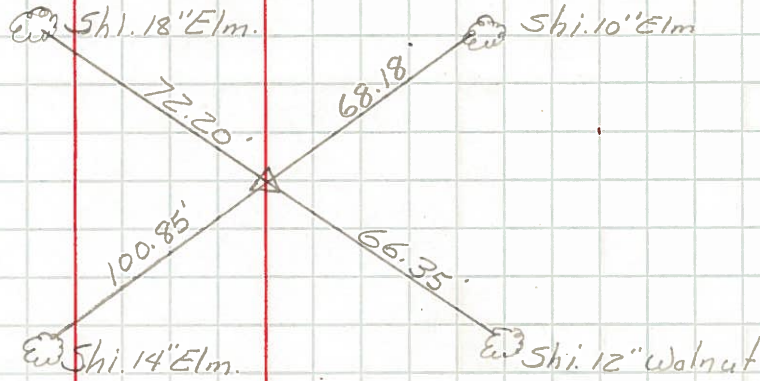


Sta. 1413+12.25 (stone)
W. Boundary & Indiana

54-E #911

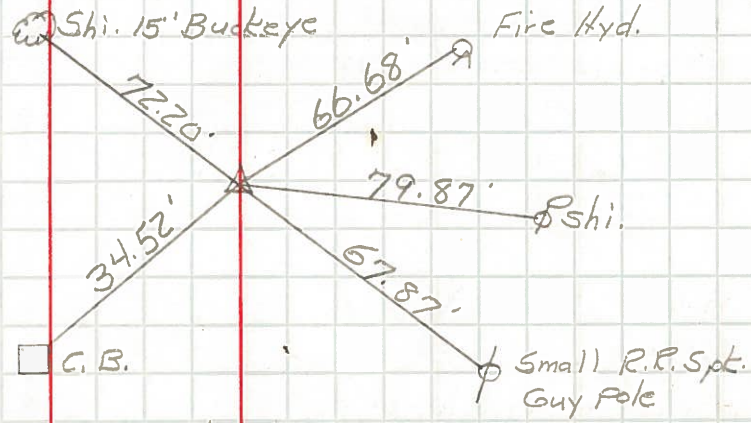

Sta. 1417+92.60
P.O.T.
R.K. nail.

#912

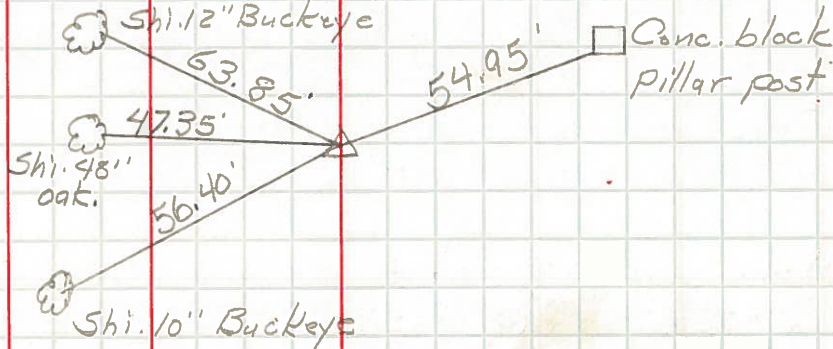

PERSONNEL	TITLE	PERSONNEL	TITLE	COUNTY	DATE
Stone				Wood	9 April '75
Michaldek				S. R. # 25	WEATHER Cloudy
Dennis				SEC. Perry's bridge	TEMP. 33°
Curtis					

DESCRIPTION: References to Central Points JOB NO. _____

