

O.D.O.T. DISTRICT 2 SURVEY OFFICE (USE ONLY)

PERSONNEL

REFERENCE NO. 1

SHEET 1 OF 40

NOTES RHOADES

DATE 4/28/17

ROUTE SR 65

H.C. LEU

WEATHER FAIR

COUNTY WOOD

R.C. HELDMAN

TEMP. 46°

TOWNSHIP GRAND RAPIDS

DWG BY RHOADES PID 95796

SECTION 7

T 5 N R 9 E

TYPE MONUMENT MAG/WASHER

ON SURFACE - ~~BELOW~~ ON

OFFSET CL PAVEMENT 2.4' ~~LT~~ : RT

12.5' TO LT EDGE PAVEMENT


STATION: 0+00

HORIZ.DATUM: NAD83 2011


GEOID: NAVD88 2018

GRID: NORTHING: 638092.144

EASTING: 1589091.109

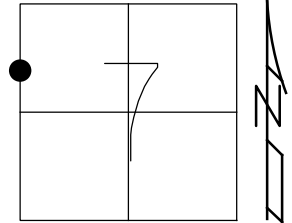

NOTE: HEN 65 REF 40

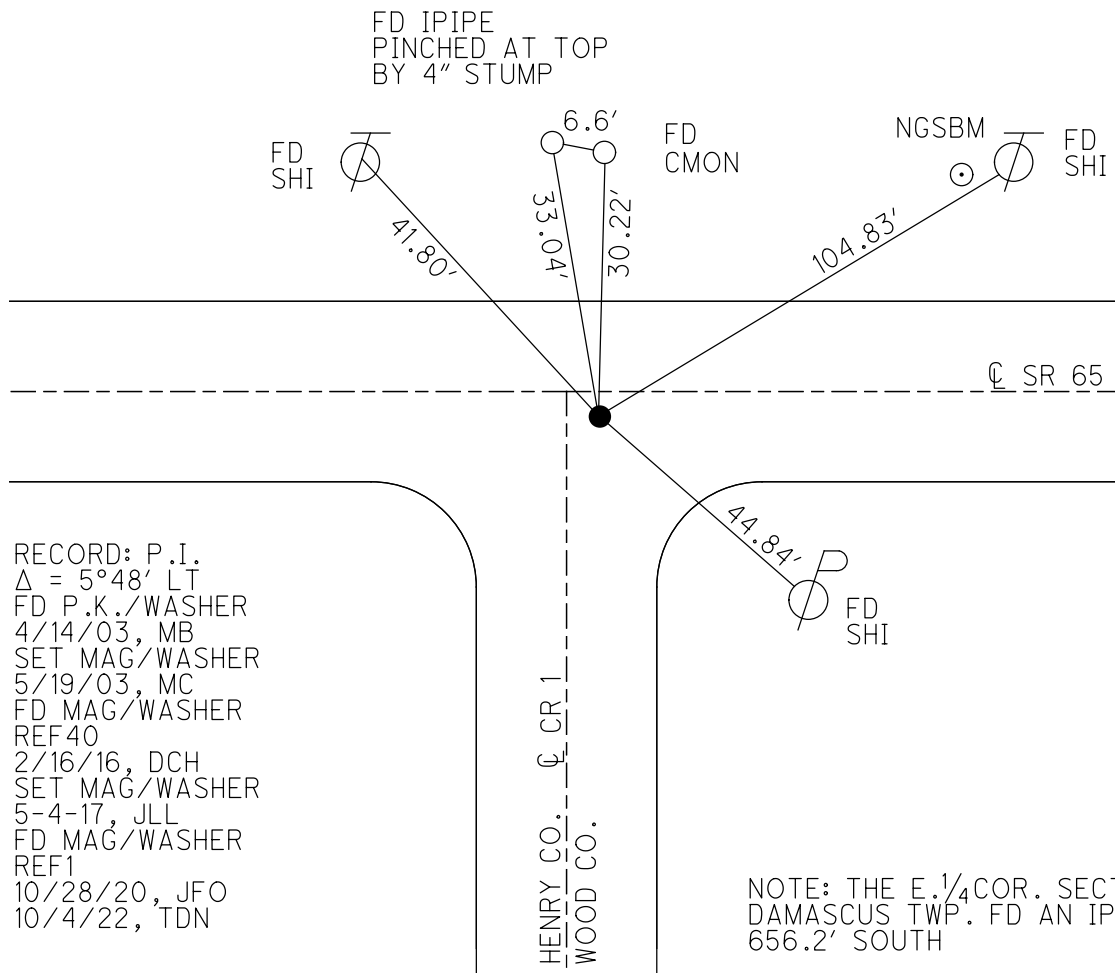

RECORD: P.I.
 $\Delta = 5^{\circ}48'$ LT
FD P.K./WASHER
4/14/03, MB
SET MAG/WASHER
5/19/03, MC
FD MAG/WASHER
REF40
2/16/16, DCH
SET MAG/WASHER
5-4-17, JLL
FD MAG/WASHER
REF1
10/28/20, JFO
10/4/22, TDN

NOTE: THE E. $\frac{1}{4}$ COR. SECT. 12
DAMASCUS TWP. FD AN IPIN
656.2' SOUTH

O.D.O.T. DISTRICT 2 SURVEY OFFICE (USE ONLY)

PERSONNEL

REFERENCE NO. 1 A

SHEET 2 OF 40

NOTES O'DONNELL

DATE 3/21/22

ROUTE SR 65

H.C. NIESE

WEATHER SUNNY

COUNTY WOOD

R.C. AUBLE

TEMP. 65°

TOWNSHIP GRAND RAPIDS

DWG BY RHOADES

PID 95796

SECTION 7

T 5 N R 9 E

TYPE MONUMENT 1" IPIN

ON SURFACE - ~~BELOW~~ ON

OFFSET Q PAVEMENT 11.5' ~~LT~~ : RT

7.7' TO RT EDGE PAVEMENT


STATION: 10+78.09

HORZ.DATUM: NAD83 2011

GEOID: NAVD88 2018

GRID: NORTHING: 637935.915

EASTING: 1590159.766

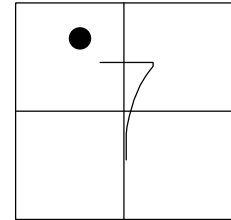

RECORD: P.I.

$\Delta = 14^{\circ} 34' \text{ LT}$

ORIGIN UNKNOWN

FD 1" IPIN

6/17/04, DCH

SET MAG/WASHER

9-20-04, RGN

FD MAG/WASHER

REFA1


5-26-20, JLL

10/28/20, JFO

SET MAG/WASHER

10/4/22, TDN

MARY JANE
THURSTON
STATE PARK

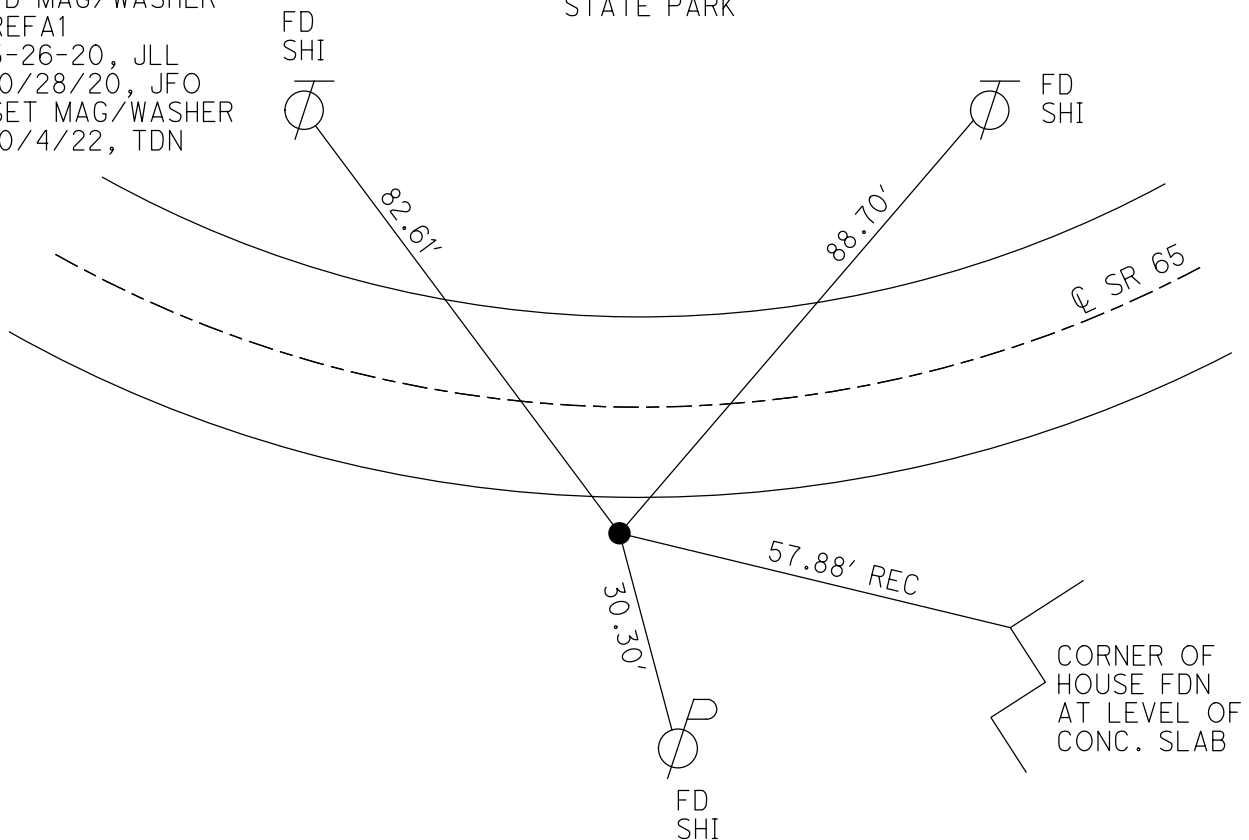

O.D.O.T. DISTRICT 2 SURVEY OFFICE (USE ONLY)

PERSONNEL

REFERENCE NO. 1 B

SHEET 3 OF 40

NOTES O'DONNELL

DATE 3/21/22

ROUTE SR 65

H.C. NIESE

WEATHER SUNNY

COUNTY WOOD

R.C. AUBLE

TEMP. 65°

TOWNSHIP GRAND RAPIDS

SECTION 7

DWG BY RHOADES

PID 95796

T 5 N R 9 E

TYPE MONUMENT P.K./WASHER

ON SURFACE - ~~BELOW~~ ON

OFFSET CL PAVEMENT 2.6' ~~LT~~ : RT

7.5' TO RT EDGE PAVEMENT


STATION: 22+29.98

HORZ.DATUM: NAD83 2011

GEOID: NAVD88 2018


GRID: NORTHING: 638061.410

EASTING: 1591304.837

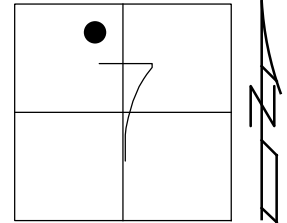

RECORD: P.I.
 $\Delta = 8^{\circ} 44' \text{ LT}$
SET P.K./WASHER
4-20-92, BVD
FD P.K./WASHER
6/17/04, DCH
SET MAG/WASHER
9-16-04, SAH
FD MAG/WASHER
REFAB1
5-26-20, JLL
REFB1
10/28/20, JFO
SET MAG/WASHER
10/4/22, TDN

MARY JANE
THURSTON
STATE PARK

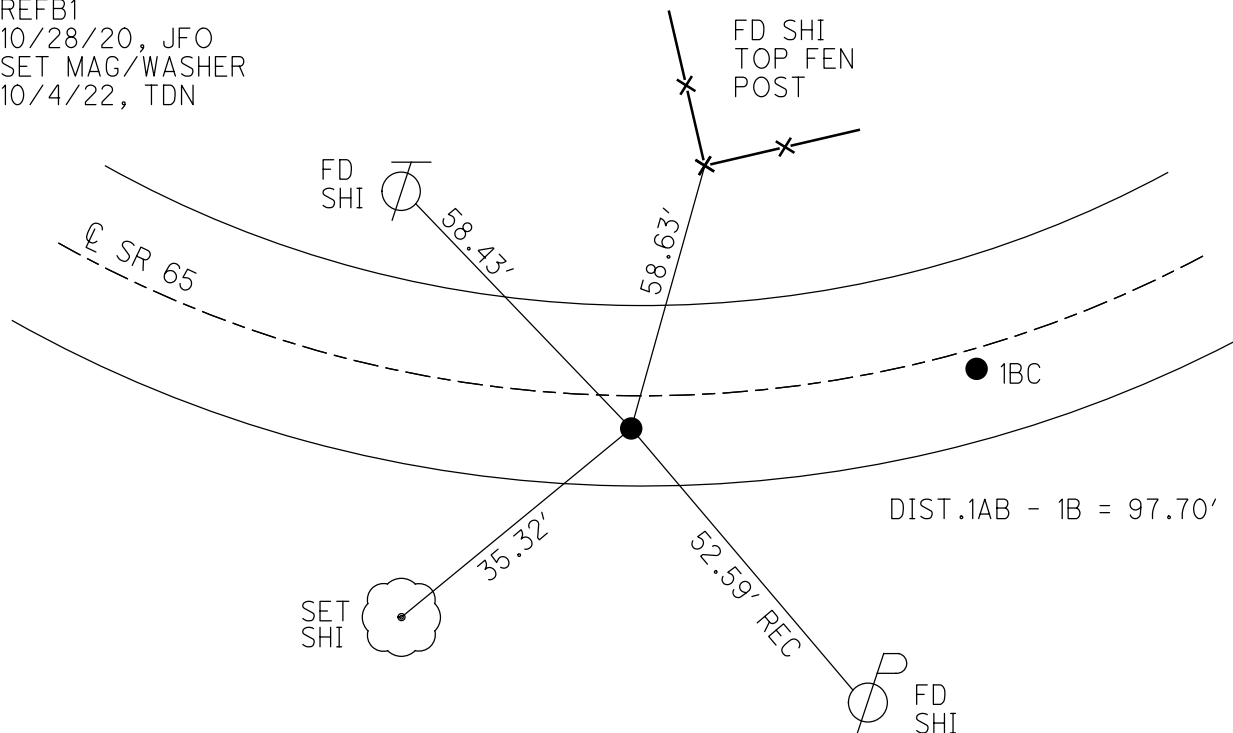

O.D.O.T. DISTRICT 2 SURVEY OFFICE (USE ONLY)

PERSONNEL

REFERENCE NO. 1 BC

SHEET 4 OF 40

NOTES O'DONNELL

DATE 3/21/22

ROUTE SR 65

H.C. NIESE

WEATHER SUNNY

COUNTY WOOD

R.C. AUBLE

TEMP. 65°

TOWNSHIP GRAND RAPIDS

SECTION 7

T 5 N R 9 E

DWG BY RHOADES

PID 95796

TYPE MONUMENT MAG/WASHER

ON SURFACE - ~~BELOW~~ ON

OFFSET Q PAVEMENT 2.0' ~~LT~~ : RT

8' TO RT EDGE PAVEMENT


STATION: 23+27.55

HORZ.DATUM: NAD83 (2011)

GEOID: NAVD88 2018

GRID: NORTHING: 638080.295


EASTING: 1591400.662

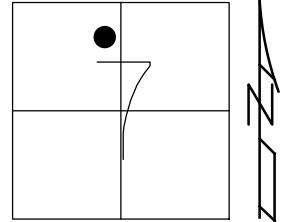

RECORD:

ORIGIN UNKNOWN
SET P.K./WASHER
4-20-92, BVD
FD P.K./WASHER
6/17/04, DCH
SET MAG/WASHER
9-16-04, SAH
FD MAG/WASHER
REFB1
5-26-20, JLL
REFBC1
10/28/20, JFO
SET MAG/WASHER
10/4/22, TDN

MARY JANE
THURSTON
STATE PARK

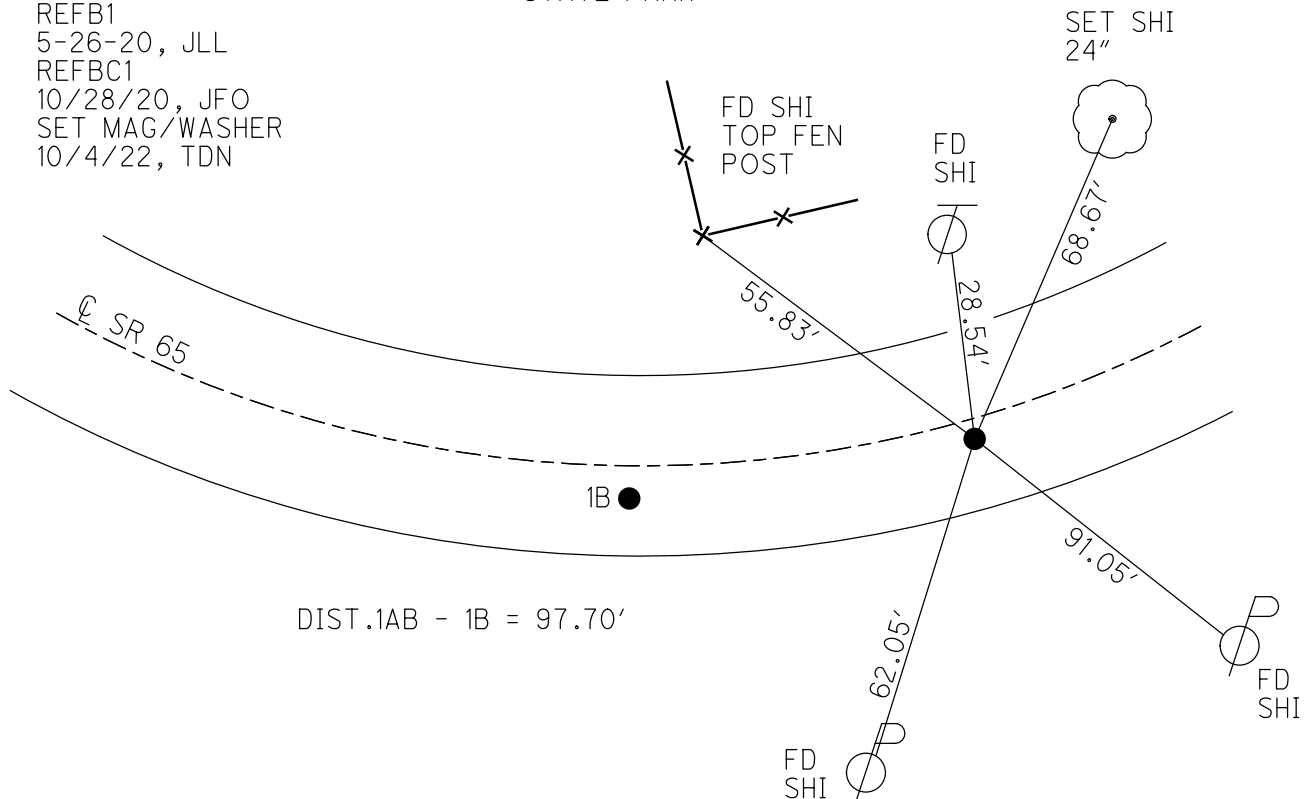

O.D.O.T. DISTRICT 2 SURVEY OFFICE (USE ONLY)

PERSONNEL

REFERENCE NO. 1 C

SHEET 5 OF 40

NOTES RHOADES

DATE 3/29/22

ROUTE SR 65

H.C. NIESE

WEATHER CLEAR

COUNTY WOOD

R.C. KETNER, AUBLE

TEMP. 27°

TOWNSHIP GRAND RAPIDS

O'DONNELL

SECTION 7

DWG BY RHOADES

PID 95796

T 5 N R 9 E

TYPE MONUMENT MAG/WASHER

ON SURFACE - ~~BELOW~~ ON

OFFSET Q PAVEMENT 4.4' LT : ~~RT~~

5' TO LT EDGE PAVEMENT


STATION: 26+22.89

HORZ.DATUM: NAD83 2011


GEOID: NAVD88 2018

GRID: NORTHING: 638163.240

EASTING: 1591684.311

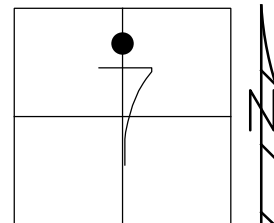

RECORD:
SET P.K./WASHER
11-21-89, SWH
FD SM.R.R.SPIKE
1" DOWN
6/17/04, DCH
SET MAG/WASHER
9-20-04, SAH
FD MAG/WASHER
REFC1
5-26-20, JLL
10/28/20, JFO
SET MAG/WASHER
10/4/22, TDN

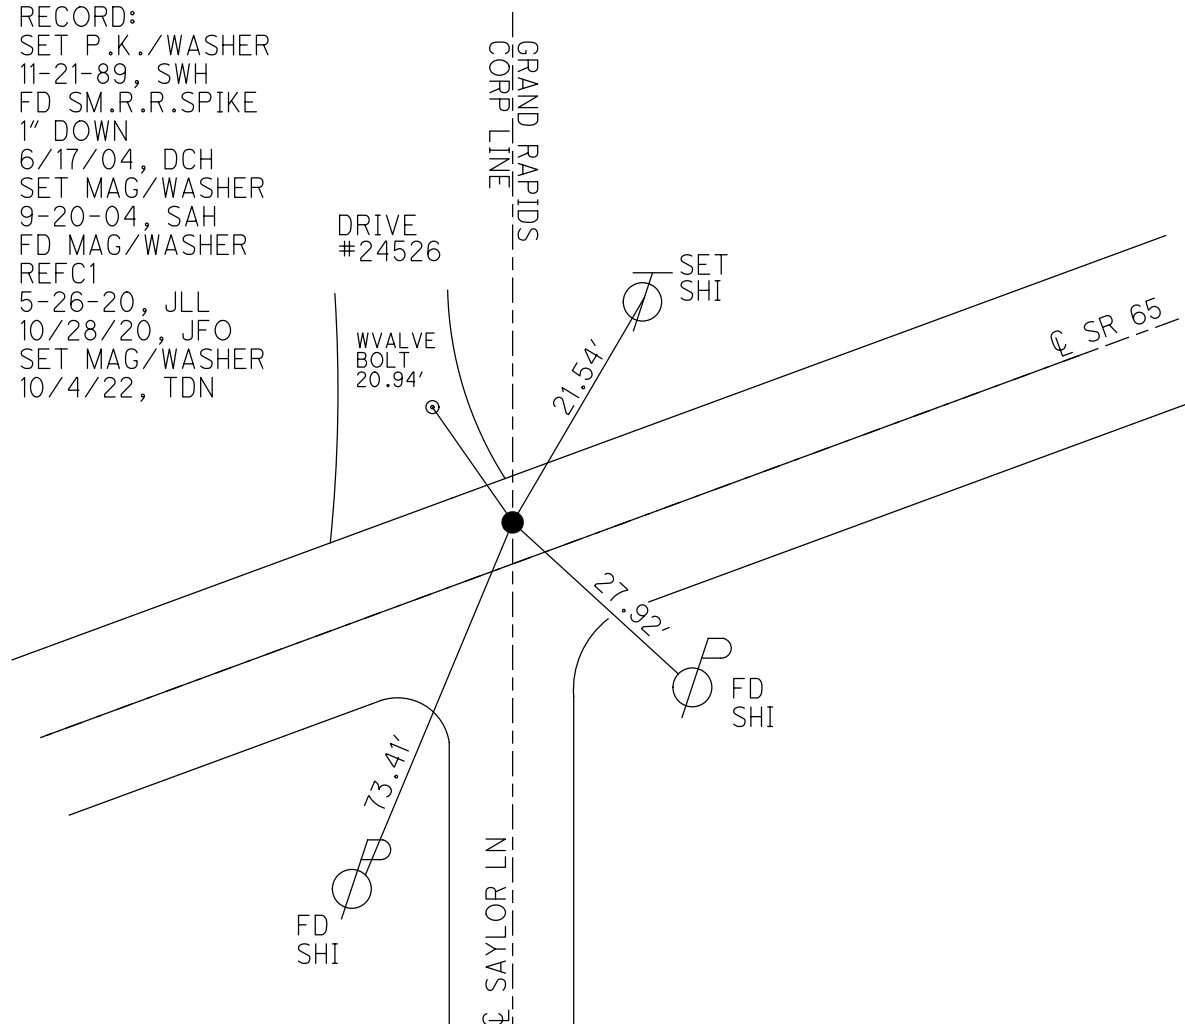

O.D.O.T. DISTRICT 2 SURVEY OFFICE (USE ONLY)

PERSONNEL

REFERENCE NO. 1 CA

SHEET 6 OF 40

NOTES O'DONNELL

DATE 3/21/22

ROUTE SR 65

H.C. NIESE

WEATHER SUNNY

COUNTY WOOD

R.C. AUBLE

TEMP. 5°

TOWNSHIP GRAND RAPIDS

DWG BY RHOADES

PID 95796

SECTION 7

T 5 N R 9 E

TYPE MONUMENT MONBOX W/1" IPIN

ON SURFACE - ~~BELOW~~ ON

OFFSET Q PAVEMENT ON LT : RT

- TO - EDGE PAVEMENT


STATION: 34+05.1

HORIZ.DATUM: NAD83 2011

GEOID: NAVD88 2018


GRID: NORTHING: 638336.122

EASTING: 1592447.227

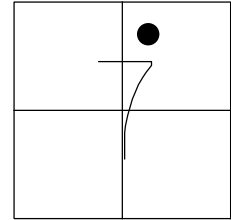

RECORD:
FD MONBOX
6/24/04, DCH
FD MONBOX
W/1" IPIN
REFCA1
3/21/22, JFO
NEWREFCA1
10/4/22, TDN

FD 5/8" IPIDS
1.3' N. OF WALK

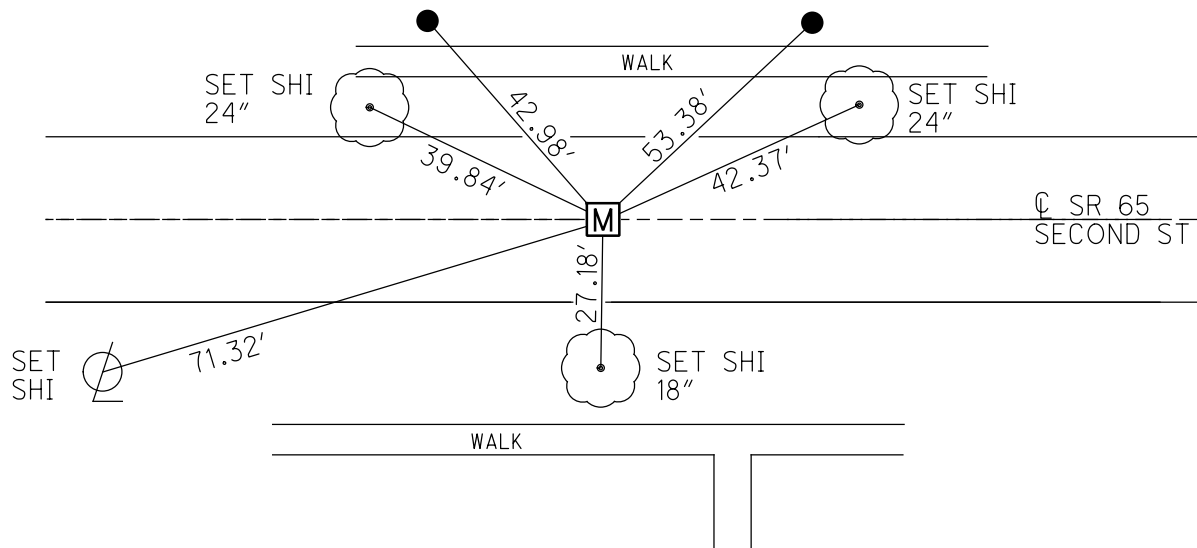

RES #24351

O.D.O.T. DISTRICT 2 SURVEY OFFICE (USE ONLY)

PERSONNEL

REFERENCE NO. 1 CB

SHEET 7 OF 40

NOTES O'DONNELL

DATE 6/24/04

ROUTE SR 65

H.C. AUBLE

WEATHER SUNNY

COUNTY WOOD

R.C. O'DONNELL

TEMP. 70°

TOWNSHIP GRAND RAPIDS

DWG BY RHOADES

PID 95796

SECTION 7

T 5 N R 9 E

TYPE MONUMENT MONBOX W/ 1" IPIN

ON SURFACE - ~~BELOW~~ ON

OFFSET CL PAVEMENT ON LT : RT

- TO - EDGE PAVEMENT


STATION: 36+50.95

HORIZ.DATUM: NAD83 2011

GEOID: NAVD88 2018

GRID: NORTHING: 638389.791

EASTING: 1592687.106

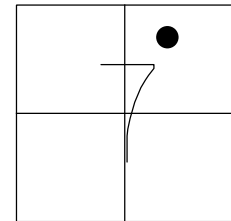

RECORD:
FD MONBOX
6/24/04, DCH
FD MONBOX
W/1" IPIN
REFCB1
11/02/20, JFO
FD MONBOX
W/1" IPIN
NEWREFCB1
10/4/22, TDN

BOTTOM
OF BEVELED
EDGE
WINGWALL


FD
SHI

FD
DISK

NOTE: 7' W OF CL WEST ST

SET SHI
30"

FD 1/2"
IPIN

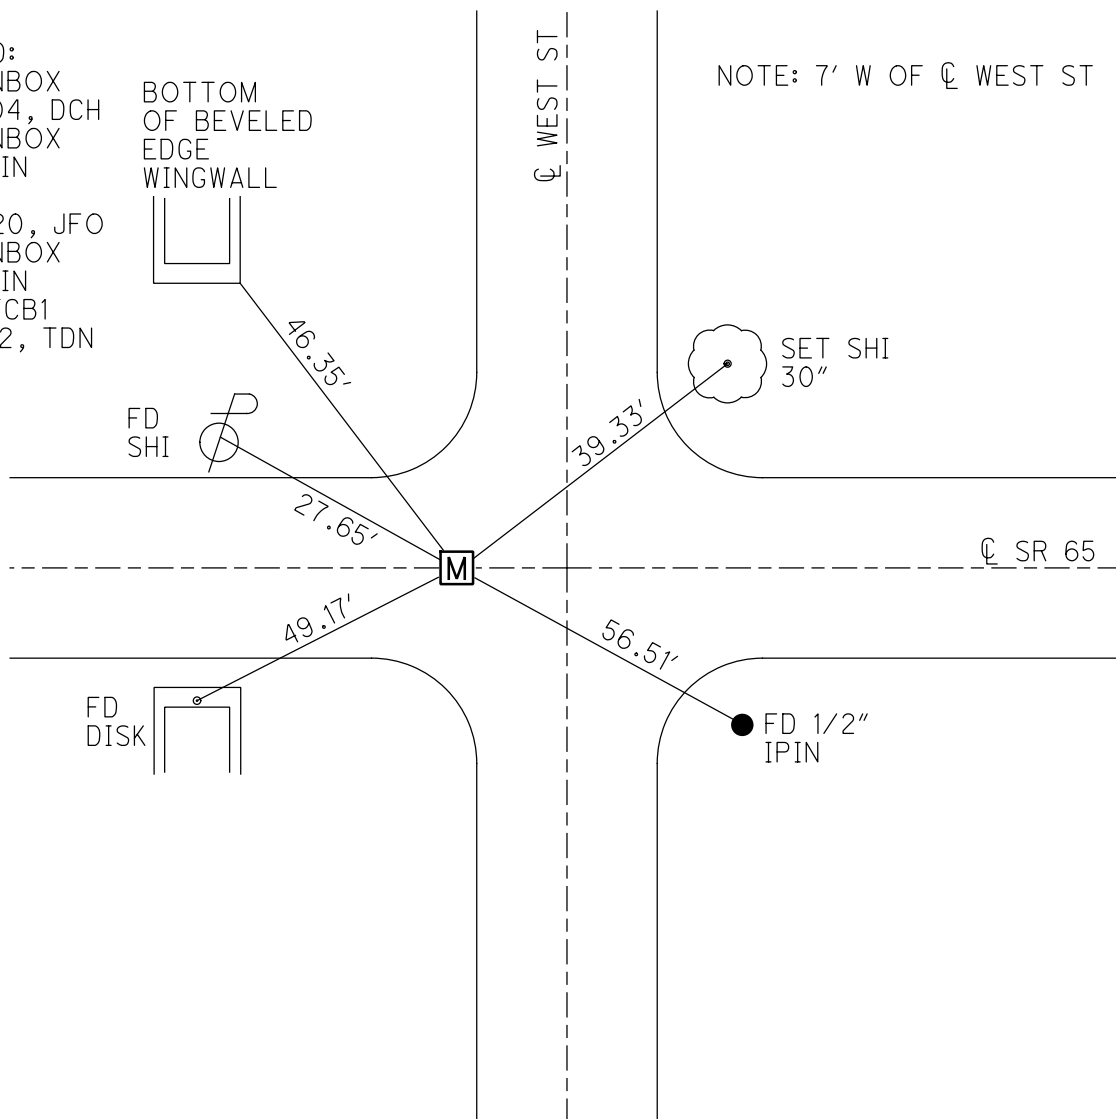

O.D.O.T. DISTRICT 2 SURVEY OFFICE (USE ONLY)

PERSONNEL

REFERENCE NO. 1 D

SHEET 8 OF 40

NOTES RHOADES

DATE 3/29/22

ROUTE SR 65H.C. NIESE

WEATHER CLEAR

COUNTY WOOD

R.C. KETNER

TEMP. 27°

TOWNSHIP GRAND RAPIDS

AUBLE, O'DONNELL

SECTION 7DWG BY RHOADES

PID 95796

T_5_N R_9_E

TYPE MONUMENT MAG/WASHER

ON SURFACE - ~~BELOW~~ ON

OFFSET @ PAVEMENT _____ ON _____ LT : RT _____


_____TO_____EDGE PAVEMENT

STATION: 42+24.3


HORZ.DATUM: NAD83 2011

GEOID: NAVD88 2018

GRID: NORTHING: 638514.780

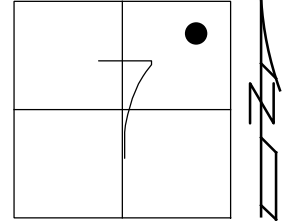EASTING: 1593246.624

RECORD:
SET P.K./WASHER
11-21-89, SWH
FD P.K.NAIL
1.5" DOWN
6/17/04, DCH
SET MAG/WASHER
9-20-04, RGN
FD MAG/WASHER
REFD1
10/28/20, JFO
SET MAG/WASHER
10/4/22, TDN

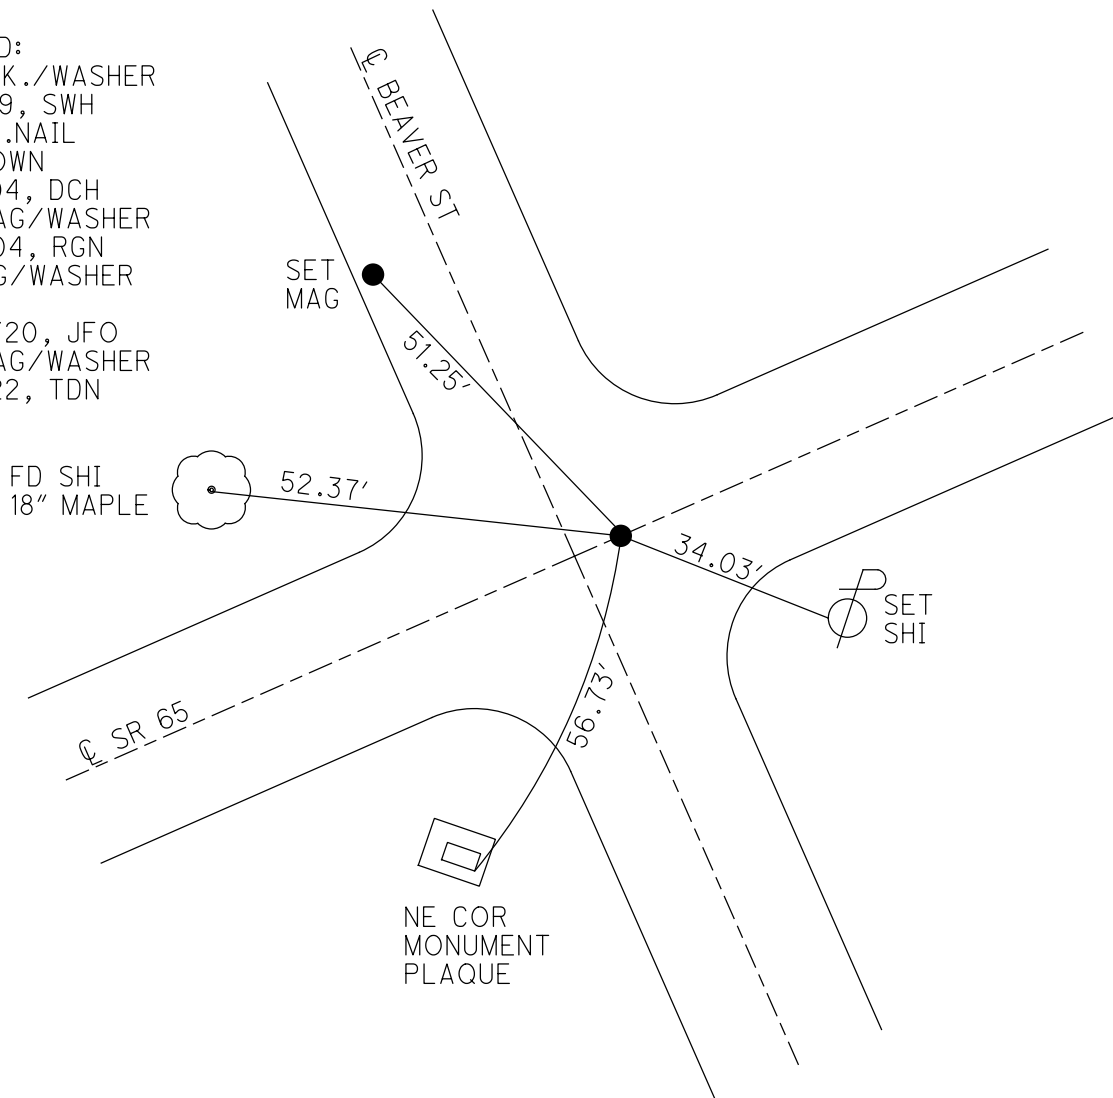

O.D.O.T. DISTRICT 2 SURVEY OFFICE (USE ONLY)

PERSONNEL

REFERENCE NO. 1 E

SHEET 9 OF 40

NOTES RHOADES

DATE 3/29/22

ROUTE SR 65

H.C. NIESE

WEATHER CLEAR

COUNTY WOOD

R.C. KETNER

TEMP. 27°

TOWNSHIP GRAND RAPIDS

AUBLE, O'DONNELL

SECTION 7

DWG BY RHOADES

PID 95796

T 5 N R 9 E

TYPE MONUMENT MAG/WASHER

ON SURFACE - ~~BELOW~~ ON

OFFSET Q PAVEMENT 1' LT : ~~RT~~

- TO - EDGE PAVEMENT


STATION: 47+97.24

HORIZ.DATUM: NAD83 2011


GEOID: NAVD88 2018

GRID: NORTHING: 638639.194

EASTING: 1593805.917

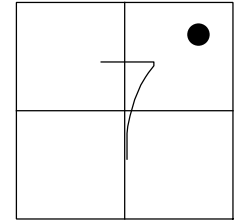

RECORD:
ORIGIN UNKNOWN
SET P.K./WASHER
11-21-89, SWH
FD HINGE NAIL
0.15' DOWN
6/24/04, DCH
SET MAG/WASHER
9-20-04, RGN
FD MAG/WASHER
REFE1
10/28/20, JFO
SET MAG/WASHER
10/4/22, TDN

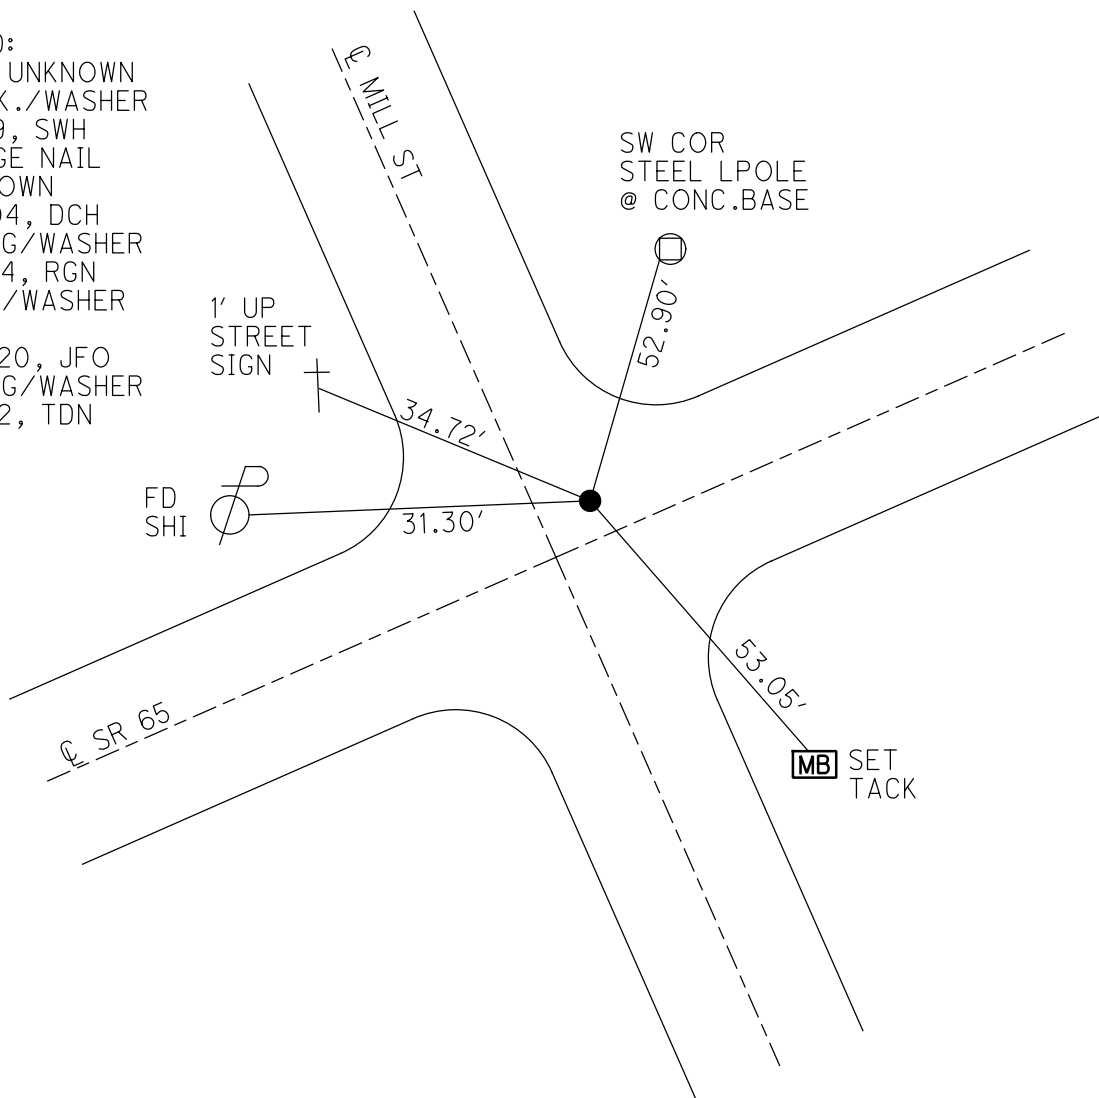

O.D.O.T. DISTRICT 2 SURVEY OFFICE (USE ONLY)

PERSONNEL

REFERENCE NO. 2

SHEET 10 OF 40

NOTES RHOADES

DATE 3/29/22

ROUTE SR 65

H.C. NIESE

WEATHER CLEAR

COUNTY WOOD

R.C. KETNER

TEMP. 27°

TOWNSHIP GRAND RAPIDS

AUBLE, O'DONNELL

SECTION 7

DWG BY RHOADES

PID 95796

T 5 N R 9 E

TYPE MONUMENT MAG/WASHER

ON SURFACE - ~~BELOW~~ ON

OFFSET CL PAVEMENT 3.3' ~~LT~~ : RT

- TO - EDGE PAVEMENT



STATION: 53+55.05

HORIZ.DATUM: NAD83 2011

GEOID: NAVD88 2018

GRID: NORTHING: 638761.425

EASTING: 1594350.258

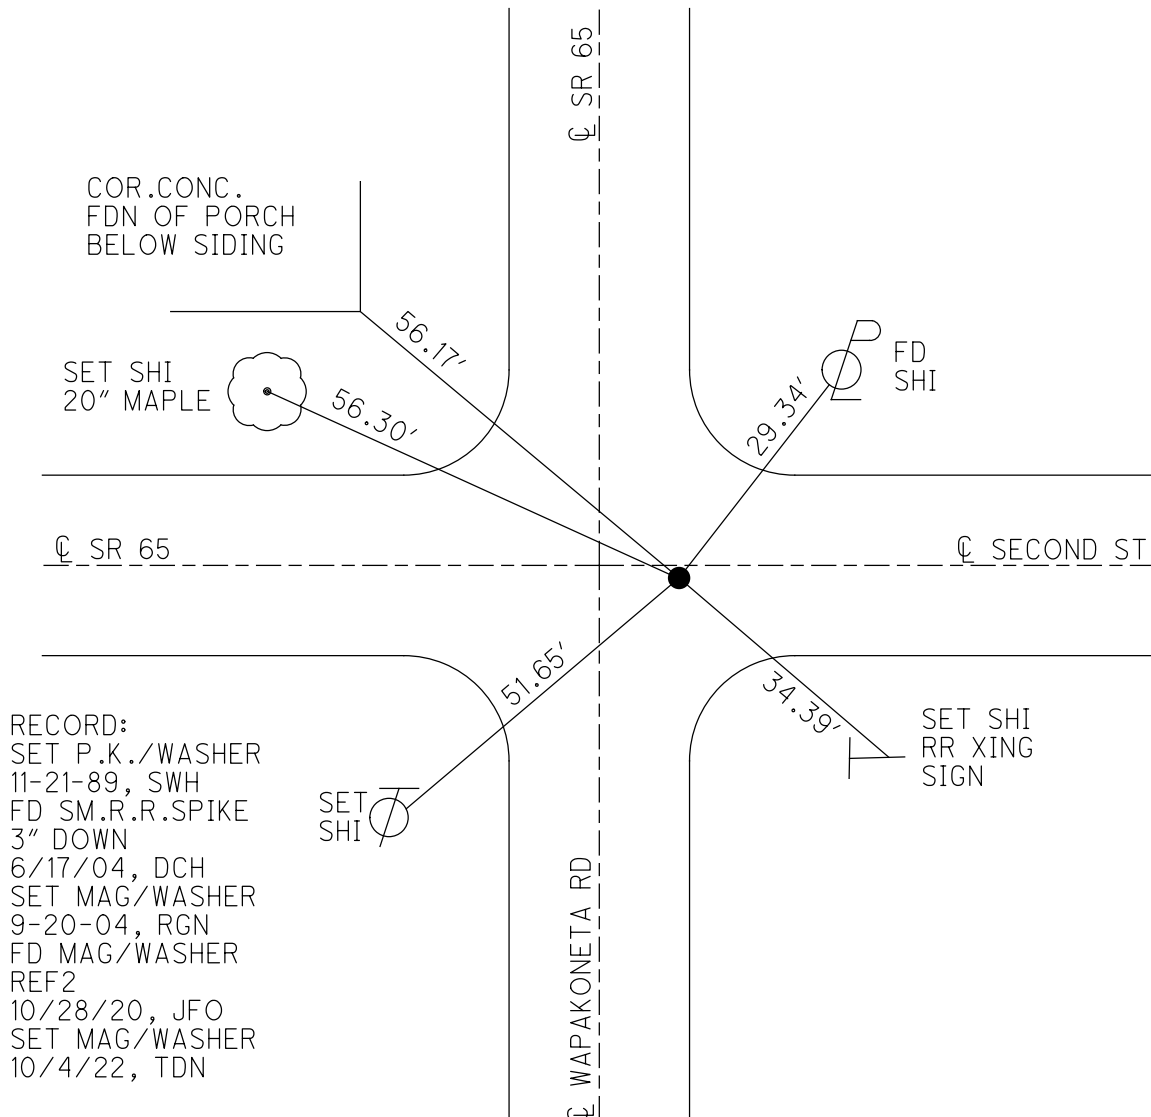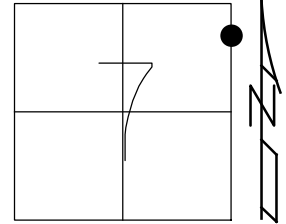

O.D.O.T. DISTRICT 2 SURVEY OFFICE (USE ONLY)

PERSONNEL

REFERENCE NO. 2468

SHEET 1 OF 2

NOTES RHOADES

DATE 4/12/22

ROUTE CR 189

H.C. NIESE

WEATHER SUNNY

COUNTY WOOD

R.C. KETNER

TEMP. 44°

TOWNSHIP GRAND RAPIDS

O'DONNELL

SECTION 7

DWG BY RHOADES PID 95796

T 5 N R 9 E

TYPE MONUMENT LG.R.R.SPIKE

~~ON SURFACE~~ - BELOW 4 1/2"

OFFSET 6' LT : ~~RT~~

- TO - EDGE PAVEMENT


STATION: 195+19.40

HORIZ.DATUM: NAD83 2011


GEOID: NAVD88 2018

GRID: NORTHING: 638359.071

EASTING: 1594349.742

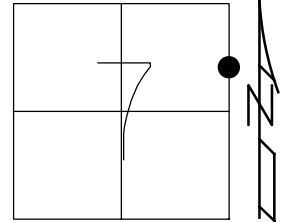

RECORD: P.I.
FD R.R.SPIKE
SV2468
FD LG.R.R.SPIKE
4 1/2" DOWN
SV2468
4/12/22, TDN
SET MAG/WASHER
10/4/22, TDN

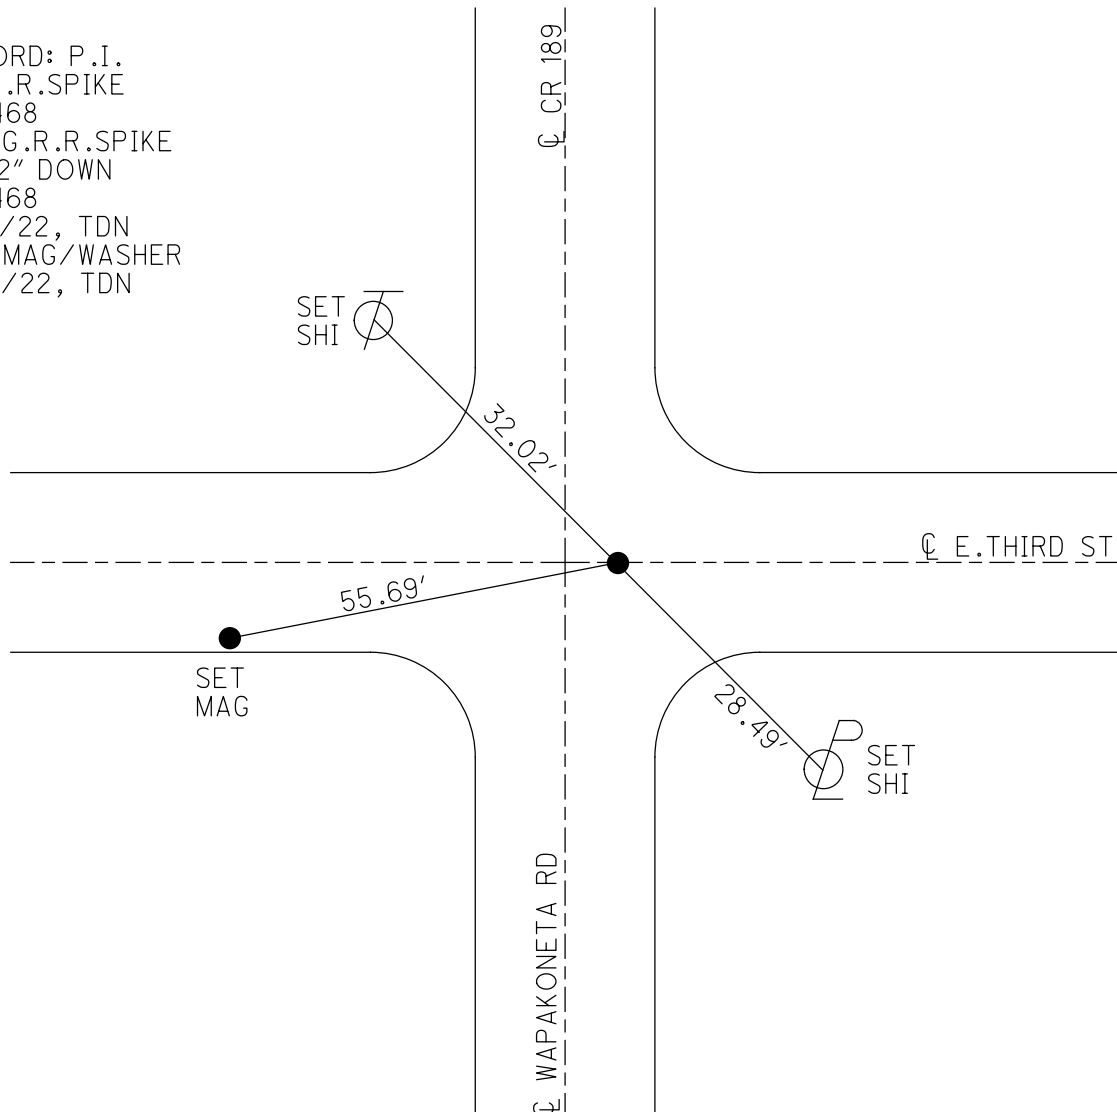

O.D.O.T. DISTRICT 2 SURVEY OFFICE (USE ONLY)

PERSONNEL

REFERENCE NO. 1957

SHEET 2 OF 2

NOTES RHOADES

DATE 4/12/22

ROUTE CR 189

H.C. NIESE

WEATHER SUNNY

COUNTY WOOD

R.C. KETNER

TEMP. 44°

TOWNSHIP GRAND RAPIDS

O'DONNELL

SECTION 7

DWG BY RHOADES PID 95796

T 5 N R 9 E

TYPE MONUMENT 1 1/4" IPIPE

~~ON SURFACE~~ - BELOW 5"

OFFSET CL PAVEMENT 12' LT : ~~RT~~

ON TO RT EDGE BERM


STATION: 185+60.58

HORZ.DATUM: NAD83 2011

GEOID: NAVD88 2018

GRID: NORTHING: 637399.879

EASTING: 1594349.423

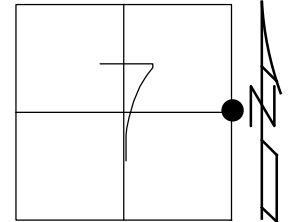

RECORD: P.I.
FD IPIPE
SV1957
FD 1 1/4" IPIPE
5" DOWN
BENT NORTHERNLY
SHOT @ BENT
SV1957
4/12/22
10/4/22, TDN

SET SHI
40" MAPLE



62.49'

SET
SHI



45.95'

59.95'



SET
SHI

CL CR 189

CL WAPAKONETA RD

O.D.O.T. DISTRICT 2 SURVEY OFFICE (USE ONLY)

PERSONNEL

REFERENCE NO. 2 A

SHEET 11 OF 40

NOTES O'DONNELL

DATE 10/30/20

ROUTE SR 65

H.C. AUBLE

WEATHER CLOUDY

COUNTY WOOD

R.C. O'DONNELL

TEMP. 38°

TOWNSHIP GRAND RAPIDS

SECTION 7

DWG BY RHOADES

PID 95796

T 5 N R 9 E

TYPE MONUMENT P.K.SHANK

ON SURFACE - ~~BELOW~~ ON

OFFSET CL PAVEMENT 1.1' LT : ~~RT~~

- TO - EDGE PAVEMENT



STATION: 57+65.30

HORIZ.DATUM: NAD83 2011

GEOID: NAVD88 2018

GRID: NORTHING: 639165.232

EASTING: 1594350.682

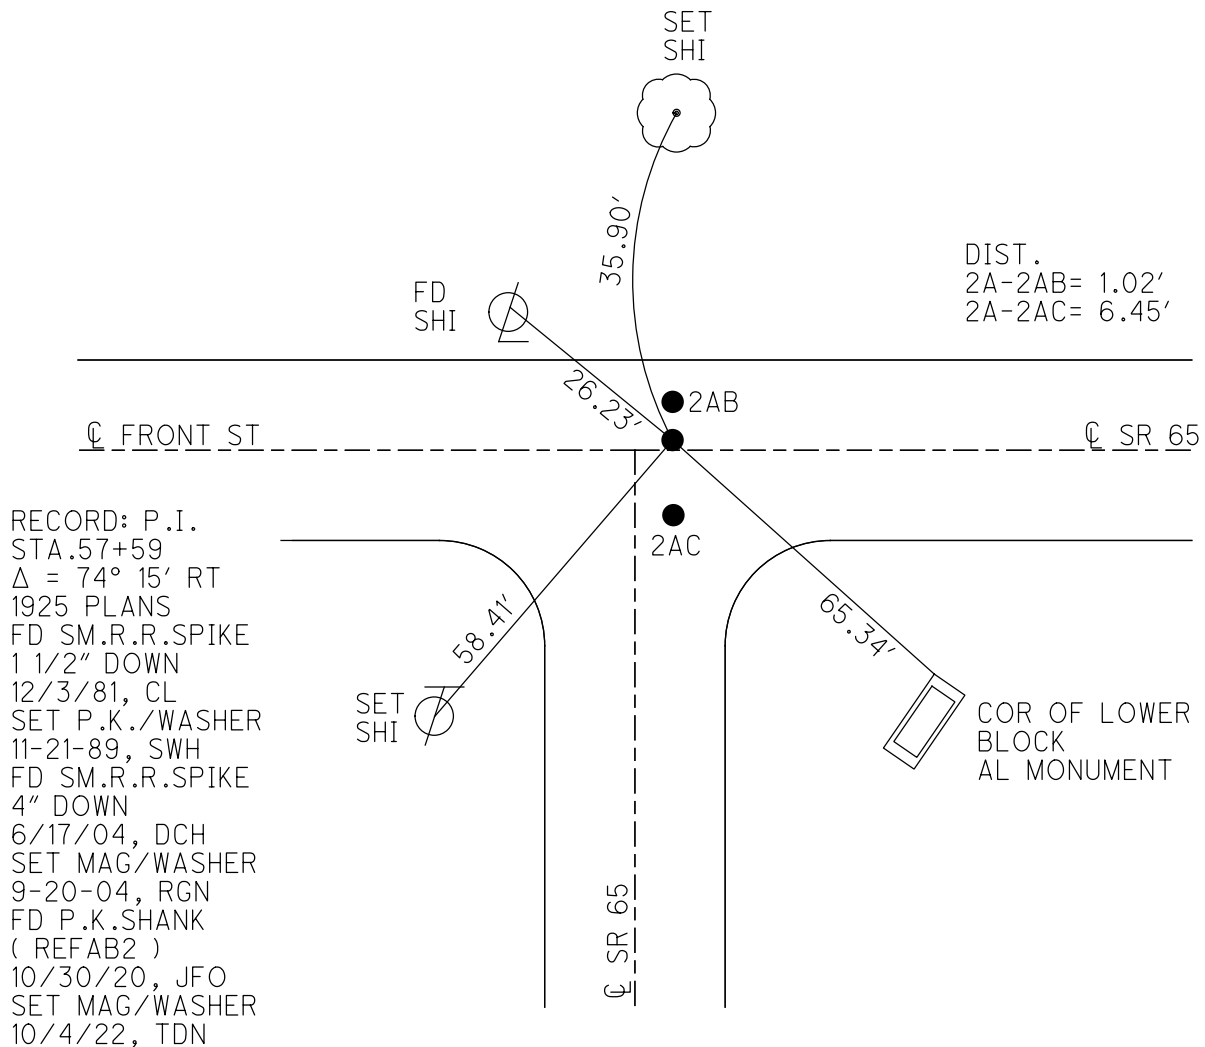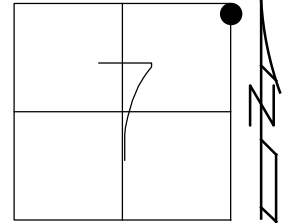

O.D.O.T. DISTRICT 2 SURVEY OFFICE (USE ONLY)

PERSONNEL

REFERENCE NO. 2 AB

SHEET 12 OF 40

NOTES O'DONNELL

DATE 10/30/20

ROUTE SR 65

H.C. AUBLE

WEATHER CLOUDY

COUNTY WOOD

R.C. O'DONNELL

TEMP. 38°

TOWNSHIP GRAND RAPIDS

DWG BY RHOADES

PID 95796

SECTION 7

T 5 N R 9 E

TYPE MONUMENT HOLE

~~ON SURFACE~~ - BELOW 6"

OFFSET CL PAVEMENT 2.1' LT : ~~RT~~

- TO - EDGE PAVEMENT



STATION: 57+65

HORZ.DATUM: NAD83 2011

GEOID: NAVD88 2018

GRID: NORTHING: 639172.676

EASTING: 1594350.662

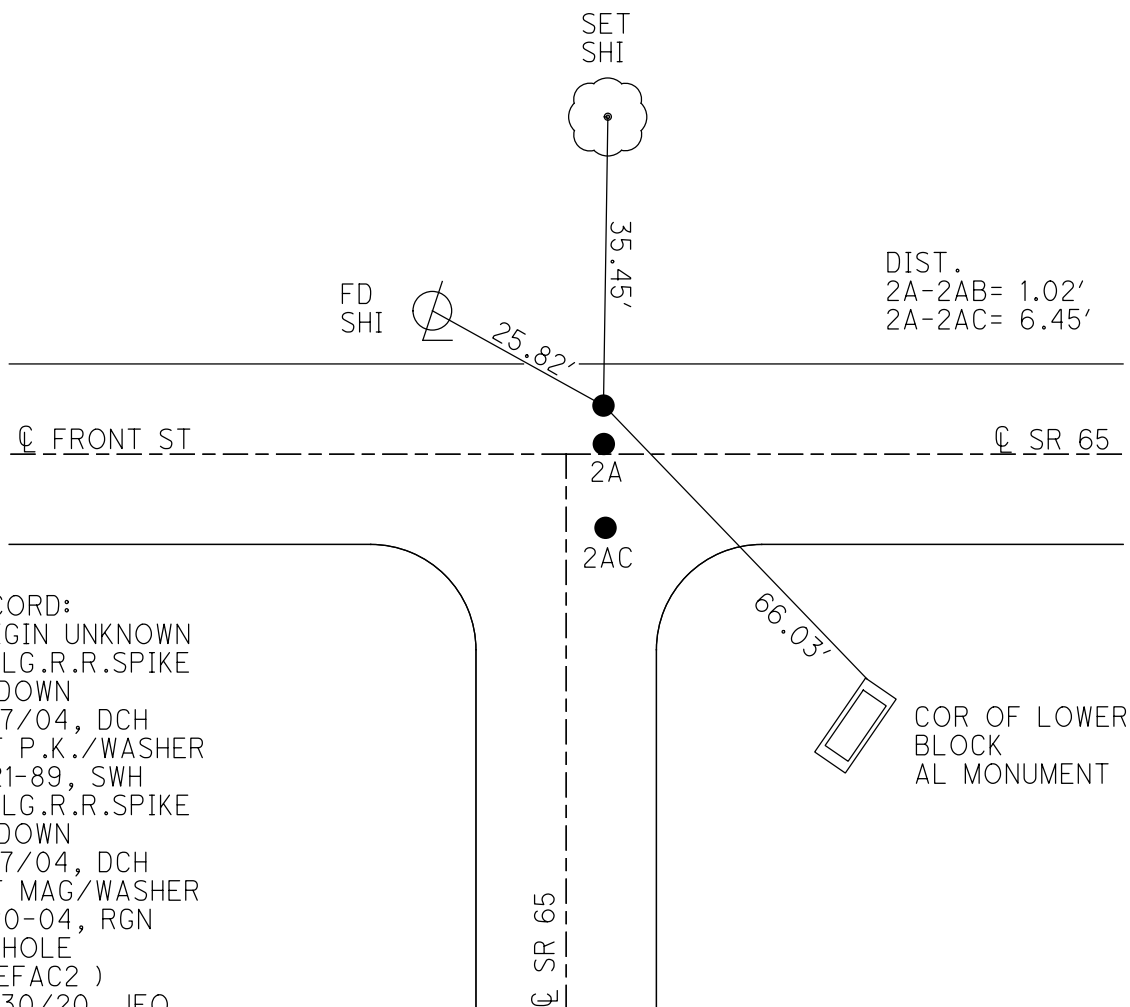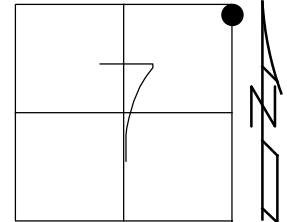

RECORD:
ORIGIN UNKNOWN
FD LG.R.R.SPIKE
4" DOWN
6/17/04, DCH
SET P.K./WASHER
11-21-89, SWH
FD LG.R.R.SPIKE
4" DOWN
6/17/04, DCH
SET MAG/WASHER
9-20-04, RGN
FD HOLE
(REFAC2)
10/30/20, JFO
SET MAG/WASHER
10/4/22, TDN

COR OF LOWER
BLOCK
AL MONUMENT

O.D.O.T. DISTRICT 2 SURVEY OFFICE (USE ONLY)

PERSONNEL

REFERENCE NO. 2 AC

SHEET 13 OF 40

NOTES O'DONNELL

DATE 10/30/20

ROUTE SR 65

H.C. AUBLE

WEATHER CLOUDY

COUNTY WOOD

R.C. O'DONNELL

TEMP. 38°

TOWNSHIP GRAND RAPIDS

DWG BY RHOADES

PID 95796

SECTION 7

T 5 N R 9 E

TYPE MONUMENT P.K.SHANK

ON SURFACE - ~~BELOW~~ ON

OFFSET CL PAVEMENT 5.33' ~~LT~~ : RT

- TO - EDGE PAVEMENT


STATION: 57+65

HORZ.DATUM: NAD83 2011


GEOID: NAVD88 2018

GRID: NORTHING: 639165.232

EASTING: 1594350.682

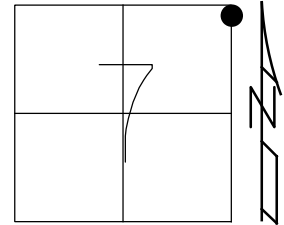


RECORD:
ORIGIN UNKNOWN
FD LG.R.R.SPIKE
4" DOWN
6/17/04, DCH
SET P.K./WASHER
11-21-89, SWH
FD LG.R.R.SPIKE
4" DOWN
6/17/04, DCH
SET MAG/WASHER
9-20-04, RGN
FD P.K.SHANK
(REFA2)
10/30/20, JFO
SET MAG/WASHER
10/4/22, TDN

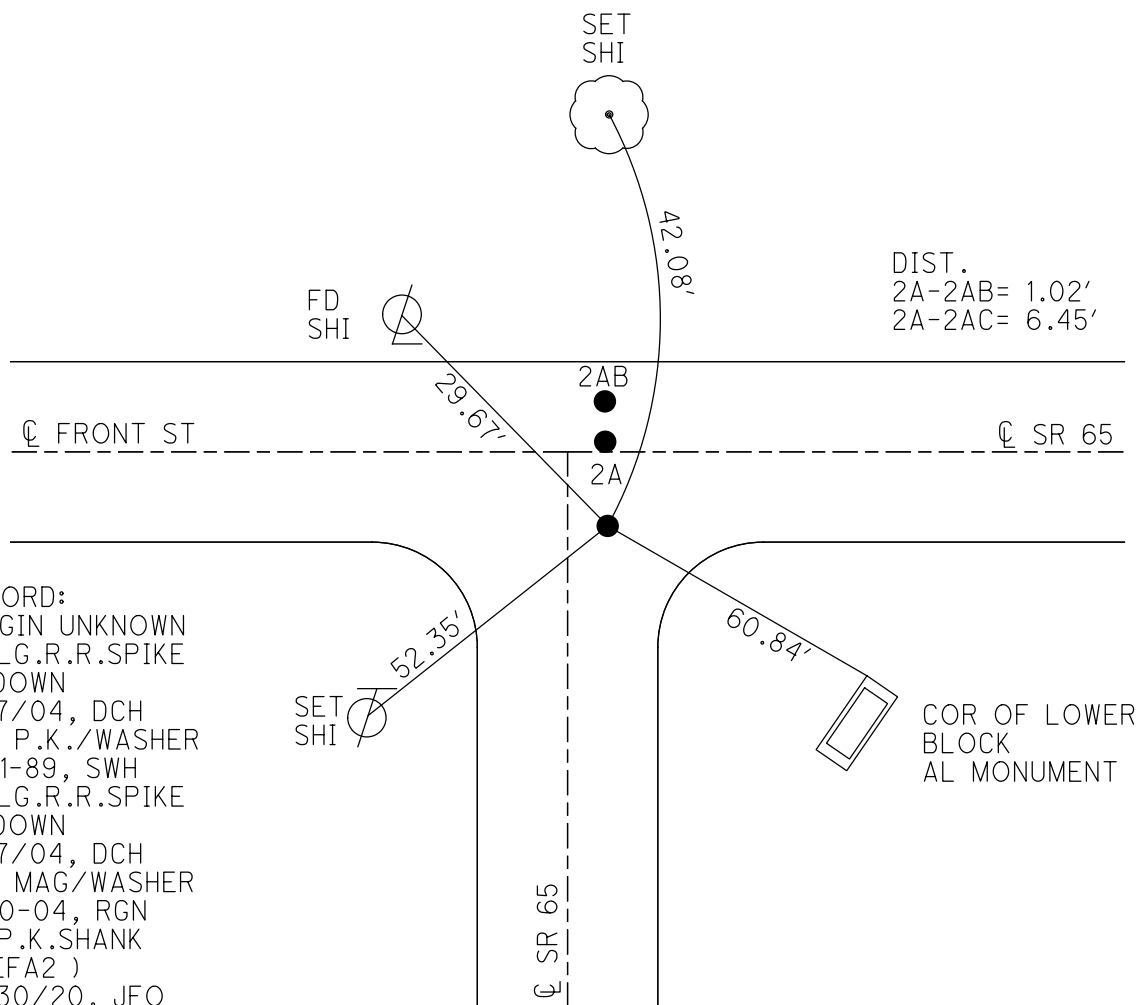

O.D.O.T. DISTRICT 2 SURVEY OFFICE (USE ONLY)


PERSONNEL _____ REFERENCE NO. 2 AD SHEET 14 OF 40
NOTES RHOADES DATE 4/22/20 ROUTE SR 65
H.C. O'DONNELL WEATHER CLOUDY COUNTY WOOD
R.C. RHOADES TEMP. 39° TOWNSHIP GRAND RAPIDS
SECTION 8
DWG BY RHOADES PID 95796 T 5 N R 9 E

TYPE MONUMENT X-ING TIES
ON SURFACE - ~~BELOW~~ ON
OFFSET CL PAVEMENT 12.5' LT : ~~RT~~
1' LT TO LT EDGE PAVEMENT
STATION: 60+93.68

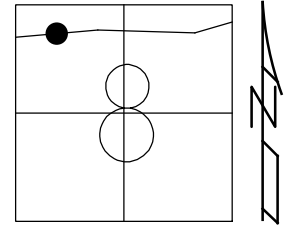

HORZ.DATUM: NAD83 2011 GEOID: NAVD88 2018
GRID: NORTHING: 639259.664 EASTING: 1594670.539

RECORD:
FD "+" CUT IN OLD
CONCRETE PVMT
5" DOWN
9/7/89, CL
FD X-ING TIES
REFAD2
4/22/00, JFO

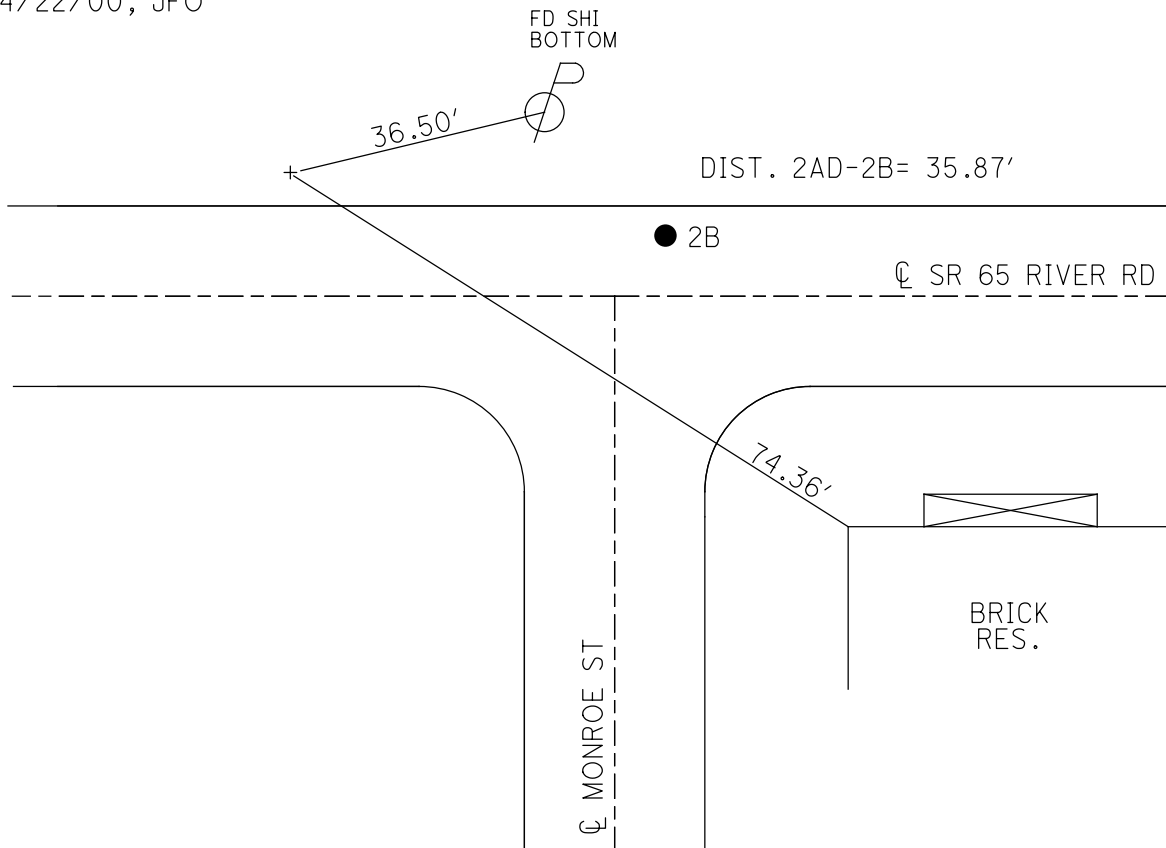


O.D.O.T. DISTRICT 2 SURVEY OFFICE (USE ONLY)


PERSONNEL _____ REFERENCE NO. 2 B SHEET 15 OF 40
 NOTES RHOADES DATE 4/22/20 ROUTE SR 65
 H.C. O'DONNELL WEATHER CLOUDY COUNTY WOOD
 R.C. RHOADES TEMP. 39° TOWNSHIP GRAND RAPIDS
 SECTION 8
 DWG BY O'DONNELL PID 95796 T 5 N R 9 E

TYPE MONUMENT MAG/WASHER
 ON SURFACE - ~~BELOW~~ ON
 OFFSET Q PAVEMENT 6.2' LT : ~~RT~~
2.8' TO LT EDGE PAVEMENT
 STATION: 61+29.55

HORZ.DATUM: NAD83 2011 GEOID: NAVD88 2018
 GRID: NORTHING: 639255.002 EASTING: 1594706.142

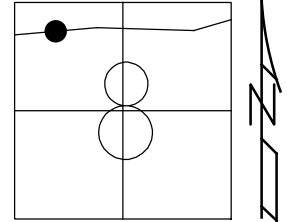

RECORD: P.I.
 $\Delta = 21^\circ 56' RT$
 SET P.K./WASHER
 11-21-89, SWH
 FD P.K./WASHER
 6-18-04, DCH
 SET MAG/WASHER
 9-20-04, RGN
 FD MAG NAIL
 REFB2
 3-10-15, EBW
 FD MAG/WASHER
 REFB2
 4-22-20, JFO
 SET MAG/WASHER
 10/4/22, TDN

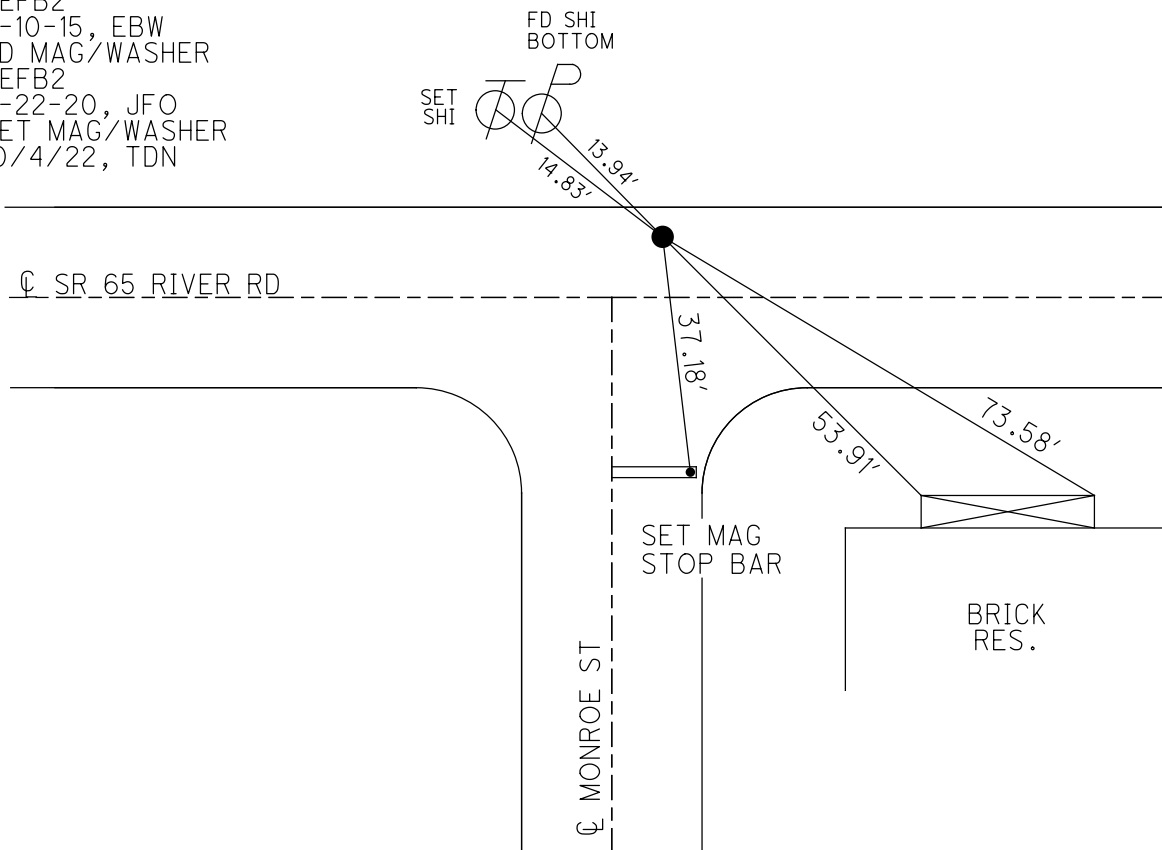

O.D.O.T. DISTRICT 2 SURVEY OFFICE (USE ONLY)

PERSONNEL

REFERENCE NO. 3

SHEET 16 OF 40

NOTES RHOADES

DATE 3/29/22

ROUTE SR 65

H.C. NIESE

WEATHER CLEAR

COUNTY WOOD

R.C. KETNER

TEMP. 27°

TOWNSHIP GRAND RAPIDS

AUBLE, O'DONNELL

SECTION 8

DWG BY RHOADES

PID 95796

T 5 N R 9 E

TYPE MONUMENT MAG SHANK

~~ON SURFACE~~ - BELOW 1"

OFFSET CL PAVEMENT 1' ~~LT~~ : RT

- TO - EDGE PAVEMENT


STATION: 65+90.32

HORIZ.DATUM: NAD83 2011


GEOID: NAVD88 2018

GRID: NORTHING: 639202.156

EASTING: 1595163.575

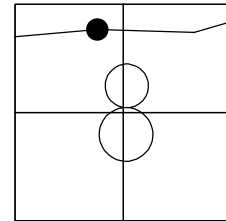

RECORD:
SET P.K./WASHER
11-21-89, SWH
FD P.K./WASHER
6-18-04, DCH
SET MAG/WASHER
9-20-04, RGN
SET MAG/WASHER
REF3
3-10-15, EBW
FD MAG SHANK
1" DOWN
RECREP3
10/28/20, JFO
SET MAG/WASHER
10/4/22, TDN

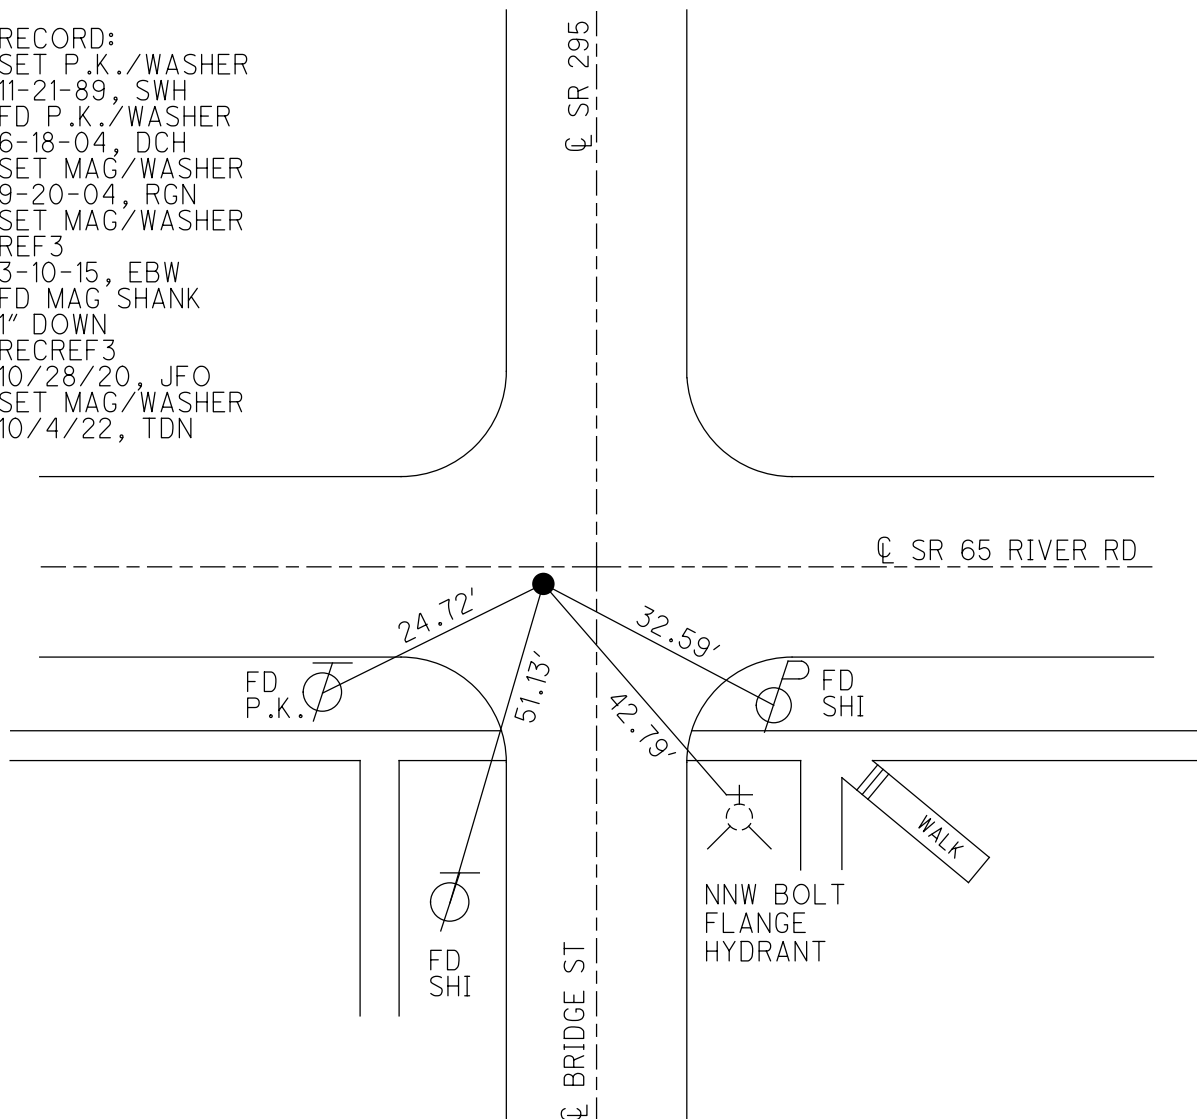

O.D.O.T. DISTRICT 2 SURVEY OFFICE (USE ONLY)

PERSONNEL

REFERENCE NO. 3 A

SHEET 17 OF 40

NOTES _____ RHOADES

DATE 3/29/22

ROUTE SR 65H.C. NIESE

WEATHER CLEAR

COUNTY WOOD

R.C. KETNER

TEMP. 27°

TOWNSHIP GRAND RAPIDS

AUBLE, O'DONNELL

SECTION

DWG BY RHOADESPID 95796

T_5_N R_9_E

TYPE MONUMENT MAG NAIL

~~ON SURFACE~~ - BELOW 3 1/2"

OFFSET $\odot$ PAVEMENT 2.4' ~~LT~~ : RT


7.5' TO RT EDGE PAVEMENT

STATION: 68+03.68


HORZ.DATUM: NAD83 2011

GEOID: NAVD88 2018

GRID: NORTHING: 639177.637

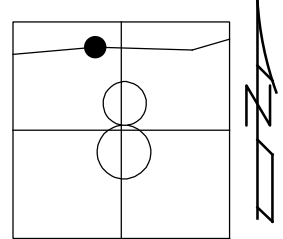EASTING: 1595375.520

RECORD: P.I.
Δ = 0° 37' LT
FD LG. R.R. SPIKE
6-18-04, DCH
FD LG.R.R.SPIKE
6/18/04, DCH
SET MAG/WASHER
9-20-04, RGN
FD MAG NAIL
REFA3
3-10-15, EBW
10/28/20, JFO
SET MAG/WASHER
10/4/22, TDN

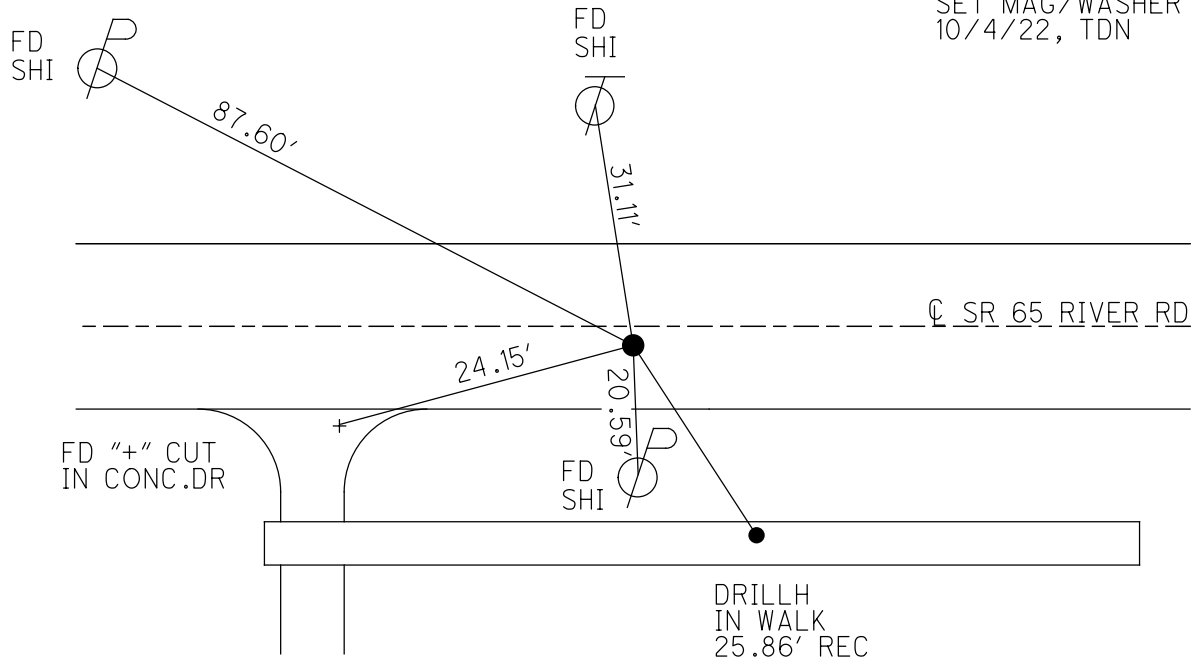

O.D.O.T. DISTRICT 2 SURVEY OFFICE (USE ONLY)

PERSONNEL

REFERENCE NO. 3 B

SHEET 18 OF 40

NOTES RHOADES

DATE 3/29/22

ROUTE SR 65

H.C. NIESE

WEATHER CLEAR

COUNTY WOOD

R.C. KETNER

TEMP. 27°

TOWNSHIP GRAND RAPIDS

AUBLE, O'DONNELL

SECTION 8

DWG BY RHOADES

PID 95796

T 5 N R 9 E

TYPE MONUMENT MAG/WASHER

ON SURFACE - ~~BELOW~~ ON

OFFSET CL PAVEMENT 0.5' LT : RT

10.4' TO LT EDGE PAVEMENT


STATION: 76+25.87

HORZ.DATUM: NAD83 2011

GEOID: NAVD88 2018

GRID: NORTHING: 639091.829

EASTING: 1596193.224

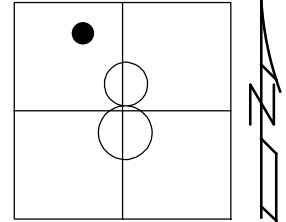

RECORD:

FD P.K./WASHER

6/18/04, DCH

SET MAG/WASHER

9-20-04, RGN


FD MAG/WASHER

REFB3

11/2/20, JFO

SET MAG/WASHER

10/5/22, TDN

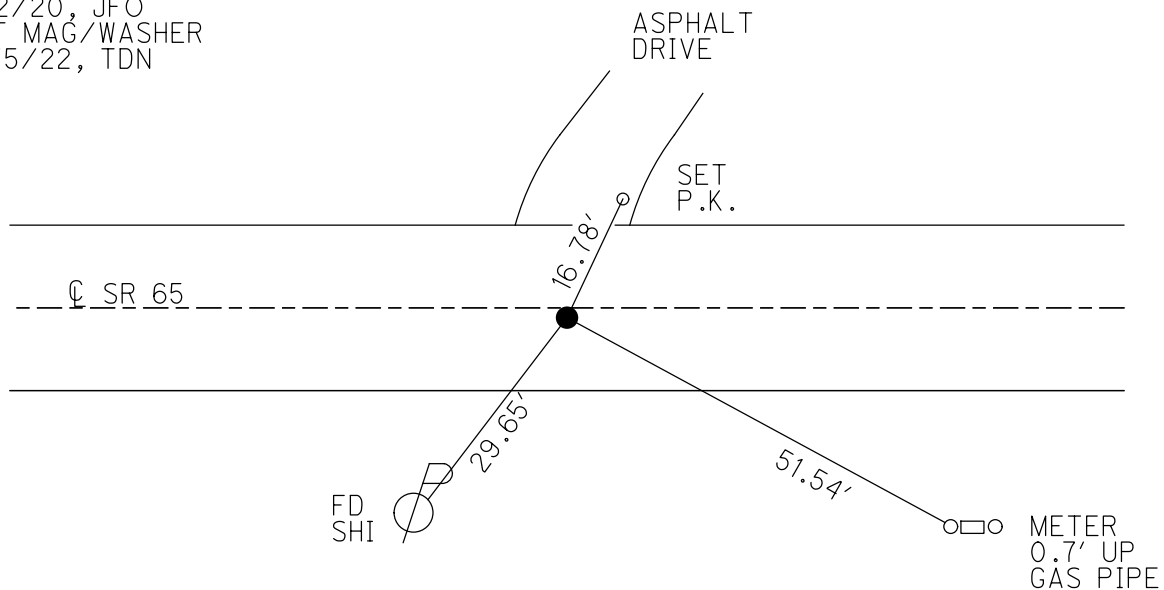

O.D.O.T. DISTRICT 2 SURVEY OFFICE (USE ONLY)

PERSONNEL

REFERENCE NO. 3 C

SHEET 19 OF 40

NOTES RHOADES

DATE 3/29/22

ROUTE SR 65

H.C. NIESE

WEATHER CLEAR

COUNTY WOOD

R.C. KETNER

TEMP. 27°

TOWNSHIP GRAND RAPIDS

AUBLE, O'DONNELL

SECTION 8

DWG BY RHOADES

PID 95796

T 5 N R 9 E

TYPE MONUMENT MAG/WASHER

ON SURFACE - ~~BELOW~~ ON

OFFSET 0.5' LT : RT

10.4' TO LT EDGE PAVEMENT


STATION: 79+30.73

HORZ.DATUM: NAD83 2011


GEOID: NAVD88 2018

GRID: NORTHING: 639059.832

EASTING: 1596496.419

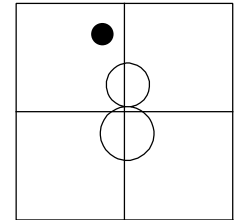

RECORD:
SET P.K./WASHER
11-21-89, SWH
FD P.K./WASHER
6/18/04, DCH
SET MAG/WASHER
9-20-04, RGN
FD MAG NAIL
REFC3
11/2/20, JFO
SET MAG/WASHER
10/5/22, TDN

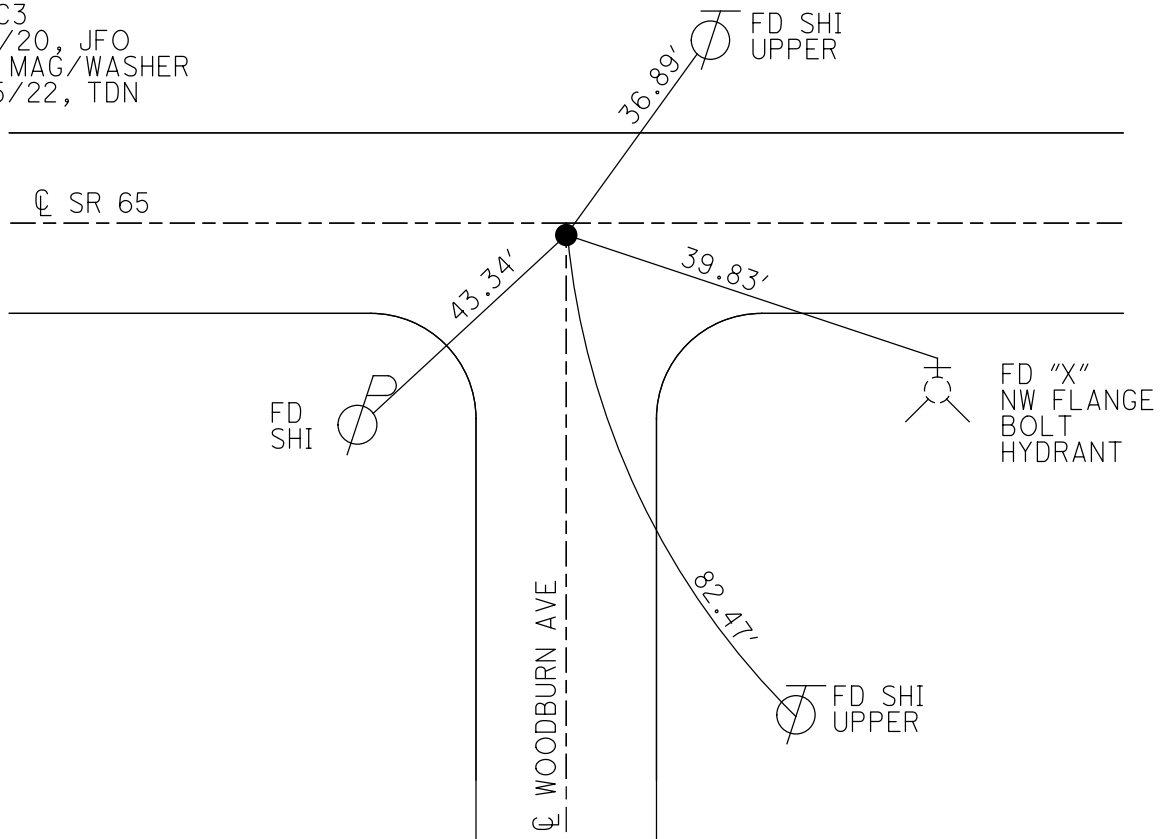

O.D.O.T. DISTRICT 2 SURVEY OFFICE (USE ONLY)

PERSONNEL

REFERENCE NO. 3 D

SHEET 20 OF 40

NOTES RHOADES DATE 3/28/22
H.C. NIESE WEATHER CLEAR
R.C. KETNER TEMP. 28°
AUBLE, O'DONNELL

ROUTE SR 65
COUNTY WOOD
TOWNSHIP GRAND RAPIDS
SECTION 8
T 5 N R 9 E

DWG BY RHOADES PID 95796

TYPE MONUMENT MAG/WASHER

ON SURFACE - ~~BELOW~~ ON

OFFSET CL PAVEMENT 1.5' ~~LT~~ : RT

9.8' TO RT EDGE PAVEMENT


STATION: 80+32.9

HORIZ.DATUM: NAD83 2011

GEOID: NAVD88 2018


GRID: NORTHING: 639049.263

EASTING: 1596598.022

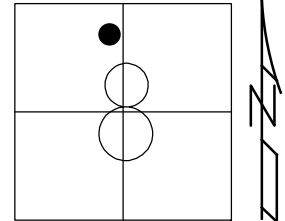

RECORD: P.C.
STA.12+30.24
1931 PLAN
 $\Delta = 34^\circ 52'$
FD P.K./WASHER
6/18/04, DCH
SET MAG/WASHER
9-20-04, RGN
FD MAG/WASHER
REFD3
3/28/22, JFO
SET MAG/WASHER
10/5/22, TDN

DIST.3D-3E= 10.16'

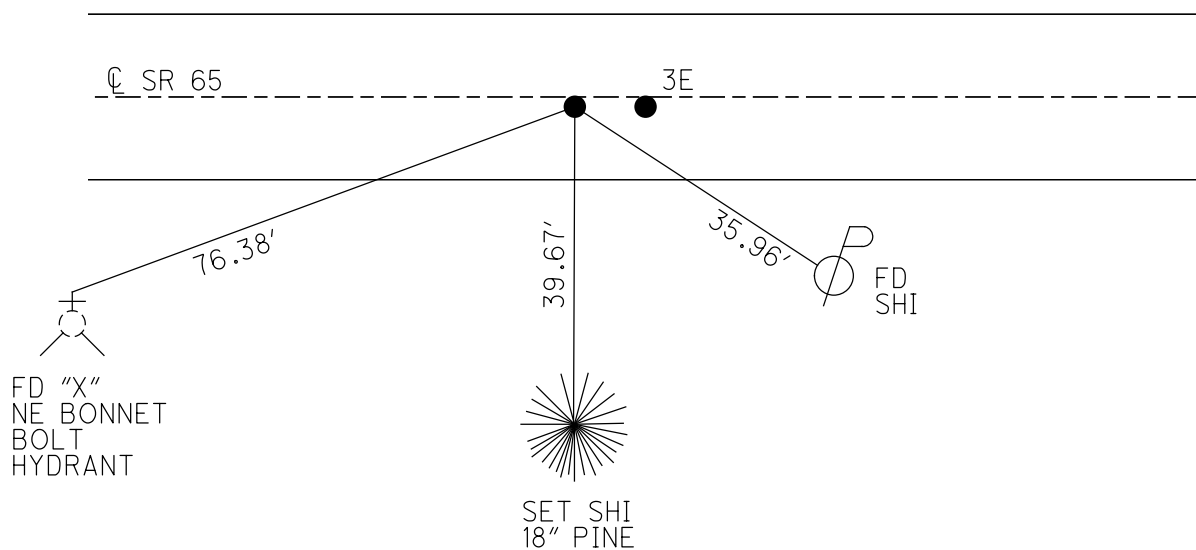

O.D.O.T. DISTRICT 2 SURVEY OFFICE (USE ONLY)

PERSONNEL

REFERENCE NO. 3 E

SHEET 21 OF 40

NOTES RHOADES

DATE 3/28/22

ROUTE SR 65

H.C. NIESE

WEATHER CLEAR

COUNTY WOOD

R.C. KETNER

TEMP. 28°

TOWNSHIP GRAND RAPIDS

AUBLE, O'DONNELL

SECTION 8

DWG BY RHOADES

PID 95796

T 5 N R 9 E

TYPE MONUMENT MAG NAIL

ON SURFACE - ~~BELOW~~ ON

OFFSET Q PAVEMENT 1.5' ~~LT~~ : RT

9.8' TO RT EDGE PAVEMENT


STATION: 80+43.1

HORZ.DATUM: NAD83 2011

GEOID: NAVD88 2018


GRID: NORTHING: 639048.240

EASTING: 1596608.176

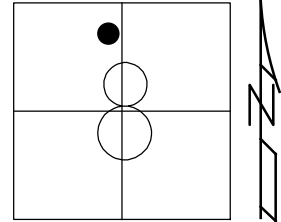

RECORD:

FD P.K./WASHER
6/18/04, DCH
SET MAG/WASHER
9-20-04, RGN
FD MAG NAIL
REFE3
11/2/20, JFO
SET MAG/WASHER
10/5/22, TDN

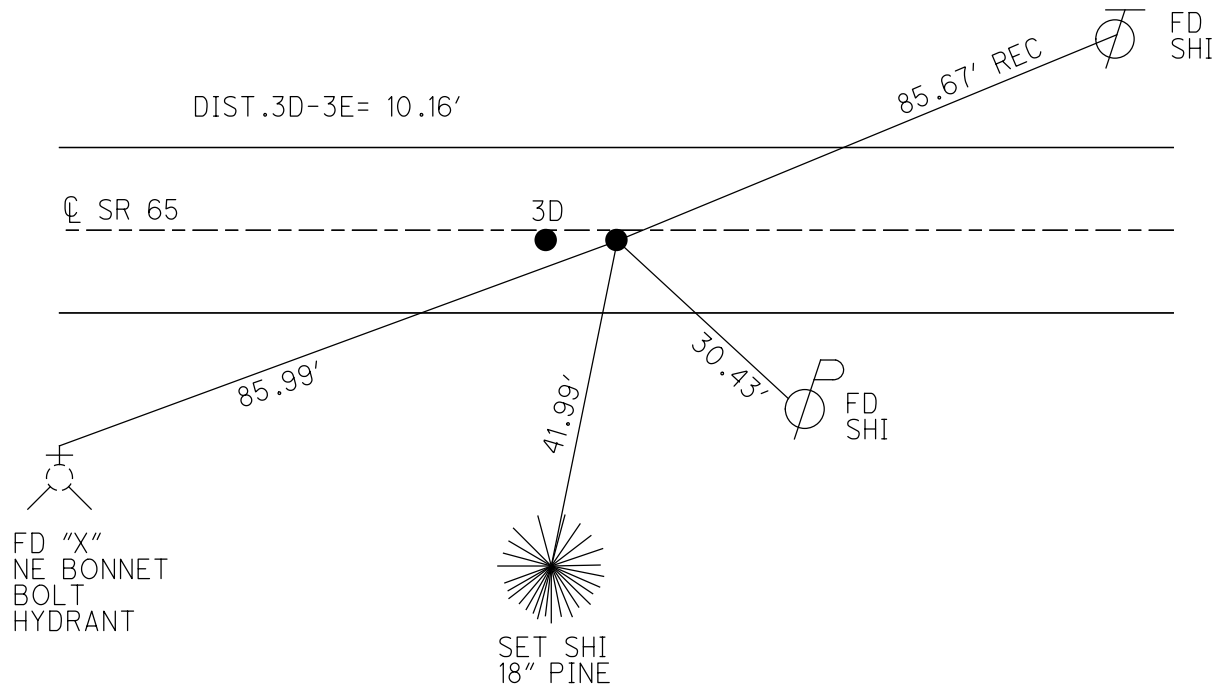

O.D.O.T. DISTRICT 2 SURVEY OFFICE (USE ONLY)

PERSONNEL

REFERENCE NO. 4

SHEET 22 OF 40

NOTES _____ RHOADES

DATE 3/29/22

ROUTE SR 65H.C. NIESE

WEATHER CLEAR

COUNTY WOOD

R.C. KETNER

TEMP. 27°

TOWNSHIP GRAND RAPIDS

AUBLE, O'DONNELL

SECTION 8DWG BY RHOADES

PID 95796

T_5_N R_9_E

TYPE MONUMENT MAG/WASHER

ON SURFACE - ~~BELOW~~ ON

OFFSET C PAVEMENT 1' ~~LT~~ : RT



10.5' TO LT EDGE PAVEMENT

STATION: 84+53.5

HORZ.DATUM: NAD83 2011

GEOID: NAVD88 2018

GRID: NORTHING: 639082.447

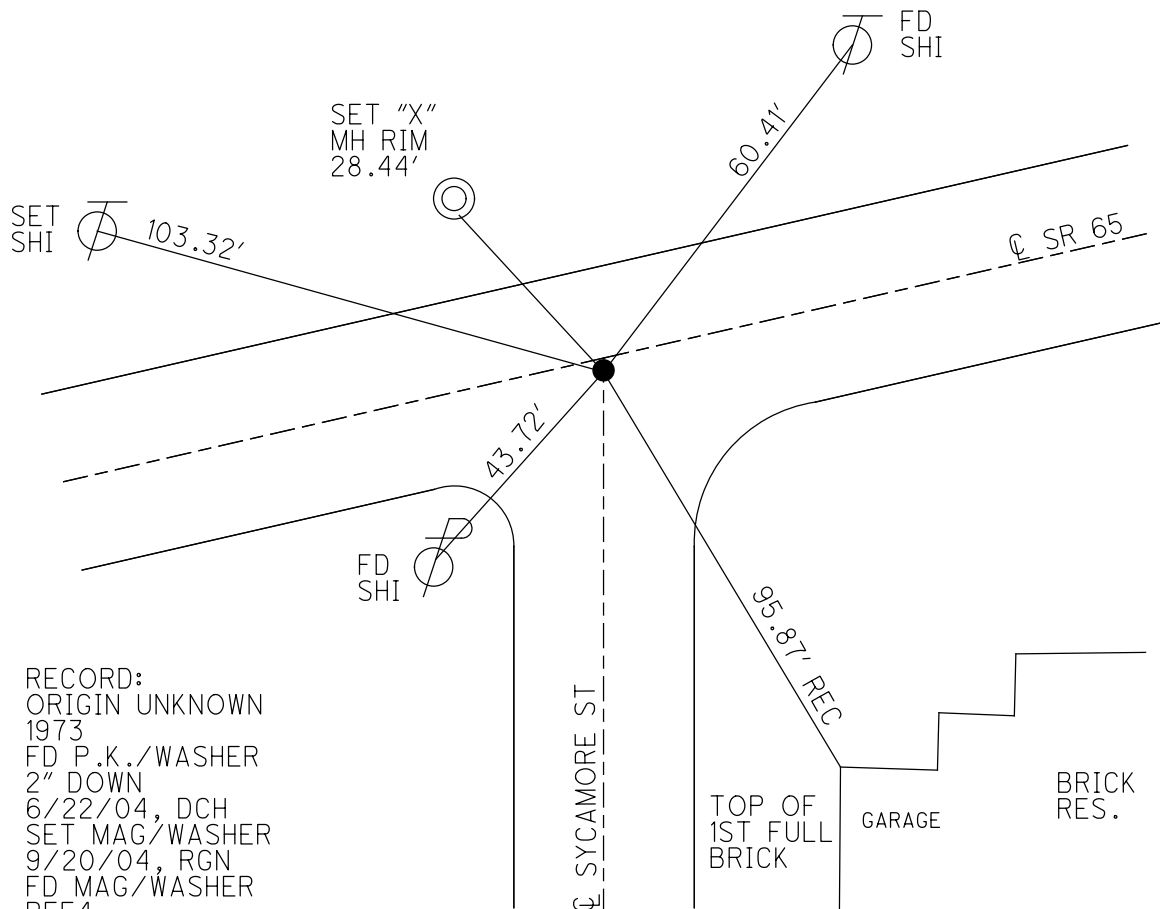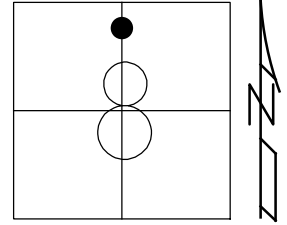EASTING: 1597014.875

RECORD:

ORIGIN UNKNOWN
1973

FD P.K./WASHER
2" DOWN

6/22/04, DCH

SET MAG/WASHER

9/20/04, RGN
ED, MAG/WACUE

FD MAG/WASHER
REF 4

REF 4
11/2/20 JFO

SET MAG/WASHER

10/5/22, TDN

O.D.O.T. DISTRICT 2 SURVEY OFFICE (USE ONLY)

PERSONNEL

REFERENCE NO. 4 A

SHEET 23 OF 40

NOTES RHOADES

DATE 3/29/22

ROUTE SR 65

H.C. NIESE

WEATHER CLEAR

COUNTY WOOD

R.C. AUBLE

TEMP. 35°

TOWNSHIP GRAND RAPIDS

KETNER, O'DONNELL

SECTION 8

DWG BY RHOADES

PID 95796

T 5 N R 9 E

TYPE MONUMENT MAG/WASHER

ON SURFACE - ~~BELOW~~ ON

OFFSET Q PAVEMENT 1.5' ~~LT~~ : RT

9.7' TO RT EDGE PAVEMENT


STATION: 87+30.48

HORZ.DATUM: NAD83 2011


GEOID: NAVD88 2018

GRID: NORTHING: 639185.327

EASTING: 1597271.270

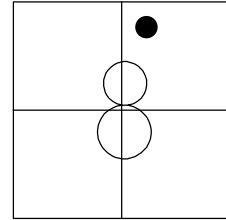

RECORD: P.C.C.
STA. 19+27.77
1931 PLANS
FD P.K./WASHER
6/22/04, DCH
SET MAG/WASHER
9/20/04, RGN
FD MAG/WASHER
REFA4
11/2/20, JFO
SET MAG/WASHER
10/5/22, TDN

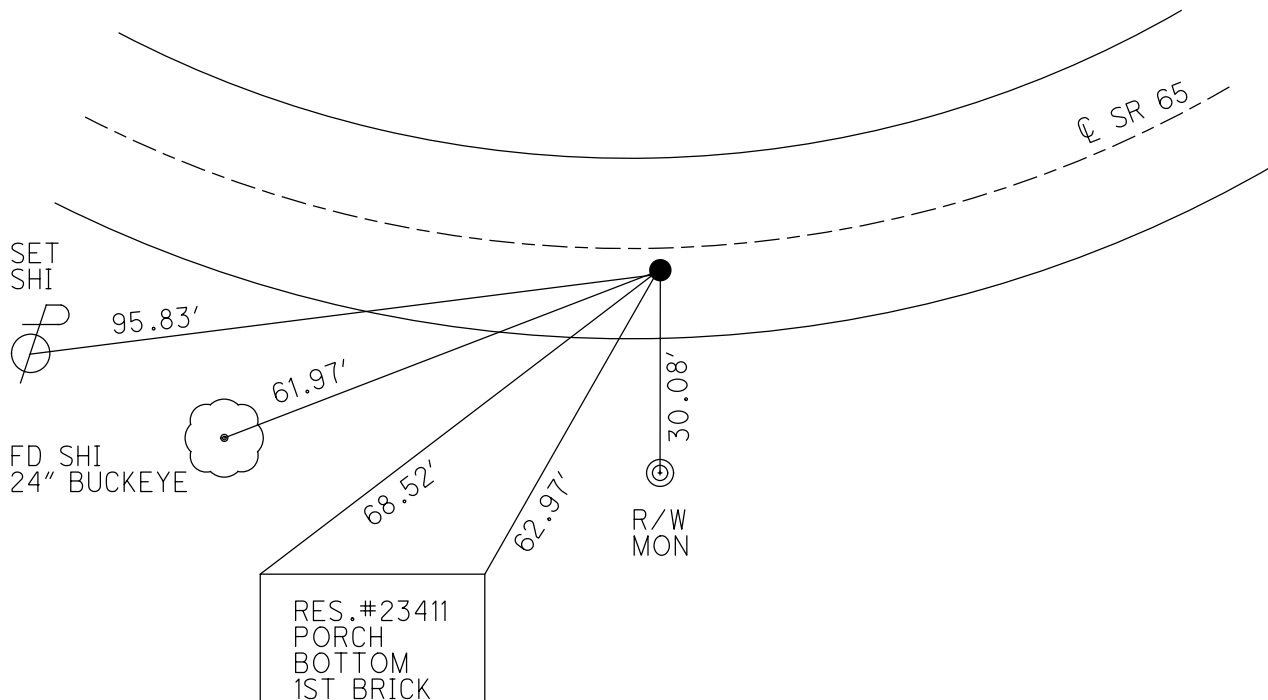

O.D.O.T. DISTRICT 2 SURVEY OFFICE (USE ONLY)

PERSONNEL

REFERENCE NO. 4 B

SHEET 24 OF 40

NOTES RHOADES

DATE 3/29/22

ROUTE SR 65

H.C. NIESE

WEATHER CLEAR

COUNTY WOOD

R.C. AUBLE
KETNER, O'DONNELL

TEMP. 35°

TOWNSHIP GRAND RAPIDS

DWG BY RHOADES

PID 95796

SECTION 5

T 5 N R 9 E

TYPE MONUMENT MAG/WASHER

ON SURFACE - ~~BELOW~~ ON

OFFSET 0.3' LT : ~~RT~~

9.9' TO RT EDGE PAVEMENT


STATION: 102+02.20

HORIZ.DATUM: NAD83 2011


GEOID: NAVD88 2018

GRID: NORTHING: 640247.369

EASTING: 1598253.411

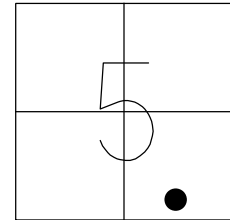

RECORD: P.T.
STA.33+99.57
FD P.K./WASHER
6/22/04, DCH
SET MAG/WASHER
9/17/04, RGN
FD MAG/WASHER
REFB4
11/2/20, JFO
SET MAG/WASHER
10/5/22, TDN

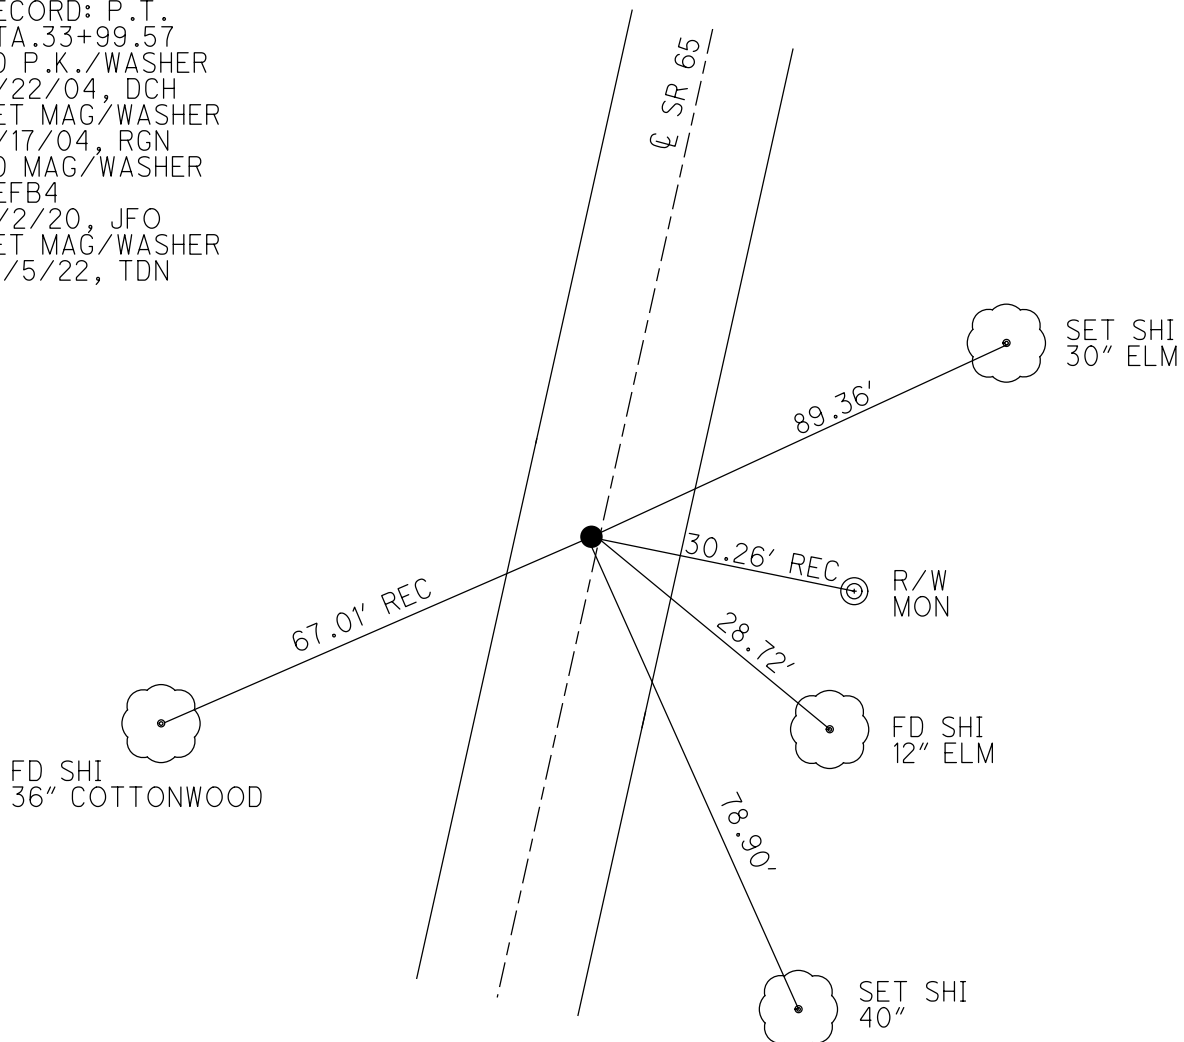

O.D.O.T. DISTRICT 2 SURVEY OFFICE (USE ONLY)

PERSONNEL

REFERENCE NO. 5

SHEET 25 OF 40

NOTES RHOADES

DATE 3/29/22

ROUTE SR 65

H.C. NIESE

WEATHER CLEAR

COUNTY WOOD

R.C. AUBLE

TEMP. 35°

TOWNSHIP GRAND RAPIDS

KETNER, O'DONNELL

SECTION 5

DWG BY RHOADES

PID 95796

T 5 N R 9 E

TYPE MONUMENT MAG/WASHER

ON SURFACE - ~~BELOW~~ ON

OFFSET Q PAVEMENT 4.0' LT : ~~RT~~

6.1' TO LT EDGE PAVEMENT


STATION: 105+27.14

HORZ.DATUM: NAD83 2011


GEOID: NAVD88 2018

GRID: NORTHING: 640543.082

EASTING: 1598388.102

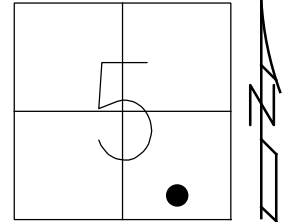

RECORD: P.I.
STA. 4+75.4
 $\Delta = 6^\circ 05'$
R= 1432.69
T= 76.12
L= 152.02'
 $\Delta = 6^\circ 41'$ RT MEAS.
1973
FD P.K./WASHER
6/22/04, DCH
SET MAG/WASHER
9/17/04, RGN
FD MAG/WASHER
REF5
11/2/20, JFO
SET MAG/WASHER
10/5/22, TDN

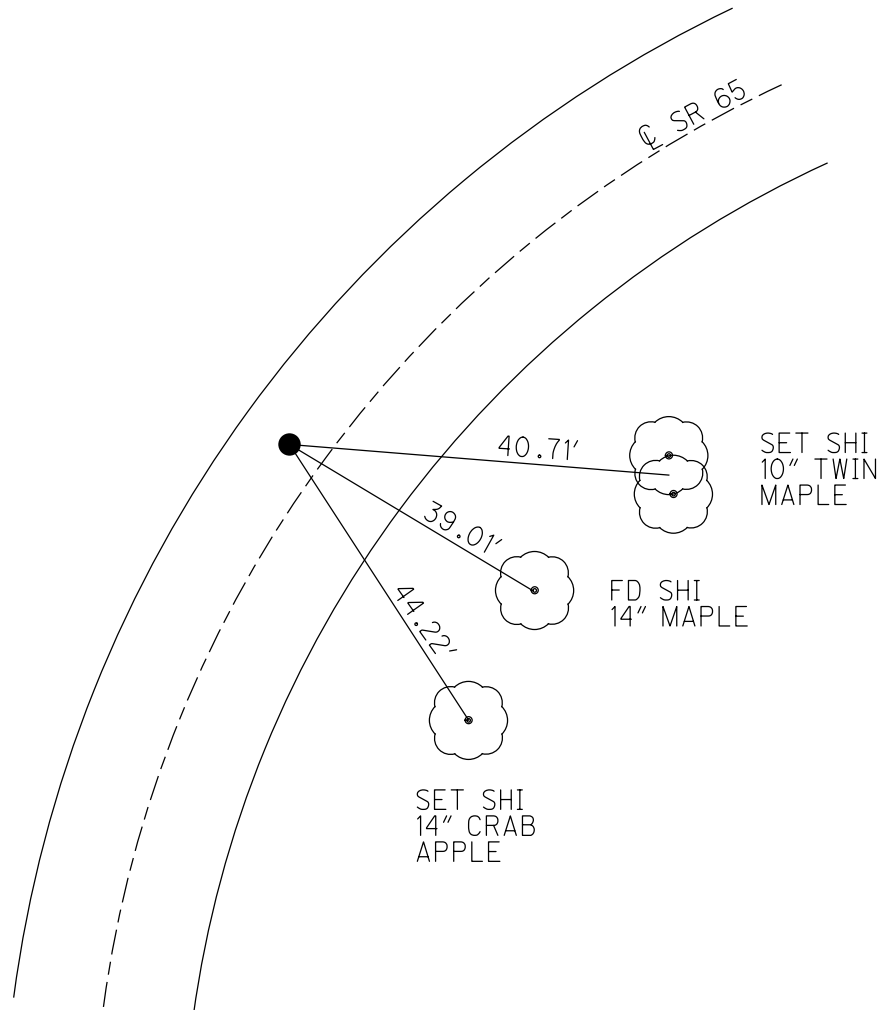

O.D.O.T. DISTRICT 2 SURVEY OFFICE (USE ONLY)

PERSONNEL

REFERENCE NO. 6

SHEET 26 OF 40

NOTES RHOADES

DATE 3/29/22

ROUTE SR 65

H.C. AUBLE

WEATHER CLEAR

COUNTY WOOD

R.C. KETNER

TEMP. 35°

TOWNSHIP GRAND RAPIDS

NIESE, O'DONNELL

SECTION 5

DWG BY RHOADES

PID 95796

T 5 N R 9 E

TYPE MONUMENT MAG NAIL

ON SURFACE - ~~BELOW~~ ON

OFFSET Q PAVEMENT 1.8' LT : ~~RT~~

8.5' TO LT EDGE PAVEMENT



STATION: 110+72.17

HORIZ.DATUM: NAD83 2011

GEOID: NAVD88 2018

GRID: NORTHING: 641009.630

EASTING: 1598670.228

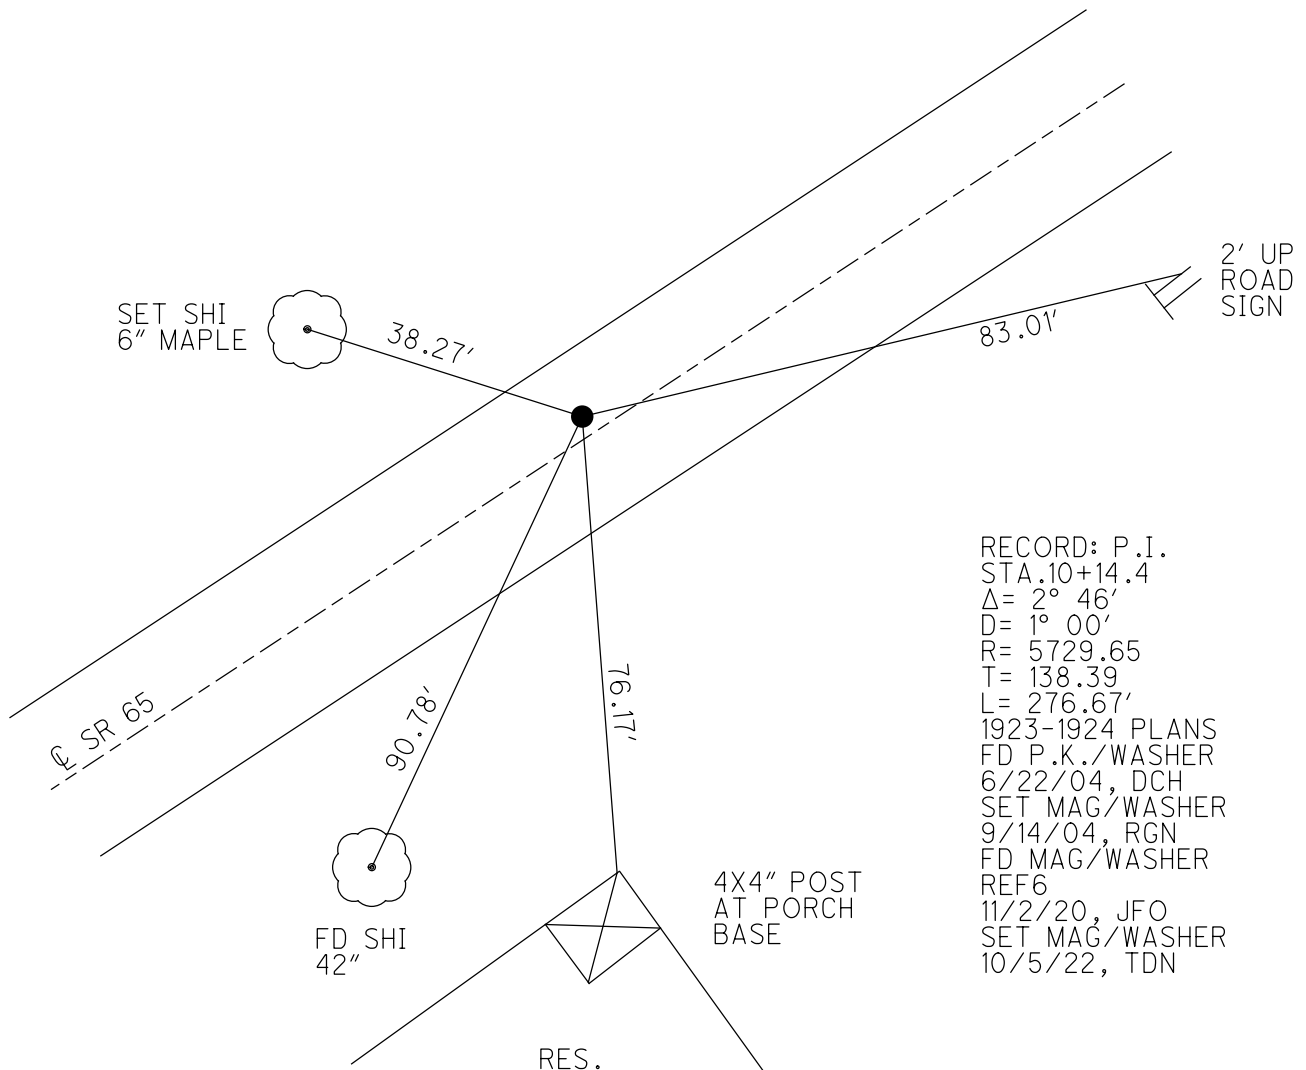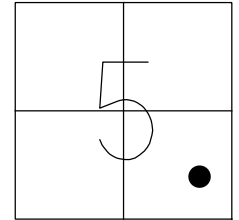

O.D.O.T. DISTRICT 2 SURVEY OFFICE (USE ONLY)

PERSONNEL

REFERENCE NO. 7

SHEET 27 OF 40

NOTES RHOADES

DATE 3/29/22

ROUTE SR 65

H.C. NIESE

WEATHER CLEAR

COUNTY WOOD

R.C. KETNER

TEMP. 35°

TOWNSHIP GRAND RAPIDS

AUBLE, O'DONNELL

SECTION 5

DWG BY RHOADES

PID 95796

T 5 N R 9 E

TYPE MONUMENT MAG/WASHER

ON SURFACE - ~~BELOW~~ ON

OFFSET CL PAVEMENT 4.0' LT : ~~RT~~

5.8' TO LT EDGE PAVEMENT


STATION: 114+51.42

HORIZ.DATUM: NAD83 2011

GEOID: NAVD88 2018

GRID: NORTHING: 641324.276

EASTING: 1598882.054

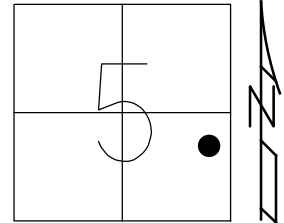

RECORD: P.I.

STA. 13+96

$\Delta = 7^\circ 17' \text{ RT}$

D = 4° 00'

R = 1432.69

T = 91.55

L = 182.08'

1923 PLANS

FD P.K./WASHER

6/22/04, DCH

SET MAG/WASHER

9/17/04, RGN

FD MAG/WASHER

REF7

11/2/20, JFO

SET MAG/WASHER

10/5/22, TDN

SET SHI
5"-7" TWIN
LOCUST

40.47'

52.44'

SET SHI
8" TWIN
LOCUST

81.85'

37.65'

FD SHI
WOOD
FEN POST

SET SHI
6"

O.D.O.T. DISTRICT 2 SURVEY OFFICE (USE ONLY)

PERSONNEL

REFERENCE NO. 7 A

SHEET 28 OF 40

NOTES RHOADES

DATE 3/30/22

ROUTE SR 65

H.C. NIESE

WEATHER CLOUDY

COUNTY WOOD

R.C. KETNER

TEMP. 40°

TOWNSHIP GRAND RAPIDS

AUBLE

SECTION 5

DWG BY RHOADES PID 95796

T 5 N R 9 E

TYPE MONUMENT MAG/WASHER

ON SURFACE - ~~BELOW~~ ON

OFFSET Q PAVEMENT 9.0' LT : ~~RT~~

1.4' TO LT EDGE PAVEMENT


STATION: 119+56.12

HORIZ.DATUM: NAD83 2011


GEOID: NAVD88 2018

GRID: NORTHING: 641704.249

EASTING: 1599214.602

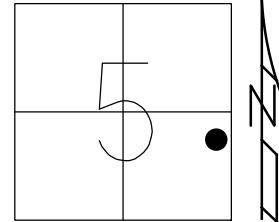

RECORD: P.I.
STA.19+01.4
 $\Delta = 12^\circ 40'$ RT
D= $4^\circ 20'$
R= 1322.53
T= 146.80
L= 292.48
1923-1924 PLANS
FD P.K./WASHER
6/22/04, DCH
SET MAG/WASHER
9/14/04, RGN
FD MAG NAIL
REFA7
11/2/20, JFO
SET MAG/WASHER
10/5/22, TDN

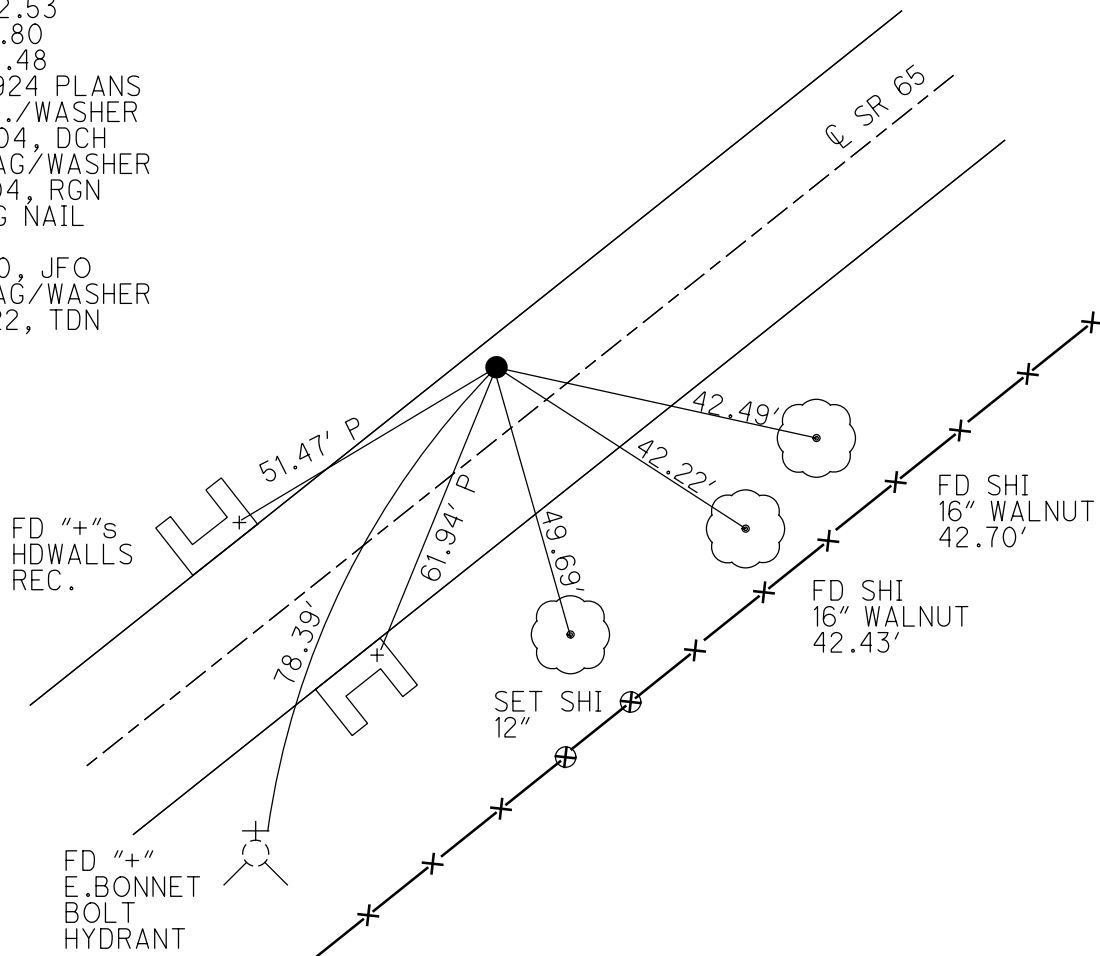

O.D.O.T. DISTRICT 2 SURVEY OFFICE (USE ONLY)

PERSONNEL

REFERENCE NO. 7 B

SHEET 29 OF 40

NOTES RHOADES

DATE 3/30/22

ROUTE SR 65

H.C. NIESE

WEATHER CLOUDY

COUNTY WOOD

R.C. KETNER

TEMP. 40°

TOWNSHIP GRAND RAPIDS

AUBLE

SECTION 4

DWG BY RHOADES

PID 95796

T 5 N R 9 E

TYPE MONUMENT MAG/WASHER

ON SURFACE - ~~BELOW~~ ON

OFFSET Q PAVEMENT 3.5' LT : ~~RT~~

7.5' TO LT EDGE PAVEMENT


STATION: 126+23.68

HORZ.DATUM: NAD83 2011

GEOID: NAVD88 2018

GRID: NORTHING: 642098.608

EASTING: 1599754.709

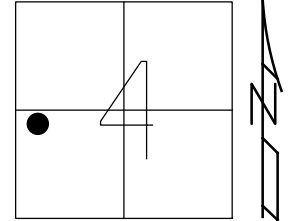

RECORD: P.I.

STA. 25+70.5

$\Delta = 5^{\circ} 27' \text{ RT}$

D = 3^{\circ} 00'

R = 1910.08

T = 91.30

L = 181.66'

FD P.K./WASHER

6/22/04, DCH

SET MAG/WASHER

9/16/04, SAH


FD MAG/WASHER

REFB7

11/2/20, JFO

SET MAG/WASHER

10/5/22, TDN

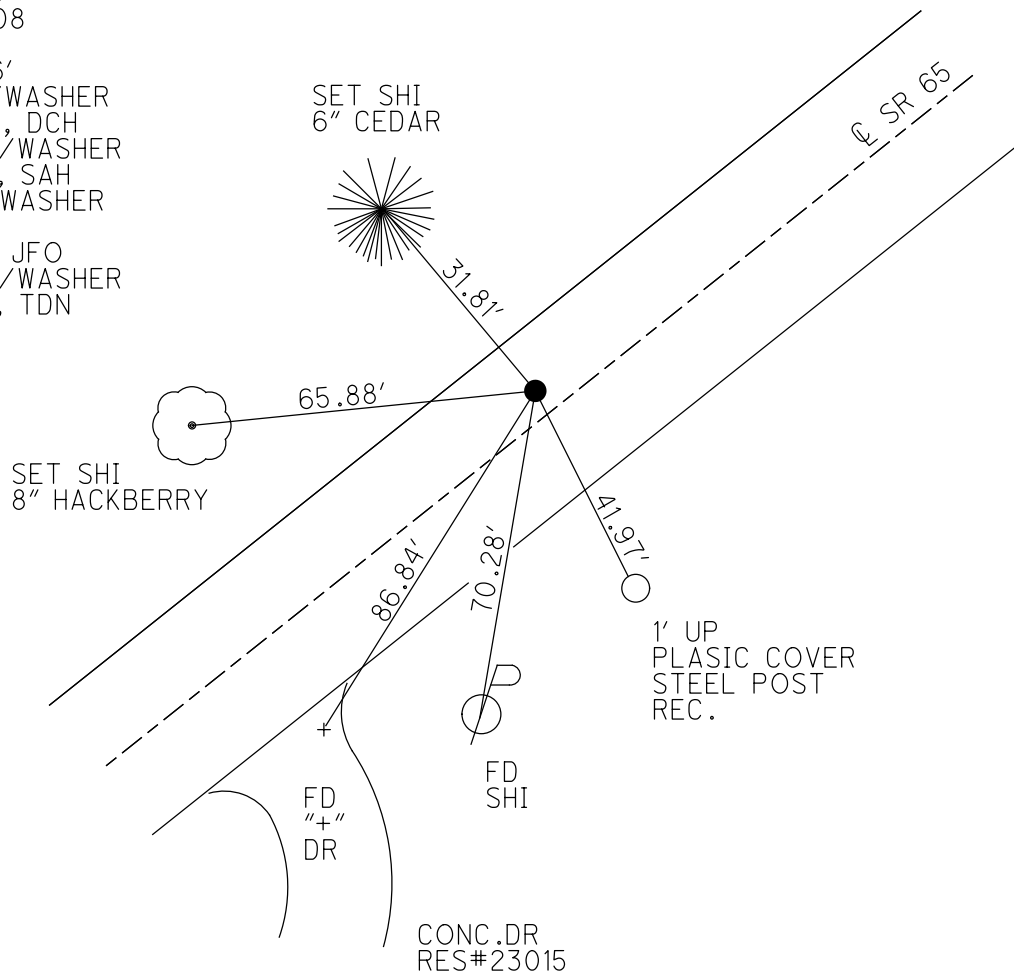

O.D.O.T. DISTRICT 2 SURVEY OFFICE (USE ONLY)

PERSONNEL

REFERENCE NO. 7 C

SHEET 30 OF 40

NOTES RHOADES

DATE 3/30/22

ROUTE SR 65

H.C. NIESE

WEATHER CLOUDY

COUNTY WOOD

R.C. KETNER

TEMP. 40°

TOWNSHIP GRAND RAPIDS

AUBLE

SECTION 4

DWG BY RHOADES PID 95796

T 5 N R 9 E

TYPE MONUMENT MAG/WASHER

ON SURFACE - ~~BELOW~~ ON

OFFSET Q PAVEMENT 6' LT : ~~RT~~

5.3' TO LT EDGE PAVEMENT


STATION: 137+01.39

HORIZ.DATUM: NAD83 2011


GEOID: NAVD88 2018

GRID: NORTHING: 642648.544

EASTING: 1600681.714

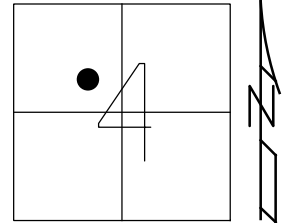

RECORD: P.I.
STA.36+48.10
 $\Delta = 4^\circ 51' \text{ RT}$
D= $1^\circ 00'$
R= 5729.65
T= 241.79
L= 485.00'
FD P.K./WASHER
6/22/04, DCH
SET MAG/WASHER
9/16/04, SAH
FD MAG/WASHER
REFC7
11/2/20, JFO
SET MAG/WASHER
10/5/22, TDN

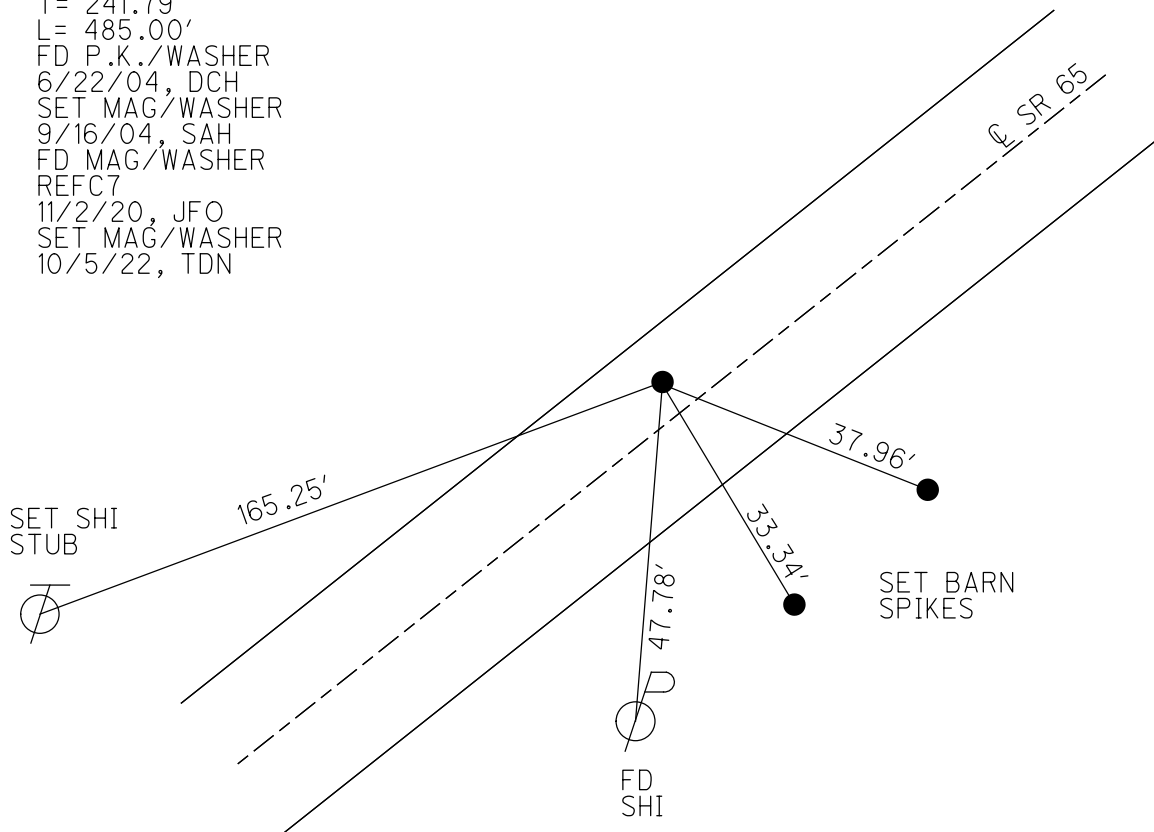

O.D.O.T. DISTRICT 2 SURVEY OFFICE (USE ONLY)

PERSONNEL

REFERENCE NO. 7 D

SHEET 31 OF 40

NOTES RHOADES

DATE 3/30/22

ROUTE SR 65

H.C. NIESE

WEATHER CLOUDY

COUNTY WOOD

R.C. KETNER
AUBLE

TEMP. 40°

TOWNSHIP GRAND RAPIDS

DWG BY RHOADES PID 95796

SECTION 4

T 5 N R 9 E

TYPE MONUMENT MAG/WASHER

ON SURFACE - ~~BELOW~~ ON

OFFSET Q PAVEMENT 1.7' ~~LT~~ : RT

7.3' TO RT EDGE PAVEMENT


STATION: 146+62.99

HORZ.DATUM: NAD83 2011


GEOID: NAVD88 2018

GRID: NORTHING: 643067.514

EASTING: 1601547.563

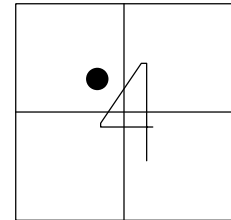

RECORD: P.I.
STA. 46+10.30
 $\Delta = 1^\circ 26'$
FD P.K./WASHER
6/22/04, DCH
SET MAG/WASHER
9/17/04, RGN
FD MAG/WASHER
REFD7
11/2/20, JFO
SET MAG/WASHER
10/5/22, TDN

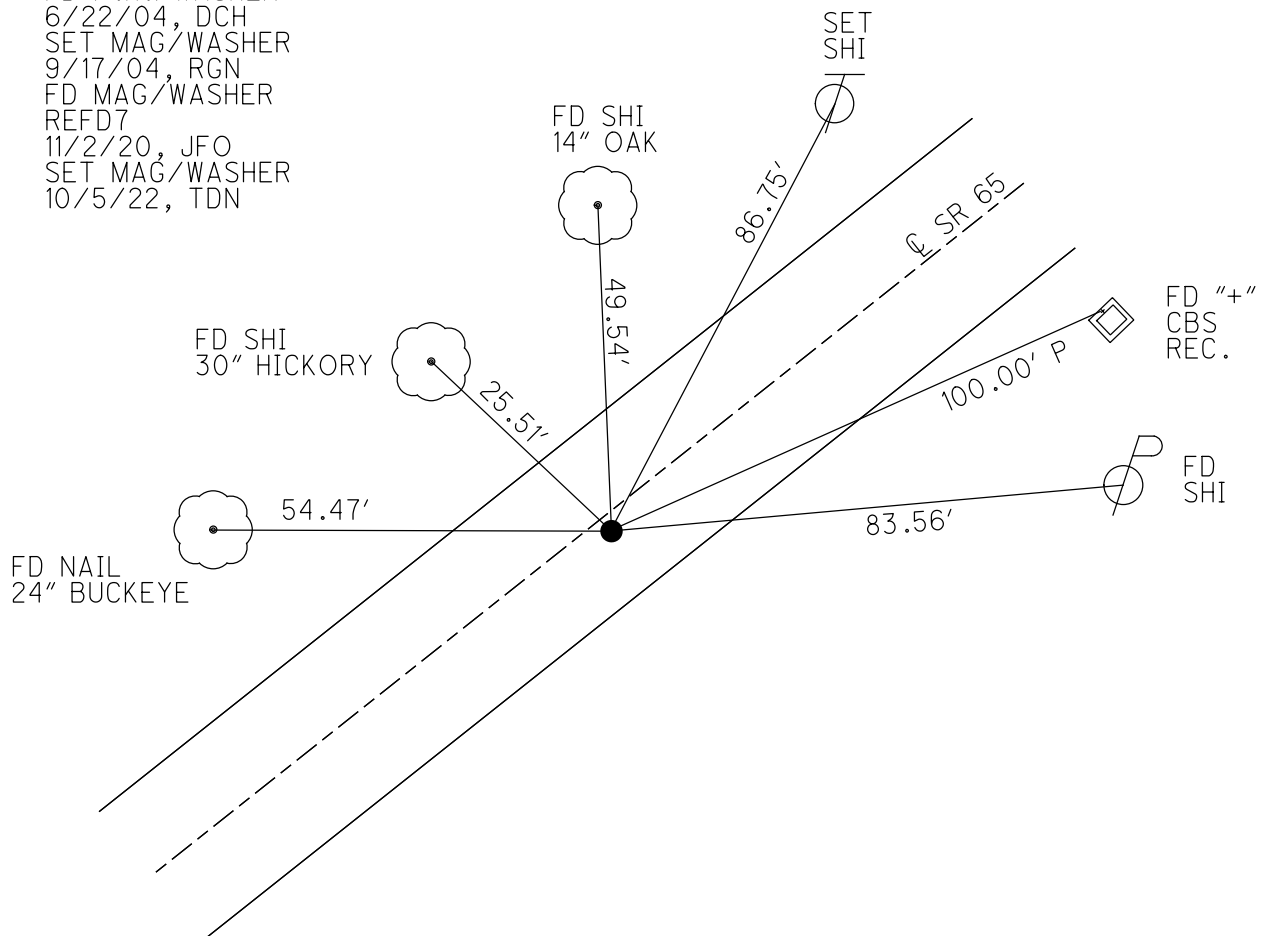

O.D.O.T. DISTRICT 2 SURVEY OFFICE (USE ONLY)

PERSONNEL

REFERENCE NO. 7 E

SHEET 32 OF 40

NOTES RHOADES

DATE 3/30/22

ROUTE SR 65

H.C. NIESE

WEATHER CLOUDY

COUNTY WOOD

R.C. KETNER

TEMP. 40°

TOWNSHIP GRAND RAPIDS

AUBLE

SECTION 4

DWG BY RHOADES

PID 95796

T 5 N R 9 E

TYPE MONUMENT MAG/WASHER

ON SURFACE - ~~BELOW~~ ON

OFFSET Q PAVEMENT 4.9' LT : ~~RT~~

5.7' TO LT EDGE PAVEMENT



STATION: 148+92.50

HORZ.DATUM: NAD83 2011


GEOID: NAVD88 2018

GRID: NORTHING: 643172.350

EASTING: 1601751.727

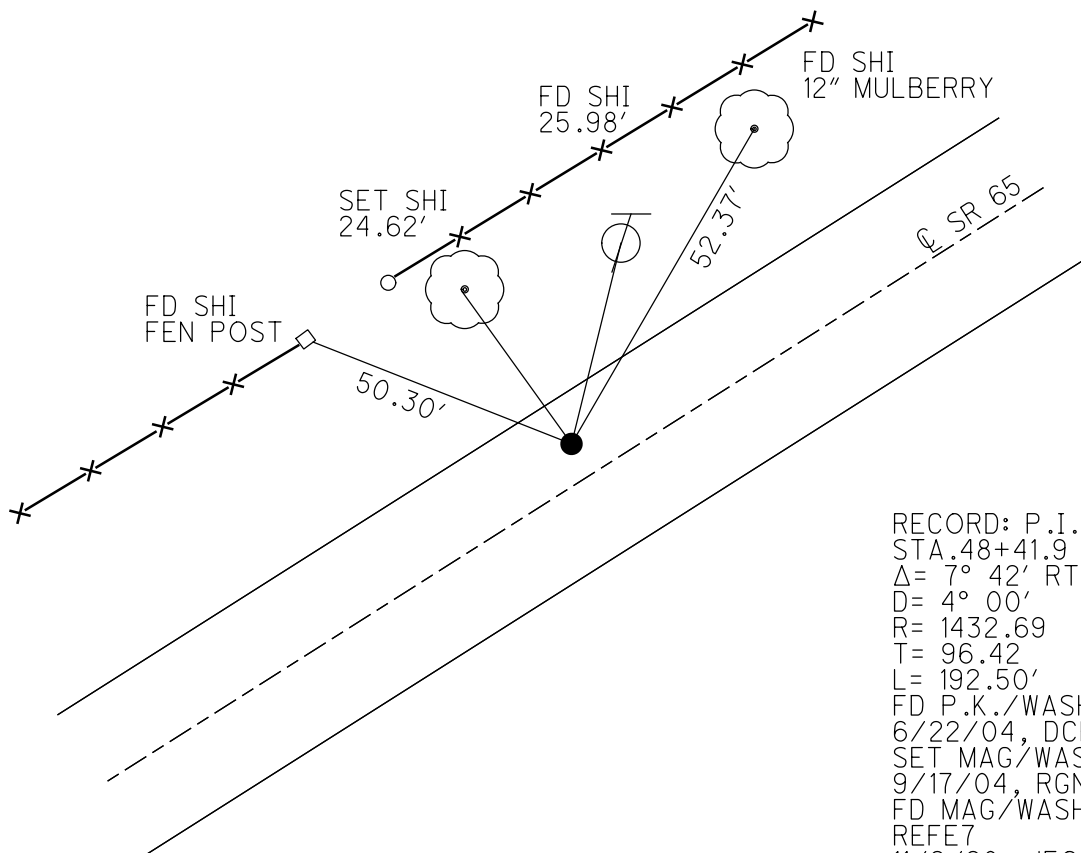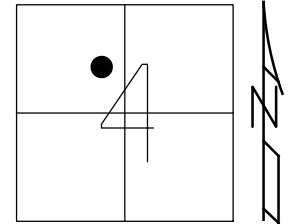

RECORD: P.I.
STA. 48+41.9
 $\Delta = 7^\circ 42' \text{ RT}$
 $D = 4^\circ 00'$
 $R = 1432.69$
 $T = 96.42$
 $L = 192.50'$
FD P.K./WASHER
6/22/04, DCH
SET MAG/WASHER
9/17/04, RGN
FD MAG/WASHER
REFE7
11/2/20, JFO
SET MAG/WASHER
10/5/22, TDN

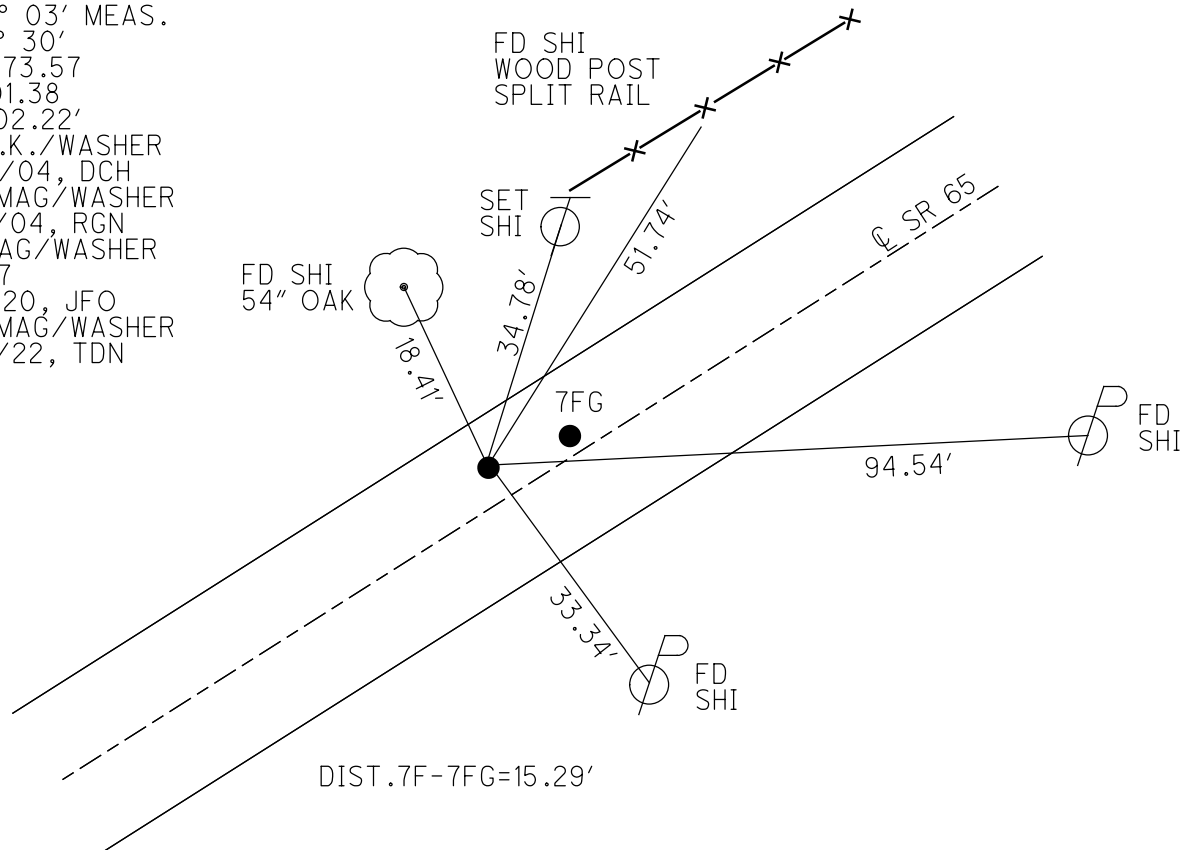

O.D.O.T. DISTRICT 2 SURVEY OFFICE (USE ONLY)

PERSONNEL

REFERENCE NO. 7 FA

SHEET 34 OF 40

NOTES RHOADES

DATE 3/30/22

ROUTE SR 65

H.C. NIESE

WEATHER CLOUDY

COUNTY WOOD

R.C. KETNER

TEMP. 40°

TOWNSHIP GRAND RAPIDS

AUBLE

SECTION 4

DWG BY RHOADES

PID 95796

T 5 N R 9 E

TYPE MONUMENT MAG/WASHER

ON SURFACE - ~~BELOW~~ ON

OFFSET Q PAVEMENT 1.6' LT : ~~RT~~

8.2' TO LT EDGE PAVEMENT


STATION: 155+44.55

HORIZ.DATUM: NAD83 2011


GEOID: NAVD88 2018

GRID: NORTHING: 643386.281

EASTING: 1602367.133

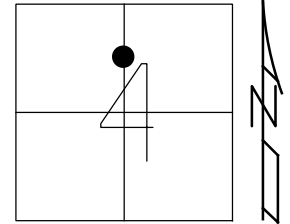

RECORD:
ORIGIN UNKNOWN
FD 1/2" IPIN
1" DOWN
FD P.K./WASHER
6/22/04, DCH
SET MAG/WASHER
9/17/04, RGN
FD MAG/WASHER
REFFA7
11/3/20, JFO
SET MAG/WASHER
10/5/22, TDN

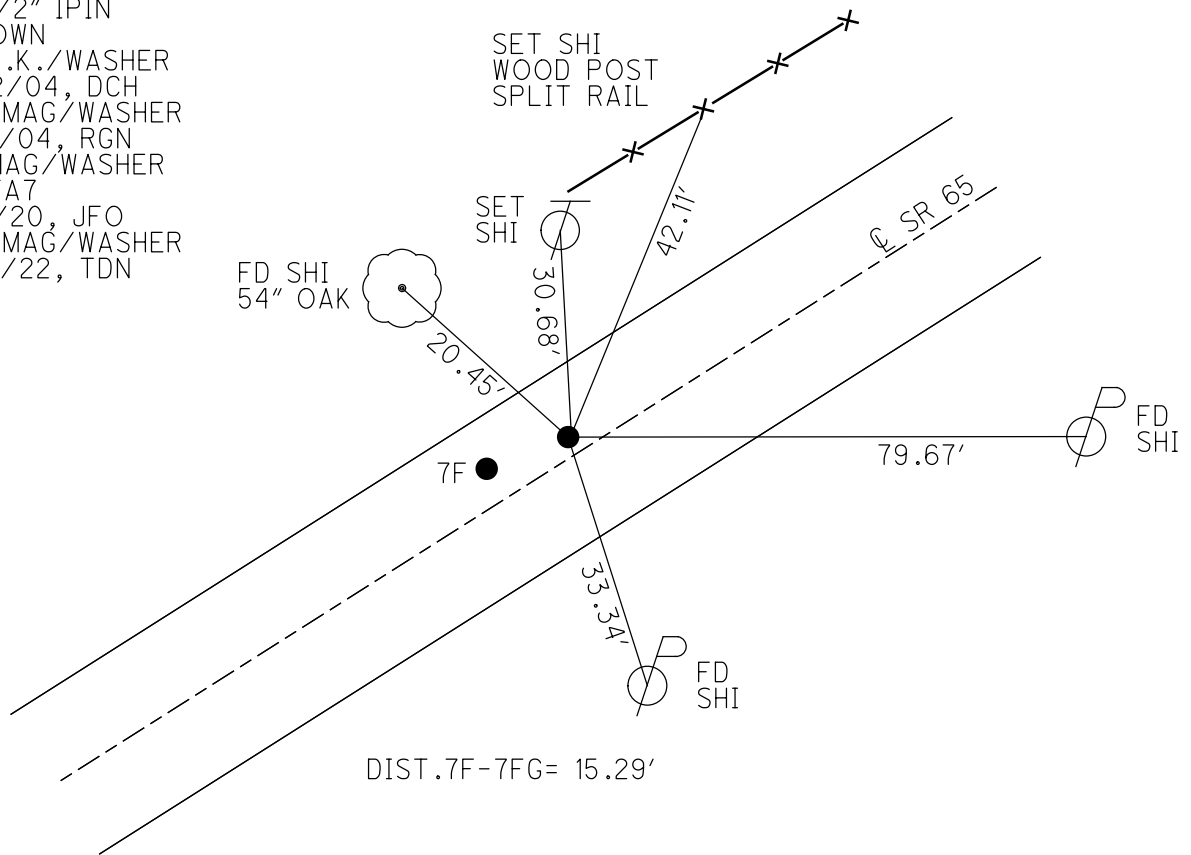

O.D.O.T. DISTRICT 2 SURVEY OFFICE (USE ONLY)

PERSONNEL

REFERENCE NO. 7 G

SHEET 35 OF 40

NOTES RHOADES

DATE 3/30/22

ROUTE SR 65

H.C. NIESE

WEATHER CLOUDY

COUNTY WOOD

R.C. KETNER

TEMP. 46°

TOWNSHIP GRAND RAPIDS

AUBLE

SECTION 4

DWG BY RHOADES

PID 95796

T 5 N R 9 E

TYPE MONUMENT P.K./WASHER

~~ON SURFACE~~ - BELOW 2 1/2"

OFFSET CL PAVEMENT 0.6' ~~LT~~ : RT

9.0' TO RT EDGE PAVEMENT


STATION: 165+62.66

HORZ.DATUM: NAD83 2011


GEOID: NAVD88 2018

GRID: NORTHING: 643573.328

EASTING: 1603368.727

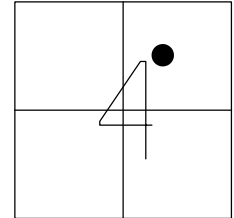

RECORD: P.O.T.
ORIGIN UNKNOWN
FD R.R.SPIKE
1" DOWN
FD P.K./WASHER
6/22/04, DCH
SET MAG/WASHER
9/17/04, RGN
FD P.K./WASHER
2 1/2" DOWN
REFG7
11/3/20, JFO
SET MAG/WASHER
10/5/22, TDN

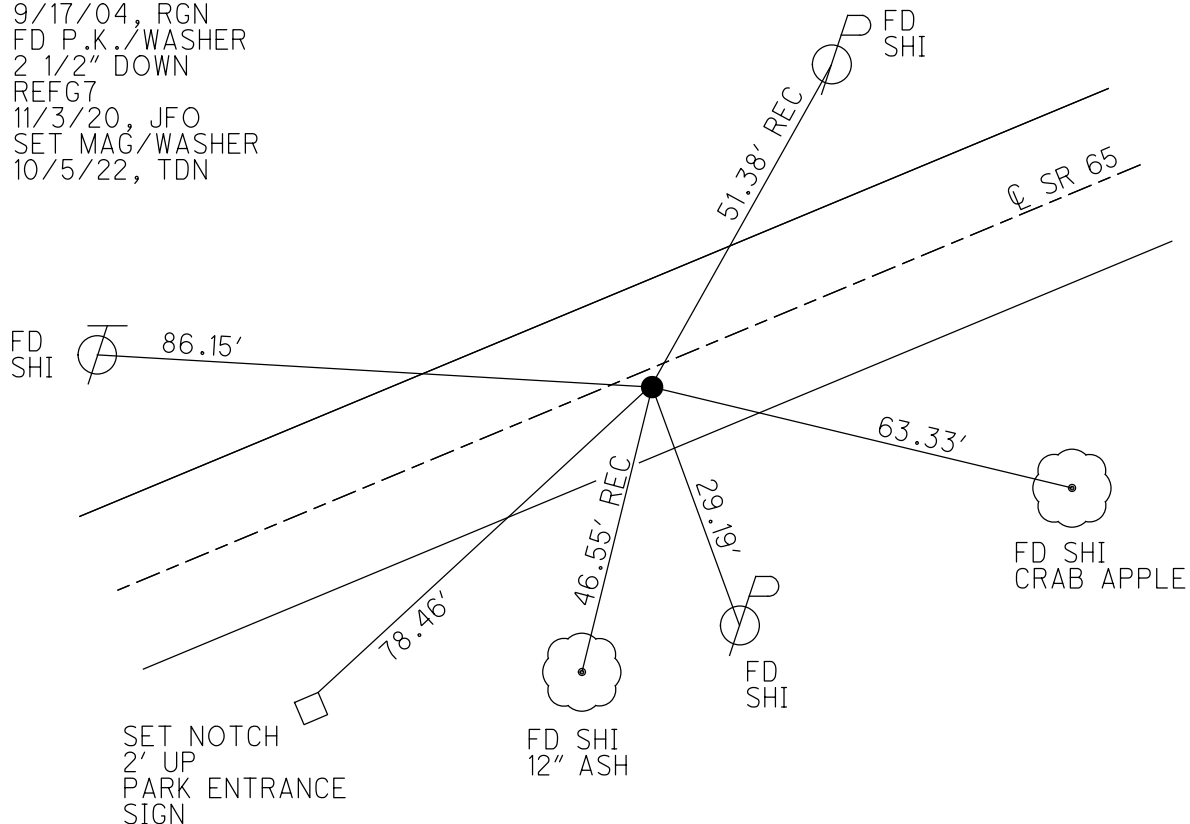

O.D.O.T. DISTRICT 2 SURVEY OFFICE (USE ONLY)

PERSONNEL

REFERENCE NO. 7 GA

SHEET 36 OF 40

NOTES O'DONNELL

DATE 11/3/20

ROUTE SR 65

H.C. AUBLE

WEATHER SUNNY

COUNTY WOOD

R.C. O'DONNELL

TEMP. 40°

TOWNSHIP GRAND RAPIDS

SECTION 4

DWG BY RHOADES

PID 95796

T 5 N R 9 E

TYPE MONUMENT P.K./WASHER

ON SURFACE - BELOW ON

OFFSET Q PAVEMENT 2.0' LT : RT
8.6' TO LT EDGE PAVEMENT


STATION: 187+61.18

HORIZ.DATUM: NAD83 2011


GEOID: NAVD88 2018

GRID: NORTHING: 643974.908

EASTING: 1605541.975

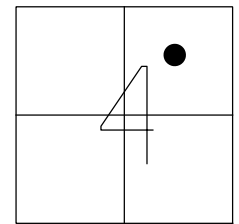

RECORD: P.C.
FD R.R.SPIKE
FD P.K./WASHER
6/22/04, DCH
SET MAG/WASHER
9/17/04, RGN
FD HOLE
REFGA7
11/3/20, JFO
SET MAG/WASHER
10/5/22, TDN

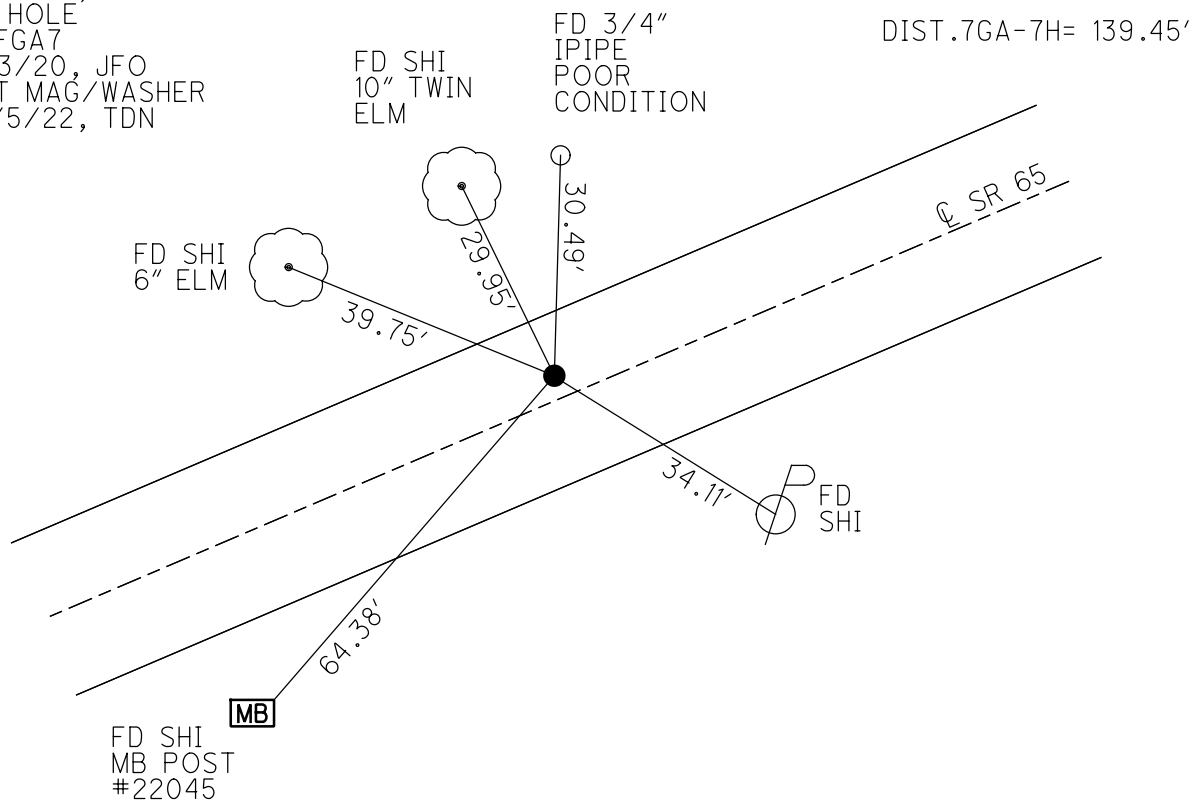

O.D.O.T. DISTRICT 2 SURVEY OFFICE (USE ONLY)

PERSONNEL

REFERENCE NO. 7 H

SHEET 37 OF 40

NOTES RHOADES

DATE 3/30/22

ROUTE SR 65

H.C. NIESE

WEATHER CLOUDY

COUNTY WOOD

R.C. KETNER

TEMP. 45°

TOWNSHIP GRAND RAPIDS

AUBLE

SECTION 4

DWG BY RHOADES

PID 95796

T 5 N R 9 E

TYPE MONUMENT MAG SHANK

ON SURFACE - ~~BELOW~~ ON

OFFSET Q PAVEMENT 7.4' LT : ~~RT~~

2.9' TO LT EDGE PAVEMENT


STATION: 189+12.14

HORIZ.DATUM: NAD83 2011

GEOID: NAVD88 2018

GRID: NORTHING: 644000.233


EASTING: 1605679.091

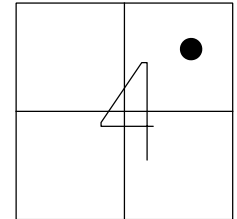

RECORD: P.I.
STA.88+76.9
 $\Delta = 11^\circ 08' \text{ RT}$
 $D = 3^\circ 30'$
 $R = 1637.28$
 $T = 159.68$
 $L = 315.14'$
FD R.R.SPIKE
1" DOWN
FD P.K./WASHER
0.2. DOWN
6/22/04, DCH
SET MAG/WASHER
9/17/04, RGN
FD MAG SHANK
REFH7
11/3/20, JFO
SET MAG/WASHER
10/5/22, TDN

FD SHI
24" MAPLE

MID.OF
5TH BRICK UP
PILLAR

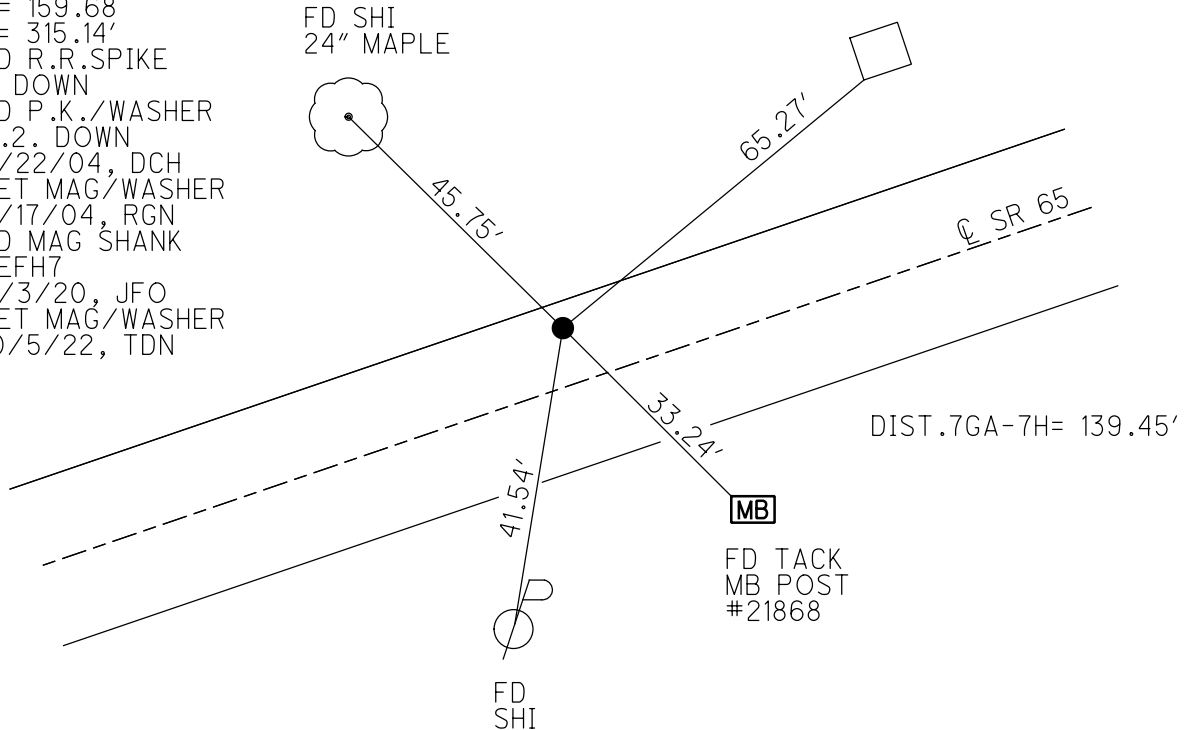

O.D.O.T. DISTRICT 2 SURVEY OFFICE (USE ONLY)

PERSONNEL

REFERENCE NO. 7 I

SHEET 38 OF 40

NOTES RHOADES

DATE 3/30/22

ROUTE SR 65

H.C. AUBLE

WEATHER CLOUDY

COUNTY WOOD

R.C. KETNER

TEMP. 46°

TOWNSHIP GRAND RAPIDS

AUBLE

SECTION 3

DWG BY RHOADES

PID 95796

T 5 N R 9 E

TYPE MONUMENT 1" IPIPE

~~ON SURFACE~~ - BELOW 4"

OFFSET Q PAVEMENT 15.7' ~~LT~~ : RT

5.7' RT TO RT EDGE PAVEMENT


STATION: 194+67.67

HORZ.DATUM: NAD83 2011


GEOID: NAVD88 2018

GRID: NORTHING: 643999.631

EASTING: 1606235.469

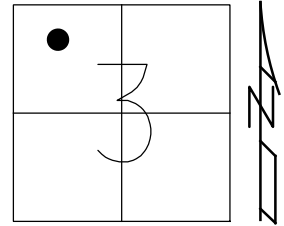

RECORD: P.I.
STA. 94+13.3
 $\Delta = 20^\circ 22' \text{ LT}$
 $D = 6^\circ 00'$
 $R = 955.37$
 $T = 171.58$
 $L = 339.44'$
FD IPIPE
FD IPIPE
4" DOWN
6/22/04, DCH
9/17/04, RGN
FD 1" IPIPE
4" DOWN
REFI7
BENT S.E.
SHOT BASE
AT GROUND
11/3/20, JFO

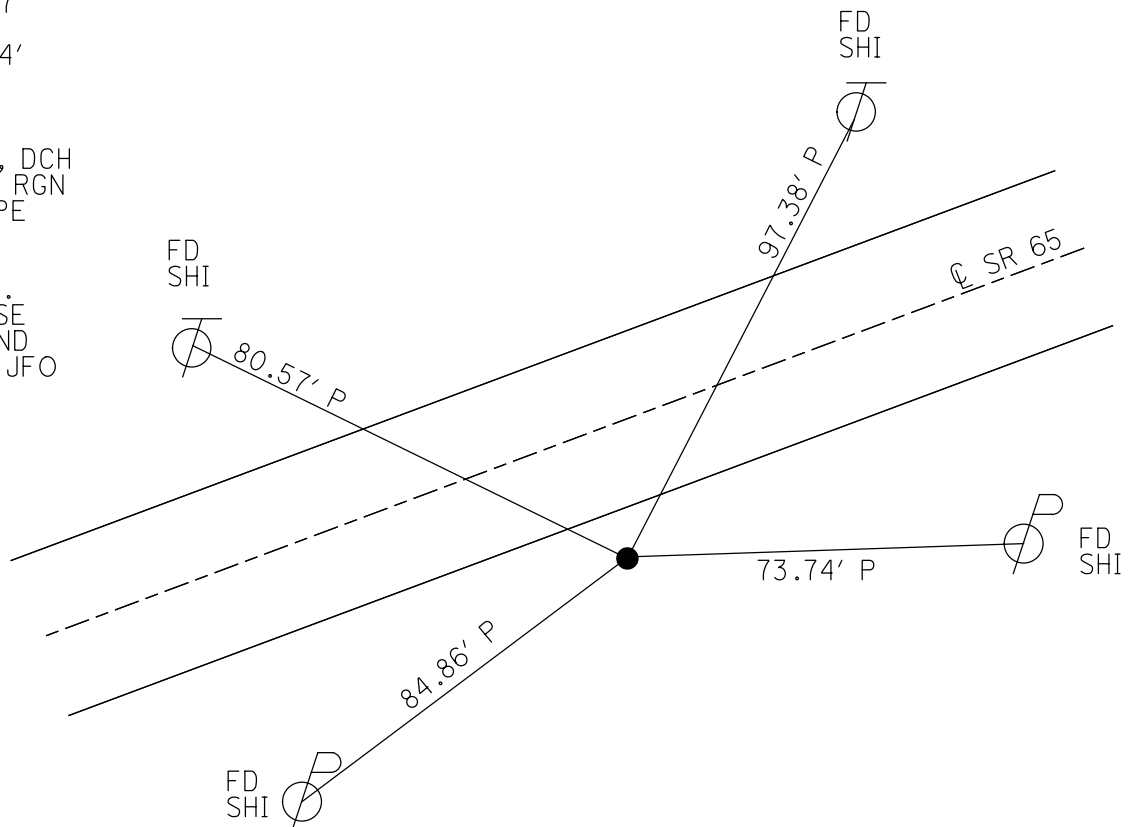

O.D.O.T. DISTRICT 2 SURVEY OFFICE (USE ONLY)

PERSONNEL

REFERENCE NO. 8

SHEET 39 OF 40

NOTES RHOADES

DATE 3/30/22

ROUTE SR 65

H.C. NIESE

WEATHER CLOUDY

COUNTY WOOD

R.C. KETNER

TEMP. 46°

TOWNSHIP GRAND RAPIDS

AUBLE

SECTION 3

DWG BY RHOADES

PID 95796

T 5 N R 9 E

TYPE MONUMENT 1" IPIPE

~~ON SURFACE~~ - BELOW 6"

OFFSET Q PAVEMENT 12' ~~LT~~ : RT

2.6' TO RT EDGE PAVEMENT


STATION: 199+33.44

HORIZ.DATUM: NAD83 2011


GEOID: NAVD88 2018

GRID: NORTHING: 644152.214

EASTING: 1606678.675

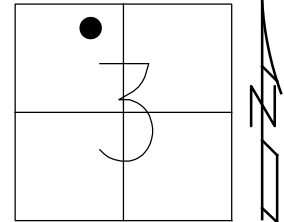

RECORD: P.I.
STA.99+97.9
 $\Delta = 14^{\circ} 45' \text{ LT}$
D= $6^{\circ} 00'$
R= 955.37
T= 123.53
L= 245.63'
FD 1" IPIPE
4" DOWN
6/22/04, DCH
SET MAG/WASHER
9/17/04, RGN
FD 1" IPIPE
6" DOWN
REF8
11/3/20, JFO
10/5/22, TDN

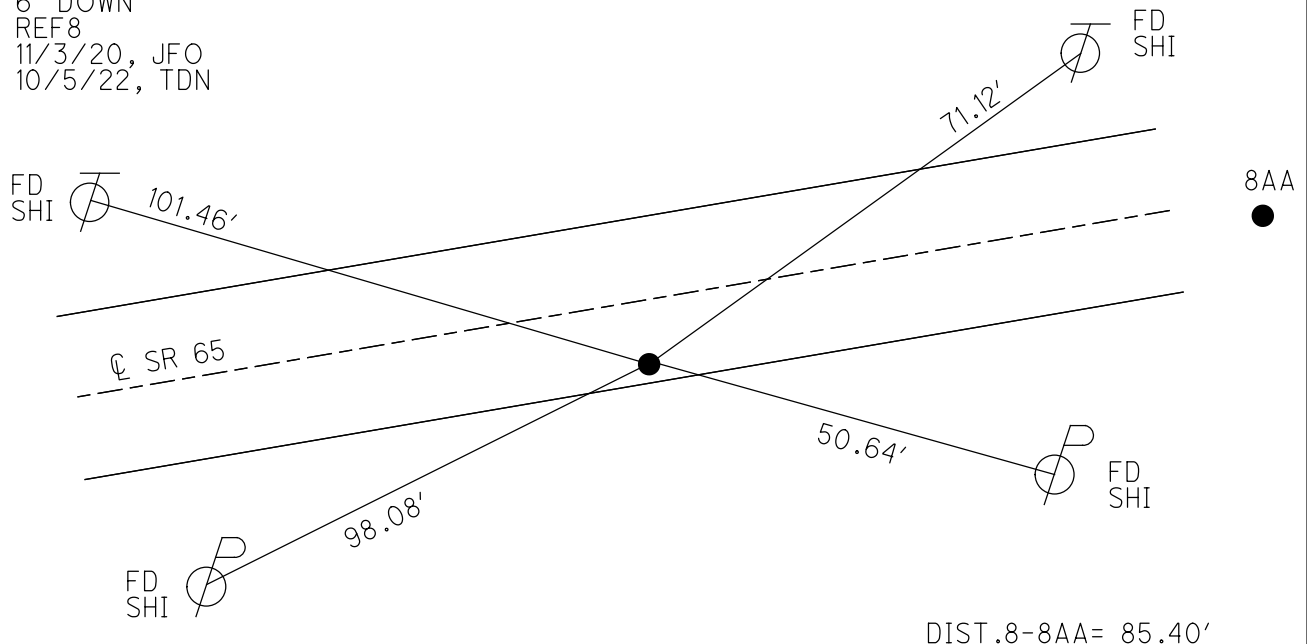

O.D.O.T. DISTRICT 2 SURVEY OFFICE (USE ONLY)

PERSONNEL

REFERENCE NO. 8 AA

SHEET 40 OF 40

NOTES RHOADES

DATE 3/30/22

ROUTE SR 65

H.C. NIESE

WEATHER CLOUDY

COUNTY WOOD

R.C. KETNER

TEMP. 46°

TOWNSHIP GRAND RAPIDS

AUBLE

SECTION 3

DWG BY RHOADES

PID 95796

T 5 N R 9 E

TYPE MONUMENT MAG/WASHER

ON SURFACE - ~~BELOW~~ ON

OFFSET Q PAVEMENT 3' LT : RT

13.3' TO LT EDGE PAVEMENT


STATION: 200+17.36

HORZ.DATUM: NAD83 2011


GEOID: NAVD88 2018

GRID: NORTHING: 644200.639

EASTING: 1606749.021

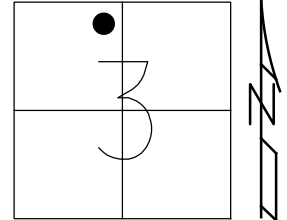

RECORD:
ORIGIN UNKNOWN
FD MAG/SHI
6/22/04, DCH
SET MAG/WASHER
9/17/04, RGN
FD MAG/WASHER
REFAA8
11/3/20, JFO
SET MAG/WASHER
10/5/22, TDN

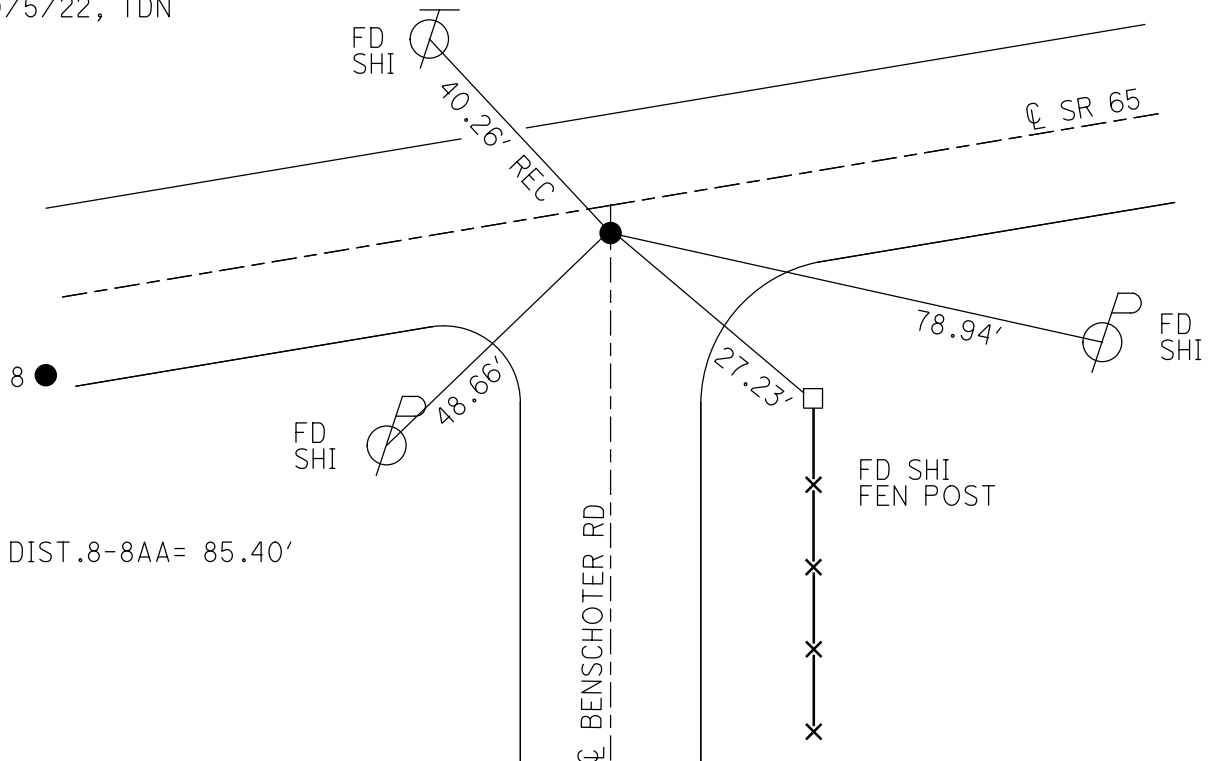

O.D.O.T. DISTRICT 2 SURVEY OFFICE (USE ONLY)

PERSONNEL

REFERENCE NO. 8 AB

SHEET 1 OF 22

NOTES RHOADES

DATE 3/30/22

ROUTE SR 65

H.C. NIESE

WEATHER WINDY

COUNTY WOOD

R.C. AUBLE

TEMP. 61°

TOWNSHIP GRAND RAPIDS

KETNER

SECTION 3

DWG BY RHOADES PID 95796

T 5 N R 9 E

TYPE MONUMENT MAG/WASHER

ON SURFACE - ~~BELOW~~ ON

OFFSET Q PAVEMENT 5' LT : ~~RT~~

4.5' TO LT EDGE PAVEMENT


STATION: 207+41.18

HORZ.DATUM: NAD83 2011

GEOID: NAVD88 2018


GRID: NORTHING: 644608.937

EASTING: 1607347.095

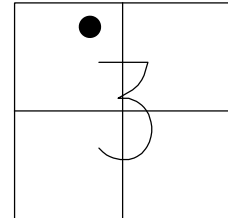

RECORD: P.I.
STA.106+90
 $\Delta = 9^\circ 28'$ MEAS
STA.207+54
6/9/82
SET SM.R.R.SPIKE
10/12/72
SET P.K./WASHER
6/8/92
FD MAG/WASHER
REFAB8
3/30/22, TDN
SET MAG/WASHER
10/6/22, TDN

SET SHI
TRI-CLUMP

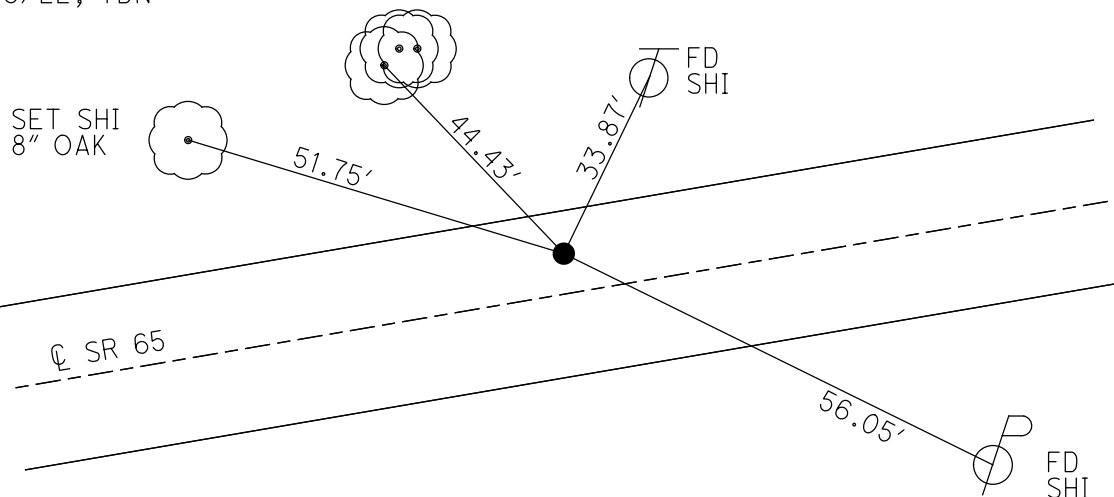

O.D.O.T. DISTRICT 2 SURVEY OFFICE (USE ONLY)

PERSONNEL

REFERENCE NO. 8 B

SHEET 2 OF 22

NOTES RHOADES

DATE 4/11/22

ROUTE SR 65

H.C. NIESE

WEATHER RAIN

COUNTY WOOD

R.C. KETNER

TEMP. 63°

TOWNSHIP GRAND RAPIDS

O'DONNELL

SECTION 3

DWG BY RHOADES

PID 95796

T 5 N R 9 E

TYPE MONUMENT P.K.SHANK

~~ON SURFACE~~ - BELOW 1"

OFFSET Q PAVEMENT 0.9' ~~LT~~ : RT

8.7' TO RT EDGE PAVEMENT


STATION: 212+11.49

HORZ.DATUM: NAD83 2011


GEOID: NAVD88 2018

GRID: NORTHING: 644806.600

EASTING: 1607774.524

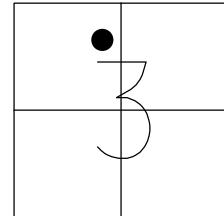

RECORD: P.I.
1923-1924 PLANS
STA. 111+60.8
 $\Delta = 1^\circ 01' \text{ LT}$
FD P.K./WASHER
6/23/04, DCH
SET P.K./WASHER
9/17/04, RGN
FD P.K.SHANK
1" DOWN
(REFAC8)
4/11/22, TDN
SET MAG/WASHER
10/6/22, TDN

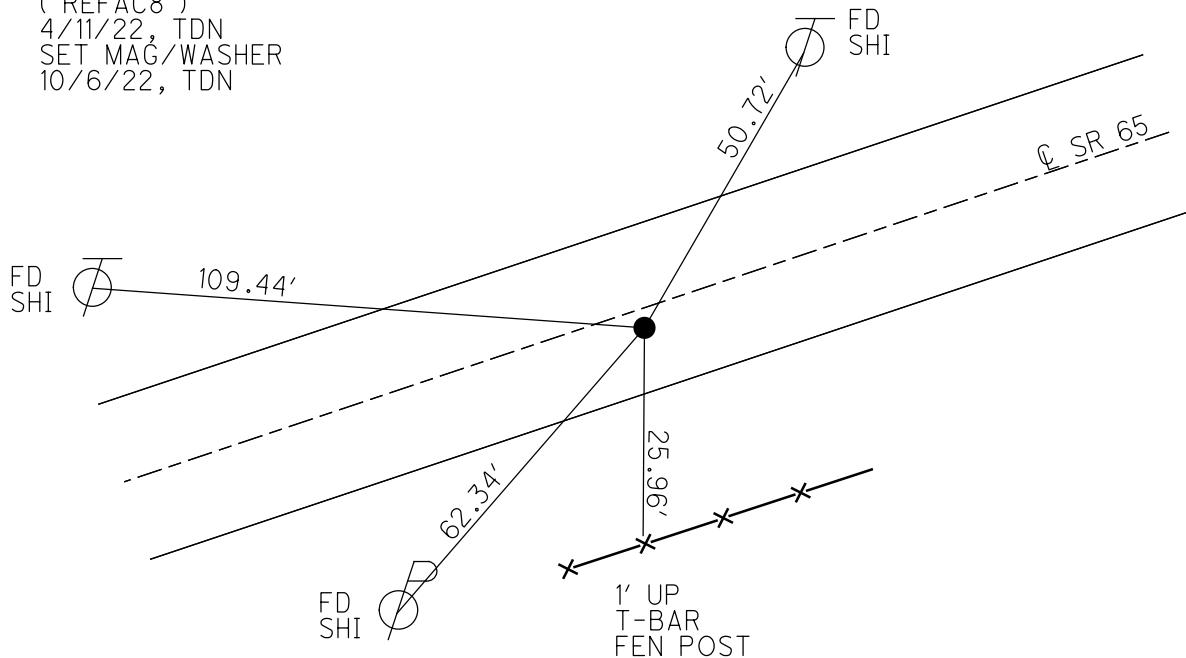

O.D.O.T. DISTRICT 2 SURVEY OFFICE (USE ONLY)

PERSONNEL

REFERENCE NO. 8 C

SHEET 3 OF 22

NOTES RHOADES

DATE 3/30/22

ROUTE SR 65

H.C. NIESE

WEATHER WINDY

COUNTY WOOD

R.C. AUBLE

TEMP. 61°

TOWNSHIP GRAND RAPIDS

KETNER

SECTION 3

DWG BY RHOADES

PID 95796

T 5 N R 9 E

TYPE MONUMENT MAG/WASHER

ON SURFACE - ~~BELOW~~ ON

OFFSET CL PAVEMENT 2.4' ~~LT~~ : RT

7.4' TO RT EDGE PAVEMENT


STATION: 220+00.44

HORZ.DATUM: NAD83 2011


GEOID: NAVD88 2018

GRID: NORTHING: 645151.259

EASTING: 1608484.132

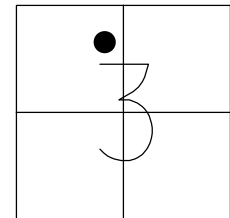

RECORD: P.I.
1923-1924 PLANS
STA. 119+49.75
 $\Delta = 1^\circ 45'$ LT
SET P.K./WASHER
5/1/92, MB
FD P.K./WASHER
6/23/04, DCH
SET P.K./WASHER
9/17/04, RGN
FD P.K./WASHER
4/20/15, EBW
FD P.K.SHANK
SET MAG/WASHER
(REFA8)
11/3/20, JFO
SET MAG/WASHER
10/6/22, TDN

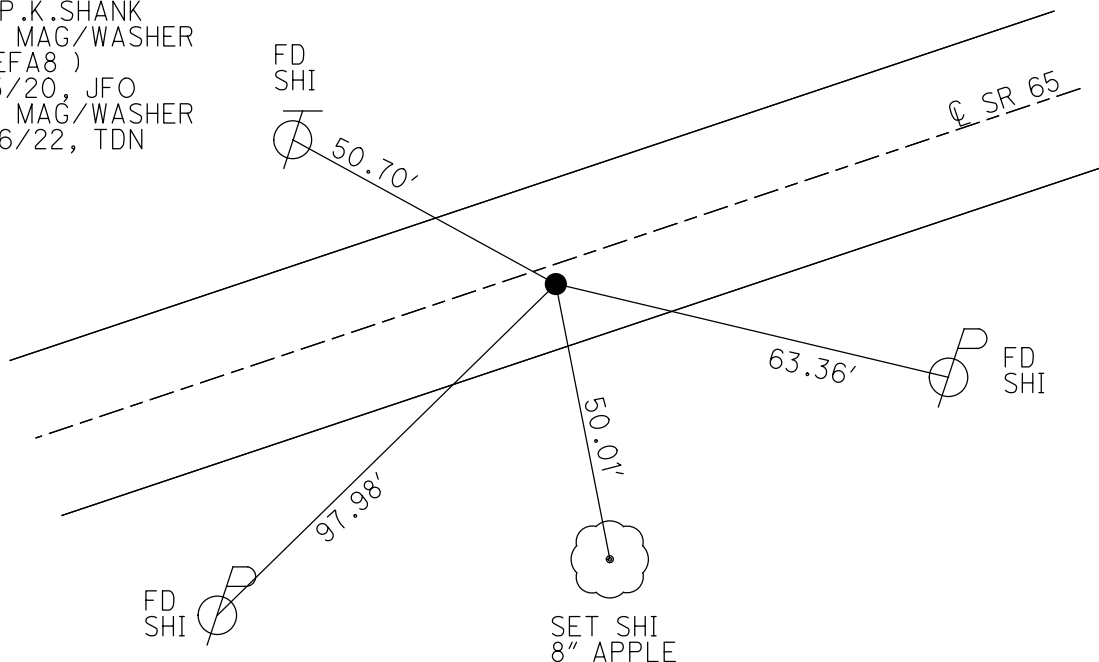

O.D.O.T. DISTRICT 2 SURVEY OFFICE (USE ONLY)

PERSONNEL

REFERENCE NO. 9

SHEET 4 OF 22

NOTES RHOADES

DATE 3/30/22

ROUTE SR 65

H.C. NIESE

WEATHER WINDY

COUNTY WOOD

R.C. KETNER

TEMP. 64°

TOWNSHIP GRAND RAPIDS

AUBLE

SECTION 3

DWG BY RHOADES

PID 95796

T 5 N R 9 E

TYPE MONUMENT MAG/WASHER

ON SURFACE - ~~BELOW~~ ON

OFFSET Q PAVEMENT 5.6' ~~LT~~ : RT

4.1' TO RT EDGE PAVEMENT


STATION: 225+38.40

HORZ.DATUM: NAD83 2011


GEOID: NAVD88 2018

GRID: NORTHING: 645401.648

EASTING: 1608960.267

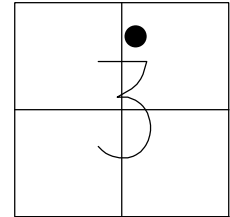

RECORD: P.I.
1923-1924 PLANS
STA. 124+88
 $\Delta = 8^{\circ} 56'$ LT
 $D = 5^{\circ} 00'$
 $R = 1146.28$
 $T = 89.52$
 $L = 178.67$
FD P.K./WASHER
6/23/04, DCH
SET MAG/WASHER
9/17/04, RGN
FD MAG/WASHER
4/20/15, EBW
FD MAG/WASHER
REF9
11/3/20, JFO
SET MAG/WASHER
10/6/22, TDN

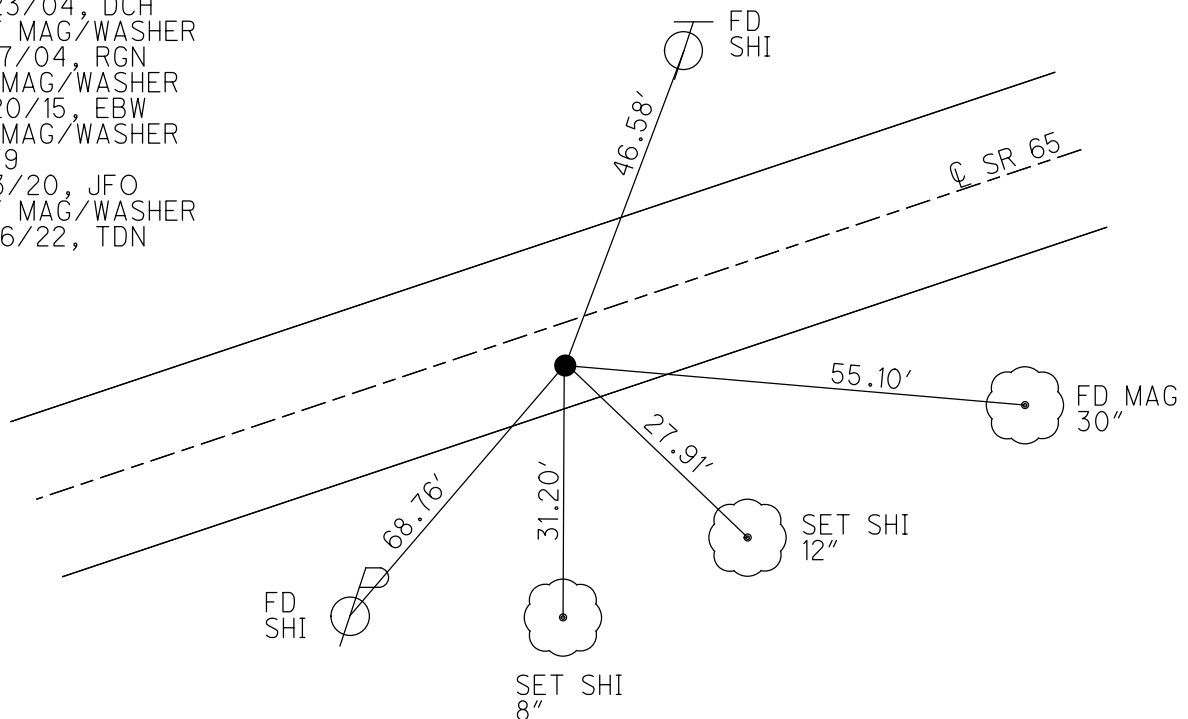

O.D.O.T. DISTRICT 2 SURVEY OFFICE (USE ONLY)

PERSONNEL

REFERENCE NO. 9 A

SHEET 5 OF 22

NOTES RHOADES

DATE 4/11/22

ROUTE SR 65H.C. NIESE

WEATHER FAIR

COUNTY WOOD

R.C. KETNER

TEMP. 55°

TOWNSHIP WASHINGTON

O'DONNELL

SECTION 34DWG BY RHOADES

PID 95796

T 5 N R 9 E

TYPE MONUMENT MAG/WASHER

ON SURFACE - ~~BELOW~~ _____ ON

OFFSET C PAVEMENT 1.2' ~~LT~~ : RT

8.8' TO RT EDGE PAVEMENT

STATION: 231+16.82

HORZ.DATUM: NAD83 2011

GEOID: NAVD88 2018

GRID: NORTHING: 645746.163

EASTING: 1609425.335

RECORD: P.I.

STA. 130+65.5

$$\Delta = 0^{\circ} 50' \text{ LT PLAN}$$
$$\Delta = 0^{\circ} 50' \text{ LT MEASURE}$$

FD P.K.SHANK

1" BELOW

6/23/04, DCH

SET MAG/WASHER

9/17/04, RGN

FD MAG/WASHER

4/20/15, EBW
GET MAG MAG

SET MAG/WASHER

NEWREF A9

9/16/15, JFO


FD MAG/WASHER

NEWREF A9

11/3/20, JFO

SET MAG/WASHER

10/6/22, TDN

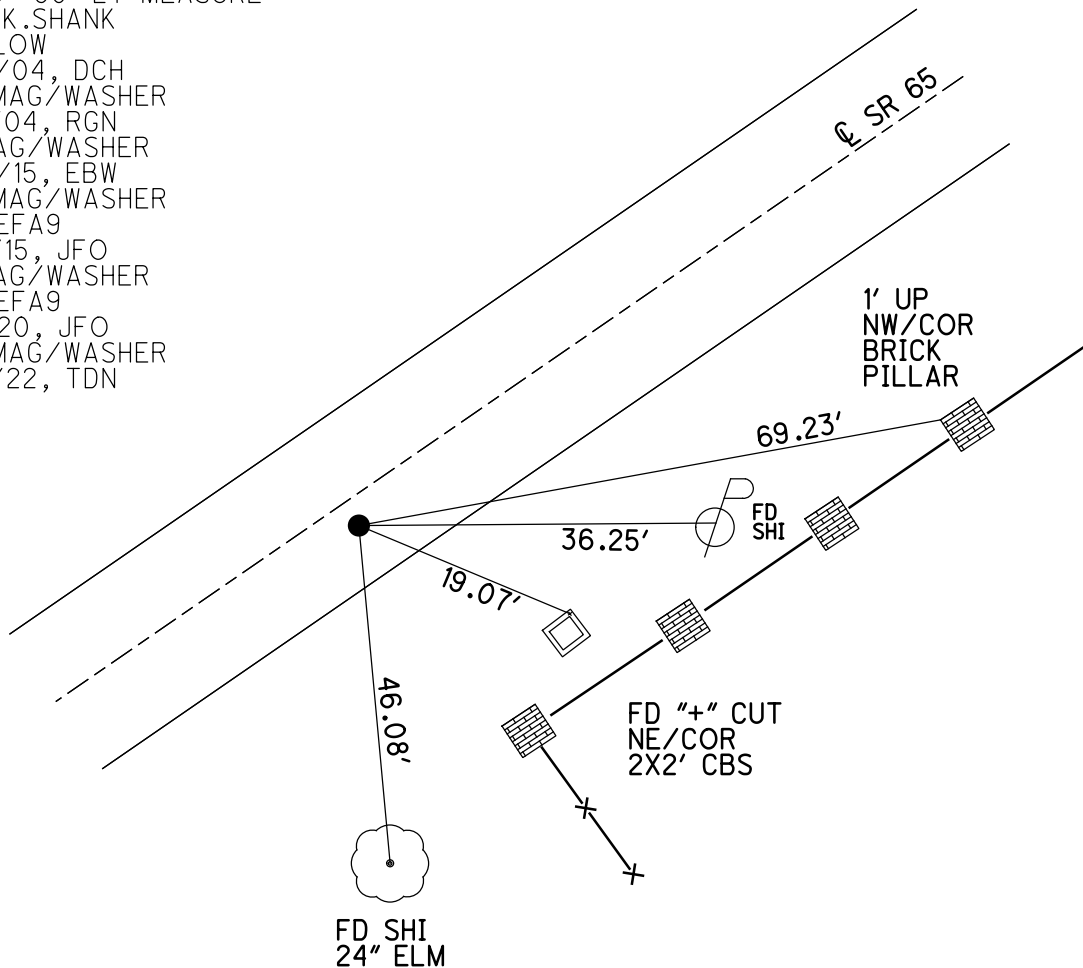

O.D.O.T. DISTRICT 2 SURVEY OFFICE (USE ONLY)

PERSONNEL

REFERENCE NO. 9 B

SHEET 6 OF 22

NOTES RHOADES

DATE 4/11/15

ROUTE SR 65

H.C. NIESE

WEATHER FAIR

COUNTY WOOD

R.C. KETNER

TEMP. 55°

TOWNSHIP WASHINGTON

O'DONNELL

SECTION 34

DWG BY RHOADES PID 95796

T 5 N R 9 E

TYPE MONUMENT MAG/WASHER

ON SURFACE - ~~BELOW~~ ON

OFFSET 0.4' RT : RT

9.4' TO RT EDGE PAVEMENT


STATION: 234+20.25

HORZ. DATUM: NAD83 2011


GEOID: NAVD88 2018

GRID: NORTHING: 645930.717

EASTING: 1609666.187

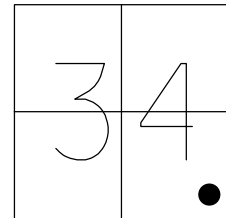

RECORD: P.I.
STA. 133+69
 $\Delta = 1^\circ 35'$ PLAN
 $\Delta = 1^\circ 35'$ MEASURE
1972
FD P.K./WASHER
6/23/04, DCH
SET MAG/WASHER
9/17/04, RGN
FD MAG/WASHER
4/20/15, EBW
SET MAG/WASHER
NEWREFB9
9/16/15, JFO
FD MAG/WASHER
REFB9
11/3/20, JFO
SET MAG/WASHER
10/6/22, TDN

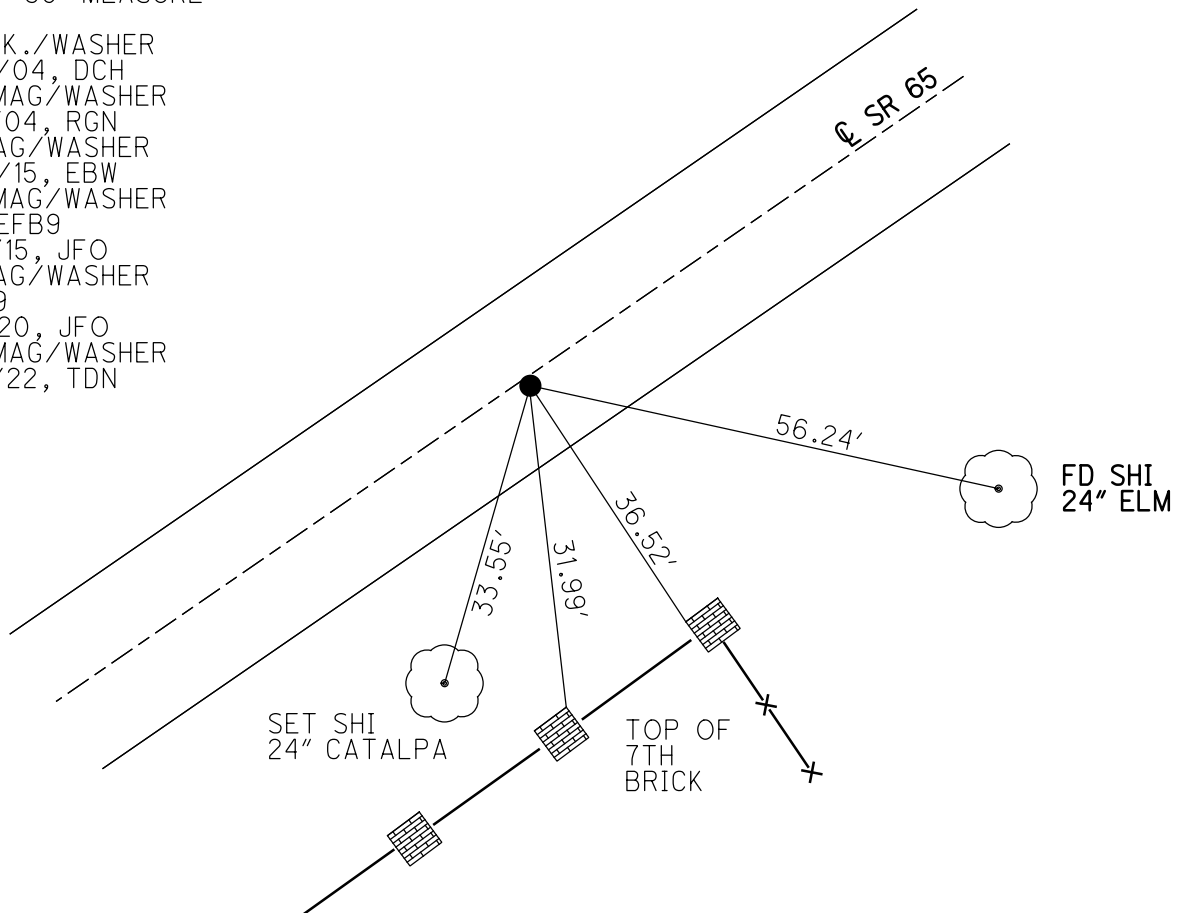

O.D.O.T. DISTRICT 2 SURVEY OFFICE (USE ONLY)

PERSONNEL

REFERENCE NO. 10

SHEET 7 OF 22

NOTES RHOADES DATE 4/11/22
H.C. NIESE WEATHER FAIR
R.C. KETNER TEMP. 55°
O'DONNELL

ROUTE SR 65
COUNTY WOOD
TOWNSHIP WASHINGTON
SECTION 35

DWG BY RHOADES PID 95796

T 5 N R 9 E

TYPE MONUMENT MAG/WASHER

ON SURFACE - ~~BELOW~~ ON

OFFSET Q PAVEMENT 0.8' LT : ~~RT~~

9.4' TO LT EDGE PAVEMENT


STATION: 244+25.64

HORZ.DATUM: NAD83 2011


GEOID: NAVD88 2018

GRID: NORTHING: 646563.716

EASTING: 1610447.280

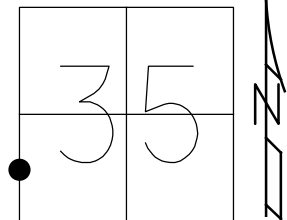

RECORD: P.I.
1923-1924 PLANS
STA. 143+74.4
 $\Delta = 1^\circ 47'$ LT
 $\Delta = 1^\circ 47'$ LT MEAS.
1972
FD P.K./WASHER
6/23/04, DCH
SET P.K./WASHER
9/17/04, RGN
FD MAG/WASHER
4/20/15, EBW
FD MAG NAIL
REF10
11/3/20, JFO
SET MAG/WASHER
10/6/22, TDN

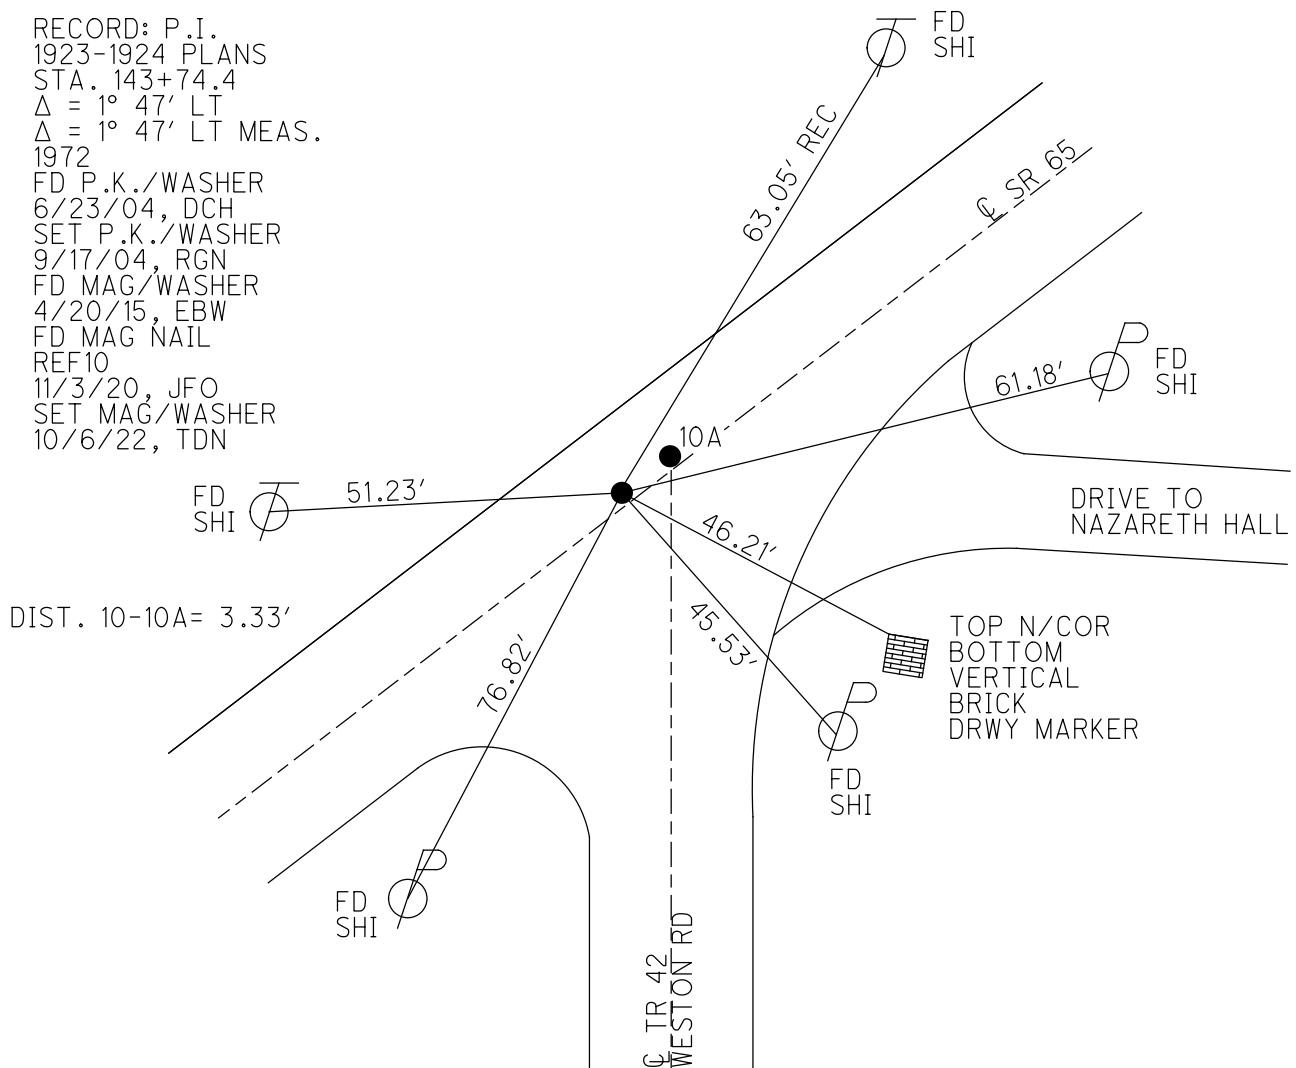

O.D.O.T. DISTRICT 2 SURVEY OFFICE (USE ONLY)

PERSONNEL

REFERENCE NO. 10 A

SHEET 8 OF 22

NOTES RHOADES

DATE 4/11/22

ROUTE SR 65

H.C. NIESE

WEATHER FAIR

COUNTY WOOD

R.C. KETNER

TEMP. 55°

TOWNSHIP WASHINGTON

O'DONNELL

SECTION 35

DWG BY RHOADES PID 95796

T 5 N R 9 E

TYPE MONUMENT P.K./WASHER

ON SURFACE - ~~BELOW~~ ON

OFFSET 0.8' LT : ~~RT~~

9.4' TO LT EDGE PAVEMENT


STATION: 244+28.96

HORIZ.DATUM: NAD83 2011


GEOID: NAVD88 2018

GRID: NORTHING: 646565.852

EASTING: 1610449.844

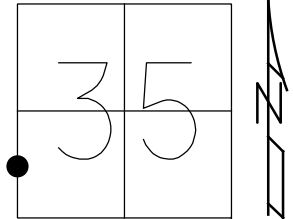

RECORD:
ORIGIN UNKNOWN
FD P.K./WASHER
6/23/04, DCH
SET P.K./WASHER
9/17/04, RGN
FD P.K./WASHER
4/20/15, EBW
FD MAG/WASHER
REFA10
11/3/20, JFO
SET MAG/WASHER
10/6/22, TDN

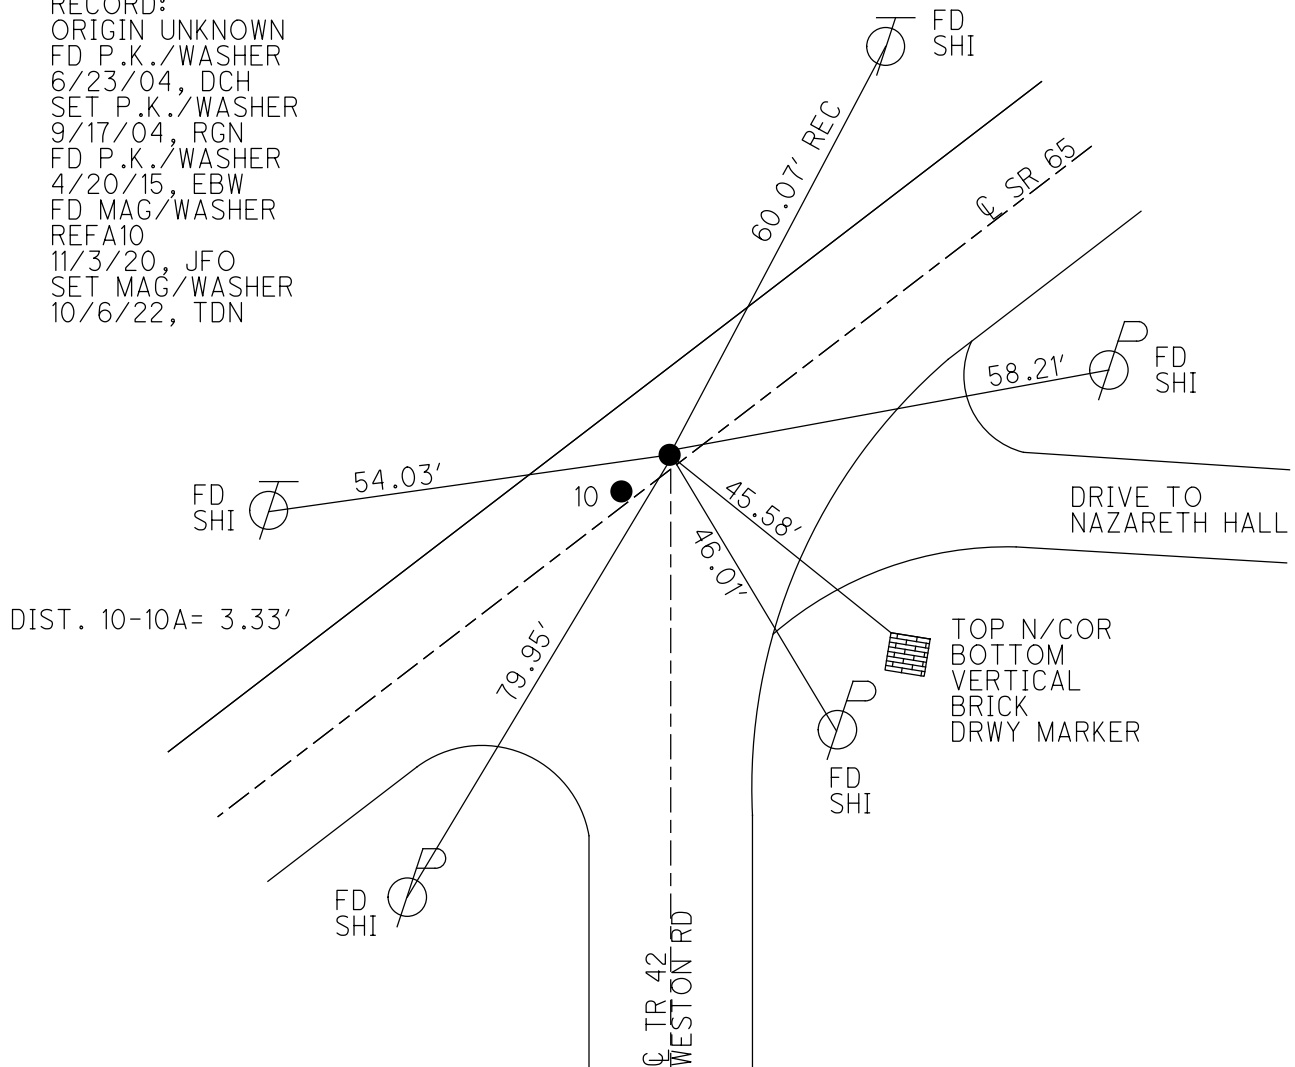

O.D.O.T. DISTRICT 2 SURVEY OFFICE (USE ONLY)

PERSONNEL

REFERENCE NO. 11

SHEET 9 OF 22

NOTES RHOADES

DATE 4/11/22

ROUTE SR 65

H.C. NIESE

WEATHER FAIR

COUNTY WOOD

R.C. KETNER

TEMP. 55°

TOWNSHIP WASHINGTON

O'DONNELL

SECTION 35

DWG BY RHOADES PID 95796

T 6 N R 9 E

TYPE MONUMENT P.K./WASHER

~~ON SURFACE~~ - BELOW 3.5"

OFFSET Q PAVEMENT 3.4' LT : ~~RT~~

7.2' TO LT EDGE PAVEMENT


STATION: 251+15.79

HORZ.DATUM: NAD83 2011


GEOID: NAVD88 2018

GRID: NORTHING: 647014.283

EASTING: 1610970.063

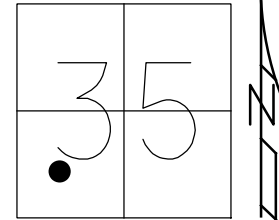

RECORD: P.I.
STA. 150+64.6
 $\Delta = 2^\circ 39' \text{ RT}$
1939
FD P.K./WASHER
6/23/04, DCH
SET P.K./WASHER
9/16/04, SAH
FD P.K./WASHER
REF11
11/3/20, JFO
SET MAG/WASHER
10/6/22, TDN

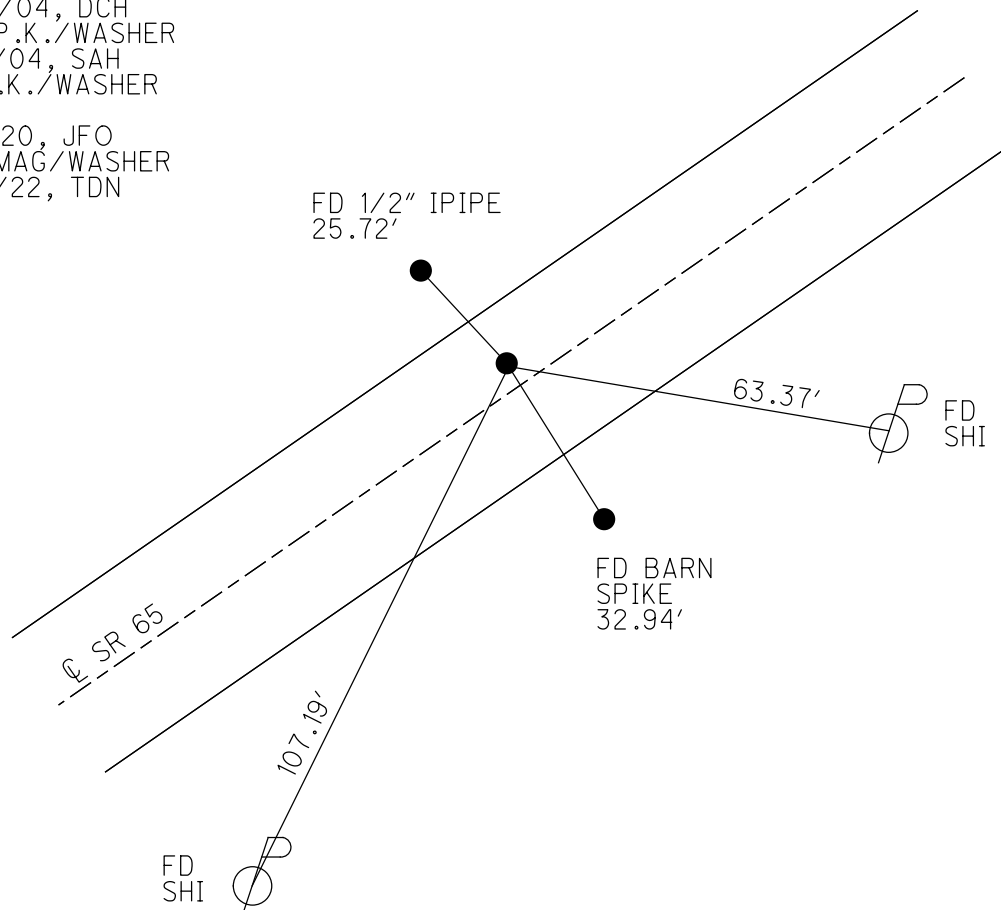

O.D.O.T. DISTRICT 2 SURVEY OFFICE (USE ONLY)

PERSONNEL

REFERENCE NO. 11 A

SHEET 10 OF 22

NOTES RHOADES

DATE 10/6/22

ROUTE SR 65

H.C. NIESE

WEATHER CLOUDY

COUNTY WOOD

R.C. AUBLE

TEMP. 75°

TOWNSHIP WASHINGTON

SECTION 35

DWG BY RHOADES

PID 95796

T 9 N R 9 E

TYPE MONUMENT MAG/WASHER

ON SURFACE - ~~BELOW~~ ON

OFFSET 0.8' LT : RT

10' TO RT EDGE PAVEMENT


STATION: 256+98.27

HORZ.DATUM: NAD83 2011


GEOID: NAVD88 2018

GRID: NORTHING: 647373.718

EASTING: 1611428.421

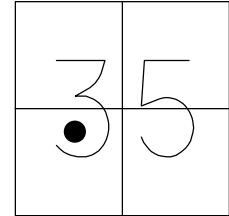

RECORD: P.I.
STA. 156+54
 $\Delta = 0^\circ 56' \text{ LT}$
1972
FD P.K./WASHER
6/23/04, DCH
SET P.K./WASHER
9/17/04, RGN
FD MAG/WASHER
REFA11
11/4/20, JFO
SET MAG/WASHER
10/6/22, TDN

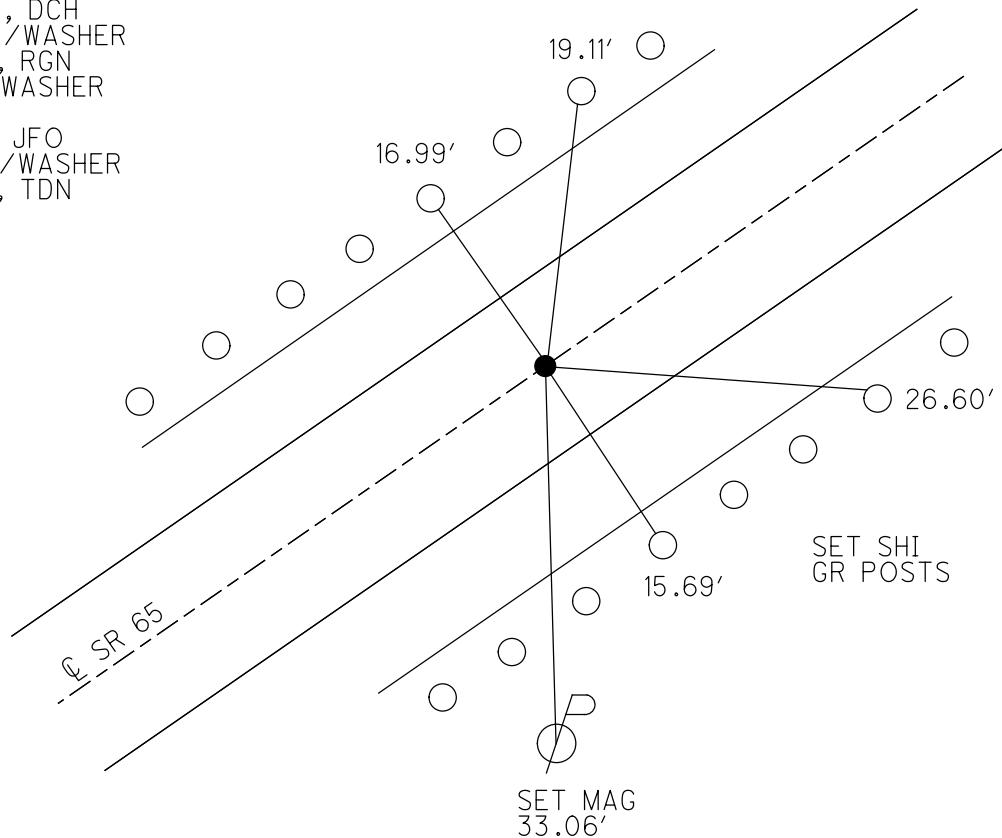

O.D.O.T. DISTRICT 2 SURVEY OFFICE (USE ONLY)

PERSONNEL

REFERENCE NO. 11 B

SHEET 11 OF 22

NOTES RHOADES

DATE 4/11/22

ROUTE SR 65

H.C. NIESE

WEATHER FAIR

COUNTY WOOD

R.C. KETNER

TEMP. 63°

TOWNSHIP WASHINGTON

O'DONNELL

SECTION 35

DWG BY RHOADES PID 95796

T 6 N R 9 E

TYPE MONUMENT MAG/WASHER

ON SURFACE - ~~BELOW~~ ON

OFFSET Q PAVEMENT 1.5' ~~LT~~ : RT

7.9' TO RT EDGE PAVEMENT


STATION: 262+60.40

HORIZ.DATUM: NAD83 2011

GEOID: NAVD88 2018

GRID: NORTHINGS 647726.591

EASTING: 1611865.994

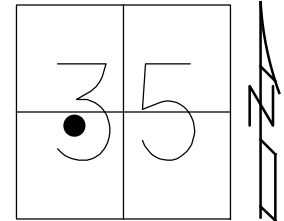

RECORD: P.I.

STA. 162+12.6

$\Delta = 1^\circ 36' \text{ LT}$

1972

FD P.K./WASHER

6/23/04, DCH

SET P.K./WASHER

9/16/04, SAH


FD MAG/WASHER

REFB11

11/4/20, JFO

SET MAG/WASHER

10/6/22, TDN

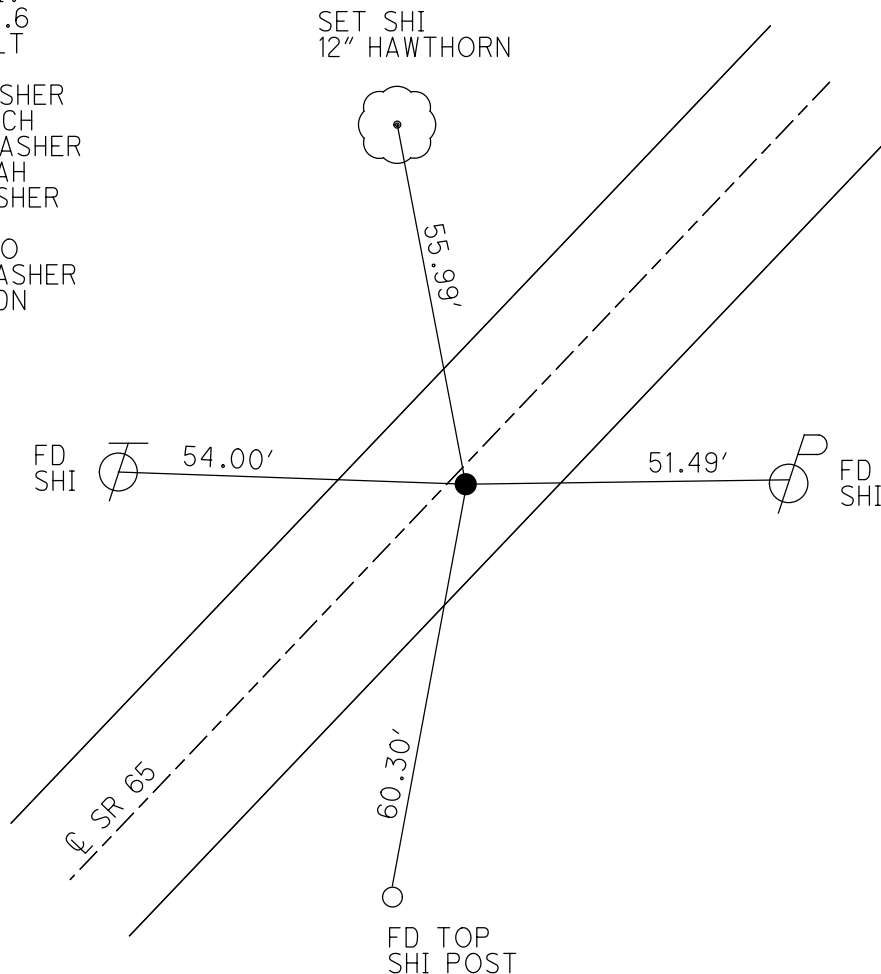

O.D.O.T. DISTRICT 2 SURVEY OFFICE (USE ONLY)

PERSONNEL

REFERENCE NO. 11 C

SHEET 12 OF 22

NOTES RHOADES

DATE 4/11/22

ROUTE SR 65

H.C. NIESE

WEATHER FAIR

COUNTY WOOD

R.C. KETNER

TEMP. 63°

TOWNSHIP WASHINGTON

O'DONNELL

SECTION 35

DWG BY RHOADES

PID 95796

T 6 N R 9 E

TYPE MONUMENT MAG/WASHER

ON SURFACE - ~~BELOW~~ ON

OFFSET CL PAVEMENT 6.4' LT : ~~RT~~

3.8' TO LT EDGE PAVEMENT



STATION: 275+79.09

HORZ.DATUM: NAD83 2011

GEOID: NAVD88 2018

GRID: NORTHING: 648582.482

EASTING: 1612869.186

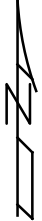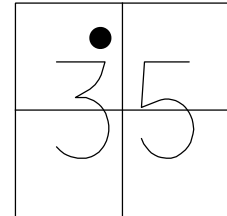

RECORD: P.I.
1923-1924 PLANS
STA. 175+31.3

$\Delta = 9^\circ 01'$

$D = 5^\circ 00'$

$R = 1146.28$

$T = 90.21$

$L = 180.33'$

FD P.K./WASHER

6/22/04, DCH

SET MAG/WASHER

9/17/04, RGN


FD MAG/WASHER

REFC11

11/4/20, JFO

SET MAG/WASHER

10/6/22, TDN

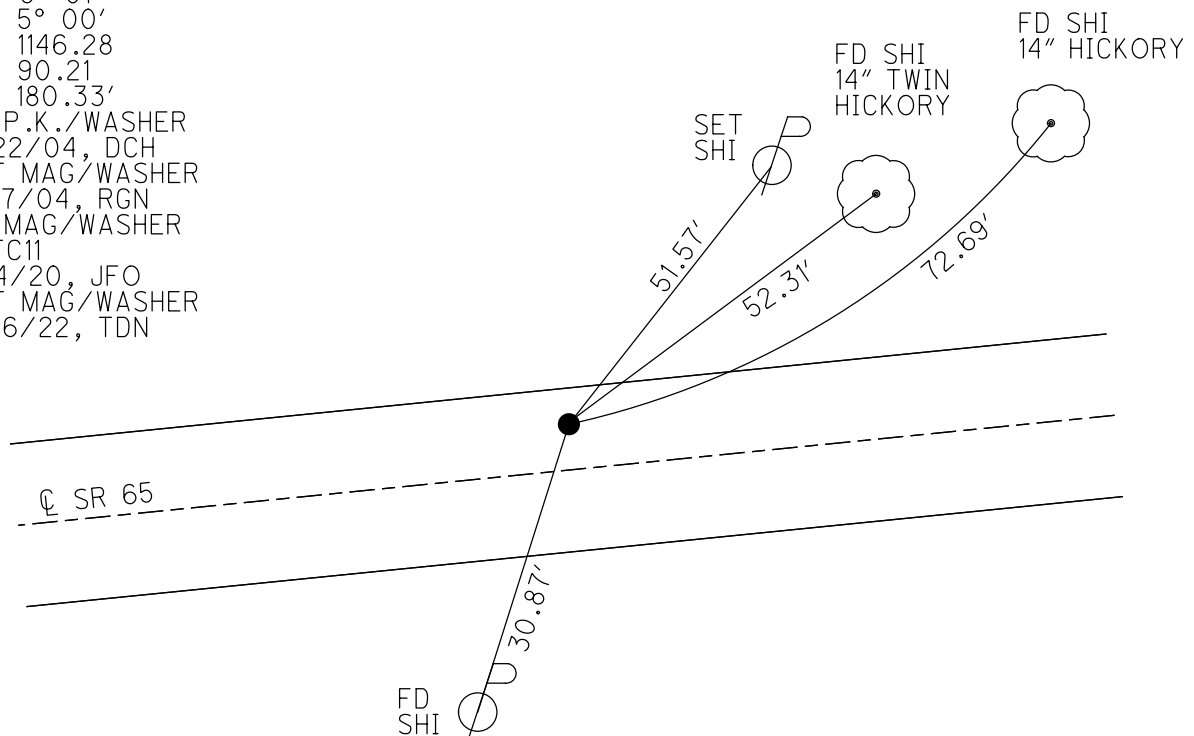

O.D.O.T. DISTRICT 2 SURVEY OFFICE (USE ONLY)

PERSONNEL

REFERENCE NO. 11 D

SHEET 13 OF 22

NOTES RHOADES

DATE 4/11/12

ROUTE SR 65

H.C. NIESE

WEATHER FAIR

COUNTY WOOD

R.C. KETNER

TEMP. 63°

TOWNSHIP WASHINGTON

O'DONNELL

SECTION 35

DWG BY RHOADES

PID 95796

T 6 N R 9 E

TYPE MONUMENT MAG NAIL

ON SURFACE - ~~BELOW~~ ON

OFFSET CL PAVEMENT ON LT : RT

9.0' TO RT EDGE PAVEMENT


STATION: 278+23.28

HORZ.DATUM: NAD83 2011


GEOID: NAVD88 2018

GRID: NORTHING: 648710.155

EASTING: 1613077.898

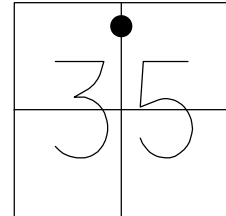

RECORD:
ORIGIN UNKNOWN
FD P.K./WASHER
6/23/04, DCH
SET MAG/WASHER
9/16/04, SAH
FD MAG NAIL
REFD11
11/4/20, JFO
SET MAG/WASHER
10/6/22, TDN

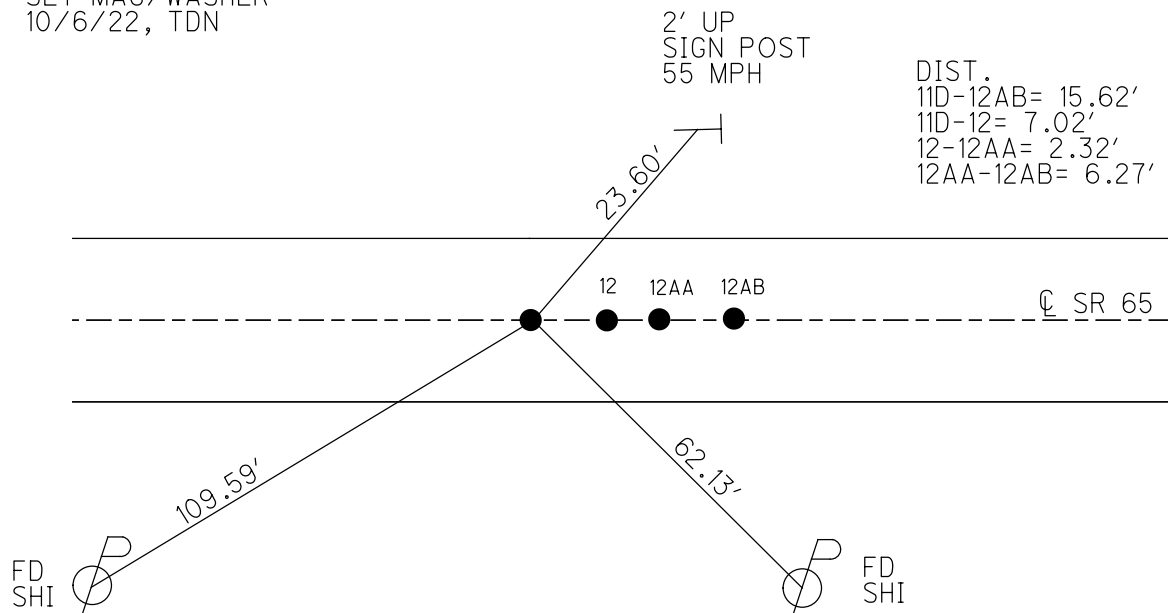

O.D.O.T. DISTRICT 2 SURVEY OFFICE (USE ONLY)

PERSONNEL

REFERENCE NO. 12

SHEET 14 OF 22

NOTES RHOADES

DATE 4/11/12

ROUTE SR 65

H.C. NIESE

WEATHER FAIR

COUNTY WOOD

R.C. KETNER

TEMP. 63°

TOWNSHIP WASHINGTON

O'DONNELL

SECTION 35

DWG BY RHOADES PID 95796

T 6 N R 9 E

TYPE MONUMENT MAG NAIL

ON SURFACE - ~~BELOW~~ ON

OFFSET CL PAVEMENT ON LT : RT

9.0' TO RT EDGE PAVEMENT


STATION: 278+30.31

HORIZ.DATUM: NAD83 2011

GEOID: NAVD88 2018


GRID: NORTHING: 648713.817

EASTING: 1613083.908

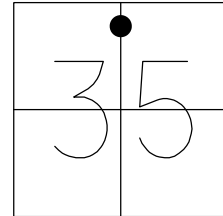

RECORD:

FD P.K./WASHER
6/23/04, DCH
SET MAG/WASHER
9/16/04, SAH
FD MAG NAIL
REF12
11/4/20, JFO
SET MAG/WASHER
10/6/22, TDN

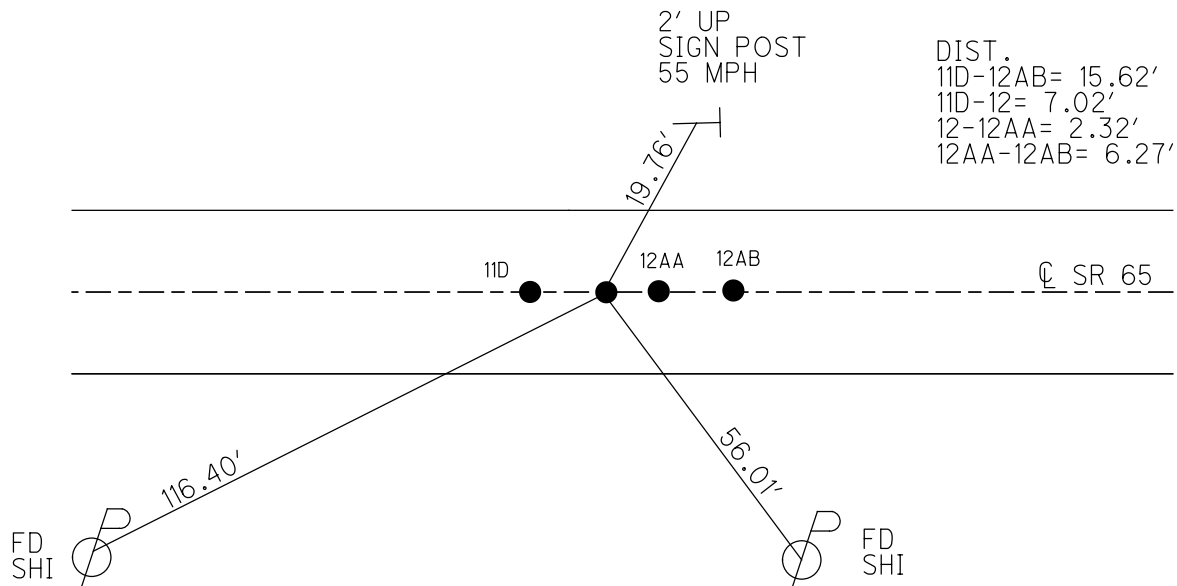

O.D.O.T. DISTRICT 2 SURVEY OFFICE (USE ONLY)

PERSONNEL

REFERENCE NO. 12 AA

SHEET 15 OF 22

NOTES RHOADES

DATE 4/11/22

ROUTE SR 65

H.C. NIESE

WEATHER FAIR

COUNTY WOOD

R.C. KETNER

TEMP. 63°

TOWNSHIP WASHINGTON

O'DONNELL

SECTION 35

DWG BY RHOADES

PID 95796

T 6 N R 9 E

TYPE MONUMENT MAG NAIL

ON SURFACE - ~~BELOW~~ ON

OFFSET CL PAVEMENT ON LT : RT

9.0' TO RT EDGE PAVEMENT


STATION: 278+32.63

HORIZ.DATUM: NAD83 2011


GEOID: NAVD88 2018

GRID: NORTHING: 648714.983

EASTING: 1613085.908

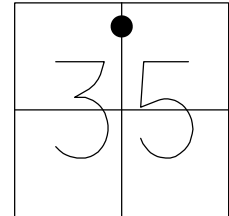

RECORD:
ORIGIN UNKNOWN
FD P.K./WASHER
6/23/04, DCH
SET MAG/WASHER
9/16/04, SAH
FD MAG NAIL
REFAA12
11/4/20, JFO
SET MAG/WASHER
10/6/22, TDN

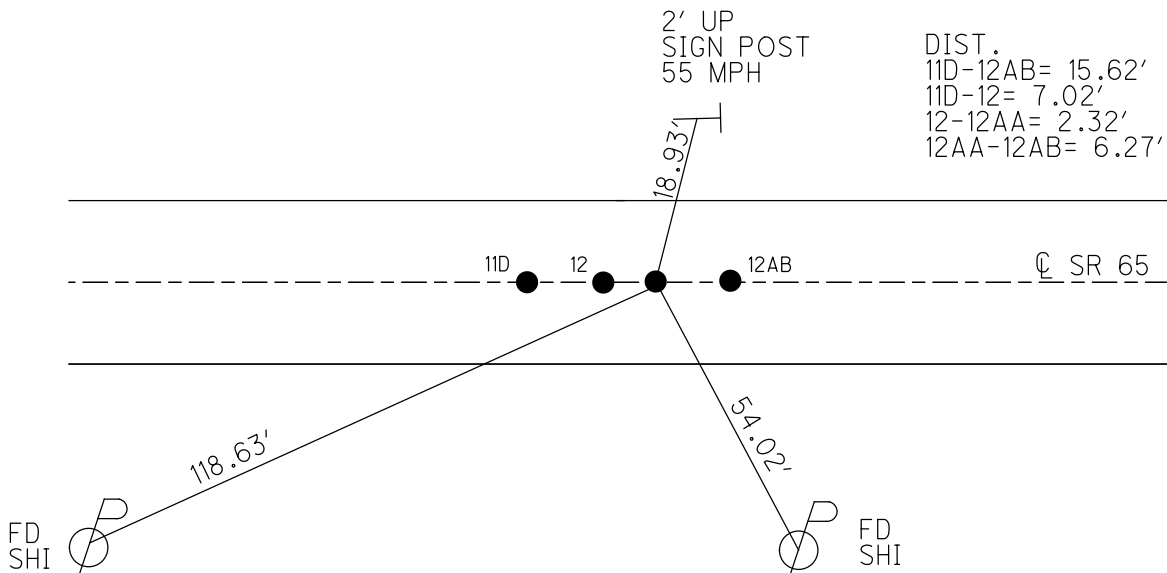

O.D.O.T. DISTRICT 2 SURVEY OFFICE (USE ONLY)

PERSONNEL

REFERENCE NO. 12 AB

SHEET 16 OF 22

NOTES RHOADES

DATE 4/11/22

ROUTE SR 65

H.C. NIESE

WEATHER FAIR

COUNTY WOOD

R.C. KETNER

TEMP. 63°

TOWNSHIP WASHINGTON

O'DONNELL

SECTION 35

DWG BY RHOADES

PID 95796

T 6 N R 9 E

TYPE MONUMENT MAG NAIL

ON SURFACE - ~~BELOW~~ ON

OFFSET CL PAVEMENT ON LT : RT

9.0' TO RT EDGE PAVEMENT


STATION: 278+38.92

HORZ.DATUM: NAD83 2011


GEOID: NAVD88 2018

GRID: NORTHING: 648718.264

EASTING: 1613091.259

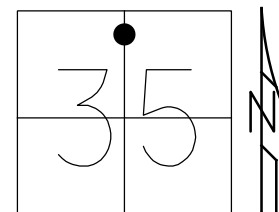

RECORD:
ORIGIN UNKNOWN
FD P.K./WASHER
6/23/04, DCH
SET MAG/WASHER
9/16/04, SAH
FD MAG NAIL
REFAB12
11/4/20, JFO
SET MAG/WASHER
10/6/22, TDN

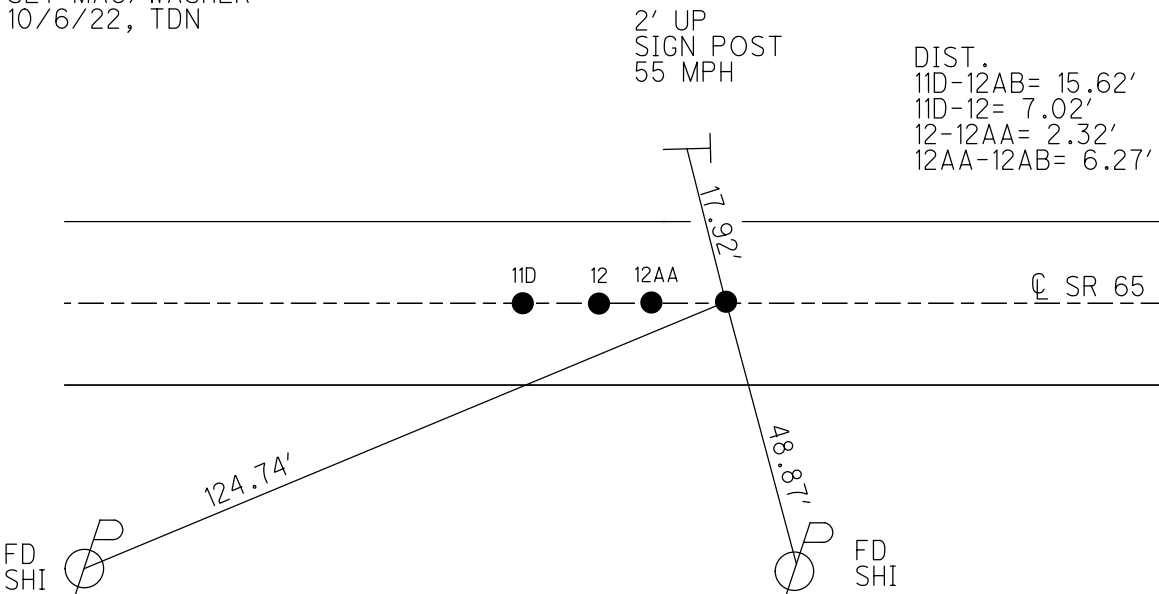

O.D.O.T. DISTRICT 2 SURVEY OFFICE (USE ONLY)

PERSONNEL

REFERENCE NO. 12 A

SHEET 17 OF 22

NOTES RHOADES

DATE 4/27/21

ROUTE SR 65

H.C. O'DONNELL

WEATHER SUNNY

COUNTY WOOD

R.C. RHOADES

TEMP. 70°

TOWNSHIP WASHINGTON

DWG BY RHOADES PID 95796

SECTION 35

T 6 N R 9 E

TYPE MONUMENT MAG SHANK

ON SURFACE - ~~BELOW~~ ON

OFFSET Q PAVEMENT ON LT : RT

10.2' TO LT EDGE PAVEMENT



STATION: 287+15.07

HORIZ.DATUM: NAD83 2011

GEOID: NAVD88 2018

GRID: NORTHING: 649174.860

EASTING: 1613838.925

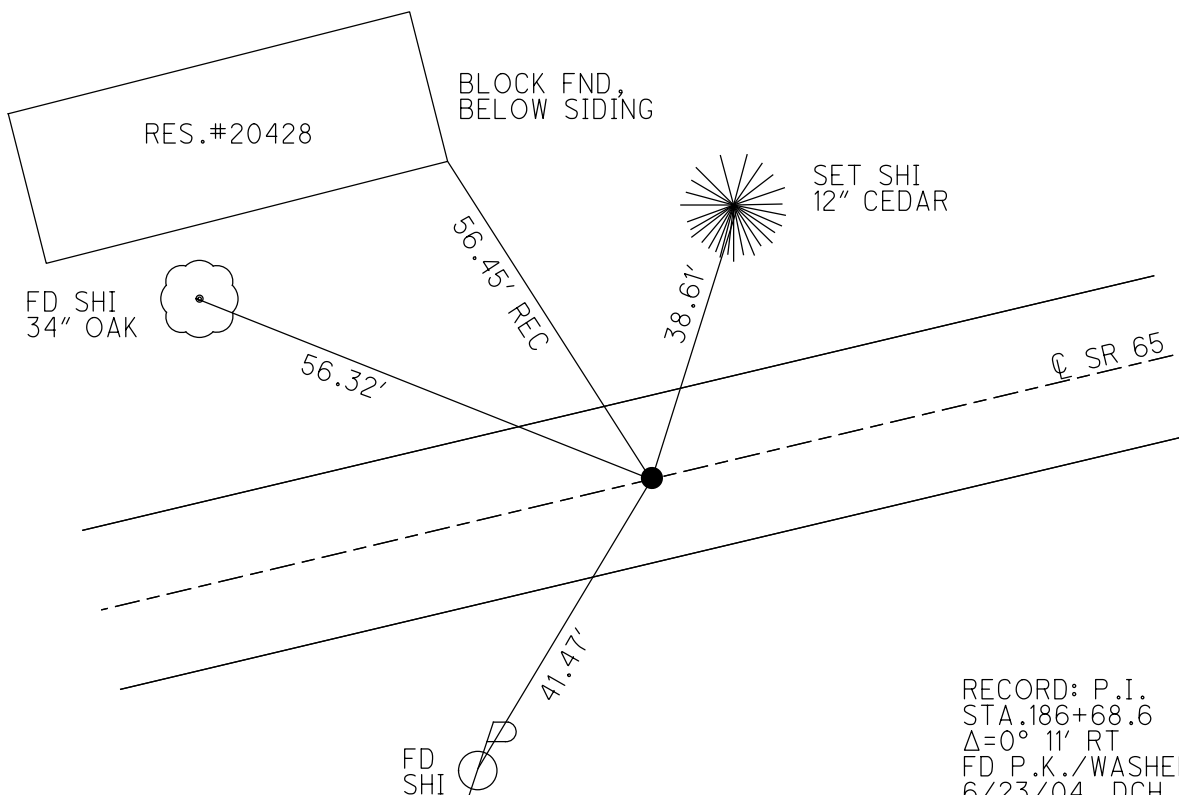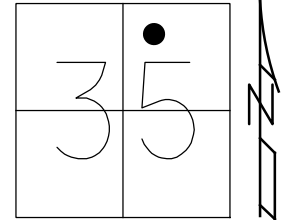

RECORD: P.I.
STA.186+68.6
 $\Delta=0^{\circ} 11' RT$
FD P.K./WASHER
6/23/04, DCH
SET MAG/WASHER
9/16/04, SAH
FD MAG SHANK
REFA12
11/4/20, JFO
SET MAG/WASHER
10/6/22, TDN

O.D.O.T. DISTRICT 2 SURVEY OFFICE (USE ONLY)

PERSONNEL

REFERENCE NO. 12 B

SHEET 18 OF 22

NOTES NIESE DATE 2/16/24
H.C. NIESE WEATHER FAIR
R.C. ASTON TEMP. 32°

ROUTE SR 65
COUNTY WOOD
TOWNSHIP WASHINGTON
SECTION 35

DWG BY RHOADES PID 93680

T 6 N R 9 E

TYPE MONUMENT MAG/WASHER

ON SURFACE - ~~BELOW~~ ON

OFFSET CL PAVEMENT 1.6' ~~LT~~ : RT

8.4' TO RT EDGE PAVEMENT


STATION: 292+21.11

HORZ.DATUM: NAD83 2011


GEOID: NAVD88 2018

GRID: NORTHING: 649437.399

EASTING: 1614271.527

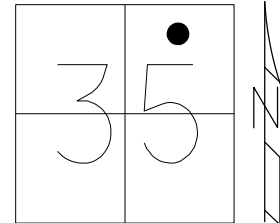

RECORD: P.I.
STA. 194+74
 $\Delta = 3^\circ 35' \text{ LT}$
 $D = 2^\circ 00'$
 $R = 2864.93$
 $T = 89.2$
 $L = 179.16'$
FD P.K./WASHER
6/23/04, DCH
SET MAG/WASHER
9/16/04, SAH
FD MAG/WASHER
REFB12
11/4/20, JFO
SET MAG/WASHER
10/6/22, TDN
FD MAG/WASHER
REF12B
2/16/24, TDN

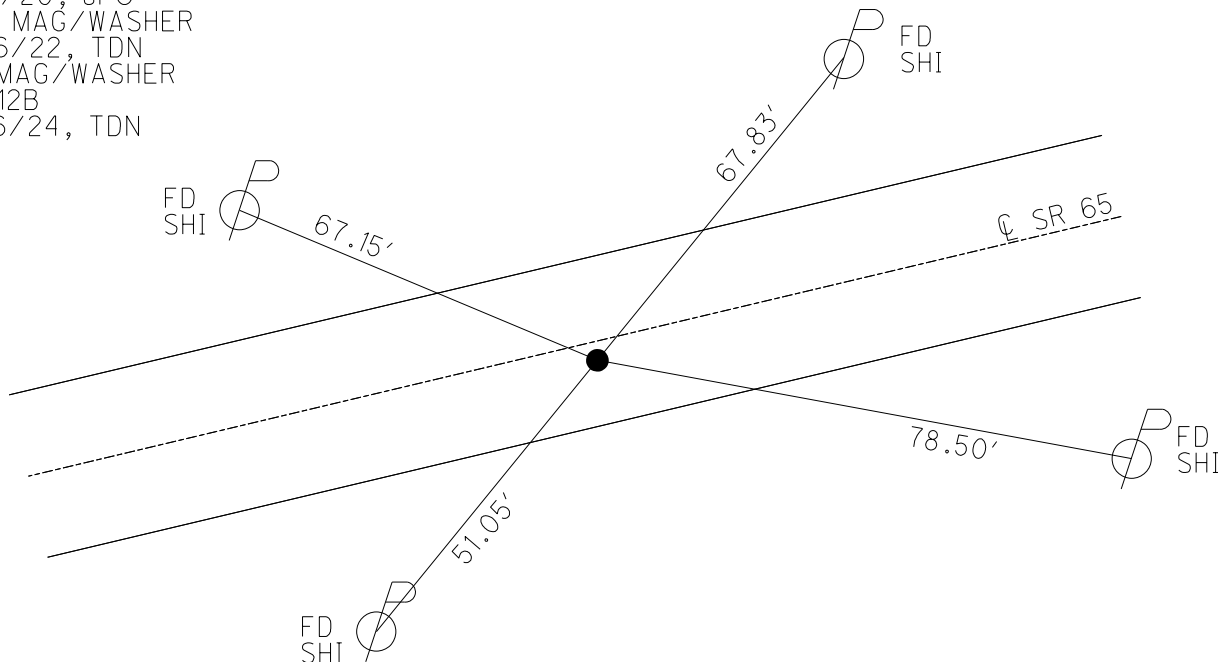

O.D.O.T. DISTRICT 2 SURVEY OFFICE (USE ONLY)

PERSONNEL

REFERENCE NO. 12 C

SHEET 19 OF 22

NOTES NIESE DATE 2/16/24

H.C. NIESE WEATHER FAIR

R.C. ASTON TEMP. 32°

ROUTE SR 65

COUNTY WOOD

TOWNSHIP WASHINGTON

SECTION 35

DWG BY RHOADES PID 93680

T 6 N R 9 E

TYPE MONUMENT MAG/WASHER

ON SURFACE - ~~BELOW~~ ON

OFFSET CL PAVEMENT 5.3' ~~LT~~ : RT

4.8' TO RT EDGE PAVEMENT


STATION: 297+44.53

HORZ.DATUM: NAD83 2011


GEOID: NAVD88 2018

GRID: NORTHING: 649736.379

EASTING: 1614701.227

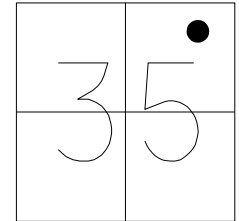

RECORD: P.I.
STA. 196+98.3
 $\Delta = 7^\circ 03' \text{ LT}$
 $D = 6^\circ 00'$
 $R = 959.37$
 $T = 58.85'$
 $L = 117.50'$
FD P.K./WASHER
6/23/04, DCH
SET MAG/WASHER
9/16/04, SAH
FD MAG/WASHER
REFC12
11/4/20, JFO
SET MAG/WASHER
10/7/22, TDN
FD MAG/WASHER
REF12C
2/16/24 TDN

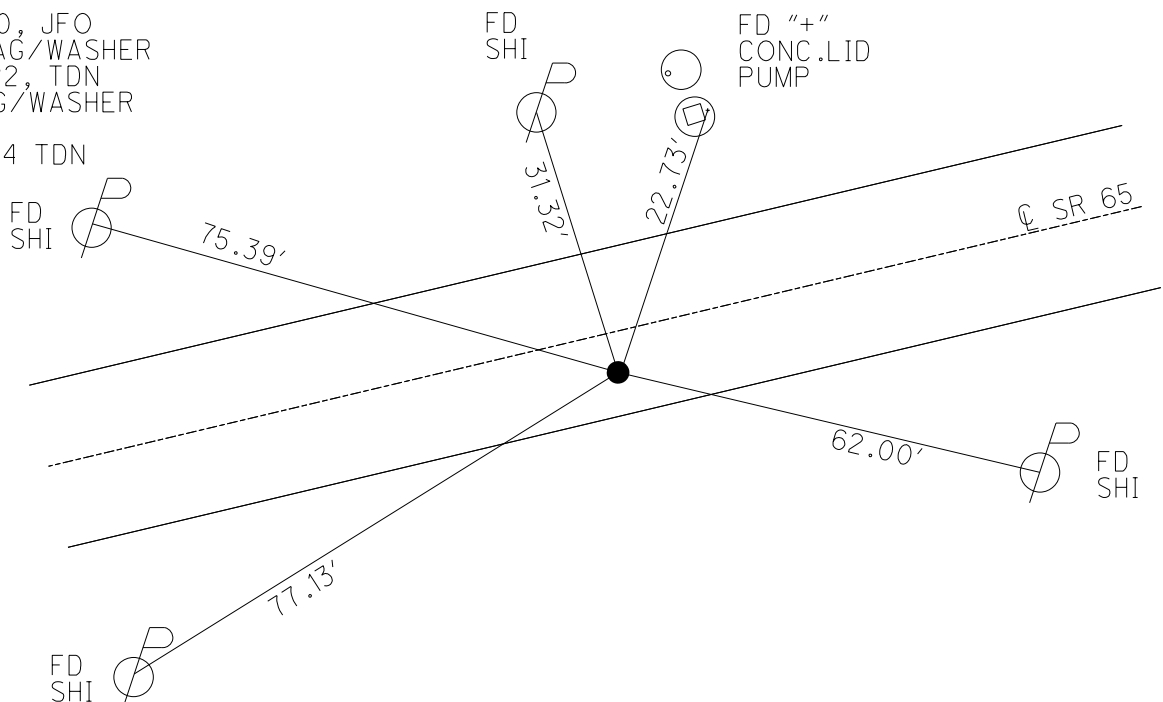

O.D.O.T. DISTRICT 2 SURVEY OFFICE (USE ONLY)

PERSONNEL

REFERENCE NO. 12 D

SHEET 20 OF 22

NOTES NIESE DATE 2/16/24

H.C. NIESE WEATHER FAIR

R.C. ASTON TEMP. 32°

ROUTE SR 65

COUNTY WOOD

TOWNSHIP WASHINGTON

SECTION 35

DWG BY RHOADES PID 93680

T 6 N R 9 E

TYPE MONUMENT MAG/WASHER

ON SURFACE - ~~BELOW~~ ON

OFFSET Q PAVEMENT 1.2' LT : ~~RT~~

8.8' TO LT EDGE PAVEMENT


STATION: 301+80.87

HORZ.DATUM: NAD83 2011

GEOID: NAVD88 2018

GRID: NORTHING: 650027.507

EASTING: 1615026.421

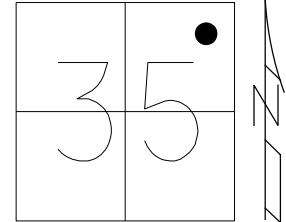

RECORD: P.I.

$\Delta = 3^\circ 50'$

D = $2^\circ 0'$

R = 2864.93

T = 25.98

L = 191.66

FD P.K./WASHER

6/23/04, DCH

SET MAG/WASHER

9/16/04, SAH

FD MAG/WASHER

REFD12

11/4/20, JFO


SET MAG/WASHER

10/7/22, TDN

FD MAG/WASHER

REF12D

2/16/24, TDN

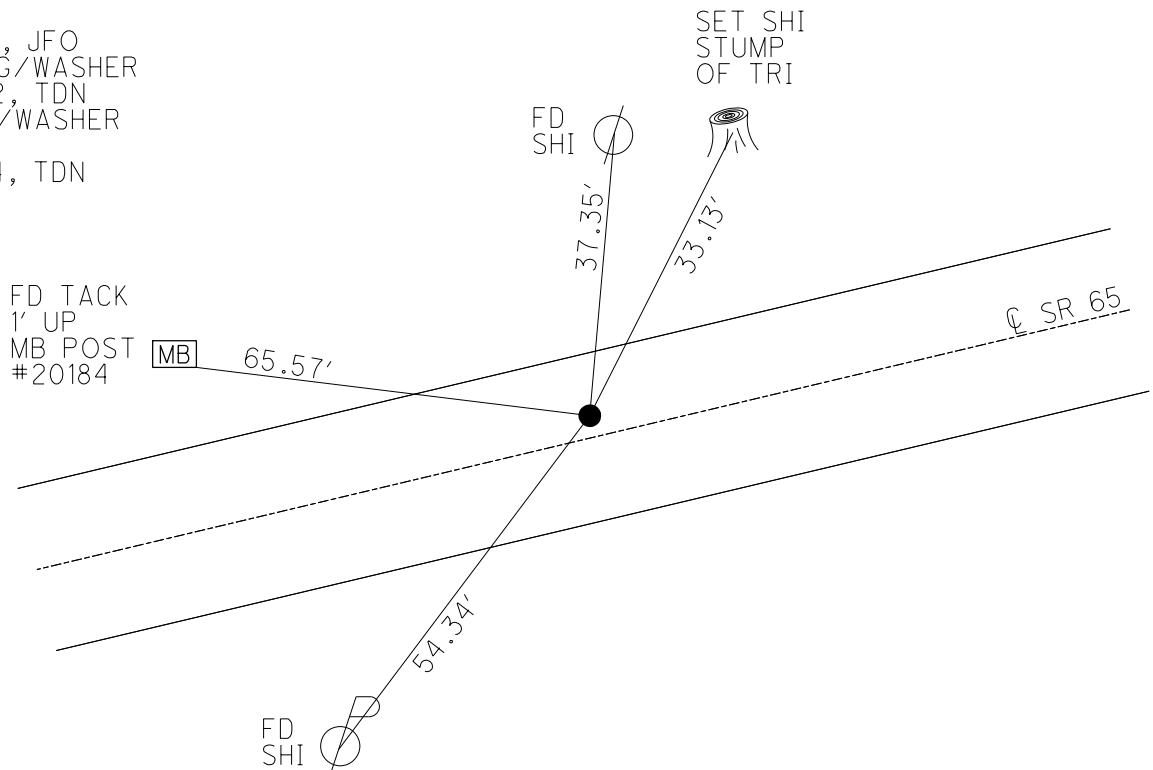

O.D.O.T. DISTRICT 2 SURVEY OFFICE (USE ONLY)

PERSONNEL

REFERENCE NO. 12 E

SHEET 21 OF 22

NOTES RHOADES

DATE 4/11/22

ROUTE SR 65

H.C. NIESE

WEATHER FAIR

COUNTY WOOD

R.C. KETNER

TEMP. 63°

TOWNSHIP WASHINGTON

O'DONNELL

SECTION 35

DWG BY RHOADES PID 95796

T 6 N R 9 E

TYPE MONUMENT MAG/WASHER

ON SURFACE - ~~BELOW~~ ON

OFFSET CL PAVEMENT 1.4' ~~LT~~ : RT

8' TO RT EDGE PAVEMENT


STATION: 305+85.32

HORZ.DATUM: NAD83 2011


GEOID: NAVD88 2018

GRID: NORTHING: 650276.054

EASTING: 1615345.927

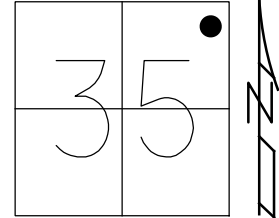

RECORD:
FD R.R.SPIKE
1.5' DOWN
6/23/04, DCH
SET MAG/WASHER
9/16/04, SAH
SET MAG/WASHER
REFE12
11/4/20, JFO
SET MAG/WASHER
10/7/22, TDN

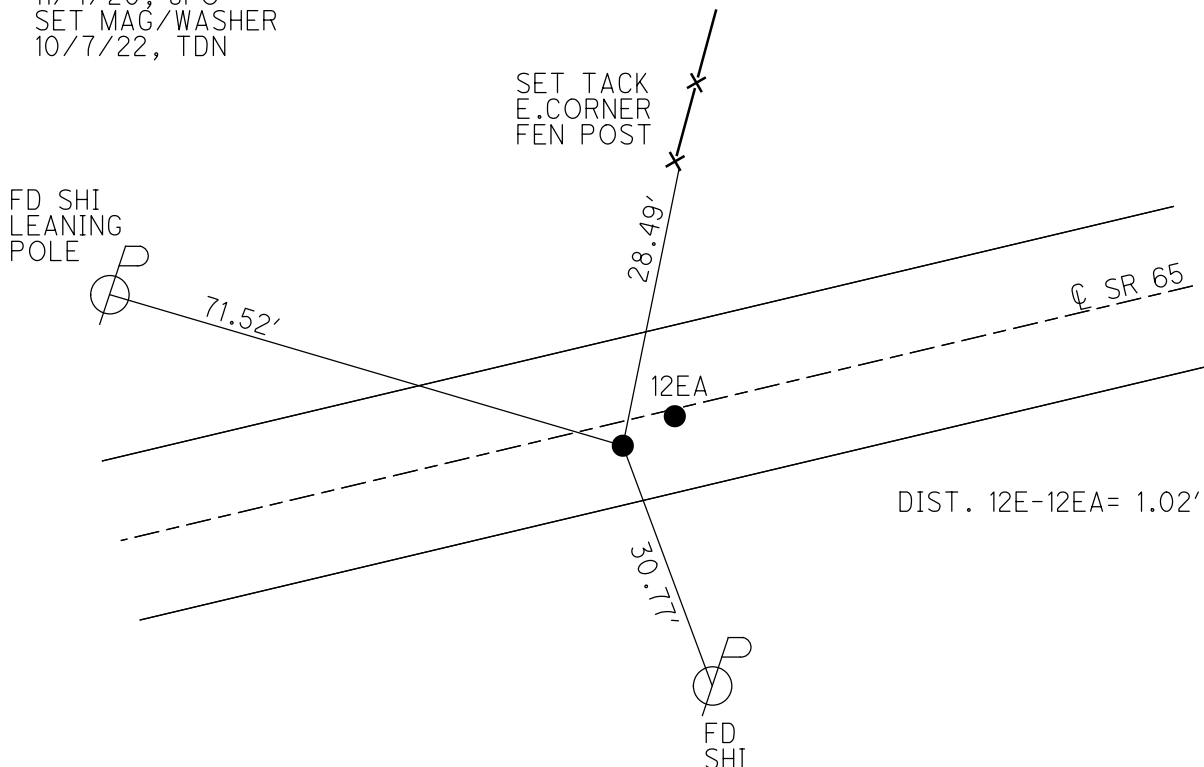

O.D.O.T. DISTRICT 2 SURVEY OFFICE (USE ONLY)

PERSONNEL

REFERENCE NO. 12 EA

SHEET 22 OF 22

NOTES RHOADES

DATE 4/11/22

ROUTE SR 65

H.C. NIESE

WEATHER FAIR

COUNTY WOOD

R.C. KETNER

TEMP. 63°

TOWNSHIP WASHINGTON

O'DONNELL

SECTION 35

DWG BY RHOADES

PID 95796

T 6 N R 9 E

TYPE MONUMENT MAG/WASHER

ON SURFACE - ~~BELOW~~ ON

OFFSET Q PAVEMENT 0.4' ~~LT~~ : RT

9' TO RT EDGE PAVEMENT


STATION: 305+86.34

HORIZ.DATUM: NAD83 2011

GEOID: NAVD88 2018

GRID: NORTHING: 650277.065

EASTING: 1615345.895

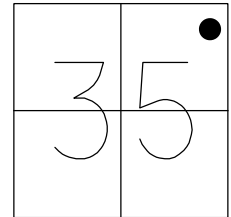

RECORD:

FD P.K./WASHER

1.5' DOWN

6/23/04, DCH

SET MAG/WASHER

9/16/04, SAH

SET MAG/WASHER

REFEA12

11/4/20, JFO

SET MAG/WASHER

10/7/22, TDN

FD SHI
LEANING
POLE



71.68'

SET TACK
E.CORNER
FEN POST

27.48'

12E

31.69'



FD
SHI

Q SR 65

DIST. 12E-12EA= 1.02'

O.D.O.T. DISTRICT 2 SURVEY OFFICE (USE ONLY)

PERSONNEL

REFERENCE NO. 12 F

SHEET 1 OF 63

NOTES RHOADES

DATE 4/11/22

ROUTE SR 65

H.C. NIESE

WEATHER FAIR

COUNTY WOOD

R.C. KETNER

TEMP. 63°

TOWNSHIP WASHINGTON

O'DONNELL

SECTION 35

DWG BY RHOADES PID 95796

T 6 N R 9 E

TYPE MONUMENT MAG SHANK

ON SURFACE - ~~BELOW~~ ON

OFFSET Q PAVEMENT 4.4' ~~LT~~ : RT

6.2' TO RT EDGE PAVEMENT



STATION: 306+71.32

HORZ.DATUM: NAD83 2011

GEOID: NAVD88 2018

GRID: NORTHING: 650328.746

EASTING: 1615413.660

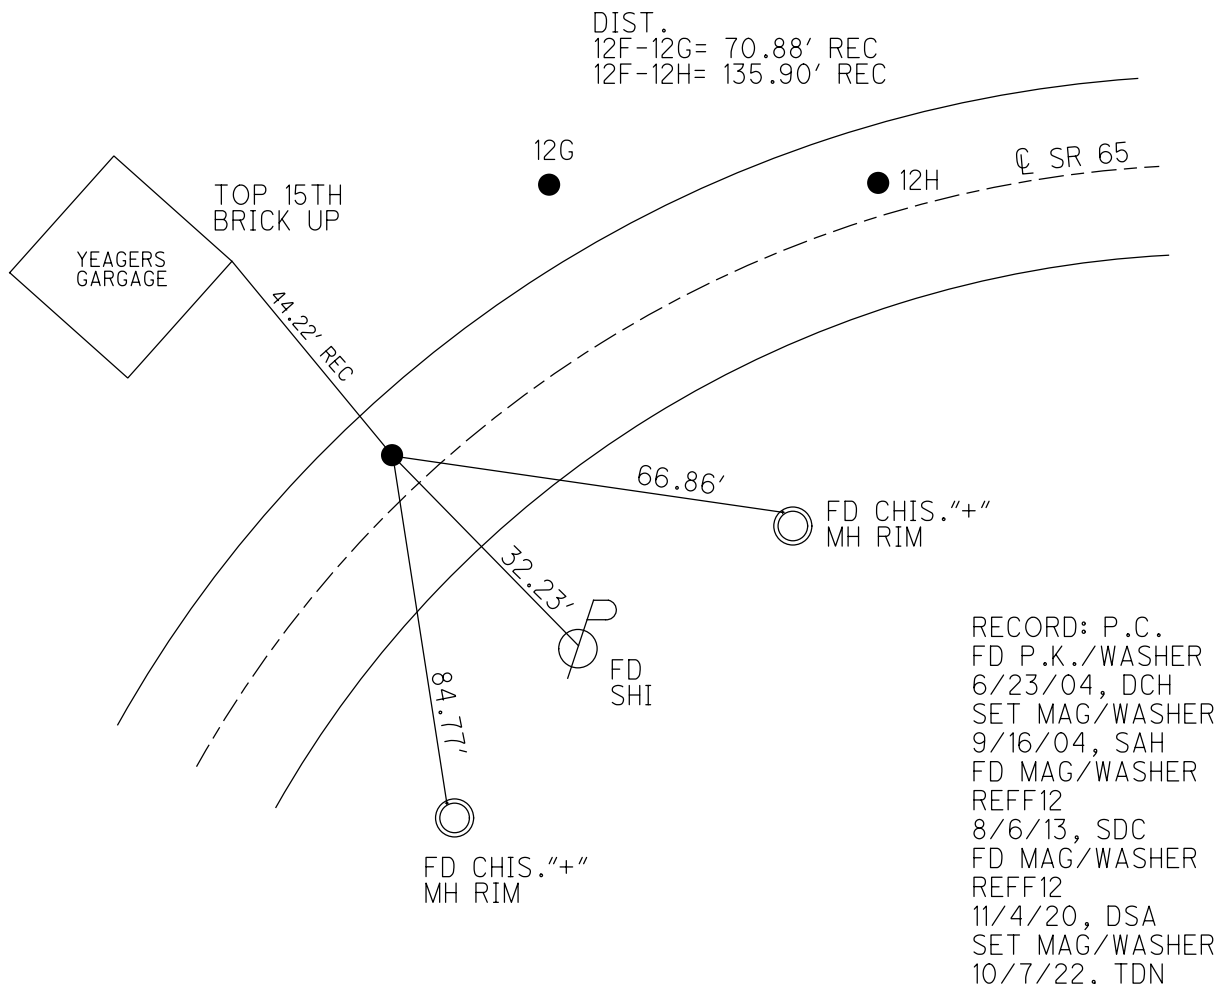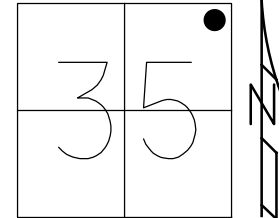

O.D.O.T. DISTRICT 2 SURVEY OFFICE (USE ONLY)

PERSONNEL

REFERENCE NO. 12 G

SHEET 2 OF 63

NOTES RHOADES

DATE 11/4/20

ROUTE SR 65

H.C. O'DONNELL

WEATHER FAIR

COUNTY WOOD

R.C. RHOADES

TEMP. 40°

TOWNSHIP WASHINGTON

DWG BY RHOADES PID 95796

SECTION 35

T 6 N R 9 E

TYPE MONUMENT 1/2" IPIPE

ON SURFACE - ~~BELOW~~ ON

OFFSET Q PAVEMENT 19.2' LT : ~~RT~~

8.1' LT TO LT EDGE PAVEMENT



STATION: 307+42.27

HORZ. DATUM: NAD83 2011

GEOID: NAVD88 2018

GRID: NORTHING: -

EASTING: -

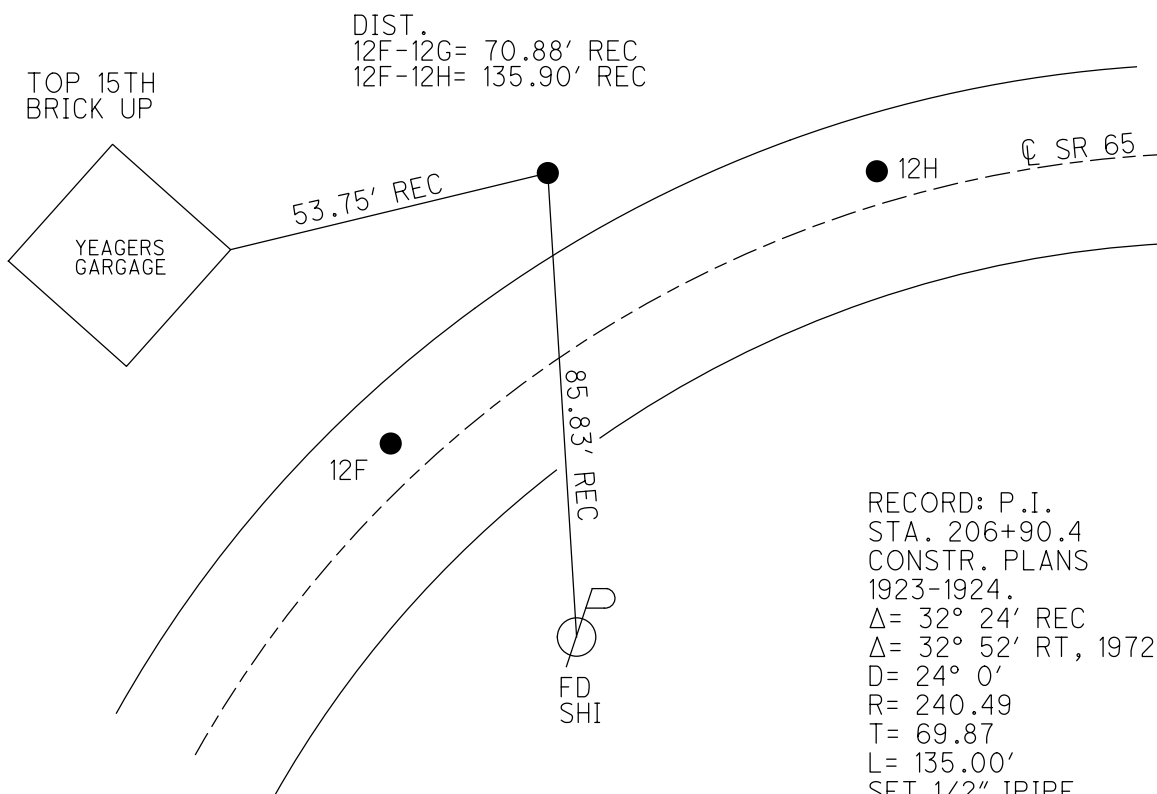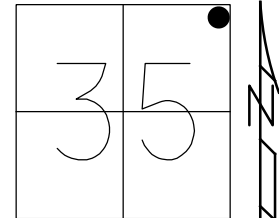

RECORD: P.I.
STA. 206+90.4
CONSTR. PLANS
1923-1924.
 $\Delta = 32^\circ 24'$ REC
 $\Delta = 32^\circ 52'$ RT, 1972
D= 24' 0"
R= 240.49
T= 69.87
L= 135.00'
SET 1/2" IPIPE
2/2/1972, BURNSIDE
FD 1/2" IPIPE
12/14/81, HOFFMAN
D.N.F. POINT
8/30/90, 4/17/92,
9/16/04, 8/5/13,
11/4/20, JFO

PERSONNEL

REFERENCE NO. 12 H

SHEET 3 OF 63

NOTES _____ RHOADES

DATE 4/11/22ROUTE SR 65H.C. NIESE

WEATHER FAIR

COUNTY WOOD

R.C. KETNER

TEMP. 63°

TOWNSHIP WASHINGTON

O'DONNELL

DWG BY RHOADESPID 95796

T_6_N R_9_E

TYPE MONUMENT MAG/WASHER

ON SURFACE - ~~BELOW~~ ON

OFFSET C PAVEMENT 4.7' LT : ~~RT~~

5.7' TO LT EDGE PAVEMENT

STATION: 308+07.44

HORZ.DATUM: NAD83 2011


GEOID: NAVD88 2018

GRID: NORTHING: 650378.453

EASTING: 1615540.165

RECORD: P.T.
FD P.K./WASHER
6/23/04, DCH
SET MAG/WASHER
9/16/04, SAH
FD MAG/WASHER
REFH12
8/6/13, SDC
FD MAG/WASHER
REFH12
11/4/20, JFO
SET MAG/WASHER
10/7/22, TDN

DIST.
12F-12G= 70.88' REC
12F-12H= 135.90' REC

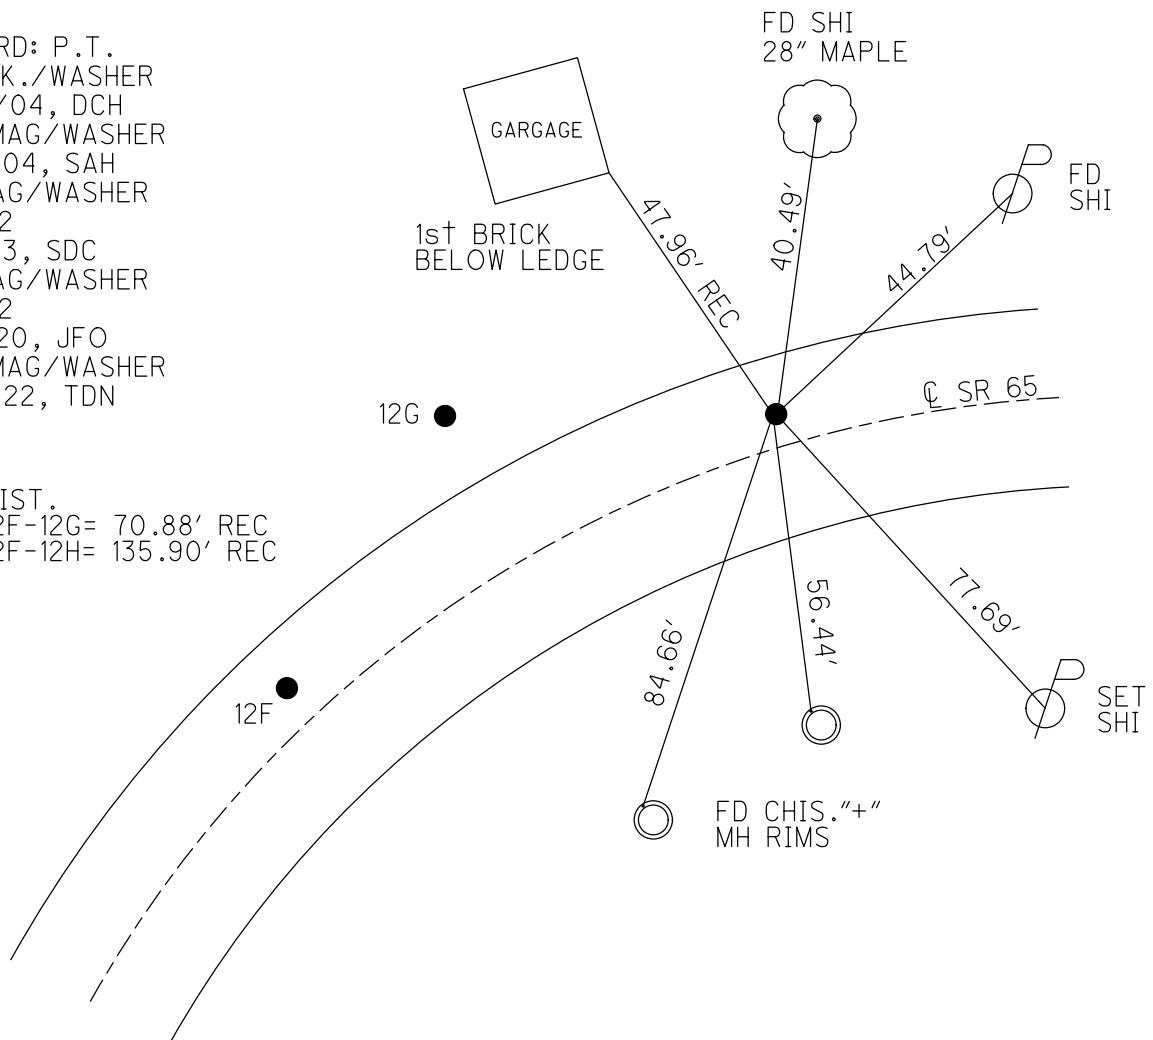

O.D.O.T. DISTRICT 2 SURVEY OFFICE (USE ONLY)

PERSONNEL

REFERENCE NO. 12 I

SHEET 4 OF 63

NOTES RHOADES

DATE 4/11/22

ROUTE SR 65

H.C. NIESE

WEATHER FAIR

COUNTY WOOD

R.C. KETNER

TEMP. 63°

TOWNSHIP WASHINGTON

O'DONNELL

SECTION 35

DWG BY RHOADES

PID 95796

T 6 N R 9 E

TYPE MONUMENT MAG/WASHER

ON SURFACE - ~~BELOW~~ ON

OFFSET Q PAVEMENT ON LT : RT

9.8' TO LT EDGE PAVEMENT


STATION: 310+67

HORZ.DATUM: NAD83 2011

GEOID: NAVD88 2018

GRID: NORTHING: 650401.261

EASTING: 1615800.613

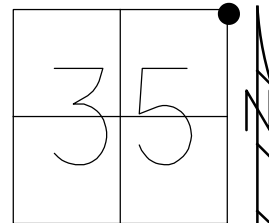

NOTE:

UNKNOWN ORIGIN

FD P.K./WASHER

4/20/15, EBW


FD MAG/WASHER


REFI12

11/4/20, JFO

SET MAG/WASHER

10/7/22, TDN

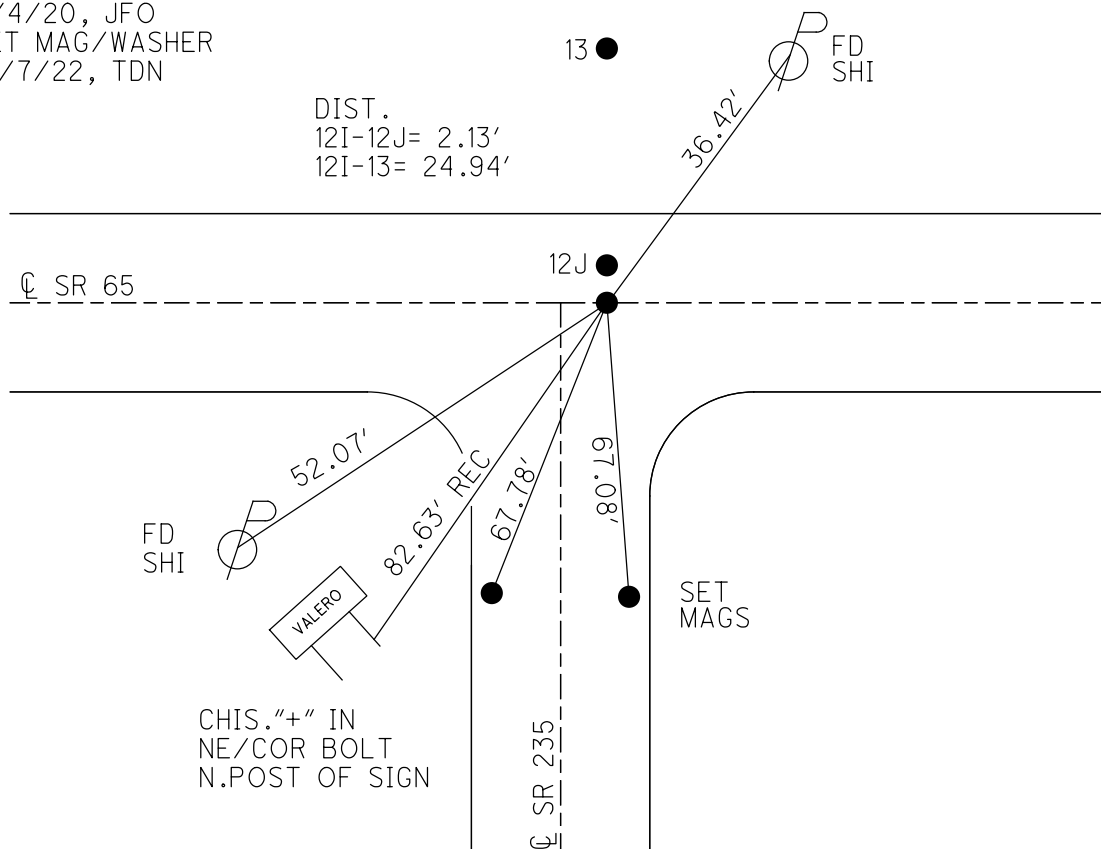

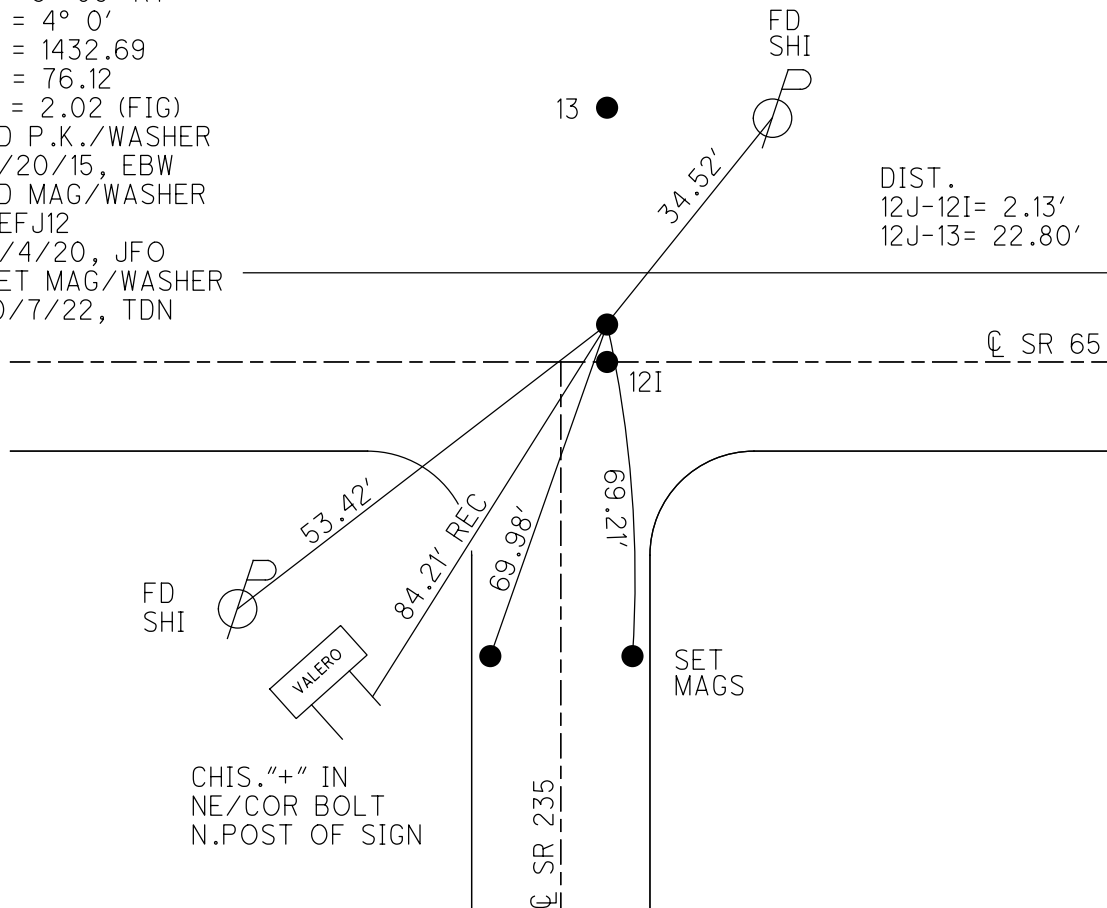

O.D.O.T. DISTRICT 2 SURVEY OFFICE (USE ONLY)

PERSONNEL _____ REFERENCE NO. 13 SHEET 6 OF 63

NOTES RHOADES DATE 4/11/22 ROUTE SR 65
H.C. NIESE WEATHER FAIR COUNTY WOOD
R.C. KETNER TEMP. 63° TOWNSHIP WASHINGTON
O'DONNELL SECTION 35

DWG BY RHOADES PID 95796 T 6 N R 9 E

TYPE MONUMENT 1" IPIPE

~~ON SURFACE~~ - BELOW 3"


OFFSET Q PAVEMENT 30.3' LT : ~~RT~~

20.4' LT TO LT EDGE PAVEMENT


STATION: 310+67

HORIZ.DATUM: NAD83 2011 GEOID: NAVD88 2018

GRID: NORTHING: 650424.092 EASTING: 1615800.831

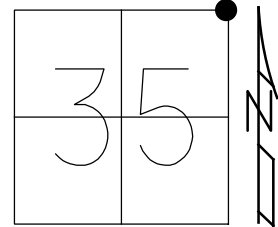

RECORD:
NE/COR.SEC.35
FD 3/4" IPIPE
6/23/04
8/6/13, SDC
FD 3/4" IPIPE
4/20/15, EBW
FD 3/4" IPIPE
3" DOWN
11/4/20, JFO

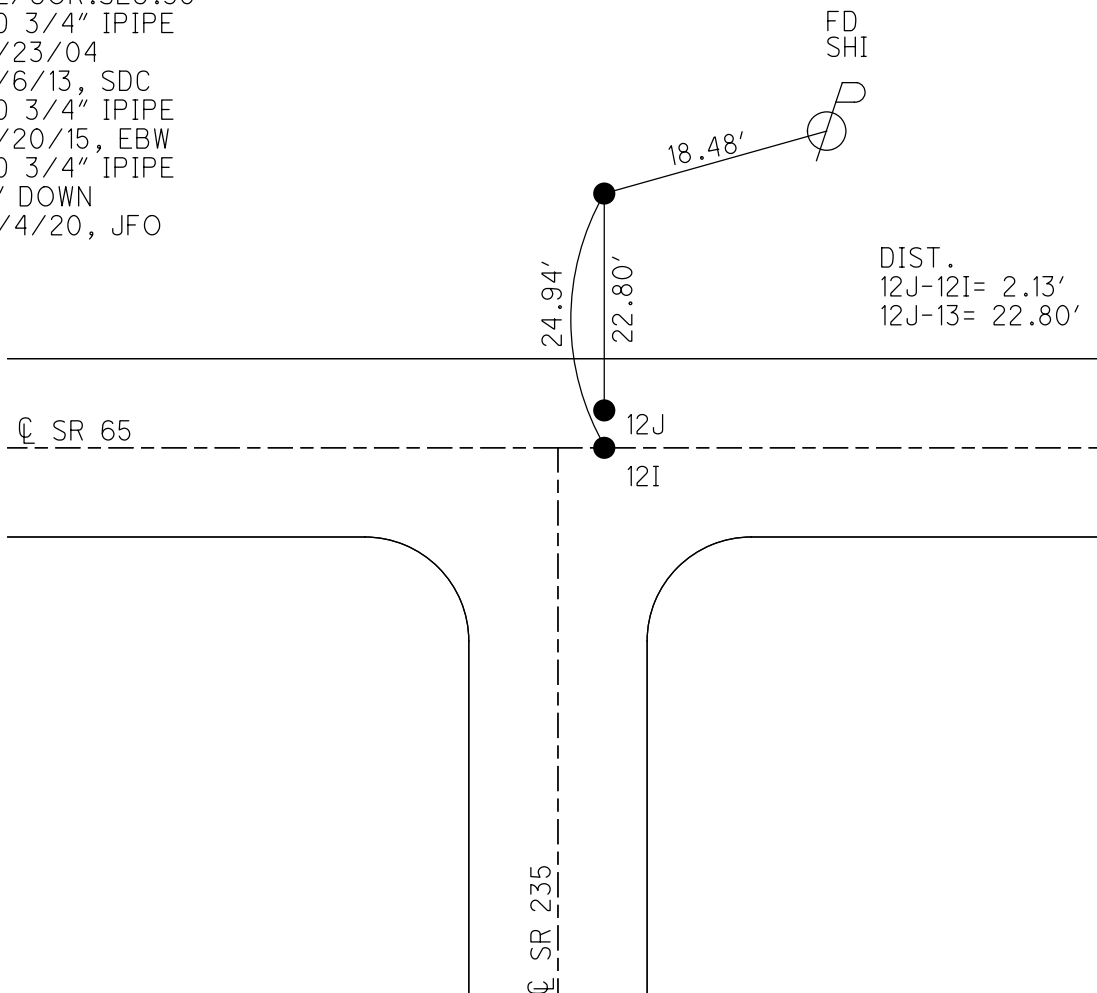

O.D.O.T. DISTRICT 2 SURVEY OFFICE (USE ONLY)

PERSONNEL

REFERENCE NO. 13 A

SHEET 7 OF 63

NOTES RHOADES

DATE 4/11/22

ROUTE SR 65

H.C. NIESE

WEATHER FAIR

COUNTY WOOD

R.C. KETNER

TEMP. 63°

TOWNSHIP WASHINGTON

O'DONNELL

SECTION 25

DWG BY RHOADES

PID 95796

T 6 N R 9 E

TYPE MONUMENT MAG/WASHER

ON SURFACE - ~~BELOW~~ ON

OFFSET Q PAVEMENT 2.9' ~~LT~~ : RT

7.2' TO RT EDGE PAVEMENT



STATION: 316+65.77

HORZ.DATUM: NAD83 2011

GEOID: NAVD88 2018

GRID: NORTHING: 650396.113

EASTING: 1616399.105

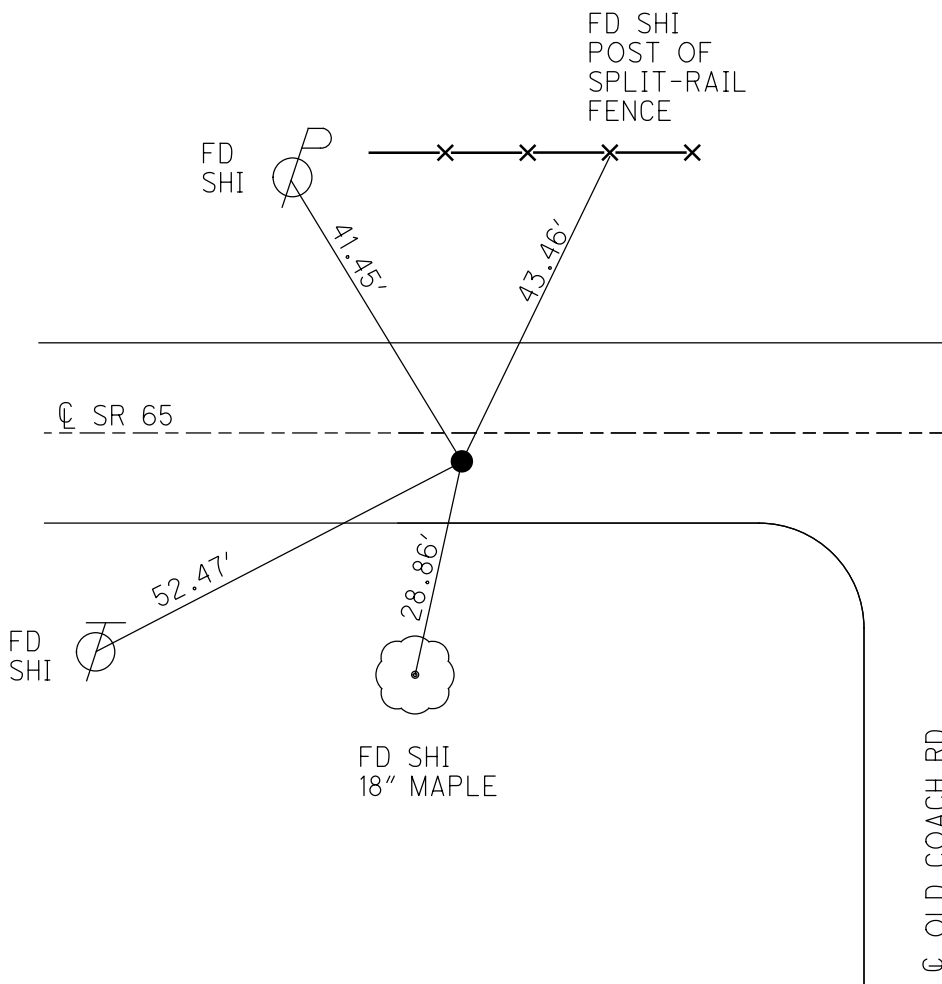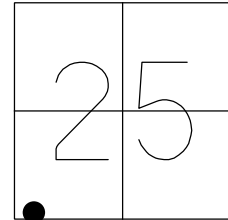

RECORD: P.I.
STA. 216+23.2
 $\Delta = 1^\circ 35' \text{ RT}$
 $\Delta = 1^\circ 32' \text{ RT}$
MEAS. 1972
FD P.K./WASHER
5/14/04
SET P.K./WASHER
8/31/92, MB
FD P.K.SHANK
REFA13
8/6/13, SDC
4/20/15, EBW
SET MAG/WASHER
NEWREFA13
7/20/15, JFO
FD MAG/WASHER
REFA13
11/4/20, JFO

O.D.O.T. DISTRICT 2 SURVEY OFFICE (USE ONLY)

PERSONNEL

REFERENCE NO. 13 B

SHEET 8 OF 63

NOTES RHOADES
H.C. WESTFALL
R.C. O'DONNELL

DATE 4/20/15
WEATHER WINDY
TEMP. 59°

ROUTE SR 65
COUNTY WOOD
TOWNSHIP WASHINGTON
SECTION 25
T 6 N R 9 E

TYPE MONUMENT P.K.SHANK


ON SURFACE - ~~BELOW~~ ON

~~LEFT~~ - PAV'T - RIGHT 2.8'

7.0' ~~TORT~~ EDGE PAVEMENT


S.L.M. 318+59.38

Grid: Northing: 650399.038 Easting: 1616560.667

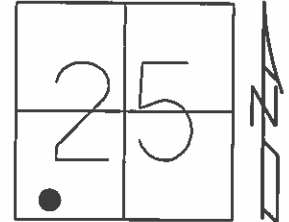

RECORD: P.C.
STA. 318+1

FD P.K./WASHER
5/14/04
SET P.K./WASHER
8/31/92, CL
FD P.K.SHANK
GPS, REFB13
8/6/13, SDC
SET MAG/WASHER
GPS, NEWREFB13
7/20/15, JFO

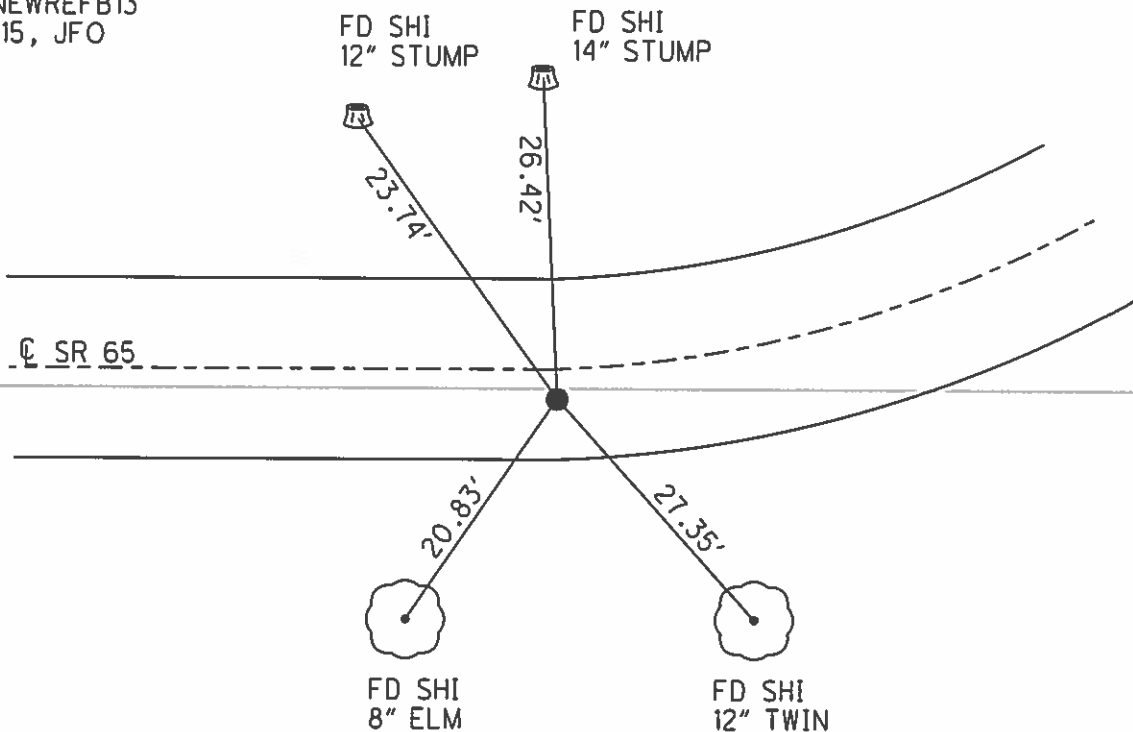

O.D.O.T. DISTRICT 2 SURVEY OFFICE (USE ONLY)

PERSONNEL

REFERENCE NO. 13 BC

SHEET 9 OF 63

NOTES RHOADES

DATE 4/20/15

ROUTE SR 65

H.C. WESTFALL

WEATHER WINDY

COUNTY WOOD

R.C. O'DONNELL

TEMP. 59°

TOWNSHIP WASHINGTON

SECTION 25

T 6 N R 9 E

TYPE MONUMENT 1" IPIPE


ON SURFACE - ~~BELOW~~ ON

~~LEFT~~ - PAV'T - RIGHT 24.5'

13.2' RT TORT EDGE PAVEMENT

S.L.M. 319+88.03

Grid: Northing: 650400.236 Easting: 1616673.399

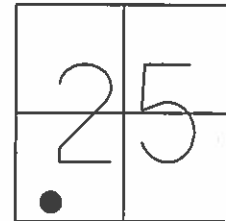


RECORD: P.I.
STA. 219+13.8
CURVE DATA FROM
CONSTR.PLAN 1923-24
 $\Delta = 32^\circ 34' \text{ LT}$
 $D = 13^\circ 0'$
 $R = 441.68$
 $T = 129.01$
 $L = 250.51$

FD 1" IPIPE
5/14/04, MB
8/6/13, SDC
GPS, REFBC13

FD SHI
10" TWIN
ASH



71.87' REC

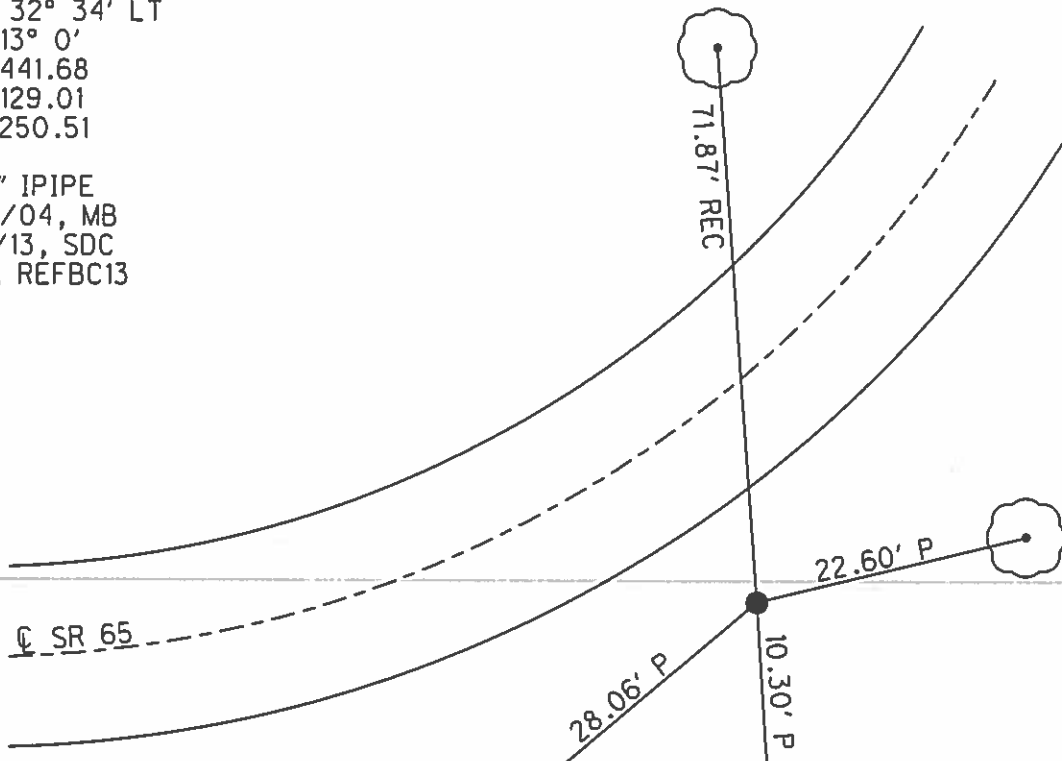

SET SHI
12" TWIN

SET
SHI

SET SHI
6" ELM

O.D.O.T. DISTRICT 2 SURVEY OFFICE (USE ONLY)

PERSONNEL

REFERENCE NO. 13 C

SHEET 10 OF 63

NOTES RHOADES

DATE 4/20/15

ROUTE SR 65

H.C. WESTFALL

WEATHER WINDY

COUNTY WOOD

R.C. O'DONNELL

TEMP. 59°

TOWNSHIP WASHINGTON

SECTION 25

T 6 N R 9 E

TYPE MONUMENT P.K./WASHER



ON SURFACE - ~~BELOW~~ ON

~~LEFT~~ - PAV'T - RIGHT 3.0'

7.2' TORT EDGE PAVEMENT

S.L.M. 321+09.76

Grid: Northing: 650472.689 Easting: 1616796.563

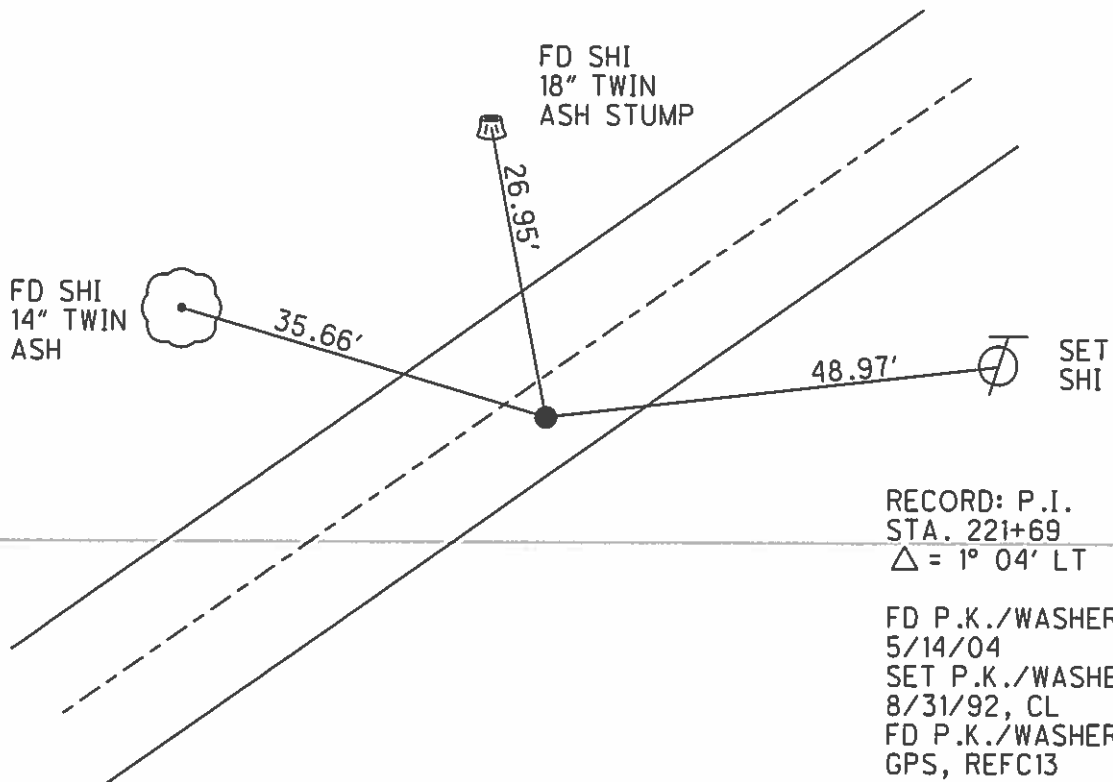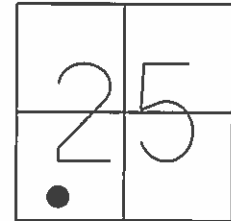

RECORD: P.I.
STA. 221+69
 $\Delta = 1^\circ 04' \text{ LT}$

FD P.K./WASHER
5/14/04
SET P.K./WASHER
8/31/92, CL
FD P.K./WASHER
GPS, REFC13
8/6/13, SDC
SET MAG/WASHER
GPS, NEWREFC13
7/20/15, JFO

O.D.O.T. DISTRICT 2 SURVEY OFFICE (USE ONLY)

PERSONNEL

REFERENCE NO. 13 D

SHEET 11 OF 63

NOTES RHOADES

DATE 4/20/15

ROUTE SR 65

H.C. WESTFALL

WEATHER RAIN

COUNTY WOOD

R.C. O'DONNELL

TEMP. 60°

TOWNSHIP WASHINGTON

LEU

SECTION 25

T 6 N R 9 E

TYPE MONUMENT P.K./WASHER


ON SURFACE - ~~BELOW~~ ON

LEFT - PAV'T - ~~RIGHT~~ 3.7'

6.3' TOLT EDGE PAVEMENT


S.L.M. 323+53.54

Grid: Northing: 650609.479 Easting: 1616998.379

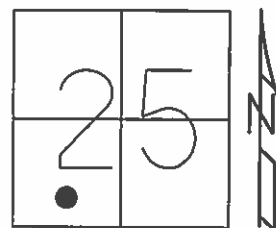

RECORD: P.C.
STA. 323+03

FD P.K./WASHER
5/13/04
SET P.K./WASHER
8/31/92, CL
FD P.K./WASHER
GPS, REFD13
8/5/13, SDC
SET MAG/WASHER
GPS, NEWREFD13
7/20/15, JFO

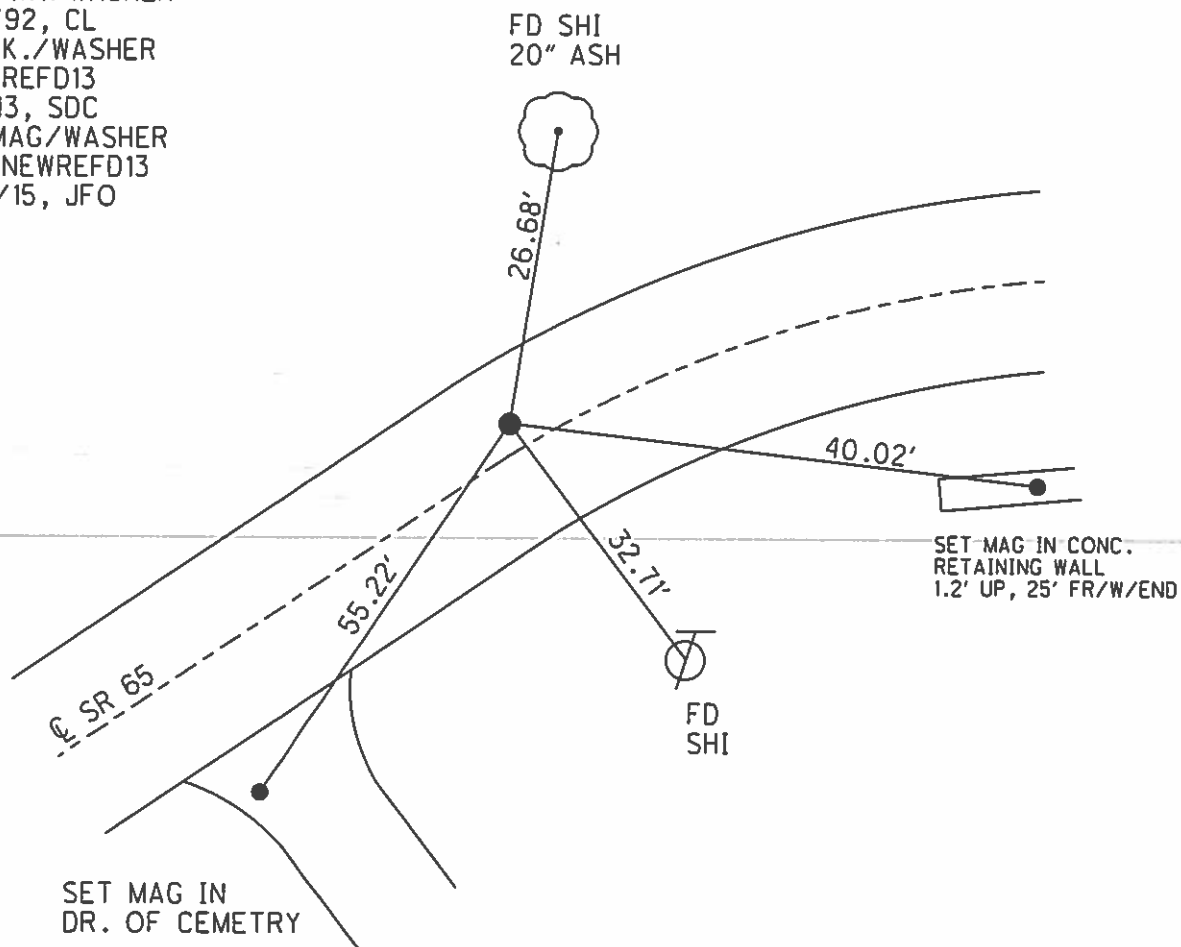

O.D.O.T. DISTRICT 2 SURVEY OFFICE (USE ONLY)

PERSONNEL

REFERENCE NO. 13 E

SHEET 12 OF 63

NOTES RHOADES
H.C. WESTFALL
R.C. O'CONNELL
LEU

DATE 4/20/15
WEATHER RAIN
TEMP. 60°

ROUTE SR 65
COUNTY WOOD
TOWNSHIP WASHINGTON
SECTION 25
T 6 N R 9 E

TYPE MONUMENT P.K./WASHER


ON SURFACE - ~~BELOW~~ ON

LEFT - PAV'T - ~~RIGHT~~ 13.8'

3.8' LT TOLT EDGE PAVEMENT


S.L.M. 324+38.88

Grid: Northing: 650657.997 Easting: 1617068.433

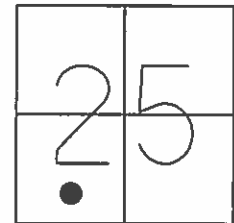

RECORD: P.I.
STA. 223+64.8
CURVE DATA FROM
CONSTR.PLAN 1923-24
 $\Delta = 19^\circ 49'$
 $D = 12^\circ 0'$
 $R = 478.34$
 $T = 83.55$
 $L = 165.14$

FD P.K./WASHER
5/13/04, MB
SET SM.R.R.SPIKE
8/31/32, CL
FD SM.R.R.SPIKE
GPS, REFE13, SDC
SET MAG/WASHER
GPS, NEWREFE13
7/20/15, JFO

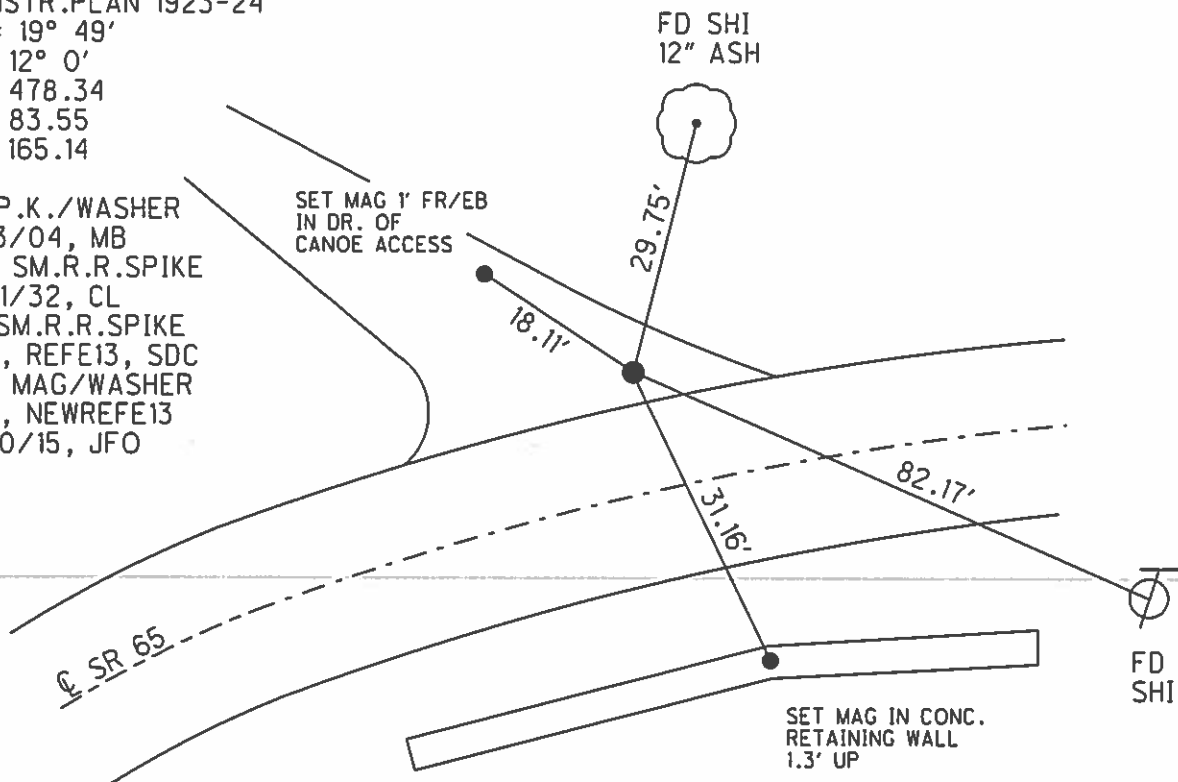

O.D.O.T. DISTRICT 2 SURVEY OFFICE (USE ONLY)

PERSONNEL

REFERENCE NO. 14 DA

SHEET 13 OF 63

NOTES RHOADES
H.C. WESTFALL
R.C. O'DONNELL

DATE 4/20/15
WEATHER WINDY
TEMP. 55°

ROUTE SR 65
COUNTY WOOD
TOWNSHIP WASHINGTON
SECTION 25
T 6 N R 9 E

TYPE MONUMENT P.K./WASHER


ON SURFACE - ~~BELOW~~ ON

~~LEFT~~ - PAV'T - RIGHT 0.3'

9.3' TO LT EDGE PAVEMENT


S.L.M. 350+19.02

Grid: Northing: 652531.409 Easting: 1618443.103

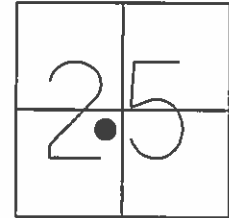

RECORD: P.C.
STA. 349+77.03

FD P.K./WASHER
9/25/00
SET P.K./WASHER
6/20/03, MB
FD P.K./WASHER
TS, REFDA14
8/26/13, SDC
SET MAG/WASHER
BY GPS, NEWREFDA14
7/20/15, JFO

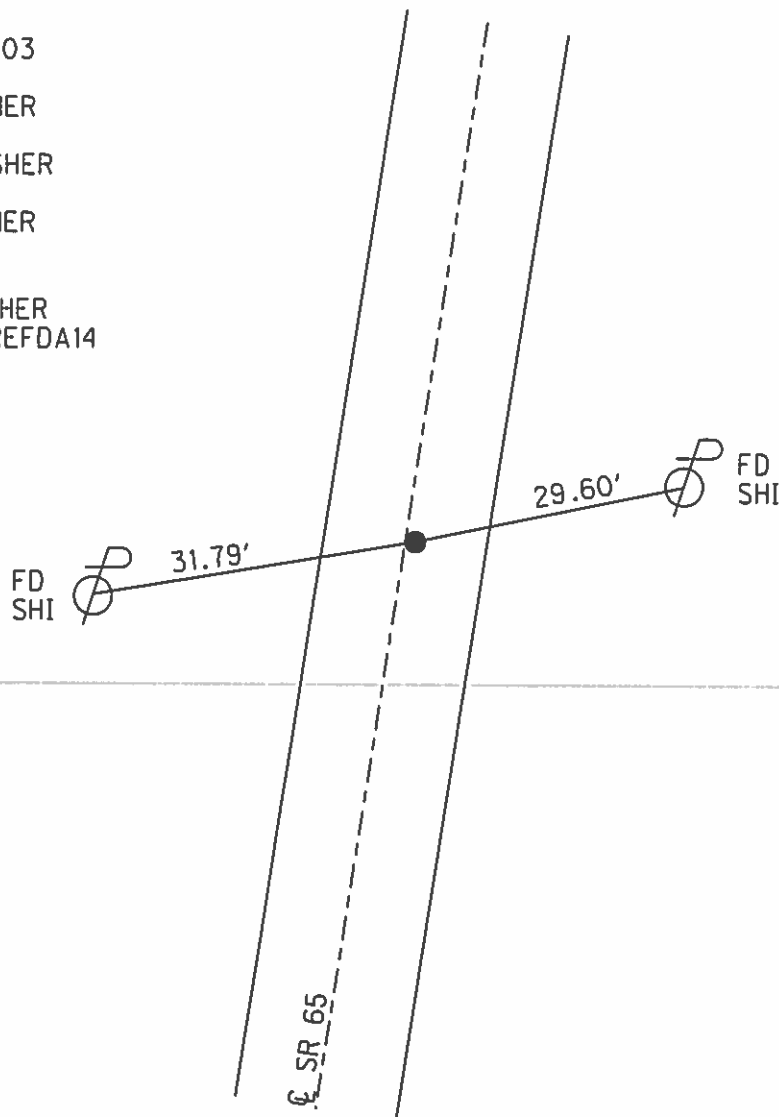

O.D.O.T. DISTRICT 2 SURVEY OFFICE (USE ONLY)

PERSONNEL

REFERENCE NO. 14 DB

SHEET 14 OF 63

NOTES RHOADES

DATE 4/20/15

ROUTE SR 65

H.C. WESTFALL

WEATHER WINDY

COUNTY WOOD

R.C. O'CONNELL

TEMP. 55°

TOWNSHIP WASHINGTON

SECTION 25

T 6 N R 9 E

TYPE MONUMENT LG.R.R.SPIKE


ON SURFACE - ~~BELOW~~ ON

LEFT - PAV'T - ~~RIGHT~~ 3.6'

6.0' TOLT EDGE PAVEMENT

S.L.M. 351+25.97

Grid: Northing: 652637.185 Easting: 1618459.437

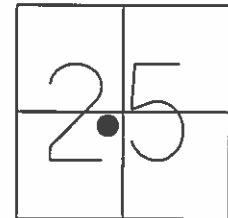

FD SHI
18" MAPLE



42.32'

21.83'

20.12'

MB

SET BARN SPK.
2.5' FR/EP

RECORD: P.I.
STA. 350+83.97
CURVE DATA 1992
 $\Delta = 6^\circ 14' 01''$ RT
D = $2^\circ 55' 03''$
R = 1963.91'
T = 106.94'
L = 213.67'
E = 2.91'

FD LG.R.R.SPIKE
9/25/00, MB
FD LG.R.R.SPIKE
TS, REFDB14
8/6/13, SDC
SET MAG/WASHER
GPS, NEWREFDB14
7/20/15, JFO

SET TACK
4X4" MB POST
1.7' UP

SR 65

O.D.O.T. DISTRICT 2 SURVEY OFFICE (USE ONLY)

PERSONNEL

REFERENCE NO. 14 DC

SHEET 15 OF 63

NOTES RHOADES

DATE 4/20/15

ROUTE SR 65

H.C. WESTFALL

WEATHER WINDY

COUNTY WOOD

R.C. O'DONNELL

TEMP. 55°

TOWNSHIP WASHINGTON

SECTION 25

T 6 N R 9 E

TYPE MONUMENT P.K./WASHER



ON SURFACE - ~~BELOW~~ ON

LEFT - PAV'T - ~~RIGHT~~ 0.4'

9.3' TO LT EDGE PAVEMENT

S.L.M. 352+32.71

Grid: Northing: 652740.477 Easting: 1618486.968

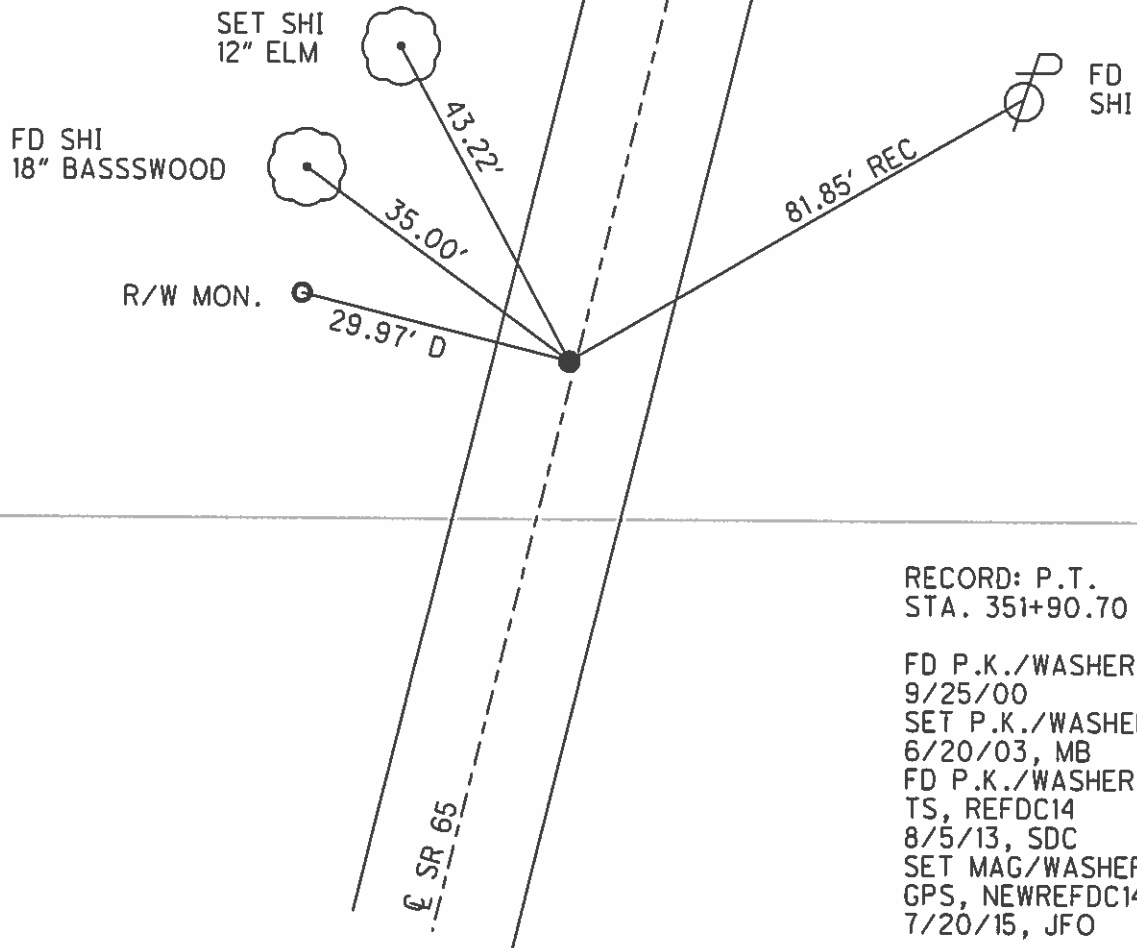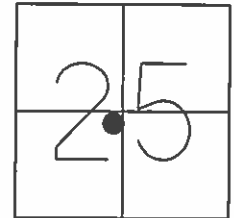

O.D.O.T. DISTRICT 2 SURVEY OFFICE (USE ONLY)

PERSONNEL

REFERENCE NO. 14 DD

SHEET 16 OF 63



NOTES RHOADES
H.C. WESTFALL
R.C. O'DONNELL

DATE 4/20/15
WEATHER WINDY
TEMP. 55°

ROUTE SR 65
COUNTY WOOD
TOWNSHIP WASHINGTON
SECTION 25
T 6 N R 9 E

TYPE MONUMENT P.K./WASHER
ON SURFACE - ~~BELOW~~ ON
LEFT - PAV'T - ~~RIGHT~~ 2.0'
7.7' TOLT EDGE PAVEMENT
S.L.M. 354+54.80

Grid: Northing: 652954.999 Easting: 1618544.257

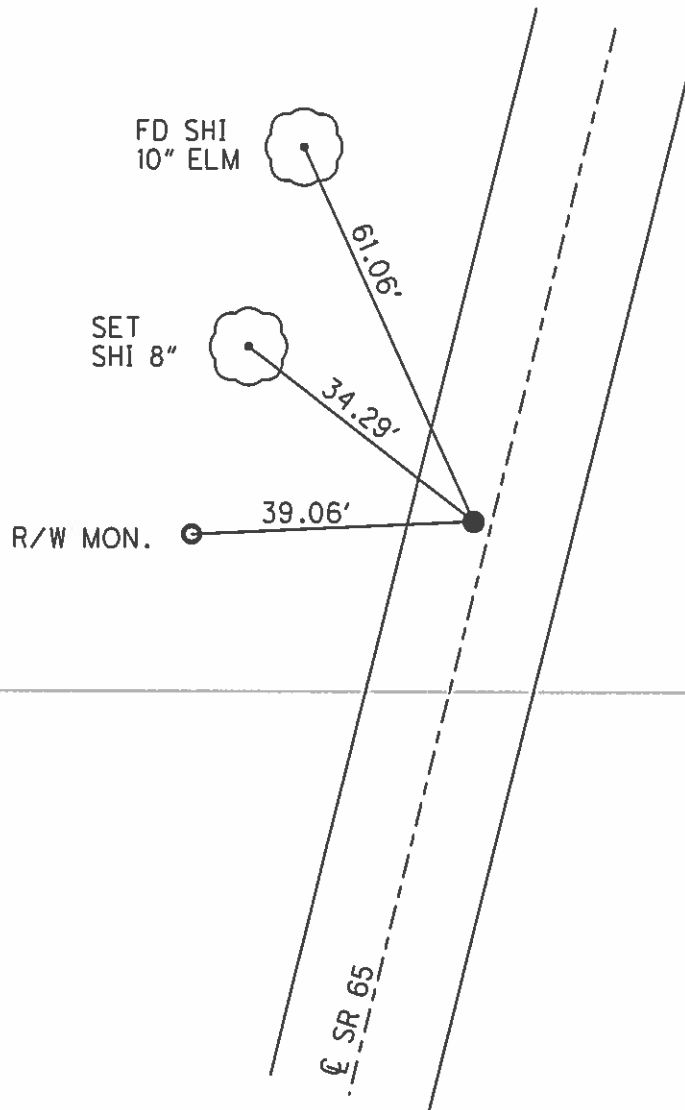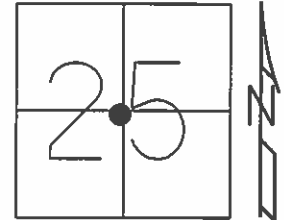

RECORD: P.C.
STA. 254+28.4
SET P.K. NAIL, 1972.
STA. 354+12.86
SET P.K./WASHER
8/27/92, CL

FD P.K./WASHER
9/25/00
SET P.K./WASHER
5/14/04, MB
FD P.K./WASHER
TS, REFDD14
8/5/13, SDC
SET MAG/WASHER
GPS, NEWREFDD14
7/20/15, JFO

O.D.O.T. DISTRICT 2 SURVEY OFFICE (USE ONLY)

PERSONNEL

REFERENCE NO. 14 DE

SHEET 17 OF 63



NOTES RHOADES
H.C. WESTFALL
R.C. O'DONNELL
LEU

DATE 4/20/15
WEATHER WINDY
TEMP. 55°

ROUTE SR 65
COUNTY WOOD
TOWNSHIP WASHINGTON
SECTION 25
T 6 N R 9 E

TYPE MONUMENT P.K./WASHER
ON SURFACE - ~~BELOW~~ ON
LEFT - PAV'T - ~~RIGHT~~ 8.5'
1.0' TOLT EDGE PAVEMENT
S.L.M. 355+79.46

Grid: Northing: 653075.553 Easting: 1618576.342

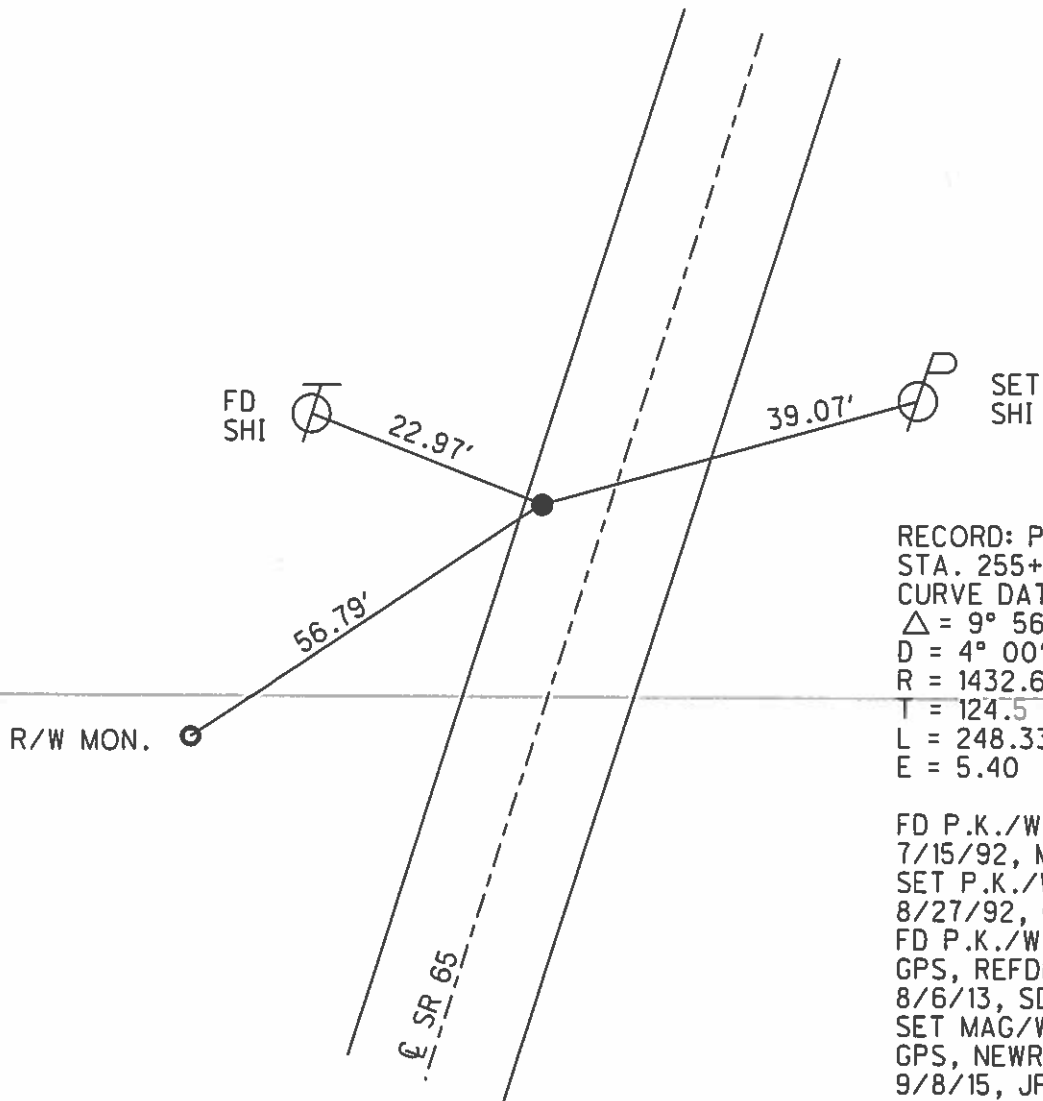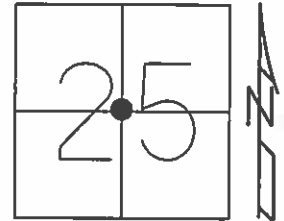

RECORD: P.I.
STA. 255+52.9
CURVE DATA 1926
 $\Delta = 9^\circ 56' \text{ RT}$
 $D = 4^\circ 00'$
 $R = 1432.69$
 $T = 124.5$
 $L = 248.33$
 $E = 5.40$

FD P.K./WASHER
7/15/92, MB
SET P.K./WASHER
8/27/92, CL
FD P.K./WASHER
GPS, REFDE14
8/6/13, SDC
SET MAG/WASHER
GPS, NEWREFDE14
9/8/15, JFO

O.D.O.T. DISTRICT 2 SURVEY OFFICE (USE ONLY)

PERSONNEL

REFERENCE NO. 14 DF

SHEET 18 OF 63

NOTES RHOADES

DATE 4/20/15

ROUTE SR 65

H.C. WESTFALL

WEATHER WINDY

COUNTY WOOD

R.C. O'DONNELL

TEMP. 55°

TOWNSHIP WASHINGTON

LEU

SECTION 25

T 6 N R 9 E

TYPE MONUMENT P.K./WASHER


ON SURFACE - ~~BELOW~~ ON

LEFT - PAV'T - ~~RIGHT~~ 1.8'

7.8' TO LT EDGE PAVEMENT

S.L.M. 357+03.50

Grid: Northing: 653188.357 Easting: 1618629.286

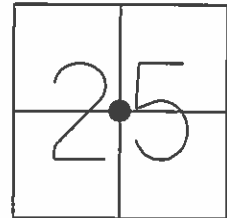

RECORD: P.T.
STA. 256+76.73
SET P.K. NAIL, 1972.
SET P.K./WASHER
8/27/92, CL

FD P.K./WASHER
7/15/92
SET P.K./WASHER
5/14/04, MB
FD P.K./WASHER
GPS, REFDF14
8/6/13, SDC
SET MAG/WASHER
GPS, NEWREFDF14
9/8/15, JFO

FD
SHI



51.57'

FD SHI
18" PINE



81.76'

57.77'



FD
SHI

SR 65

O.D.O.T. DISTRICT 2 SURVEY OFFICE (USE ONLY)

PERSONNEL

REFERENCE NO. 14 E

SHEET 19 OF 63

NOTES
H.C. RHOADES
R.C. WESTFALL
O'DONNELL
LEU

DATE 4/20/15
WEATHER WINDY
TEMP. 55°

ROUTE SR 65
COUNTY WOOD
TOWNSHIP WASHINGTON
SECTION 25
T 6 N R 9 E

TYPE MONUMENT SM.R.R.SPIKE


~~ON SURFACE~~ - BELOW 0.3'

LEFT - PAV'T - ~~RIGHT~~ 0.8'


- TOLT EDGE PAVEMENT

S.L.M. 361+55.29

Grid: Northing: 653075.553 Easting: 1618576.342

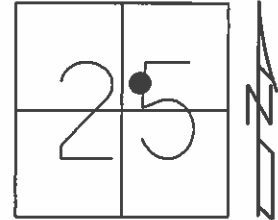

RECORD: P.I.
CURVE DATA 1926
STA. 262+50.0
 $\Delta = 7^\circ 13' \text{ RT}$
 $D = 3^\circ 00'$
 $R = 1910.08$
 $T = 120.74$
 $L = 240.55$

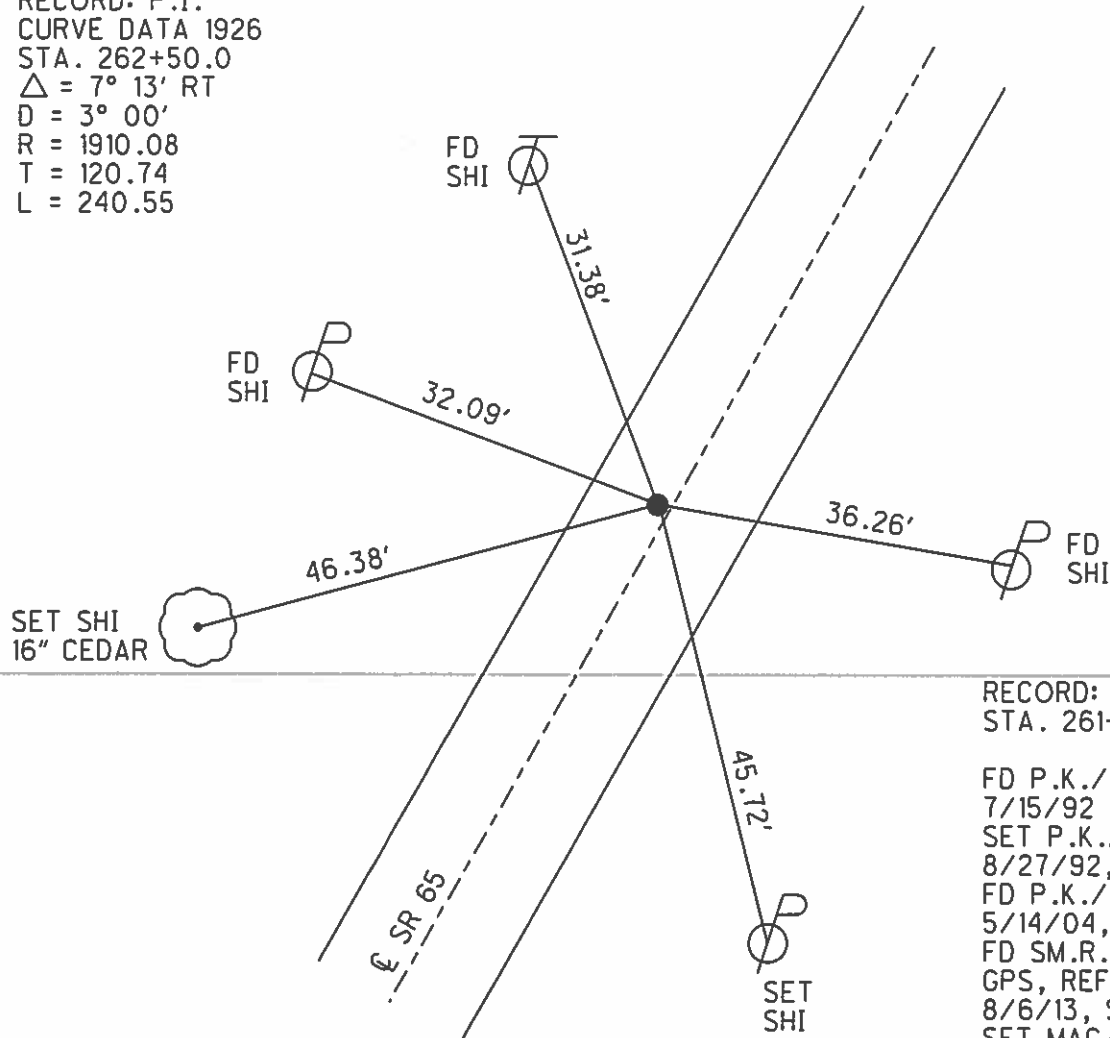

RECORD: P.C.
STA. 261+29.26

FD P.K./WASHER
7/15/92
SET P.K./WASHER
8/27/92, MB
FD P.K./WASHER
5/14/04, MC
FD SM.R.R.SPIKE
GPS, REFE14
8/6/13, SDC
SET MAG/WASHER
GPS, NEWREFE14
9/8/15, JFO

O.D.O.T. DISTRICT 2 SURVEY OFFICE (USE ONLY)

PERSONNEL

REFERENCE NO 14 EF

SHEET 20 OF 63


NOTES RHOADES
H.C. WESTFALL
R.C. O'DONNELL
LEU

DATE 4/20/15
WEATHER WINDY
TEMP. 55°


ROUTE SR 65
COUNTY WOOD
TOWNSHIP WASHINGTON
SECTION 25
T 6 N R 9 E

TYPE MONUMENT P.K. SHANK
ON SURFACE - ~~BELOW~~ ON
LEFT - PAV'T - ~~RIGHT~~ 1.7'
- TOLT EDGE PAVEMENT
S.L.M. 363+95.14

Grid: Northing: 653807.405 Easting: 1618936.757

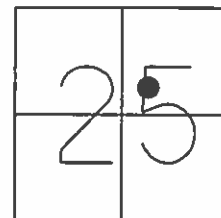

RECORD: P.I.
CURVE DATA 1926
STA. 262+50.0
 $\Delta = 7^\circ 13' \text{ RT}$
D = 3° 00'
R = 1910.08
T = 120.74
L = 240.55

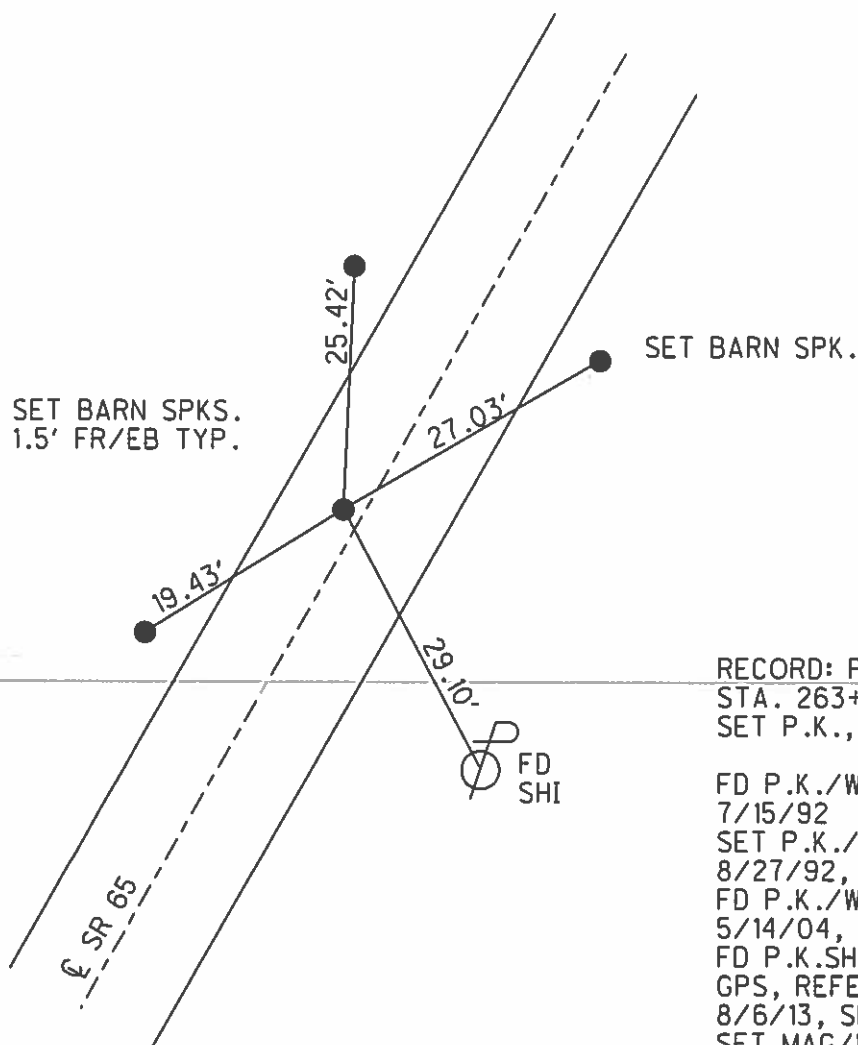

RECORD: P.T.
STA. 263+69.81
SET P.K., 1972

FD P.K./WASHER
7/15/92
SET P.K./WASHER
8/27/92, MB
FD P.K./WASHER
5/14/04, MC
FD P.K. SHANK
GPS, REFEF14
8/6/13, SDC
SET MAG/WASHER
GPS, NEWREFEF14
9/8/15, JFO

O.D.O.T. DISTRICT 2 SURVEY OFFICE (USE ONLY)

PERSONNEL

REFERENCE NO. 14 F

SHEET 21 OF 63


NOTES LEU
H.C. O'DONNELL
R.C. WESTFALL
RHOADES

DATE 4/21/15
WEATHER WINDY
TEMP. 43°

ROUTE SR 65
COUNTY WOOD
TOWNSHIP WASHINGTON
SECTION 25
T 6 N R 9 E


TYPE MONUMENT P.K./WASHER
ON SURFACE - ~~BELOW~~ ON
LEFT - PAV'T - ~~RIGHT~~ 1.6'
- TORT EDGE PAVEMENT
S.L.M. 370+41.35

Grid: Northing: 654353.659 Easting: 1619282.017

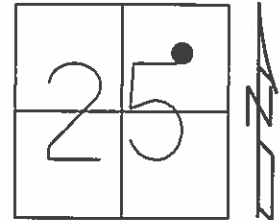

RECORD: P.I.
CURVE DATA 1926
STA. 272+49.8
 $\Delta = 36^\circ 22' \text{ RT}$
 $D = 8^\circ 00'$
 $R = 716.78$
 $T = 235.43$
 $L = 454.58$

DIST. 14F-14G = ± 219.15

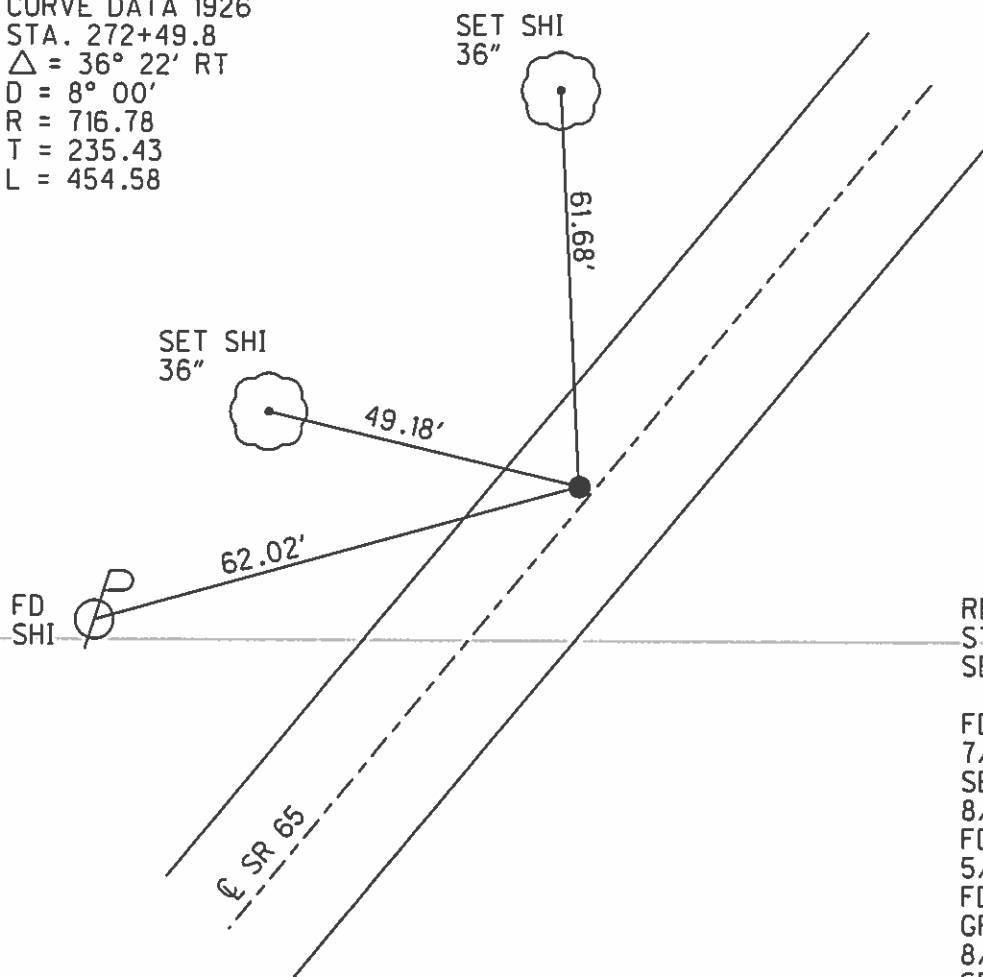

RECORD: P.C.
STA. 270+14.37
SET P.K., 1972

FD SM.R.R.SPIKE
7/15/92
SET P.K./WASHER
8/27/92, MB
FD P.K./WASHER
5/14/04, MC
FD P.K./WASHER
GPS, REFF14
8/26/13, SDC
SET MAG/WASHER
GPS, NEWREFF14
9/8/15, JFO

O.D.O.T. DISTRICT 2 SURVEY OFFICE (USE ONLY)

PERSONNEL

REFERENCE NO. 14 G

SHEET 22 OF 63

NOTES LEU
H.C. O'DONNELL
R.C. WESTFALL
RHOADES

DATE 4/21/15
WEATHER WINDY
TEMP. 43°

ROUTE SR 65
COUNTY WOOD
TOWNSHIP WASHINGTON
SECTION 25
T 6 N R 9 E

TYPE MONUMENT SM.R.R.SPIKE


~~ON SURFACE~~ - BELOW 2"

LEFT - PAV'T - ~~RIGHT~~ 1.3'

- TORT EDGE PAVEMENT

S.L.M. 374+96.42


Grid: Northing: 654638.552 Easting: 1619627.094

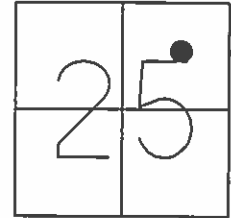

RECORD: P.T.
STA. 274+68.95
SET P.K., 1972

DIST. 14F-14G = ± 219.15

FD SM.R.R.SPIKE
2" DOWN. 7/15/92
SET P.K./WASHER
8/27/92, MB
FD SM.R.R.SPIKE
2" DOWN. 5/14/04, MC
9/18/15, RGN
GPS, REFPC14
SET MAG/WASHER
GPS, NEWREFG14
9/8/15, JFO

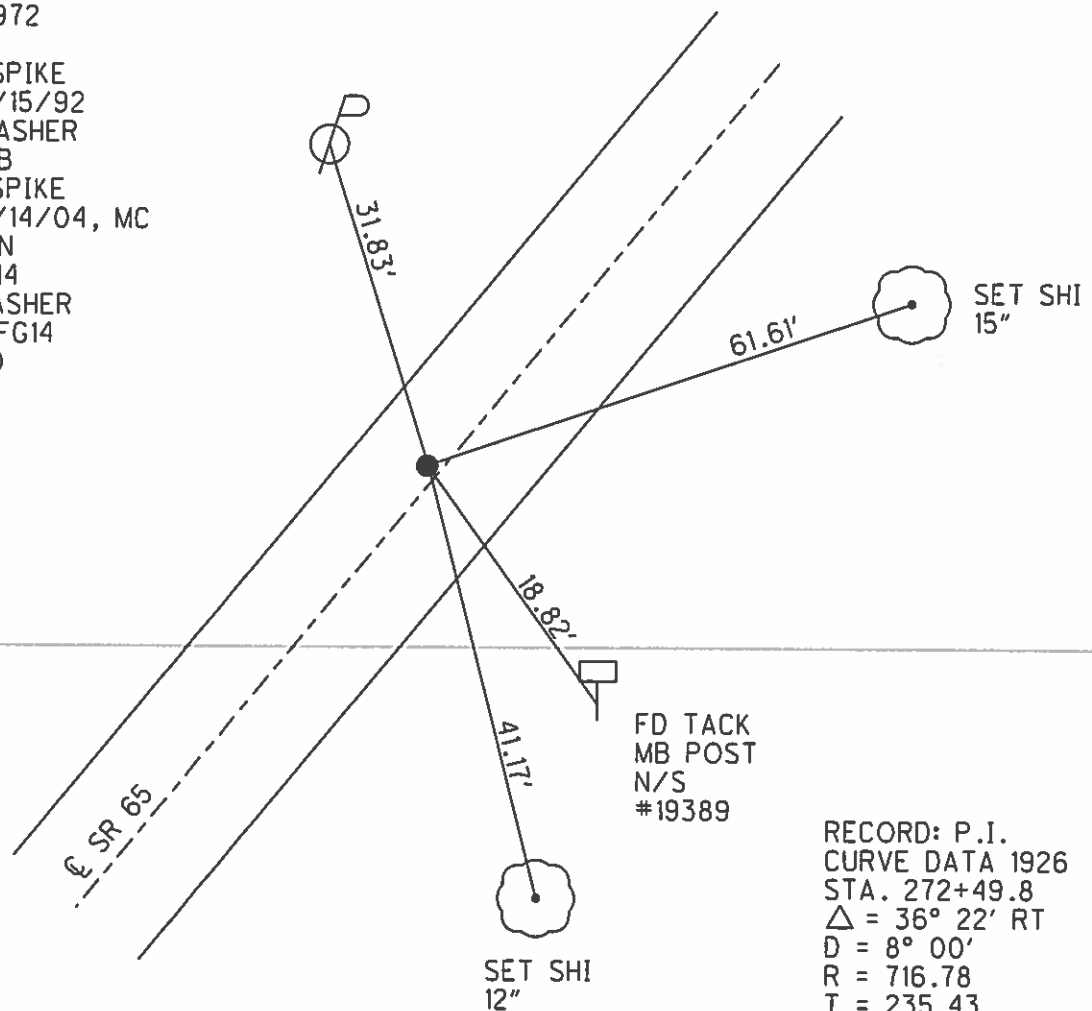

FD TACK
MB POST
N/S
#19389

RECORD: P.I.
CURVE DATA 1926
STA. 272+49.8
 $\Delta = 36^\circ 22' \text{ RT}$
D = 8° 00'
R = 716.78
T = 235.43
L = 454.58

O.D.O.T. DISTRICT 2 SURVEY OFFICE (USE ONLY)

PERSONNEL

REFERENCE NO. 14 H

SHEET 23 OF 63

NOTES LEU

DATE 4/21/15

ROUTE SR 65

H.C. O'DONNELL

WEATHER WINDY

COUNTY WOOD

R.C. WESTFALL

TEMP. 43°

TOWNSHIP WASHINGTON

RHOADES

SECTION 25

T 6 N R 9 E

TYPE MONUMENT SM.R.R.SPIKE


~~ON SURFACE~~ - BELOW 0.2'

LEFT - PAV'T - RIGHT ON

- TO - EDGE PAVEMENT


S.L.M. 391+34.59

Grid: Northing: 655234.274 Easting: 1621153.029

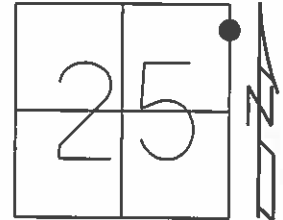

RECORD:
ORIGIN UNKNOWN

FD SM.R.R.SPIKE
7/15/92
SET P.K./WASHER
8/27/92, MB
FD SM.R.R.SPIKE
2" DOWN
8/5/13, SDC
GPS, REFH14
SET MAG/WASHER
GPS, NEWREFH14
9/8/15, JFO

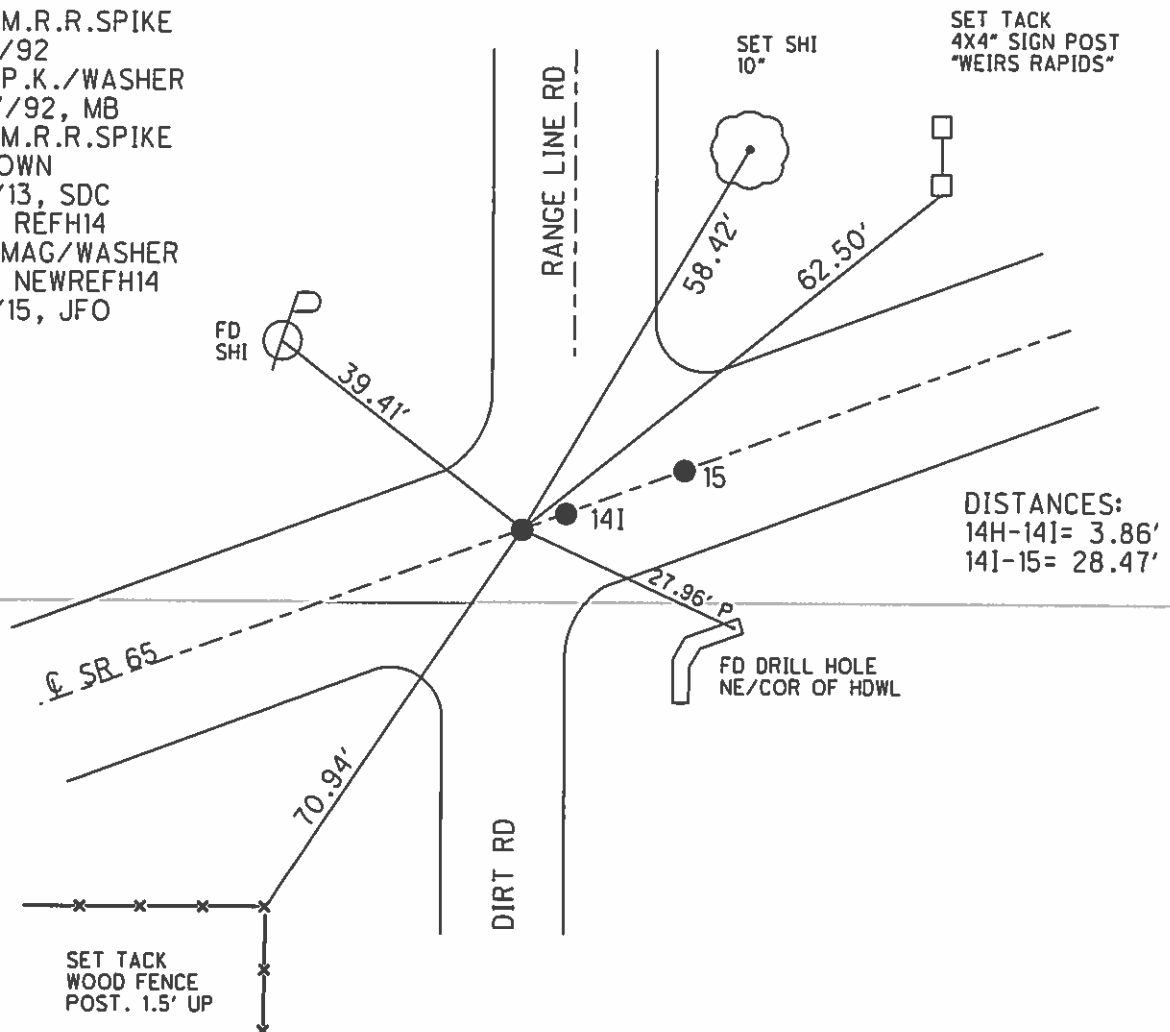

O.D.O.T. DISTRICT 2 SURVEY OFFICE (USE ONLY)

PERSONNEL

REFERENCE NO. 14 I

SHEET 24 OF 63


NOTES LEU
H.C. O'DONNELL
R.C. WESTFALL
RHOADES

DATE 4/21/15
WEATHER WINDY
TEMP. 43°

ROUTE SR 65
COUNTY WOOD
TOWNSHIP WASHINGTON
SECTION 25
T 6 N R 9 E


TYPE MONUMENT P.K.NAIL
ON SURFACE - ~~BELOW~~ ON
LEFT - PAV'T - RIGHT ON
- TO - EDGE PAVEMENT
S.L.M. 391+38.42

Grid: Northing: 655235.601 Easting: 1621156.662

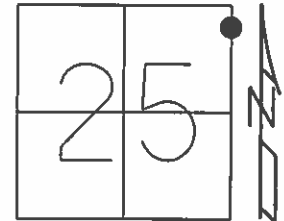

RECORD: P.I.

FD SM.R.R.SPIKE
7/15/92
SET P.K./WASHER
8/27/92, MB
FD P.K.NAIL
8/5/13, SDC
GPS, REF114
SET MAG/WASHER
GPS, NEWREF114
9/8/15, JFO

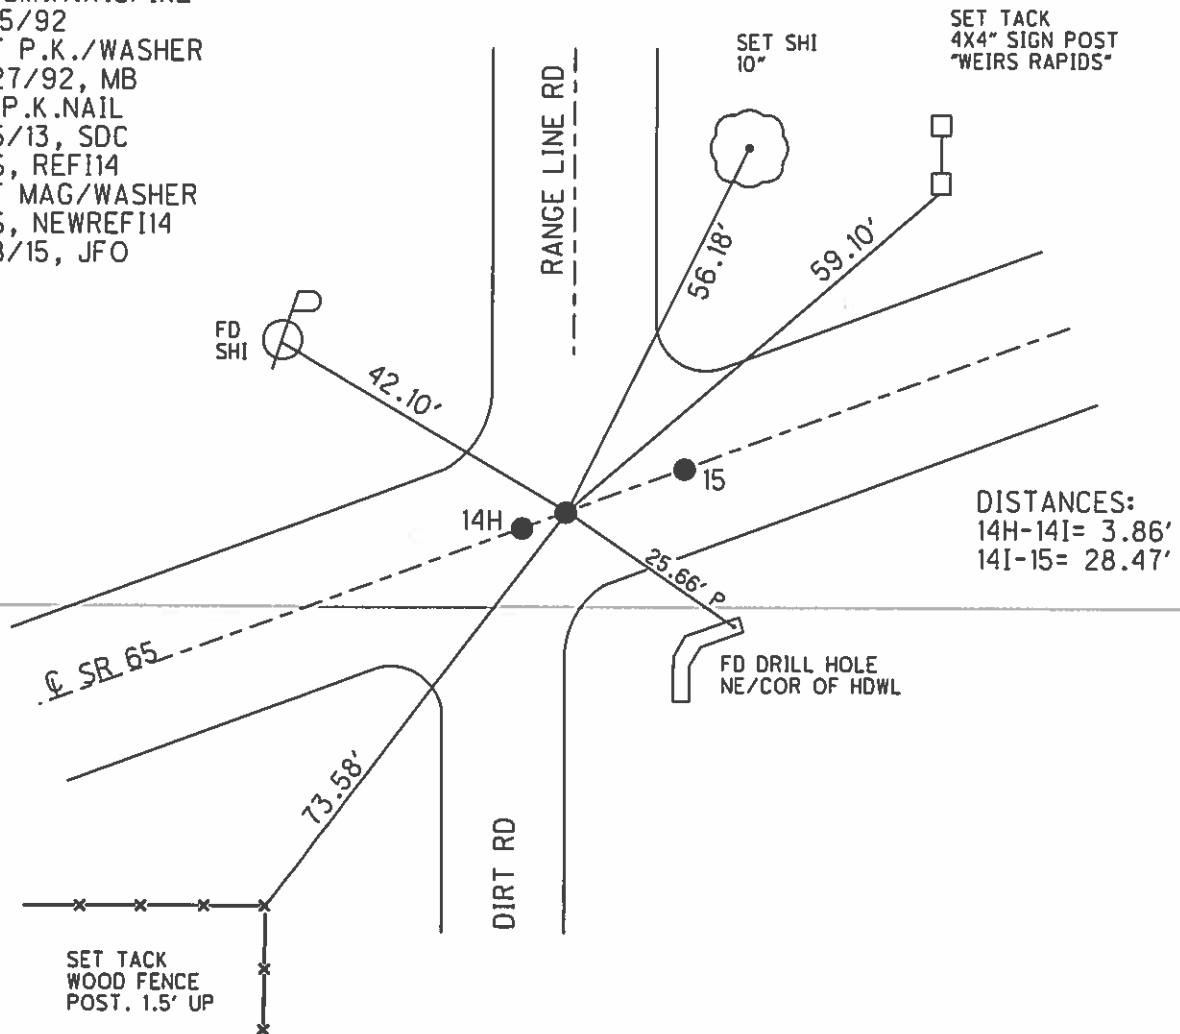

O.D.O.T. DISTRICT 2 SURVEY OFFICE (USE ONLY)

PERSONNEL

REFERENCE NO. 15

SHEET 25 OF 63


NOTES LEU
H.C. O'DONNELL
R.C. WESTFALL
RHOADES

DATE 4/21/15
WEATHER WINDY
TEMP. 43°

ROUTE SR 65
COUNTY WOOD
TOWNSHIP WASHINGTON
SECTION 25
T 6 N R 9 E


TYPE MONUMENT P.K. NAIL
ON SURFACE - ~~BELOW~~ ON
LEFT - PAV'T - RIGHT ON
- TO - EDGE PAVEMENT
S.L.M. 391+66.81

Grid: Northing: 655245.801 Easting: 1621183.222

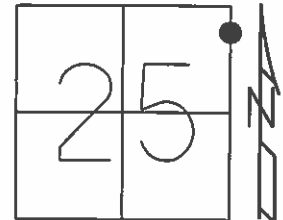

RECORD:

FD SM.R.R.SPIKE
7/15/92
SET P.K./WASHER
8/27/92, MB
FD P.K.NAIL
8/5/13, SDC
GPS, REF15
SET MAG/WASHER
GPS, NEWREF15
9/8/15, JFO

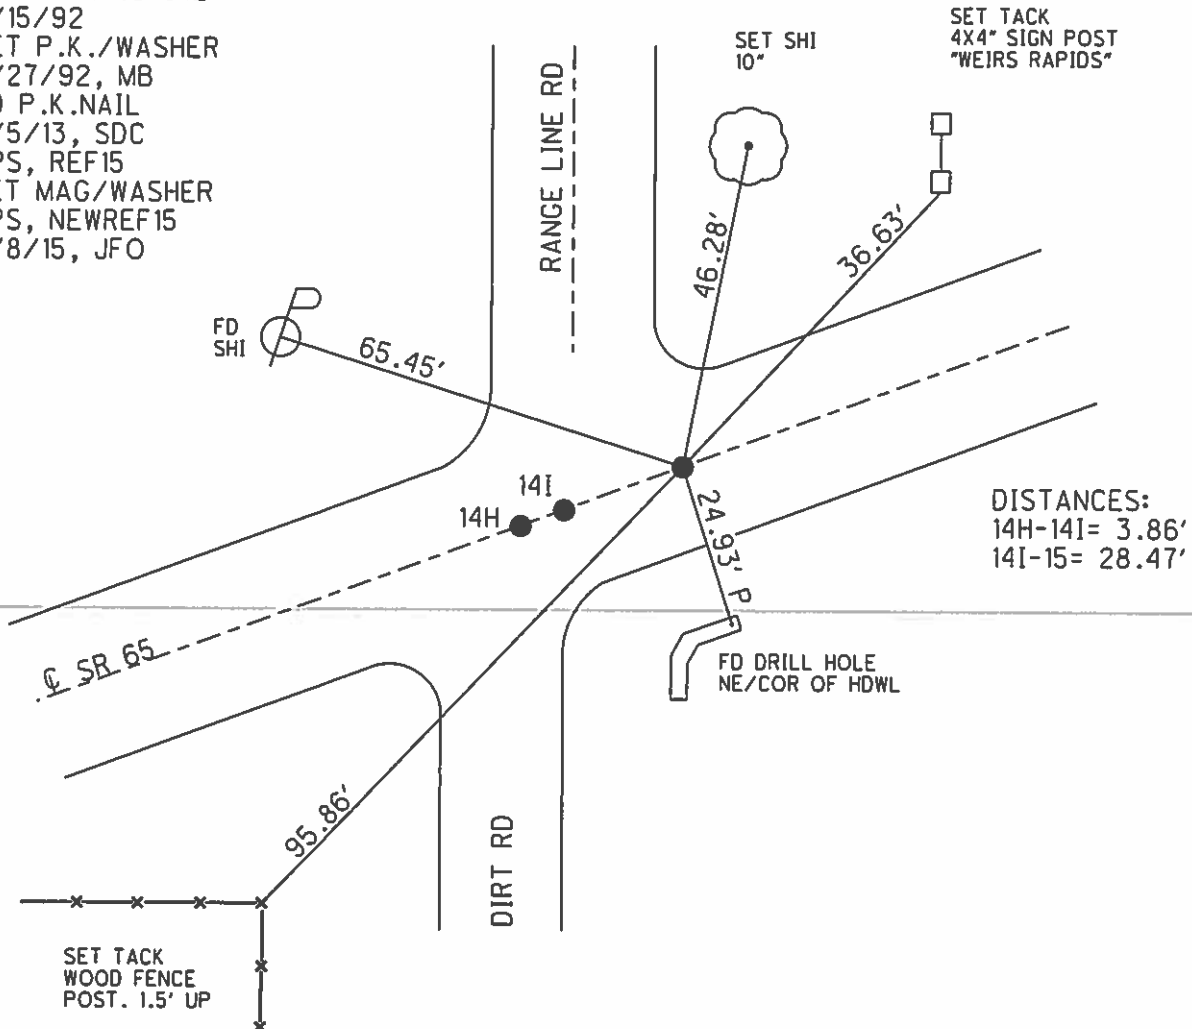

O.D.O.T. DISTRICT 2 SURVEY OFFICE (USE ONLY)

PERSONNEL

REFERENCE NO. 15 A

SHEET 26 OF 63

NOTES LEU
H.C. O'DONNELL
R.C. WESTFALL
RHOADES

DATE 4/21/15
WEATHER WINDY
TEMP. 43°

ROUTE SR 65
COUNTY WOOD
TOWNSHIP WASHINGTON
SECTION 19
T 6 N R 10 E

TYPE MONUMENT P.K. SHANK


ON SURFACE - ~~BELOW~~ ON

LEFT - PAV'T - ~~RIGHT~~ 0.8'


8.6' TOLT EDGE PAVEMENT

S.L.M. 405+80.69

Grid: Northing: 655751.166 Easting: 1622503.700

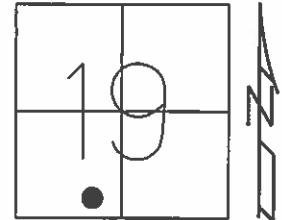

RECORD: P.C.
STA. 305+56.12
SET P.K.NAIL, 1972
FD P.K./WASHER
7/15/92
SET P.K./WASHER
8/31/92, MB
FD P.K. SHANK
8/27/13, SDC
GPS, REFA15
SET MAG/WASHER
GPS, NEWREFA15
9/8/15, JFO

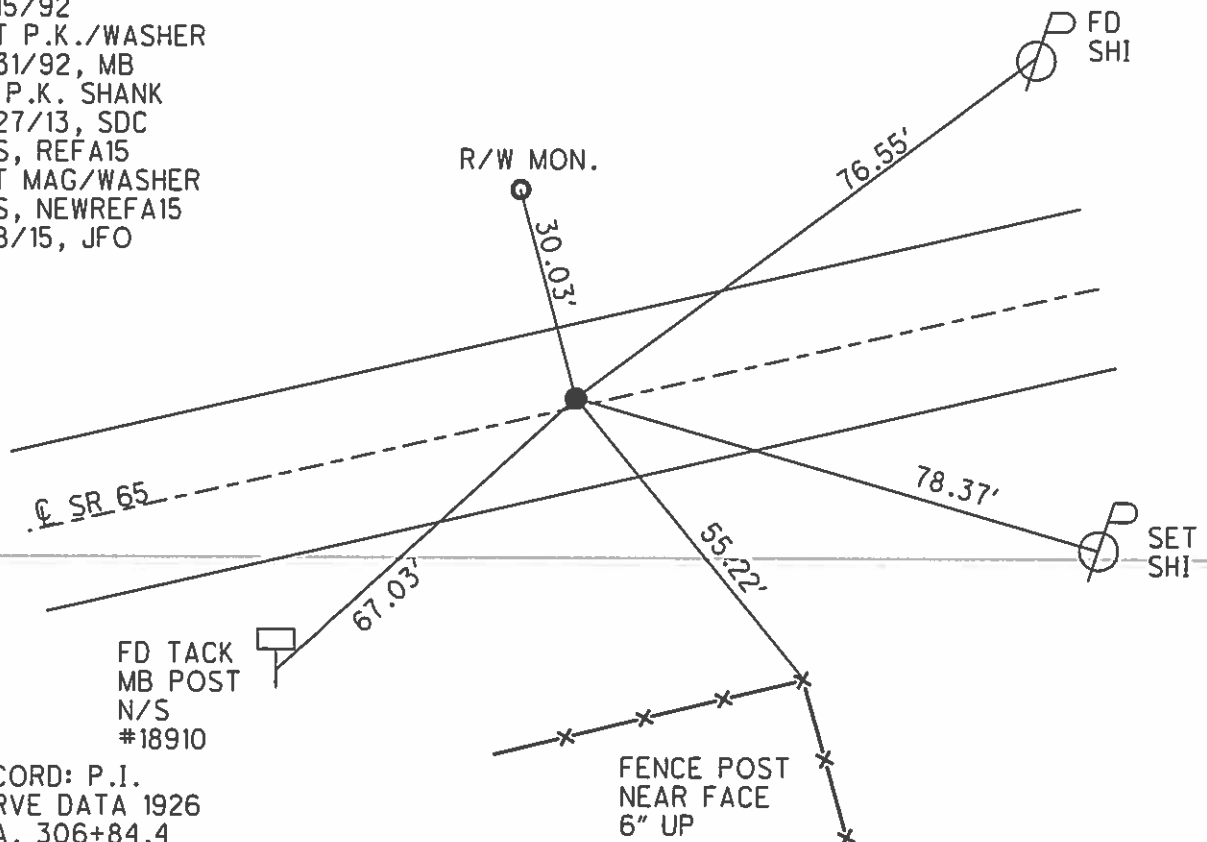

RECORD: P.I.
CURVE DATA 1926
STA. 306+84.4
 $\Delta = 10^\circ 14' RT$
D = $4^\circ 00'$
R = 1432.69
T = 128.28
L = 255.83

O.D.O.T. DISTRICT 2 SURVEY OFFICE (USE ONLY)

PERSONNEL

REFERENCE NO. 15 B

SHEET 27 OF 63

NOTES LEU
H.C. O'DONNELL
R.C. WESTFALL
RHOADES

DATE 4/21/15
WEATHER WINDY
TEMP. 43°

ROUTE SR 65
COUNTY WOOD
TOWNSHIP WASHINGTON
SECTION 19
T 6 N R 10 E

TYPE MONUMENT P.K. SHANK


ON SURFACE - BELOW ON

LEFT - PAV'T - RIGHT 0.8'


9.1' TOLT EDGE PAVEMENT

S.L.M. 408+37.49

Grid: Northing: 655821.264 Easting: 1622750.211

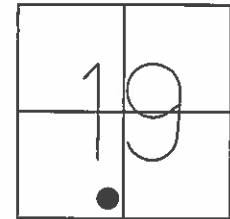

RECORD: P.T.
STA. 308+11.95
SET P.K.NAIL, 1972
FD P.K./WASHER
7/15/92
SET P.K./WASHER
8/31/92, MB
FD P.K. SHANK
8/27/13, SDC
GPS, REFB15
SET MAG/WASHER
GPS, NEWREFB15
9/9/15, JFO

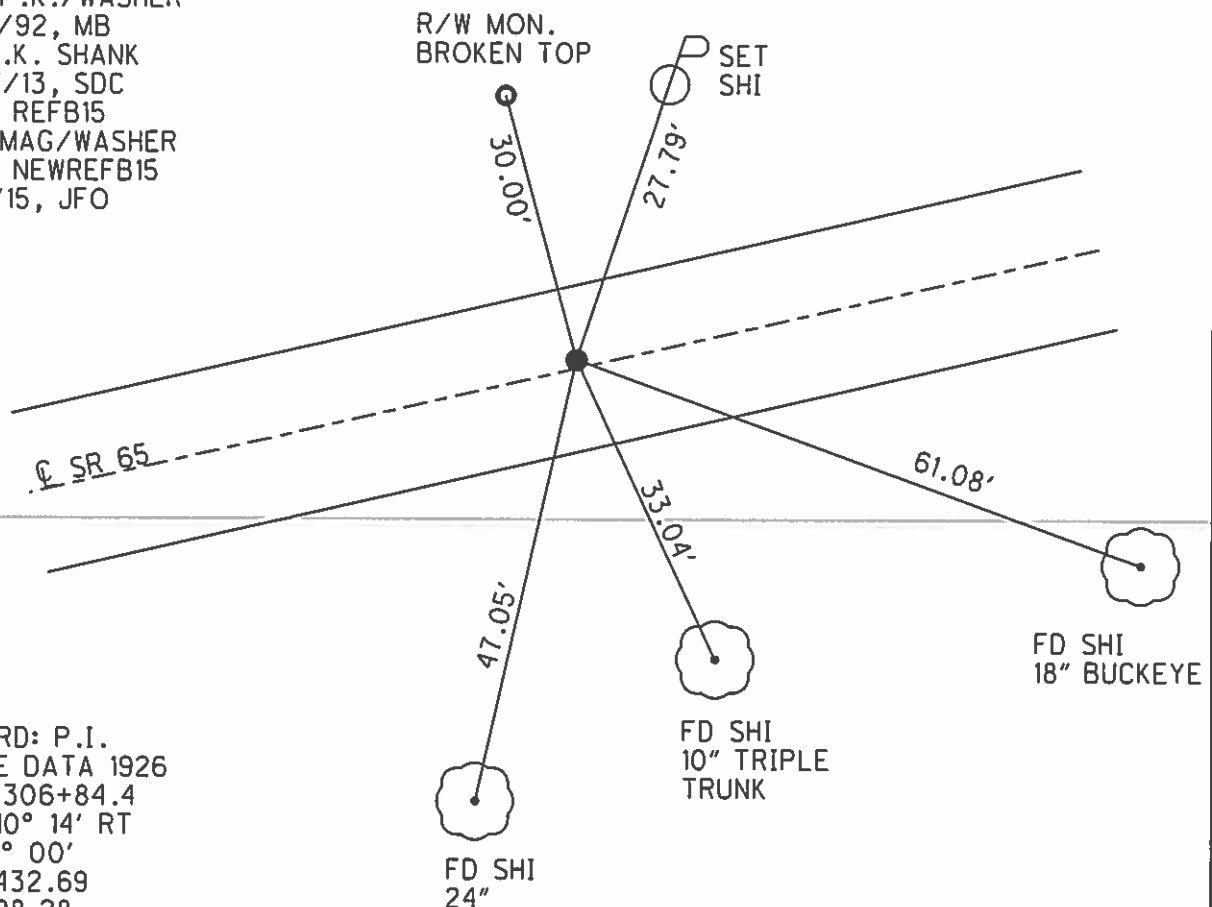

RECORD: P.I.
CURVE DATA 1926
STA. 306+84.4
 $\Delta = 10^\circ 14'$ RT
D = $4^\circ 00'$
R = 1432.69
T = 128.28
L = 255.83

O.D.O.T. DISTRICT 2 SURVEY OFFICE (USE ONLY)

PERSONNEL

REFERENCE NO. 15 C

SHEET 28 OF 63



NOTES LEU
H.C. O'DONNELL
R.C. WESTFALL
RHOADES

DATE 4/21/15
WEATHER WINDY
TEMP. 43°

ROUTE SR 65
COUNTY WOOD
TOWNSHIP WASHINGTON
SECTION 19
T 6 N R 10 E

TYPE MONUMENT P.K./WASHER
ON SURFACE - ~~BELOW~~ ON
LEFT - PAV'T - ~~RIGHT~~ 1.2'
8.6+' TO LT EDGE PAVEMENT
S.L.M. 412+83.33

Grid: Northing: 655903.572 Easting: 1623188.440

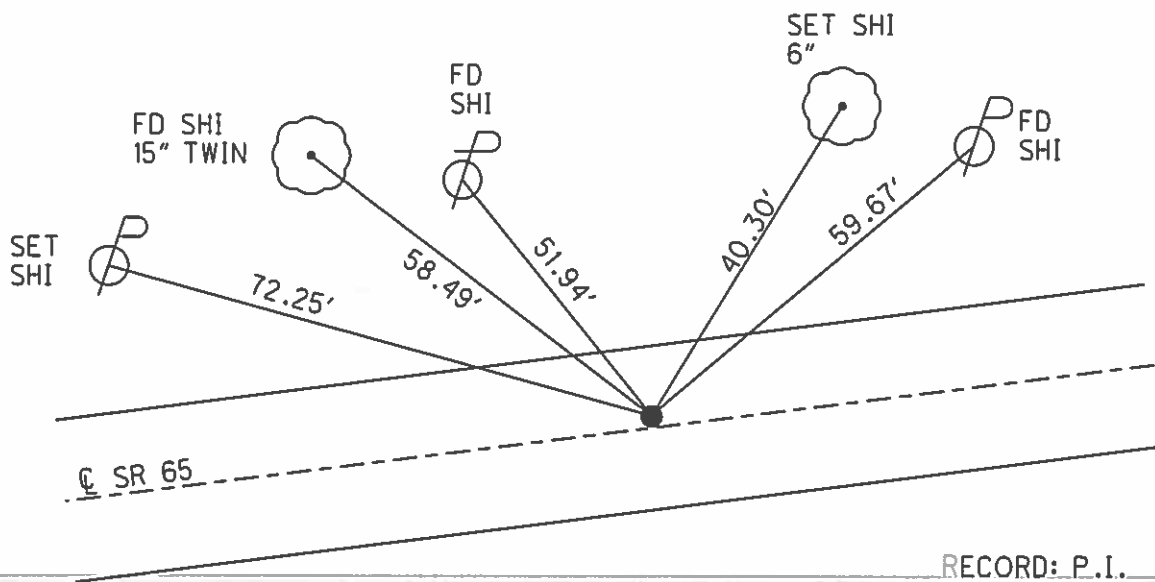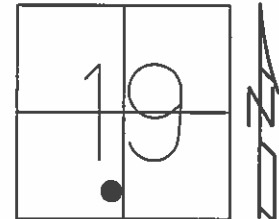

RECORD: P.I.
STA. 312+59.9
 $\Delta = 2^\circ 27' \text{ RT (PLAN)}$
SET P.K., 1972

FD P.K./WASHER
7/15/92, 5/14/04
SET P.K./WASHER
8/31/92, MB
FD P.K./WASHER
GPS, REFC15
8/27/13, SDC
SET MAG/WASHER
GPS, NEWREFC15
9/9/15, JFO

O.D.O.T. DISTRICT 2 SURVEY OFFICE (USE ONLY)

PERSONNEL

REFERENCE NO. 16

SHEET 29 OF 63

NOTES WESTFALL

DATE 4/21/15

ROUTE SR 65

H.C. O'DONNELL

WEATHER WINDY

COUNTY WOOD

R.C. LEU

TEMP. 50°

TOWNSHIP WASHINGTON

RHOADES

SECTION 19

T 6 N R 10 E

TYPE MONUMENT P.K. SHANK


ON SURFACE - ~~BELOW~~ ON

~~LEFT~~ - PAV'T - RIGHT 1.4'

10.4' TO LT EDGE PAVEMENT


S.L.M. 419+88.66

Grid: Northing: 656004.756 Easting: 1623886.520

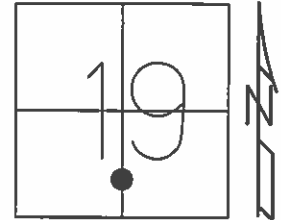

RECORD: P.I.
STA. 319+64.35
 $\Delta = 2^\circ 30'$ LT (PLAN)
SET P.K., 1972

FD P.K./WASHER
7/15/92, 5/17/04
SET P.K./WASHER
8/31/92, MB
FD P.K./WASHER
GPS, REF16
8/27/13, SDC
SET MAG/WASHER
GPS, NEWREF16
9/9/15, JFO

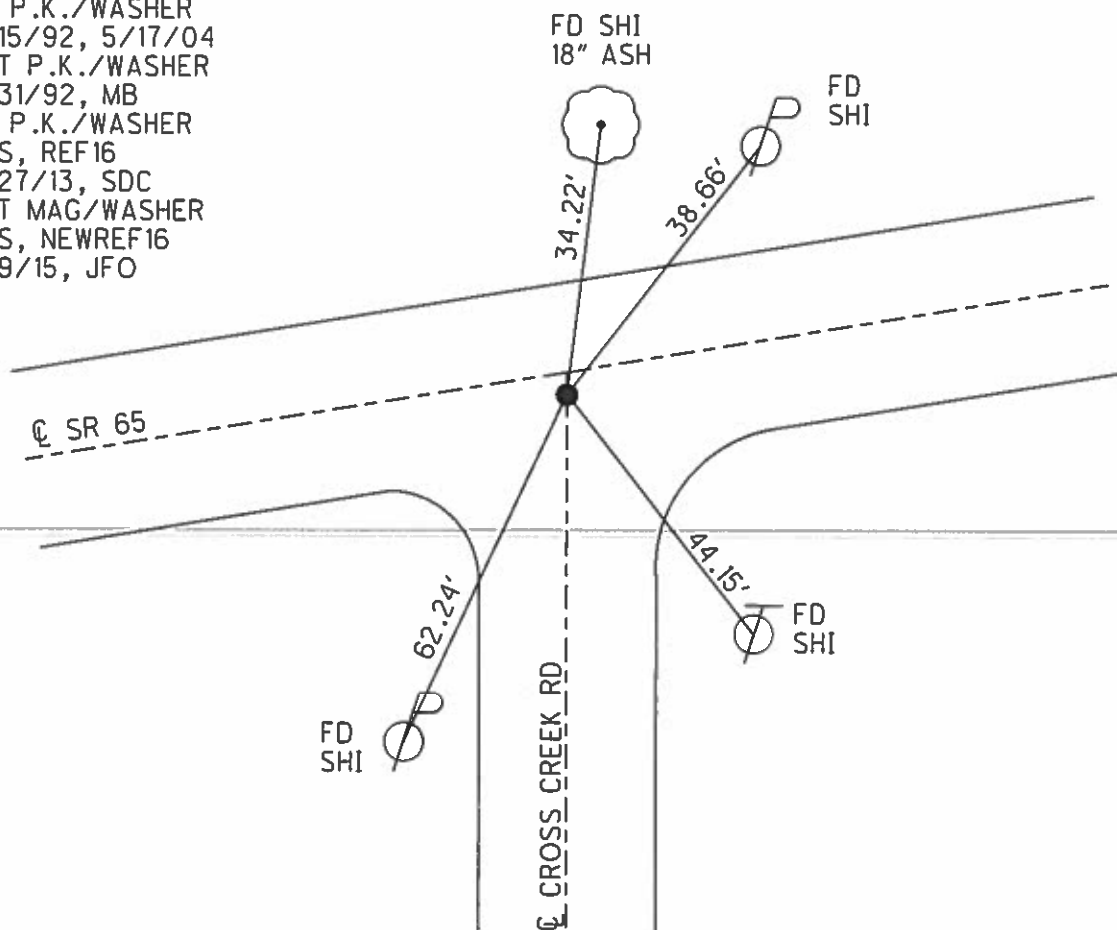

O.D.O.T. DISTRICT 2 SURVEY OFFICE (USE ONLY)

PERSONNEL

REFERENCE NO. 16 A

SHEET 30 OF 63


NOTES WESTFALL
H.C. O'DONNELL
R.C. LEU
RHOADES

DATE 4/21/15
WEATHER WINDY
TEMP. 50°

ROUTE SR 65
COUNTY WOOD
TOWNSHIP WASHINGTON
SECTION 19
T 6 N R 10 E


TYPE MONUMENT P.K./WASHER
ON SURFACE - ~~BELOW~~ ON
~~LEFT~~ - PAV'T - RIGHT 1.4'
9.0' TORT EDGE PAVEMENT
S.L.M. 422+59.35

Grid: Northing: 656055.084 Easting: 1624152.469

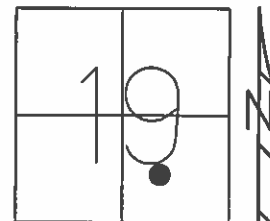

RECORD: P.C.
STA. 322+34.61
SET P.K., 1972

FD P.K./WASHER
7/15/92, 5/17/04
SET P.K./WASHER
9/3//92, MB
FD P.K./WASHER
GPS, REFFA16
8/28/13, SDC
SET MAG/WASHER
GPS, NEWREFA16
9/10/15, JFO

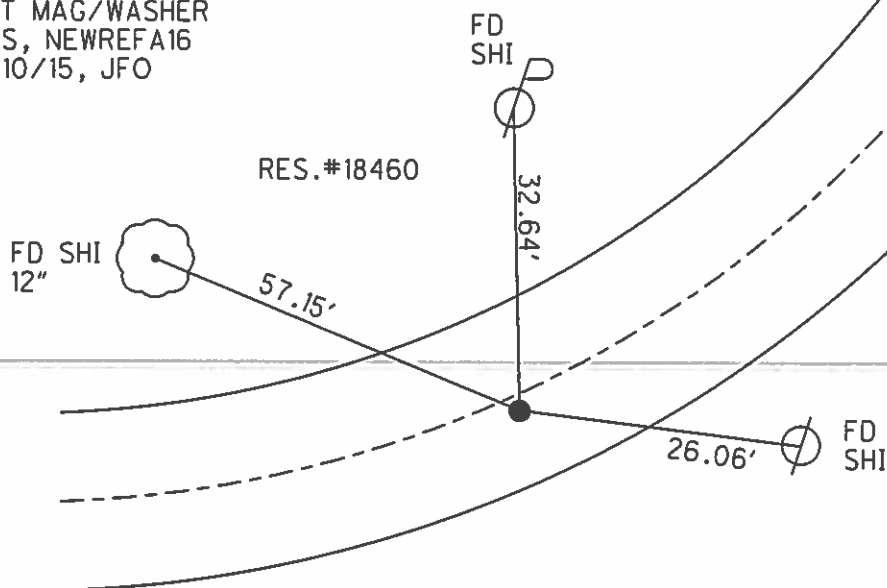

RECORD: P.I.
CURVE DATA 1926
STA. 324+32.95
 $\Delta = 19^\circ 39' \text{ LT}$
D = 5° 00'
R = 1146.28
T = 198.34
L = 393.00

O.D.O.T. DISTRICT 2 SURVEY OFFICE (USE ONLY)

PERSONNEL

REFERENCE NO. 16 B

SHEET 31 OF 63

NOTES WESTFALL
H.C. O'DONNELL
R.C. LEU
RHOADES

DATE 4/21/15
WEATHER WINDY
TEMP. 50°

ROUTE SR 65
COUNTY WOOD
TOWNSHIP WASHINGTON
SECTION 19
T 6 N R 10 E

TYPE MONUMENT P.K. NAIL


ON SURFACE - ~~BELOW~~ ON

~~LEFT~~ - PAV'T - RIGHT 2.0'

8.0' TORT EDGE PAVEMENT

S.L.M. 426+48.49

Grid: Northing: 656190.733 Easting: 1624515.226

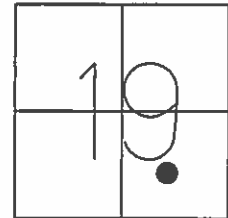


RECORD: P.T.
STA. 326+27.61
SET P.K., 1972

FD P.K./WASHER
7/15/92, 5/17/04
SET P.K./WASHER
9/3//92, MB
FD P.K.NAIL
GPS, REFFB16
8/6/13, SDC
SET MAG/WASHER
GPS, NEWREFB16
9/10/15, JFO

RECORD: P.I.
CURVE DATA 1926
STA. 324+32.95
 $\Delta = 19^\circ 39' \text{ LT}$
 $D = 5^\circ 00'$
 $R = 1146.28$
 $T = 198.34$
 $L = 393.00$

RES.#18460

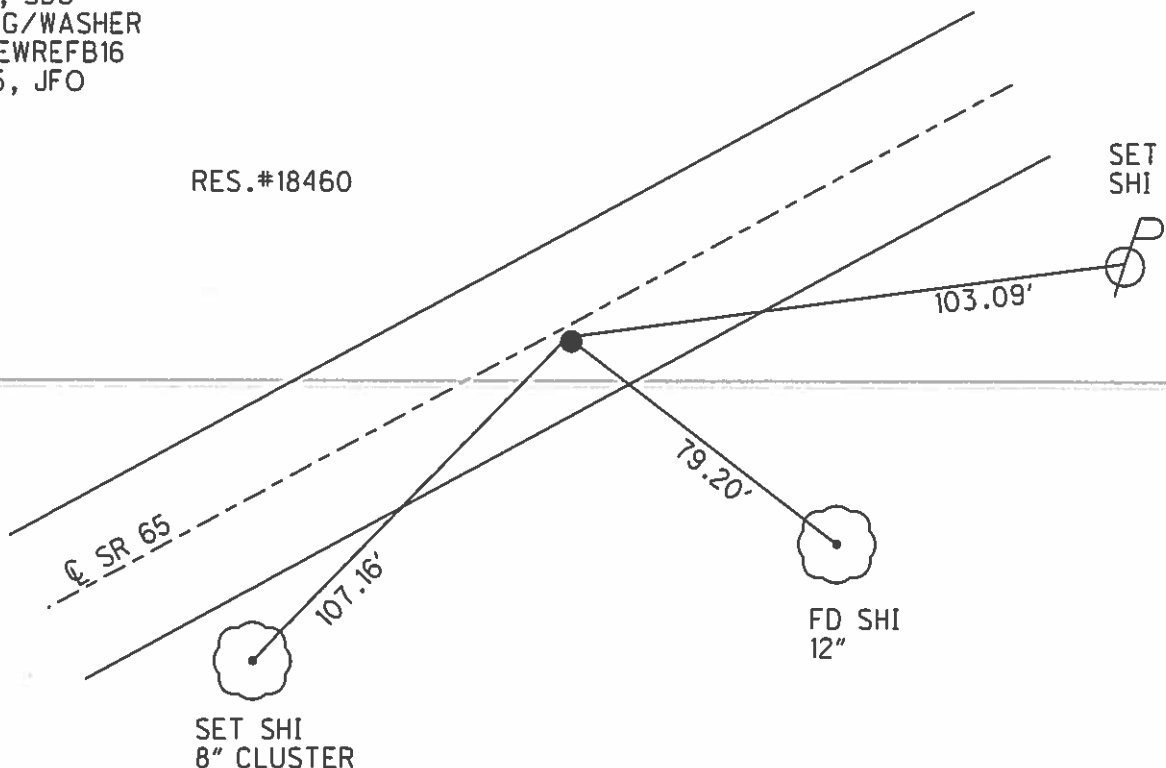

O.D.O.T. DISTRICT 2 SURVEY OFFICE (USE ONLY)

PERSONNEL

REFERENCE NO. 16 C

SHEET 32 OF 63


NOTES WESTFALL
H.C. LEU
R.C. O'DONNELL
RHOADES

DATE 4/22/15
WEATHER CLOUDY
TEMP. 40°

ROUTE SR 65
COUNTY WOOD
TOWNSHIP WASHINGTON
SECTION 19
T 6 N R 10 E


TYPE MONUMENT P.K./WASHER
ON SURFACE - ~~BELOW~~ ON
LEFT - PAV'T - ~~RIGHT~~ 1.2'
11.0' TORT EDGE PAVEMENT
S.L.M. 429+91.85

Grid: Northing: 656364.187 Easting: 1624811.628

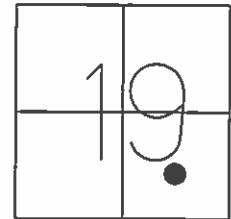

RECORD: P.C.
STA. 329+70.26
SET P.K.NAIL, 1972

FD P.K./WASHER
7/15/92
SET P.K./WASHER
9/3/92, MB
FD P.K./WASHER
GPS, REFFC16
8/6/13, SDC
SET MAG/WASHER
GPS, NEWREFC16
9/10/15, JFO

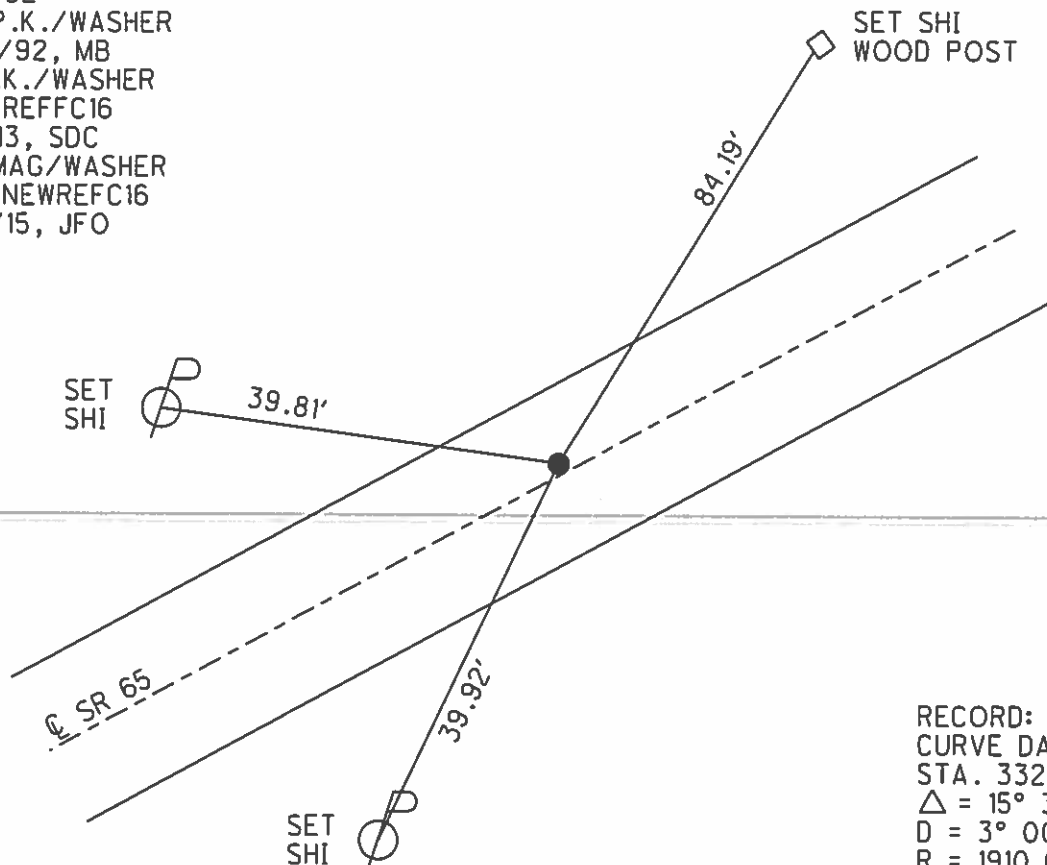

RECORD: P.I.
CURVE DATA 1926
STA. 332+31.23
 $\Delta = 15^\circ 33' \text{ RT}$
D = $3^\circ 00'$
R = 1910.08'
T = 260.77'
L = 518.33'

O.D.O.T. DISTRICT 2 SURVEY OFFICE (USE ONLY)

PERSONNEL

REFERENCE NO. 16 D

SHEET 33 OF 63

NOTES WESTFALL

DATE 4/22/15

ROUTE SR 65

H.C. LEU

WEATHER CLOUDY

COUNTY WOOD

R.C. O'DONNELL

TEMP. 40°

TOWNSHIP WASHINGTON

RHOADES

SECTION 19

T 6 N R 10 E

TYPE MONUMENT P.K./WASHER


ON SURFACE - ~~BELOW~~ ON

LEFT - PAV'T - ~~RIGHT~~ 1.0'

10.9' TORT EDGE PAVEMENT


S.L.M. 435+12.57

Grid: Northing: 656563.367 Easting: 1625290.895

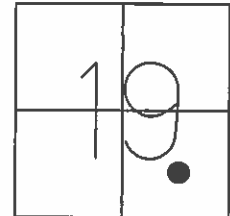

RECORD: P.T.
STA. 334+88.79
SET P.K.NAIL, 1972

FD P.K./WASHER
7/15/92
SET P.K./WASHER
9/3//92, MB
FD P.K./WASHER
GPS, REFFD16
8/6/13, SDC
SET MAG/WASHER
GPS, NEWREFD16
9/10/15, JFO

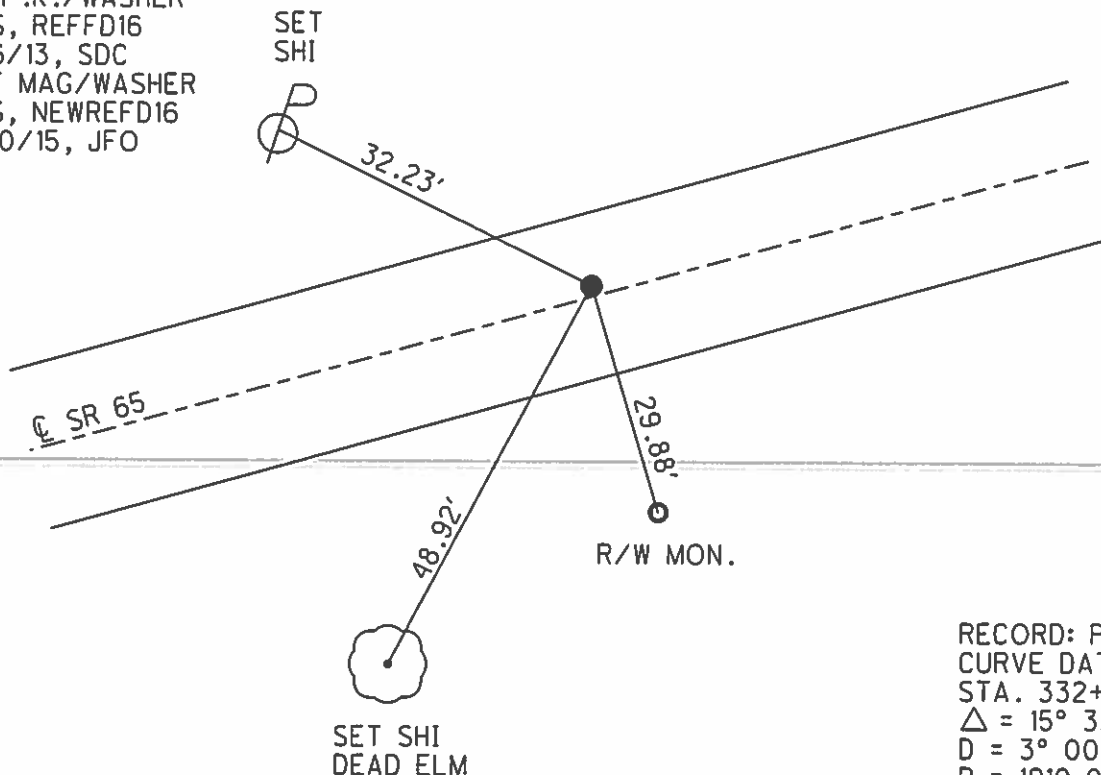

RECORD: P.I.
CURVE DATA 1926
STA. 332+31.23
 $\Delta = 15^{\circ} 33' RT$
D = $3^{\circ} 00'$
R = 1910.08'
T = 260.77'
L = 518.33'

O.D.O.T. DISTRICT 2 SURVEY OFFICE (USE ONLY)

PERSONNEL

REFERENCE NO. 16 E

SHEET 34 OF 63

NOTES WESTFALL

DATE 4/22/15

ROUTE SR 65

H.C. LEU

WEATHER CLOUDY

COUNTY WOOD

R.C. O'DONNELL

TEMP. 40°

TOWNSHIP WASHINGTON

RHOADES

SECTION 19

T 6 N R 10 E

TYPE MONUMENT P.K./WASHER


ON SURFACE - ~~BELOW~~ ON

~~LEFT~~ - PAV'T - RIGHT 1.2'


8.9' TORT EDGE PAVEMENT

S.L.M. 444+07.72

Grid: Northing: 656563.364 Easting: 1625290.895

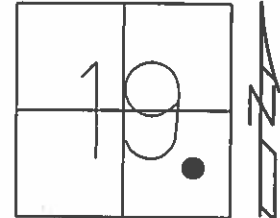

RES# 18078

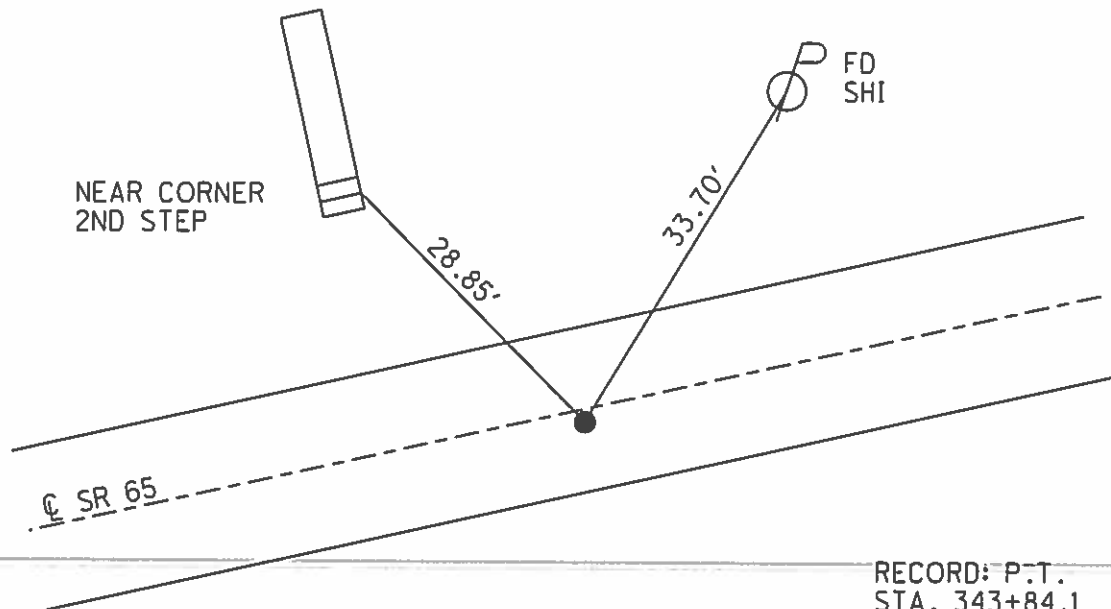

RECORD: P.I.
CURVE DATA 1926
STA. 349+80.39
 $\Delta = 15^\circ 48' \text{ LT}$
 $D = 10^\circ 20'$
 $R = 4297.28$
 $T = 596.26$
 $L = 1185.00$

RECORD: P.T.
STA. 343+84.1
SET P.K.NAIL, 1972

FD P.K./WASHER
7/16/92
SET P.K./WASHER
9/3//92, MB
FD P.K./WASHER
GPS, REFFE16
8/28/13, SDC
SET MAG/WASHER
GPS, NEWREFE16
9/10/15, JFO

O.D.O.T. DISTRICT 2 SURVEY OFFICE (USE ONLY)

PERSONNEL

REFERENCE NO. 16 G

SHEET 35 OF 63


NOTES WESTFALL
H.C. O'DONNELL
R.C. LEU
RHOADES

DATE 4/21/15
WEATHER CLOUDY
TEMP. 40°

ROUTE SR 65
COUNTY WOOD
TOWNSHIP MIDDLETON
SECTION 20
T 6 N R 10 E


TYPE MONUMENT P.K./WASHER
ON SURFACE - ~~BELOW~~ ON
~~LEFT~~ - PAV'T - RIGHT 1.3'
11.7' TOLT EDGE PAVEMENT
S.L.M. 453+39.12

Grid: Northing: 657126.441 Easting: 1627023.598

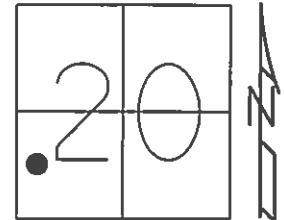

RECORD:
ORIGIN UNKNOWN

FD P.K./WASHER
7/16/92
SET P.K./WASHER
9/3/92, MB
FD P.K./WASHER
GPS, REFFG16
8/6/13, SDC
SET MAG/WASHER
GPS, NEWREFG16
9/11/15, JFO

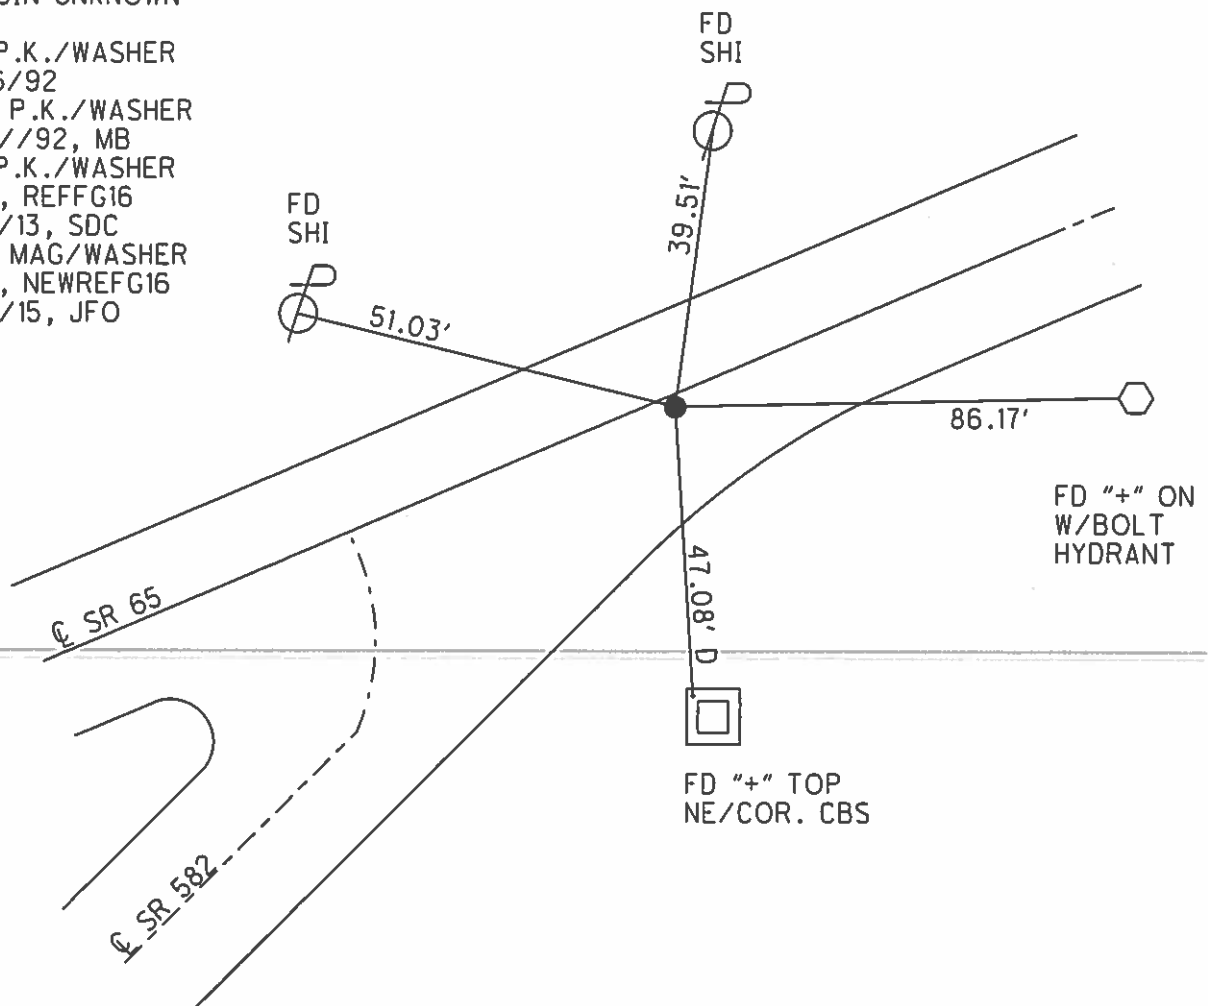

O.D.O.T. DISTRICT 2 SURVEY OFFICE (USE ONLY)

PERSONNEL

REFERENCE NO. 17


SHEET 36 OF 63

NOTES WESTFALL
H.C. O'DONNELL
R.C. LEU
RHOADES

DATE 4/21/15
WEATHER CLOUDY
TEMP. 40°


ROUTE SR 65
COUNTY WOOD
TOWNSHIP MIDDLETON
SECTION 20
T 6 N R 10 E

TYPE MONUMENT P.K./WASHER
ON SURFACE - ~~BELOW~~ ON
~~LEFT~~ - PAV'T - RIGHT 2.5'
7.6' TORT EDGE PAVEMENT
S.L.M. 455+90.21

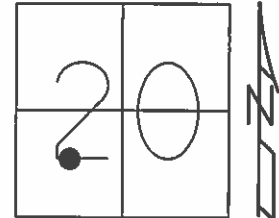

Grid: Northing: 657247.092 Easting: 1627243.735

RECORD: P.I.
CURVE DATA 1926
STA. 361+20.4
 $\Delta = 51^\circ 23' \text{ LT}$
D = $5^\circ 00'$
R = 1146.28
T = 551.30
L = 1027.67

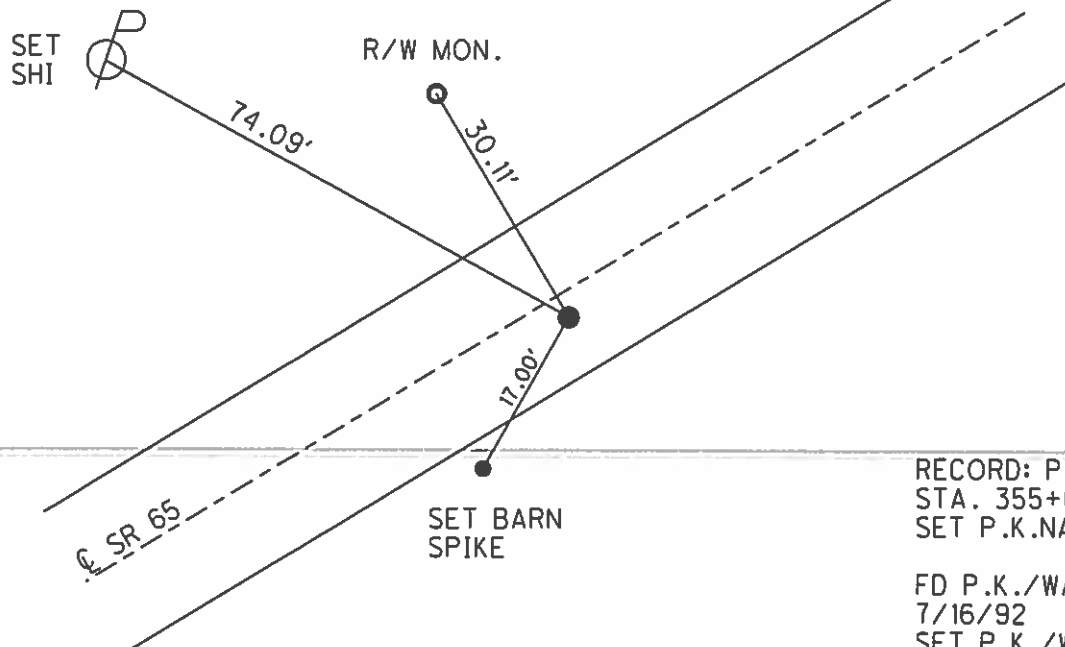

RECORD: P.C.C.
STA. 355+69.1
SET P.K.NAIL, 1972

FD P.K./WASHER
7/16/92
SET P.K./WASHER
9/3//92, MB
FD P.K./WASHER
GPS, REF17
8/29/13, SDC
SET MAG/WASHER
GPS, NEWREF17
9/11/15, JFO

O.D.O.T. DISTRICT 2 SURVEY OFFICE (USE ONLY)

PERSONNEL

REFERENCE NO. 17 A

SHEET 37 OF 63

NOTES WESTFALL

DATE 4/21/15

ROUTE SR 65

H.C. O'DONNELL

WEATHER CLOUDY

COUNTY WOOD

R.C. LEU

TEMP. 30°

TOWNSHIP MIDDLETON

RHOADES

SECTION 20

T 6 N R 10 E

TYPE MONUMENT P.K./WASHER


ON SURFACE - ~~BELOW~~ ON

~~LEFT~~ - PAV'T - RIGHT 1.8'

8.5' TORT EDGE PAVEMENT

S.L.M. 466+20.74


Grid: Northing: 658076.218 Easting: 1627795.954

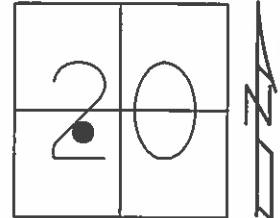

RECORD: P.T.
STA. 365+96.77
SET P.K.NAIL, 1972

FD P.K./WASHER
7/16/92
SET P.K./WASHER
9/3/92, MB
FD P.K./WASHER
GPS, REFA17
8/16/13, SDC
SET MAG/WASHER
GPS, NEWREFA17
9/11/15, JFO

RECORD: P.I.
CURVE DATA 1926
STA. 361+20.4
 $\Delta = 51^\circ 23' \text{ LT}$
D = $5^\circ 00'$
R = 1146.28
T = 551.30
L = 1027.67

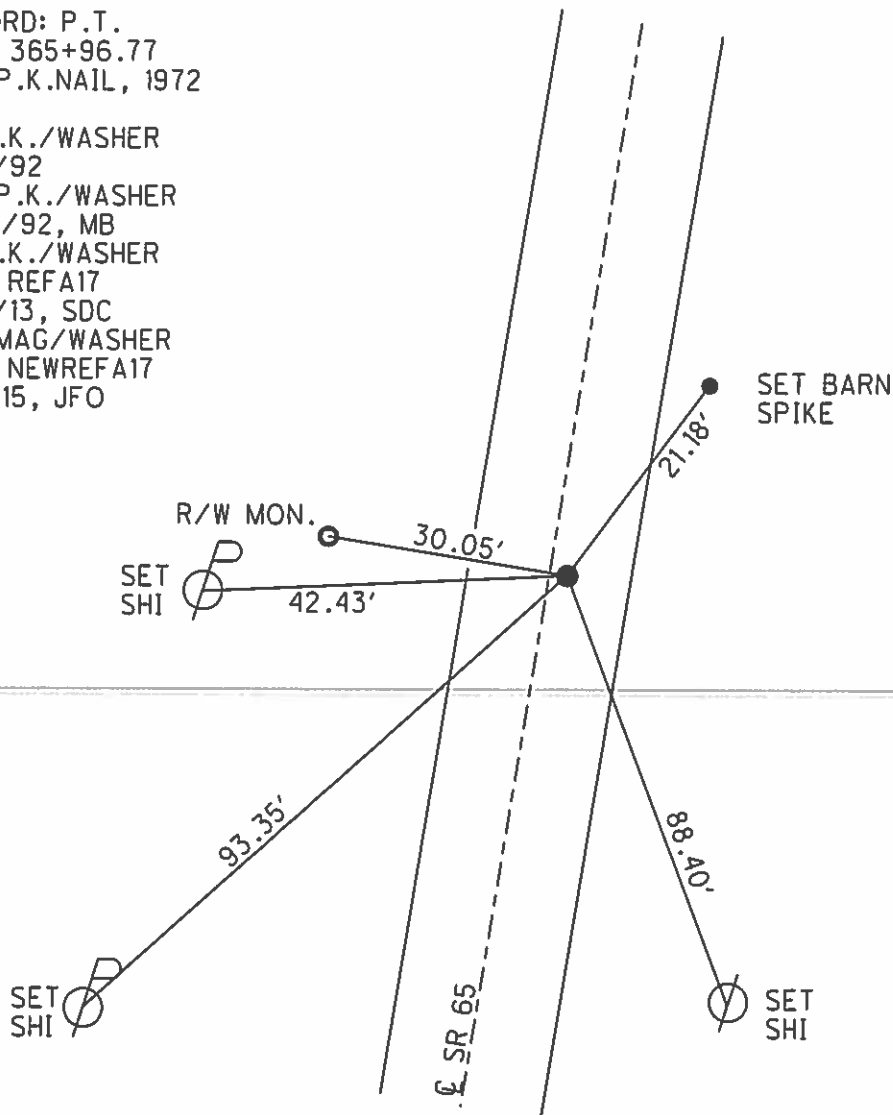

O.D.O.T. DISTRICT 2 SURVEY OFFICE (USE ONLY)

PERSONNEL

REFERENCE NO. 17 B

SHEET 38 OF 63

NOTES WESTFALL

DATE 4/21/15

ROUTE SR 65

H.C. O'DONNELL

WEATHER CLOUDY

COUNTY WOOD

R.C. LEU

TEMP. 30°

TOWNSHIP MIDDLETON

RHOADES

SECTION 20

T 6 N R 10 E

TYPE MONUMENT P.K. NAIL


ON SURFACE - ~~BELOW~~ 0.25'

LEFT - PAV'T - ~~RIGHT~~ 2.3'

7.9' TO LT EDGE PAVEMENT

S.L.M. 469+67.54

Grid: Northing: 658419.707 Easting: 1627843.787

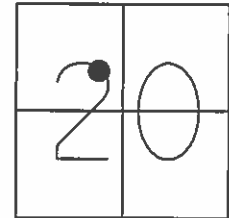

FD SHI
34" MAPLE



67.47'

FD SHI
30" MAPLE



29.05'

R/W MON.



30.02'

29.97' R/W MON.

RES# 17832

SR 65

RECORD: P.C.
STA. 369+77.79
SET P.K. NAIL, 1972

FD P.K./WASHER
7/16/92
SET P.K./WASHER
9/3/92, MB
FD P.K./WASHER
GPS, REFB17
8/16/13, SDC
SET MAG/WASHER
GPS, NEWREFB17
9/11/15, JFO

RECORD: P.I.
CURVE DATA 1926
STA. 3370+79.2
 $\Delta = 18^\circ 05' \text{ RT}$
D = 9° 00'
R = 637.28
T = 101.41
L = 200.90'

O.D.O.T. DISTRICT 2 SURVEY OFFICE (USE ONLY)

PERSONNEL

REFERENCE NO. 17 C


SHEET 39 OF 63

NOTES WESTFALL
H.C. O'DONNELL
R.C. LEU
RHOADES

DATE 4/21/15
WEATHER CLOUDY
TEMP. 30°

ROUTE SR 65
COUNTY WOOD
TOWNSHIP MIDDLETON
SECTION 20
T 6 N R 10 E


TYPE MONUMENT P.K.NAIL
ON SURFACE - ~~BELOW~~ ON
LEFT - PAV'T - ~~RIGHT~~ 2.4'
7.1' TOLT EDGE PAVEMENT
S.L.M. 471+68.32

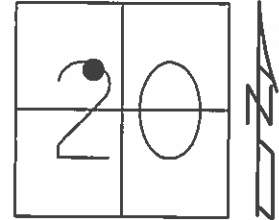

Grid: Northing: 658610.904 Easting: 1627902.376

RECORD: P.T.
STA. 371+78.69
SET P.K.NAIL, 1972

FD P.K./WASHER
7/16/92
SET P.K./WASHER
9/3//92, MB
FD P.K./WASHER
GPS, REFC17
8/6/13, SDC
SET MAG/WASHER
GPS, NEWREFC17
9/11/15, JFO

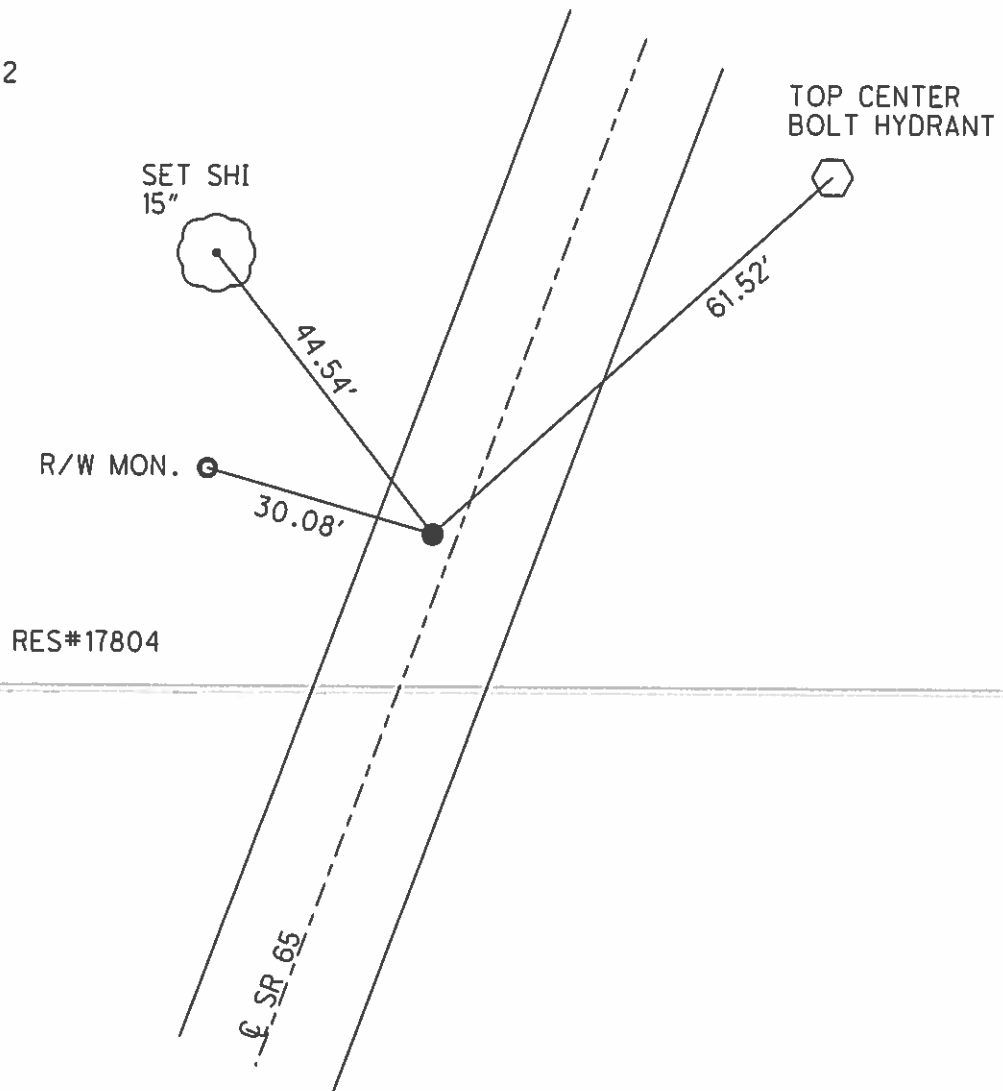

RECORD: P.I.
CURVE DATA 1926
STA. 370+79.2
 $\Delta = 18^{\circ}05' RT$
D = $9^{\circ} 00'$
R = 637.28
T = 101.41
L = 200.90

O.D.O.T. DISTRICT 2 SURVEY OFFICE (USE ONLY)

PERSONNEL

REFERENCE NO. 17 D

SHEET 40 OF 63


NOTES WESTFALL
H.C. O'DONNELL
R.C. LEU
RHOADES

DATE 4/22/15
WEATHER CLOUDY
TEMP. 40°

ROUTE SR 65
COUNTY WOOD
TOWNSHIP MIDDLETON
SECTION 20
T 6 N R 10 E

TYPE MONUMENT P.K./WASHER
ON SURFACE - ~~BELOW~~ ON
~~LEFT~~ - PAV'T - RIGHT 0.6'
10.1' TOLT EDGE PAVEMENT
S.L.M. 476+76.32


Grid: Northing: 659067.399 Easting: 1628125.25

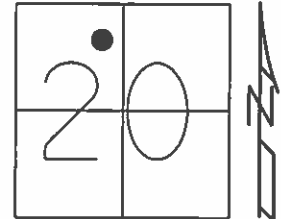

RECORD: P.C.
STA. 376+86.89
SET P.K.NAIL, 1972

FD P.K./WASHER
7/16/92
SET P.K./WASHER
9/4/92, MB
FD P.K./WASHER
5/25/04
GPS, REFD17
8/6/13, SDC
SET MAG/WASHER
GPS, NEWREFD17
9/11/15, JFO

RECORD: P.I.
CURVE DATA 1926
STA. 378+61.95
 $\Delta = 3^\circ 30' \text{ LT}$
D = 1° 00'
R = 5729.65
T = 175.06
L = 350.00

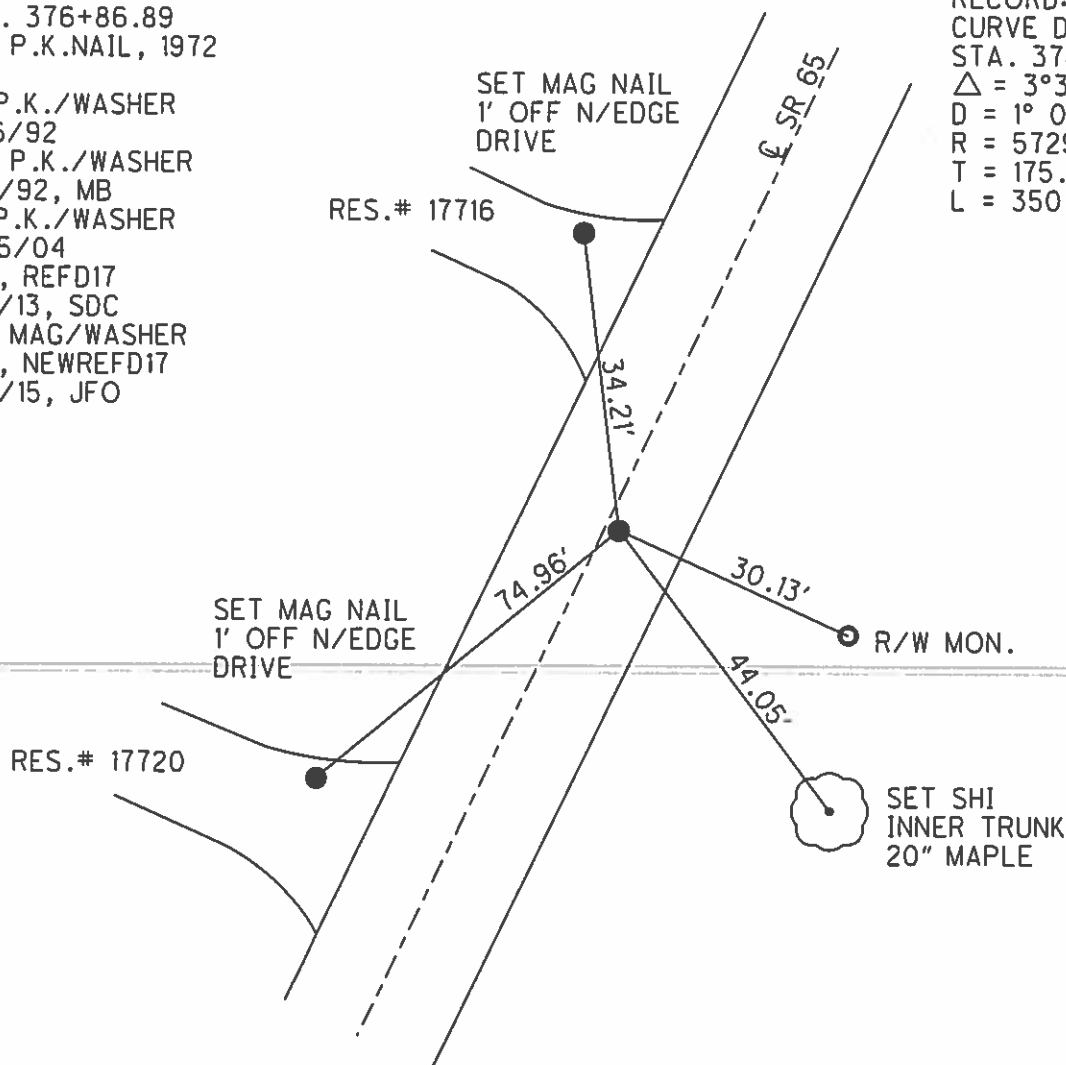

O.D.O.T. DISTRICT 2 SURVEY OFFICE (USE ONLY)

PERSONNEL

REFERENCE NO. 17 E

SHEET 41 OF 63



NOTES WESTFALL
H.C. O'DONNELL
R.C. LEU
RHOADES

DATE 4/22/15
WEATHER CLOUDY
TEMP. 40°

ROUTE SR 65
COUNTY WOOD
TOWNSHIP MIDDLETON
SECTION 20
T 6 N R 10 E

TYPE MONUMENT P.K./WASHER
ON SURFACE - ~~BELOW~~ ON
LEFT - PAV'T - RIGHT ON
9.4' TOLT EDGE PAVEMENT
S.L.M. 480+26.11

Grid: Northing: 659386.333 Easting: 1628269.157

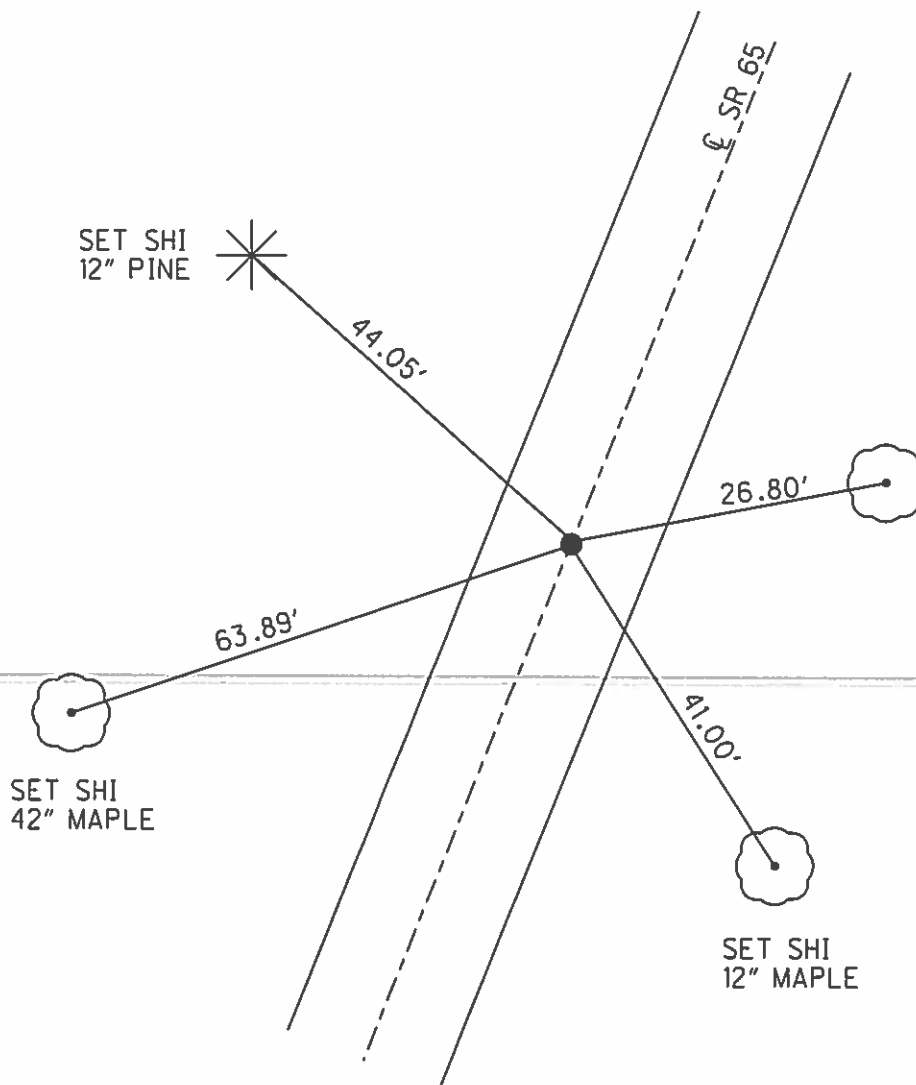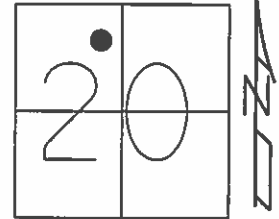

RECORD: P.I.
CURVE DATA 1926
STA. 378+61.95
 $\Delta = 3^{\circ}30'$ LT
D = $1^{\circ}00'$
R = 5729.65
T = 175.06
L = 350.00

RECORD: P.T.
STA. 380+36.89
SET P.K.NAIL, 1972

FD P.K./WASHER
7/16/92
SET P.K./WASHER
9/4/92, MB
FD P.K./WASHER
5/25/04
GPS, REFE17
8/6/13, SDC
SET MAG/WASHER
GPS, NEWREFE17
9/14/15, JFO

O.D.O.T. DISTRICT 2 SURVEY OFFICE (USE ONLY)

PERSONNEL

REFERENCE NO. 17 F

SHEET 42 OF 63


NOTES WESTFALL
H.C. O'DONNELL
R.C. LEU
RHOADES

DATE 4/22/15
WEATHER CLOUDY
TEMP. 40°

ROUTE SR 65
COUNTY WOOD
TOWNSHIP MIDDLETON
SECTION 20
T 6 N R 10 E

TYPE MONUMENT P.K./WASHER
ON SURFACE - ~~BELOW~~ ON
LEFT - PAV'T - RIGHT ON
10.1' TO RT EDGE PAVEMENT
S.L.M. 488+73.14


Grid: Northing: 660168.703 Easting: 1628593.531

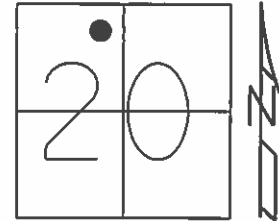

RECORD: P.C.
STA. 388+83.5

FD P.K./WASHER
7/16/92
SET P.K./WASHER
9/4/92, MB
FD P.K./WASHER
5/25/04
GPS, REFF17
9/13/13, SDC
SET MAG/WASHER
GPS, NEWREFGA17
9/14/15, JFO

RECORD: P.I.
STA. 391+24.7
 $\Delta = 23^\circ 37' 30''$ LT
MEAS. 1972

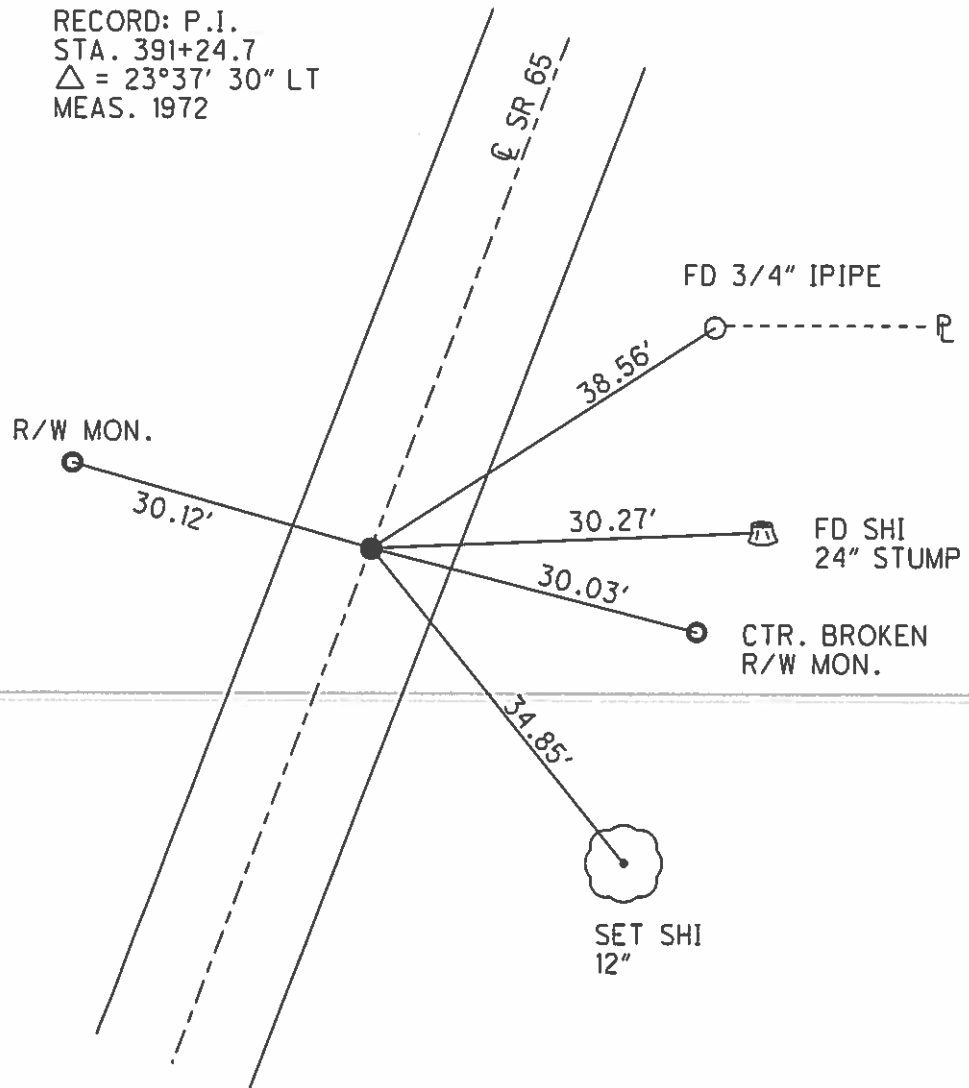

O.D.O.T. DISTRICT 2 SURVEY OFFICE (USE ONLY)

PERSONNEL

REFERENCE NO. 17 G

SHEET 43 OF 63


NOTES WESTFALL
H.C. O'DONNELL
R.C. LEU
RHOADES

DATE 4/22/15
WEATHER CLOUDY
TEMP. 40°

ROUTE SR 65
COUNTY WOOD
TOWNSHIP MIDDLETON
SECTION 20
T 6 N R 10 E

TYPE MONUMENT P.K./WASHER
ON SURFACE - ~~BELOW~~ ON
LEFT - PAV'T - RIGHT ON
11.8' TORT EDGE PAVEMENT
S.L.M. 493+49.13


Grid: Northing: 660632.796 Easting: 1628681.175

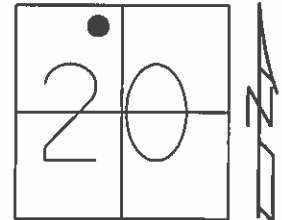

RECORD: P.T.
STA. 393+82

FD P.K./WASHER
7/16/92
SET P.K./WASHER
9/4/92, MB
FD P.K./WASHER
5/25/04
GPS, REFG17
9/3/13, SDC
SET MAG/WASHER
GPS, NEWREFGG17
9/14/15, JFO

RECORD: P.I.
STA. 391+24.7
 $\Delta = 23^\circ 37' 30''$ LT
MEAS. 1972

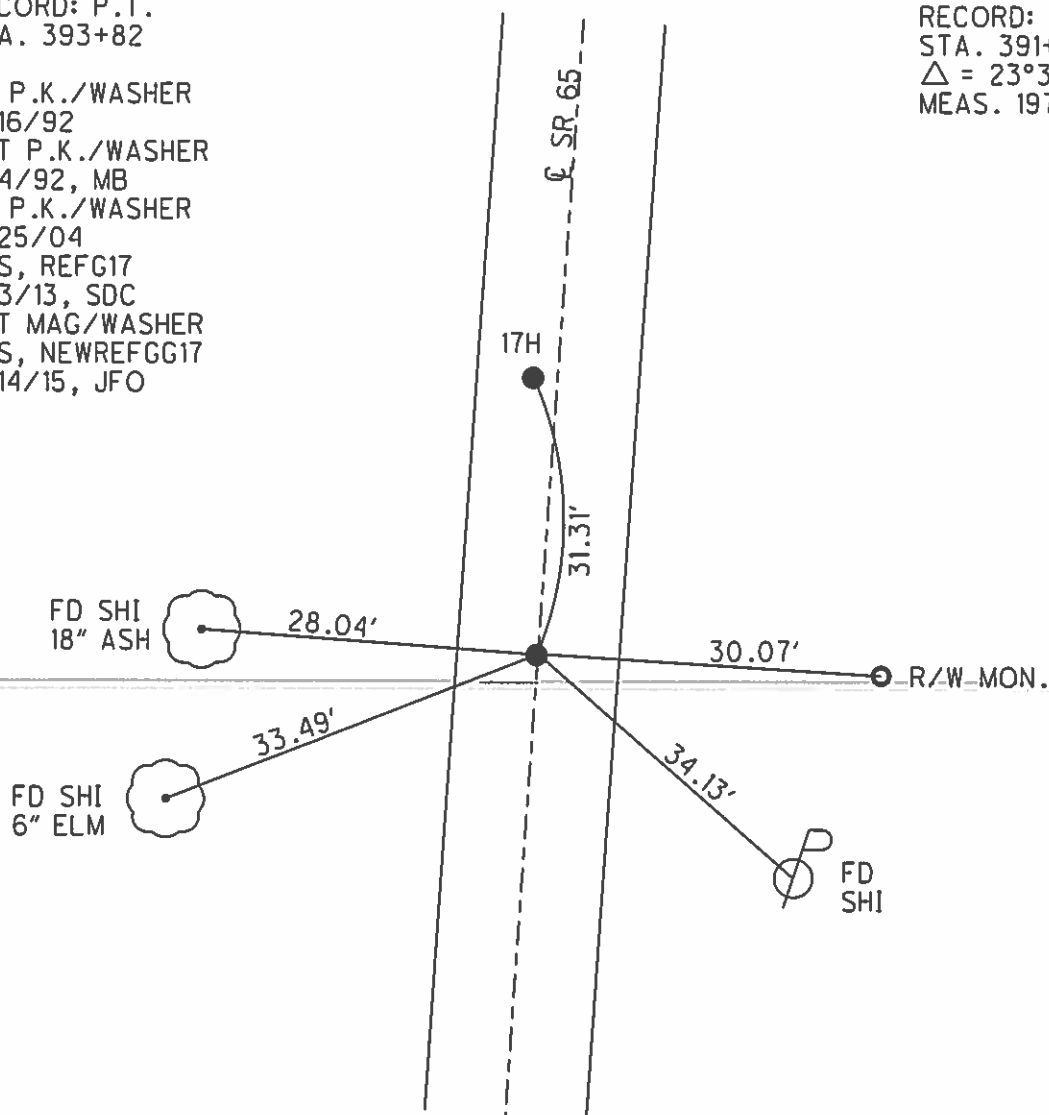

O.D.O.T. DISTRICT 2 SURVEY OFFICE (USE ONLY)

PERSONNEL

REFERENCE NO. 17 H

SHEET 44 OF 63

NOTES NIESE DATE 2/16/24

H.C. NIESE WEATHER FAIR

R.C. ASTON TEMP. 32°

ROUTE SR 65

COUNTY WOOD

TOWNSHIP MIDDLETON

SECTION 20

DWG BY RHOADES PID 93680

T 6 N R 10 E

TYPE MONUMENT MAG/WASHER

ON SURFACE - ~~BELOW~~ ON

OFFSET Q PAVEMENT 1.8' LT : ~~RT~~

11.2' TO RT EDGE PAVEMENT


STATION: 493+80.45

HORZ.DATUM: NAD83 2011

GEOID: NAVD88 2018

GRID: NORTHING: 660663.870

EASTING: 1628680.618

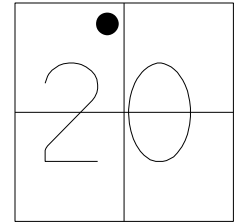

SET SHI
12" ASH



32.58'

FD SHI
18" ASH



31.78'

17G

42.95'

R/W MON

DIST .17G-17H= 31.31'

RECORD: P.C.
STA. 393+82
FD P.K./WASHER
7/16/92
SET P.K./WASHER
9/4/92, MB
FD P.K./WASHER
5/25/04
REFH17
9/3/13, SDC
SET MAG/WASHER
NEWREFH17
9/14/15, JFO
FD MAG/WASHER
REF17H
2/16/24, TDN

O.D.O.T. DISTRICT 2 SURVEY OFFICE (USE ONLY)

PERSONNEL

REFERENCE NO. 17 1

SHEET 45 OF 63

NOTES LEU
H.C. O'DONNELL
R.C. RHOADES

DATE 4/30/15
WEATHER CLOUDY
TEMP. 50°

ROUTE SR 65
COUNTY WOOD
TOWNSHIP MIDDLETON
SECTION 20
T 6 N R 10 E

TYPE MONUMENT P.K./WASHER


~~ON SURFACE~~ - BELOW 0.25'

LEFT - PAV'T - ~~RIGHT~~ 3.4'

6.1' TO LT EDGE PAVEMENT


S.L.M. 495+31.23

Grid: Northing: 660814.635 Easting: 1628685.356

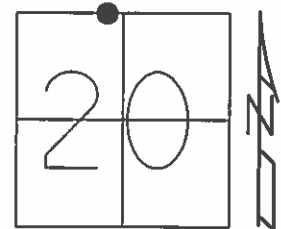

RECORD: P.C.

FD P.K./WASHER
7/16/92
SET P.K./WASHER
7/28/92, MB
FD P.K./WASHER
5/25/04
GPS, REF117
9/4/13, SDC
SET MAG/WASHER
GPS, NEWREF117
9/14/15, JFO

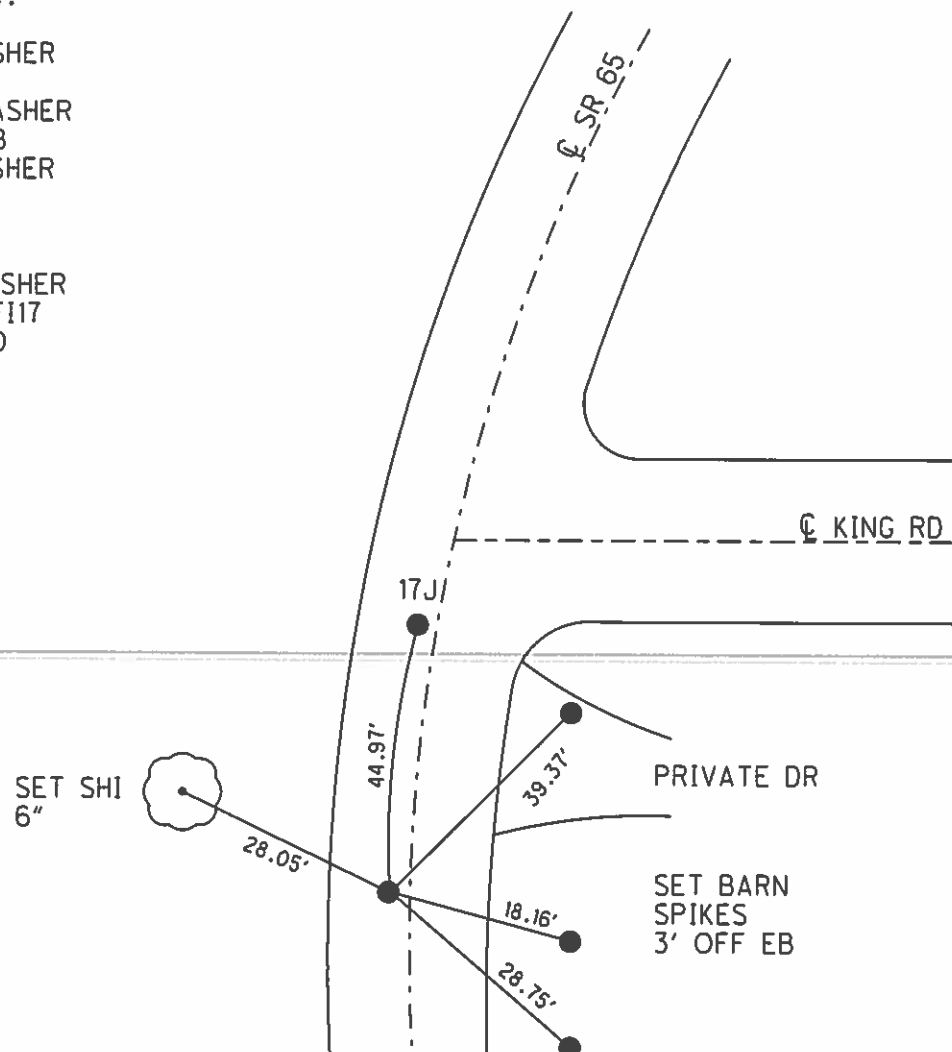

O.D.O.T. DISTRICT 2 SURVEY OFFICE (USE ONLY)

PERSONNEL

REFERENCE NO. 17 J

SHEET 46 OF 63

NOTES LEU

DATE 4/30/15

ROUTE SR 65

H.C. O'DONNELL

WEATHER CLOUDY

COUNTY WOOD

R.C. RHOADES

TEMP. 50°

TOWNSHIP MIDDLETON

SECTION 20

T 6 N R 10 E

TYPE MONUMENT P.K./WASHER


~~ON SURFACE~~ - BELOW 0.25'

LEFT - PAV'T - ~~RIGHT~~ 2.4'

7.1' TO LT EDGE PAVEMENT


S.L.M. 495+76.18

Grid: Northing: 660859.335 Easting: 1628690.000

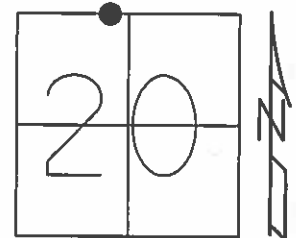

RECORD:
ORIGIN UNKNOWN

FD P.K./WASHER
7/16/92
SET P.K./WASHER
9/4/92, MB
FD P.K./WASHER
8/6/13, SDC
GPS, REFJ17
9/4/13, SDC
SET MAG/WASHER
GPS, NEWREFJ17
9/14/15, JFO

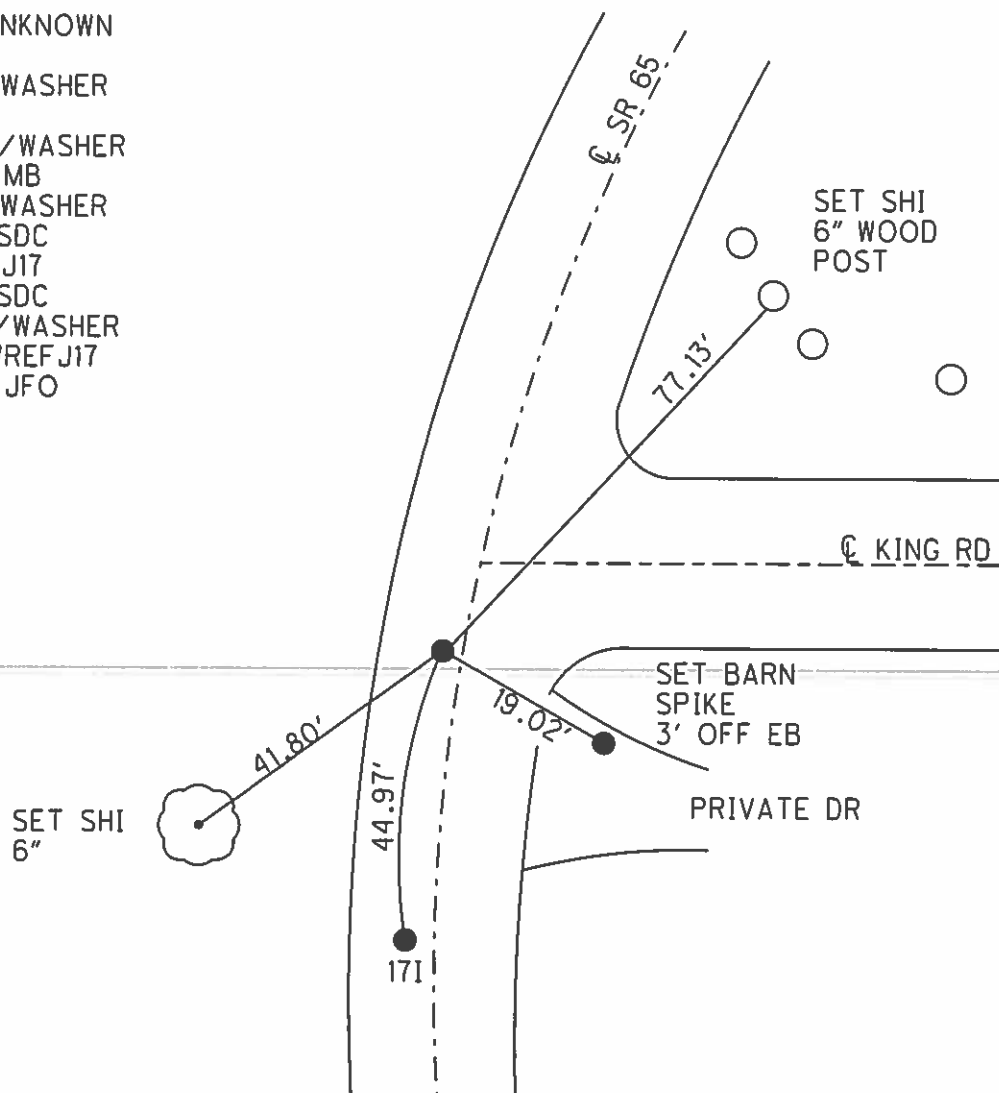


O.D.O.T. DISTRICT 2 SURVEY OFFICE (USE ONLY)


PERSONNEL _____ REFERENCE NO. 18 SHEET 47 OF 63
 NOTES NIESE DATE 2/16/24 ROUTE SR 65
 H.C. NIESE WEATHER FAIR COUNTY WOOD
 R.C. ASTON TEMP. 32° TOWNSHIP MIDDLETON
 SECTION 17
 DWG BY RHOADES PID 93680 T 6 N R 10 E

TYPE MONUMENT MAG/WASHER
 ON SURFACE - ~~BELOW~~ ON
 OFFSET Q PAVEMENT 1.3' LT : ~~RT~~
8.6' TO LT EDGE PAVEMENT
 STATION: 499+76.22

HORZ. DATUM: NAD83 2011 GEOID: NAVD88 2018
 GRID: NORTHING: 661244.914 EASTING: 1628791.904

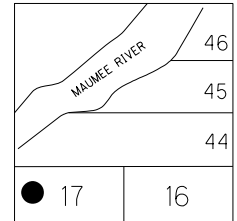

RECORD: P.C.C.
 STA. 399+82.2
 1926 PLAN
 SET P.K.NAIL 1972
 FD P.K./WASHER
 7/16/92
 SET P.K./WASHER
 7/28/92, MB
 FD P.K./WASHER
 5/25/04, 8/6/13
 GPS, REF18
 9/4/13, SDC
 SET MAG/WASHER
 NEWREF18
 9/14/15, JFO
 FD MAG/WASHER
 REF18
 2/16/24, TDN

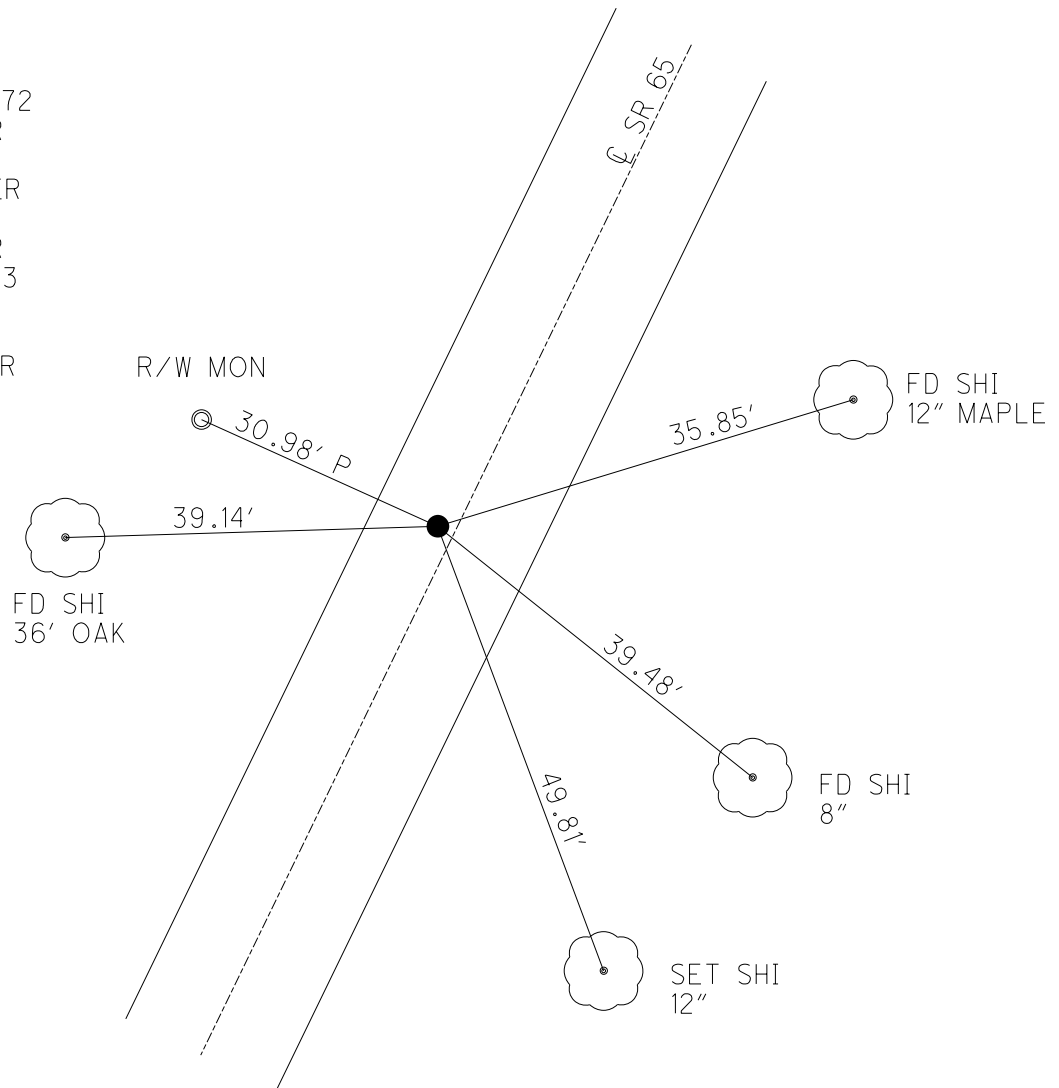

O.D.O.T. DISTRICT 2 SURVEY OFFICE (USE ONLY)

PERSONNEL

REFERENCE NO. 18 A

SHEET 48 OF 63

NOTES LEU

DATE 4/30/15

ROUTE SR 65

H.C. O'DONNELL

WEATHER CLOUDY

COUNTY WOOD

R.C. RHOADES

TEMP. 50°

TOWNSHIP MIDDLETON

SECTION RT 44

T 1 R 10 E

TYPE MONUMENT P.K./WASHER


ON SURFACE - ~~BELOW~~ ON

LEFT - PAV'T - ~~RIGHT~~ 0.5'

9.5' TOLT EDGE PAVEMENT

S.L.M. 511+87.27

Grid: Northing: 662303.137 Easting: 1629375.833

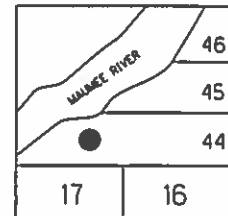

RECORD: P.C.C.

STA. 411+93.66

1926 PLAN

SET P.K.NAIL 1972

FD P.K./WASHER

7/17/92

SET P.K./WASHER

7/28/92, MB

FD P.K./WASHER

5/25/04, 8/6/13


GPS, REFA18

9/4/13, SDC

SET MAG/WASHER

GPS, NEWREFA18

9/14/15, JFO

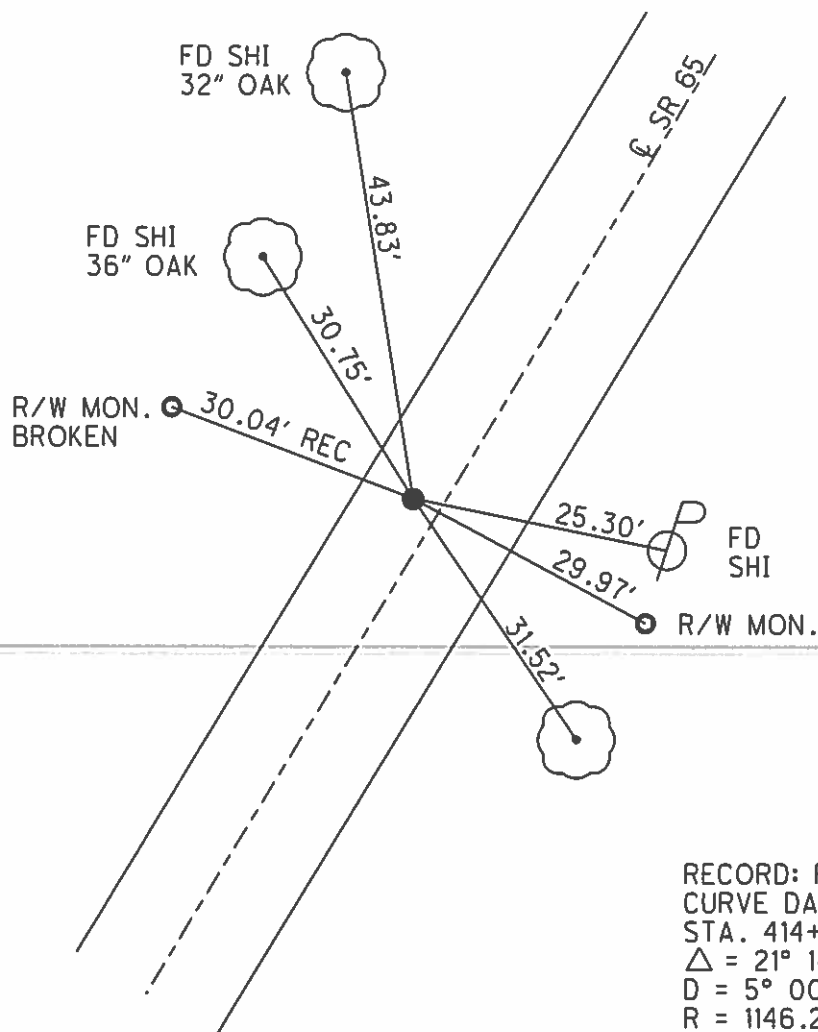

RECORD: P.I.
CURVE DATA 1926
STA. 414+08.67
 $\Delta = 21^\circ 14' RT$
 $D = 5^\circ 00'$
 $R = 1146.28$
 $T = 214.81$
 $L = 424.66$

O.D.O.T. DISTRICT 2 SURVEY OFFICE (USE ONLY)

PERSONNEL

REFERENCE NO. 18 B

SHEET 49 OF 63

NOTES

LEU

DATE

4/30/15

ROUTE

SR 65

H.C.

O'DONNELL

WEATHER

CLOUDY

COUNTY

WOOD

R.C.

RHOADES

TEMP.

50°

TOWNSHIP

MIDDLETON

SECTION

RT 44

T 1

R 10 E

TYPE MONUMENT P.K./WASHER


ON SURFACE - ~~BELOW~~ ON

LEFT - PAV'T - ~~RIGHT~~ 3.2'


7.4' TOLT EDGE PAVEMENT

S.L.M. 516+15.76

Grid: Northing: 662602.778 Easting: 1629678.582

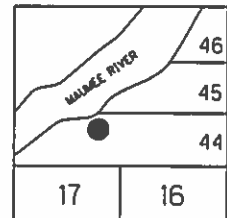

RECORD: P.C.C.
STA. 416+18.52
P.T. FOR 5° 0'
1926 PLAN
SET P.K.NAIL 1972
FD P.K./WASHER
7/15/92
SET P.K./WASHER
7/28/92, MB
FD P.K./WASHER
5/25/04, 8/6/13
GPS, REFB18
9/4/13, SDC
SET MAG/WASHER
GPS, NEWREFB18
9/14/15, JFO

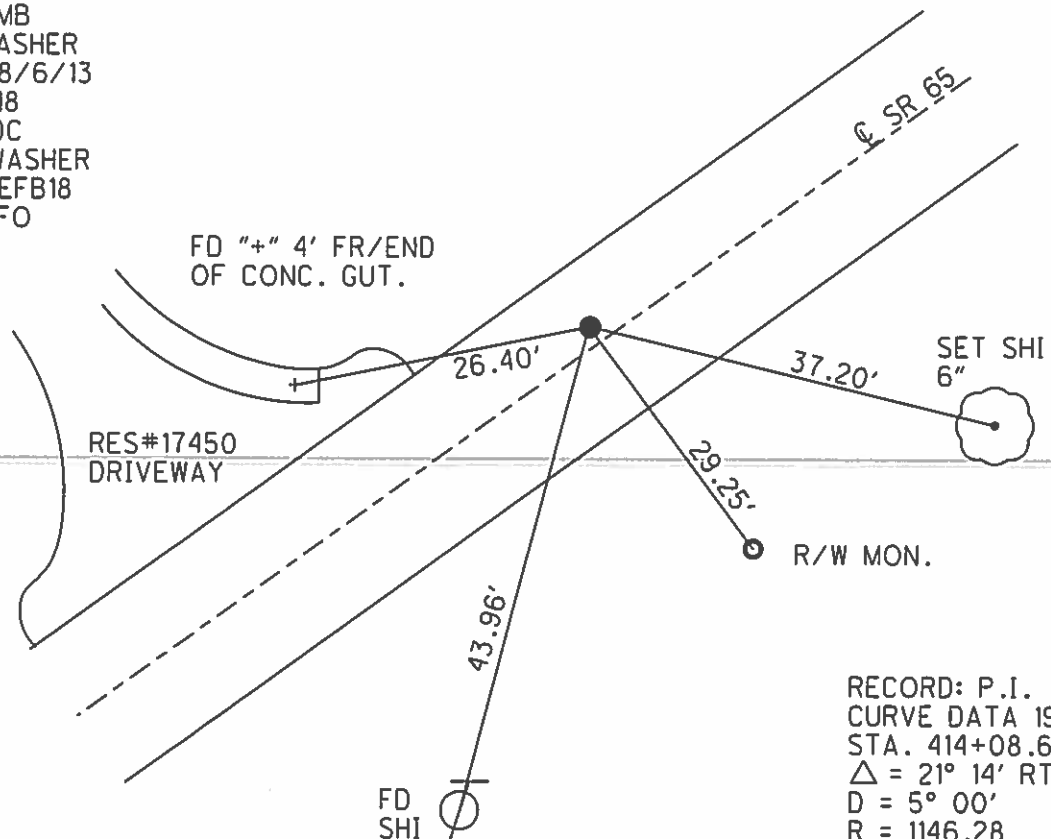

RECORD: P.I.
CURVE DATA 1926
STA. 414+08.67
 $\Delta = 21^\circ 14' \text{ RT}$
 $D = 5^\circ 00'$
 $R = 1146.28$
 $T = 214.81$
 $L = 424.66$

O.D.O.T. DISTRICT 2 SURVEY OFFICE (USE ONLY)

PERSONNEL

REFERENCE NO. 18 C

SHEET 50 OF 63


NOTES LEU
H.C. O'DONNELL
R.C. RHOADES

DATE 4/30/15
WEATHER CLOUDY
TEMP. 50°

ROUTE SR 65
COUNTY WOOD
TOWNSHIP MIDDLETON
SECTION RT 44
T 1 R 10 E


TYPE MONUMENT P.K./WASHER
ON SURFACE - ~~BELOW~~ ON
LEFT - PAV'T - RIGHT ON
9.9' TOLT EDGE PAVEMENT
S.L.M. 526+17.45

Grid: Northing: 662956.199 Easting: 1630284.248

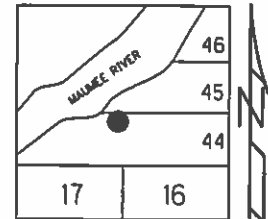

RECORD:

FD P.K./WASHER
7/15/92
SET P.K./WASHER
7/28/92, MB
FD P.K./WASHER
5/25/04, 8/6/13
GPS, REFC18
9/4/13, SDC
SET MAG/WASHER
GPS, NEWREFC18
9/14/15, JFO

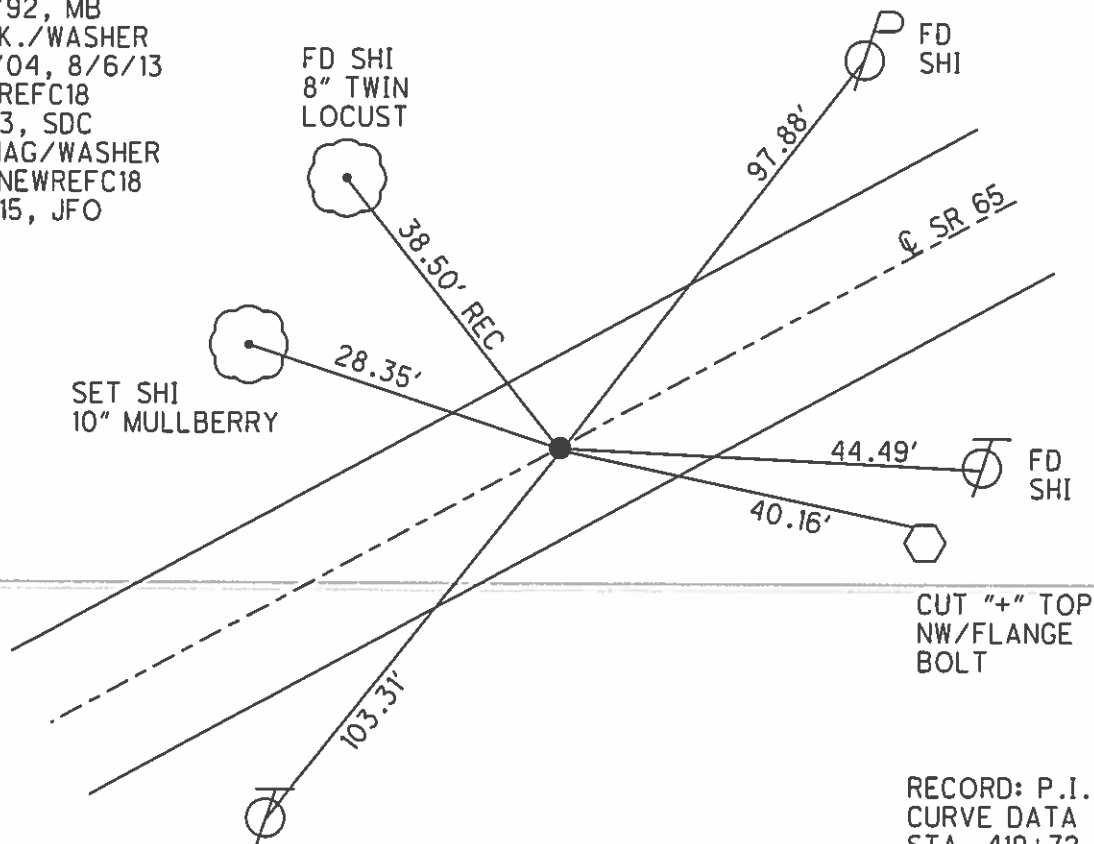

RECORD: P.I.
CURVE DATA 1926
STA. 419+72.31
 $\Delta = 7^\circ 04' RT$
D = 1° 00'
R = 5729.65
T = 353.79
L = 706.67

O.D.O.T. DISTRICT 2 SURVEY OFFICE (USE ONLY)

PERSONNEL

REFERENCE NO. 19

SHEET 51 OF 63

NOTES LEU

DATE 4/30/15

ROUTE SR 65

H.C. O'DONNELL

WEATHER CLOUDY

COUNTY WOOD

R.C. RHOADES

TEMP. 50°

TOWNSHIP MIDDLETON

SECTION RT 45

T 1 R 10 E

TYPE MONUMENT P.K./WASHER


ON SURFACE - ~~BELOW~~ ON

LEFT - PAV'T - ~~RIGHT~~ 0.6'

10.0' TOLT EDGE PAVEMENT

S.L.M. 541+46.24

Grid: Northing: 663781.166 Easting: 1631916.515

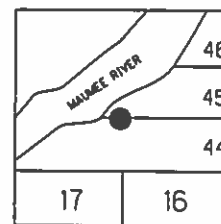

RECORD:

ORIGIN UNKNOWN

FD P.K./WASHER

7/15/92

SET P.K./WASHER

9/4/92, MB

FD P.K./WASHER

5/25/04, 8/6/13


GPS, REF19

9/4/13, SDC

SET MAG/WASHER

GPS, NEWREF19

9/14/15, JFO

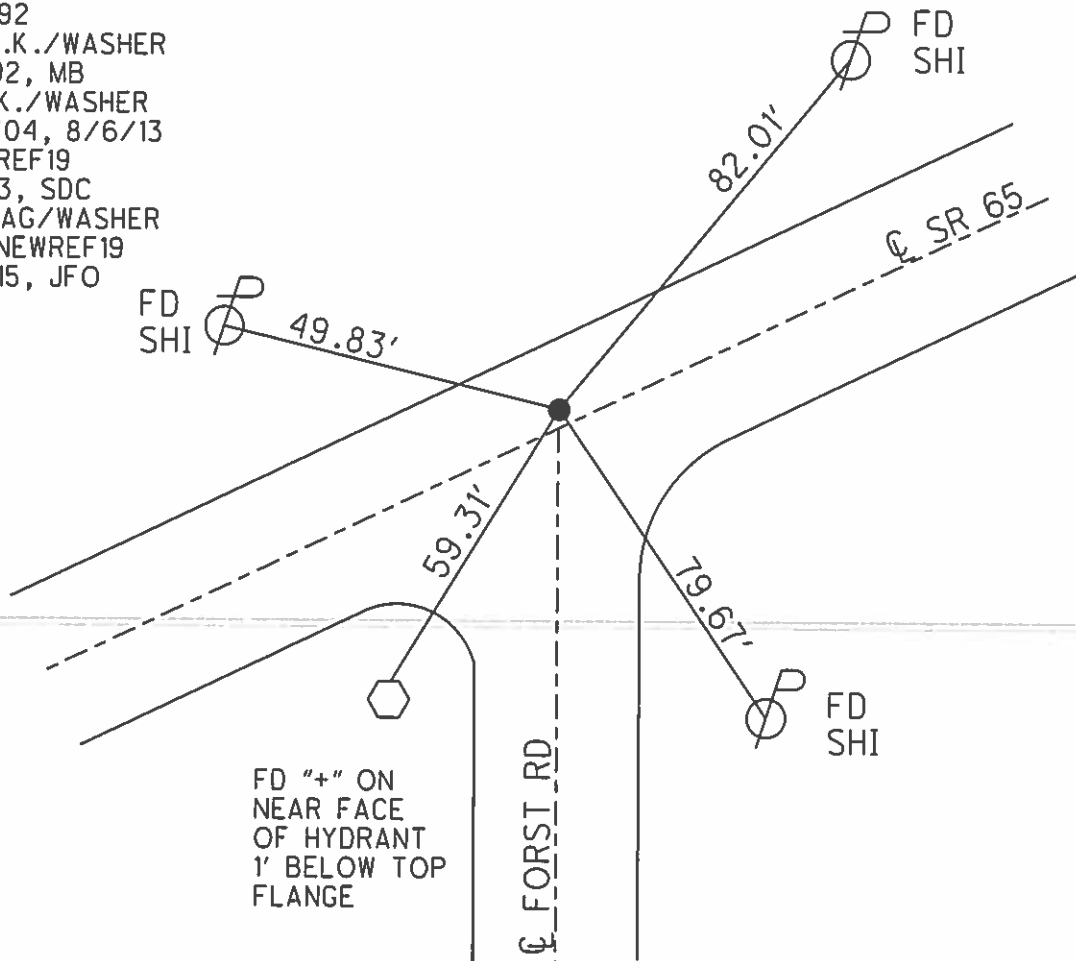

O.D.O.T. DISTRICT 2 SURVEY OFFICE (USE ONLY)

PERSONNEL

REFERENCE NO. 19 A

SHEET 52 OF 63

NOTES LEU

DATE 4/30/15

ROUTE SR 65

H.C. O'DONNELL

WEATHER CLOUDY

COUNTY WOOD

R.C. RHOADES

TEMP. 50°

TOWNSHIP MIDDLETON

SECTION RT 45

T 1 R 10 E

TYPE MONUMENT P.K.NAIL


ON SURFACE - ~~BELOW~~ ON

LEFT - PAV'T - ~~RIGHT~~ 1.6'

8.8' TOLT EDGE PAVEMENT


S.L.M. 545+83.49

Grid: Northing: 663978.412 Easting: 1632306.615

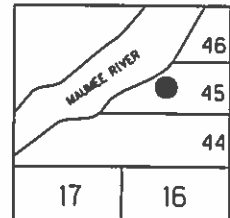

RECORD: P.C.
STA. 445+91.46
SET P.K.NAIL 1972

FD P.K./WASHER
7/13/92
SET P.K./WASHER
7/28/92, MB
FD P.K./WASHER
5/25/04, 8/6/13
GPS, REFFA19
9/5/13, SDC
SET MAG/WASHER
GPS, NEWREFA19
9/14/15, JFO

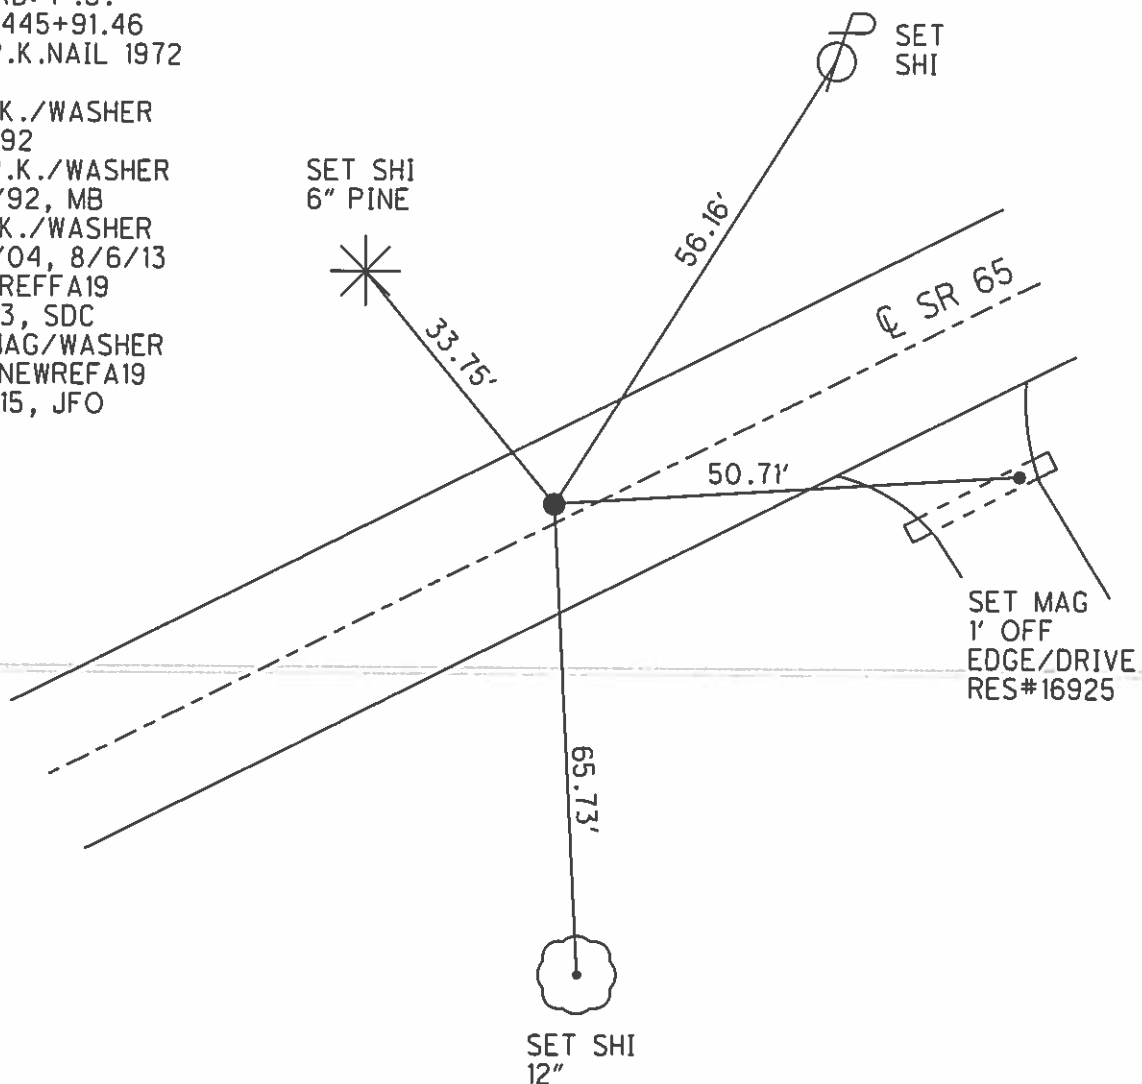

O.D.O.T. DISTRICT 2 SURVEY OFFICE (USE ONLY)

PERSONNEL

REFERENCE NO. 19 B

SHEET 53 OF 63

NOTES LEU

DATE 4/30/15

ROUTE SR 65

H.C. O'DONNELL

WEATHER CLOUDY

COUNTY WOOD

R.C. RHOADES

TEMP. 50°

TOWNSHIP MIDDLETON

SECTION RT 45

T 1 R 10 E

TYPE MONUMENT P.K./WASHER


ON SURFACE - ~~BELOW~~ ON

LEFT - PAV'T - ~~RIGHT~~ 3.6'


6.0' TO LT EDGE PAVEMENT

S.L.M. 546+93.85

Grid: Northing: 664026.595 Easting: 1632406.197

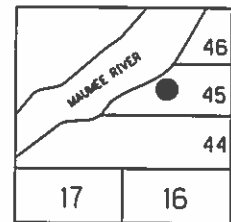

RECORD: P.I.
CURVE DATA 1926
STA. 447+05.79
 $\Delta = 9^\circ 10' \text{ RT}$
 $D = 4^\circ 00'$
 $R = 1432.69$
 $T = 114.83$
 $L = 229.16$

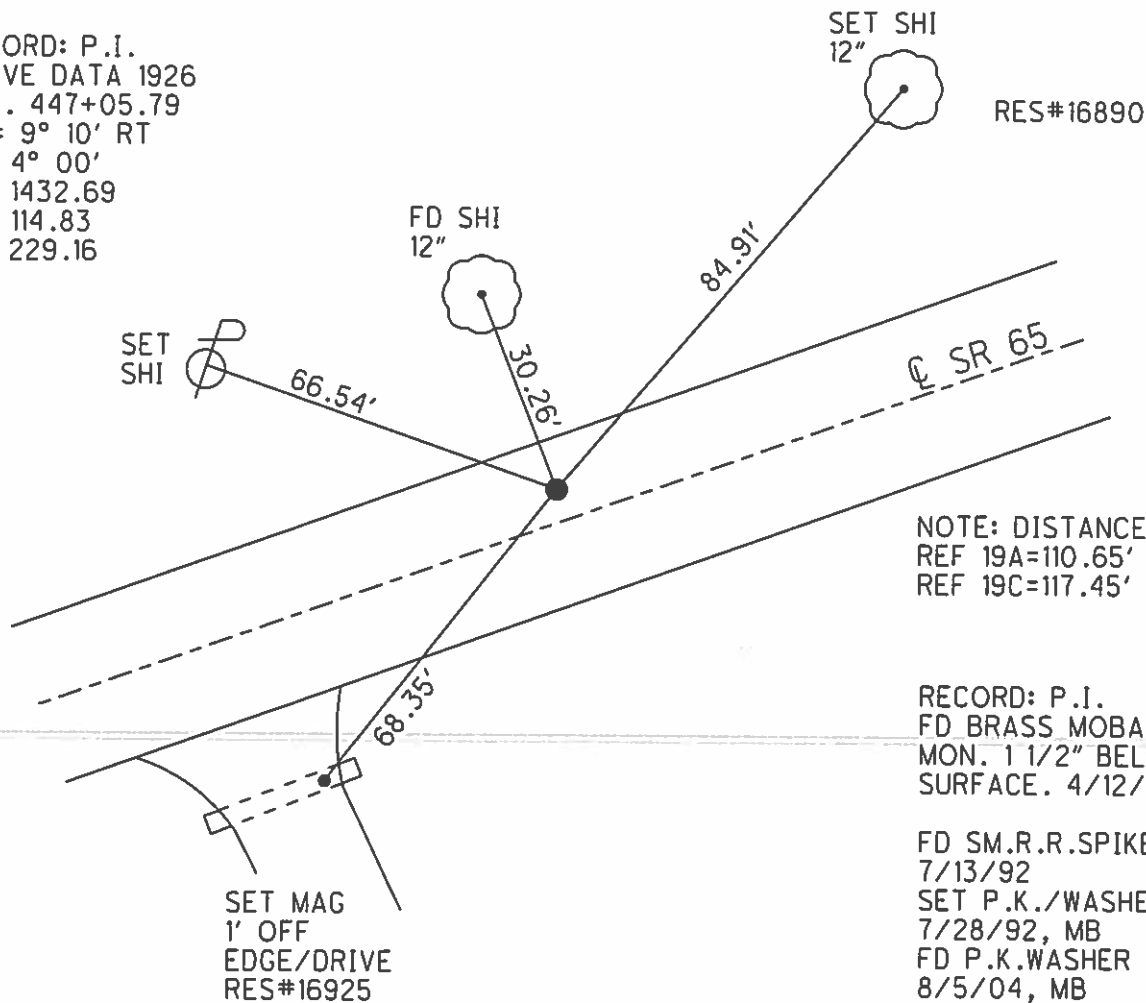

RECORD: P.I.
FD BRASS MOBAR
MON. 1 1/2" BELOW
SURFACE. 4/12/84

FD SM.R.R.SPIKE
7/13/92
SET P.K./WASHER
7/28/92, MB
FD P.K.WASHER
8/5/04, MB
8/5/13, SDC
GPS, REFB19
SET MAG/WASHER
GPS, NEWREFB19
9/14/15, JFO

O.D.O.T. DISTRICT 2 SURVEY OFFICE (USE ONLY)

PERSONNEL

REFERENCE NO. 19 C

SHEET 54 OF 63

NOTES LEU

DATE 4/30/15

ROUTE SR 65

H.C. O'DONNELL

WEATHER CLOUDY

COUNTY WOOD

R.C. RHOADES

TEMP. 50°

TOWNSHIP MIDDLETON

SECTION RT 45

T 1 R 10 E

TYPE MONUMENT P.K./WASHER


ON SURFACE - ~~BELOW~~ ON

~~LEFT~~ - PAV'T - RIGHT 1.2'

9.8' TO LT EDGE PAVEMENT


S.L.M. 548+11.17

Grid: Northing: 664064.258 Easting: 1632517.409

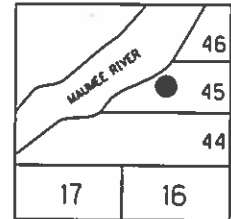

RECORD: P.T.
STA. 448+20.62
SET P.K.NAIL 1972
FD P.K./WASHER
7/13/92
SET P.K./WASHER
7/28/92, MB

FD P.K./WASHER
5/25/04, 8/6/13
GPS, REFFC19
9/5/13, SDC
SET MAG/WASHER
GPS, NEWREFC19
9/16/15, JFO

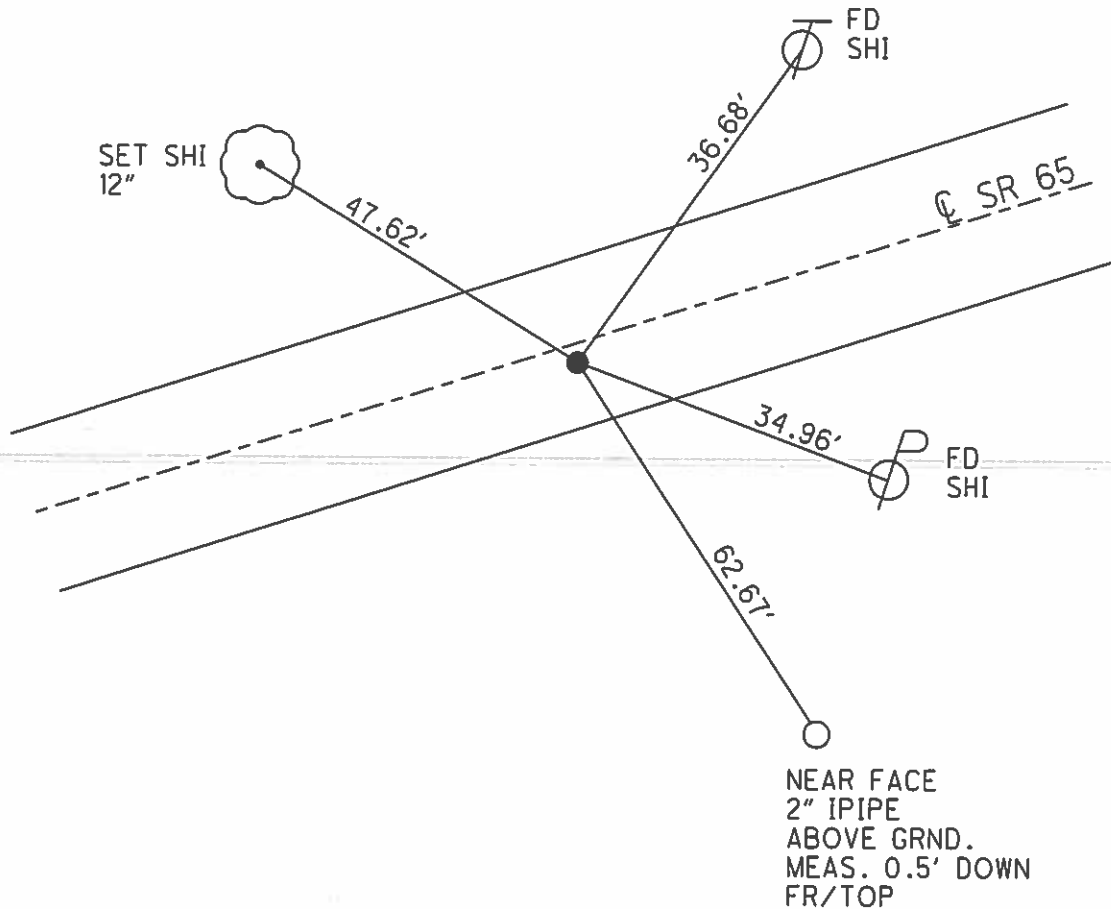

O.D.O.T. DISTRICT 2 SURVEY OFFICE (USE ONLY)

PERSONNEL

REFERENCE NO. 19 D

SHEET 55 OF 63

NOTES

LEU

DATE

4/30/15

ROUTE

SR 65

H.C.

O'DONNELL

WEATHER

CLOUDY

COUNTY

WOOD

R.C.

RHOADES

TEMP.

50°

TOWNSHIP

MIDDLETON

SECTION

RT 46

T 1

R 10 E

TYPE MONUMENT P.K./WASHER


ON SURFACE - ~~BELOW~~ ON

~~LEFT~~ - PAV'T - RIGHT 3.7'


5.7' TORT EDGE PAVEMENT

S.L.M. 570+48.94

Grid: Northing: 664744.558 Easting: 1634649.232

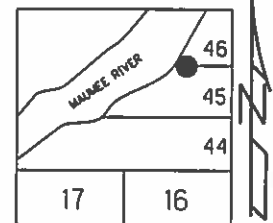

RECORD: P.C.
STA. 471+01.13
SET P.K.NAIL 1972
FD P.K./WASHER
7/13/92
SET P.K./WASHER
7/28/92, MB
FD P.K./WASHER
5/25/04, 8/6/13
GPS, REFFD19
9/5/13, SDC
SET MAG/WASHER
GPS, NEWREFC19
9/16/15, JFO

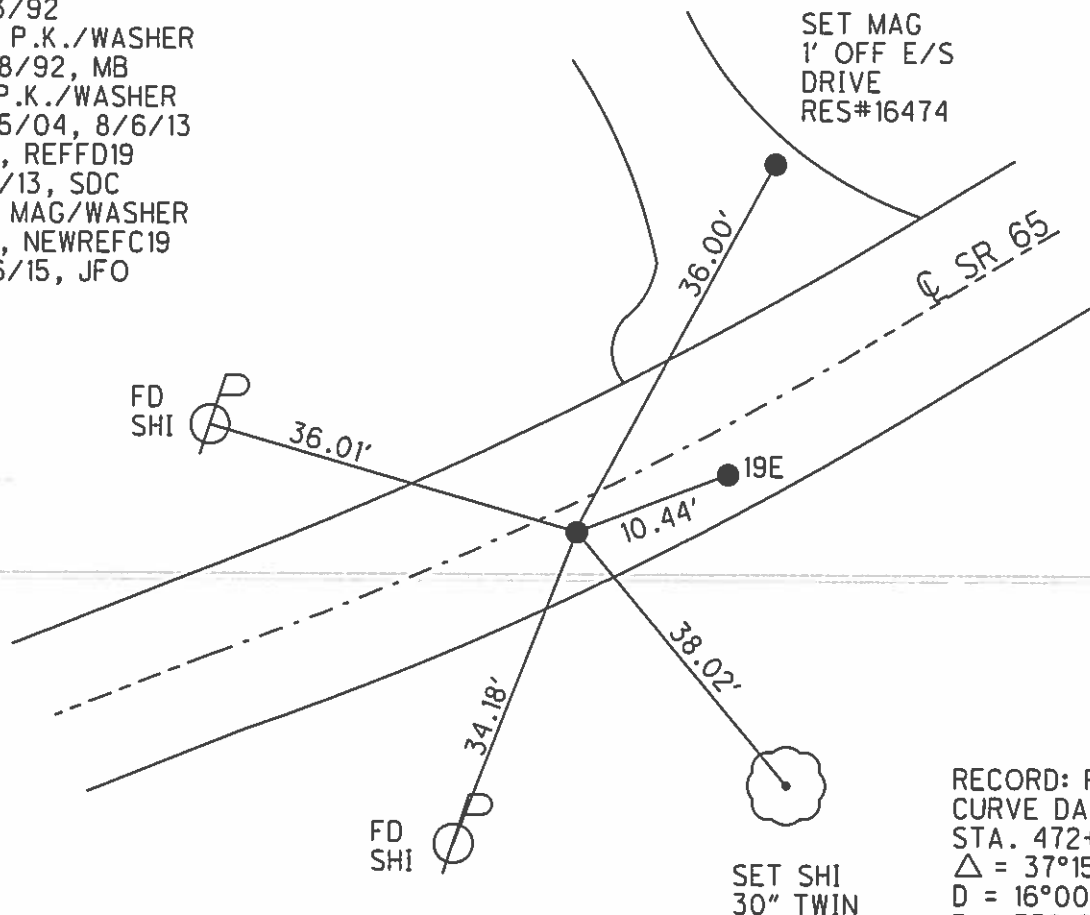

RECORD: P.I.
CURVE DATA 1926
STA. 472+22.15
 $\Delta = 37^{\circ}15' \text{ LT}$
 $D = 16^{\circ}00'$
 $R = 359.27$
 $T = 121.02$
 $L = 232.81$

O.D.O.T. DISTRICT 2 SURVEY OFFICE (USE ONLY)

PERSONNEL

REFERENCE NO. 19 E

SHEET 56 OF 63

NOTES LEU

DATE 4/30/15

ROUTE SR 65

H.C. O'DONNELL

WEATHER CLOUDY

COUNTY WOOD

R.C. RHOADES

TEMP. 50°

TOWNSHIP MIDDLETON

SECTION RT 46

T 1 R 10 E

TYPE MONUMENT P.K./WASHER


ON SURFACE - ~~BELOW~~ ON

~~LEFT~~ - PAV'T - RIGHT 5.5'


4.0' TORT EDGE PAVEMENT

S.L.M. 570+59.38

Grid: Northing: 664746.940 Easting: 1634659.402

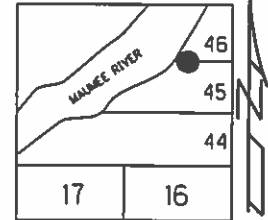

RECORD:
ORIGIN UNKNOWN
FD P.K./WASHER
7/13/92
SET P.K./WASHER
7/28/92, MB
FD P.K./WASHER
5/25/04, 8/6/13
GPS, REFFE19
9/5/13, SDC
SET MAG/WASHER
GPS, NEWREFE19
9/16/15, JFO

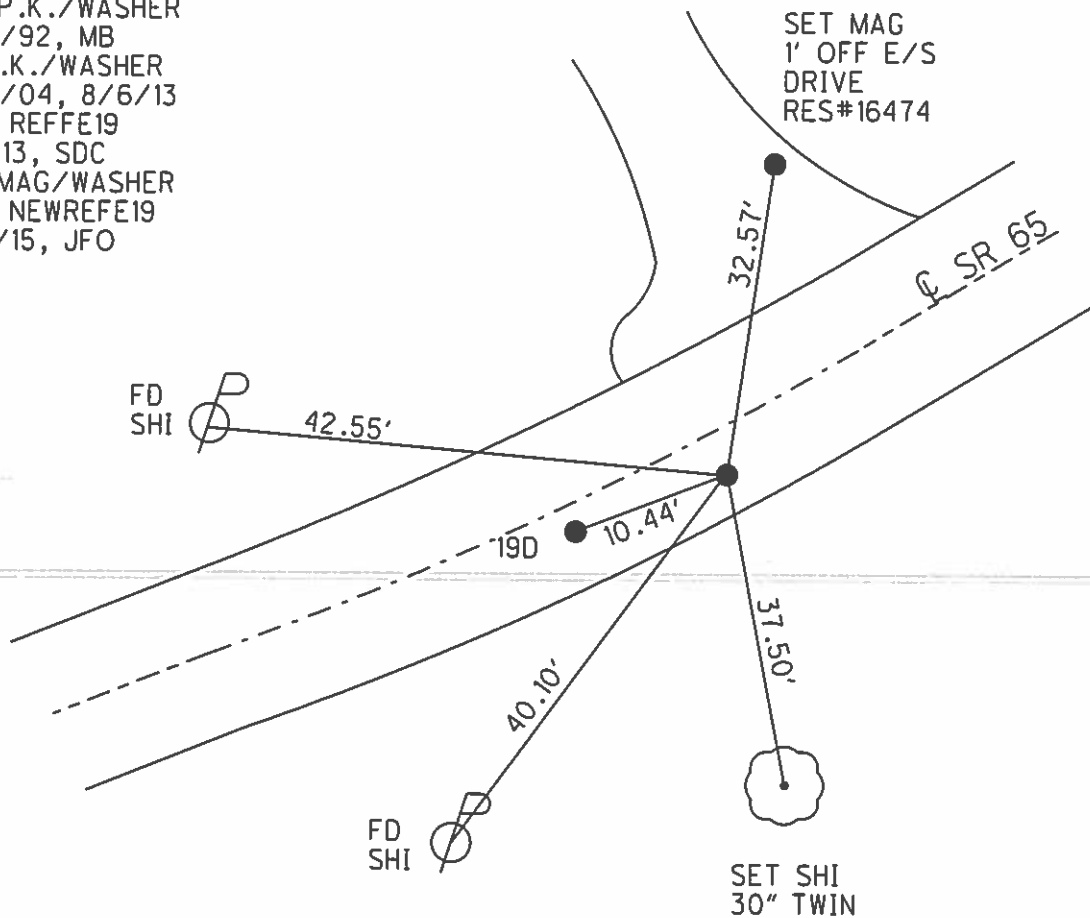

O.D.O.T. DISTRICT 2 SURVEY OFFICE (USE ONLY)

PERSONNEL

REFERENCE NO. 19 F

SHEET 57 OF 63

NOTES LEU

DATE 4/30/15

ROUTE SR 65

H.C. O'DONNELL

WEATHER CLOUDY

COUNTY WOOD

R.C. RHOADES

TEMP. 50°

TOWNSHIP MIDDLETON

SECTION RT 46

T 1 R 10 E

TYPE MONUMENT P.K./WASHER


ON SURFACE - ~~BELOW~~ ON

~~LEFT~~ - PAV'T - RIGHT 2.0'


7.7' ~~TORT~~ EDGE PAVEMENT

S.L.M. 572+82.12

Grid: Northing: 664879.972 Easting: 1634833.886

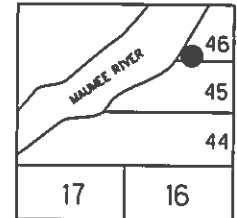

RECORD: P.T.
STA. 473+33.94
SET P.K.NAIL 1972
FD P.K./WASHER
7/13/92
SET P.K./WASHER
7/28/92, MB
FD P.K./WASHER
5/25/04, 8/6/13
GPS, REFFF19
9/5/13, SDC
SET MAG/WASHER
GPS, NEWREFF19
9/16/15, JFO

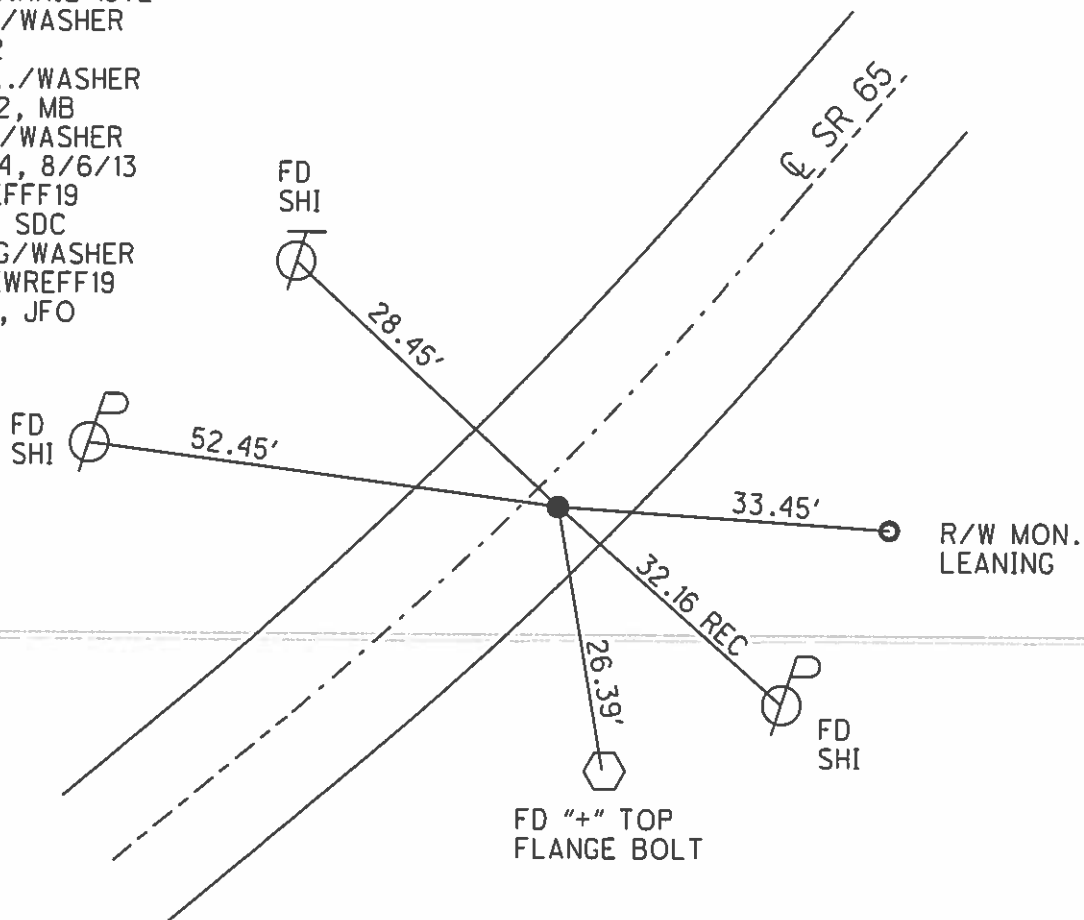

O.D.O.T. DISTRICT 2 SURVEY OFFICE (USE ONLY)

PERSONNEL

REFERENCE NO. 20

SHEET 58 OF 63

NOTES LEU

DATE 4/30/15

ROUTE SR 65

H.C. O'DONNELL

WEATHER CLOUDY

COUNTY WOOD

R.C. RHOADES

TEMP. 50°

TOWNSHIP MIDDLETON

SECTION RT 46

T 1 R 10 E

TYPE MONUMENT P.K./WASHER


ON SURFACE - ~~BELOW~~ ON

~~LEFT~~ - PAV'T - RIGHT 1.0'


10.3' TOLT EDGE PAVEMENT

S.L.M. 581+22.55

Grid: Northing: 665567.765 Easting: 1635316.974

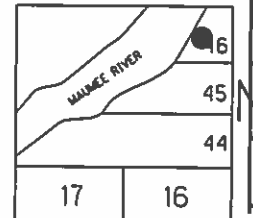

RECORD:
 ORIGIN UNKNOWN
 FD P.K./WASHER
 7/13/92
 SET P.K./WASHER
 9/4/92, MB
 FD P.K./WASHER
 5/25/04, 8/6/13
 GPS, REFF20
 9/6/13, SDC
 SET MAG/WASHER
 GPS, NEWREF20
 9/16/15, JFO

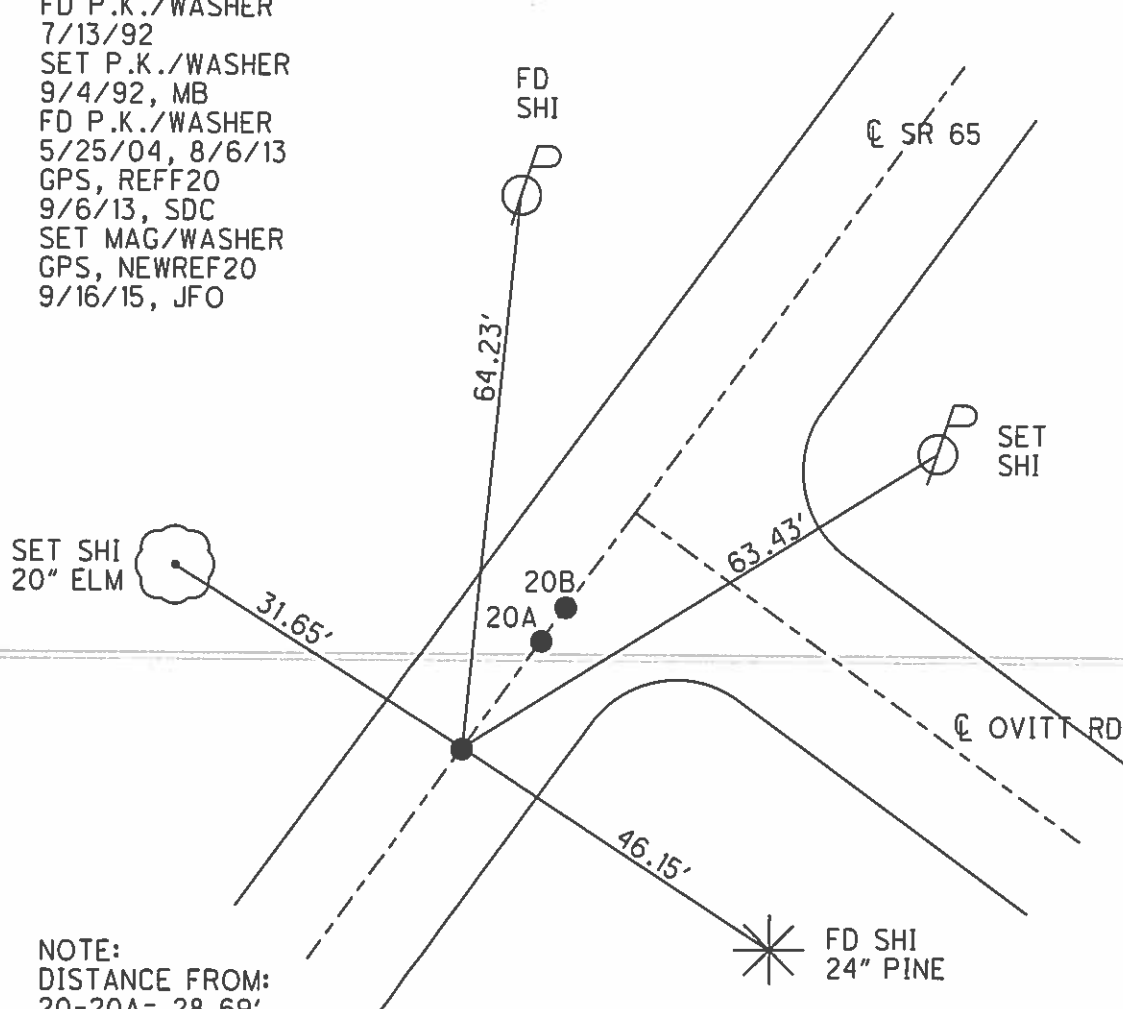

NOTE:
 DISTANCE FROM:
 20-20A= 28.69'
 20A-20B= 1.37'

O.D.O.T. DISTRICT 2 SURVEY OFFICE (USE ONLY)

PERSONNEL

REFERENCE NO 20 A

SHEET 59 OF 63

NOTES LEU

DATE 4/30/15

ROUTE SR 65

H.C. O'DONNELL

WEATHER CLOUDY

COUNTY WOOD

R.C. RHOADES

TEMP. 50°

TOWNSHIP MIDDLETON

SECTION RT 46

T 1 R 10 E

TYPE MONUMENT P.K./WASHER


ON SURFACE - ~~BELOW~~ ON

~~LEFT~~ - PAV'T - RIGHT 0.8'


10.5' TO LT EDGE PAVEMENT

S.L.M. 581+51.22

Grid: Northing: 665591.279 Easting: 1635333.399

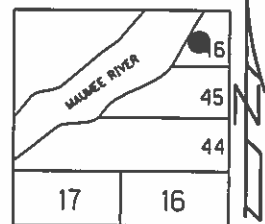

RECORD: P.T.
FD R.R.SPIKE 1972
FD P.K./WASHER
7/13/92
SET P.K./WASHER
9/4/92, MB
FD P.K./WASHER
5/25/04, 8/6/13
GPS, REFA20
9/6/13, SDC
SET MAG/WASHER
GPS, NEWREFA20
9/16/15, JFO

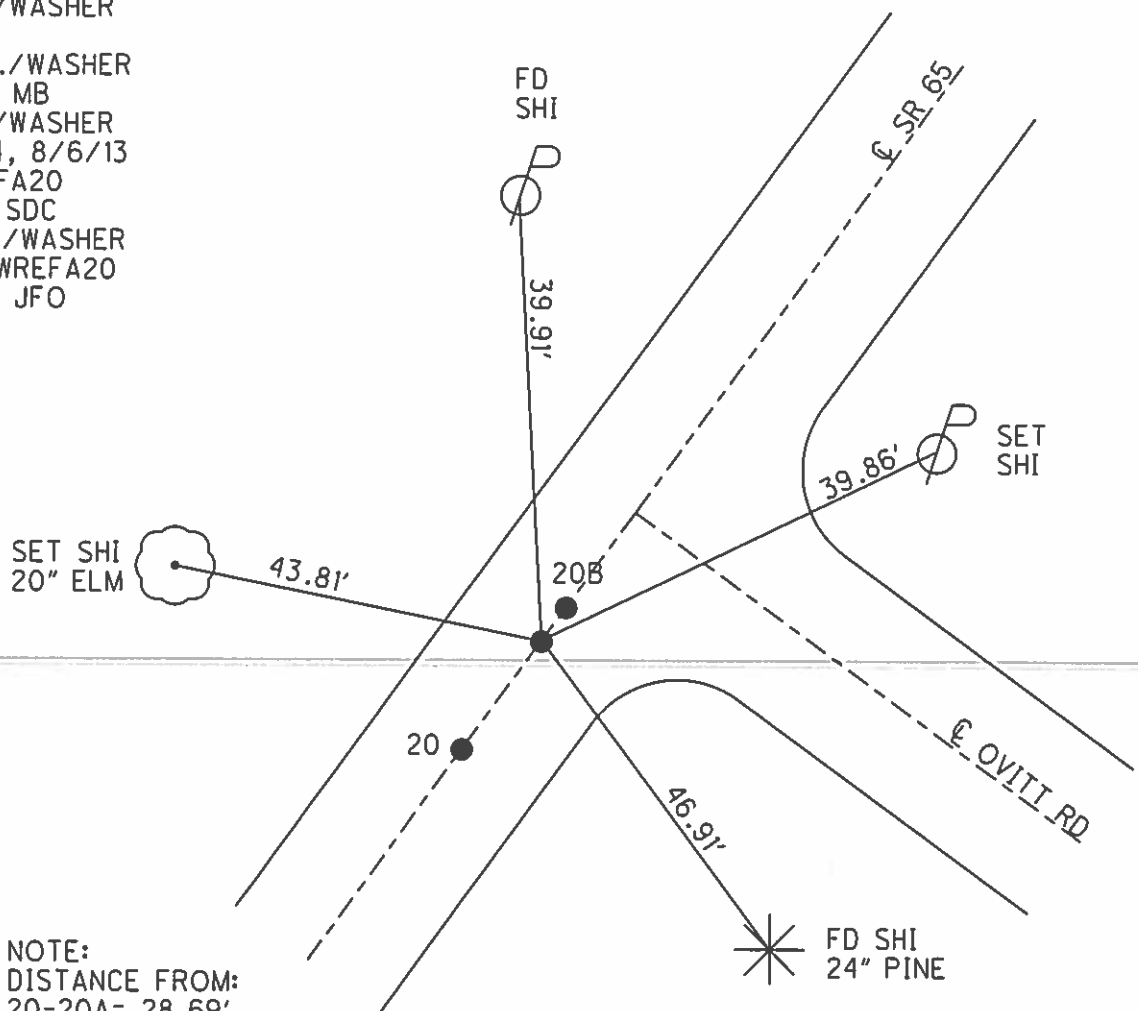

NOTE:
DISTANCE FROM:
20-20A= 28.69'
20A-20B= 1.37'

O.D.O.T. DISTRICT 2 SURVEY OFFICE (USE ONLY)

PERSONNEL

REFERENCE NO 20 B

SHEET 60 OF 63

NOTES LEU

DATE 4/30/15

ROUTE SR 65

H.C. O'DONNELL

WEATHER CLOUDY

COUNTY WOOD

R.C. RHOADES

TEMP. 50°

TOWNSHIP MIDDLETON

SECTION RT 46

T 1 R 10 E

TYPE MONUMENT P.K./WASHER


ON SURFACE - ~~BELOW~~ ON

~~LEFT~~ - PAV'T - RIGHT 0.8'

10.5' TOLT EDGE PAVEMENT

S.L.M. 581+52.58

Grid: Northing: 665592.376 Easting: 1635334.228

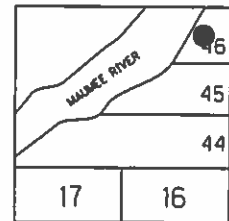

RECORD:

FD BRASS MOBAR MON.

2" BELOW. 1972

FD SM.R.R.SPIKE

7/13/92

SET P.K./WASHER

9/4/92, MB

FD P.K./WASHER

5/25/04, 8/6/13


GPS, REFB20

9/6/13, SDC

SET MAG/WASHER

GPS, NEWREFB20

9/16/15, JFO

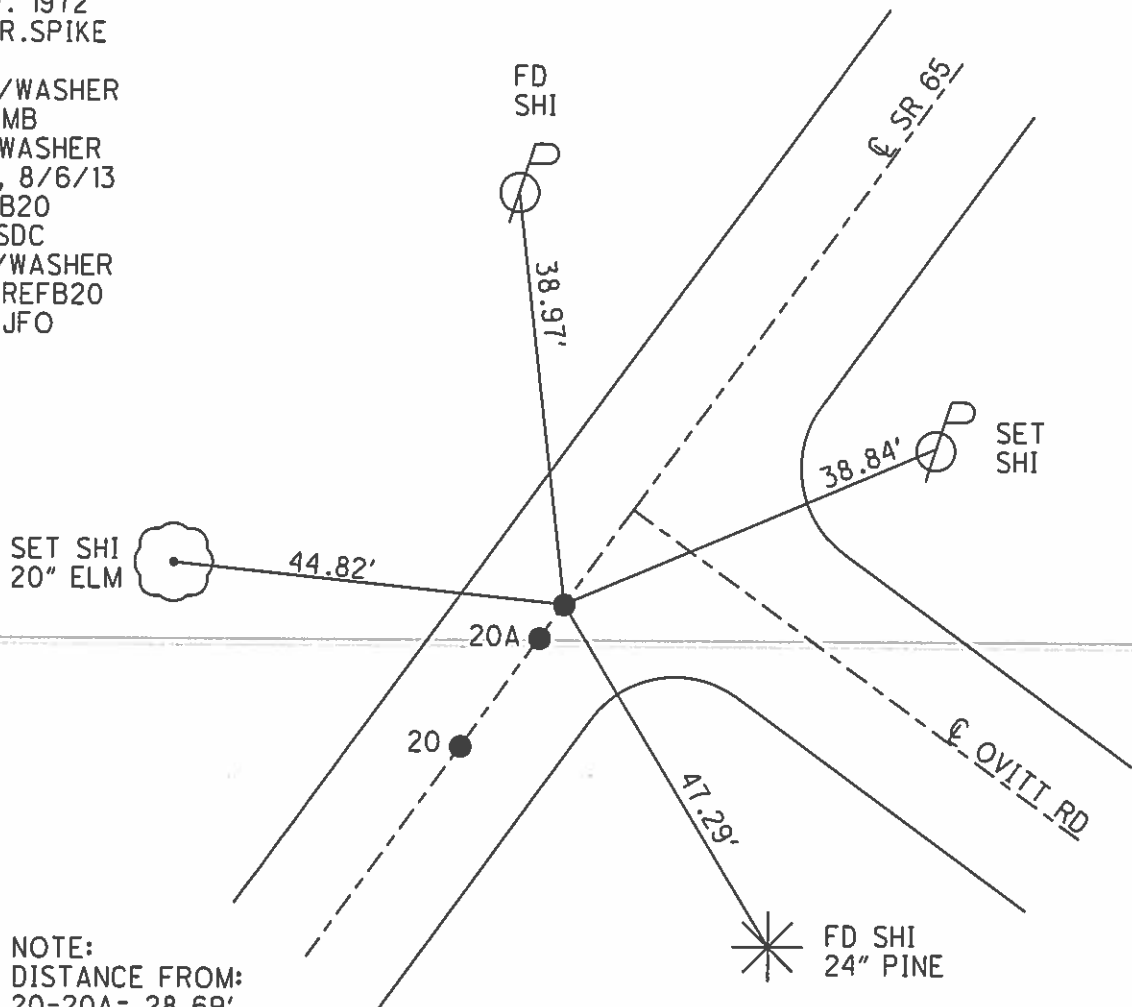

NOTE:
DISTANCE FROM:
20-20A= 28.69'
20A-20B= 1.37'

O.D.O.T. DISTRICT 2 SURVEY OFFICE (USE ONLY)

PERSONNEL

REFERENCE NO 20 C

SHEET 61 OF 63

NOTES BARNHISEL
H.C. VAN DUSEN
R.C. KUSZ
BURNETT

DATE 7/13/92
WEATHER CLOUDY
TEMP. 72°


ROUTE SR 65
COUNTY WOOD
TOWNSHIP MIDDLETON
SECTION RT 47
T 1 R 10 E

TYPE MONUMENT P.K./WASHER
ON SURFACE - ~~BELOW~~ ON
LEFT - PAV'T - ~~RIGHT~~ 1.0'
8.8' TO LT EDGE PAVEMENT
S.L.M. 595+42.12

Grid: Northing: 666729.960 Easting: 1636132.215

	47
	46
34	

RECORD: P.C.
STA. 497+36.70
SET P.K.NAIL 1972
FD P.K./WASHER
7/13/92
SET P.K./WASHER
9/4/92, MB
FD P.K./WASHER
5/25/04
FD MONBOX
GPS, REFFC20
9/10/13, SDC

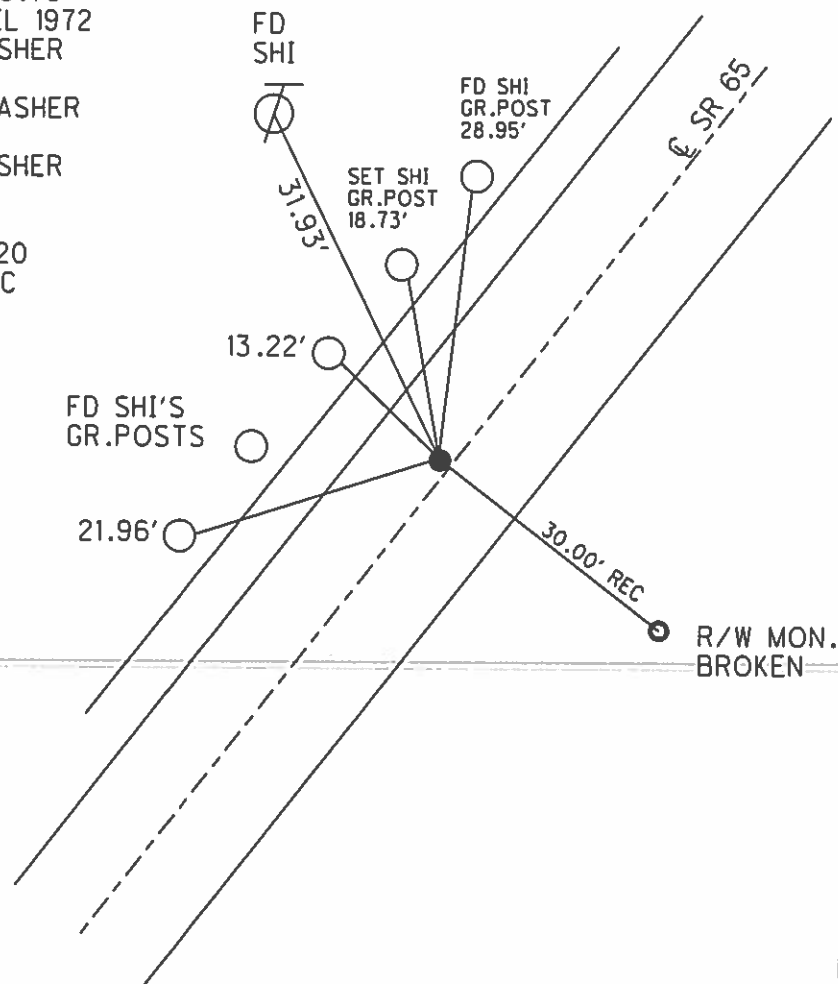

RECORD: P.I.
CURVE DATA 2011
STA. 596+61.23
 $\Delta = 08^\circ 25' 15'' \text{RT}$
D = 1° 45' 00"
R = 3274.04
T = 241.03
L = 481.19

O.D.O.T. DISTRICT 2 SURVEY OFFICE (USE ONLY)

PERSONNEL

REFERENCE NO 20 D

SHEET 62 OF 63

NOTES BARNHISEL

DATE 7/13/92

ROUTE SR 65

H.C. VAN DUSEN

WEATHER CLOUDY

COUNTY WOOD

R.C. KUSZ

TEMP. 72°

TOWNSHIP MIDDLETON

BURNETT

SECTION RT 47

T 1 R 10 E

TYPE MONUMENT P.K./WASHER

ON SURFACE - BELOW ON

LEFT - PAV'T - RIGHT 1.7'


8.3' TOLT EDGE PAVEMENT

S.L.M. 600+23.58

Grid: Northing: 667102.431 Easting: 1636436.309

47
46
34

RECORD: P.T.
STA. 499+42.95
SET P.K.NAIL 1972
FD P.K./WASHER
7/13/92
SET P.K./WASHER
9/4/92, MB
FD P.K./WASHER
5/25/04
FD MONBOX
GPS, REFFD20
9/10/13, SDC

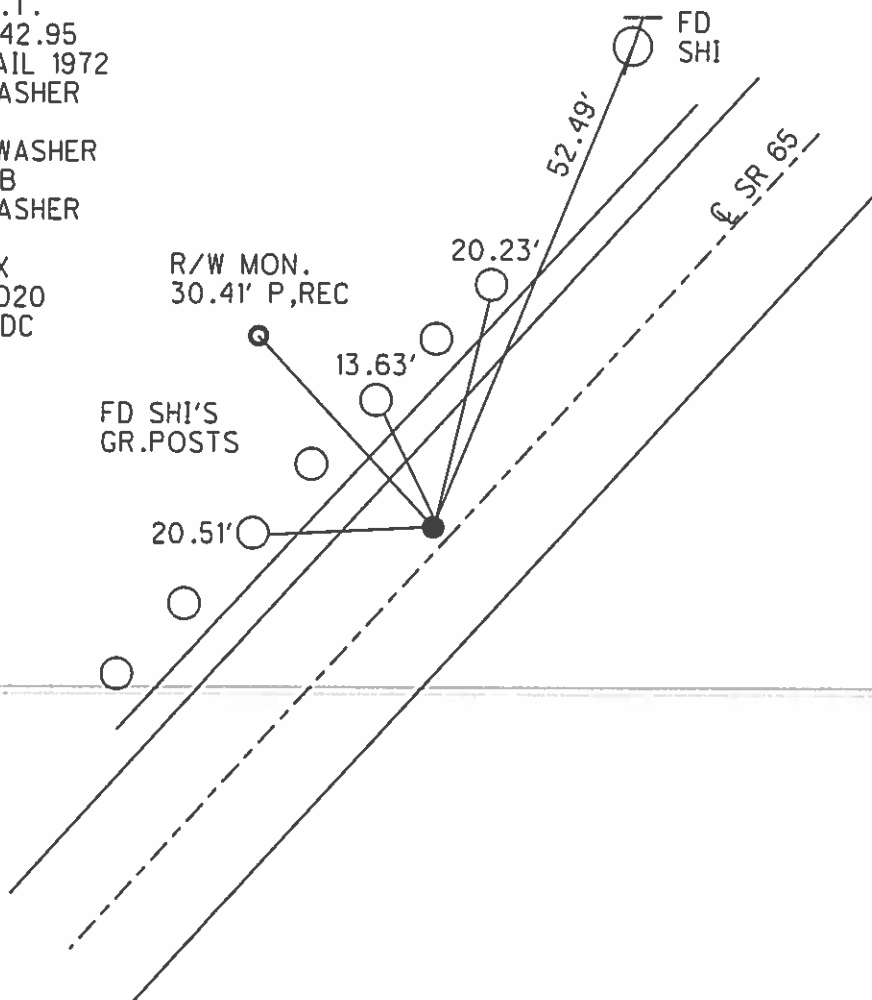

O.D.O.T. DISTRICT 2 SURVEY OFFICE (USE ONLY)

PERSONNEL

REFERENCE NO. 20 E

SHEET 63 OF 63


NOTES BARNHISEL
H.C. VAN DUSEN
R.C. KUSZ
BURNETT

DATE 7/13/92
WEATHER CLOUDY
TEMP. 72°

ROUTE SR 65
COUNTY WOOD
TOWNSHIP MIDDLETON
SECTION RT 47
T 1 R 10 E


TYPE MONUMENT P.K./WASHER
ON SURFACE - ~~BELOW~~ ON
LEFT - PAV'T - RIGHT -
11.6' TO LT EDGE PAVEMENT
S.L.M. 602+55.33

Grid: Northing: 667270.590 Easting: 1636593.075

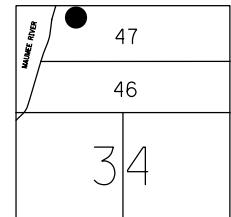

RECORD: P.C.
STA. 503+35.47
SET P.K.NAIL 1972
FD P.K./WASHER
7/13/92
SET P.K./WASHER
9/4/92, MB
FD P.K./WASHER
5/25/04
FD MONBOX
GPS, REFF21
9/10/13, SDC

NOTE:
TIES RECORDED AS RECORD
WERE PULLED ON 7/13/92.
UPDATED TIES WERE PULLED
ON 9/10/13.

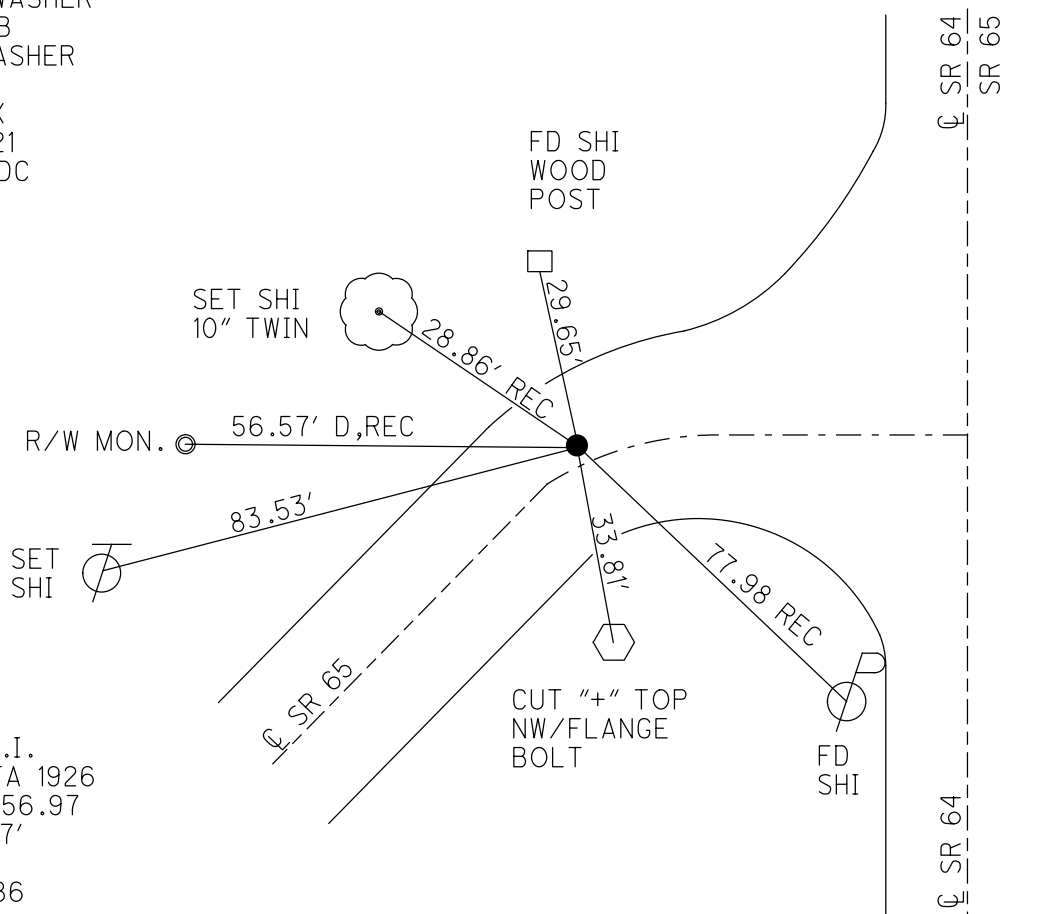

RECORD: P.I.
CURVE DATA 1926
STA. 504+56.97
 $\Delta = 23^\circ 57'$
D = $10^\circ 0'$
R = 573.686
T = 121.50
L = 239.50

O.D.O.T. DISTRICT 2 SURVEY OFFICE (USE ONLY)

PERSONNEL

REFERENCE NO. 20 EF

SHEET 1 OF 7

NOTES LUMBREZER-DGL

DATE 8/13/14

ROUTE SR 65

H.C. _____

WEATHER _____

COUNTY WOOD

R.C. _____

TEMP. _____

TOWNSHIP MIDDLETON

SECTION RT 47, 48

DWG BY RHOADES

PID 87671

T 6 N R 10 E

TYPE MONUMENT P.K.NAIL

ON SURFACE - ~~BELOW~~ ON _____

OFFSET ℄ PAVEMENT ON _____ LT : RT

- TO - EDGE PAVEMENT


STATION: 603+86.17

HORZ.DATUM: NAD 83 2007


GEOID: _____

GRID: NORTHING: 667483.816

EASTING: 1636724.615

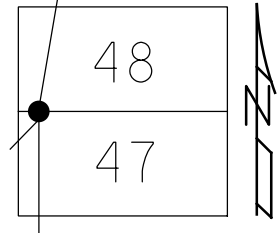

RECORD:
FD P.K.NAIL
8/13/14, RJL

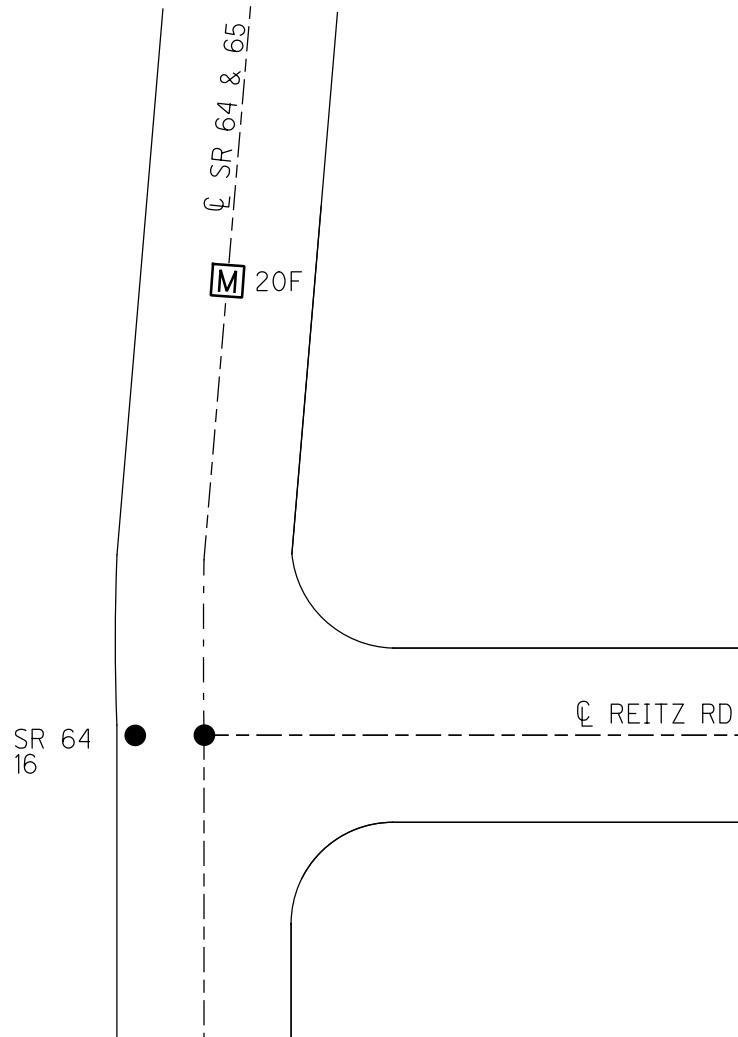

O.D.O.T. DISTRICT 2 SURVEY OFFICE (USE ONLY)

PERSONNEL

REFERENCE NO. 20 F

SHEET 2 OF 7

NOTES LUMBREZER-DGL

DATE 8/13/14

ROUTE SR 65

H.C. _____

WEATHER _____

COUNTY WOOD

R.C. _____

TEMP. _____

TOWNSHIP MIDDLETON

SECTION RT 47, 48

DWG BY RHOADES

PID 87671

T 6 N R 10 E

TYPE MONUMENT MONBOX

ON SURFACE - ~~BELOW~~ ON

OFFSET $\varnothing$ PAVEMENT 0.77' ~~LT~~ : RT

- TO - EDGE PAVEMENT


STATION: 604+51.82

HORZ.DATUM: NAD 83 2007


GEOID: _____

GRID: NORTHING: 667545.635

EASTING: 1636749.887

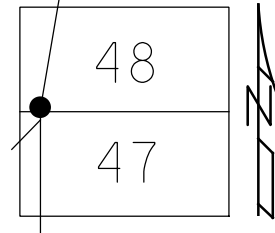

RECORD:
FD MONBOX
8/13/14, RJL

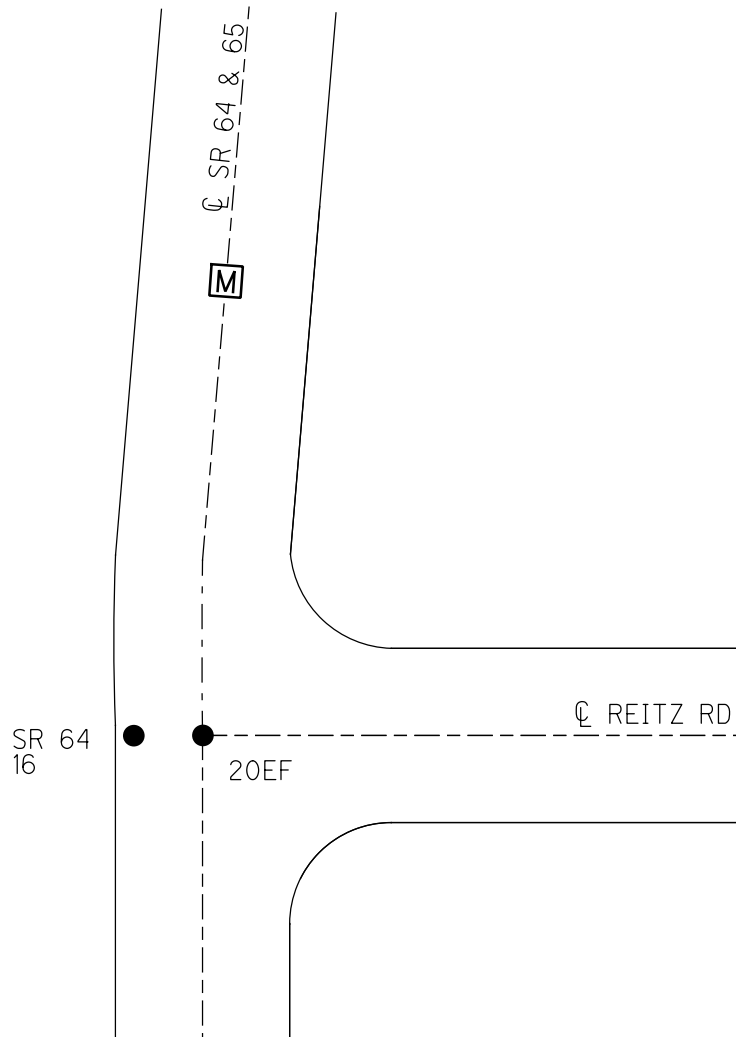

O.D.O.T. DISTRICT 2 SURVEY OFFICE (USE ONLY)

PERSONNEL

REFERENCE NO. 20 G

SHEET 3 OF 7

NOTES BURNSIDE

DATE 7/20/79

ROUTE SR 65

H.C. BOWERS

WEATHER CLEAR

COUNTY WOOD

R.C. KNAPE

TEMP. 78°

TOWNSHIP MIDDLETON

MEAD

SECTION RT 48

DWG BY RHOADES

PID 87671

T 6 N R 10 E

TYPE MONUMENT BOAT SPIKE

ON SURFACE - ~~BELOW~~ ON

OFFSET Q PAVEMENT - LT : RT

3 1/2' TO RT EDGE PAVEMENT



STATION: 608+15.80

HORZ.DATUM: NAD 83 2007

GEOID: _____

GRID: NORTHING: 667882.787

EASTING: 1636882.391

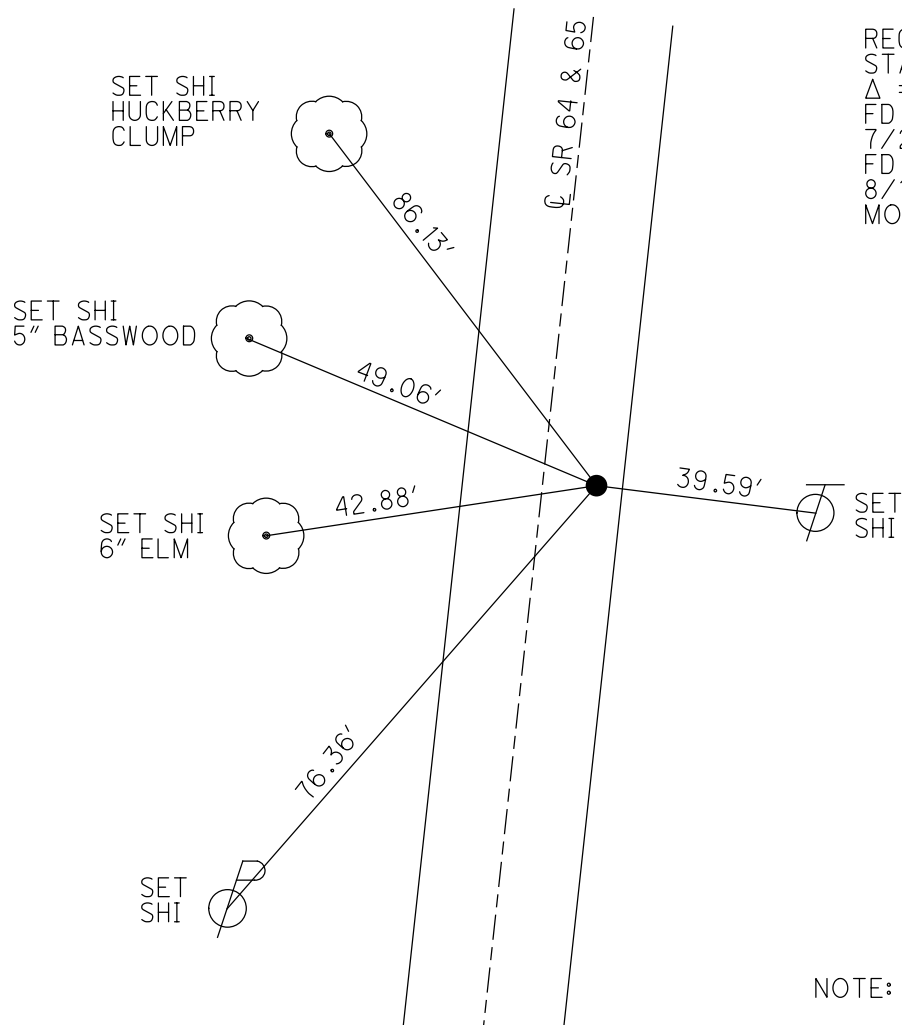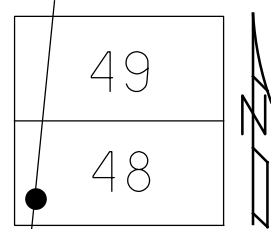

RECORD: P.I.
STA. 608+15.85
 $\Delta = 13^\circ 33' \text{ LT}$
FD BOAT SPIKE
7/20/79, BURNSIDE
FD NAIL
8/13/14, RJL
MONBOX SET

NOTE: SR 64 REF 16A

O.D.O.T. DISTRICT 2 SURVEY OFFICE (USE ONLY)

PERSONNEL

REFERENCE NO. 20 H

SHEET 4 OF 7

NOTES BURNSIDE

DATE 7/20/79

ROUTE SR 65

H.C. BOWERS

WEATHER CLEAR

COUNTY WOOD

R.C. KNAPE

TEMP. 80°

TOWNSHIP MIDDLETON

MEAD

SECTION RT 48

DWG BY RHOADES PID 92088

T 6 N R 10 E

TYPE MONUMENT BOAT SPIKE

ON SURFACE - ~~BELOW~~ ON

OFFSET Q PAVEMENT 4 1/2' LT : ~~RT~~

- TO - EDGE PAVEMENT


STATION: 612+80.46

HORIZ.DATUM: NAD 83 2011


GEOID: 2018

GRID: NORTHING: 668340.737

EASTING: 1636960.726

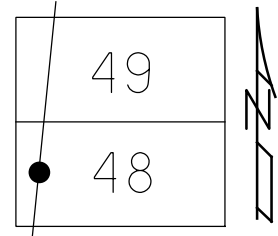

RECORD: P.I.
STA. 612+80.6
 $\Delta = 0^\circ 55' \text{ RT}$
FD BOAT SPIKE
7/20/79, BURNSIDE
FD P.K. NAIL
8/13/14, RJL
MONBOX SET
FD MONBOX
W/1" IPID
2" ALUM CAP W/MARK
CL05
1/24/18, JFO

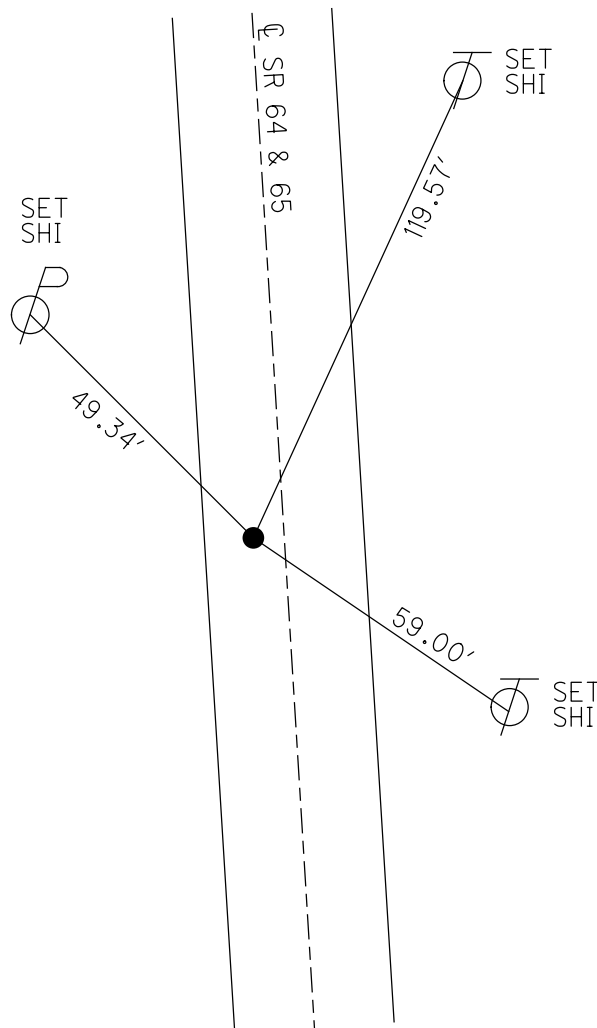

NOTE: SR 64 REF 16B

O.D.O.T. DISTRICT 2 SURVEY OFFICE (USE ONLY)

PERSONNEL

REFERENCE NO. 20 I

SHEET 5 OF 7

NOTES BURNSIDE

DATE 7/20/79

ROUTE SR 65

H.C. BOWERS

WEATHER CLEAR

COUNTY WOOD

R.C. KNAPE

TEMP. 83°

TOWNSHIP MIDDLETON

MEAD

SECTION RT 49

DWG BY RHOADES

PID 87671

T 6 N R 10 E

TYPE MONUMENT P.K.NAIL

ON SURFACE - ~~BELOW~~ ON

OFFSET Q PAVEMENT 3 1/2' LT : RT

- TO - EDGE PAVEMENT


STATION: 624+87.76

HORIZ.DATUM: NAD 83 2007


GEOID:

GRID: NORTHING: 669529.423

EASTING: 1637171.875

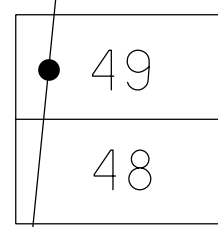

RECORD: P.I.
STA. 624+88.25
 $\Delta = 5^\circ 03' LT$
FD P.K.NAIL
7/20/79, BURNSIDE
FD P.K.NAIL
8/13/14, RJL

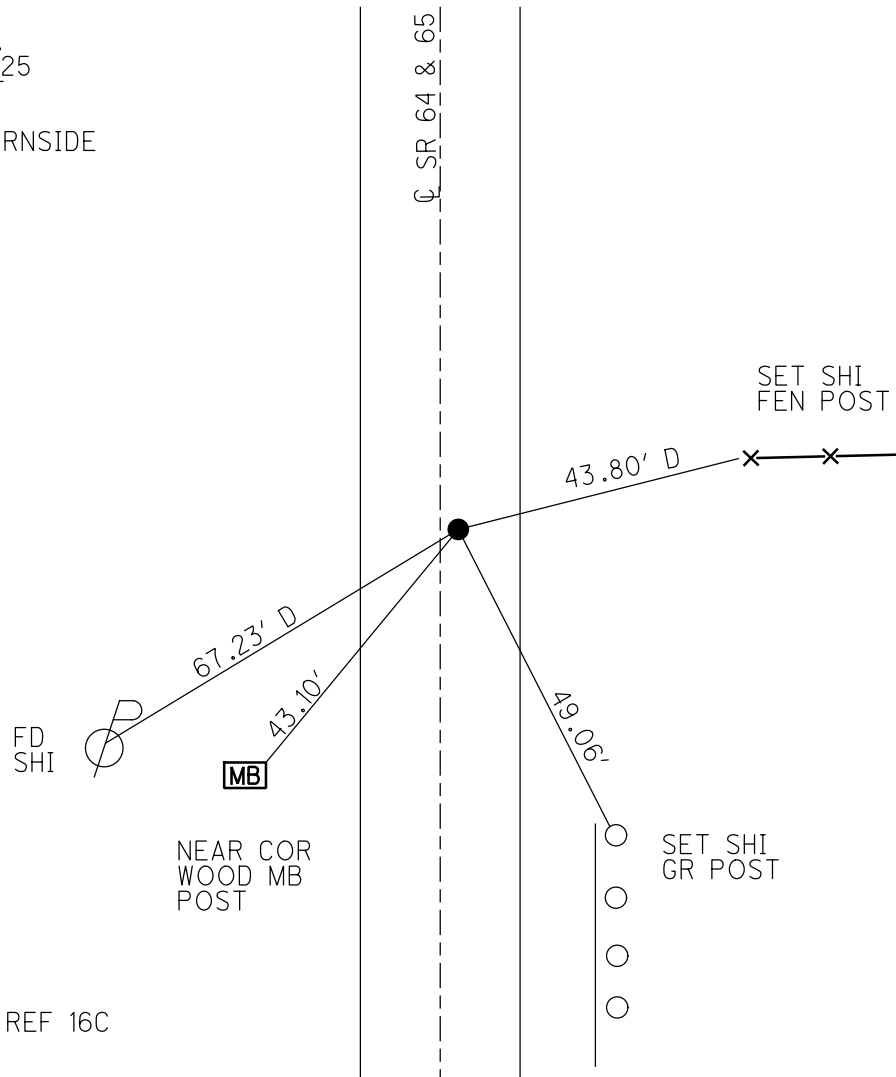

NOTE: SR 64 REF 16C

PERSONNEL

REFERENCE NO. 20 J

SHEET 6 OF 7

NOTES O'DONNELL

DATE 12/11/20

ROUTE SR 65

H.C.

WEATHER

COUNTY WOOD

R.C.

TEMP.

TOWNSHIP MIDDLETON

SECTION RT 50DWG BY RHOADES

PID 92088

T_6_N R_10_E

TYPE MONUMENT MONBOX W/1" IPID 1" ALUM CAP

ON SURFACE - ~~BELOW~~ ON

OFFSET @ PAVEMENT ON ~~LT~~ : RT

_____ TO _____ EDGE PAVEMENT


STATION: 627+00.09

HORZ.DATUM: NAD 83 2011


GEOID: 2018

GRID: NORTHING: 669529.350

EASTING: 1637171.966

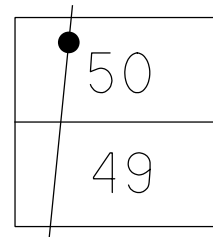

RECORD: P.I.
STA.6627+00.09
FD MONBOX
W/1" IPID
W/1" ALUM CAP
NEWSTA62700
12/11/20, JFO

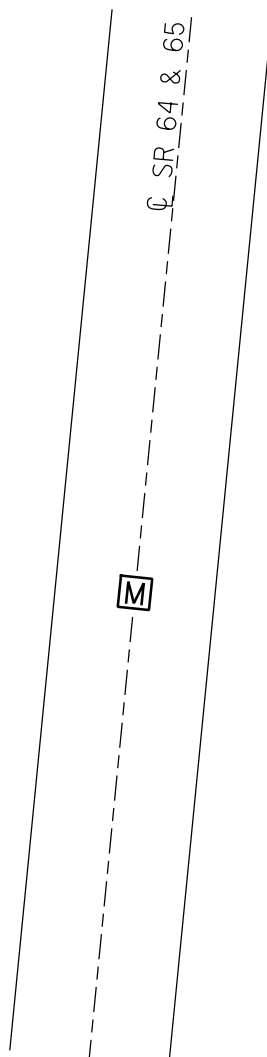

O.D.O.T. DISTRICT 2 SURVEY OFFICE (USE ONLY)

PERSONNEL

REFERENCE NO. 21 A

SHEET 7 OF 7

NOTES LEU

DATE 6/12/14

ROUTE SR 65

H.C. HOMAN

WEATHER CLOUDY

COUNTY WOOD

R.C. RHOADES

TEMP. 69°

TOWNSHIP MIDDLETON

WESTFALL

SECTION RT 50

DWG BY RHOADES PID 92088

T 6 N R 10 E

TYPE MONUMENT R.R.SPIKE

ON SURFACE - ~~BELOW~~ ON

OFFSET Q PAVEMENT ON LT : RT

11.4' TO RT EDGE PAVEMENT


STATION: 633+05

HORZ.DATUM: NAD 83 2011


GEOID: 2018

GRID: NORTHING: 670131.026

EASTING: 1637225.882

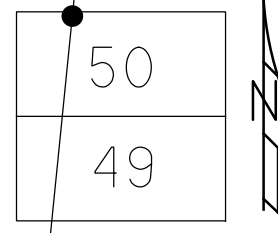

RECORD:
SET SM.R.R.SPIKE
7/13/76, BURNSIDE
FD SM.R.R.SPIKE
1984
SET P.K./WASHER
8-7-95, SAH
FD P.K./WASHER
6-12-14
7-28-15, DCH
FD CMON
NO DIMPLE
NEWSTA62723
12/11/20, JFO

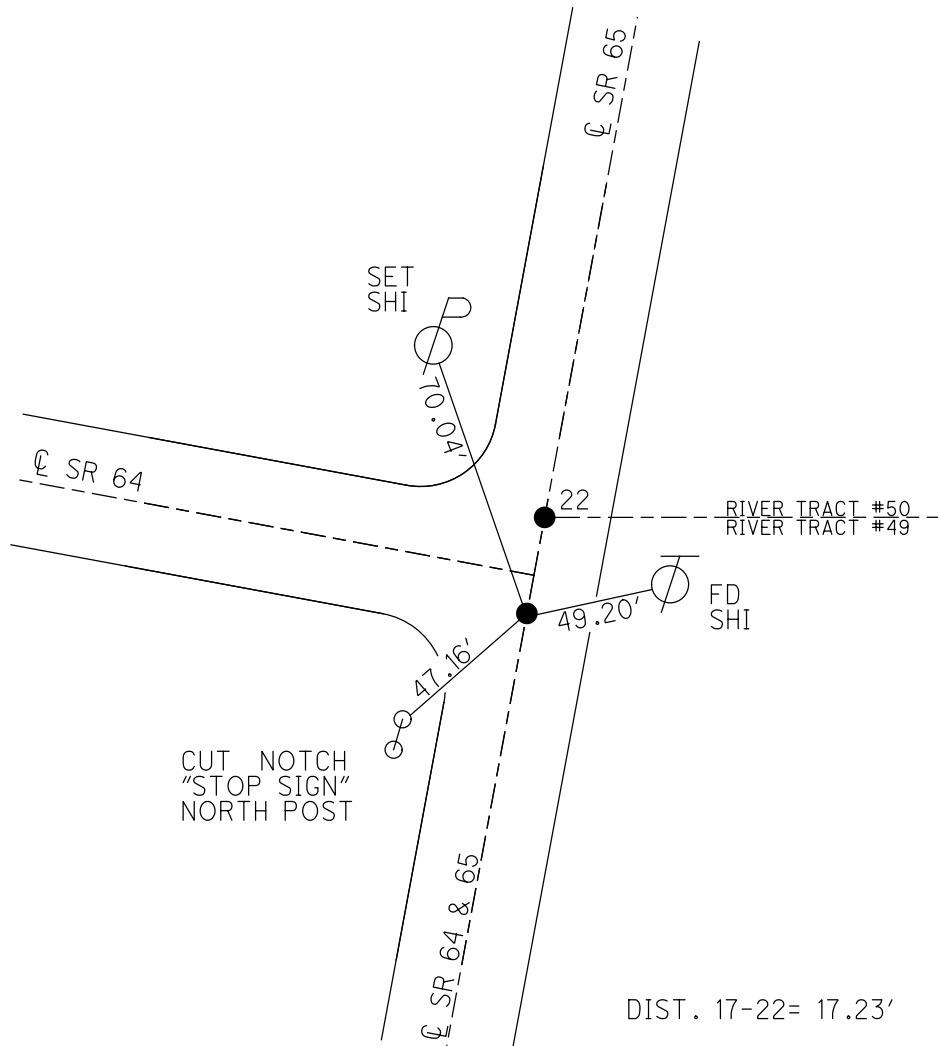

NOTE: SR 64 REF 17

DIST. 17-22= 17.23'

O.D.O.T. DISTRICT 2 SURVEY OFFICE (USE ONLY)

PERSONNEL

REFERENCE NO. 22

SHEET 2 OF 44

NOTES LEU

DATE 6/12/14

ROUTE SR 65

H.C. HOMAN

WEATHER CLOUDY

COUNTY WOOD

R.C. RHOADES

TEMP. 69°

TOWNSHIP MIDDLETON

WESTFALL

SECTION RT 49/50

DWG BY RHOADES

PID 92088

T 6 N R 10 E

TYPE MONUMENT R.R.SPIKE

~~ON SURFACE~~ - BELOW 3 1/2"

OFFSET Q PAVEMENT ON LT : RT

11.8' TO RT EDGE PAVEMENT


STATION: 633+77.34

HORZ.DATUM: NAD 83 2011


GEOID: 2018

GRID: NORTHING: 699529.350

EASTING: 1637171.966

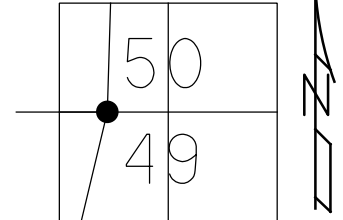

RECORD:
SET SM.R.R.SPIKE
7/13/76, BURSIDE
FD SM.R.R.SPIKE
STA. 631+76
1984
SET P.K./WASHER
8-7-95, SAH
FD P.K./WASHER
FD SM.R.R.SPIKE
3 1/2" DOWN
6-12-14
7-28-15, DCH
FD MAG SPIKE
CLO7
1/24/18, JFO
FD MONBOX
W/1" IPIN
NEWSTA63360
12/11/20, JFO

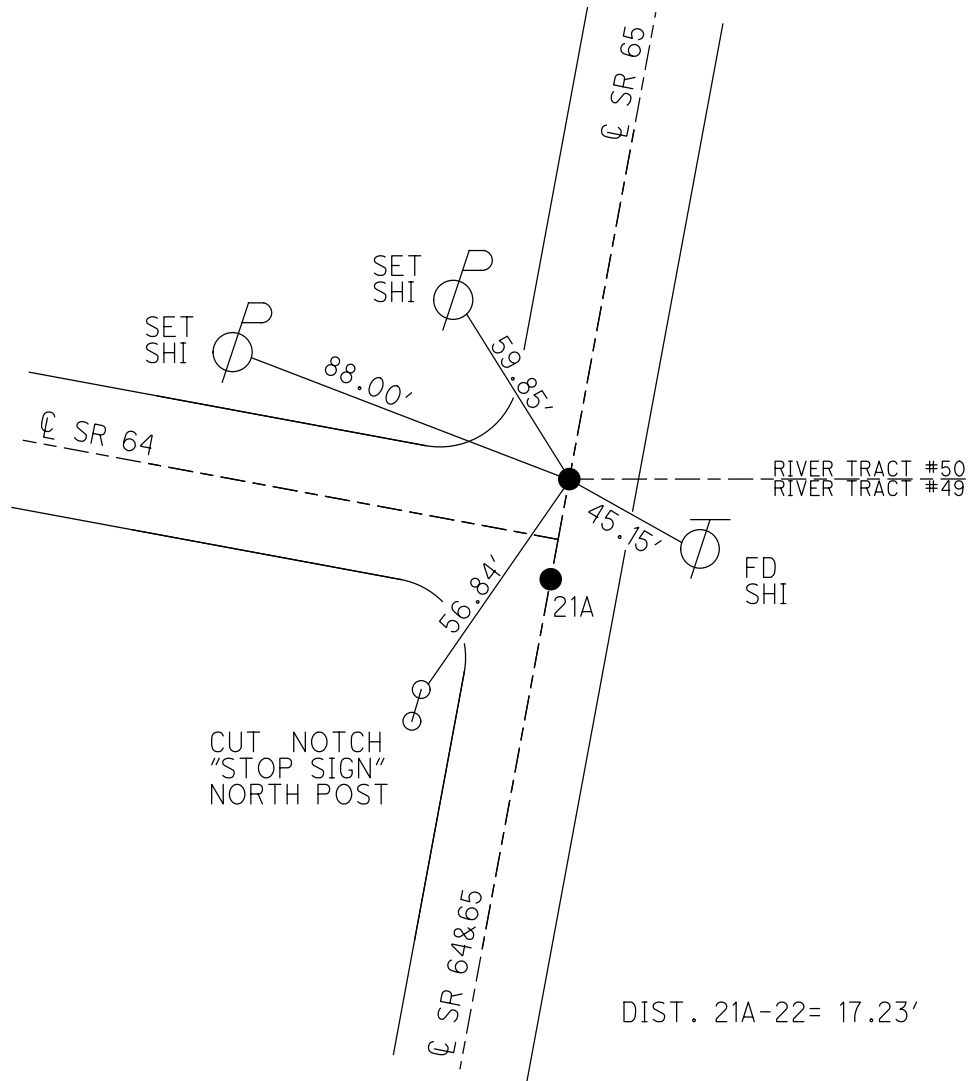

DIST. 21A-22= 17.23'

O.D.O.T. DISTRICT 2 SURVEY OFFICE (USE ONLY)

PERSONNEL

REFERENCE NO. 22 A

SHEET 3 OF 44

NOTES LEU

DATE 6/12/14

ROUTE SR 65

H.C. HOMAN

WEATHER CLOUDY

COUNTY WOOD

R.C. RHOADES

TEMP. 69°

TOWNSHIP MIDDLETON

WESTFALL

SECTION RT 50

DWG BY RHOADES

PID 92088

T 6 N R 10 E

TYPE MONUMENT P.K./WASHER

ON SURFACE - ~~BELOW~~ ON

OFFSET Q PAVEMENT 0.3' LT : ~~RT~~

9.5' TO LT EDGE PAVEMENT


STATION: 640+30.03

HORIZ.DATUM: NAD83 2011


GEOID: 2018

GRID: NORTHING: 670854.203

EASTING: 1637277.689

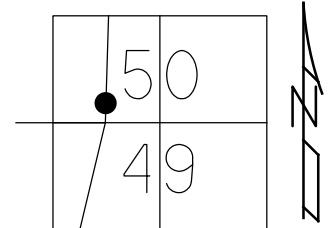

RECORD: P.I.
 $\Delta=0^{\circ}41'$ LT
SET SM.R.R.SPIKE
7/13/76, BURNSIDE
FD SM.R.R.SPIKE
1984
SET P.K./WASHER
8-7-95, SAH
FD P.K./WASHER
STA.640+29.67
6-12-14
FD R.R.SPIKE
4" DOWN
HOLE IN PAVEMENT
7-28-15, DCH
FD MAG NAIL
4" DOWN
CLO8
1/24/18, JFO
FD MONBOX
W/1" IPIN
NEWSTA64030
12/11/20, JFO

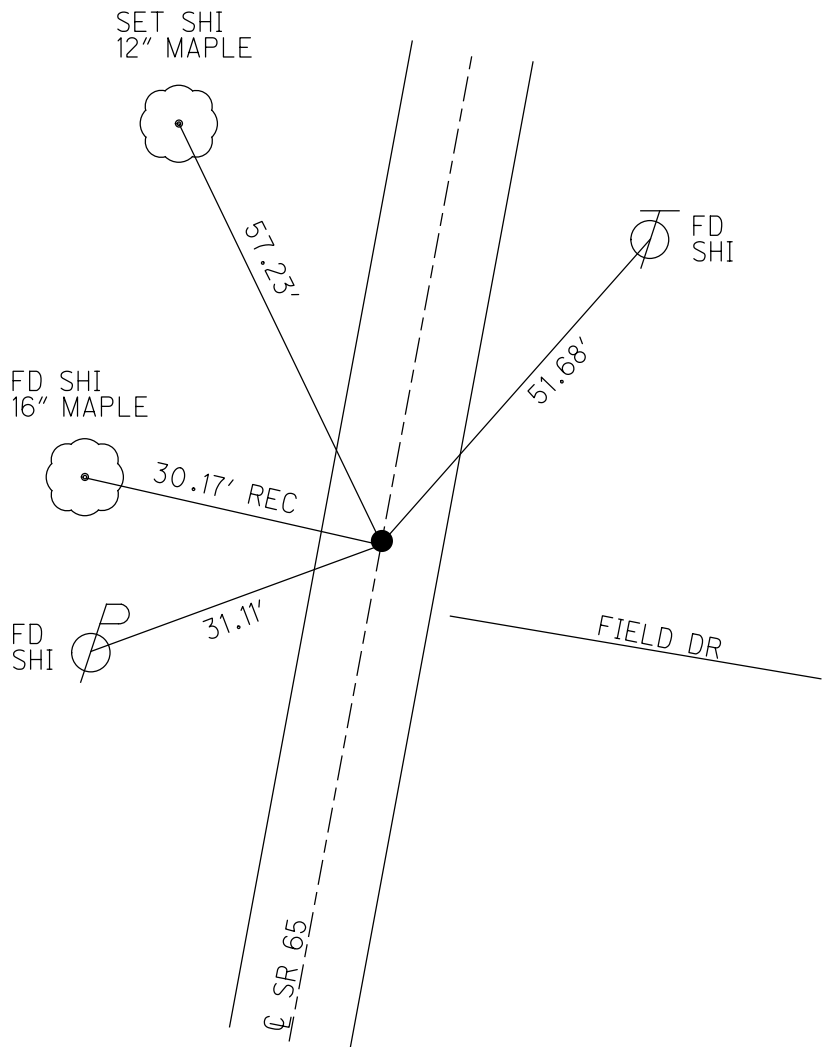

O.D.O.T. DISTRICT 2 SURVEY OFFICE (USE ONLY)

PERSONNEL

REFERENCE NO. 22 B SHEET 4 OF 44

NOTES LEU

DATE 06-12-14

ROUTE SR 65

H.C. HOMAN

WEATHER CLOUDY

COUNTY WOOD

R.C. RHOADES

TEMP. 69°F

TOWNSHIP MIDDLETON

WESTFALL

SECTION RT 50

T_6_N R_10_E

TYPE MONUMENT P.K.NAIL


~~ON SURFACE~~ - BELOW 2"

LEFT - C PAV'T - ~~RIGHT~~ 0.3'

9.7 TO LT EDGE PAVEMENT

S.L.M. 653+56.01

Grid: Northing: 672178.163 Easting: 1637354.599

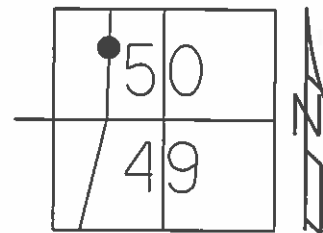


FD PK @SURFACE, 1984

NOTE: DIST. 22B-22C=12.99'

SET PK/WASHER
8-7-95, SAH

FD P.K.NAIL
06-12-14, DCH

SET MAG/WASHER
7-28-15, DCH

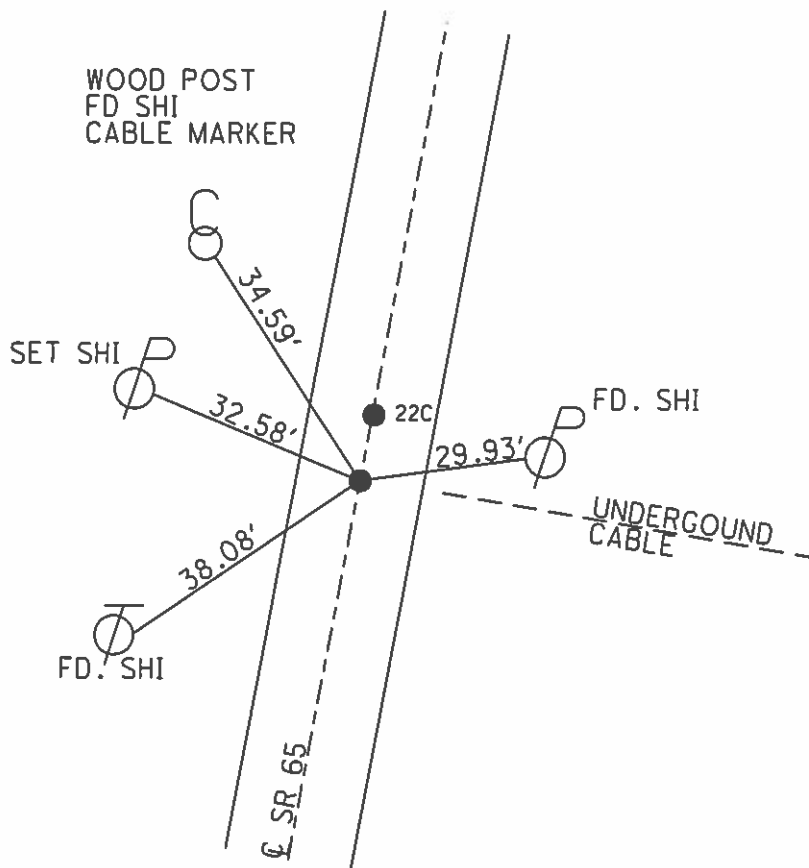

O.D.O.T. DISTRICT 2 SURVEY OFFICE (USE ONLY)

PERSONNEL

REFERENCE NO. 22 C SHEET 5 OF 44

NOTES LEU

DATE 06-12-14

ROUTE SR 65

H.C. HOMAN

WEATHER CLOUDY

COUNTY WOOD

R.C. RHOADES

TEMP. 69°F

TOWNSHIP MIDDLETON

WESTFALL

SECTION RT 50

T_6_N R_10_E

TYPE MONUMENT PK NAIL


ON SURFACE - ~~BELOW~~ ON

~~LEFT~~ - C PAV'T - RIGHT 0.4'

9.6' TO RT EDGE PAVEMENT

S.L.M. 653+69

Grid: Northing: 672191.069 Easting: 1637356.057

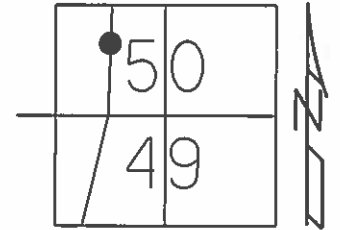


FD BENT HARROW TOOTH
1984

NOTE: DIST. 22B-22C=12.99'

SET PK/WASHER
8-7-95, SAH

FD P.K.NAIL
06-12-14, DCH


SET MAG/WASHER
7-28-15, DCH

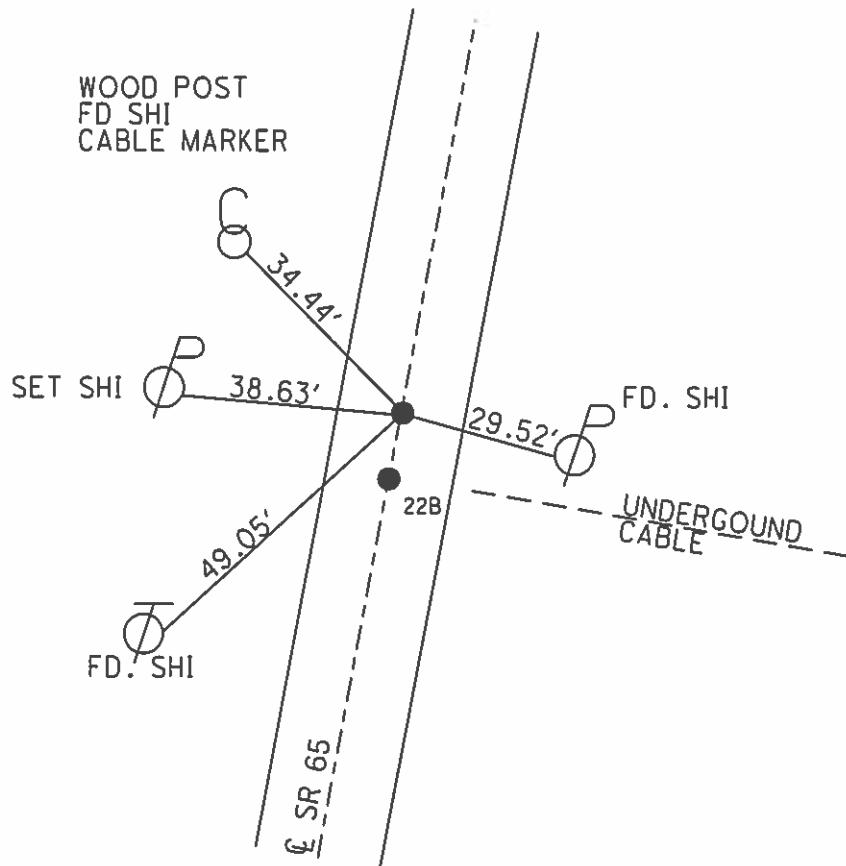

O.D.O.T. DISTRICT 2 SURVEY OFFICE (USE ONLY)

PERSONNEL _____ REFERENCE NO. 22 D SHEET 6 OF 44
 NOTES LEU DATE 6-12-14 ROUTE SR 65
 H.C. HOMAN WEATHER CLOUDY COUNTY WOOD
 R.C. WESTFALL TEMP. 70°F TOWNSHIP MIDDLETON
 SECTION RT 51
 T 6 N R 10 E

TYPE MONUMENT MAG WASHER
 ON SURFACE - ~~BELOW~~ ON
 LEFT - Q PAV'T - ~~RIGHT~~ 1.0'
10.0' TO LT EDGE PAVEMENT
 S.L.M. 655+02.86

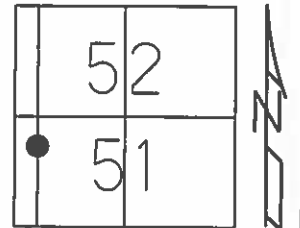


Grid: Northing: 672324.718 Easting: 1637363.620

FD PK @ SURFACE
5/24/95

NOTE: DIST. 22D-22E = 116.07'

SET PK/WASHER
8-7-95, SAH


FD P.K./WASHER
6-12-14
SET MAG/WASHER
7-28-15, DCH

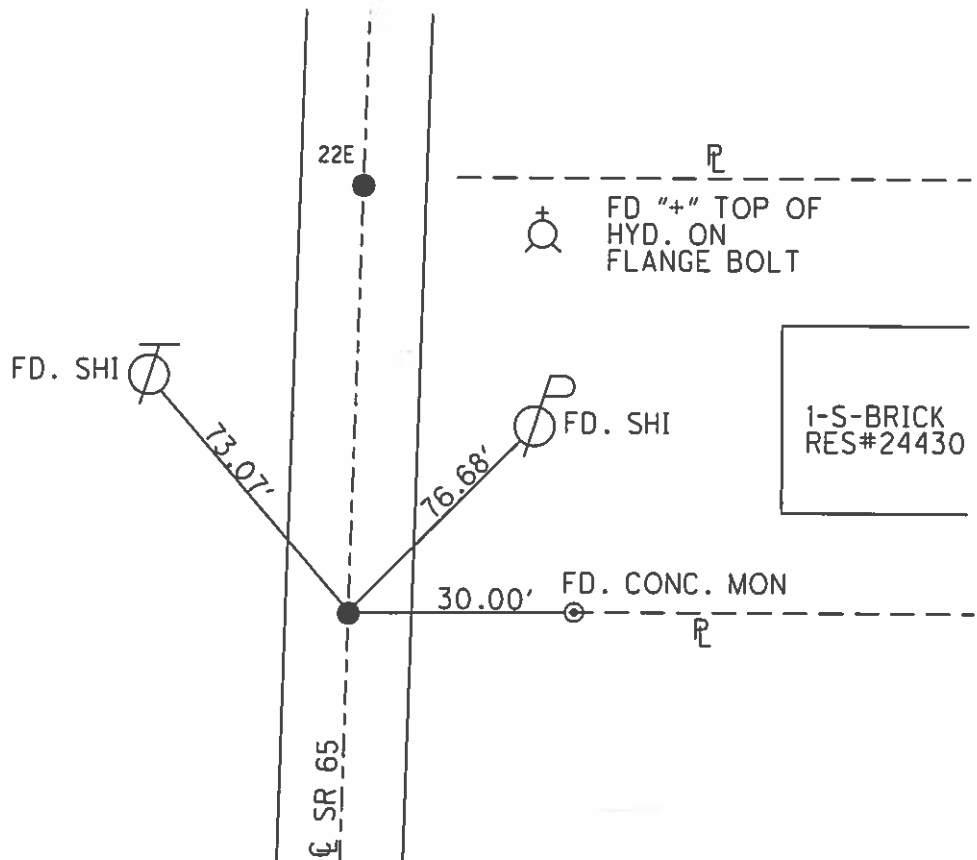

O.D.O.T. DISTRICT 2 SURVEY OFFICE (USE ONLY)

PERSONNEL _____ REFERENCE NO. 22 E SHEET 7 OF 44
 NOTES LEU DATE 6-12-14 ROUTE SR 65
 H.C. HOMAN WEATHER CLOUDY COUNTY WOOD
 R.C. WESTFALL TEMP. 70°F TOWNSHIP MIDDLETON
 SECTION RT 51
 T 6 N R 10 E

TYPE MONUMENT P.K.NAIL
 ON SURFACE - ~~BELOW~~ ON _____
 LEFT - ℄ PAV'T - ~~RIGHT~~ 1.0'
9.9' TO LT EDGE PAVEMENT
 S.L.M. 656+18.93

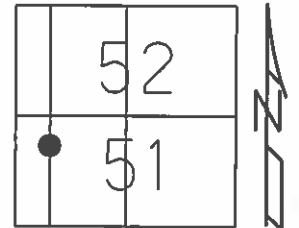


Grid: Northing: 672440.589 Easting: 1637370.357

FD PK @ SURFACE
 5/24/95

NOTE: DIST.22D-22E= 116.07'

SET PK/WASHER
 8-7-95, SAH

FD P.K./WASHER
 6-12-14
 SET MAG/WASHER
 7-28-15, DCH

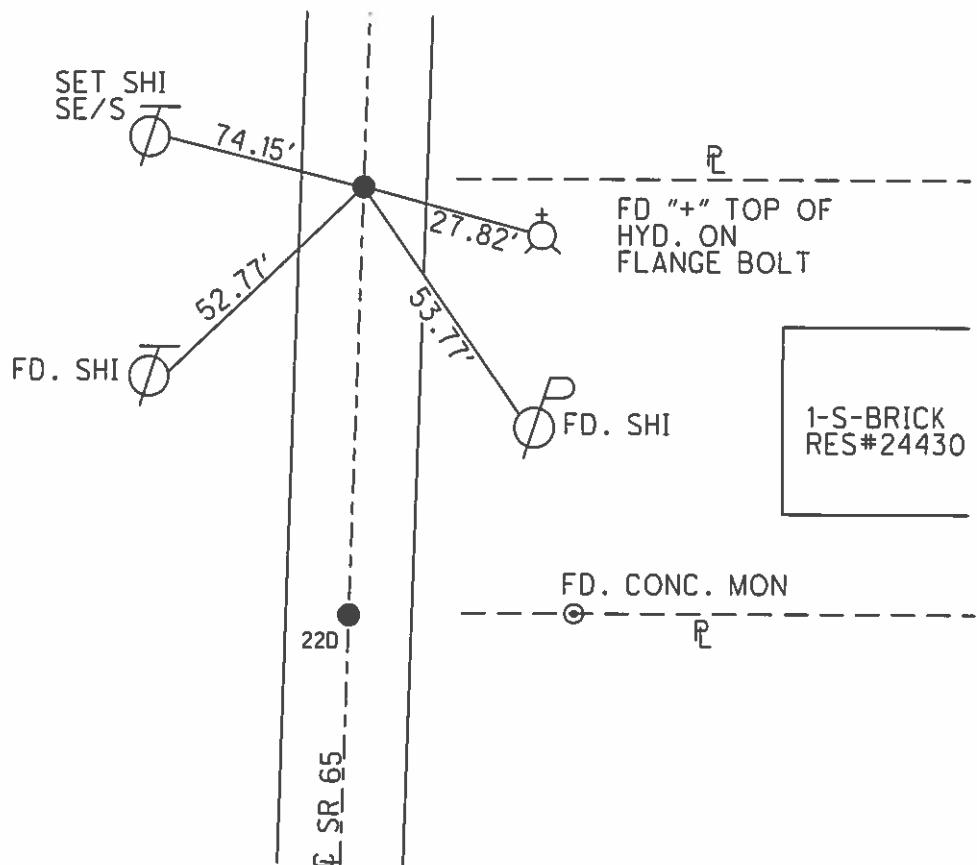

O.D.O.T. DISTRICT 2 SURVEY OFFICE (USE ONLY)

PERSONNEL _____ REFERENCE NO. 23 A SHEET 8 OF 44

NOTES LEU DATE 6-12-14 ROUTE SR 65

H.C. HOMAN WEATHER CLOUDY COUNTY WOOD

R.C. WESTFALL TEMP. 70°F TOWNSHIP MIDDLETON

SECTION RT 51&52

T 6 N R 10 E

TYPE MONUMENT P.K.NAIL


~~ON SURFACE~~ - BELOW 3.5"

LEFT - ℄ PAV'T - RIGHT ON

9.8' TO LT EDGE PAVEMENT

S.L.M. 660+17.88

Grid: Northing: 672838.878 Easting: 1637393.369

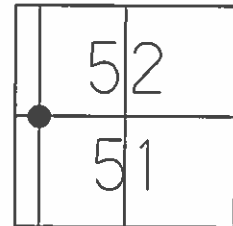


RECORD:
FD. LARGE RR. SPK
3" BELOW, 5/24/95

NOTE: DIST. 23A-23B= 4.55'

SET PK/WASHER
8-7-95, SAH

FD P.K.SHANK
9-17-12
GPS, REFA23
9-18-12, SAH

FD P.K.NAIL
05-12-2014
SET MAG/WASHER
07-28-15, DCH

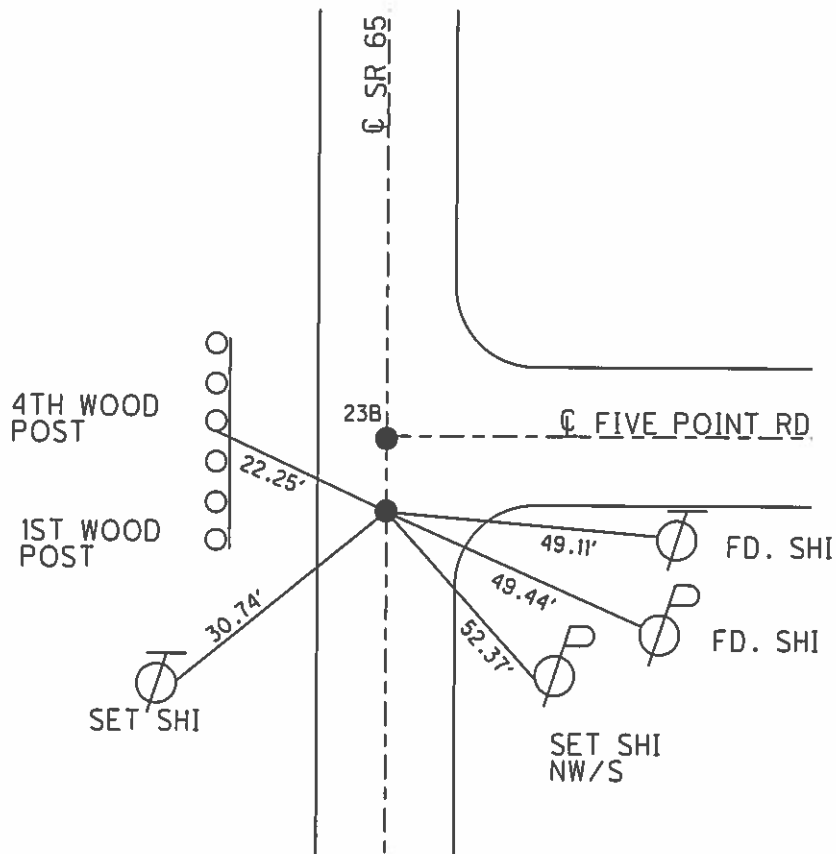

O.D.O.T. DISTRICT 2 SURVEY OFFICE (USE ONLY)

PERSONNEL _____ REFERENCE NO. 23 B SHEET 9 OF 44

NOTES LEU DATE 6-12-14 ROUTE SR 65

H.C. HOMAN WEATHER CLOUDY COUNTY WOOD

R.C. WESTFALL TEMP. 70°F TOWNSHIP MIDDLETON

SECTION RT 51&52

T 6 N R 10 E

TYPE MONUMENT SM RR. SPK


~~ON SURFACE~~ - BELOW 5"

LEFT - CL PAV'T - RIGHT ON

10.5' TO LT EDGE PAVEMENT

S.L.M. 660+22.43

Grid: Northing: 672843.2326 Easting: 1637394.2775

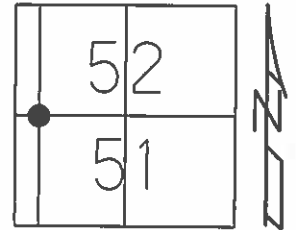


RECORD:
FD. LARGE RR. SPK
@ SURF., 5/24/95

NOTE: DIST. 23A-23B= 4.55'

SET PK/WASHER
8-7-95, SAH

FD P.K.SHANK
9-17-12
GPS, REFA23
9-18-12, SAH

FD SM.R.R.SPIKE
05-12-2014
SET MAG/WASHER
07-28-15, DCH

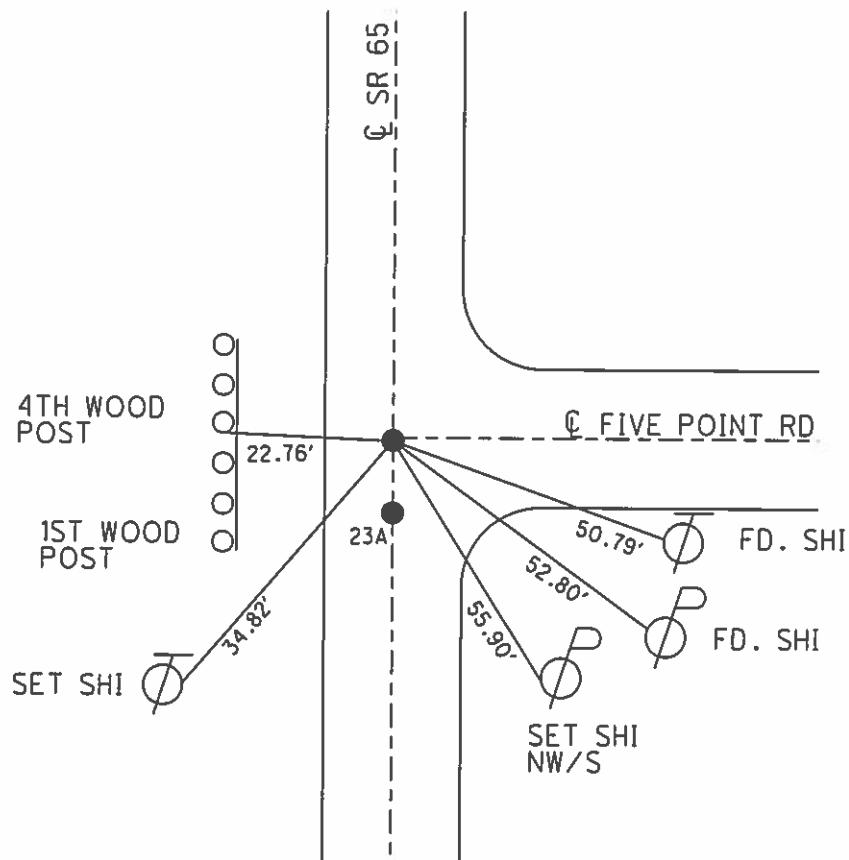

O.D.O.T. DISTRICT 2 SURVEY OFFICE (USE ONLY)

PERSONNEL

REFERENCE NO. 23 BB

SHEET 10 OF 44

NOTES HOMAN

DATE 5/12/14

ROUTE SR 65

H.C. LEU

WEATHER CLOUDY

COUNTY WOOD

R.C. HOMAN

TEMP. 70°

TOWNSHIP MIDDLETON

SECTION RT 52, 53

T 6 N R 10 E

TYPE MONUMENT P.K.NAIL


~~ON SURFACE~~ - BELOW 3"

LEFT - Q PAV'T - ~~RIGHT~~ 0.3'

9.3' TO LT EDGE PAVEMENT

S.L.M. 674+09.81

Grid: Northing: 674228.946 Easting: 1637465.338

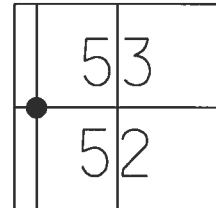

RECORD:

FD R.R.SPIKE

0.2' DOWN

RP5

10/19/12, SDC

FD P.K.NAIL


3" DOWN

CKREFC23

5/12/14, DCH

SET MAG/WASHER

7/28/15, DCH

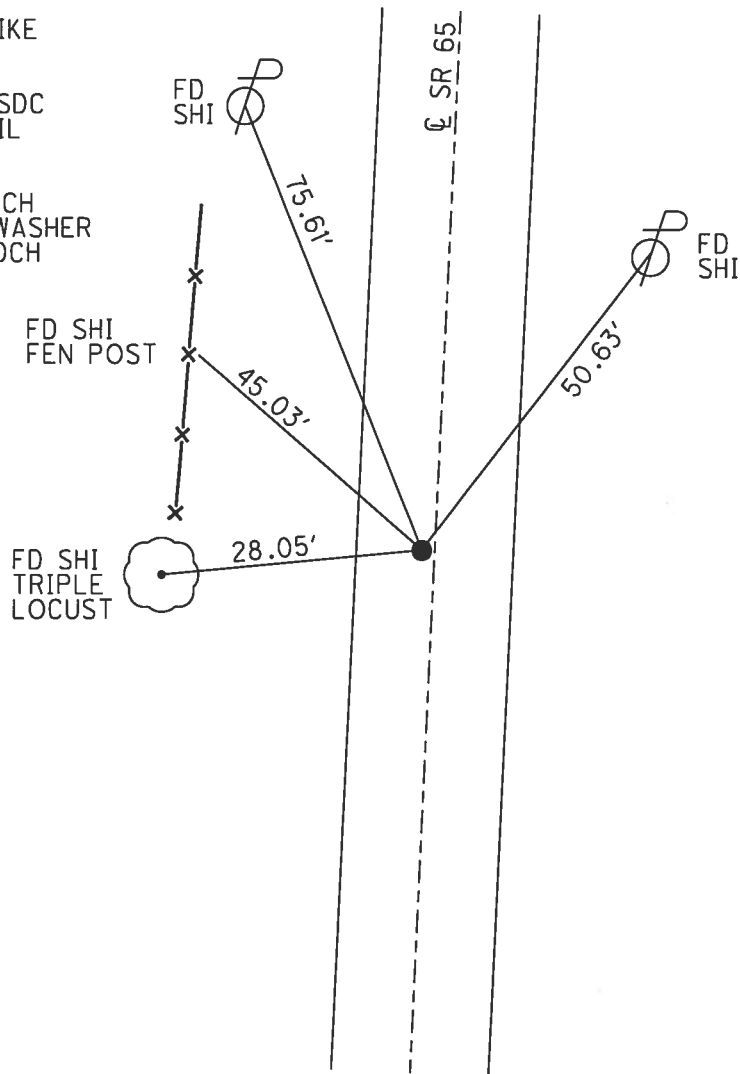

O.D.O.T. DISTRICT 2 SURVEY OFFICE (USE ONLY)

PERSONNEL _____ REFERENCE NO. 23 BC SHEET 11 OF 44

NOTES CODER _____ DATE 10/19/12 ROUTE SR 65

H.C. HUSS WEATHER RAINY COUNTY WOOD

R.C. CANTERBURY TEMP. 50° TOWNSHIP MIDDLETON

SECTION RT 53

T 6 N R 10 E

TYPE MONUMENT P.K.NAIL

~~ON SURFACE~~ - BELOW 3"

LEFT - CL PAV'T - ~~RIGHT~~ 1.3'


8.3' TO LT EDGE PAVEMENT

S.L.M. 676+51.93

Grid: Northing: 674470.743 Easting: 1637477.858

53
52

RECORD:
 FD P.K.NAIL
 3" DOWN
 RP16
 10/19/12, SDC
 D.N.F. P.K.NAIL
 5/12/14, DCH
 SET MAG/WASHER
 6/2/17, DCH

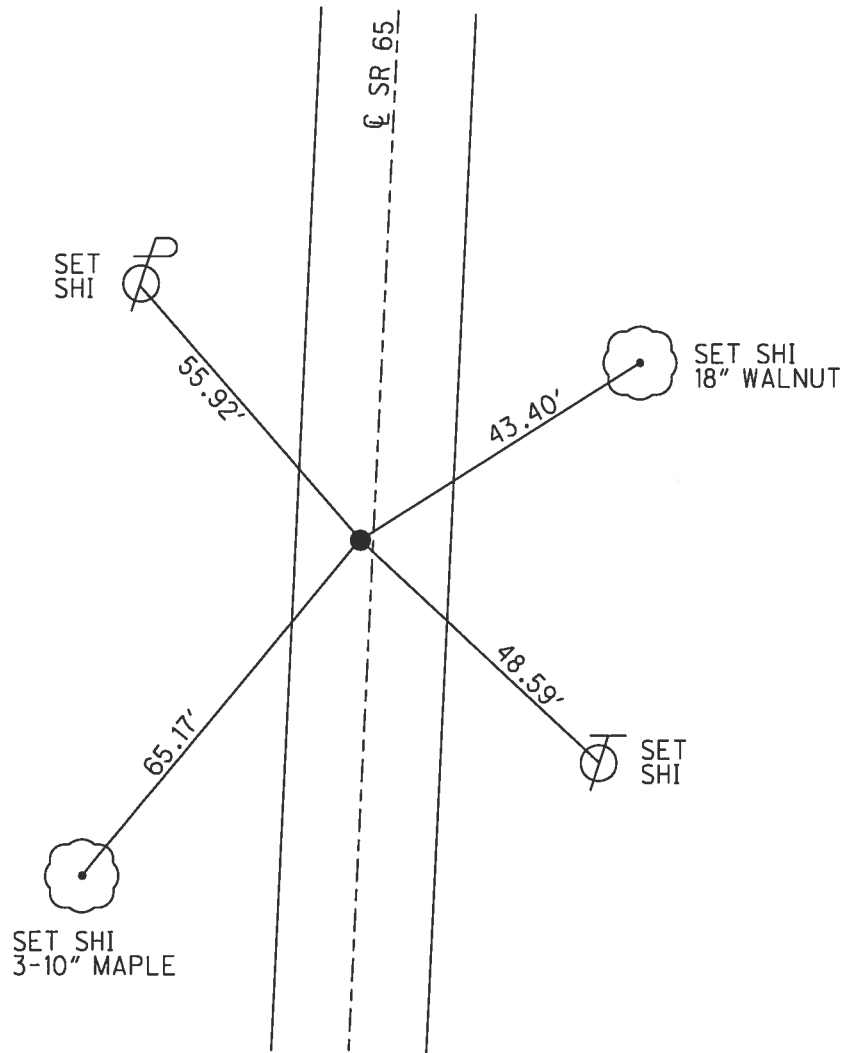

O.D.O.T. DISTRICT 2 SURVEY OFFICE (USE ONLY)

PERSONNEL

REFERENCE NO.

23 C

SHEET

12

OF 44

NOTES HOMAN

DATE 5/12/14

ROUTE SR 65

H.C. LEU

WEATHER CLOUDY

COUNTY WOOD

R.C. HOMAN

TEMP. 70°

TOWNSHIP MIDDLETON

SECTION RT 53

T 6 N R 10 E

TYPE MONUMENT MAG NAIL


ON SURFACE - ~~BELOW~~ ON

LEFT - C PAV'T - ~~RIGHT~~ 1.0'

8.9' TO LT EDGE PAVEMENT

S.L.M. 680+78.44

Grid: Northing: 674896.570 Easting: 1637501.927

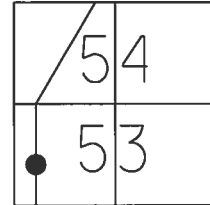

RECORD:

STA. 678+78

FD SM.R.R.SPIKE

FD P.K./WASHER

5/24/95, SAH

SET P.K./WASHER

8/7/95, SAH

FD MAG NAIL

REFC23

9/17/12, SDC


FD MAG NAIL

CKREFCC23

5/12/14, DCH

SET MAG/WASHER

3/16/16, DCH

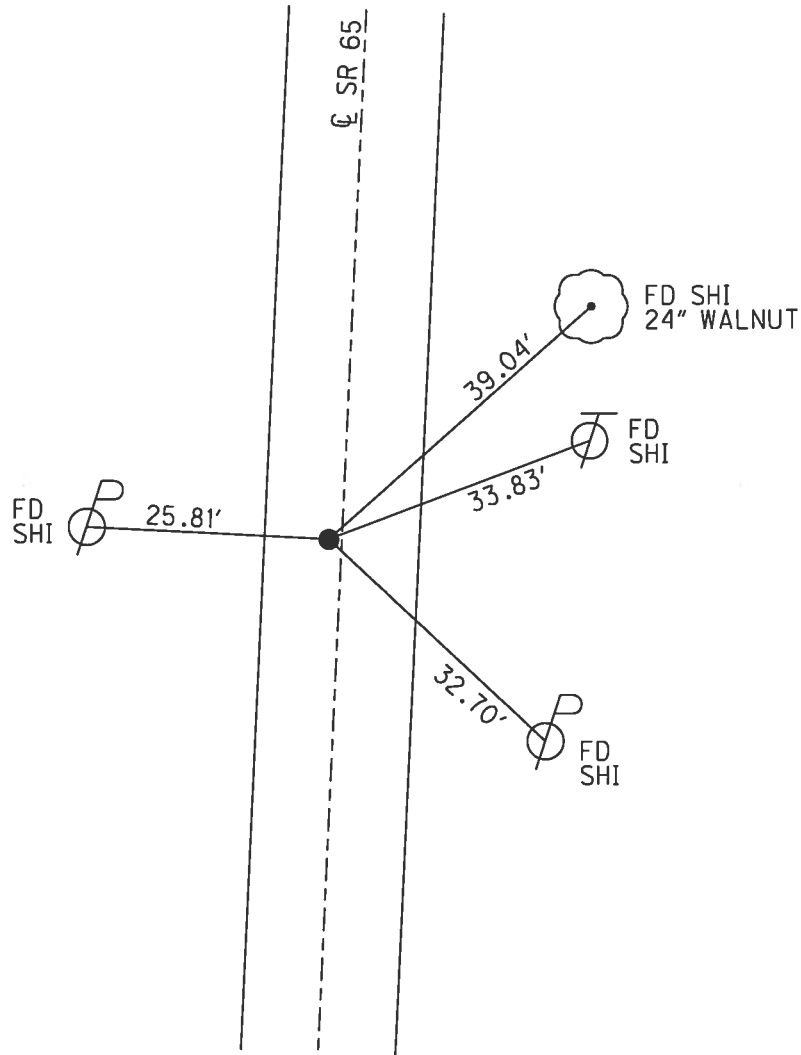

O.D.O.T. DISTRICT 2 SURVEY OFFICE (USE ONLY)

PERSONNEL

REFERENCE NO. 23 D

SHEET 13 OF 44

NOTES VAN DUSEN

DATE 5/24/95

ROUTE SR 65

H.C. MOSER

WEATHER CLOUDY

COUNTY WOOD

R.C. HUSS

TEMP. 60°

TOWNSHIP MIDDLETON

SECTION RT 53

T 6 N R 10 E

TYPE MONUMENT P.K.NAIL


ON SURFACE - ~~BELOW~~ ON

LEFT - C PAV'T - ~~RIGHT~~ 1.0'


7.4' TO LT EDGE PAVEMENT

S.L.M. 683+65.81

Grid: Northing: 675183.474 Easting: 1637518.312

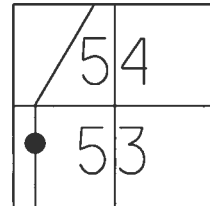

RECORD:
STA. 681+65
FD P.K.NAIL
FD P.K./WASHER
5/24/95, SAH
SET P.K./WASHER
8/7/95, SAH
FD P.K.NAIL
REFD23
9/17/12, SDC
FD P.K.NAIL
CKREFD23
5/12/14, DCH
SET MAG/WASHER
3/16/16, DCH

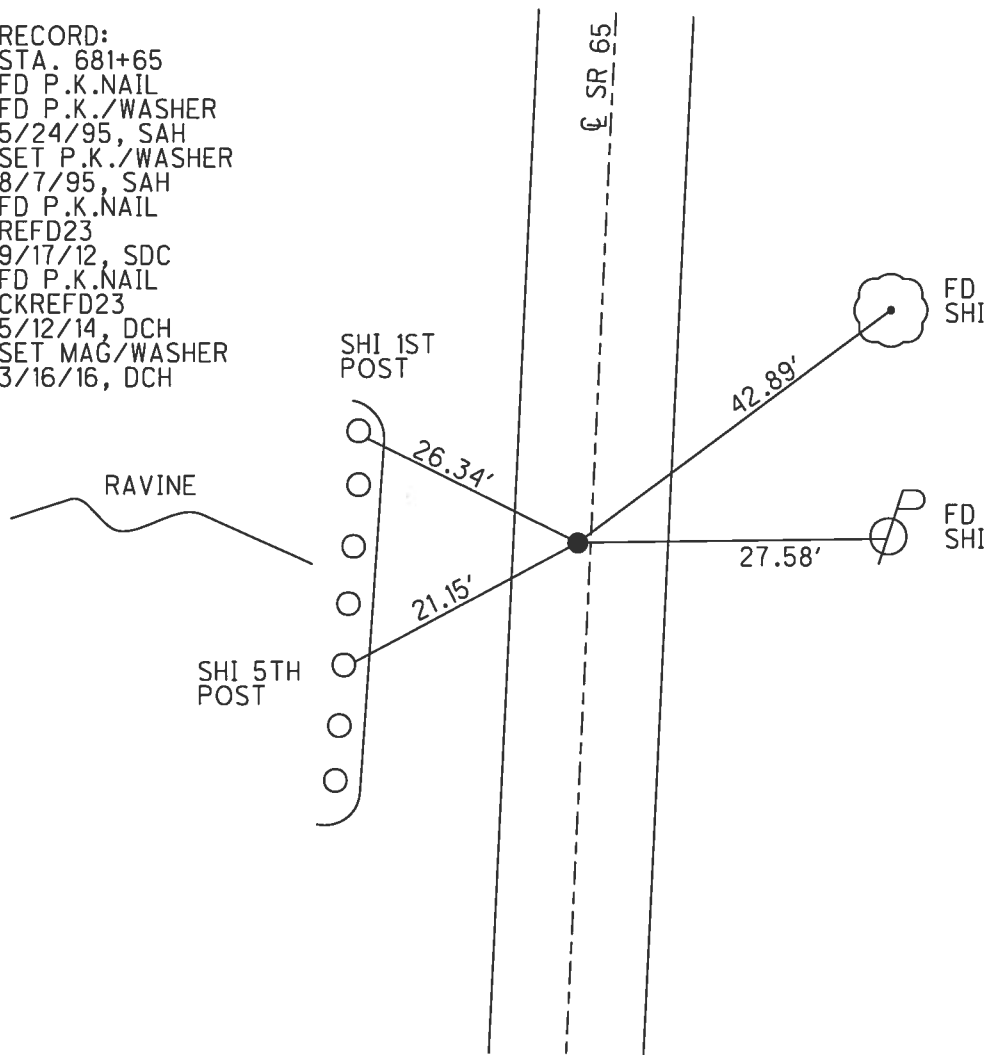

O.D.O.T. DISTRICT 2 SURVEY OFFICE (USE ONLY)

PERSONNEL

REFERENCE NO.

23 E

SHEET

14

OF 44

NOTES

NEISE

DATE

10/24/24

ROUTE

SR 65

H.C.

PRESTON-COLIVN

WEATHER

SUNNY

COUNTY

WOOD

R.C.

NEISE

TEMP.

51°

TOWNSHIP

MIDDLETON

SECTION

RT 53, 54

T 6 N

R 10 E

TYPE MONUMENT

MAG SHANK

ON SURFACE -

~~BELOW~~

ON

LEFT - ℄ PAV'T -

~~RIGHT~~

1.0'

9.3'

TO

LT

EDGE PAVEMENT

S.L.M.


685+29.33

Grid: Northing:

675346.719

Easting:

1637527.682

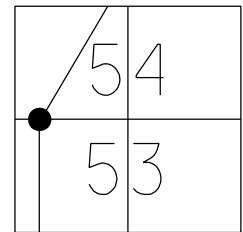

RECORD:

STA. 683+30
FD P.K.NAIL
FD P.K./WASHER
5/24/95, SAH
SET P.K./WASHER
8/7/95, SAH
FD P.K.NAIL
REFE23
9/17/12, SDC
FD P.K.NAIL
CKREFE23
5/12/14, DCH
SET MAG/WASHER
3/16/16, DCH
FD MAG SHANK
10/24/24, TDN

FD SHI
30" CATALPA

38.82'

FD SHI

27.89'

SET SHI
12" CATALPA

29.65'

16.39'-D

FD IPID

"GARCIA TRAVERSE"

33.72'

FD SHI


℄ SR 65

O.D.O.T. DISTRICT 2 SURVEY OFFICE (USE ONLY)


PERSONNEL	REFERENCE NO.	23 EF	SHEET	15	OF	44
NOTES	CODER	DATE	10/19/12	ROUTE	SR 65	
H.C.	HUSS	WEATHER	RAINY	COUNTY	WOOD	
R.C.	CANTERBURY	TEMP.	50°	TOWNSHIP	MIDDLETON	
				SECTION	RT 54	
					T 6 N R 10 E	

TYPE MONUMENT 1" IPIPE
ON SURFACE - ~~BELOW~~ ON
LEFT - CL PAV'T - ~~RIGHT~~ 23.6'
13' LT TO LT EDGE PAVEMENT
S.L.M. 687+01.19

Grid: Northing: 675518.306 Easting: 1637537.437

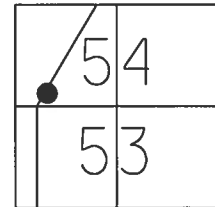

RECORD:
FD 1" IPIPE
RP2
10/19/12, SDC
FD 1" IPIPE
CKRP2
5/12/14, DCH

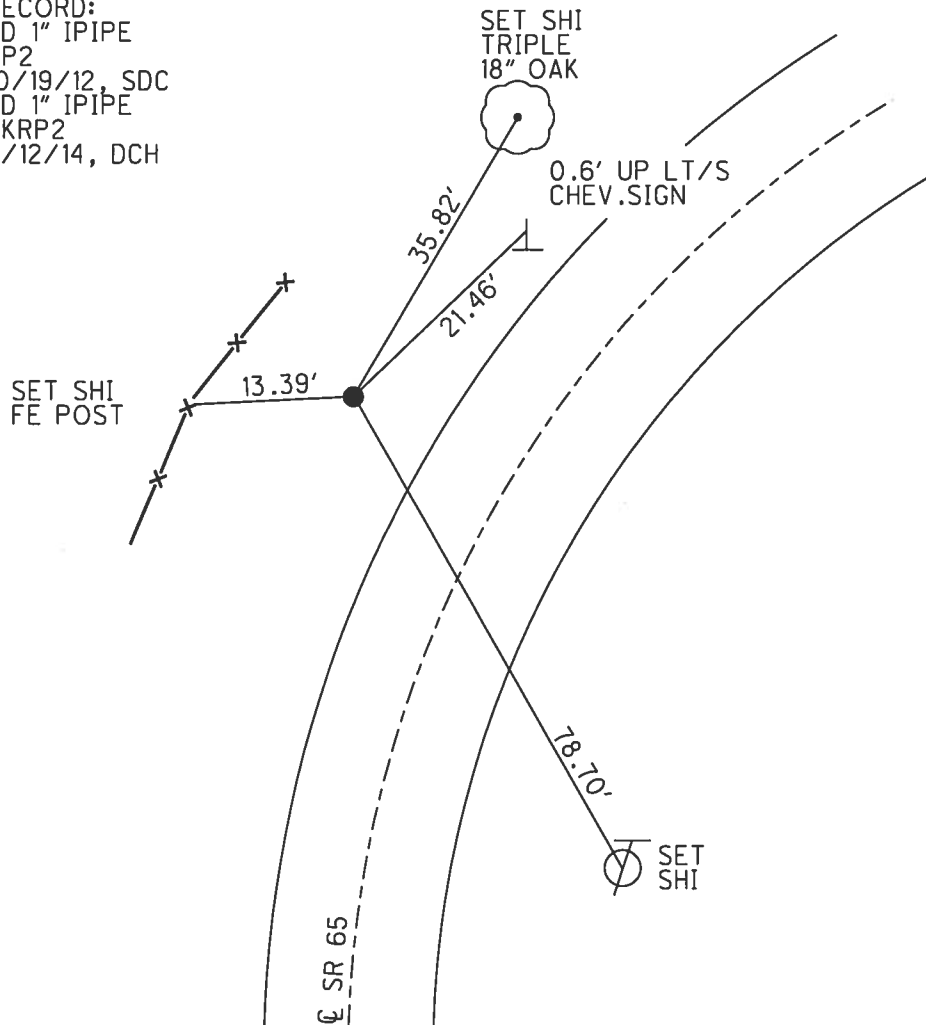

O.D.O.T. DISTRICT 2 SURVEY OFFICE (USE ONLY)

PERSONNEL

REFERENCE NO. 23 F

SHEET 16 OF 44

NOTES HOMAN

DATE 5/12/14

ROUTE SR 65

H.C. LEU

WEATHER CLOUDY

COUNTY WOOD

R.C. HOMAN

TEMP. 70°

TOWNSHIP MIDDLETON

SECTION RT 54

DWG BY RHOADES

PID 93680_R

T 7 N R 10 E

TYPE MONUMENT P.K./WASHER

ON SURFACE - ~~BELOW~~ ON

OFFSET Q PAVEMENT 0.8' ~~LT~~ : RT

8.9' TO RT EDGE PAVEMENT


STATION: 703+06.05

HORZ.DATUM: NAD83 2011

GEOID: NAVD88 2018

GRID: NORTHING: 676853.825


EASTING: 1638438.724

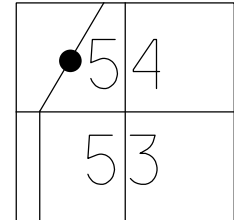

RECORD:

FD P.K.NAIL
10/17/84
FD P.K.NAIL
5/24/95, SAH
SET P.K./WASHER
8/7/95, SAH
FD P.K.NAIL
0.25' DOWN
REFF23
9/18/12, SAH
FD P.K./WASHER
REFF23
5/12/14, DCH
SET MAG/WASHER
6/2/17, DCH
FD MAG/WASHER
REF23F
3/16/23, DSA

RES#25299
DRIVEWAY

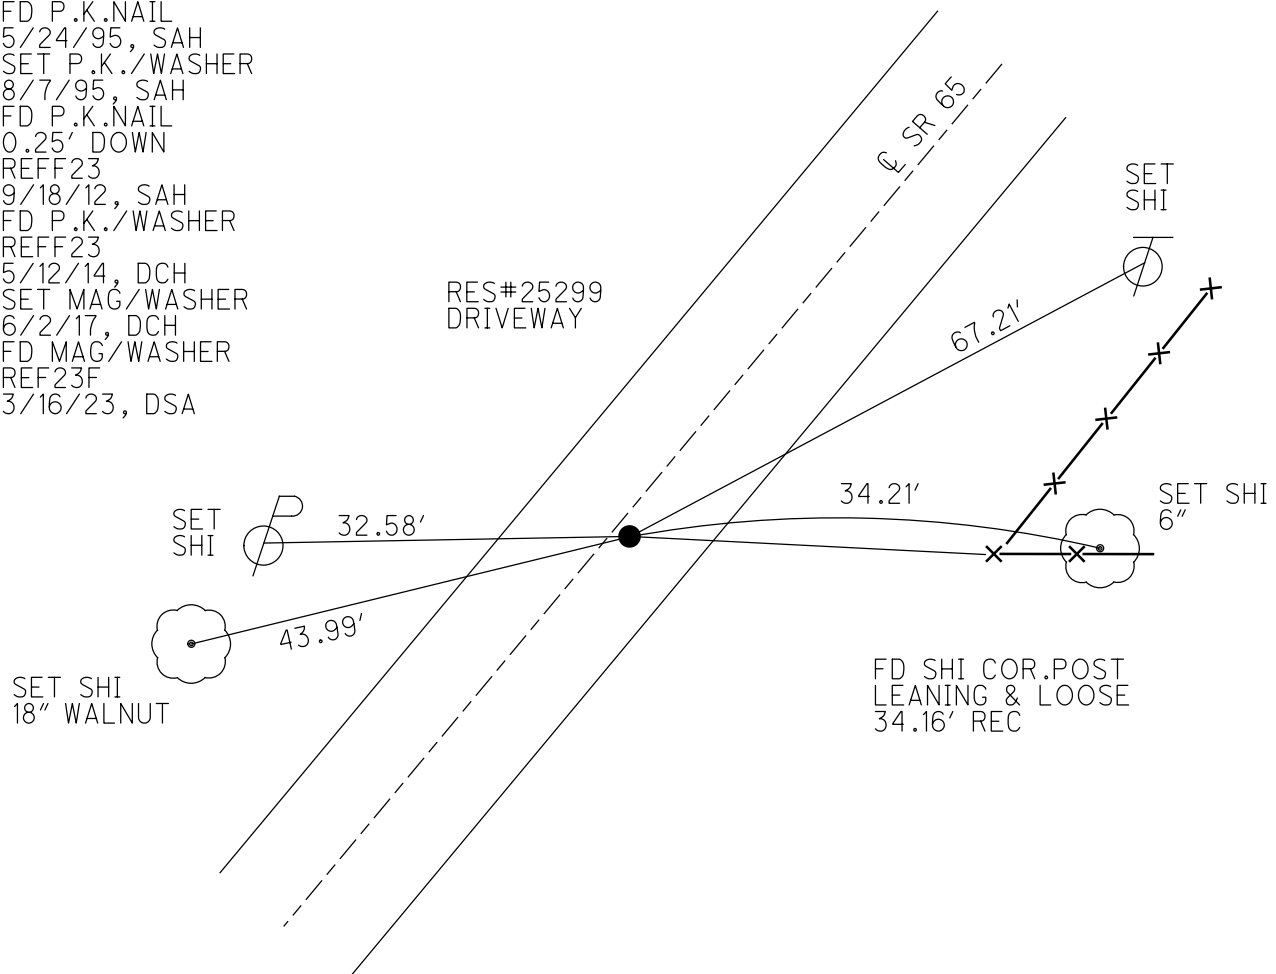


O.D.O.T. DISTRICT 2 SURVEY OFFICE (USE ONLY)


PERSONNEL _____ REFERENCE NO. 23 G SHEET 17 OF 44
NOTES HOMAN DATE 6/23/14 ROUTE SR 65
H.C. LEU WEATHER SUNNY COUNTY WOOD
R.C. THOMAS TEMP. 75° TOWNSHIP MIDDLETON
SECTION RT 54
T 7 N R 10 E


TYPE MONUMENT MAG NAIL
ON SURFACE - ~~BELOW~~ ON
LEFT - C PAV'T - RIGHT ON
10' TO RT EDGE PAVEMENT
S.L.M. 705+44.52

Grid: Northing: 677052.820 Easting: 1638570.168

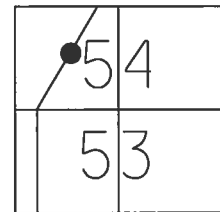

RECORD:
FD R.R.SPIKE
3" DOWN
ORIGIN UNKNOWN
SET P.K./WASHER
10/17/84
FD P.K./WASHER
5/24/95, SAH
SET P.K./WASHER
8/7/95, SAH
FD P.K.NAIL
REFG23
9/18/12, SAH
FD MAG NAIL
REFG23
6/23/14, DCH
SET MAG/WASHER
6/2/17, DCH

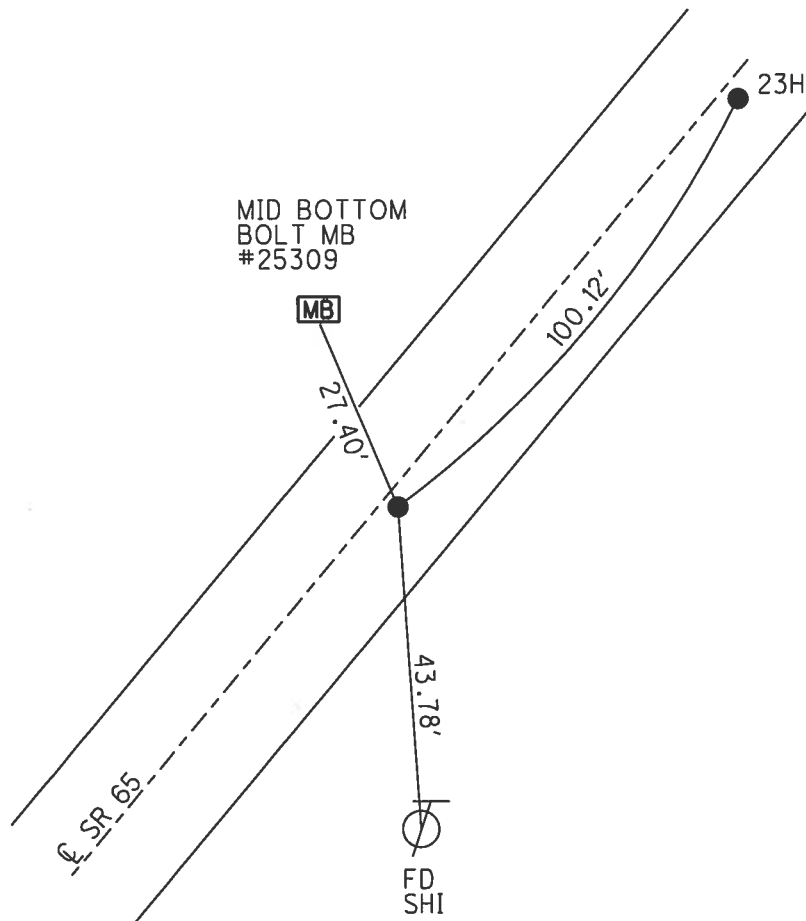

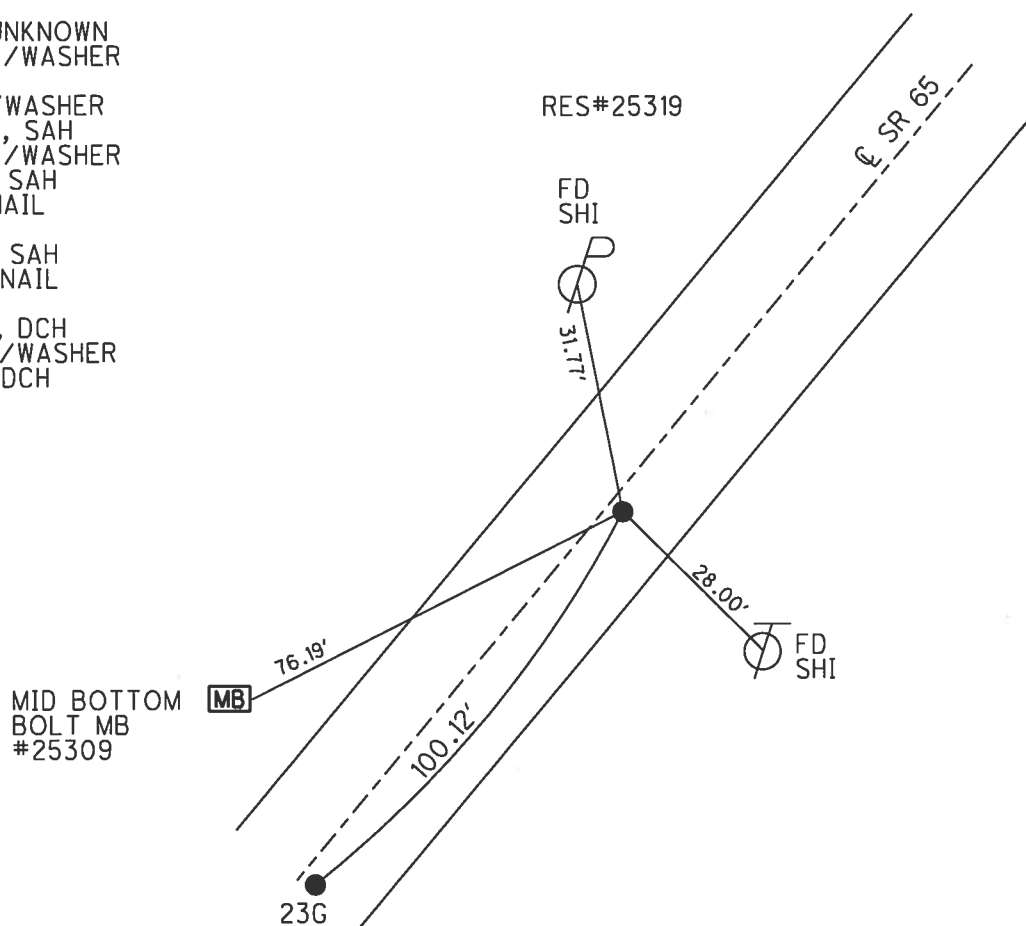

O.D.O.T. DISTRICT 2 SURVEY OFFICE (USE ONLY)

PERSONNEL

REFERENCE NO. 23 1

SHEET 19 OF 44

NOTES LEU
H.C. WESTFALL
R.C. HOMAN
RHOADES

DATE 6/12/14
WEATHER CLOUDY
TEMP. 69°

ROUTE SR 65
COUNTY WOOD
TOWNSHIP MIDDLETON
SECTION RT 55
T 7 N R 10 E

TYPE MONUMENT P.K.NAIL


ON SURFACE - ~~BELOW~~ ON

~~LEFT~~ - C PAV'T - RIGHT 0.5'

10.3' TO LT EDGE PAVEMENT


S.L.M. 710+82

Grid: Northing: 677500.736 Easting: 1638867.237

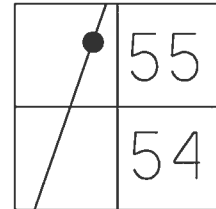

RECORD:

SET P.K./WASHER
10/17/84
FD P.K./WASHER
5/24/95, SAH
SET P.K./WASHER
8/7/95, SAH
FD P.K.NAIL
REFI23
9/18/12, SAH
FD P.K.NAIL
REFI23
6/12/14, DCH
SET MAG/WASHER
6/2/17, DCH

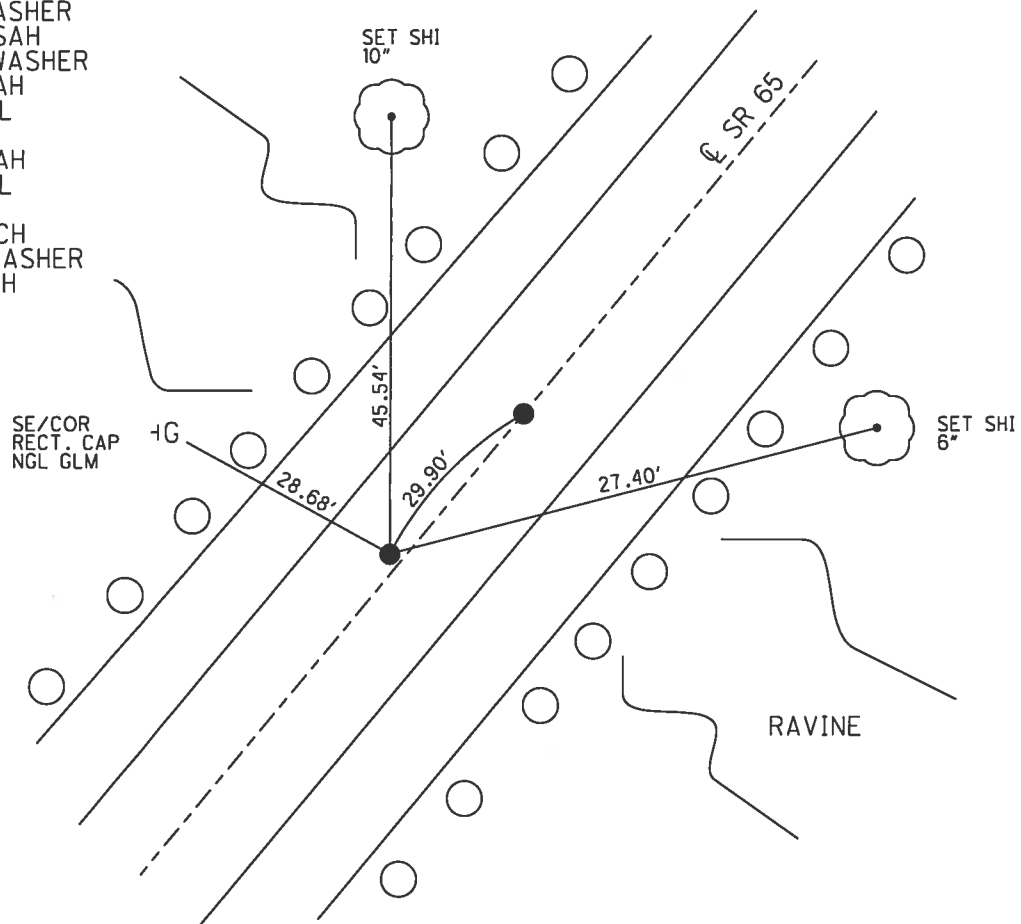


O.D.O.T. DISTRICT 2 SURVEY OFFICE (USE ONLY)

PERSONNEL _____ REFERENCE NO. 23 J SHEET 20 OF 44


NOTES LEU DATE 6/12/14 ROUTE SR 65
H.C. WESTFALL WEATHER CLOUDY COUNTY WOOD
R.C. HOMAN TEMP. 69° TOWNSHIP MIDDLETON
RHOADES SECTION RT 55
T 7 N R 10 E

TYPE MONUMENT P.K./WASHER
ON SURFACE - ~~BELOW~~ ON
LEFT - ℄ PAV'T - RIGHT ON
9.9' TO LT EDGE PAVEMENT
S.L.M. 711+85

Grid: Northing: 677525.957 Easting: 1638883.204

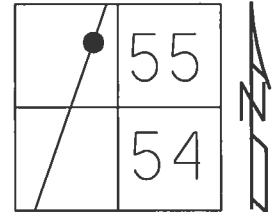

RECORD:
SET P.K./WASHER
10/17/84
FD P.K./WASHER
5/24/95, SAH
SET P.K./WASHER
8/7/95, SAH
FD P.K./NAIL
REFJ23
9/18/12, SAH
FD P.K./WASHER
REFJ23
6/12/14, DCH
SET MAG/WASHER
6/2/17, DCH

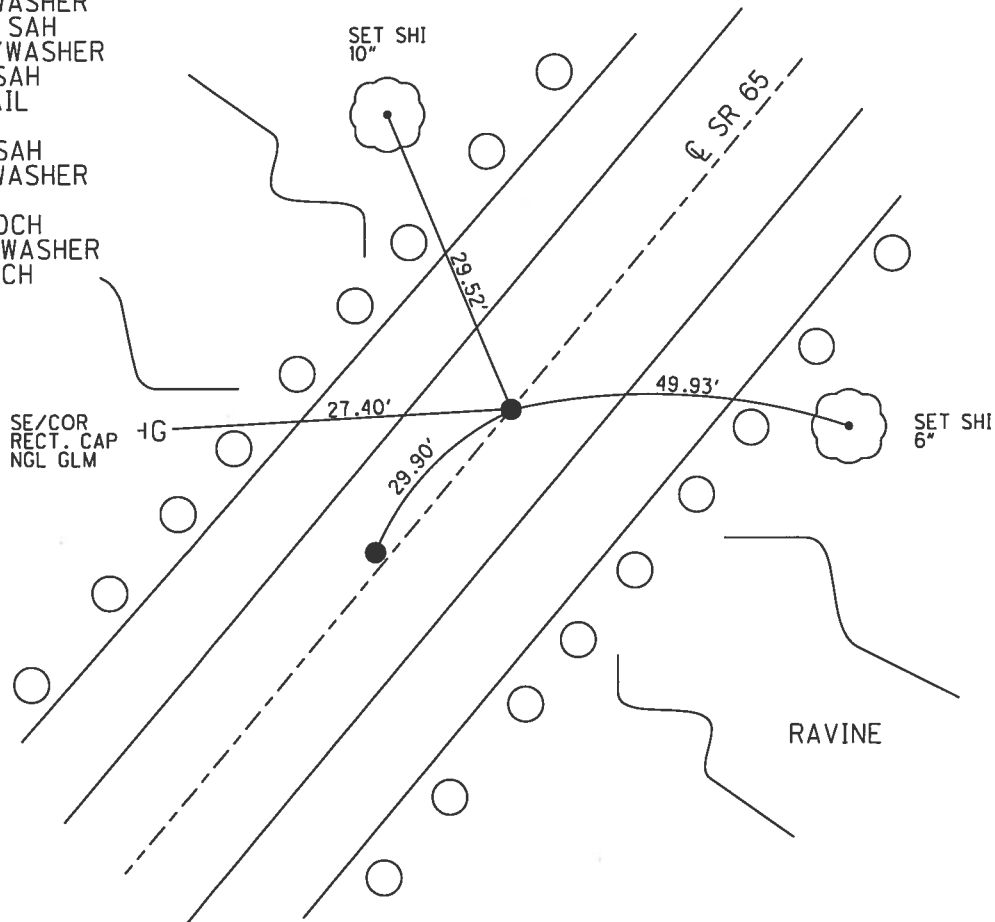


O.D.O.T. DISTRICT 2 SURVEY OFFICE (USE ONLY)

PERSONNEL _____ REFERENCE NO. 23 K SHEET 21 OF 44

NOTES LEU DATE 6/12/14 ROUTE SR 65
H.C. WESTFALL WEATHER CLOUDY COUNTY WOOD
R.C. HOMAN TEMP. 75° TOWNSHIP MIDDLETON
RHOADES SECTION RT 55
T 7 N R 10 E


TYPE MONUMENT P.K.SHANK
ON SURFACE - ~~BELOW~~ ON _____
~~LEFT~~ - C PAV'T - RIGHT 0.7'
9.7' TO RT EDGE PAVEMENT
S.L.M. 714+76.96

Grid: Northing: 677830.126 Easting: 1639085.157

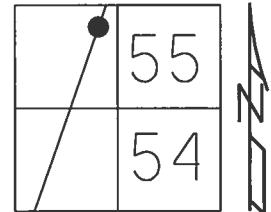

RECORD:
SET P.K./WASHER
10/17/84
FD P.K./WASHER
5/23/95, SAH
SET P.K./WASHER
8/8/95, SAH
FD P.K.NAIL
REFK23
9/18/12, SAH
FD P.K.SHANK
REFK23
6/12/14, DCH
SET MAG/WASHER
6/2/17, DCH

NOTE:
335'± S OF ROACHTON RD

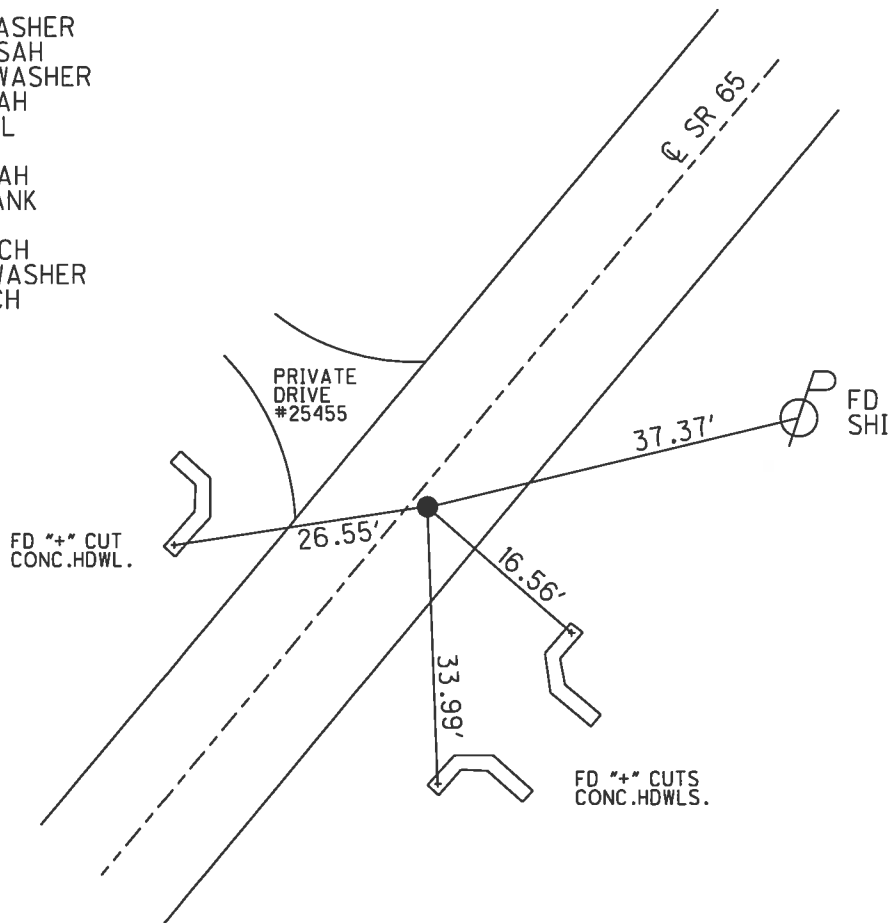

O.D.O.T. DISTRICT 2 SURVEY OFFICE (USE ONLY)

PERSONNEL

REFERENCE NO. 24

SHEET 22 OF 44

NOTES VAN DUSEN

DATE 5/23/95

ROUTE SR 65

H.C. MOSER

WEATHER SUNNY

COUNTY WOOD

R.C. HUSS

TEMP. 80°

TOWNSHIP MIDDLETON

CORDES

SECTION RT 55

DWG BY RHOADES

PID 93680_R

T 7 N R 10 E

TYPE MONUMENT P.K./WASHER

ON SURFACE - ~~BELOW~~ ON

OFFSET Q PAVEMENT ON LT : RT

9.7' TO LT EDGE PAVEMENT


STATION: 718+12.32

HORZ.DATUM: NAD83 2011

GEOID: NAVD88 2018


GRID: NORTHING: 678109.626

EASTING: 1639270.545

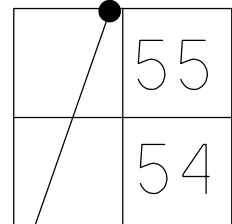

RECORD:

FD R.R.SPIKE
4/16/84
SET P.K./WASHER
10/17/84
FD P.K./WASHER
5/23/95, SAH
SET P.K./WASHER
8/8/95, SAH
FD P.K.NAIL
REF24
9/18/12, SAH
FD R.R.SPIKE
3" DOWN
REF24
6/12/14, DCH
SET MAG/WASHER
6/2/17, DCH
FD MAG/WASHER
REF24
3/16/23, DSA

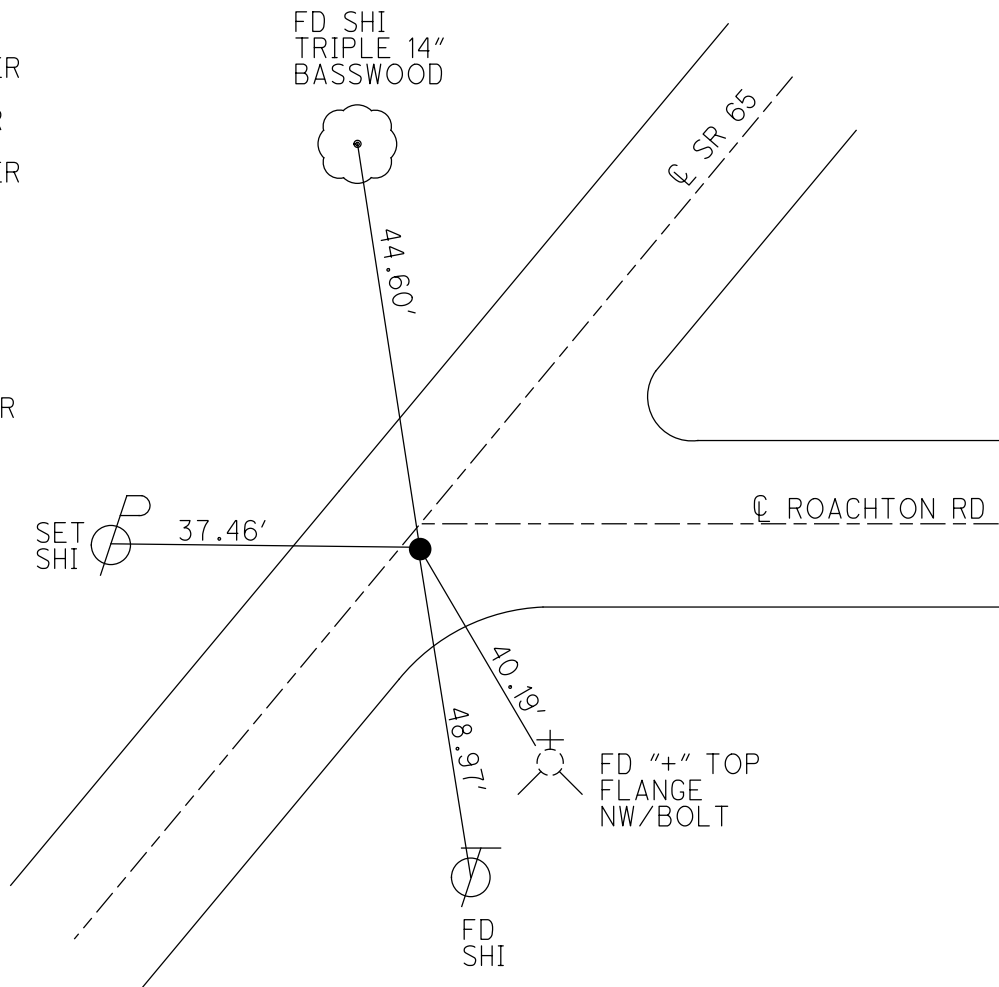


O.D.O.T. DISTRICT 2 SURVEY OFFICE (USE ONLY)


PERSONNEL _____ REFERENCE NO. 24 A SHEET 23 OF 44
NOTES LEU DATE 6/12/14 ROUTE SR 65
H.C. HOMAN WEATHER CLOUDY COUNTY WOOD
R.C. WESTFALL TEMP. 71° TOWNSHIP PERRYSBURG
RHOADES SECTION RT 56
T 7 N R 10 E

TYPE MONUMENT P.K./WASHER
ON SURFACE - ~~BELOW~~ ON
LEFT - Q PAV'T - RIGHT ON
9.8' TO RT EDGE PAVEMENT
S.L.M. 734+50.01

Grid: Northing: 679475.639 Easting: 1640173.834

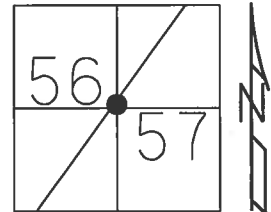

RECORD:
SET P.K./WASHER
10/17/84
FD P.K./WASHER
5/23/95, SAH
SET P.K./WASHER
8/8/95, SAH
FD P.K./WASHER
REFA24
9/18/12, SAH
FD P.K./WASHER
REFA24
6/12/14, DCH
SET MAG/WASHER
6/2/17, DCH

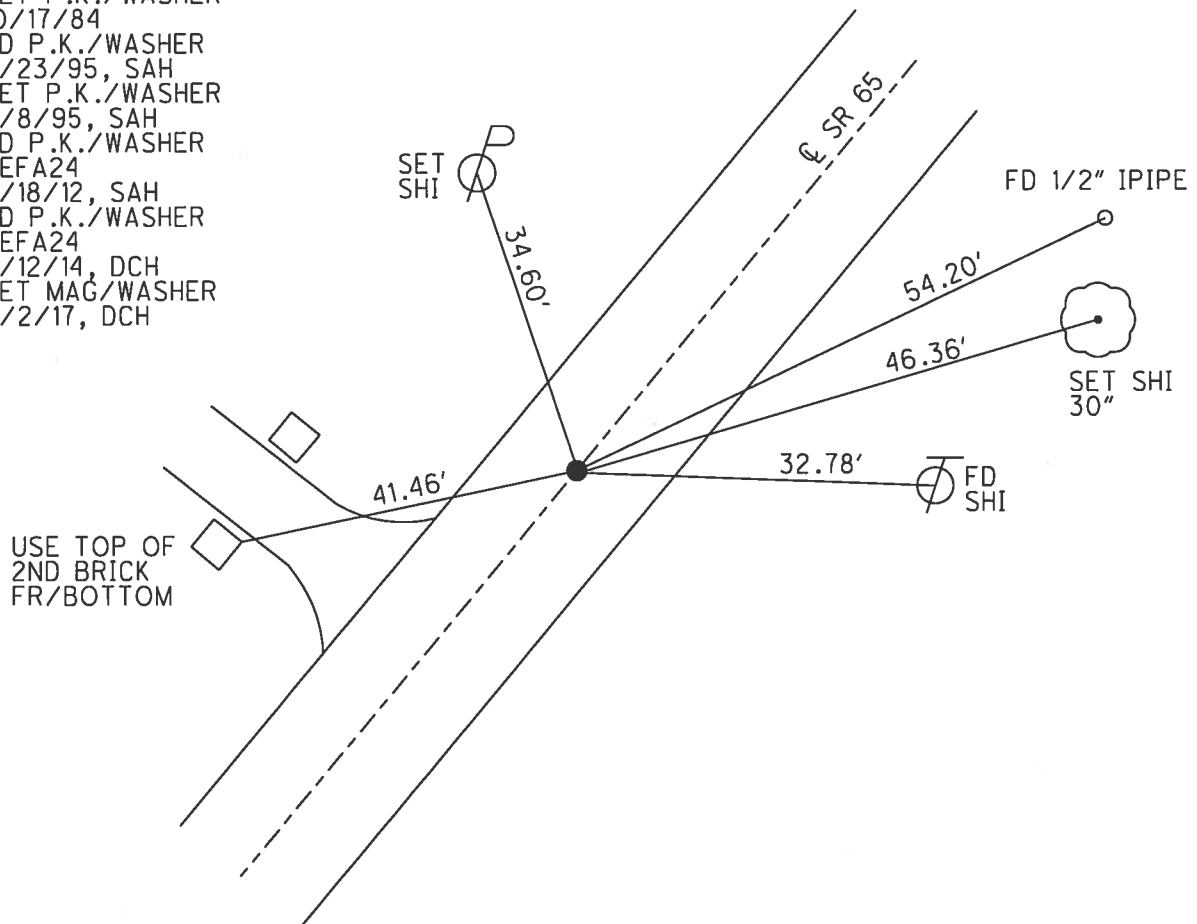


O.D.O.T. DISTRICT 2 SURVEY OFFICE (USE ONLY)

PERSONNEL _____ REFERENCE NO. 24 B SHEET 24 OF 44
 NOTES NEISE DATE 10/24/24 ROUTE SR 65
 H.C. PRESTON-COLVIN WEATHER SUNNY COUNTY WOOD
 R.C. NEISE TEMP. 53° TOWNSHIP PERRYSBURG
 _____ SECTION RT 57
 _____ T 7 N R 10 E


TYPE MONUMENT MAG SHANK
 ON SURFACE - ~~BELOW~~ ON
~~LEFT~~ - Q PAV'T - RIGHT 1'
10.7' TO LT EDGE PAVEMENT
 S.L.M. 739+00.02

Grid: Northing: 679850.697 Easting: 1640422.514

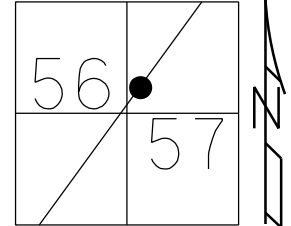

RECORD:
 FD LG.R.R.SPIKE
 SET BY H.FREY FOR
 THE WILLOWBROOK SUB.
 -FARNHAM, WIRRES & BERNING
 10/17/84
 FD P.K./WASHER
 5/23/95, SAH
 SET P.K./WASHER
 8/8/95, SAH
 FD P.K./WASHER
 REFB24
 9/18/12, SAH
 FD P.K./WASHER
 REFB24
 6/12/14, DCH
 SET MAG/WASHER
 3/16/16, DCH
 FD MAG SHANK
 10/24/24, TDN

USE TOP OF 8TH
 BRICK FROM BOT.
 DRIVE MARKER
 #25815

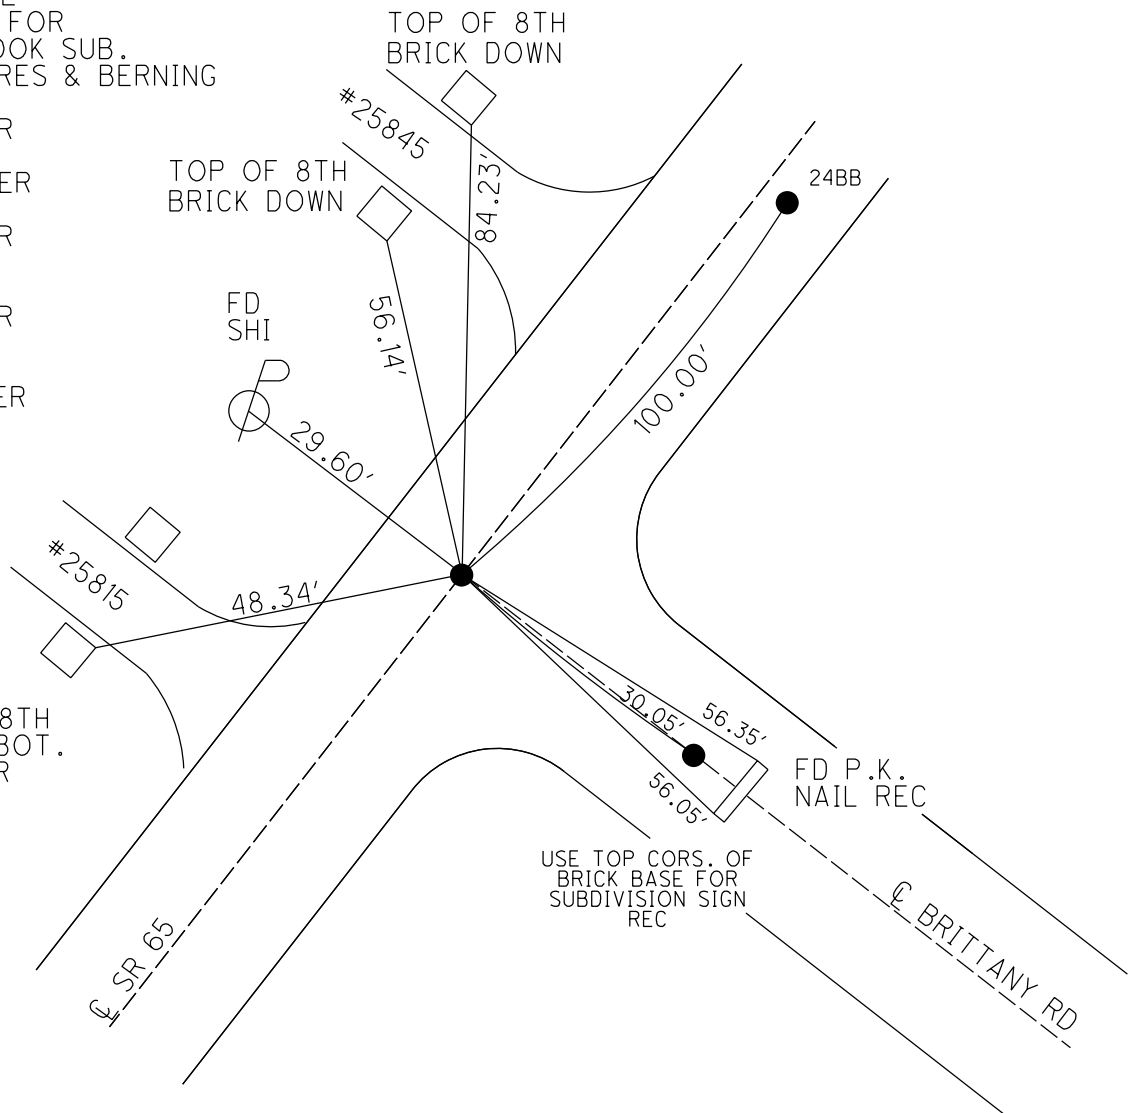

O.D.O.T. DISTRICT 2 SURVEY OFFICE (USE ONLY)

PERSONNEL	REFERENCE NO. <u>24 C</u>	SHEET <u>25</u> OF <u>44</u>
NOTES <u>LEU</u>	DATE <u>6/12/14</u>	ROUTE <u>SR 65</u>
H.C. <u>HOMAN</u>	WEATHER <u>CLOUDY</u>	COUNTY <u>WOOD</u>
R.C. <u>WESTFALL</u>	TEMP. <u>71°</u>	TOWNSHIP <u>PERRYSBURG</u>
<u>RHOADES</u>		SECTION <u>RT 57</u>
		T <u>7</u> N R <u>10</u> E

TYPE MONUMENT P.K./WASHER


~~ON SURFACE~~ - BELOW 3"

~~LEFT~~ - C PAV'T - RIGHT 3.0'

6.8' TO RT EDGE PAVEMENT


S.L.M. 740+00.02

Grid: Northing: 679934.129 Easting: 1640477.641

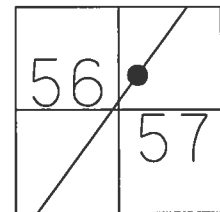

RECORD:
 FD LG.R.R.SPIKE
 10/17/84
 SLM. 737+99
 FD P.K./WASHER
 5/23/95, SAH
 SET P.K./WASHER
 8/8/95, SAH
 FD P.K./WASHER
 REFC24
 9/18/12, SAH
 FD P.K.NAIL
 3" BELOW
 REFC24
 6/12/14, DCH
 SET MAG/WASHER
 3/16/16, DCH


USE TOP OF 3RD
 BRICK FROM BOT.
 DRIVE MARKER
 #25845

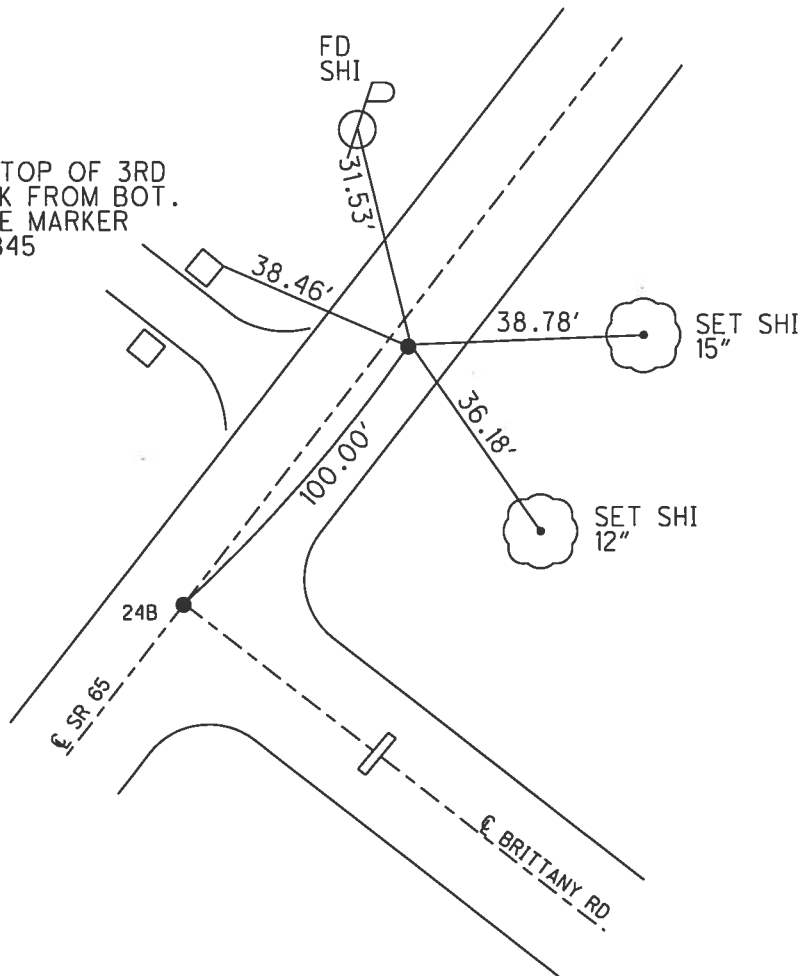

O.D.O.T. DISTRICT 2 SURVEY OFFICE (USE ONLY)


PERSONNEL _____ REFERENCE NO. 24 D SHEET 26 OF 44
 NOTES NEISE DATE 10/28/24 ROUTE SR 65
 H.C. NEISE WEATHER CALM COUNTY WOOD
 R.C. PRESTON-COLVIN TEMP. 60° TOWNSHIP PERRYSBURG
 _____ SECTION RT 57
 _____ T 7 N R 10 E

TYPE MONUMENT MAG/WASHER
 ON SURFACE - ~~BELOW~~ ON
 LEFT - ℄ PAV'T - ~~RIGHT~~ 1.5'
8.6' TO LT EDGE PAVEMENT
 S.L.M. 741+70.63

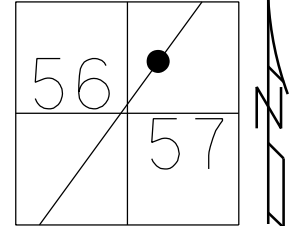

Grid: Northing: 680083.077 Easting: 1640560.846

RECORD: P.C.
 STA. 740+61.32
 FD SM.R.R.SPIKE
 4/18/84
 FD P.K./WASHER
 5/23/95, SAH
 SET P.K./WASHER
 8/8/95, SAH
 FD P.K./WASHER
 REFD24
 9/18/12, SAH
 FD P.K.NAIL
 REFD24
 6/12/14, DCH
 SET MAG/WASHER
 3/16/16, DCH
 SET MAG/WASHER
 REF24D
 10/28/24, TDN

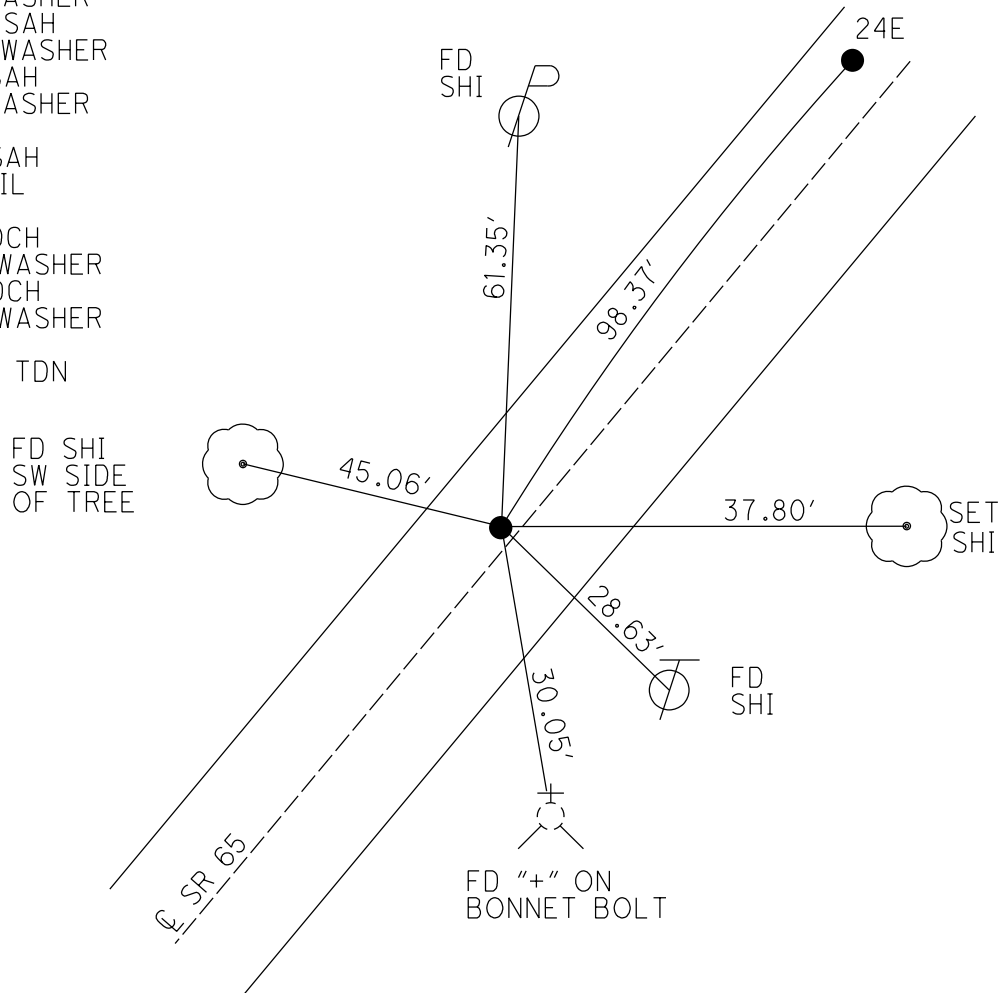


O.D.O.T. DISTRICT 2 SURVEY OFFICE (USE ONLY)

PERSONNEL _____ REFERENCE NO. 24 E SHEET 27 OF 44
NOTES NEISE DATE 10/28/24 ROUTE SR 65
H.C. NEISE WEATHER CALM COUNTY WOOD
R.C. PRESTON-COLVIN TEMP. 60° TOWNSHIP PERRYSBURG


SECTION RT 57
T 7 N R 10 E

TYPE MONUMENT MAG/WASHER
ON SURFACE - ~~BELOW~~ ON _____
LEFT - ℄ PAV'T - RIGHT 5.2'
4.7' TO LT EDGE PAVEMENT
S.L.M. 742+69

Grid: Northing: 680168.914 Easting: 1640608.897

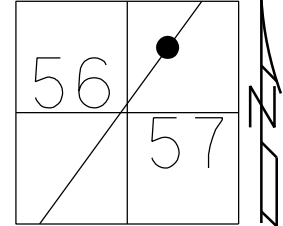

RECORD: P.I.
 $\Delta = 7^{\circ}50' 51''$ RT
STA. 741+59.72
FD SM.R.R.SPIKE
4/18/84
SET P.K./WASHER
8/8/95, SAH
FD P.K./WASHER
REFE24
9/18/12, SAH
FD P.K.NAIL
REFE24
6/12/14, DCH
SET MAG/WASHER
3/16/16, DCH
FD MAG/WASHER
REF24E
10/28/24, TDN

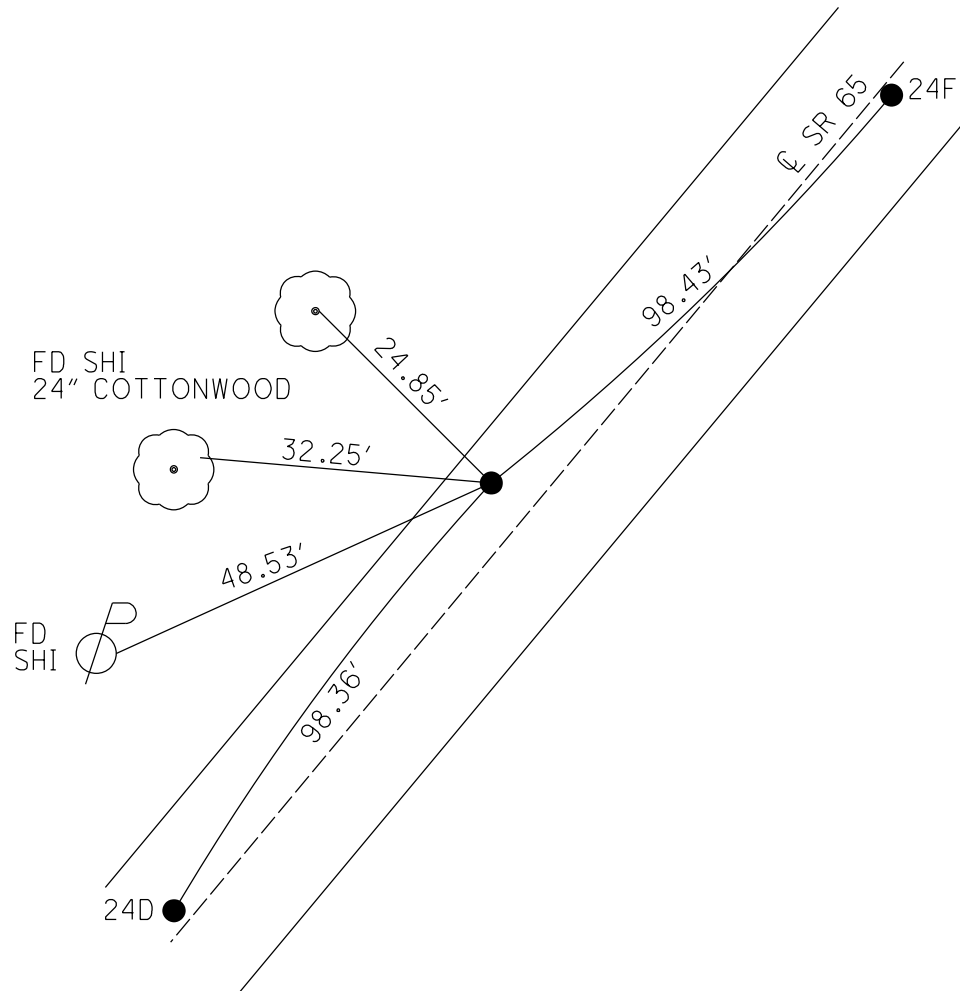


O.D.O.T. DISTRICT 2 SURVEY OFFICE (USE ONLY)

PERSONNEL _____ REFERENCE NO. 24 F SHEET 28 OF 44
NOTES NEISE DATE 10/28/24 ROUTE SR 65
H.C. NEISE WEATHER CALM COUNTY WOOD
R.C. PRESTON-COLVIN TEMP. 60° TOWNSHIP PERRYSBURG


SECTION RT 57
T 7 N R 10 E

TYPE MONUMENT MAG/WASHER
ON SURFACE - ~~BELOW~~ ON
~~LEFT~~ - ℄ PAV'T - RIGHT 0.5'
9.7' TO RT EDGE PAVEMENT
S.L.M. 743+67.32

Grid: Northing: 680247.408 Easting: 1640668.101

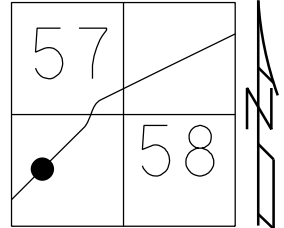

RECORD: P.T.
STA. 742+57.55
FD P.K./WASHER
5/23/95, SAH
SET P.K./WASHER
8/8/95, SAH
FD P.K./WASHER
REFF24
9/18/12, SAH
FD P.K.NAIL
REFF24
6/12/14, DCH
SET MAG/WASHER
3/16/16, DCH
SET MAG/WASHER
REF24F
10/28/24, TDN

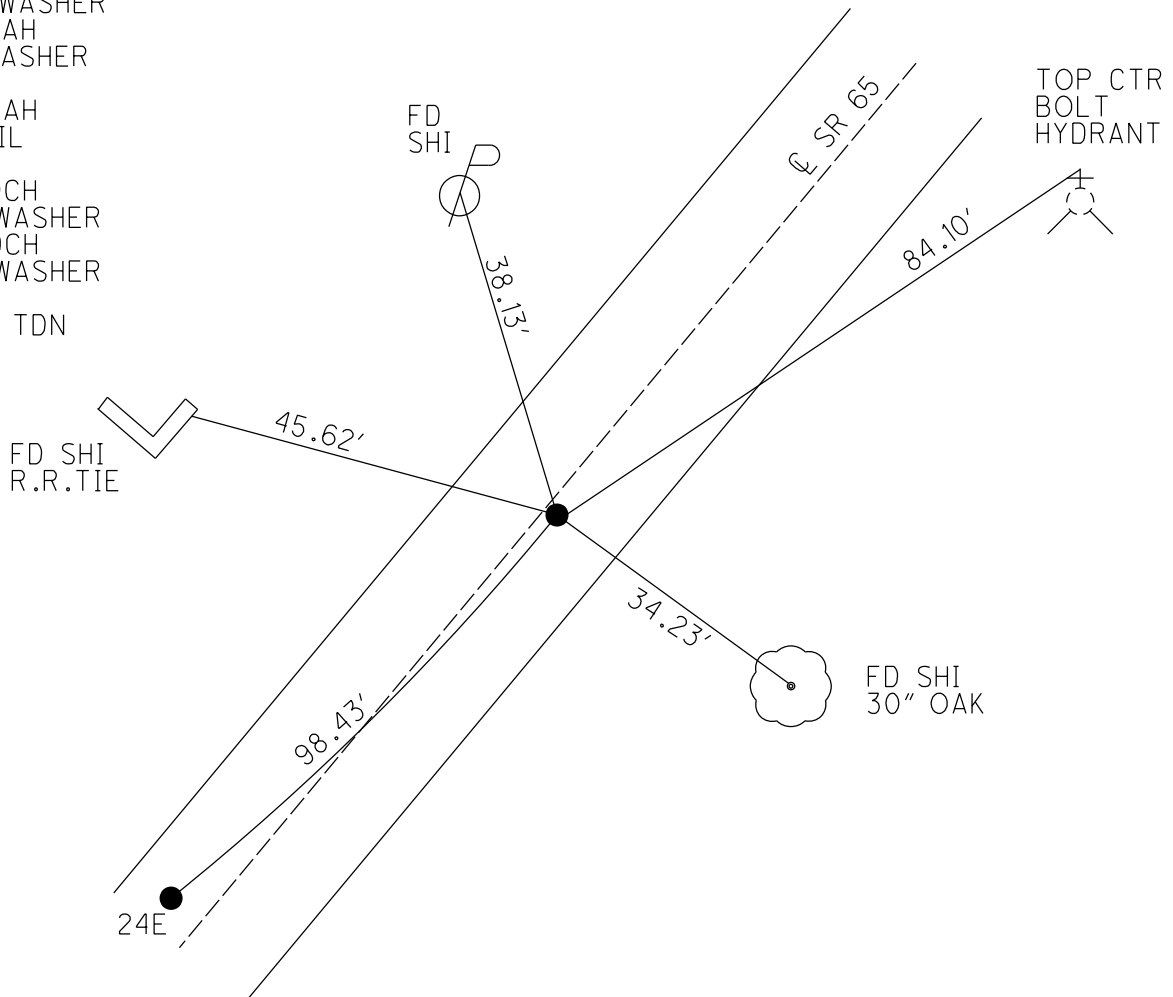

O.D.O.T. DISTRICT 2 SURVEY OFFICE (USE ONLY)

PERSONNEL

REFERENCE NO. 24 G

SHEET 29 OF 44

NOTES LEU

DATE 6/12/14

ROUTE SR 65

H.C. HOMAN

WEATHER CLOUDY

COUNTY WOOD

R.C. WESTFALL

TEMP. 72°

TOWNSHIP PERRYSBURG

RHOADES

SECTION RT 57

T 7 N R 10 E

TYPE MONUMENT MAG/WASHER


ON SURFACE - ~~BELOW~~ ON

~~LEFT~~ - C PAV'T - RIGHT 9.0'


1.0' TO RT EDGE PAVEMENT

S.L.M. 751+34.27

Grid: Northing: 680859.497 Easting: 1641130.233

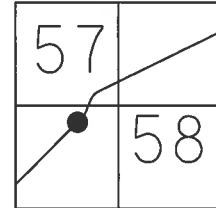

RECORD: P.I.
 $\Delta = 13^{\circ}36'34''$ LT
FD P.K./WASHER
5/23/95, SAH
SET P.K./WASHER
8/8/95, SAH
FD MAG/WASHER
REFG24
6/12/14, DCH
SET MAG/WASHER
6/2/17, DCH

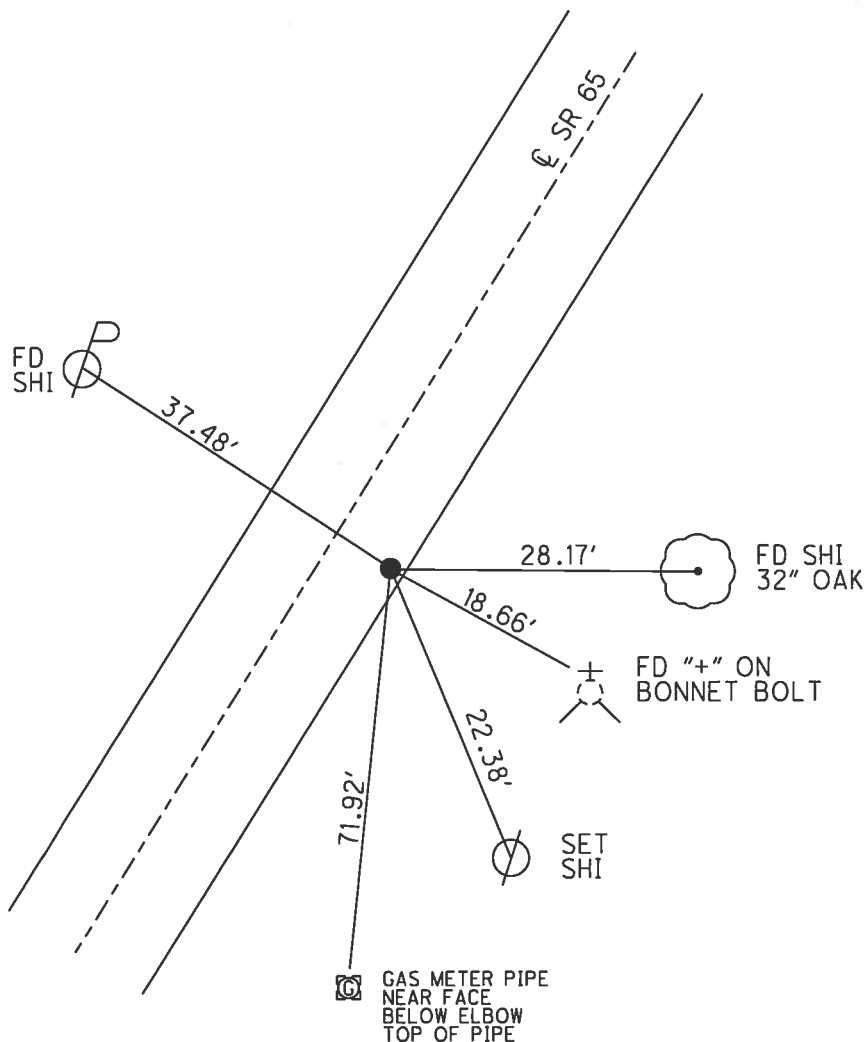

O.D.O.T. DISTRICT 2 SURVEY OFFICE (USE ONLY)

PERSONNEL

REFERENCE NO.

24 H

SHEET 30 OF 44

NOTES HOMAN

DATE 6/18/14

ROUTE SR 65

H.C. HOMAN

WEATHER CLOUDY

COUNTY WOOD

R.C. THOMAS

TEMP. 85°

TOWNSHIP PERRYSBURG

SECTION RT 57

T 7 N R 10 E

TYPE MONUMENT MAG NAIL


ON SURFACE - ~~BELOW~~ ON

LEFT - Q PAV'T - RIGHT ON

9.8' TO RT EDGE PAVEMENT

S.L.M. 753+65.94

Grid: Northing: 681072.079 Easting: 1641222.308

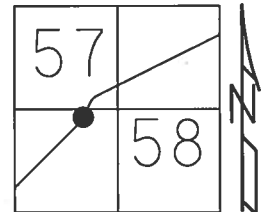

RECORD:
FD P.K.NAIL
10/19/84
SET P.K./WASHER
8/8/95, SAH
FD MAG NAIL
REFH24
6/18/14, DCH
SET MAG/WASHER
6/2/17, DCH

SET TACK
MB POST
#26065

MB


30.10'

26.07'

CORNER
DRIVE
APRON

65.15'

FD "+" TOP
CONC.HDWL.

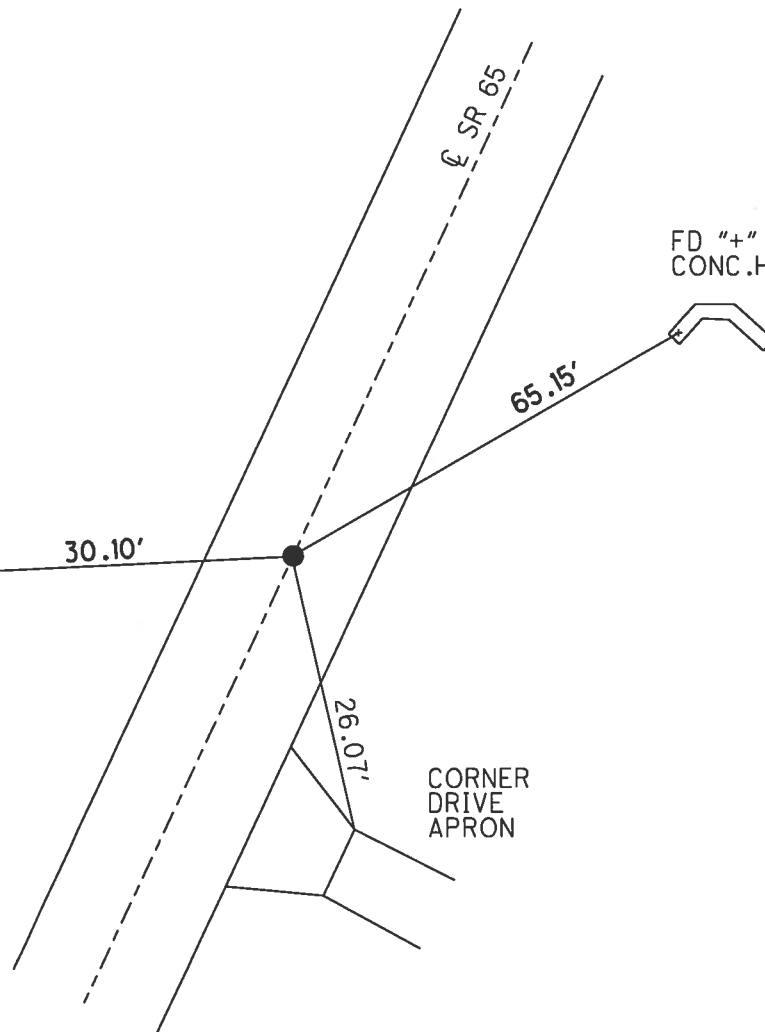


O.D.O.T. DISTRICT 2 SURVEY OFFICE (USE ONLY)


PERSONNEL _____ REFERENCE NO. 24 HI SHEET 31 OF 44
 NOTES HOMAN DATE 6/18/14 ROUTE SR 65
 H.C. HOMAN WEATHER CLOUDY COUNTY WOOD
 R.C. THOMAS TEMP. 85° TOWNSHIP PERRYSBURG
 _____ SECTION RT 57
 _____ T 7 N R 10 E

TYPE MONUMENT P.K./WASHER
 ON SURFACE - ~~BELOW~~ ON
~~LEFT~~ - C PAV'T - RIGHT 6.2'
3.2' TO RT EDGE PAVEMENT
 S.L.M. 757+08.06

Grid: Northing: 681385.961 Easting: 1641358.421

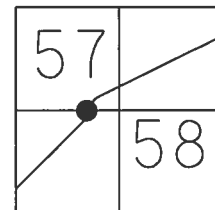

RECORD:
 STA. 755+08
 FD R.R.SPIKE
 4/16/84
 SET P.K./WASHER
 10/19/84, SWH
 FD P.K./WASHER
 5/23/95, SAH
 SET P.K./WASHER
 8/8/95, SAH
 FD P.K.NAIL
 GPS, REFH24
 9/18/12, SAH
 FD P.K./WASHER
 (REF124)
 6/18/14, DCH
 SET MAG/WASHER
 6/2/17, DCH

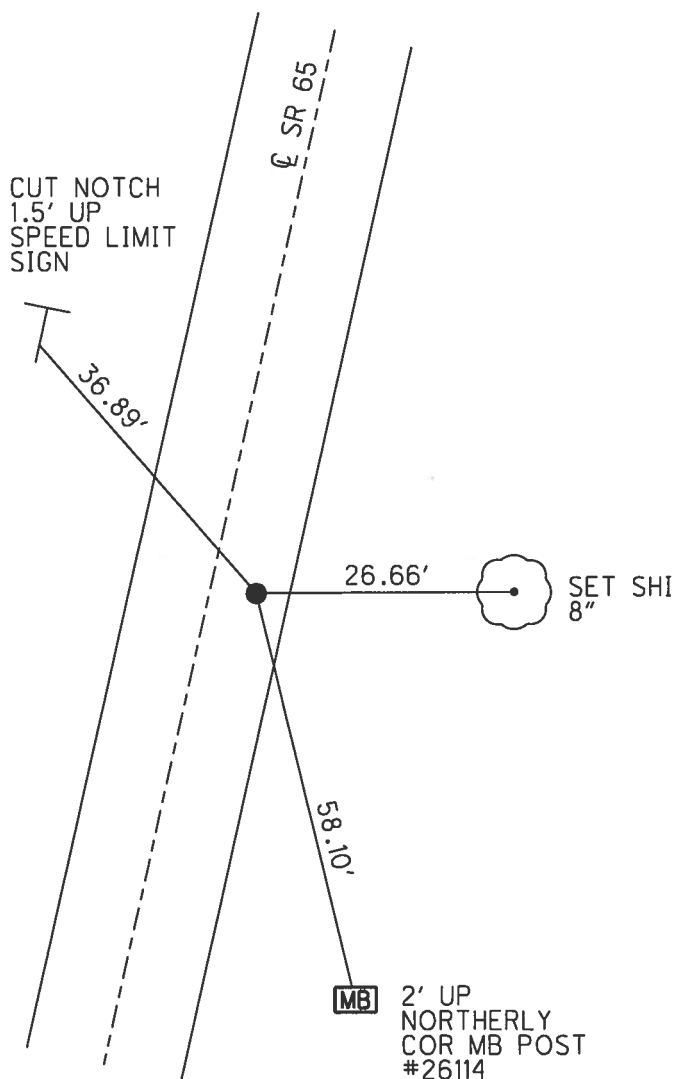


O.D.O.T. DISTRICT 2 SURVEY OFFICE (USE ONLY)


PERSONNEL	REFERENCE NO. <u>24 1</u>	SHEET <u>32</u> OF <u>44</u>	
NOTES	HOMAN	DATE <u>6-18-14</u>	ROUTE <u>SR 65</u>
H.C.	HOMAN	WEATHER <u>CLOUDY</u>	COUNTY <u>WOOD</u>
R.C.	THOMAS	TEMP. <u>90°F</u>	TOWNSHIP <u>PERRYSBURG</u>
			SECTION <u>RT 57</u>
			T <u>7</u> N R <u>10</u> E

TYPE MONUMENT RR. SPIKE
~~ON SURFACE~~ - BELOW 4"
 LEFT - ℄ PAV'T - RIGHT ON
10.8 TO LT EDGE PAVEMENT
 S.L.M. 758+67.92

Grid: Northing: 681541.408 Easting: 1641395.731

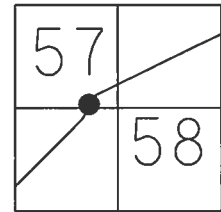


RECORD:
 SLM 756+67
 FD R.R.SPIKE
 SET PK/WASHER
 10-19-84, SWH
 SET PK/WASHER
 8-8-95, SAH
 FD P.K./WASHER
 9/19/12, SAH
 FD P.K./WASHER
 REF124
 6-18-14
 SET MAG/WASHER
 08-03-2015, JLL

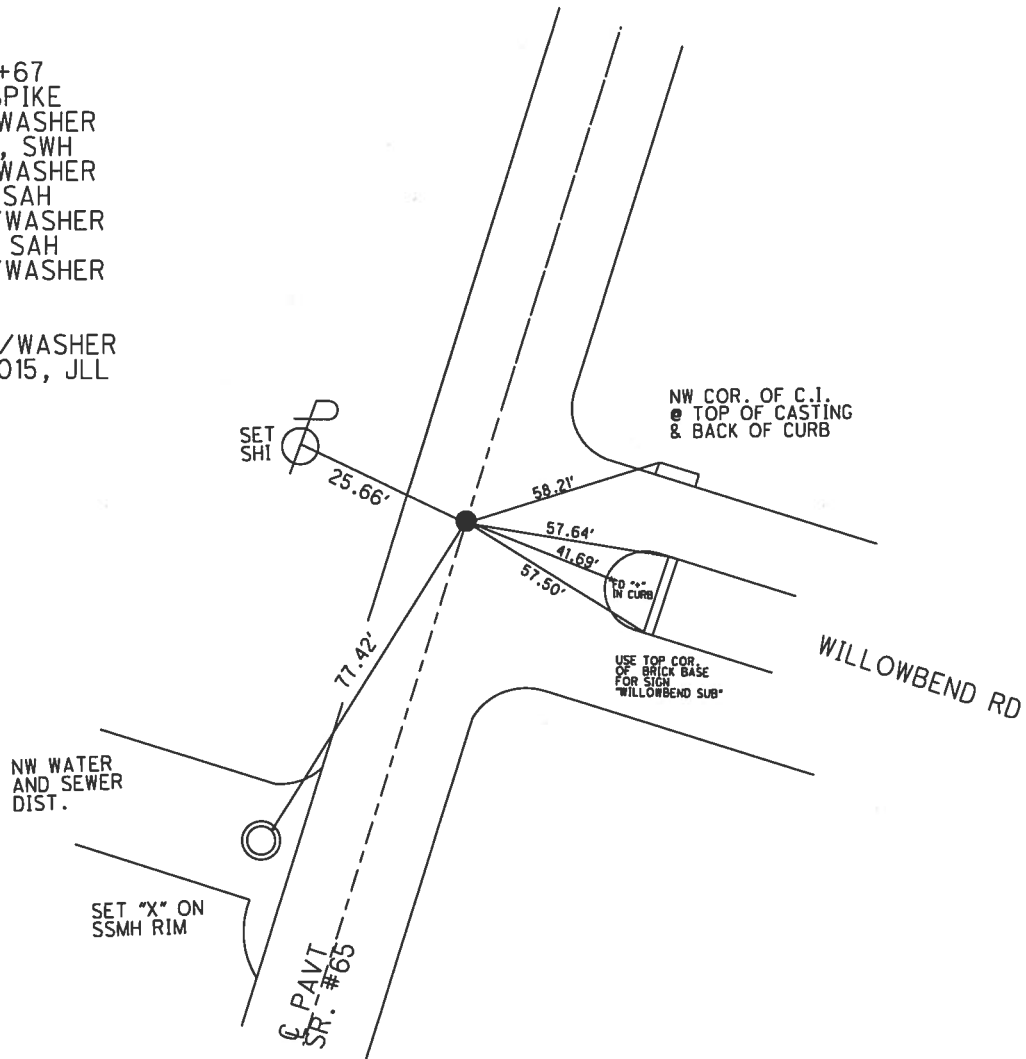


O.D.O.T. DISTRICT 2 SURVEY OFFICE (USE ONLY)

PERSONNEL	REFERENCE NO. <u>24 J</u>	SHEET <u>33</u> OF <u>44</u>
NOTES <u>HOMAN</u>	DATE <u>6-18-14</u>	ROUTE <u>SR 65</u>
H.C. <u>HOMAN</u>	WEATHER <u>CLOUDY</u>	COUNTY <u>WOOD</u>
R.C. <u>THOMAS</u>	TEMP. <u>90°F</u>	TOWNSHIP <u>PERRYSBURG</u>
		SECTION <u>RT 57</u>
		T <u>2</u> N R <u>10</u> E

TYPE MONUMENT PK/WASHER
 ON SURFACE - ~~BELOW~~ ON
 LEFT - ℄ PAV'T - ~~RIGHT~~ 11.8'
 1.8' LT TO LT EDGE PAVEMENT
 S.L.M. 760+82.81

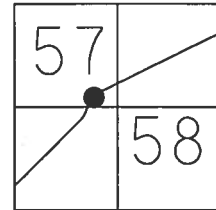

RECORD:
 STA. 758+79
 FD 1" IRON PIN
 1" BELOW
 SET IPIPE
 5-5-72
 SET PK/WASHER
 10-19-84, SWH
 SET PK/WASHER
 8-8-95, SAH
 FD P.K./WASHER
 REF J24
 9/19/12, SAH
 6-18-14, DCH
 SET MAG/WASHER
 8-03-15, JLL

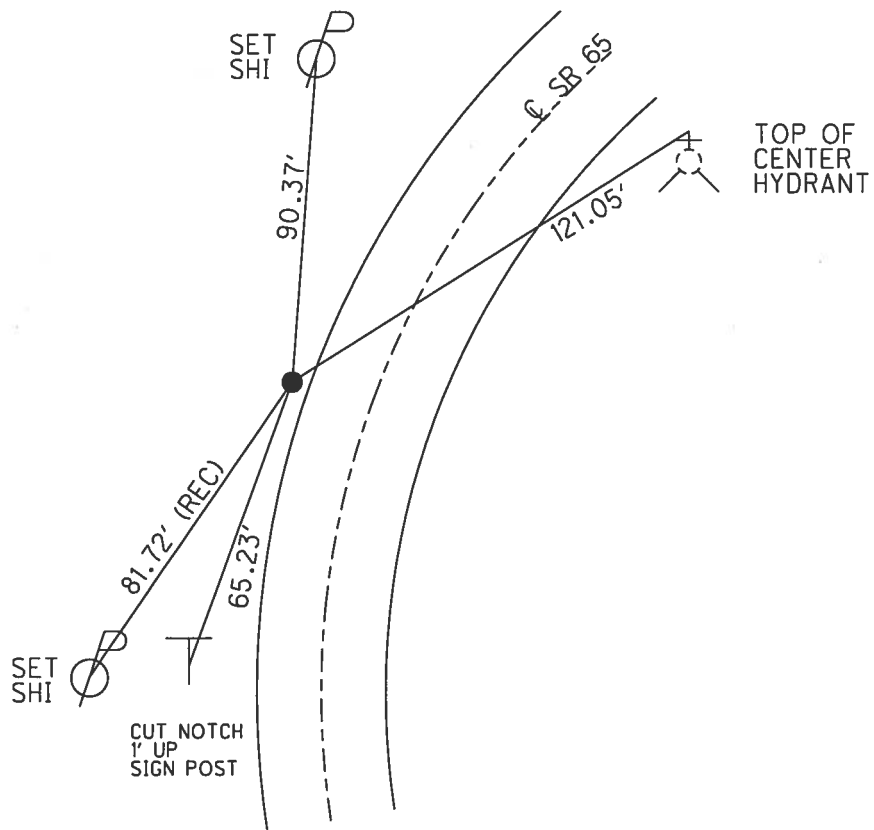

O.D.O.T. DISTRICT 2 SURVEY OFFICE (USE ONLY)

PERSONNEL _____ REFERENCE NO. 24 Q SHEET 34 OF 44

NOTES HOMAN DATE 6-23-14 ROUTE SR 65

H.C. LEU WEATHER SUNNY COUNTY WOOD

R.C. THOMAS TEMP. 70°F TOWNSHIP PERRYSBURG

SECTION RT 58

T 7 N R 10 E


TYPE MONUMENT PK/WASHER

ON SURFACE - ~~BELOW~~ ON


LEFT - ℄ PAV'T - ~~RIGHT~~ 8.4'

1.2' TO LT EDGE PAVEMENT

S.L.M. 770+19.50

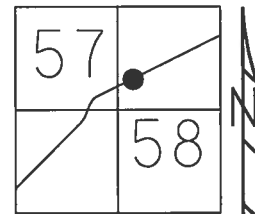

RECORD:
 STA. 768+18
 FD PK NAIL
 1984
 SET PK/WASHER
 10-19-84, SWH
 FD P.K./WASHER
 5/23/95, SAH
 SET PK/WASHER
 8-8-95, SAH
 FD P.K./WASHER
 REFQ24
 9/19/12, SAH
 6-23-14, JLL
 SET MAG/WASHER
 08-03-15, JLL

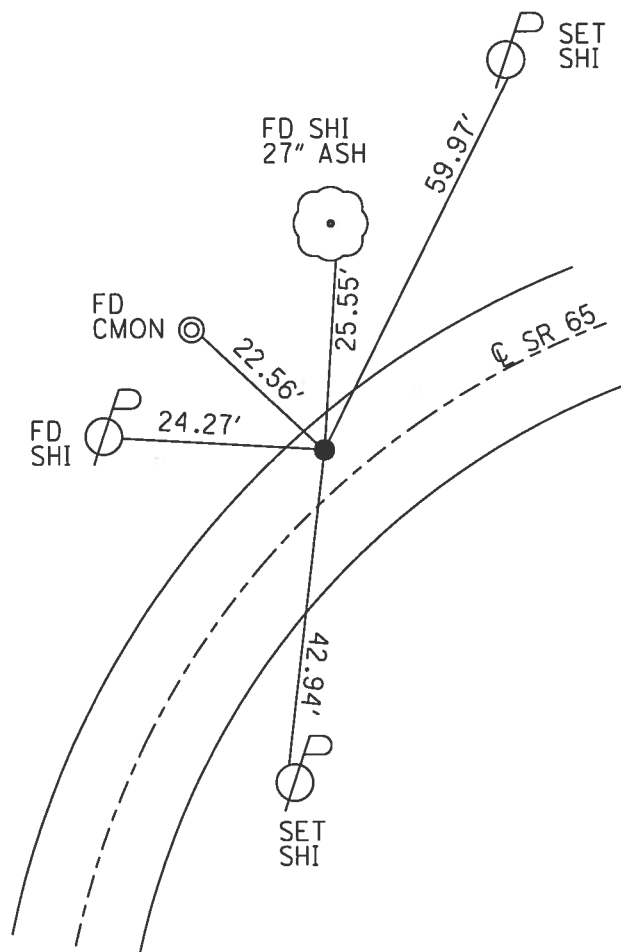

O.D.O.T. DISTRICT 2 SURVEY OFFICE (USE ONLY)

PERSONNEL	REFERENCE NO. <u>24 R</u>	SHEET <u>35</u> OF <u>44</u>
NOTES <u>HOMAN</u>	DATE <u>6-23-14</u>	ROUTE <u>SR 65</u>
H.C. <u>LEU</u>	WEATHER <u>SUNNY</u>	COUNTY <u>WOOD</u>
R.C. <u>THOMAS</u>	TEMP. <u>70°F</u>	TOWNSHIP <u>PERRYSBURG</u>
		SECTION <u>RT 58</u>
		T <u>7</u> N R <u>10</u> E

TYPE MONUMENT P.K.NAIL


~~ON SURFACE~~ - BELOW 4"

LEFT - ℄ PAV'T - ~~RIGHT~~ 1.0'


9.3' TO LT EDGE PAVEMENT

S.L.M. 783+62.89

Grid: Northing: 683536.548 Easting: 1642844.690

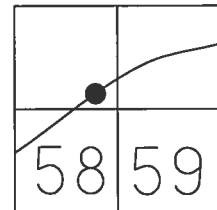

RECORD:
 STA.781+58
 FD PK NAIL
 1984
 SET PK/WASHER
 10-19-84, SWH
 FD P.K./WASHER
 5/23/95, SAH
 SET PK/WASHER
 8-8-95, SAH
 FD P.K./WASHER
 REFR24
 9/19/12, SAH
 FD P.K.NAIL
 0.4' DOWN
 REFR24
 6-23-14, JLL
 SET MAG/WASHER
 08-03-15, JLL

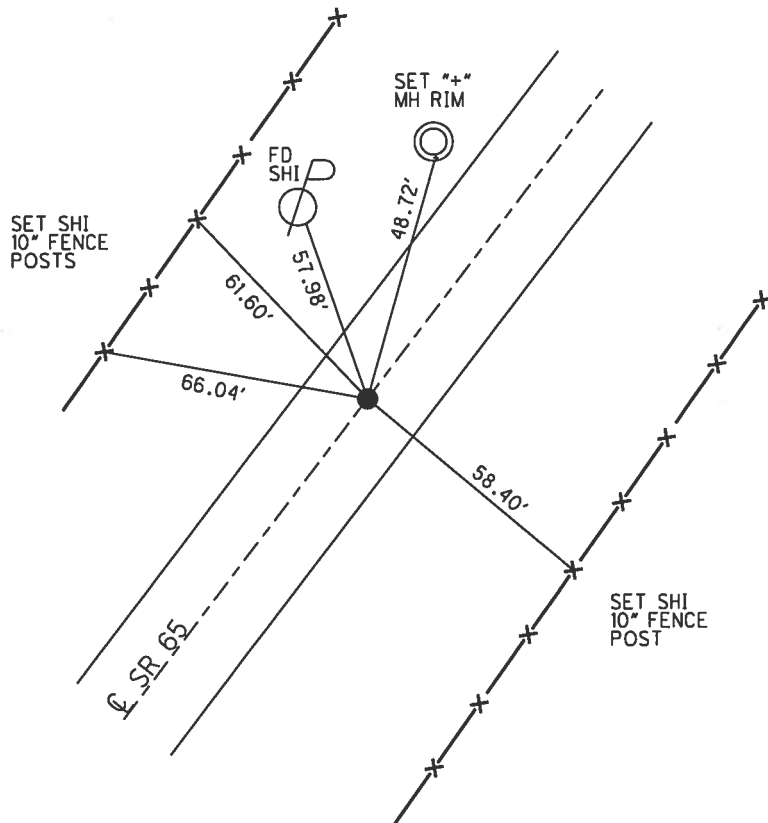


O.D.O.T. DISTRICT 2 SURVEY OFFICE (USE ONLY)

PERSONNEL _____ REFERENCE NO. 24 S SHEET 36 OF 44


NOTES HOMAN DATE 6-23-14 ROUTE SR 65
H.C. LEU WEATHER SUNNY COUNTY WOOD
R.C. THOMAS TEMP. 80°F TOWNSHIP PERRYSBURG
SECTION RT 59
T 7 N R 10 E

TYPE MONUMENT PK/WASHER
ON SURFACE - ~~BELOW~~ ON
LEFT - Q PAV'T - RIGHT ON
17.2' TO LT EDGE PAVEMENT
S.L.M. 788+28.91

Grid: Northing: 683878.076 Easting: 1643161.760

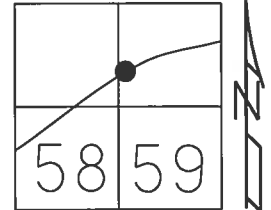

RECORD:
STA. 786+25
FD SM.R.R.SPIKE
1984
SET PK/WASHER
10-19-84, SWH
FD SM.R.R.SPIKE
5/23/95, SAH
FD SM.R.R.SPIKE
REFS24
9/21/12, SAH
6-23-14, JLL
SET MAG/WASHER
08-03-15, JLL

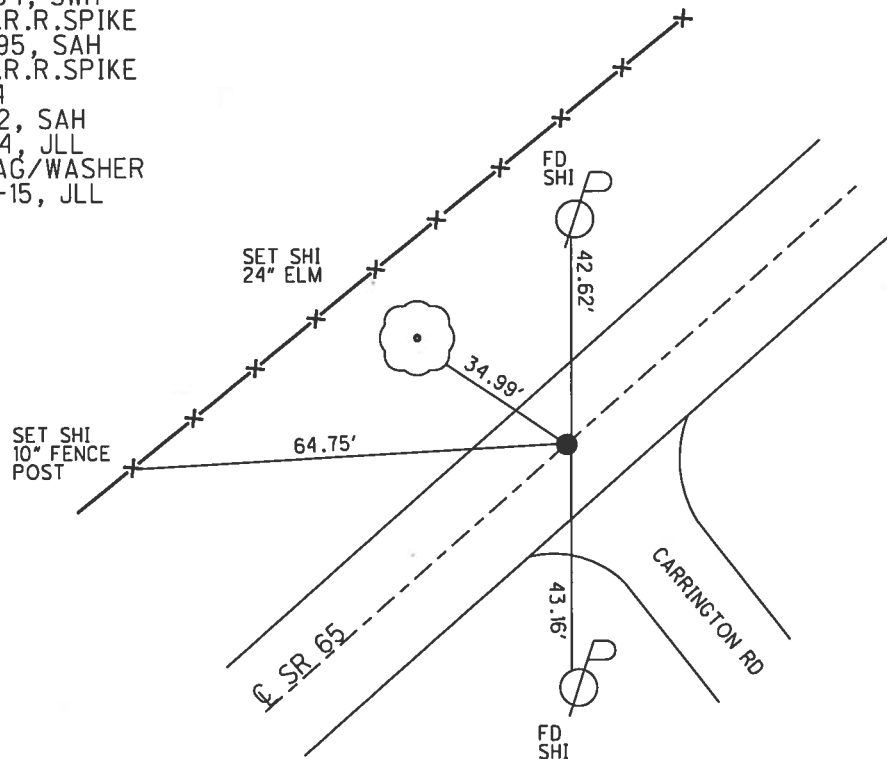

O.D.O.T. DISTRICT 2 SURVEY OFFICE (USE ONLY)

PERSONNEL

REFERENCE NO.

24 T

SHEET

37

OF 44

NOTES HOMAN

DATE

6-23-14

ROUTE SR 65

H.C. LEU

WEATHER

CLEAR

COUNTY WOOD

R.C. THOMAS

TEMP.

80°F

TOWNSHIP PERRYBURG

SECTION RT 59

T 7 N R 10 E

TYPE MONUMENT 3/4" IPIN


ON SURFACE - ~~BELOW~~ ON

LEFT - Q PAV'T - ~~RIGHT~~ 34.47'

34.30' LT TO LT EDGE PAVEMENT

S.L.M. 797+72.43

Grid: Northing: 684568.984 Easting: 1643804.316

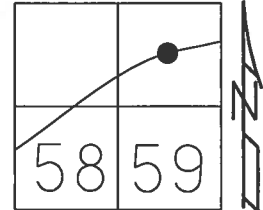

RECORD: P.I.

1924 PLAN

STA 164+17

$\Delta = 32^\circ 48'$

D = 8°00'

R = 716.78

T = 210.95

L = 410.00

FD 3/4" IPIN


1/31/90, MB

FD 3/4" IPIN

REFT24

9/21/12, SAH

6-23-14, JLL

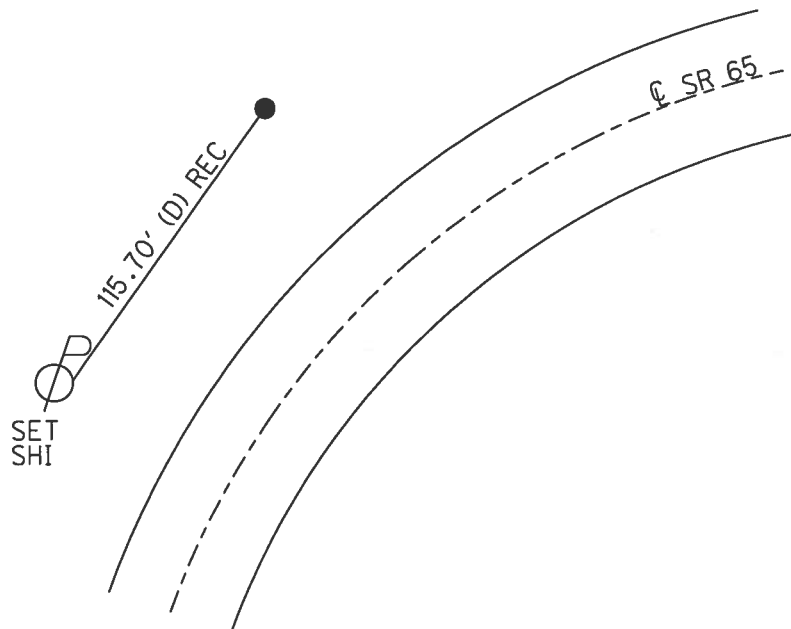

O.D.O.T. DISTRICT 2 SURVEY OFFICE (USE ONLY)

PERSONNEL _____ REFERENCE NO. 24 U SHEET 38 OF 44

NOTES HOMAN DATE 6-23-14 ROUTE SR 65

H.C. LEU WEATHER SUNNY COUNTY WOOD

R.C. THOMAS TEMP. 80°F TOWNSHIP PERRYSBURG

SECTION RT 60

T 7 N R 10 E

TYPE MONUMENT P.K.NAIL


ON SURFACE - ~~BELOW~~ ON

~~LEFT~~ - Q PAV'T - RIGHT 0.5'


9.7' TO RT EDGE PAVEMENT

S.L.M. 802+92

Grid: Northing: 684700.324 Easting: 1644318.945

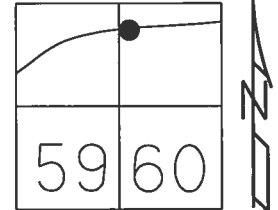

SET BY FARNAHM & WIRRES
 RECORD:
 STA. 800+88
 FD P.K.NAIL
 SET P.K./WASHER
 10-19-84, SWH
 FD P.K./WASHER
 5/23/95, SAH
 SET PK/WASHER
 8-8-95, SAH
 FD P.K./WASHER
 REFU24
 9/21/12, SAH
 6-23-14, JLL
 SET MAG/WASHER
 08-03-15, JLL

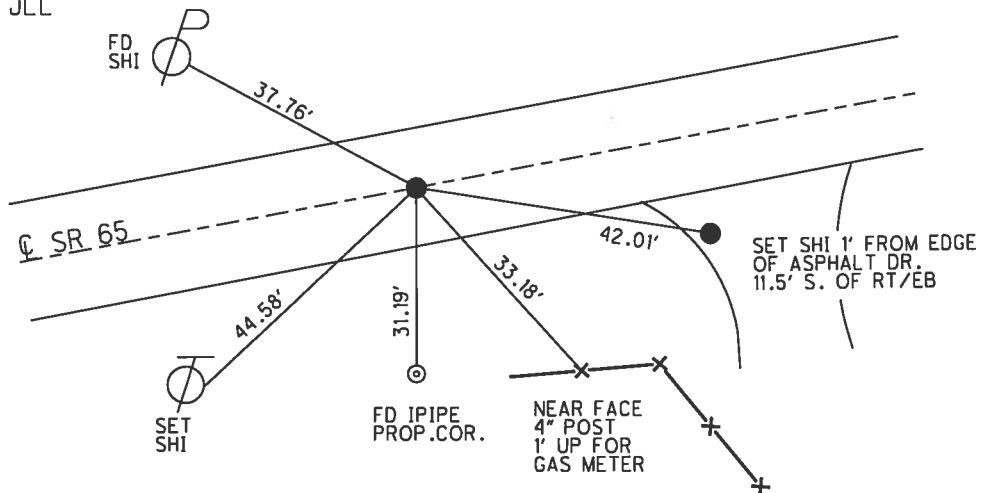

O.D.O.T. DISTRICT 2 SURVEY OFFICE (USE ONLY)

PERSONNEL _____ REFERENCE NO. 24 V SHEET 39 OF 44
 NOTES HOMAN DATE 6-23-14 ROUTE SR 65
 H.C. LEU WEATHER CLOUDY COUNTY WOOD
 R.C. THOMAS TEMP. 80°F TOWNSHIP PERRYSBURG
 _____ SECTION RT 60
 _____ T 7 N R 10 E

TYPE MONUMENT P.K./WASHER


~~ON SURFACE~~ - BELOW 1.5"

~~LEFT~~ - Q PAV'T - RIGHT 0.5


9.5' TO RT EDGE PAVEMENT

S.L.M. 804+67.42

Grid: Northing: 684743.628 Easting: 1644488.942

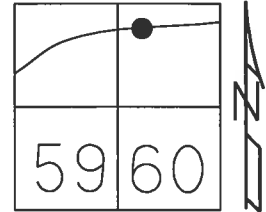

RECORD:
 STA. 802+63
 FD P.K.NAIL
 SET P.K./WASHER
 10-19-84, SWH
 FD P.K./WASHER
 5/23/95, SAH
 SET PK/WASHER
 8-8-95, SAH
 FD P.K./WASHER
 REFV24
 9/21/12, SAH
 6-23-14, JLL
 SET MAG/WASHER
 08-03-15, JLL

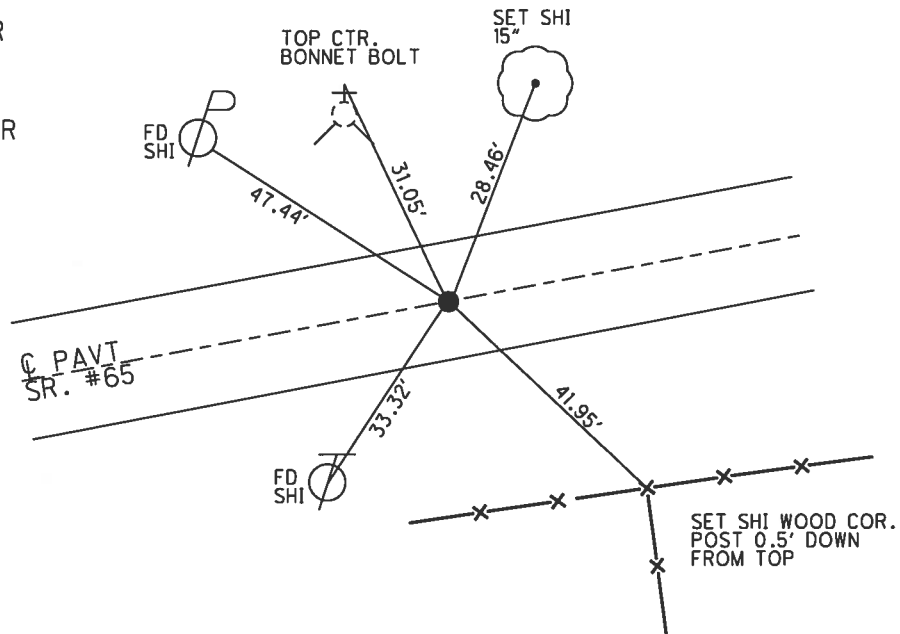


O.D.O.T. DISTRICT 2 SURVEY OFFICE (USE ONLY)

PERSONNEL _____ REFERENCE NO. 25 SHEET 40 OF 44


NOTES STONE _____ DATE 08-04-80 ROUTE SR 65
H.C. HICHALAK WEATHER WARM COUNTY WOOD
R.C. NAUSSK TEMP. 80°F TOWNSHIP PERRYSBURG
CURTIS SECTION RT 61
T 7 N R 10 E

TYPE MONUMENT 1" IPIN
ON SURFACE - ~~BELOW~~ ON
~~LEFT~~ - CL PAV'T - RIGHT 21.5'
1.87' RT TO RT EDGE PAVEMENT
S.L.M. 815+15.41

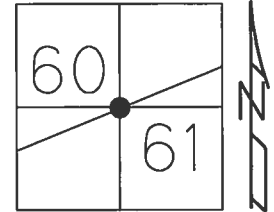

Grid: Northing: 685001.5948 Easting: 1645504.6853

RECORD:
STA. 812+66.9
BR#WOO 65 1539
FD 1" IPIN
8-04-80
FD 1" IPIN
5-9-84, SWH
FD IPIN
DOWN EMBANKMENT
BY BRIDGE
REF25
9/21/12, SAH

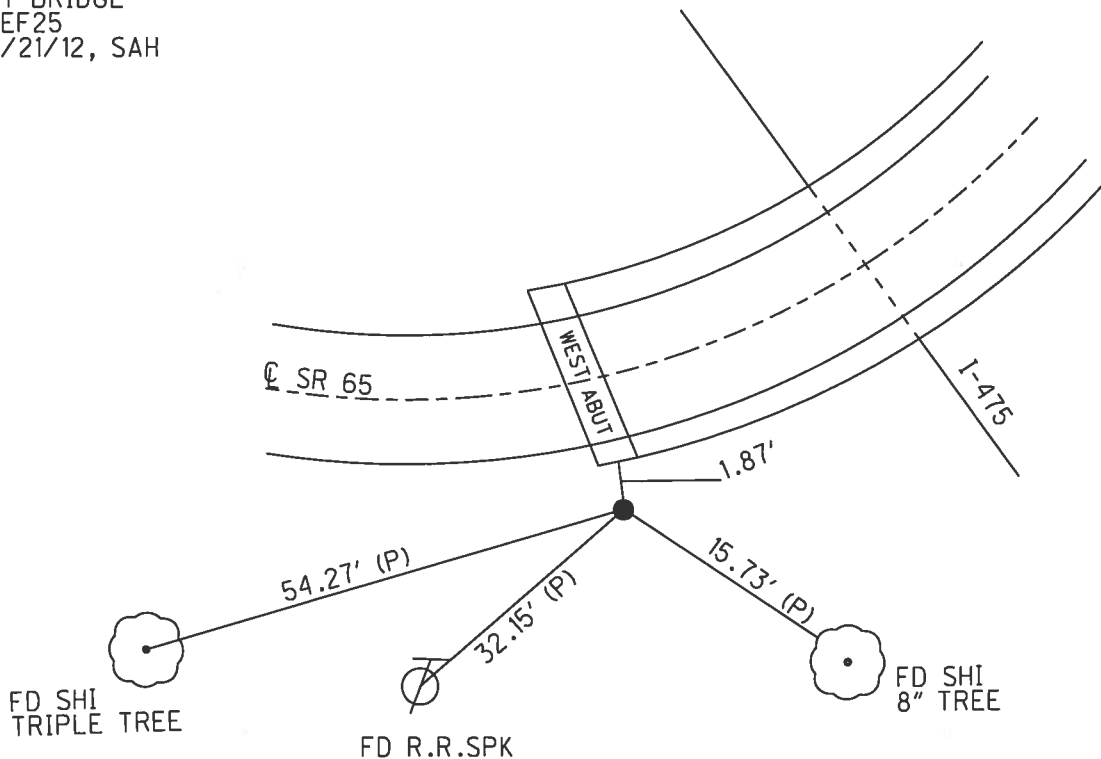

O.D.O.T. DISTRICT 2 SURVEY OFFICE (USE ONLY)

PERSONNEL

REFERENCE NO. 25 A

SHEET 41 OF 44

NOTES LEU

DATE 08-14-14

ROUTE SR 65

H.C. HOMAN

WEATHER SUNNY

COUNTY WOOD

R.C. WESTFALL

TEMP. 65°F

TOWNSHIP PERRYSBURG

SECTION RT 61

T 7 N R 10 E

TYPE MONUMENT P.K.NAIL


~~ON SURFACE~~ - BELOW 2"

~~LEFT~~ - Q PAV'T - RIGHT 1.3"

9.2' TO RT EDGE PAVEMENT

S.L.M. 818+95.83

Grid: Northing: 685155.319 Easting: 1645852.655

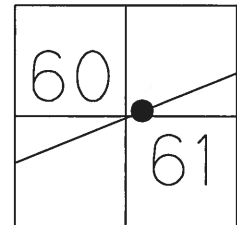

RECORD:

SLM 816+90

FD NAIL

STA. 816+48.5

11/5/84

FD P.K./WASHER

5/23/95, SAH

SET P.K./WASHER

8-8-95, SAH

FD P.K.NAIL


2" DOWN

REFA25

8-14-14, JLL

SET MAG/WASHER


8-3-15, DCH

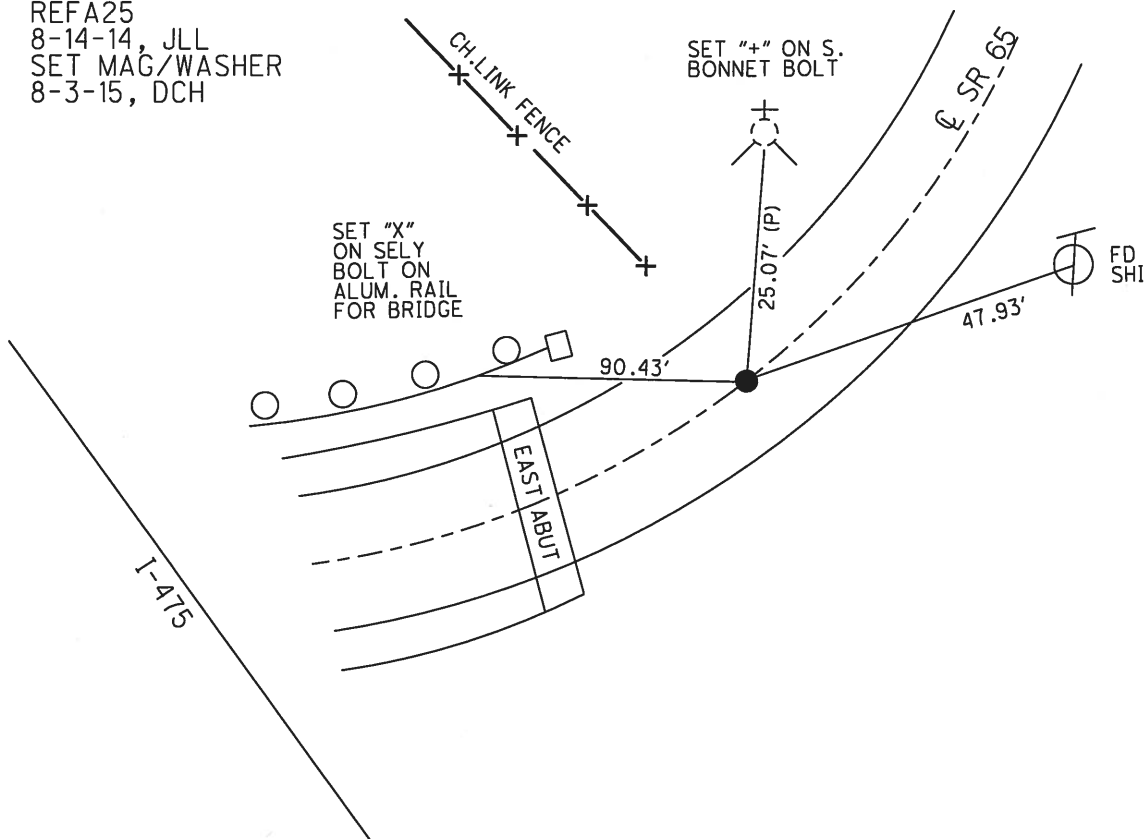

O.D.O.T. DISTRICT 2 SURVEY OFFICE (USE ONLY)


PERSONNEL	REFERENCE NO. <u>25 B</u>	SHEET <u>42</u> OF <u>44</u>
NOTES <u>LEU</u>	DATE <u>08-14-14</u>	ROUTE <u>SR 65</u>
H.C. <u>HOMAN</u>	WEATHER <u>SUNNY</u>	COUNTY <u>WOOD</u>
R.C. <u>WESTFALL</u>	TEMP. <u>65°F</u>	TOWNSHIP <u>PERRYSBURG</u>
		SECTION <u>61</u>
		T <u>7</u> N R <u>10</u> E

TYPE MONUMENT P.K.NAIL
 ON SURFACE - ~~BELOW~~ ON
~~LEFT~~ - CL PAV'T - RIGHT 0.7'
10.5' TO RT EDGE PAVEMENT
 S.L.M. 820+72.62

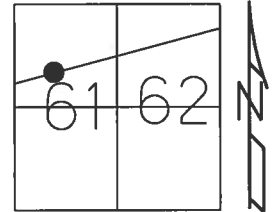

Grid: Northing: 685225.978 Easting: 1646014.710

RECORD:
 SLM 818+69
 FD P.K./WASHER
 5/19/95, SAH
 SET P.K./WASHER
 8-8-95, SAH
 FD P.K.NAIL
 REFB25
 9/21/12, SAH
 08-14-14, JLL
 SET MAG/WASHER
 8-3-15, DCH

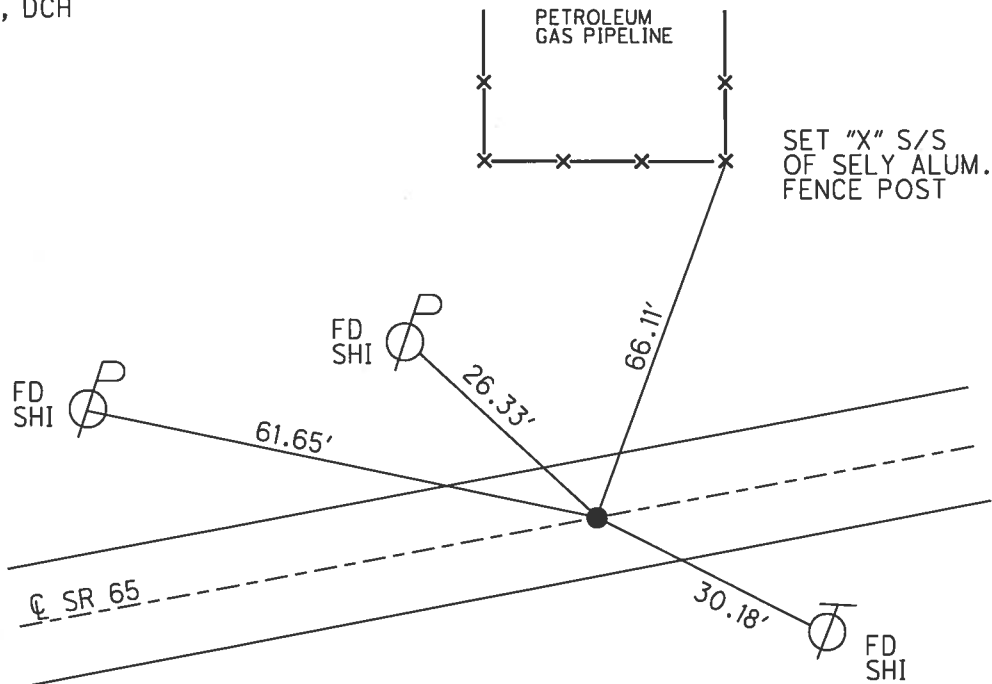

O.D.O.T. DISTRICT 2 SURVEY OFFICE (USE ONLY)

PERSONNEL

REFERENCE NO.

26 SHEET 43 OF 44

NOTES LEU

DATE 8-14-14

ROUTE SR 65

H.C. HOMAN

WEATHER SUNNY

COUNTY WOOD

R.C. WESTFALL

TEMP. 70°F

TOWNSHIP PERRYSBURGSECTION RT 62T 7 N R 10 E

TYPE MONUMENT R.R.SPIKE


~~ON SURFACE~~ - BELOW 3"

LEFT - C PAV'T - ~~RIGHT~~ 2.7'

9.6' TO LT EDGE PAVEMENT


S.L.M. 829+95.04

Grid: Northing: 685594.776 Easting: 1646860.198

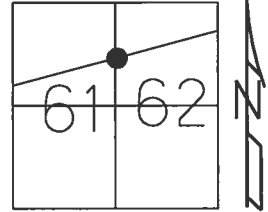

NOTE: DIST. 26-26A= 0.96'

RECORD: P.I.
STA. 827+48.71
FD R.R.SPIKE
ORIGIN UNKNOWN
 $\Delta=7^{\circ}31'20''$
FD P.K./WASHER
5/19/95, SAH
SET PK/WASHER
8-8-95, SAH
FD P.K.SHANK
REF26
9/21/12, SAH
FD P.K./WASHER
REF26
8-14-14, JLL
SET MAG/WASHER
8-03-15, JLL

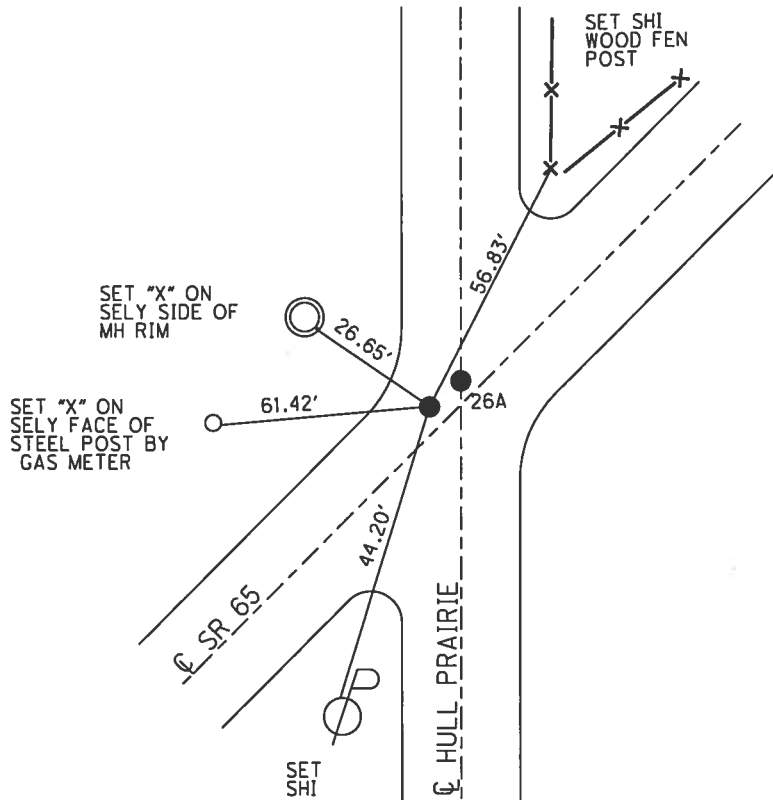

O.D.O.T. DISTRICT 2 SURVEY OFFICE (USE ONLY)

PERSONNEL

REFERENCE NO.

26 AB

SHEET

44

OF 44

NOTES

LEU

DATE

08-14-14

ROUTE

SR 65

H.C.

HOMAN

WEATHER

SUNNY

COUNTY

WOOD

R.C.

WESTFALL

TEMP.

70°F

TOWNSHIP

PERRYSBURG

SECTION

RT 62

T 7 N

R 10 E

TYPE MONUMENT

P.K./WASHER

~~ON SURFACE~~ - BELOW

3"

LEFT - $\odot$ PAV'T - ~~RIGHT~~

2.7'


9.6 TO LT EDGE PAVEMENT

S.L.M.

829+96

Grid: Northing: 685595.141

Easting: 1646861.046

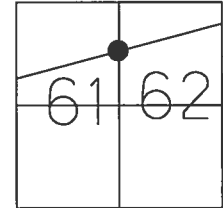

NOTE: DIST. 26-26A= 0.96'

RECORD:

FD P.K.NAIL

FD P.K./WASHER

5/19/95, SAH

SET P.K./WASHER

8-8-95, SAH

FD P.K.SHANK

REFA26

9/21/12, SAH


FD P.K./WASHER

REFA26

8-14-14, JLL

SET MAG/WASHER

08-03-15, JLL

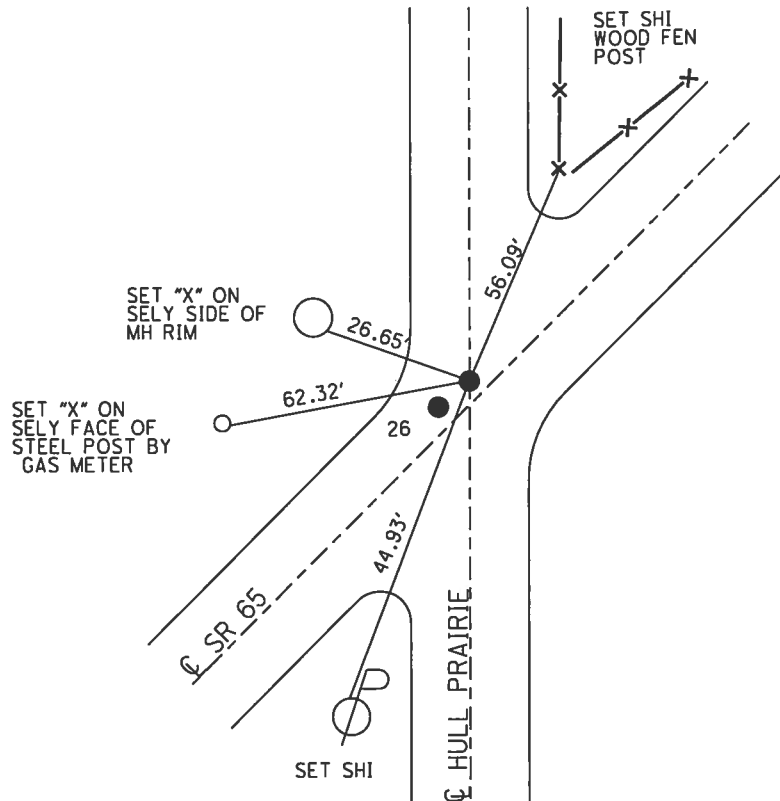

O.D.O.T. DISTRICT 2 SURVEY OFFICE (USE ONLY)

PERSONNEL

REFERENCE NO. 26 A SHEET 1 OF 25

NOTES BARNHISEL

DATE 5/19/95

ROUTE SR 65

H.C. CORDES

WEATHER SUNNY

COUNTY WOOD

R.C. BARNHISEL

TEMP. 78°

TOWNSHIP PERRYSBURG

SECTION RT 62

T 7 N R 10 E

TYPE MONUMENT P.K./WASHER


ON SURFACE - ~~BELOW~~ ON

~~LEFT~~ - CL PAV'T - RIGHT 6.7'


2.9' TO RT EDGE PAVEMENT

S.L.M. 834+39.41

Grid: Northing: 685717.762 Easting: 1647287.211

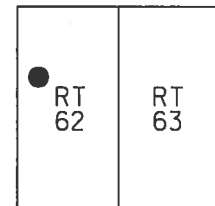

RECORD: P.I.
STA. 831+92.47
 $\Delta = 8^\circ 18' 40''$ LT
FD P.K.NAIL
FD P.K./WASHER
5/19/95, MB
SET P.K./WASHER
8/8/95, SAH
FD P.K.NAIL
REFB26
9/21/12, SAH
D.N.F. POINT
ALL TIES DESTROYED
SET MAG/WASHER
8/14/14, DCH

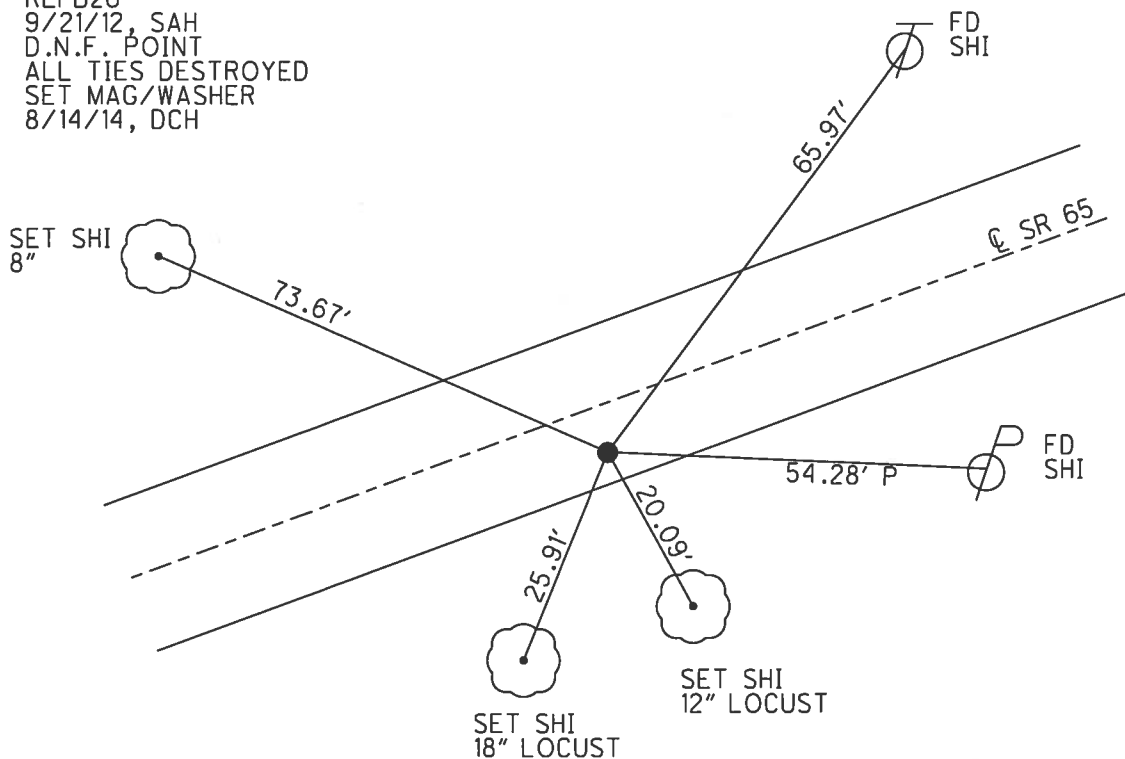

O.D.O.T. DISTRICT 2 SURVEY OFFICE (USE ONLY)

PERSONNEL

REFERENCE NO.

26 B

SHEET

2

OF 25

NOTES

LEU

DATE

8/14/14

ROUTE

SR 65

H.C.

HOMAN

WEATHER

SUNNY

COUNTY

WOOD

R.C.

WESTFALL

TEMP.

70°

TOWNSHIP

PERRYSBURG

SECTION

RT 62

T 7 N

R 10 E

TYPE MONUMENT

MONBOX

ON SURFACE - ~~BELOW~~

ON


~~LEFT~~ - C PAV'T - RIGHT 0.5'

9.4' TO RT EDGE PAVEMENT


S.L.M. 840+45.17


Grid: Northing: 685967.590

Easting: 1647839.470

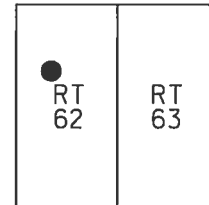

RECORD: P.I.
STA. 837+98.58
 $\Delta = 2^\circ 43' \text{ RT}$
FD P.K.NAIL
FD P.K./WASHER
5/19/95, MB
SET P.K./WASHER
8/8/95, SAH
FD MONBOX
COULD NOT OPEN
REFC26
9/21/12, SAH
SET "+" W/DIMPLE
ON LID
REFB26
8/14/14, DCH

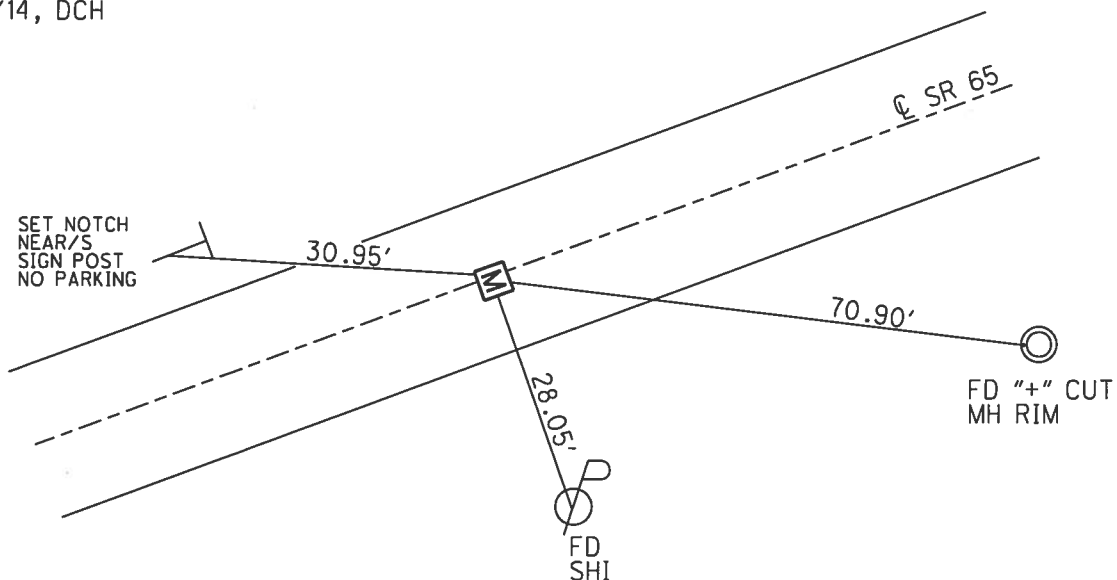

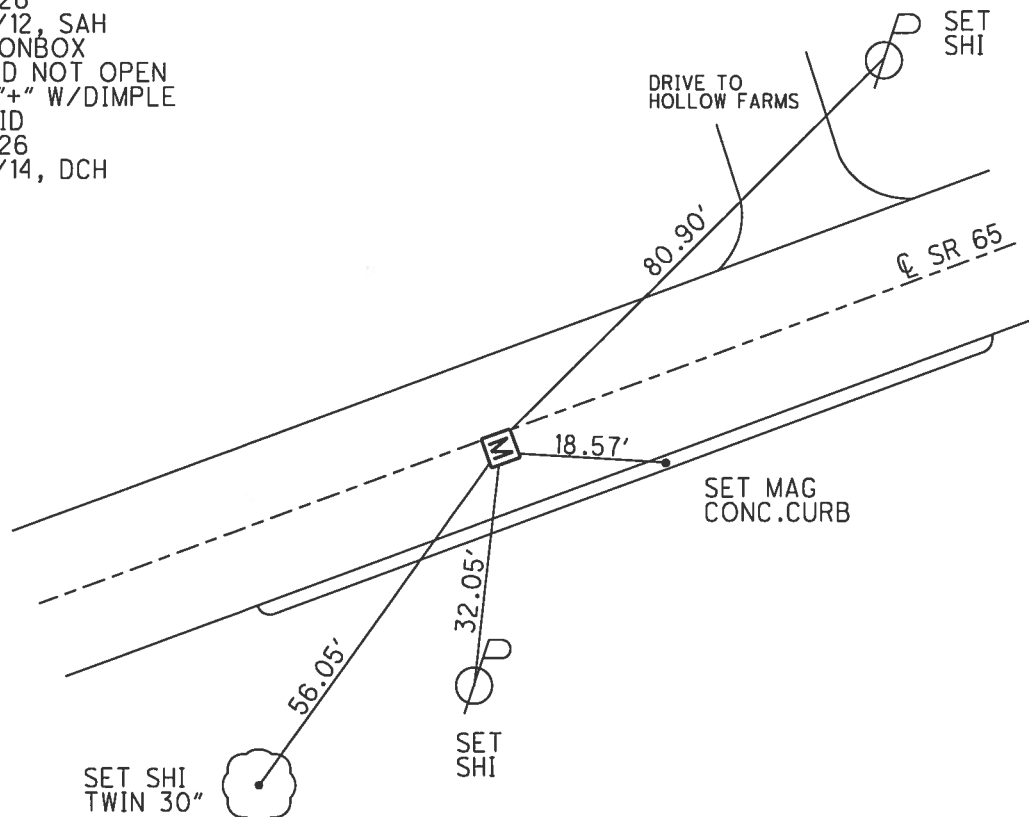

O.D.O.T. DISTRICT 2 SURVEY OFFICE (USE ONLY)

PERSONNEL

REFERENCE NO. 26 D

SHEET 4 OF 25

NOTES LEU

DATE 8/14/14

ROUTE SR 65

H.C. HOMAN

WEATHER SUNNY

COUNTY WOOD

R.C. WESTFALL

TEMP. 70°

TOWNSHIP PERRYSBURG

SECTION RT 62

T 7 N R 10 E

TYPE MONUMENT MONBOX


ON SURFACE - ~~BELOW~~ ON

~~LEFT~~ - CL PAV'T - RIGHT 1'


8.7' TO LT EDGE PAVEMENT

S.L.M. 845+13.97

Grid: Northing: 686131.867 Easting: 1648278.353

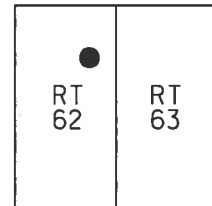

RECORD:
CORP. LINE
FD MONBOX
REFE26
9/21/12, SAH
FD MONBOX
REFD26
8/14/14, DCH

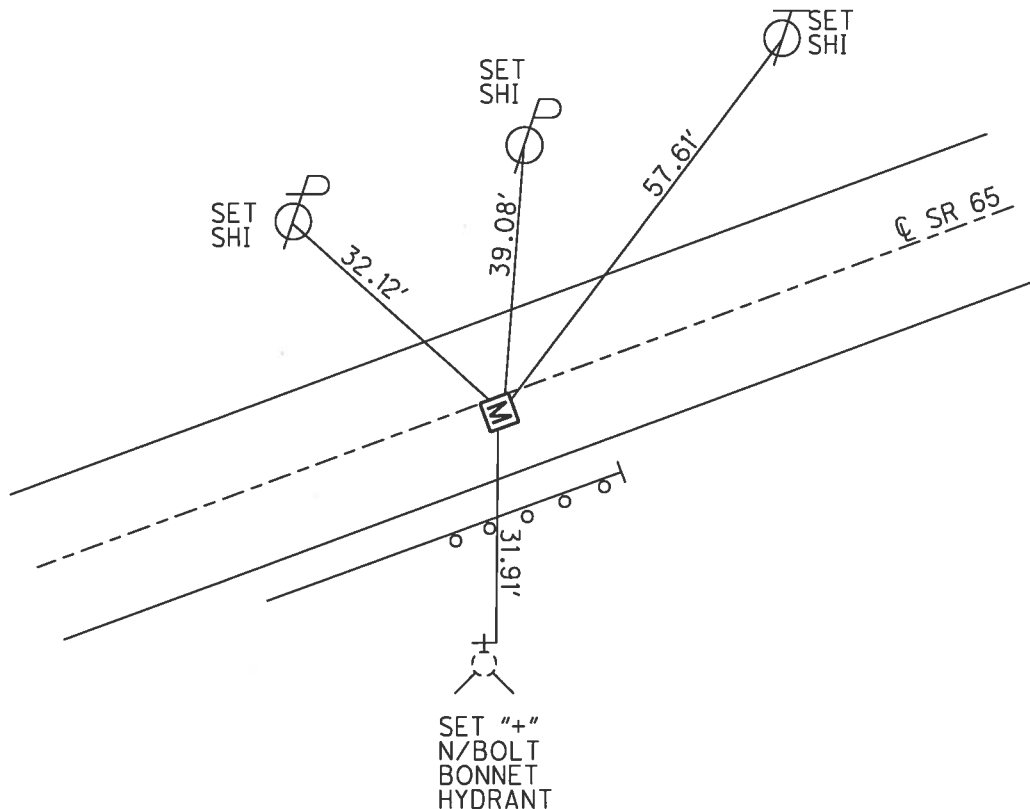


O.D.O.T. DISTRICT 2 SURVEY OFFICE (USE ONLY)


PERSONNEL	REFERENCE NO.	26 F	SHEET	5	OF	25
NOTES	LEU	DATE	8/14/14	ROUTE	SR 65	
H.C.	HOMAN	WEATHER	SUNNY	COUNTY	WOOD	
R.C.	WESTFALL	TEMP.	75°	TOWNSHIP	PERRYSBURG	
				SECTION	RT 63	
				T	7	N
				R	10	E

TYPE MONUMENT MONBOX
ON SURFACE - ~~BELOW~~ ON
~~LEFT~~ - CL PAV'T - RIGHT 11.4'
2' RT TO RT EDGE PAVEMENT
S.L.M. 848+74.69

Grid: Northing: 686231.465 Easting: 1648625.059

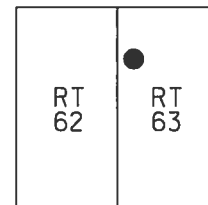

RECORD: P.I.
STA. 846+28.7
Δ = 20° 00' LT
FD P.K./WASHER
5/19/95, MB
SET P.K./WASHER
8/8/95, SAH
FD MONBOX
COULD NOT OPEN
REF26
9/21/12, SAH
FD MONBOX
COULD NOT OPEN
SET "+" W/DIMPLE
ON LID
REFE26
8/14/14, DCH

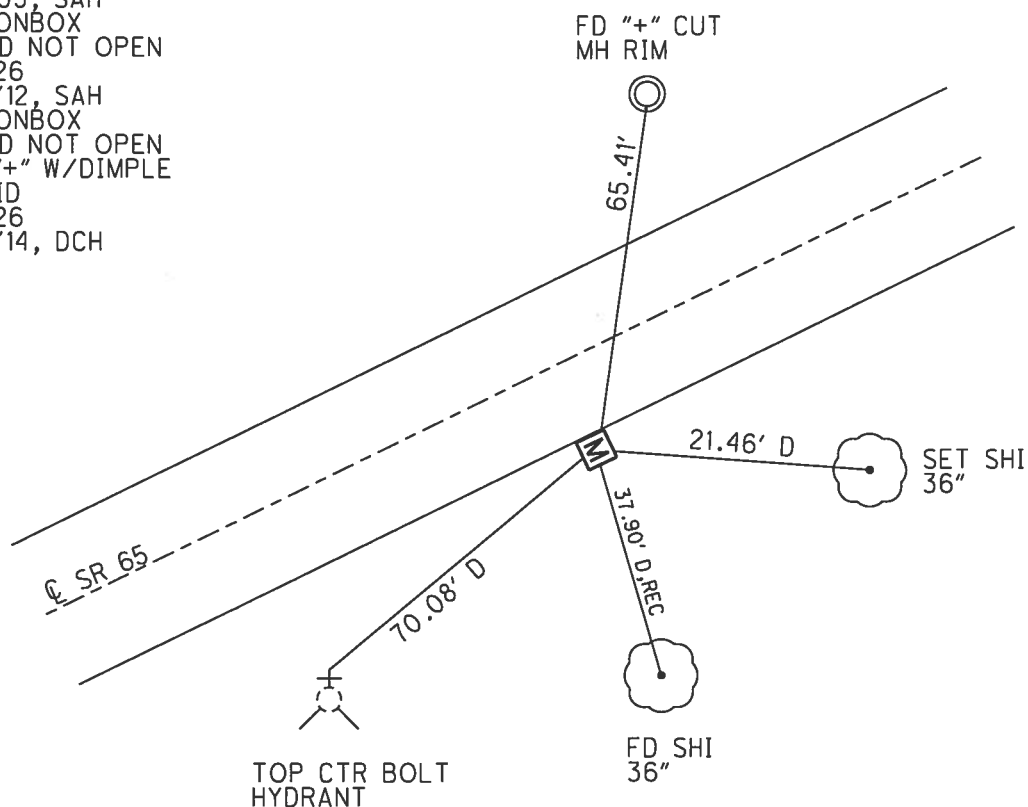

O.D.O.T. DISTRICT 2 SURVEY OFFICE (USE ONLY)

PERSONNEL

REFERENCE NO. 26 G SHEET 6 OF 25

NOTES LEU DATE 8/19/14 ROUTE SR 65
H.C. WESTFALL WEATHER SUNNY COUNTY WOOD
R.C. RHOADES TEMP. 70° TOWNSHIP PERRYSBURG
SECTION RT 63
T 7 N R 10 E

TYPE MONUMENT P.K.NAIL


~~ON SURFACE~~ - BELOW 3"

LEFT - CL PAV'T - ~~RIGHT~~ 1.5'


9.1' TO LT EDGE PAVEMENT

S.L.M. 850+48.42

Grid: Northing: 686333.602 Easting: 1648765.595

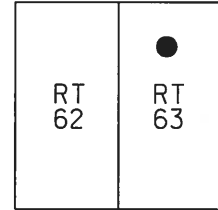

RECORD:
STA. 848+41
FD P.K./WASHER
ORIGIN UNKNOWN
5/19/95, MB
SET P.K./WASHER
8/15/95, CL
FD P.K.SHANK
REFG26
9/24/12, SAH
FD P.K.NAIL
REFF26
8/19/14, EBW
SET MAG/WASHER
6/8/17, DCH

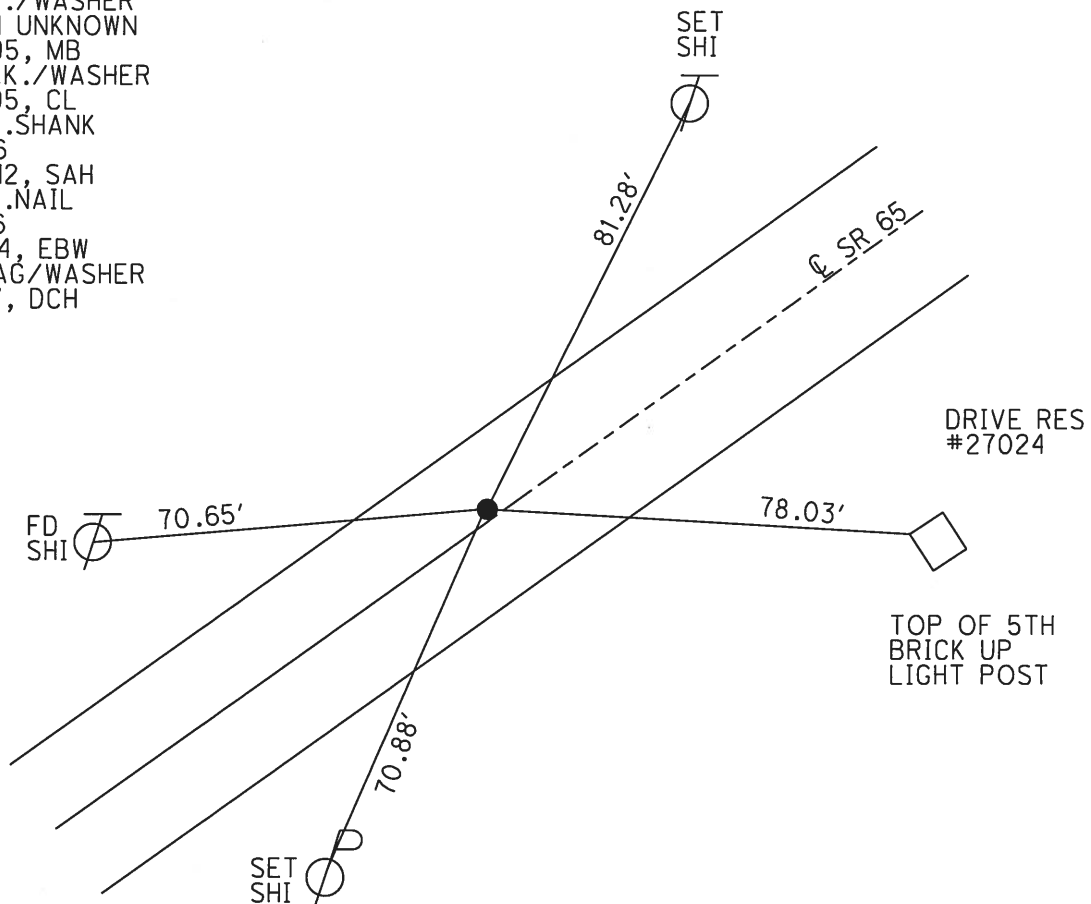

25

SR 65

WOOD

PERRYSBURG

RT 63

R 10 E

P.K./WASHER


ON

9.7'


MENT

$$860 + 11.08$$

Easting: 1649544.162

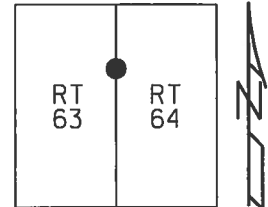

8/19/14, DCH

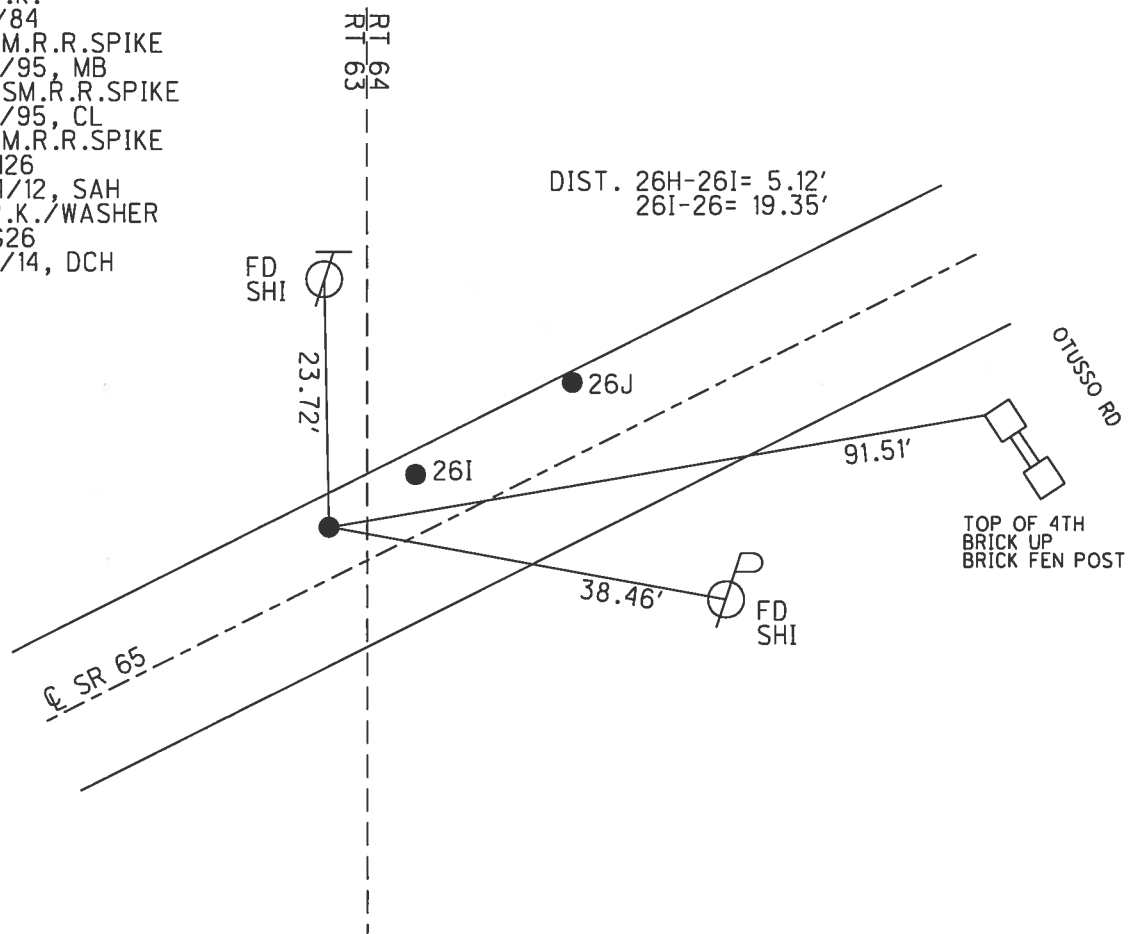


O.D.O.T. DISTRICT 2 SURVEY OFFICE (USE ONLY)

PERSONNEL _____ REFERENCE NO. 26 I SHEET 8 OF 25


NOTES LEU DATE 8/19/14 ROUTE SR 65
H.C. WESTFALL WEATHER SUNNY COUNTY WOOD
R.C. RHOADES TEMP. 70° TOWNSHIP PERRYSBURG
SECTION RT 64
T 7 N R 10 E

TYPE MONUMENT P.K.NAIL
ON SURFACE - ~~BELOW~~ ON
LEFT - CL PAV'T - ~~RIGHT~~ 10.9'
2.5' TO LT EDGE PAVEMENT
S.L.M. 860+16.18

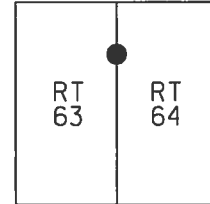

Grid: Northing: 686902.808 Easting: 1649548.255

RECORD:
FD P.K./WASHER
11/5/84
FD P.K./WASHER
5/19/95, MB
SET P.K./WASHER
8/15/95, CL
FD P.K.NAIL
REFI26
9/24/12, SAH
FD P.K.NAIL
REFH26
8/19/14, EBW
SET MAG/WASHER
6/8/17, DCH

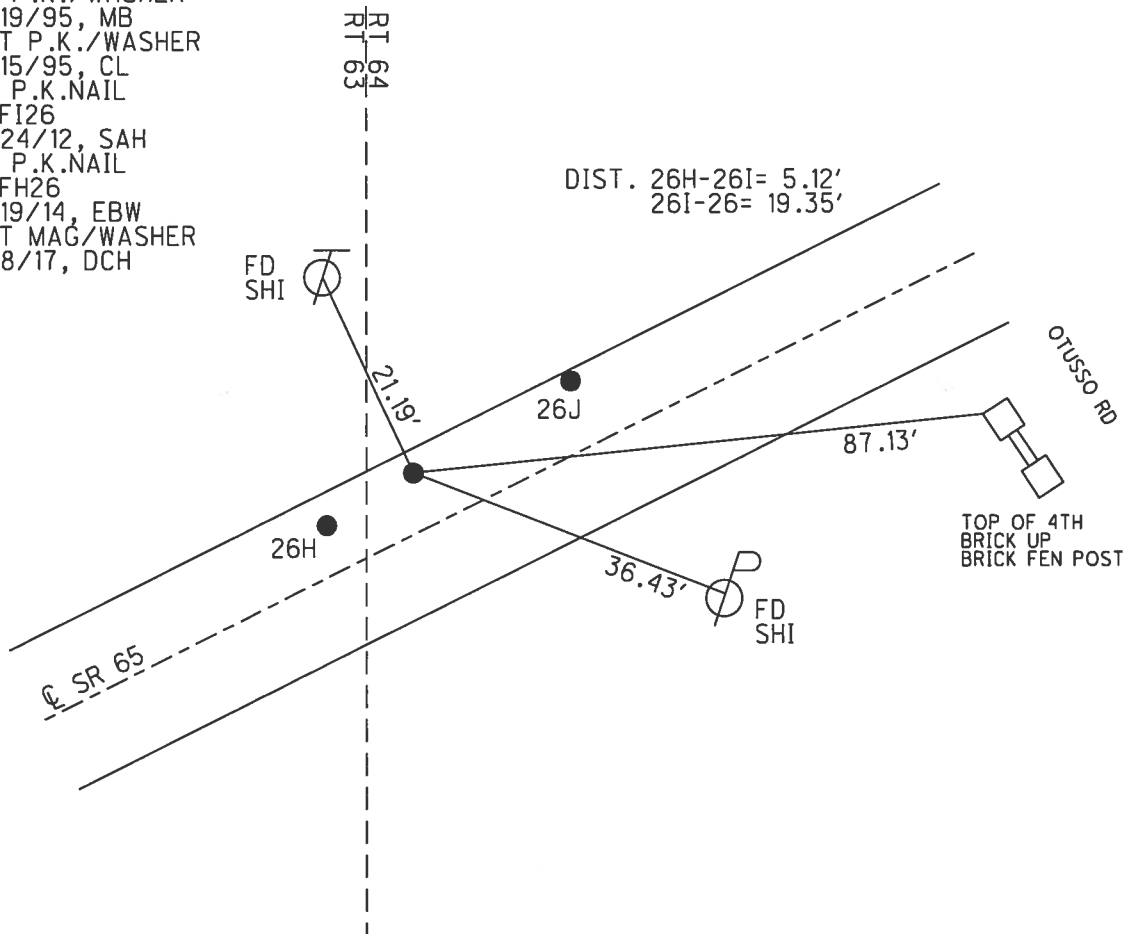

O.D.O.T. DISTRICT 2 SURVEY OFFICE (USE ONLY)

PERSONNEL _____ REFERENCE NO. 26 K SHEET 10 OF 25

NOTES LEU DATE 8/19/14 ROUTE SR 65

H.C. WESTFALL WEATHER SUNNY COUNTY WOOD

R.C. RHOADES TEMP. 70° TOWNSHIP PERRYSBURG

SECTION RT 64

T 7 N R 10 E

TYPE MONUMENT P.K.SHANK


ON SURFACE - ~~BELOW~~ ON

LEFT - CL PAV'T - RIGHT ON


11.0' TO RT EDGE PAVEMENT

S.L.M. 863+45.66

Grid: Northing: 687048.538 Easting: 1649843.424

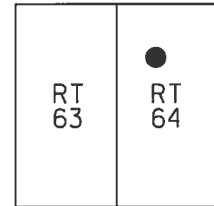


RECORD: P.O.T.
STA. 860+99.72
FD LG.R.R.SPIKE
11/5/84
FD P.K./WASHER
ATOP LG.R.R.SPIKE
3" DOWN
5/19/95, MB
SET P.K./WASHER
8/15/95, CL
FD P.K./WASHER
REFK26
9/24/12, SAH
FD P.K.SHANK
REFK26
8/19/14, EBW
SET MAG/WASHER
6/8/17, DCH

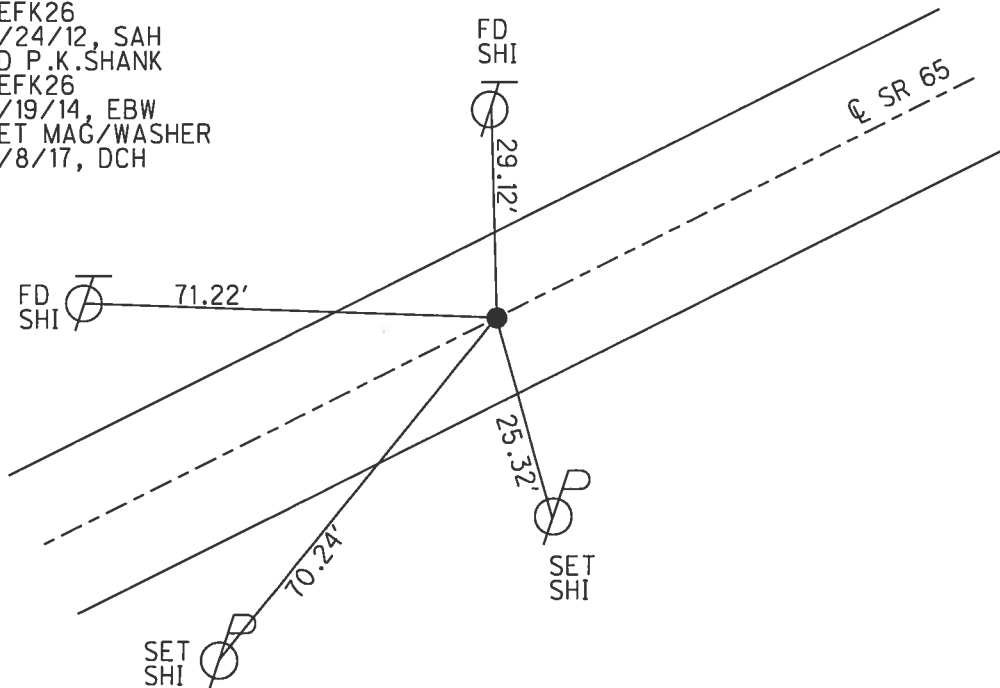


O.D.O.T. DISTRICT 2 SURVEY OFFICE (USE ONLY)

PERSONNEL _____ REFERENCE NO. 26 L SHEET 11 OF 25
 NOTES LEU DATE 8/19/14 ROUTE SR 65
 H.C. WESTFALL WEATHER SUNNY COUNTY WOOD
 R.C. RHOADES TEMP. 70° TOWNSHIP PERRYSBURG
 _____ SECTION RT 64
 _____ T 7 N R 10 E

TYPE MONUMENT P.K.SHANK
~~ON SURFACE~~ - BELOW 3"
~~LEFT~~ - CL PAV'T - RIGHT 0.5'
10.9' TO LT EDGE PAVEMENT
 S.L.M. 865+48.62
 Grid: Northing: 687136.592 Easting: 1650026.290

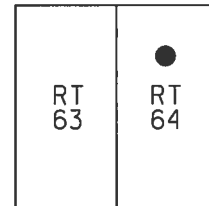

RECORD: P.O.T.
 STA. 863+02.79
 FD P.K./WASHER
 5/19/95, MB
 SET P.K./WASHER
 8/15/95, CL
 FD P.K./WASHER
 REFL26
 9/24/12, SAH
 FD P.K.SHANK
 3" DOWN
 REFGG26
 8/19/14, EBW
 SET MAG/WASHER
 6/8/17, DCH

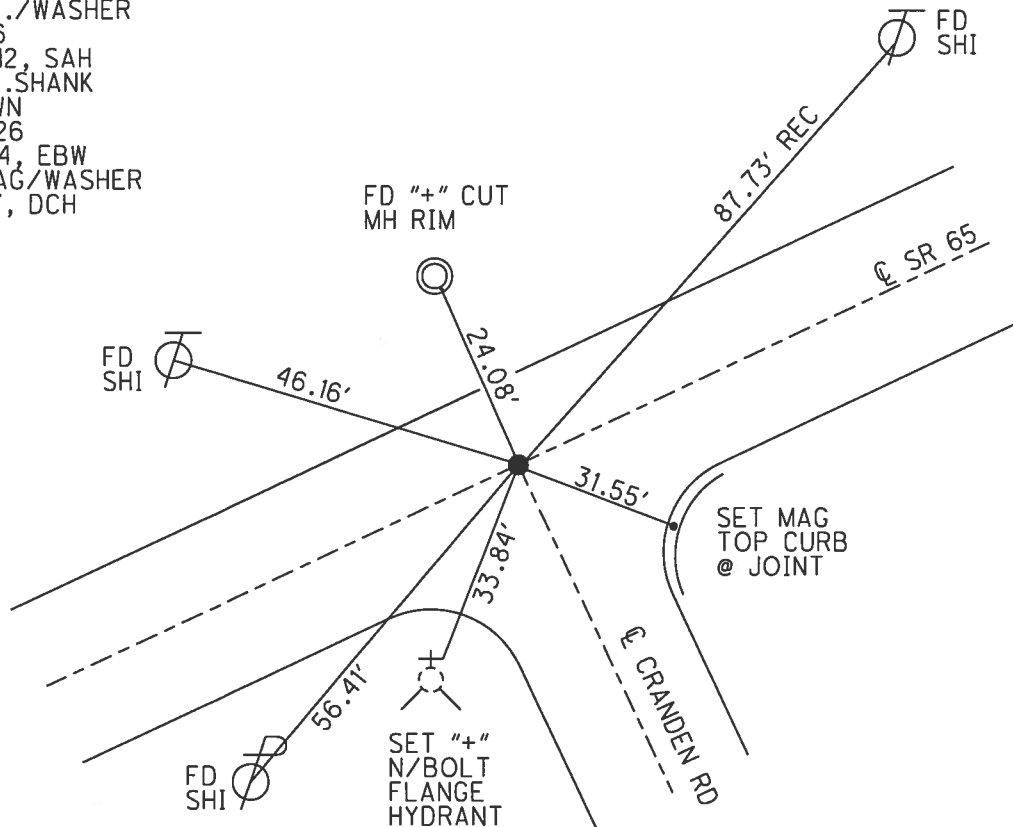

O.D.O.T. DISTRICT 2 SURVEY OFFICE (USE ONLY)

PERSONNEL _____ REFERENCE NO. 26 N SHEET 12 OF 25
 NOTES LEU DATE 8/19/14 ROUTE SR 65
 H.C. WESTFALL WEATHER SUNNY COUNTY WOOD
 R.C. RHOADES TEMP. 72° TOWNSHIP PERRYSBURG
 SECTION RT 64
 T 7 N R 10 E

TYPE MONUMENT R.R.SPIKE


ON SURFACE - ~~BELOW~~ ON _____

~~LEFT~~ - C PAV'T - RIGHT 1.7'

8.3' TO RT EDGE PAVEMENT


S.L.M. 870+64.49

Grid: Northing: 687360.177 Easting: 1650491.196

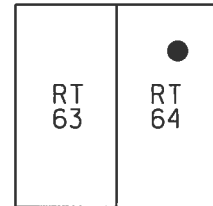

RECORD: P.O.T.
 STA. 868+18.86
 FD P.K.NAIL
 5/10/84, CL
 SET P.K./WASHER
 11/5/84, CL
 PIPE CONSTRUCTION
 DESTROYED POINT
 AND TIES, 5/19/95
 FD LG.R.R.SPIKE
 W/ "+" CUT
 REF26
 9/24/12, SAH
 FD R.R.SPIKE
 8/19/14, EBW
 SET MAG/WASHER
 6/8/17, DCH

DIST. 26M-26N= 180.61'

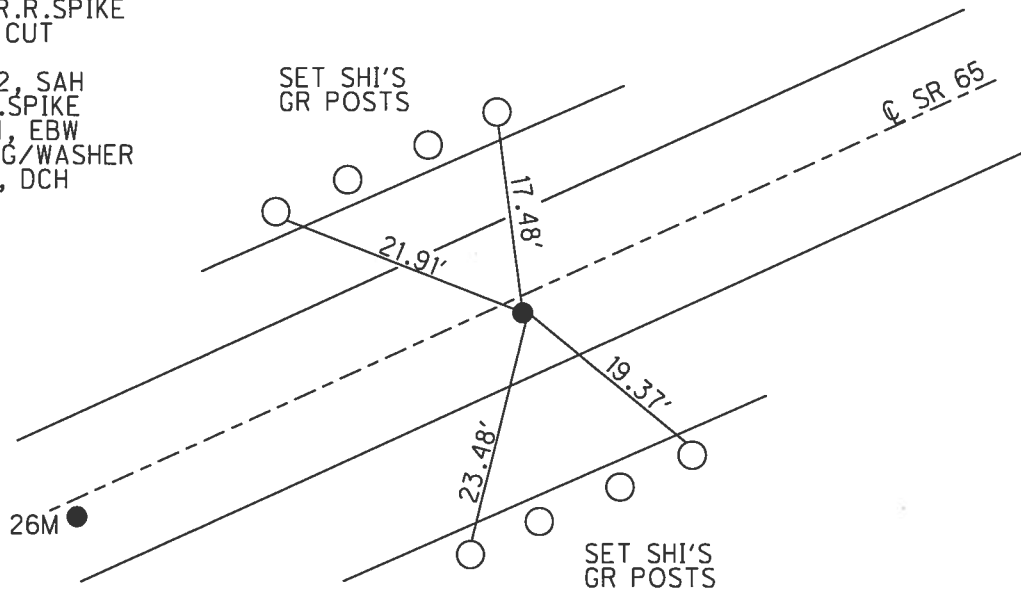

REF 26 M
 ORIGIN UNKNOWN
 FD LR.R.R.SPIKE
 W/ "+" CUT
 REFM26
 9/24/12, SAH
 STA. 686+83.88
 N: 687281.755
 E: 1650328.498

DIST. 260-26P= 109.98'
26P-26Q= 10.11'

O.D.O.T. DISTRICT 2 SURVEY OFFICE (USE ONLY)

PERSONNEL

REFERENCE NO.

26 R

SHEET

14

OF 25

NOTES

LEU

DATE

8/19/14

ROUTE

SR 65

H.C.

WESTFALL

WEATHER

SUNNY

COUNTY WOOD

R.C.

RHOADES

TEMP.

72°

TOWNSHIP

PERRYSBURG

SECTION

RT 64

T 7 N R 10 E

TYPE MONUMENT MAG NAIL


~~ON SURFACE~~ - BELOW 2"

~~LEFT~~ - CL PAV'T - RIGHT 1.7'


7.9' TO RT EDGE PAVEMENT

S.L.M. 875+58.45

Grid: Northing: 687574.349 Easting: 1650936.303

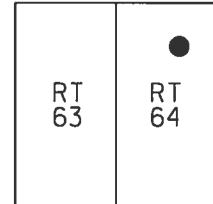

RECORD: P.I.
STA. 873+13.01
 $\Delta = 0^\circ 06' 40''$ LT
FD BOAT SPIKE
5/10/84, SAH
FD P.K./WASHER
5/18/95, SAH
SET P.K./WASHER
8/15/95, CL
FD P.K./WASHER
REFR26
9/24/12, SAH
FD P.K./WASHER
REFJJ26
8/19/14, EBW
SET MAG/WASHER
6/8/17, DCH

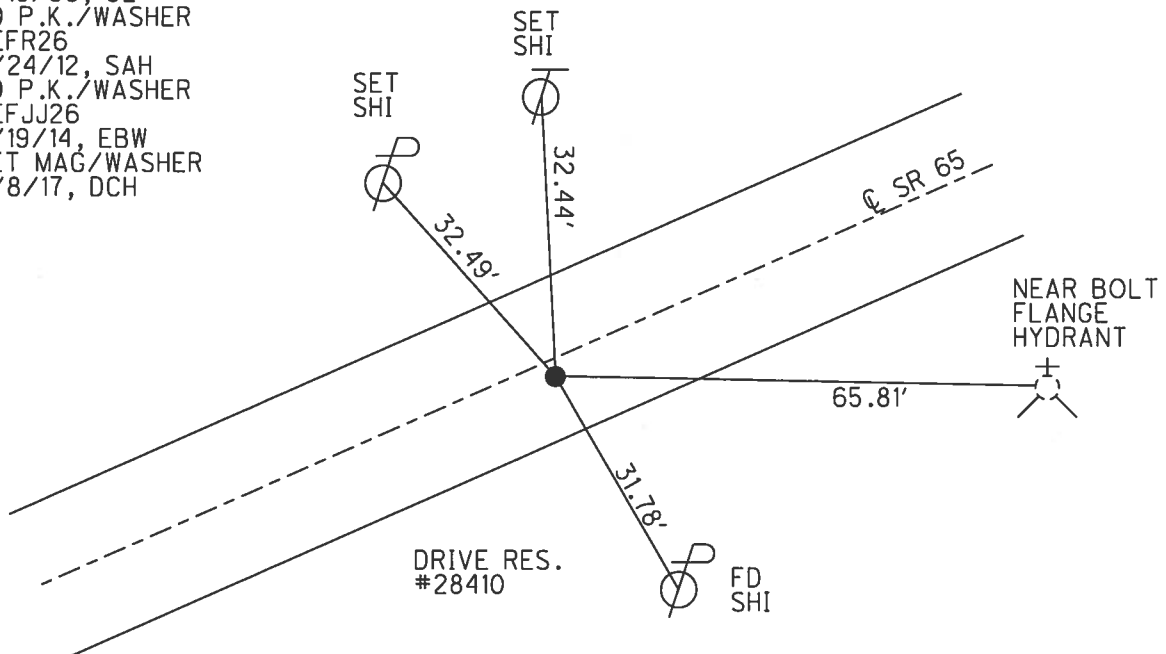


O.D.O.T. DISTRICT 2 SURVEY OFFICE (USE ONLY)

PERSONNEL _____ REFERENCE NO. 26 S SHEET 15 OF 25


NOTES LEU DATE 8/19/14 ROUTE SR 65
H.C. WESTFALL WEATHER SUNNY COUNTY WOOD
R.C. RHOADES TEMP. 75° TOWNSHIP PERRYSBURG
SECTION RT 64
T 7 N R 10 E

TYPE MONUMENT P.K./WASHER
ON SURFACE - ~~BELOW~~ ON _____
~~LEFT~~ - CL PAV'T - RIGHT 3'
6.9' TO RT EDGE PAVEMENT
S.L.M. 882+14.29

Grid: Northing: 687857.622 Easting: 1651527.816

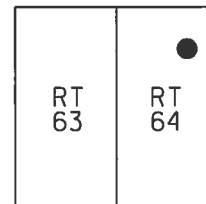

RECORD:
FD P.K./WASHER
5/10/84, SAH
FD P.K./WASHER
5/18/95, SAH
SET P.K./WASHER
8/15/95, CL
FD P.K./WASHER
REFS26
9/24/12, SAH
FD P.K./WASHER
REFKK26
8/19/14, EBW
SET MAG/WASHER
6/8/17, DCH

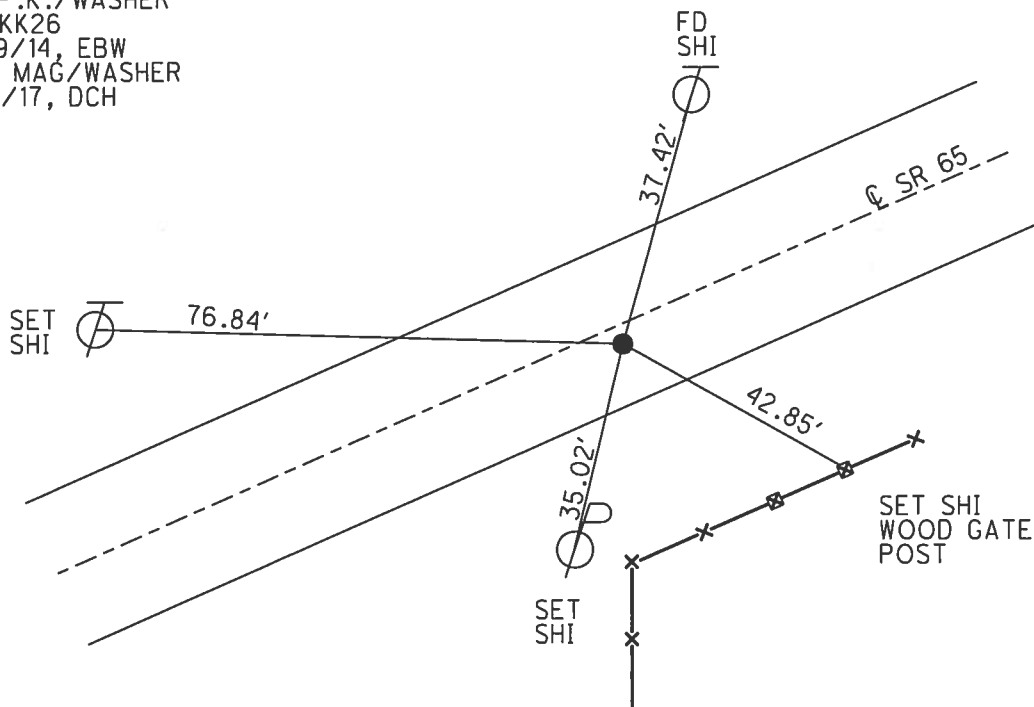


O.D.O.T. DISTRICT 2 SURVEY OFFICE (USE ONLY)


PERSONNEL _____ REFERENCE NO. 26 T SHEET 16 OF 25
NOTES LEU DATE 8/19/14 ROUTE SR 65
H.C. WESTFALL WEATHER SUNNY COUNTY WOOD
R.C. RHOADES TEMP. 70° TOWNSHIP PERRYSBURG
SECTION RT 64
T 7 N R 10 E

TYPE MONUMENT MONBOX
ON SURFACE - ~~BELOW~~ ON
LEFT - Q PAV'T - RIGHT ON
9.9' TO RT EDGE PAVEMENT
S.L.M. 885+11.60

Grid: Northing: 687989.256 Easting: 1651794.392

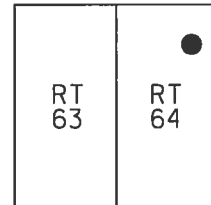

RECORD: T.S.
STA. 882+66.24
FD MONBOX
W/ "+" ON LID
5/11/84, SAH
FD MONBOX
5/18/95, SAH
FD MONBOX
REFL26
9/24/12, SAH
FD MONBOX
W/ "+" ON LID
REFL26
8/19/14, EBW

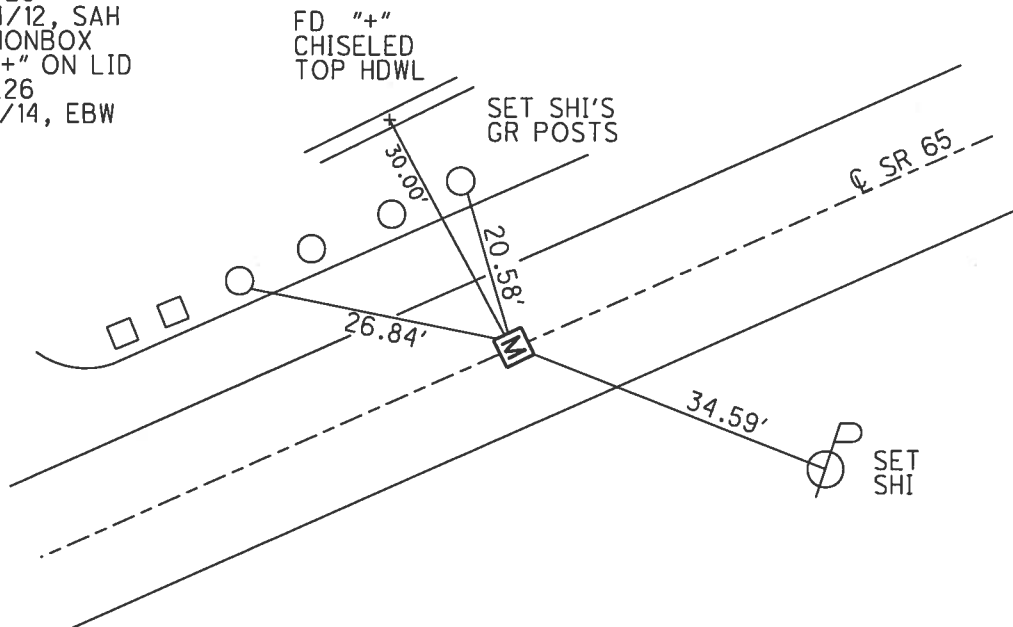

O.D.O.T. DISTRICT 2 SURVEY OFFICE (USE ONLY)

PERSONNEL _____ REFERENCE NO. 26 U SHEET 17 OF 25

NOTES LEU DATE 8/20/14 ROUTE SR 65

H.C. HOMAN WEATHER SUNNY COUNTY WOOD

R.C. WESTFALL TEMP. 80° TOWNSHIP PERRYSBURG

SECTION RT 64

T 7 N R 10 E

TYPE MONUMENT P.K.NAIL


~~ON SURFACE~~ - BELOW 2 1/2"

LEFT - CL PAV'T - ~~RIGHT~~ 1.2'


10.4' TO LT EDGE PAVEMENT

S.L.M. 886+53.68

Grid: Northing: 688050.991 Easting: 1651922.384

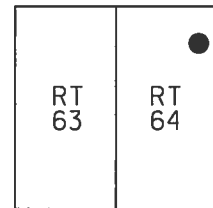

RECORD: P.I.
 STA. 884+42.18
 $\Delta = 9^\circ 51' 40''$ LT
 FD P.K.SHANK
 IN HOLE
 5/11/84, SAH
 FD P.K./WASHER
 5/18/95, SAH
 SET P.K./WASHER
 8/15/95, CL
 FD P.K./WASHER
 REFU26
 9/24/12, SAH
 FD P.K.SHANK
 REFM26
 8/20/14, EBW
 SET MAG/WASHER
 6/8/17, DCH

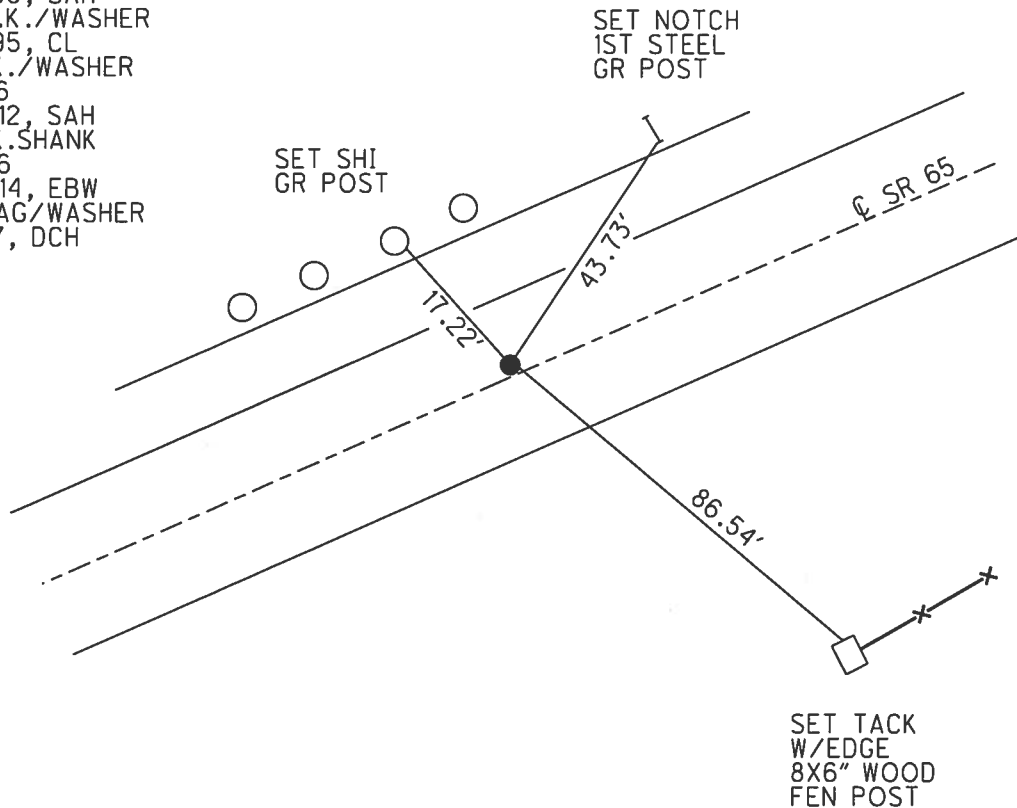

O.D.O.T. DISTRICT 2 SURVEY OFFICE (USE ONLY)

PERSONNEL

REFERENCE NO. 26 UV1

SHEET 18 OF 25

NOTES LEU
H.C. HOMAN
R.C. WESTFALL

DATE 8/20/14
WEATHER PTLY CLOUDY
TEMP. 80°

ROUTE SR 65
COUNTY WOOD
TOWNSHIP PERRYSBURG
SECTION RT 64 & 65
T 7 N R 10 E

TYPE MONUMENT P.K.NAIL


~~ON SURFACE~~ - BELOW 2"

LEFT - $\odot$ PAV'T - ~~RIGHT~~ 42'±

- TO - EDGE PAVEMENT


S.L.M. 894+00

Grid: Northing: 688247.177 Easting: 1652650.889

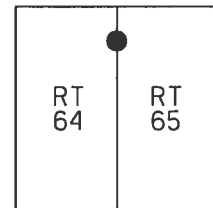

RECORD:
STA. 9+43.89
 $\odot$ FT. MEIGS RD
FD HOLE W/P.K.SHANK
POINT W/STATS
SET P.K.NAIL
5/11/84, CL
D.N.F. POINT
9/24/12, SAH
FD P.K.NAIL
2" DOWN
REFN26
8/20/14, EBW

FD "+" CUT
MH RIM

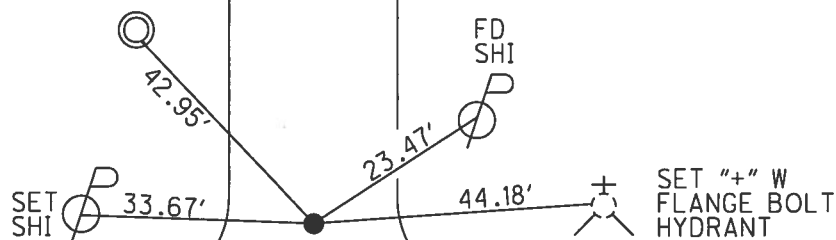

$\odot$ SR 65


$\odot$ FORT MEIGS RD

DIST. 26UV1-26UV2= 157.15'

O.D.O.T. DISTRICT 2 SURVEY OFFICE (USE ONLY)


PERSONNEL _____ REFERENCE NO. 26 UV2 SHEET 19 OF 25
NOTES LEU DATE 8/20/14 ROUTE SR 65
H.C. HOMAN WEATHER PTLY CLOUDY COUNTY WOOD
R.C. WESTFALL TEMP. 80° TOWNSHIP PERRYSBURG
SECTION RT 64 & 65
T 7 N R 10 E

TYPE MONUMENT MAG/WASHER
ON SURFACE - ~~BELOW~~ ON _____
LEFT - ℄ PAV'T - ~~RIGHT~~ 199.13'±
- TO - EDGE PAVEMENT
S.L.M. 894+00

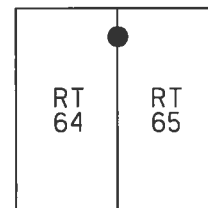

Grid: Northing: 688404.302 Easting: 1652653.097

RECORD:
STA. 11+01.06
℄ FT. MEIGS RD
FD P.K.NAIL
5/11/84, CL
D.N.F. POINT
9/24/12, SAH
SET MAG/WASHER
REFP26
8/20/14, EBW
FD MAG/WASHER
6/8/17, DCH

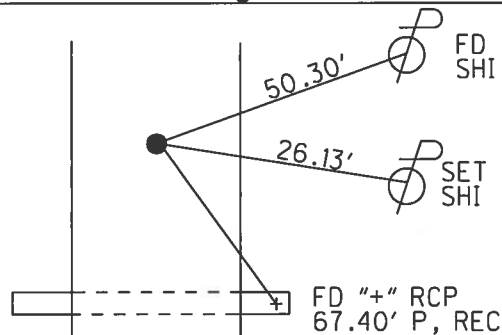

26UV1

℄ SR 65

℄ FORT MEIGS RD


DIST. 26UV1-26UV2= 157.15'

O.D.O.T. DISTRICT 2 SURVEY OFFICE (USE ONLY)

PERSONNEL _____ REFERENCE NO. 26 V SHEET 20 OF 25
NOTES LEU DATE 8/20/14 ROUTE SR 65
H.C. HOMAN WEATHER PTLY CLOUDY COUNTY WOOD
R.C. WESTFALL TEMP. 80° TOWNSHIP PERRYSBURG
SECTION RT 65
T 7 N R 10 E


TYPE MONUMENT MONBOX
ON SURFACE - ~~BELOW~~ ON
LEFT - C PAV'T - RIGHT ON
11.3' TO RT EDGE PAVEMENT
S.L.M. 898+92.56

Grid: Northing: 688129.783 Easting: 1653131.932

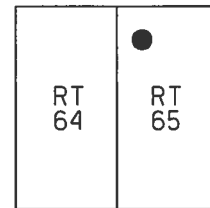

RECORD:
FD MONBOX
5/18/95, SAH
8/15/95, CL
FD MONBOX
"+" ON LID
REFV26
9/24/12, SAH
REFQ26
8/20/14, DCH


DIST. 26V-26W= 150.53'

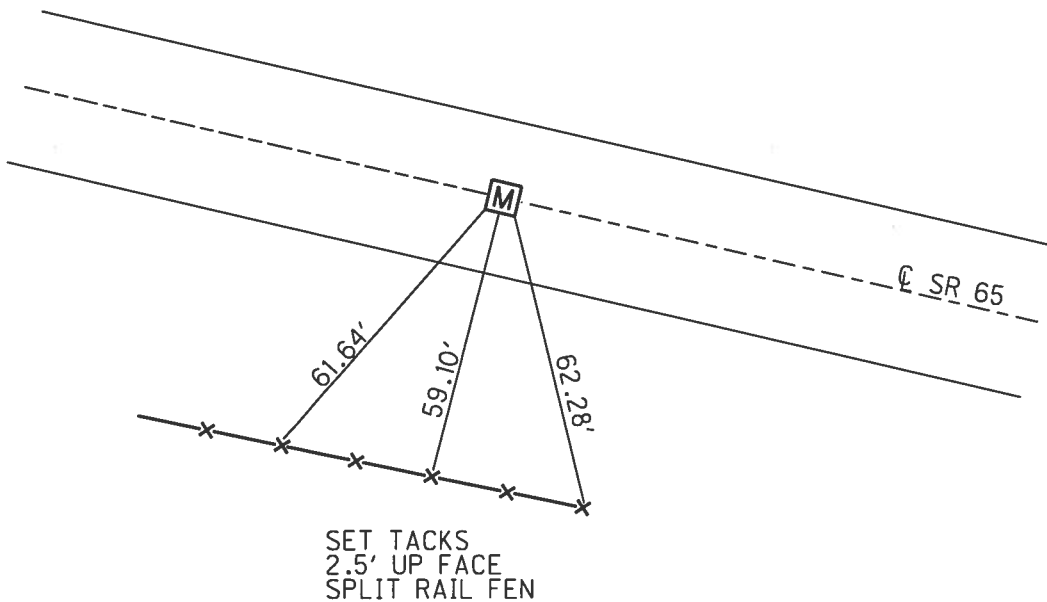

O.D.O.T. DISTRICT 2 SURVEY OFFICE (USE ONLY)


PERSONNEL _____ REFERENCE NO. 26 W SHEET 21 OF 25
NOTES LEU DATE 8/20/14 ROUTE SR 65
H.C. HOMAN WEATHER PTLY CLOUDY COUNTY WOOD
R.C. WESTFALL TEMP. 80° TOWNSHIP PERRYSBURG
SECTION RT 65
T 7 N R 10 E

TYPE MONUMENT MONBOX
ON SURFACE - ~~BELOW~~ ON
LEFT - CL PAV'T - RIGHT ON
10.9' TO RT EDGE PAVEMENT
S.L.M. 900+40.58
Grid: Northing: 688094.501 Easting: 1653275.680

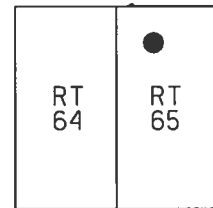

RECORD:
FD MONBOX
5/18/95, SAH
8/15/95, CL
FD MONBOX
"+" ON LID
REFW26
9/24/12, SAH
REFR26
8/20/14, DCH

DIST. 26V-26W= 150.53'

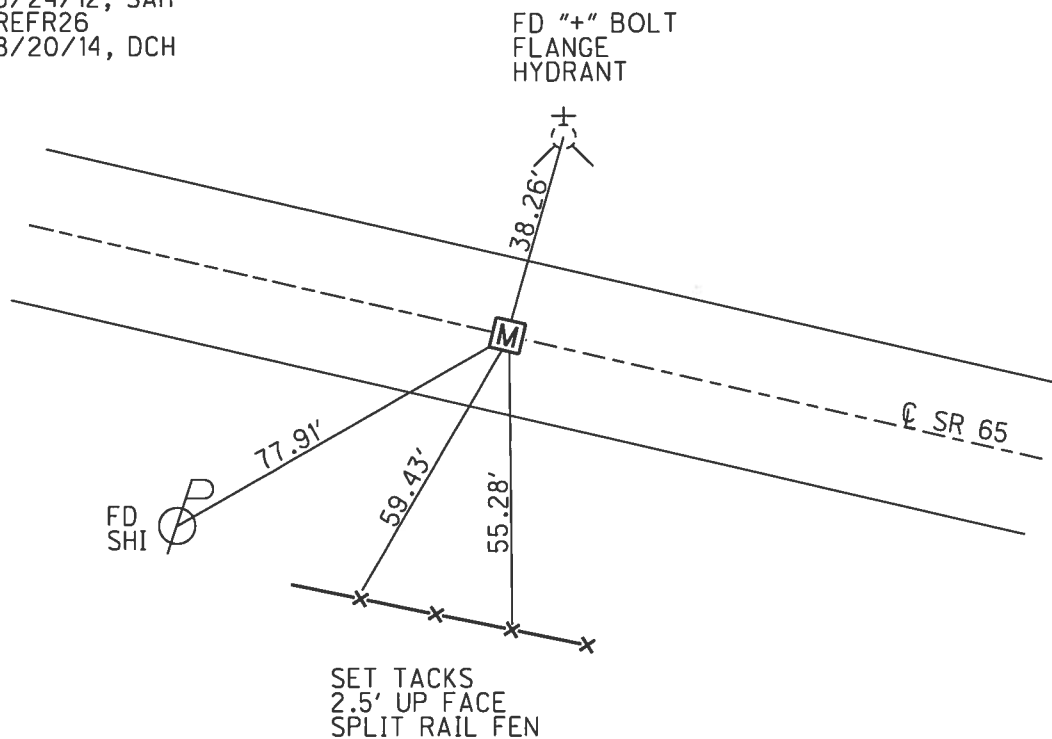


O.D.O.T. DISTRICT 2 SURVEY OFFICE (USE ONLY)


PERSONNEL _____ REFERENCE NO. 26 X SHEET 22 OF 25
 NOTES LEU DATE 8/20/14 ROUTE SR 65
 H.C. WESTFALL WEATHER PTLY CLOUDY COUNTY WOOD
 R.C. HOMAN TEMP. 80° TOWNSHIP PERRYSBURG
 SECTION RT 66
 T 7 N R 10 E

TYPE MONUMENT P.K.NAIL
 ON SURFACE - ~~BELOW~~ ON
~~LEFT~~ - Q PAV'T - RIGHT 0.4'
11.6' TO RT EDGE PAVEMENT
 S.L.M. 909+81.10

Grid: Northing: 688073.128 Easting: 1654204.500

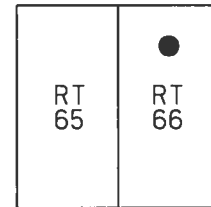

RECORD:
 FD P.K./WASHER
 5/18/95, SAH
 SET P.K./WASHER
 8/15/95, CL
 FD P.K./WASHER
 REFX6
 9/24/12, SAH
 FD P.K.NAIL
 REFS6
 8/20/14, DCH
 SET MAG/WASHER
 6/8/17, DCH

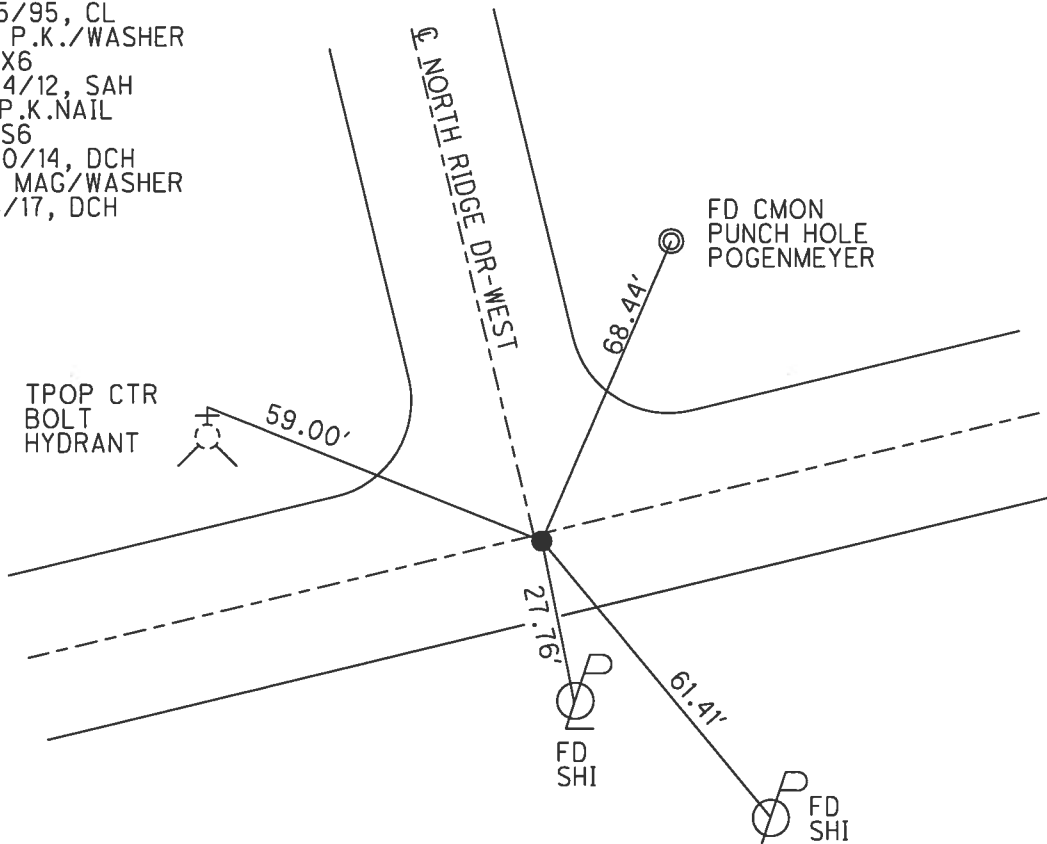

O.D.O.T. DISTRICT 2 SURVEY OFFICE (USE ONLY)

PERSONNEL

REFERENCE NO. 26 Y

SHEET 23 OF 26

NOTES LEU

DATE 8/20/14

ROUTE SR 65

H.C. WESTFALL

WEATHER PTLY CLOUDY

COUNTY WOOD

R.C. HOMAN

TEMP. 80°

TOWNSHIP PERRYSBURG

SECTION RT 66

T 7 N R 10 E

TYPE MONUMENT MONBOX


ON SURFACE - ~~BELOW~~ ON

LEFT - ℄ PAV'T - ~~RIGHT~~ 1.0'

11.1' TO RT EDGE PAVEMENT

S.L.M. 914+16.25

Grid: Northing: 688232.415 Easting: 1654608.600

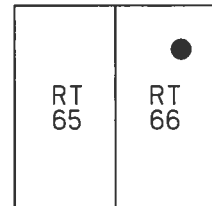

RECORD:

FD MONBOX

5/18/95, SAH

8/15/95, CL

FD MONBOX


"+" ON LID

REFY26

9/24/12, SAH

REFT26

8/20/14, DCH

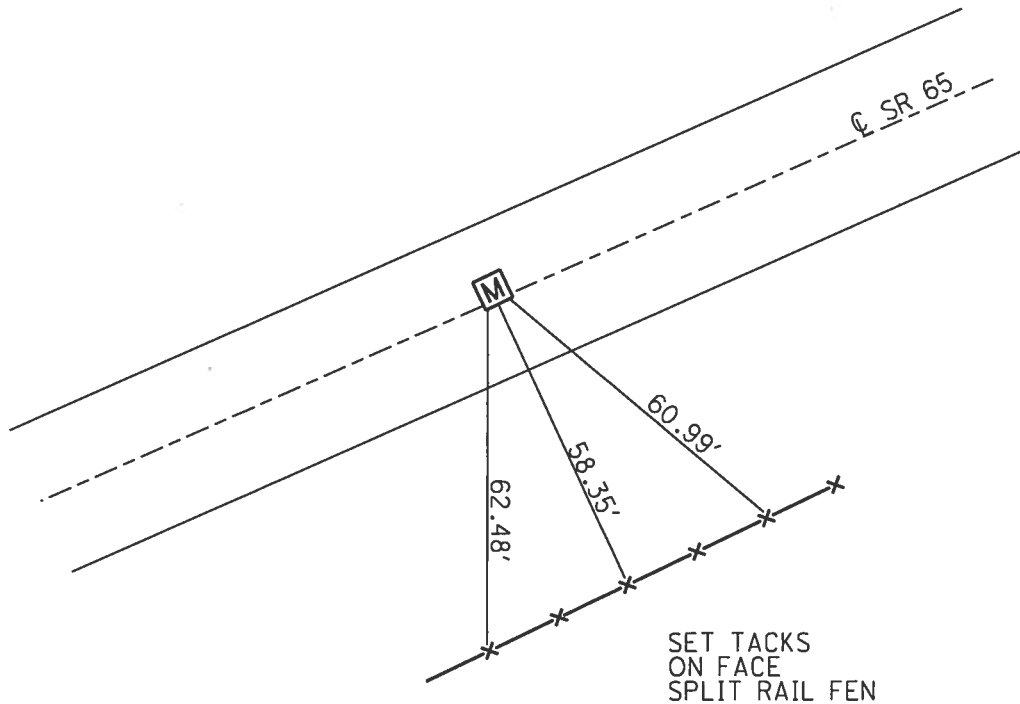

O.D.O.T. DISTRICT 2 SURVEY OFFICE (USE ONLY)

PERSONNEL

REFERENCE NO. 26 Z SHEET 24 OF 25

NOTES LEU DATE 8/20/14 ROUTE SR 65
H.C. WESTFALL WEATHER PTLY CLOUDY COUNTY WOOD
R.C. HOMAN TEMP. 80° TOWNSHIP PERRYSBURG
SECTION RT 66
T 7 N R 10 E

TYPE MONUMENT P.K.NAIL


~~ON SURFACE~~ - BELOW 3"

LEFT - Q PAV'T - RIGHT ON


11.9' TO RT EDGE PAVEMENT

S.L.M. 916+82.83

Grid: Northing: 688347.553 Easting: 1654849.036

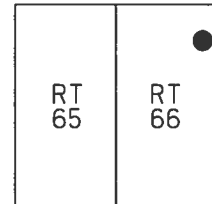

RECORD:
FD P.K./WASHER
5/18/95, SAH
SET P.K./WASHER
8/15/95, CW
FD P.K./WASHER
REFZ6
9/24/12, SAH
FD P.K.NAIL
3" BELOW
REFU26
8/20/14, DCH
SET MAG/WASHER
6/8/17, DCH

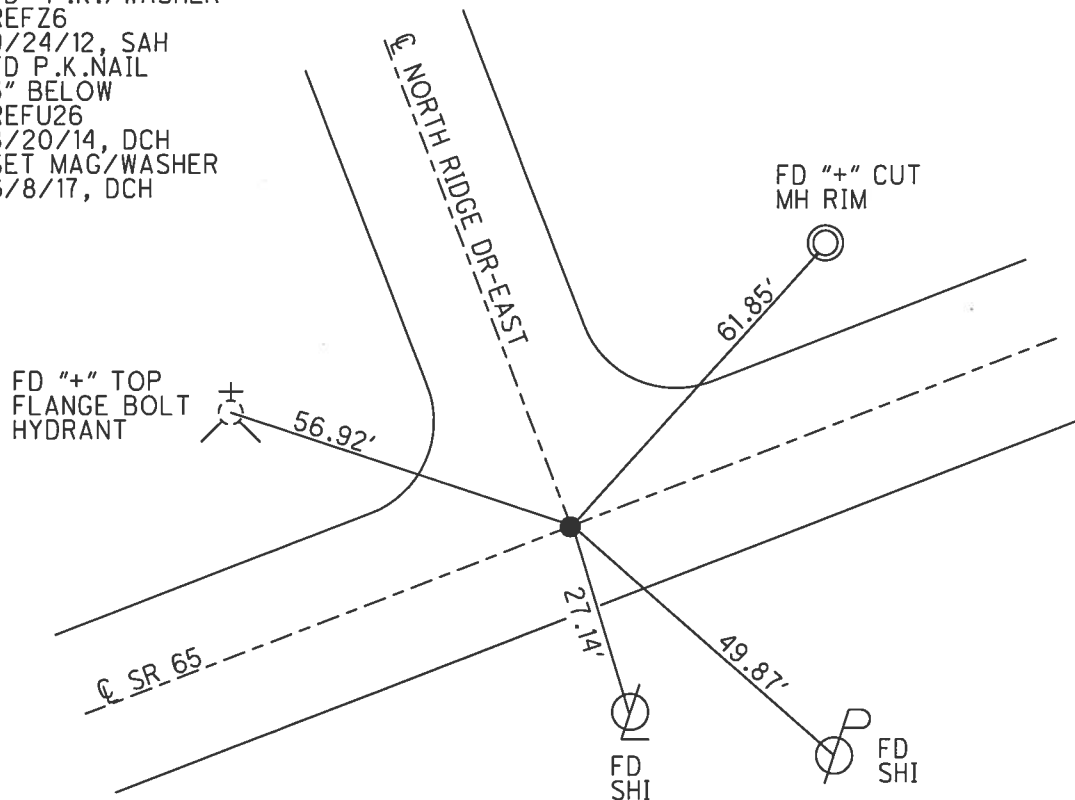

O.D.O.T. DISTRICT 2 SURVEY OFFICE (USE ONLY)

PERSONNEL

REFERENCE NO. 27

SHEET 25 OF 25

NOTES RHOADES

DATE 4/9/14

ROUTE SR 65

H.C. ROUSOS

WEATHER CLEAR

COUNTY WOOD

R.C. HOMAN

TEMP. 41°

TOWNSHIP PERRYSBURG

GABLE

SECTION 6, RT 67

T 4 N R 11 E

TYPE MONUMENT SM.R.R.SPIKE


ON SURFACE - ~~BELOW~~ ON

LEFT - ℄ PAV'T - RIGHT -

 TO EDGE PAVEMENT


S.L.M. 936+25.33

Grid: Northing: 689187.351 Easting: 1656600.601

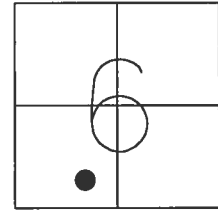

RECORD:
FD SM.R.R.SPIKE
4/22/91, I.S.
SET SM.R.R.SPIKE
6/6/91, DJC
FD SM.R.R.SPIKE
REFE54
9/24/12, SAH
SET MAG/WASHER
REFE54
6/19/15, DCH

NOTE: REF 54E SR 25

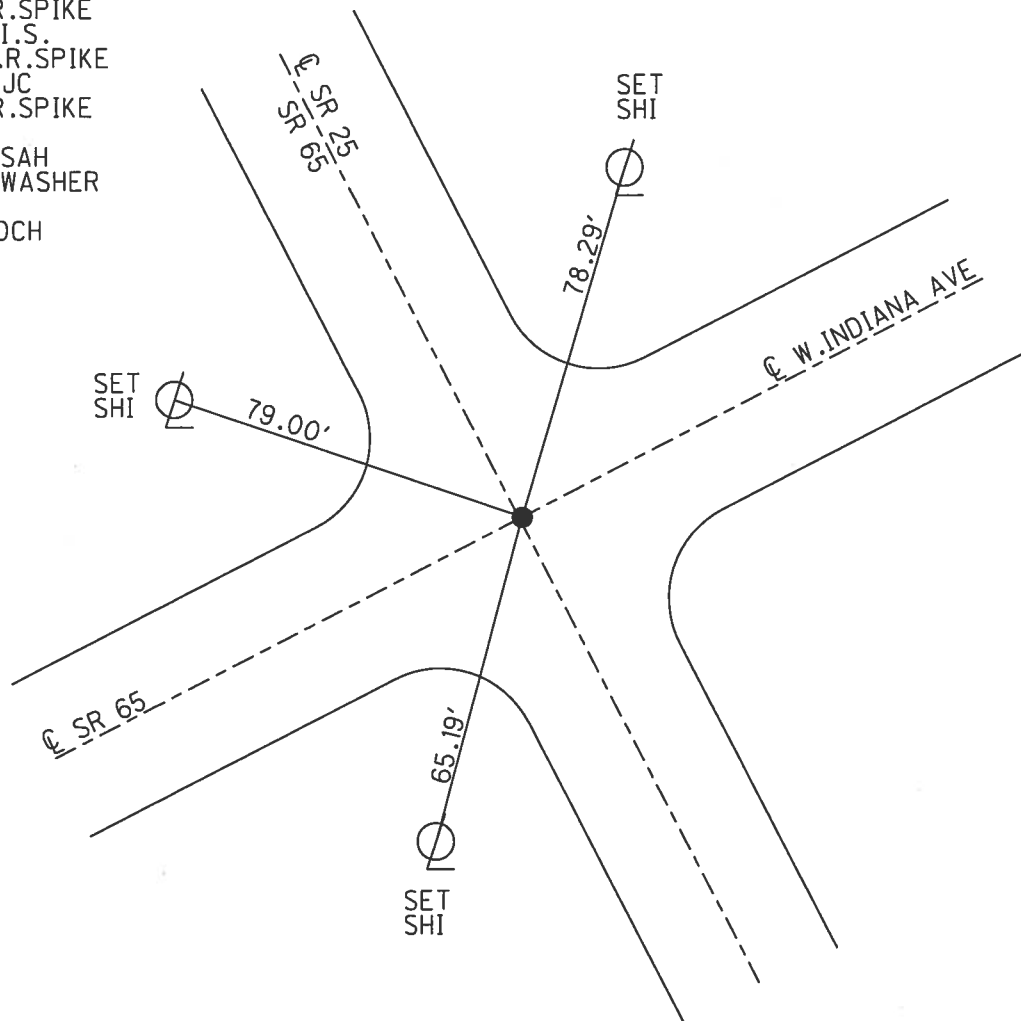

O.D.O.T. DISTRICT 2 SURVEY OFFICE

PERSONNEL

REFERENCE NO. _____

SHEET _____ OF _____

NOTES BARNHISEL

H.C. HOMER

R.C. BEAUMONT

DATE 09/05/02

WEATHER Sunny

TEMP. +70°

ROUTE 65 E US 20

COUNTY WOOD

TOWNSHIP Peerysburg

SECTION _____

T _____ R _____


TYPE MONUMENT PK

ON SURFACE - BELOW yes

LEFT- & PAV'T. - RIGHT _____

23.6 TO RT. EDGE PAVEMENT CURB

S.L.M. 19+82

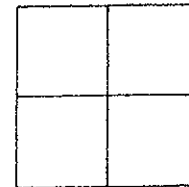

RECORD PI PLAN STA: 19+64.03

CURVE DATA FOR US 20

$\Delta = 15^\circ - 17' - 30''$


$D = 4^\circ$

$R = 1432.40'$

PC = 17+71.74


PI = 19+64.03

PT = 21+54.03

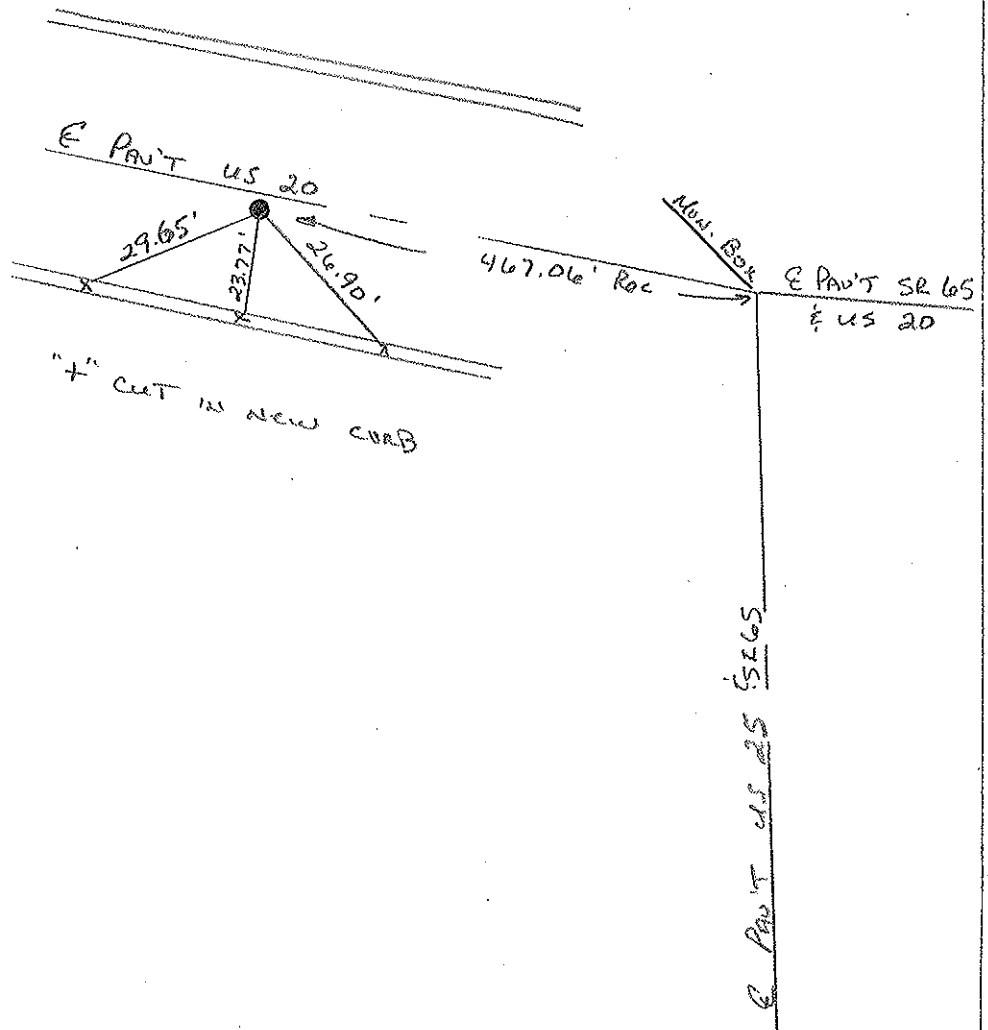


County WOOD S.R. 20 E 65Township Perryssburg

Section _____

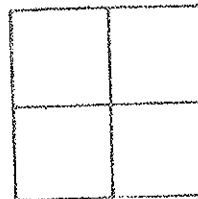T. N, R. EPersonnel LOEHRKE IIIHoffman R.C.BARHISEL H.C.Date 6-4-85Weather Pt CloudyTemp. 68P.I. PLAN STA 19464.03
5.2 Lf of Rt CURB

NOT COVERED

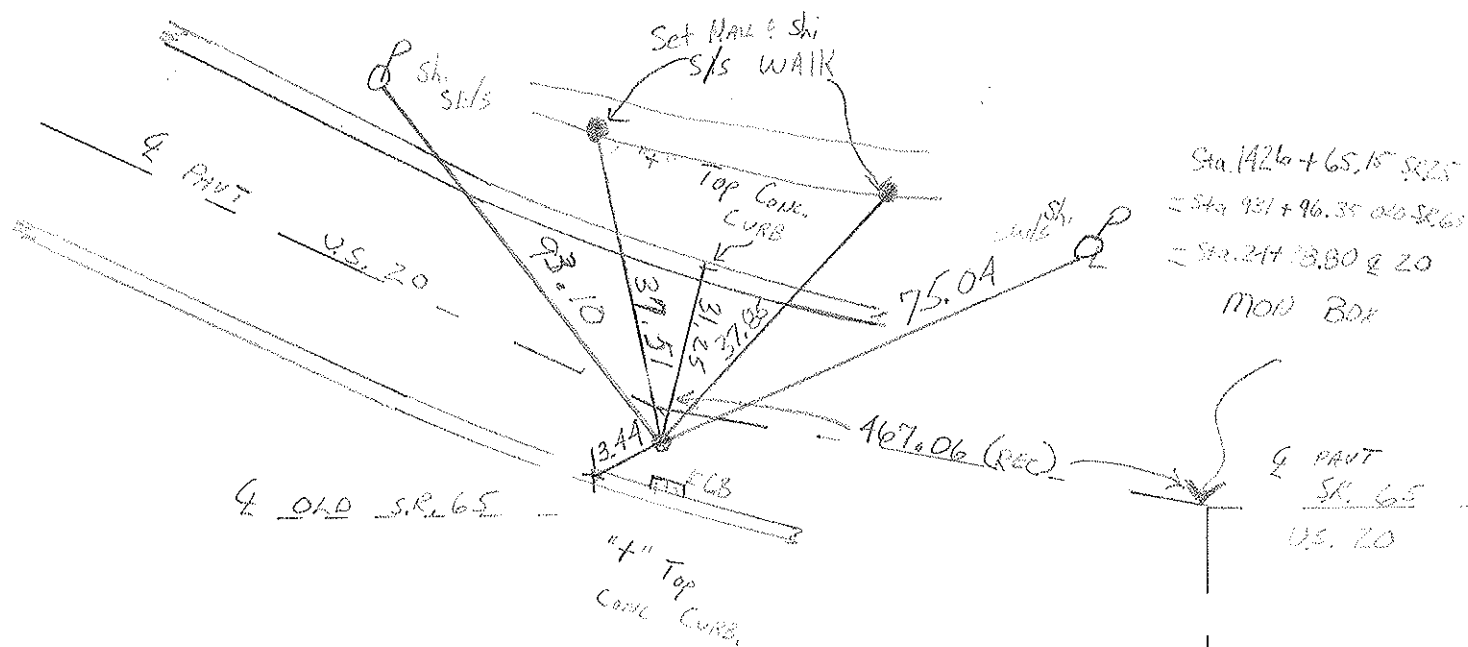SLM 19+82CURVE DATA FOR
P.I. ON U.S. 20 $\Delta = 15^\circ - 19' - 30''$ $D = 4^\circ - 00'$ $R = 1432.40$ $P.C. = 17+71.74$ $P.I. = 19+64.03$ $P.T. = 21+54.03$

S. 25

O.D.O.T. DISTRICT 2 SURVEY OFFICE

PERSONNEL _____

REFERENCE NO. _____

SHEET _____ OF _____

NOTES BARNHISEL

H.C. Homan

R.C. Beaumont

DATE 9/05/02

WEATHER SUNNY

TEMP. +70°

ROUTE 65 & US 20

COUNTY WOOD

TOWNSHIP Perrysburg

SECTION _____

T _____ R _____



TYPE MONUMENT Mon Box

ON SURFACE - BELOW YES

LEFT- & PAU'T. - RIGHT _____

18.3' TO LT EDGE PAVEMENT CURB


S.L.M. 24+47

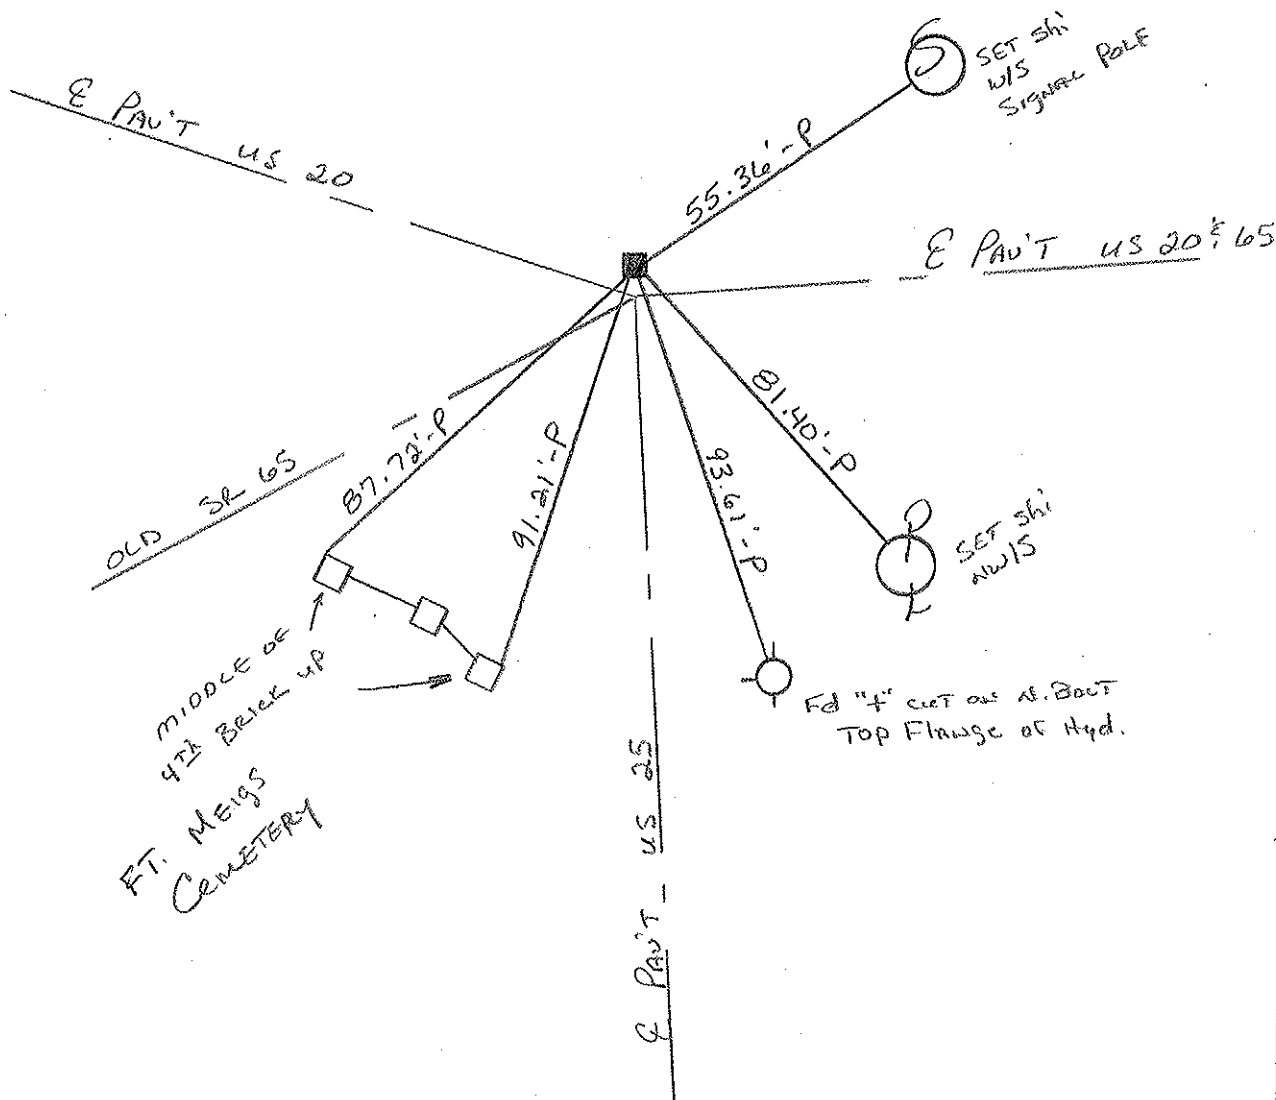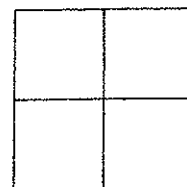

County WOOD S.R. 65 & US 20Township PERRYSBURG

Section _____

T N, R E
 Personnel LOEHRKE JD
HOFFMAN RC
LOEHRKE HC

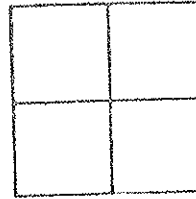Date 6-4-85Weather PT CLOUDYTemp. + 70


Mon. Box No L.D. ON & PAUT SR 25 N.

STA 24+28.80

18.25 RT of LT CURBING

NOT
COVER

SLM 24+47

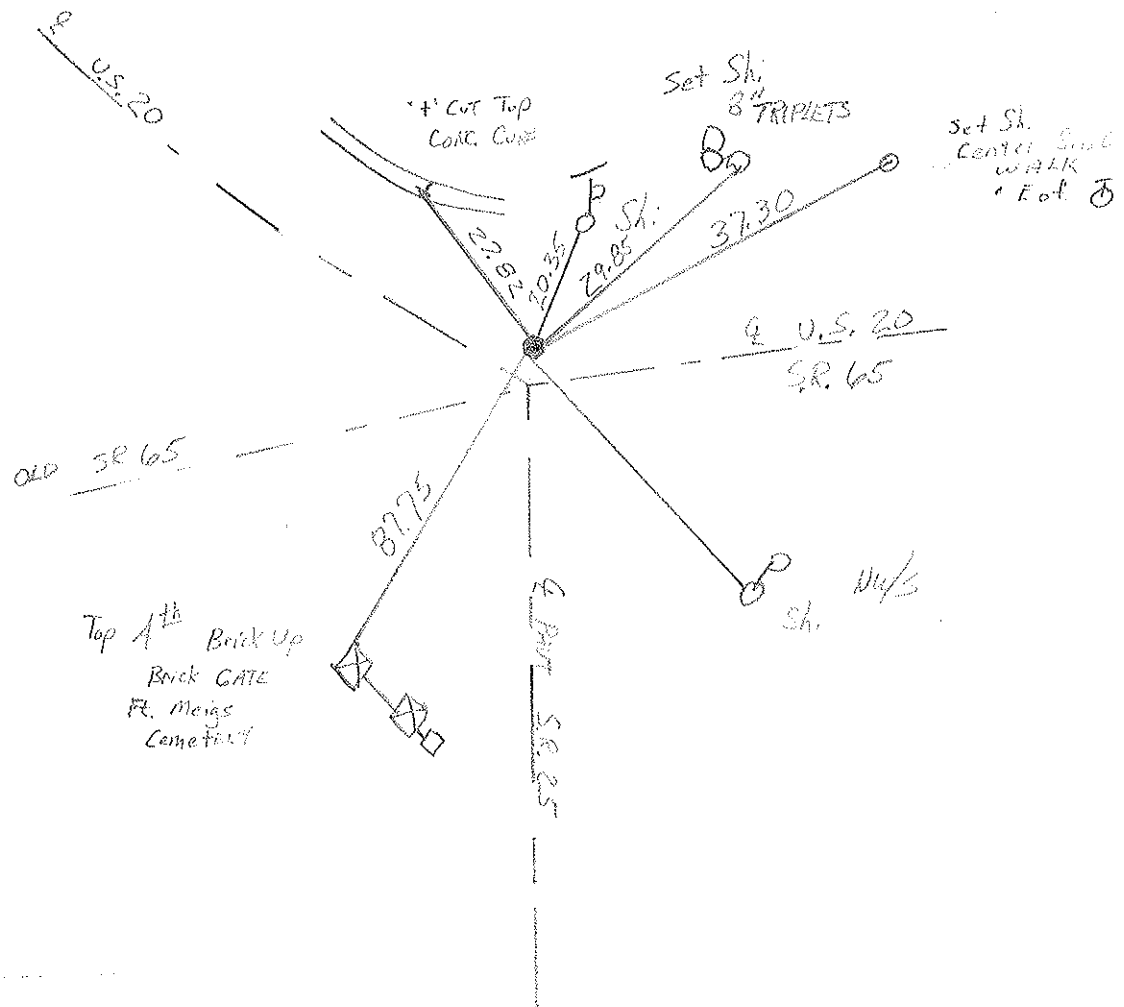

O.D.O.T. DISTRICT 2 SURVEY OFFICE (USE ONLY)

PERSONNEL

REFERENCE NO. 29

SHEET 1 OF 9

NOTES LOEHRKE

DATE 6/4/85

ROUTE SR 65

H.C. BARNHISEL

WEATHER CLEAR

COUNTY WOOD

R.C. HOFFMAN

TEMP. 70°

TOWNSHIP PERRYSBURG

SECTION 12 MILE RESERVE

DWG BY NIESE PID

T 4 US

TYPE MONUMENT LG.R.R.SPIKE

~~ON SURFACE~~ - BELOW 1"


OFFSET CL PAVEMENT 8.4' LT : ~~RT~~

6.1' TO LT EDGE PAVEMENT


STATION: 941+89

HORZ.DATUM: GEOID:

GRID: NORTHING: EASTING:

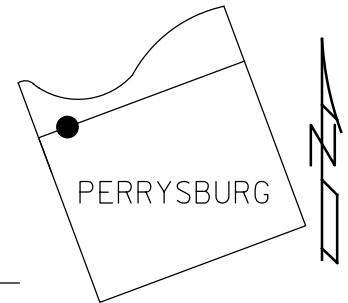

RECORD:
US 20 SLM 34+39
FD LG.R.R.SPIKE
1" DOWN
6/4/85, CL
SET SM.R.R.SPIKE
7/1/85, CL

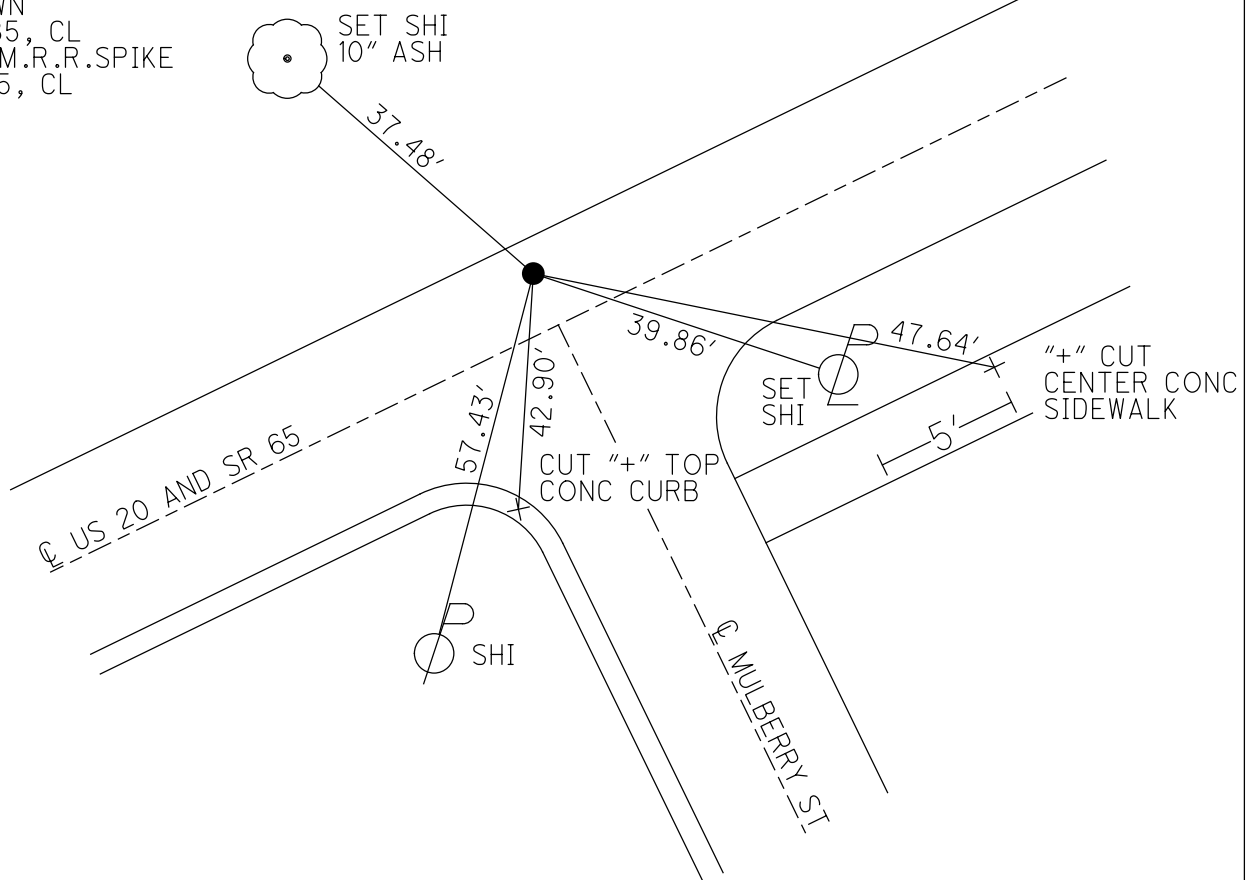

O.D.O.T. DISTRICT 2 SURVEY OFFICE (USE ONLY)

PERSONNEL

REFERENCE NO. 29 A

SHEET 2 OF 9

NOTES LOEHRKE

DATE 6/4/85

ROUTE SR 65

H.C. BARNHISEL

WEATHER CLEAR

COUNTY WOOD

R.C. HOFFMAN

TEMP. 75°

TOWNSHIP PERRYSBURG

SECTION 12 MILE RESERVE

DWG BY NIESE

PID _____

T 4 US

TYPE MONUMENT LG.R.R.SPIKE

~~ON SURFACE~~ - BELOW 1"

OFFSET Q PAVEMENT 7.5' LT : ~~RT~~

7.2' TO LT EDGE PAVEMENT


STATION: 948+34

HORZ.DATUM: _____


GEOID: _____

GRID: NORTHING: _____

EASTING: _____

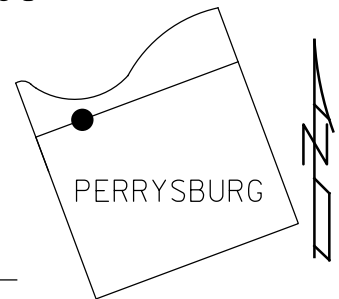

RECORD:
US 20 SLM 40+84
FD LG.R.R.SPIKE
1" DOWN
6/4/85, CL
SET SM.R.R.SPIKE
7/1/85, CL

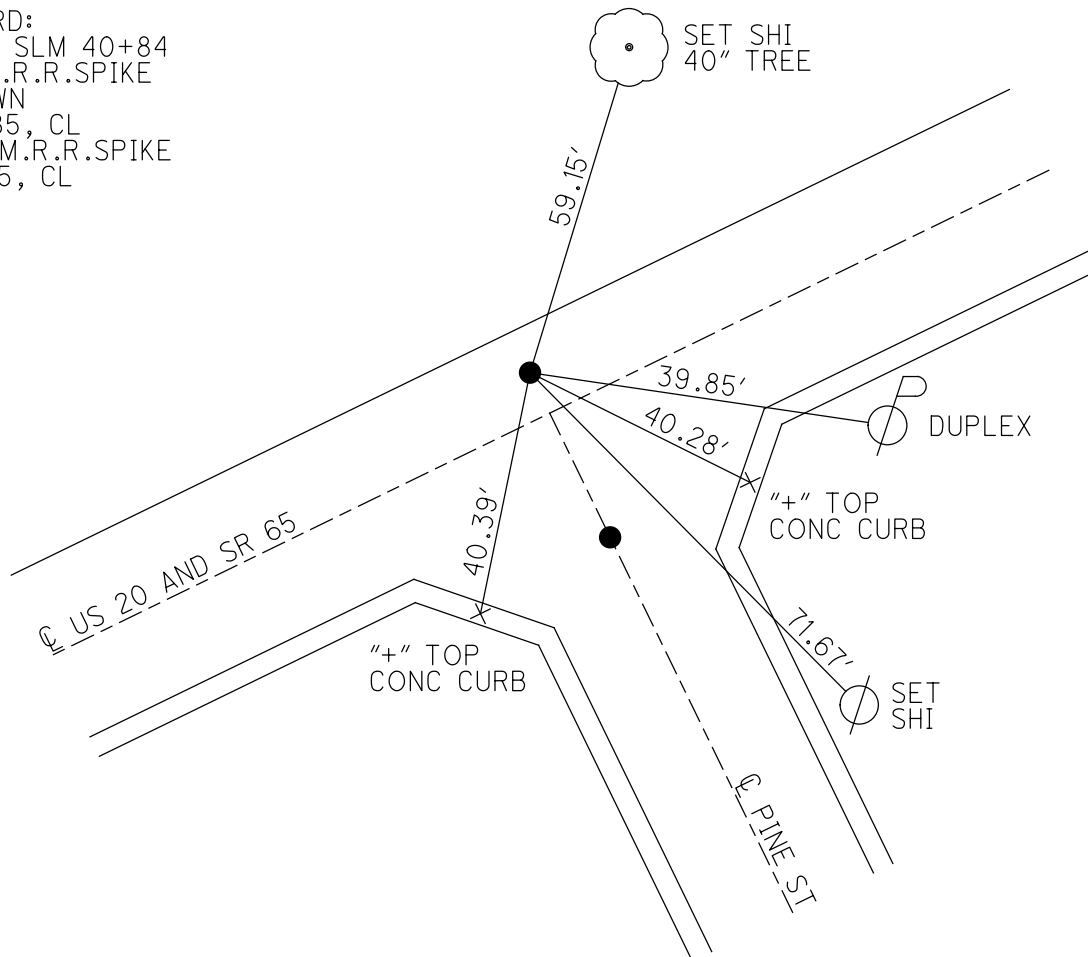

O.D.O.T. DISTRICT 2 SURVEY OFFICE (USE ONLY)

PERSONNEL

REFERENCE NO. 29 B

SHEET 3 OF 9

NOTES LOEHRKE

DATE 6/4/85

ROUTE SR 65

H.C. BARNHISEL

WEATHER CLEAR

COUNTY WOOD

R.C. HOFFMAN

TEMP. 75°

TOWNSHIP PERRYSBURG

DWG BY NIESE PID

T_4US

TYPE MONUMENT SMALL NAIL

ON SURFACE - ~~BELOW~~ _____ ON _____


OFFSET @ PAVEMENT _____ : RT

____TO____EDGE PAVEMENT


STATION: 948+34

HORZ.DATUM: _____ GEOID: _____

GRID: NORTHING:_____ EASTING:_____

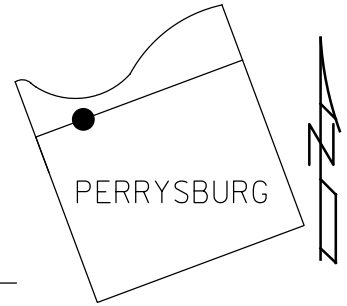

RECORD:
FD SMALL NAIL
ORIGIN UNKNOWN
6/4/85, CL

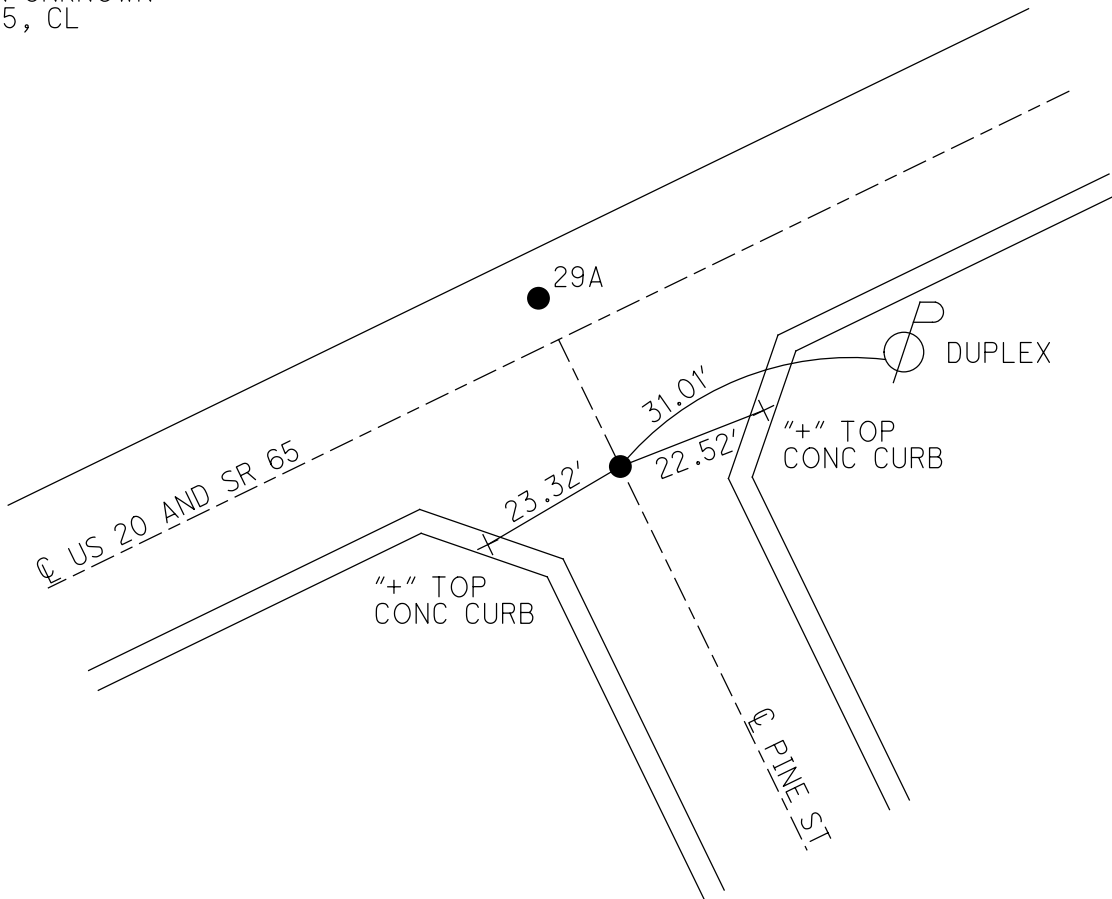

O.D.O.T. DISTRICT 2 SURVEY OFFICE (USE ONLY)

PERSONNEL

REFERENCE NO. 29 C

SHEET 4 OF 9

NOTES LOEHRKE

DATE 6/4/85

ROUTE SR 65

H.C. BARNHISEL

WEATHER PT. CLOUDY

COUNTY WOOD

R.C. HOFFMAN

TEMP. 74°

TOWNSHIP PERRYSBURG

SECTION 12 MILE RESERVE

DWG BY NIESE PID

T 4 US

TYPE MONUMENT LG.R.R.SPIKE

~~ON SURFACE~~ - BELOW 1"


OFFSET CL PAVEMENT 7.2' LT : ~~RT~~

 TO EDGE PAVEMENT


STATION: 961+24

HORZ.DATUM: GEOID:

GRID: NORTHING: EASTING:

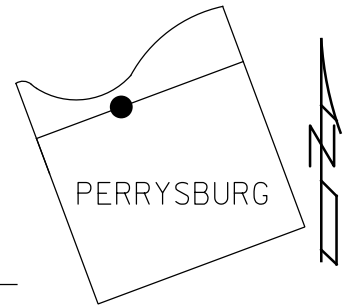

RECORD:
US 20 SLM 53+74
FD LG.R.R.SPIKE
1" DOWN
6/4/85, CL
SET SM.R.R.SPIKE
7/1/85, CL

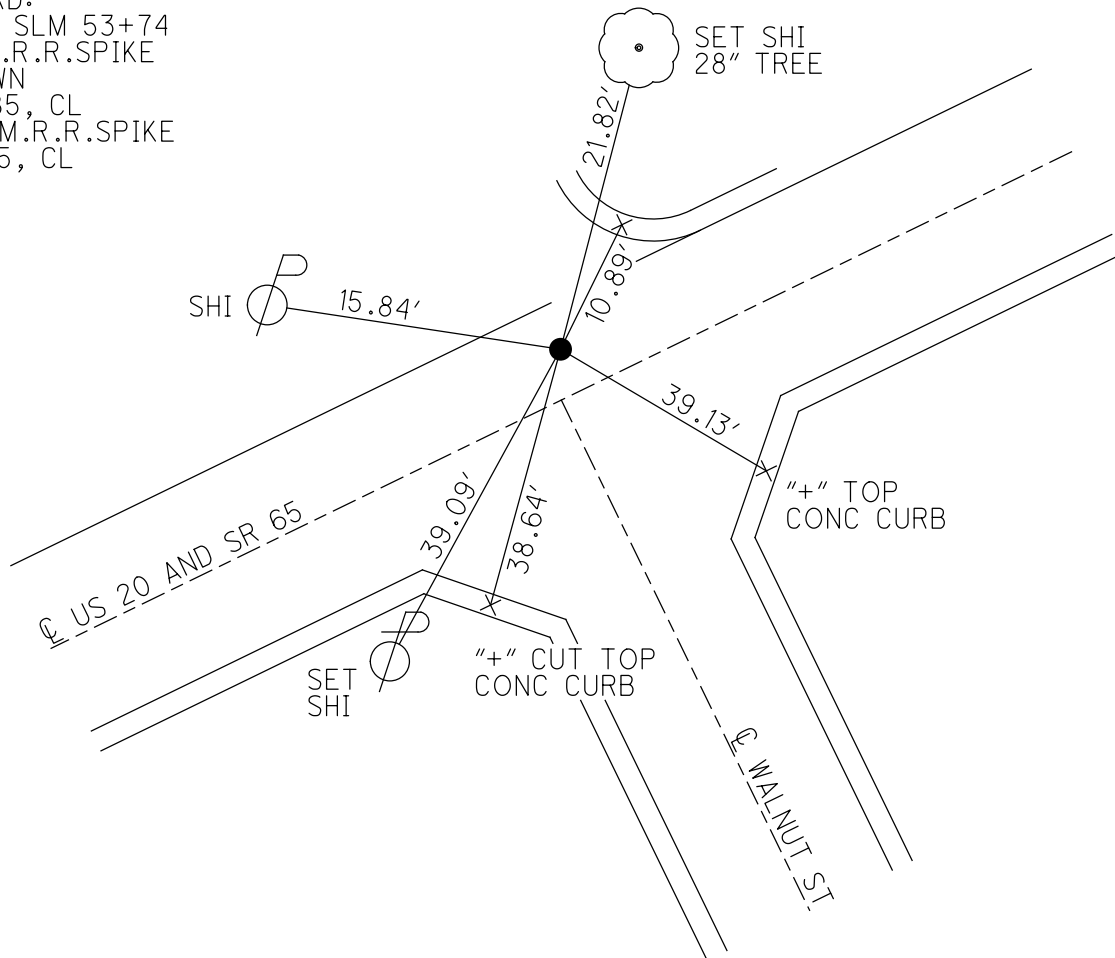

O.D.O.T. DISTRICT 2 SURVEY OFFICE (USE ONLY)

PERSONNEL

REFERENCE NO. 29 D

SHEET 5 OF 9

NOTES LOEHRKE

DATE 6/4/85

ROUTE SR 65

H.C. BARNHISEL

WEATHER PT. CLOUDY

COUNTY WOOD

R.C. HOFFMAN

TEMP. 74°

TOWNSHIP PERRYSBURG

DWG BY NIESE

PID _____

SECTION 12 MILE RESERVE

T 4 US

TYPE MONUMENT LG.R.R.SPIKE

~~ON SURFACE~~ - BELOW 1"

OFFSET $\odot$ PAVEMENT 8.1' LT : ~~RT~~

- TO - EDGE PAVEMENT


STATION: 967+84

HORZ.DATUM: _____


GEOID: _____

GRID: NORTHING: _____

EASTING: _____

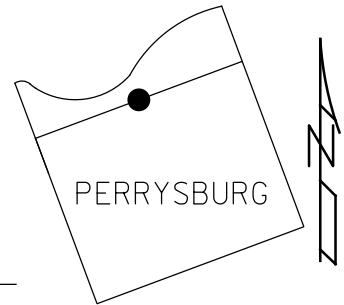

RECORD:
US 20 SLM 60+34
FD LG.R.R.SPIKE
1" DOWN
6/4/85, CL
SET SM.R.R.SPIKE
7/1/85, CL

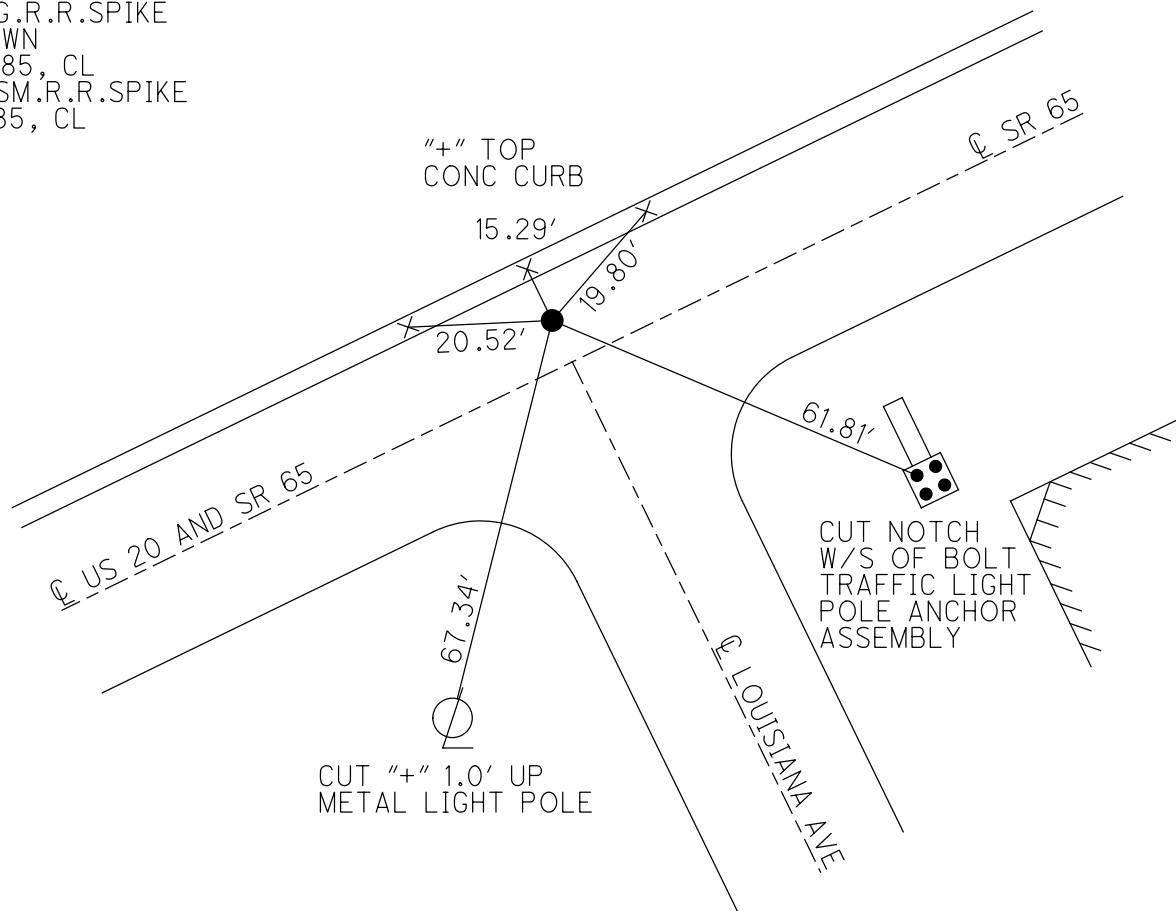

O.D.O.T. DISTRICT 2 SURVEY OFFICE (USE ONLY)

PERSONNEL

REFERENCE NO. 29 E

SHEET 6 OF 9

NOTES LOEHRKE

DATE 6/4/85

ROUTE SR 65

H.C. BARNHISEL

WEATHER PT. CLOUDY

COUNTY WOOD

R.C. HOFFMAN

TEMP. 60°

TOWNSHIP PERRYSBURG

SECTION 12 MILE RESERVE

DWG BY NIESE PID

T 4 US

TYPE MONUMENT LG.R.R.SPIKE

~~ON SURFACE~~ - BELOW 1"


OFFSET Q PAVEMENT 8.0' LT : ~~RT~~

- TO - EDGE PAVEMENT


STATION: 974+45

HORIZ.DATUM: GEOID:

GRID: NORTHING: EASTING:

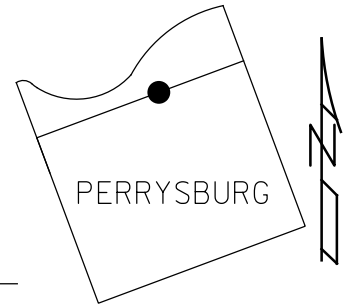

RECORD:
FD LG.R.R.SPIKE
1" DOWN
6/4/85, CL
SET SM.R.R.SPIKE
IN PATCH, ALSO SET
4 OFFSET NAILS
7/1/85, CL

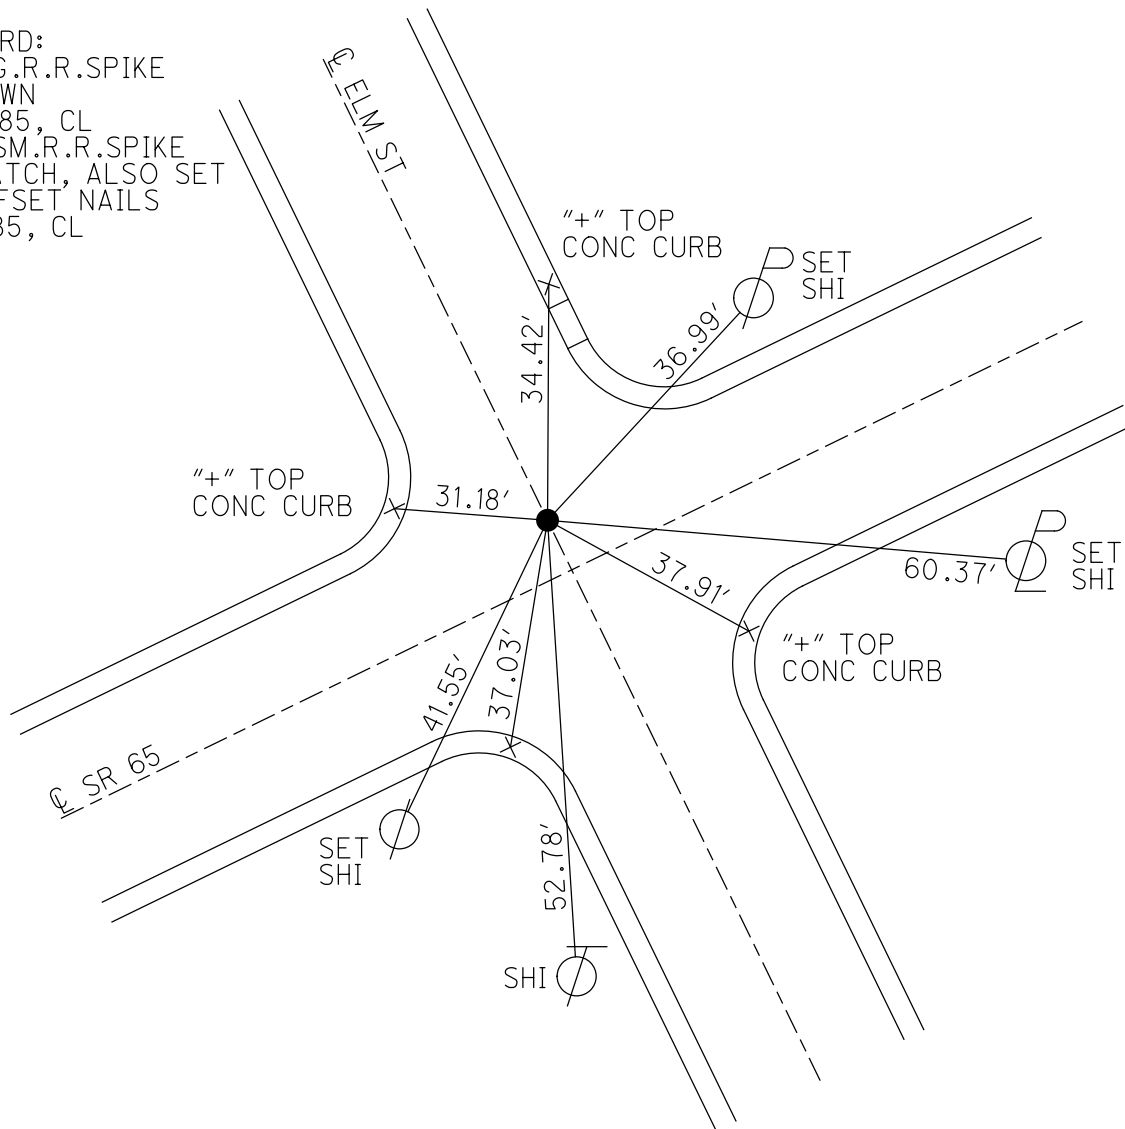

O.D.O.T. DISTRICT 2 SURVEY OFFICE (USE ONLY)

PERSONNEL

REFERENCE NO. 29 F

SHEET 7 OF 9

NOTES LOEHRKE

DATE 6/4/85

ROUTE SR 65

H.C. BARNHISEL

WEATHER CLOUDY

COUNTY WOOD

R.C. HOFFMAN

TEMP. 60°

TOWNSHIP PERRYSBURG

DWG BY NIESE PID

SECTION 12 MILE RESERVE

T 4 US

TYPE MONUMENT P.K. NAIL

~~ON SURFACE~~ - BELOW 1"


OFFSET CL PAVEMENT 8.5' LT : ~~RT~~

- TO - EDGE PAVEMENT


STATION: 980+90

HORZ.DATUM: GEOID:

GRID: NORTHING: EASTING:

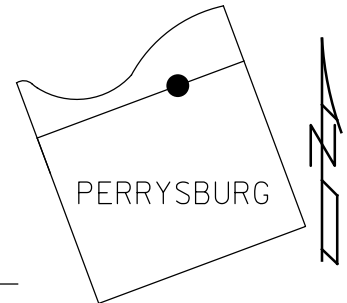

RECORD:
FD P.K. NAIL
1" DOWN
6/4/85, CL
SET SM.R.R.SPIKE
7/1/85, CL

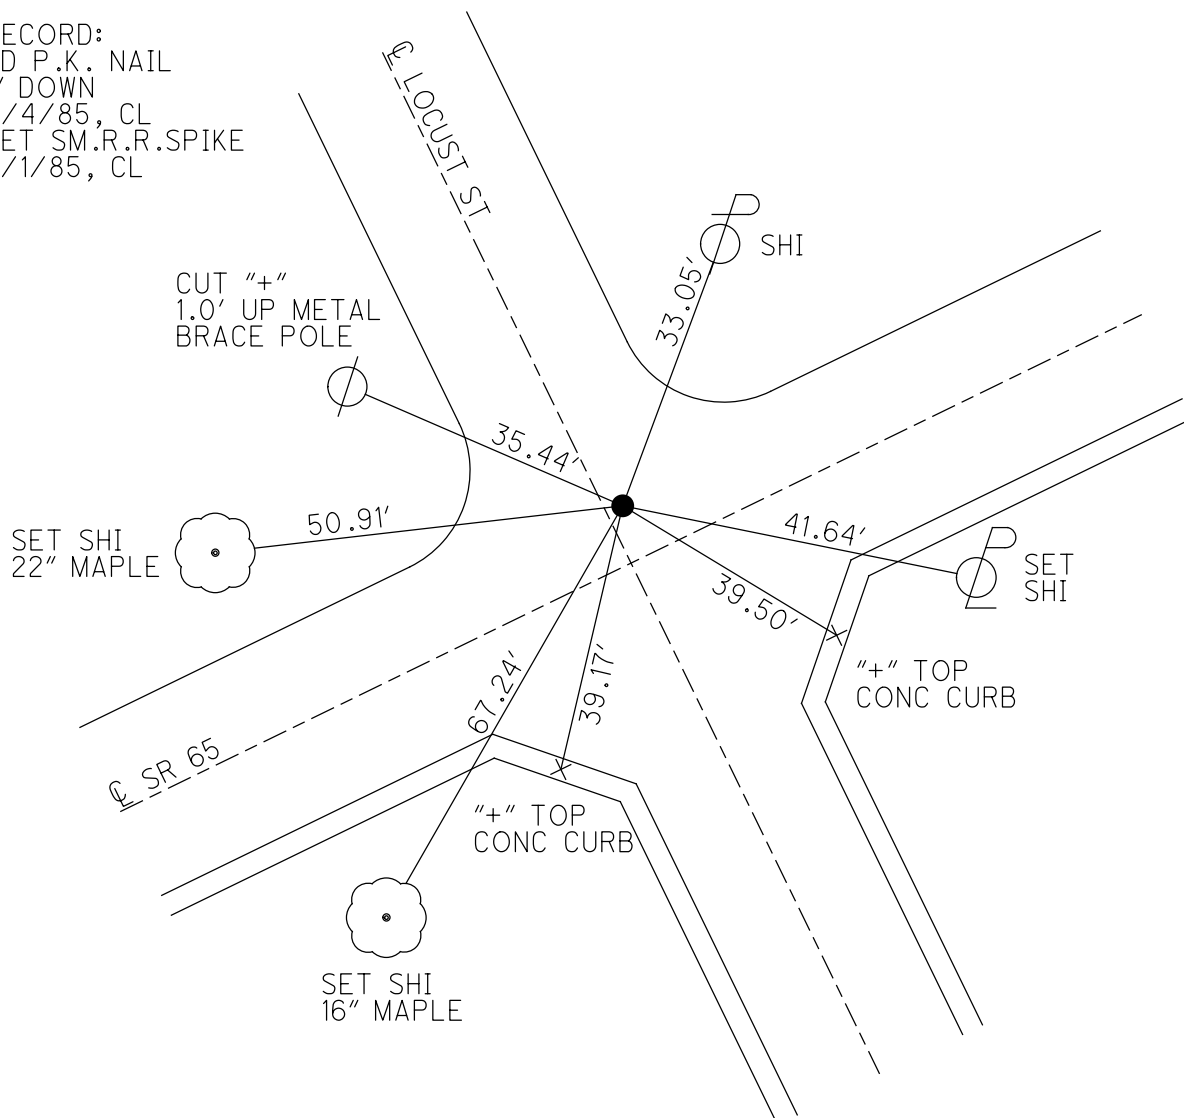

O.D.O.T. DISTRICT 2 SURVEY OFFICE (USE ONLY)

PERSONNEL

REFERENCE NO. 29 G

SHEET 8 OF 9

NOTES LOEHRKE
H.C. BARNHISEL
R.C. HOFFMAN

DATE 6/4/85
WEATHER CLOUDY
TEMP. 64°

ROUTE SR 65
COUNTY WOOD
TOWNSHIP PERRYSBURG
SECTION 12 MILE RESERVE
T 4 US

DWG BY NIESE PID

TYPE MONUMENT LG.R.R.SPIKE

~~ON SURFACE~~ - BELOW 4"


OFFSET Q PAVEMENT 7.7' LT : ~~RT~~

- TO - EDGE PAVEMENT


STATION: 987+35

HORIZ.DATUM: GEOID:

GRID: NORTHING: EASTING:

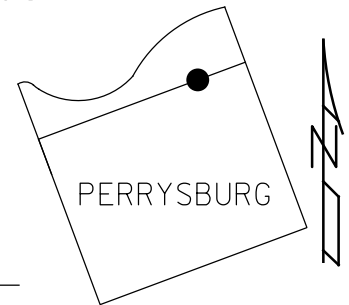

RECORD:
FD LG.R.R.SPIKE
4" DOWN
6/4/85, CL
SET SM.R.R.SPIKE
7/1/85, CL
SET SM.R.R.SPIKE
11/25/86, CL

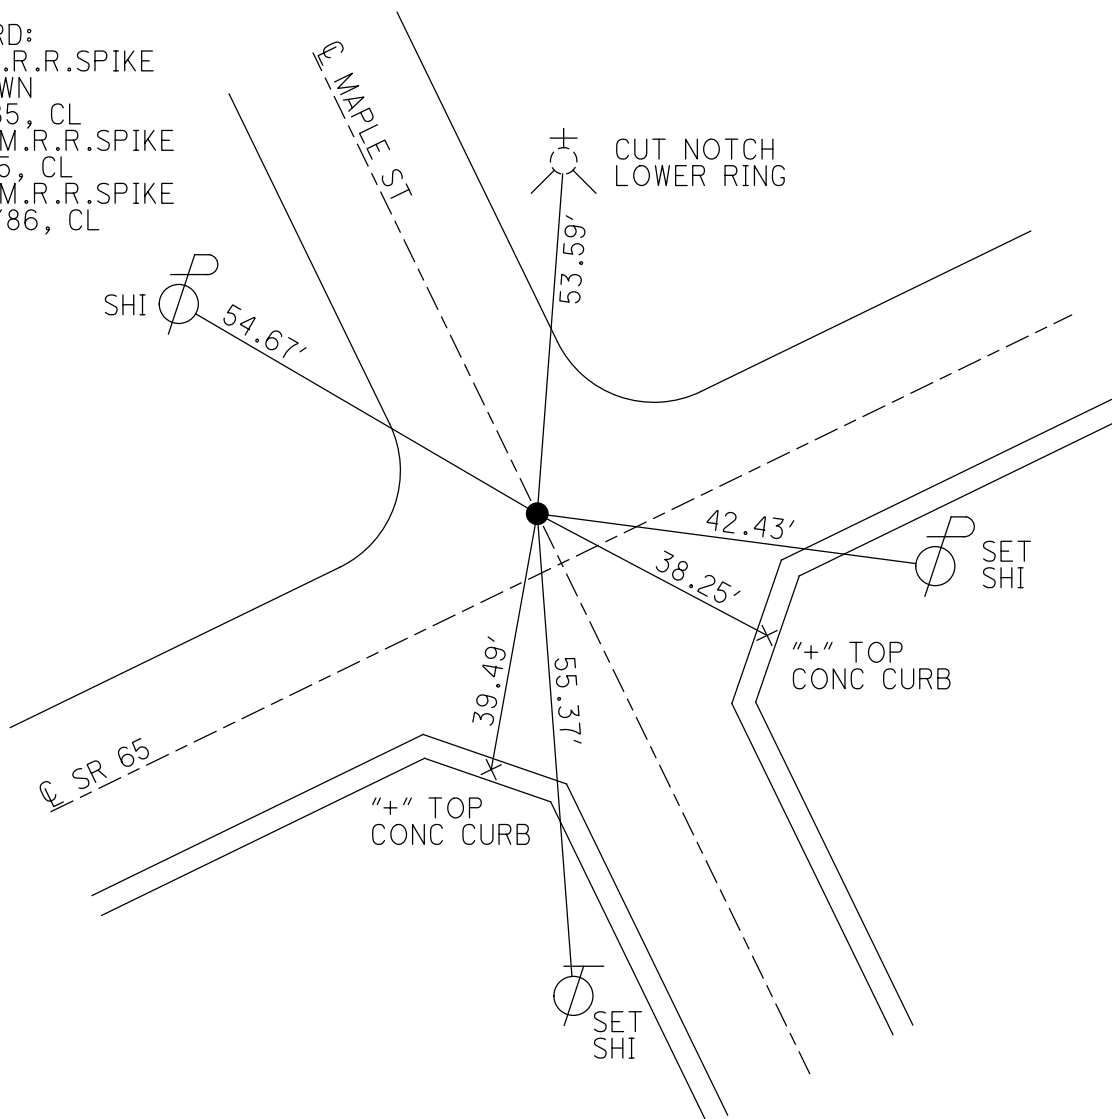

O.D.O.T. DISTRICT 2 SURVEY OFFICE (USE ONLY)

PERSONNEL

REFERENCE NO. 29 H

SHEET 9 OF 9

NOTES LOEHRKE
H.C. BARNHISEL
R.C. HOFFMAN

DATE 6/4/85
WEATHER CLOUDY
TEMP. 64°

ROUTE SR 65
COUNTY WOOD
TOWNSHIP PERRYSBURG
SECTION 12 MILE RESERVE
T 4 US

DWG BY NIESE PID

TYPE MONUMENT LARGE IRON BOLT

~~ON SURFACE~~ - BELOW 6"


OFFSET $\odot$ PAVEMENT 8.6' LT : ~~RT~~

- TO - EDGE PAVEMENT


STATION: 993+78

HORZ.DATUM: GEOID:

GRID: NORTHING: EASTING:

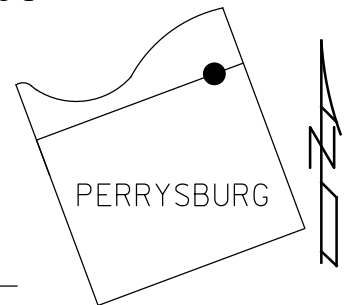

RECORD:
FD LG. IRON BOLT
6" DOWN
6/4/85, CL
SET SM.R.R.SPIKE
7/1/85, CL
SET SM.R.R.SPIKE
11/25/86, CL

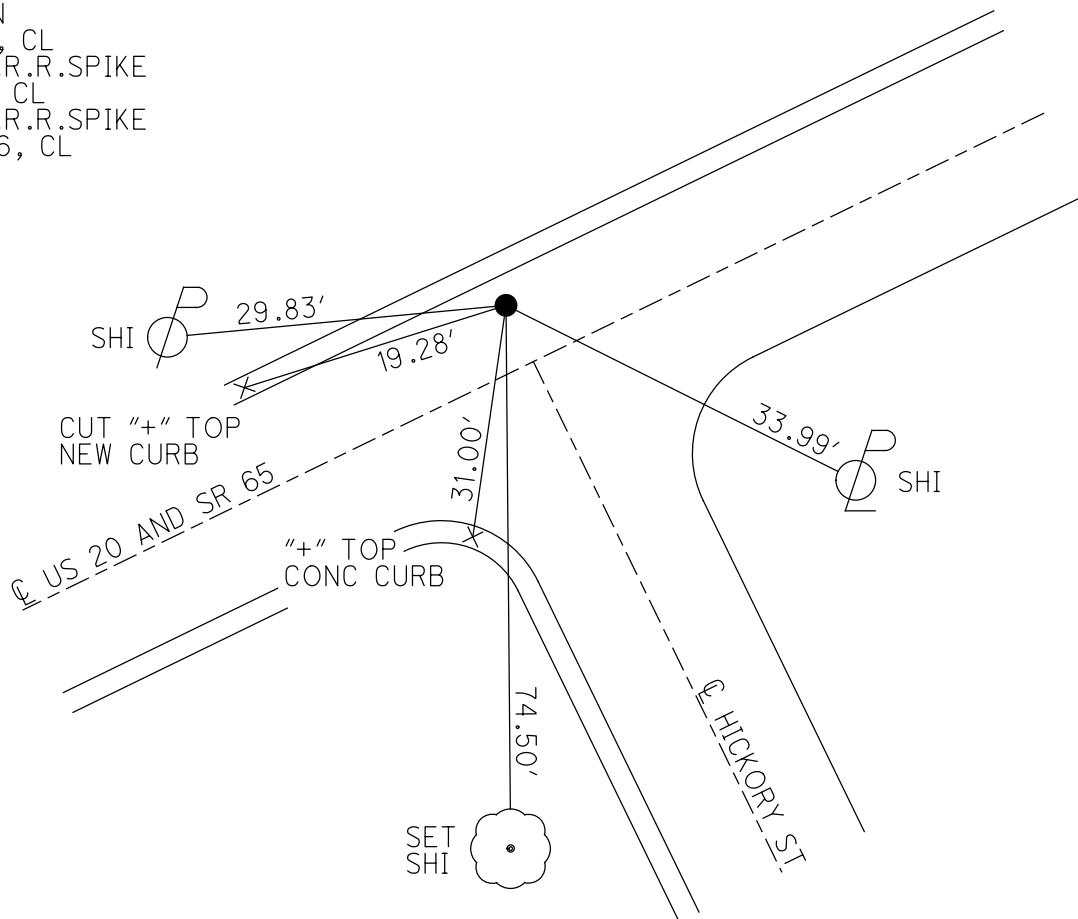

O.D.O.T. DISTRICT 2 SURVEY OFFICE (USE ONLY)

PERSONNEL

REFERENCE NO. 30

SHEET 1 OF 23

NOTES BARRIERE

DATE 7/1/24

ROUTE SR 65

H.C. MILLER

WEATHER SUNNY

COUNTY WOOD

R.C. BLUBAUGH

TEMP. 65°

TOWNSHIP PERRYSBURG

DWG BY BARRIERE

PID 101291

SECTION 68

T 4 N R 12 MI RESERVE

TYPE MONUMENT MONBOX W/ 1" IPIN

ON SURFACE - BELOW ON

OFFSET Q PAVEMENT 7.3' LT : RT

TO EDGE PAVEMENT

STATION: 1003+60

HORIZ.DATUM: NAD83 (2011)



GEOID: 18

GRID: NORTHING:


EASTING:

LDP: NORTHING: 515478.217

EASTING: 172704.287

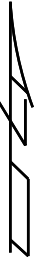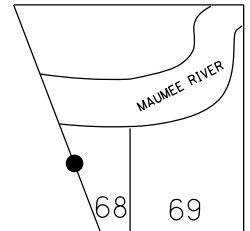

RECORD: P.I.
STA. 0+00
1937 PLANFD R.R.SPIKE
FD P.K.NAIL
5/22/72, BURNSIDE
FD MONBOX
W/1" IPIN
6/4/85, CL
9/13/05, DCH
FD MONBOX W/
1" IPIN
7/1/24, JAM
REF30

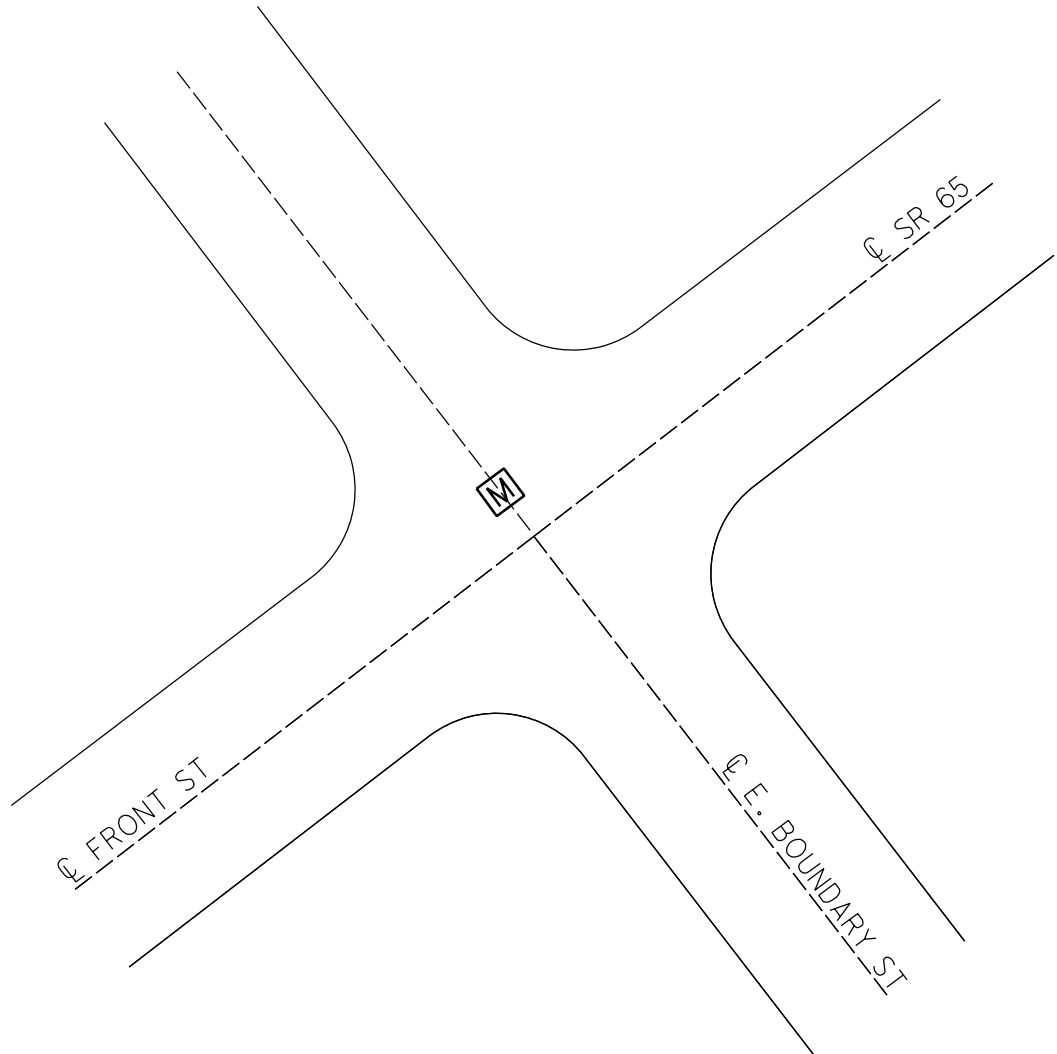

O.D.O.T. DISTRICT 2 SURVEY OFFICE (USE ONLY)

PERSONNEL

REFERENCE NO. 30 A

SHEET 2 OF 23

NOTES BARRIERE
H.C. MILLER
R.C. BLUBAUGH

DATE 7/1/24
WEATHER SUNNY
TEMP. 65°

ROUTE SR 65
COUNTY WOOD
TOWNSHIP PERRYSBURG
SECTION 68

DWG BY BARRIERE PID 101291

T 4 N R 12 MI RESERVE

TYPE MONUMENT MAG/WASHER

ON SURFACE - BELOW ON

OFFSET $\varnothing$ PAVEMENT 9.5' RT LT : RT

TO EDGE PAVEMENT

STATION: 1007+89

HORZ.DATUM: NAD83 (2011)


GEOID: 18

GRID: NORTHING:


EASTING:

LDP: NORTHING: 515669.347

EASTING: 173088.405

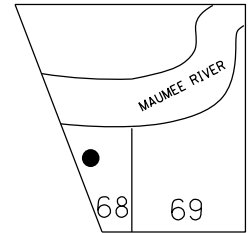

RECORD: P.I.
STA. 3+79.55
1937 PLANS
 $\Delta = 12^\circ 50' \text{ LT}$
FD R.R.SPIKE
FD IRON BLOT
ATOP BRASS R/W MON.
5/22/72, BURNSIDE
SET P.K.NAIL
11/13/80, IRS
FD P.K.NAIL
5/2/88, CL
SET P.K./WASHER
8/26/88, MB
FD P.K.NAIL
9/13/05, DCH
SET MAG/WASHER
10/27/05, SAH
FD MAG/WASH
REF30A
7/11/24, JAM

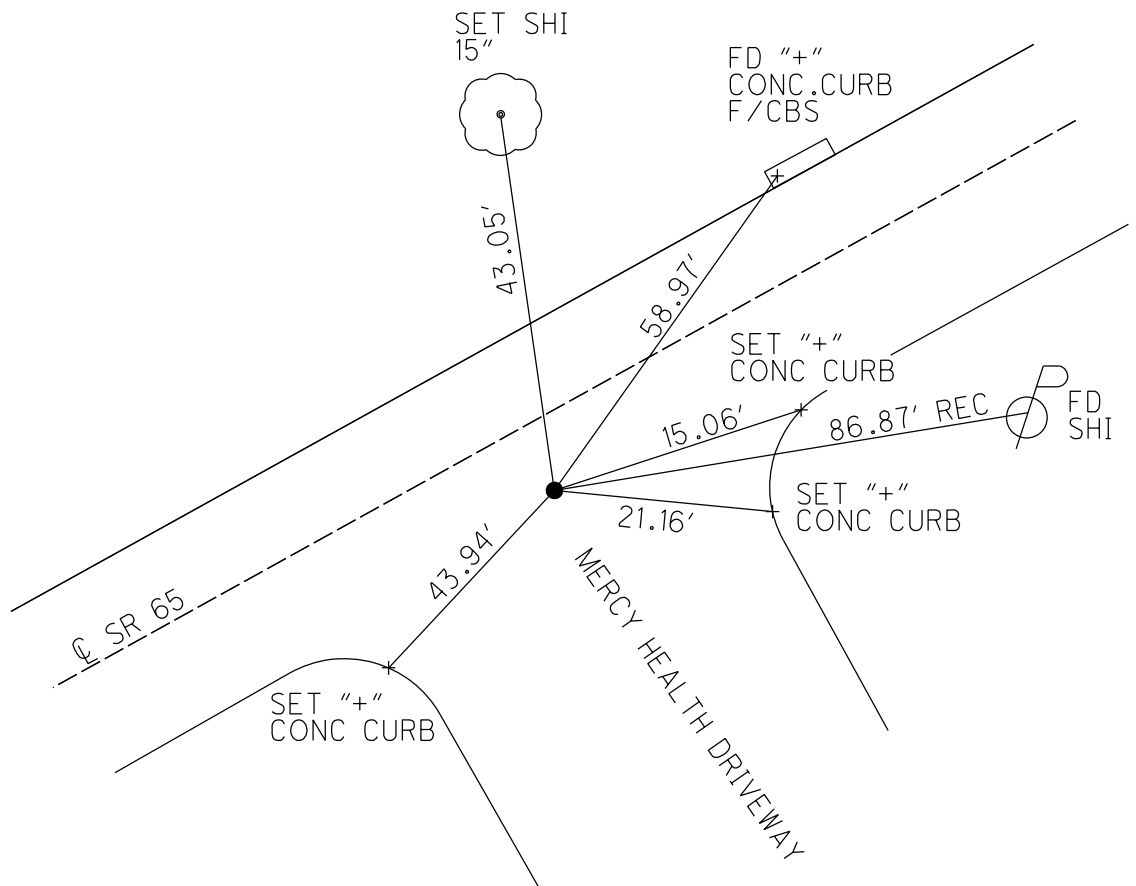

O.D.O.T. DISTRICT 2 SURVEY OFFICE (USE ONLY)

PERSONNEL

REFERENCE NO. 30 B

SHEET 3 OF 23

NOTES BARRIERE

DATE 7/1/24

ROUTE SR 65

H.C. MILLER

WEATHER SUNNY

COUNTY WOOD

R.C. BLUBAUGH

TEMP. 73°

TOWNSHIP PERRYSBURG

SECTION 69

DWG BY BARRIERE

PID 101291

T 3 N R 12 MI RESERVE

TYPE MONUMENT MAG/WASHER

ON SURFACE - BELOW ON

OFFSET Q PAVEMENT 5.3' RT LT : RT

TO EDGE PAVEMENT

STATION: 1035+75

HORZ.DATUM: NAD83 (2011)


GEOID: 18

GRID: NORTHING: 695424.330

EASTING: 1665032.098


LDP: NORTHING: 517430.997

EASTING: 175246.441

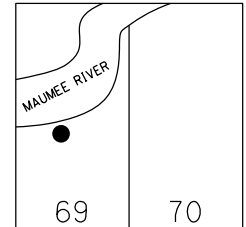

RECORD: P.I.
1937 Q SURVEY
Q RW
STA. 31+66.4
 $\Delta = 9^\circ 50'$ LT
SET MAG/WASHER
10/28/05, SAH
FD MAG/WASHER
REFB30
12/16/19, JFO
FD MAG/WASHER
REF30B
7/1/24, JAM

** DIST. 30B-30BC = 64.73'

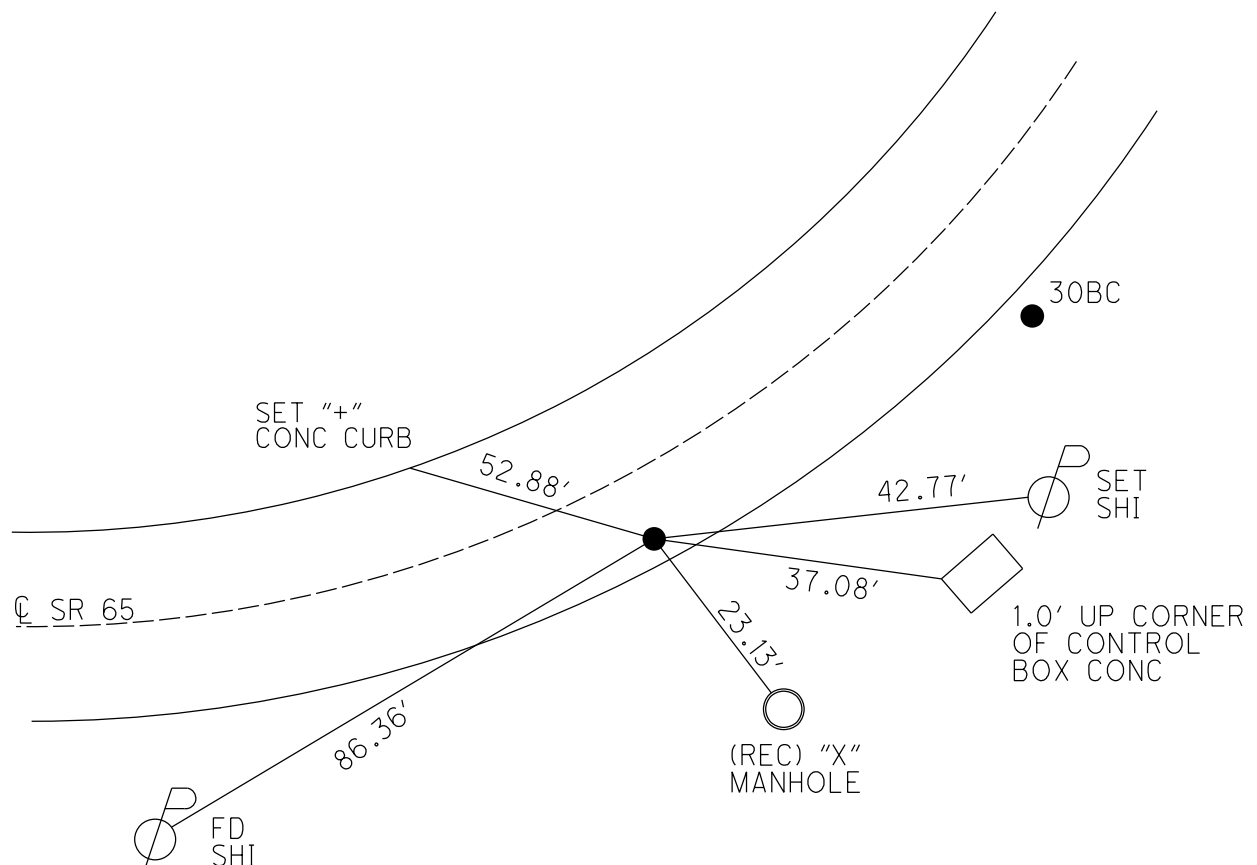

O.D.O.T. DISTRICT 2 SURVEY OFFICE (USE ONLY)

PERSONNEL

REFERENCE NO. 30 BC

SHEET 4 OF 23

NOTES BARRIERE

DATE 7/1/24

ROUTE SR 65

H.C. MILLER

WEATHER SUNNY

COUNTY WOOD

R.C. BLUBAUGH

TEMP. 74°

TOWNSHIP PERRYSBURG

DWG BY BARRIERE

PID 101291

SECTION 69

T 3 N R 12 MI RESERVE

TYPE MONUMENT MAG SHANK

ON SURFACE - BELOW ON

OFFSET $\odot$ PAVEMENT 14.5' RT LT : RT

TO EDGE PAVEMENT

STATION: 1036+40

HORZ.DATUM: NAD83 (2011)


GEOID: 18

GRID: NORTHING: 695462.039

EASTING: 1665084.641


LDP: NORTHING: 517469.438

EASTING: 175298.473

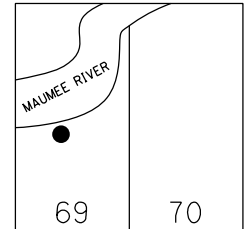

RECORD:
STA 32+31.06
 $\odot$ CONSTRUCTION
 $\Delta = 9^\circ 50'$ LT
SET MAG/WASHER
10/28/05, SAH
FD MAG/WASHER
REFBC30
12/16/19, JFO
FD MAG SHANK
REF30BC
7/1/24, JAM

DIST. 30B-30BC=64.73'

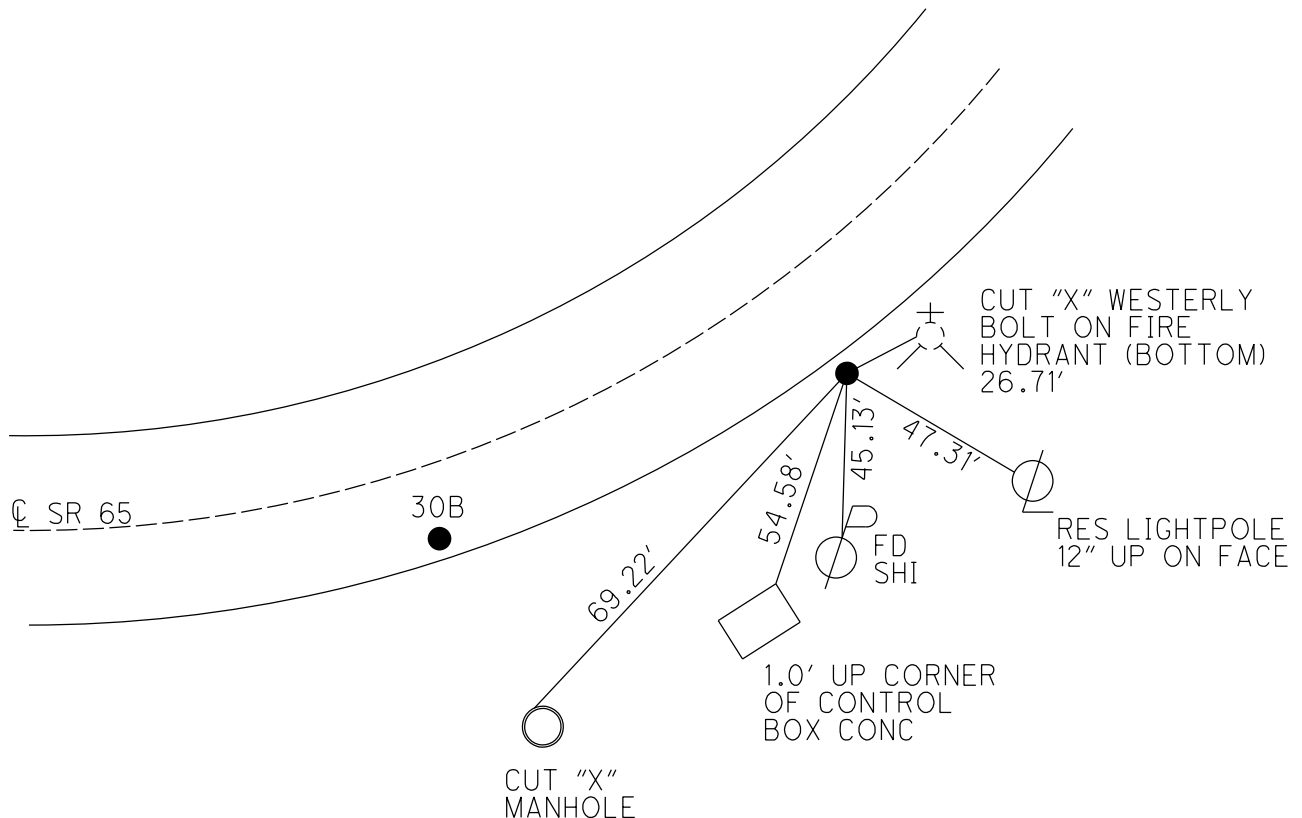

O.D.O.T. DISTRICT 2 SURVEY OFFICE (USE ONLY)

PERSONNEL

REFERENCE NO. 30 C

SHEET 5 OF 23

NOTES BARRIERE
H.C. MILLER
R.C. BLUBAUGH

DATE 7/1/24
WEATHER SUNNY
TEMP. 74°

ROUTE SR 65
COUNTY WOOD
TOWNSHIP PERRYSBURG
SECTION 69

DWG BY BARRIERE PID 101291

T 3 N R 12 MI RESERVE

TYPE MONUMENT MAG SHANK

ON SURFACE - BELOW ON

OFFSET $\varnothing$ PAVEMENT 41.00' RT LT : RT

TO EDGE PAVEMENT

STATION: 1044+34

HORIZ.DATUM: NAD83 (2011)


GEOID: 18

GRID: NORTHING: 696064.792


EASTING: 1665602.426

LDP: NORTHING: 518078.986

EASTING: 175808.260

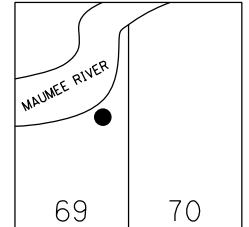

RECORD: P.I.
1937 $\varnothing$ SURVEY
STA. 40+25.7
 $\Delta = 26^\circ 22'$ LT
D = $3^\circ 00'$
T = 447.39'
L = 878.88'
E = 51.69'
R = 1909.86'
T = 298.32'
FD 3/4" IPIN
5/22/72, BURNSIDE
FD STONE
SET DRILLH
11/13/80, IRS
FD IPID
W/ 1 1/2" CAP
3 1/2" DOWN
REFC30
12/16/19, JFO
FD IPID 3" DOWN
NEW TIES PULLED
REF30C
7/1/24, JAM

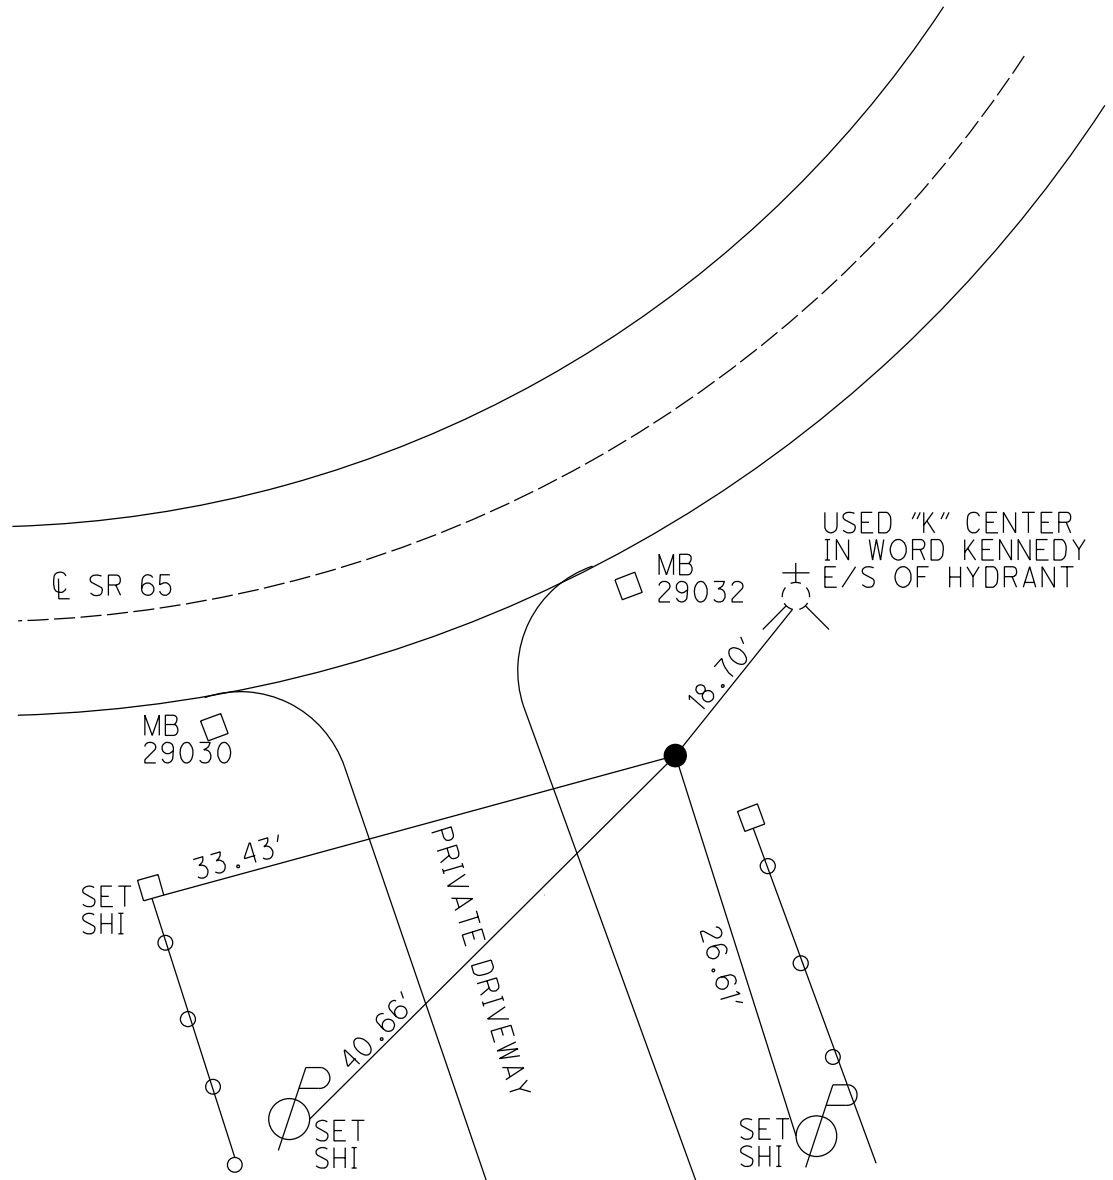

O.D.O.T. DISTRICT 2 SURVEY OFFICE (USE ONLY)

PERSONNEL

REFERENCE NO. 30 D

SHEET 6 OF 23

NOTES BARRIERE

DATE 7/1/24

ROUTE SR 65

H.C. MILLER

WEATHER SUNNY

COUNTY WOOD

R.C. BLUBAUGH

TEMP. 74°

TOWNSHIP PERRYSBURG

DWG BY BARRIERE

PID 101291

SECTION 69

T 3 N R 12 MI RESERVE

TYPE MONUMENT 3/4" IPIN

ON SURFACE - BELOW 12" BELOW

OFFSET Q PAVEMENT 46.3' LT LT : RT

TO EDGE PAVEMENT

STATION: 1052+43

HORIZ.DATUM: _____


GEOID: _____

GRID: NORTHING: _____


EASTING: _____

LDP: NORTHING: _____

EASTING: _____

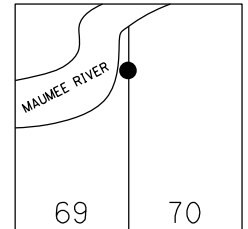

RECORD: P.I.
1937 Q SURVEY & RW
STA. 48+54.2
 $\Delta = 32^{\circ} 09' RT$
DNF
12/16/19, JFO
DID NOT FIND
7/1/24, JAM

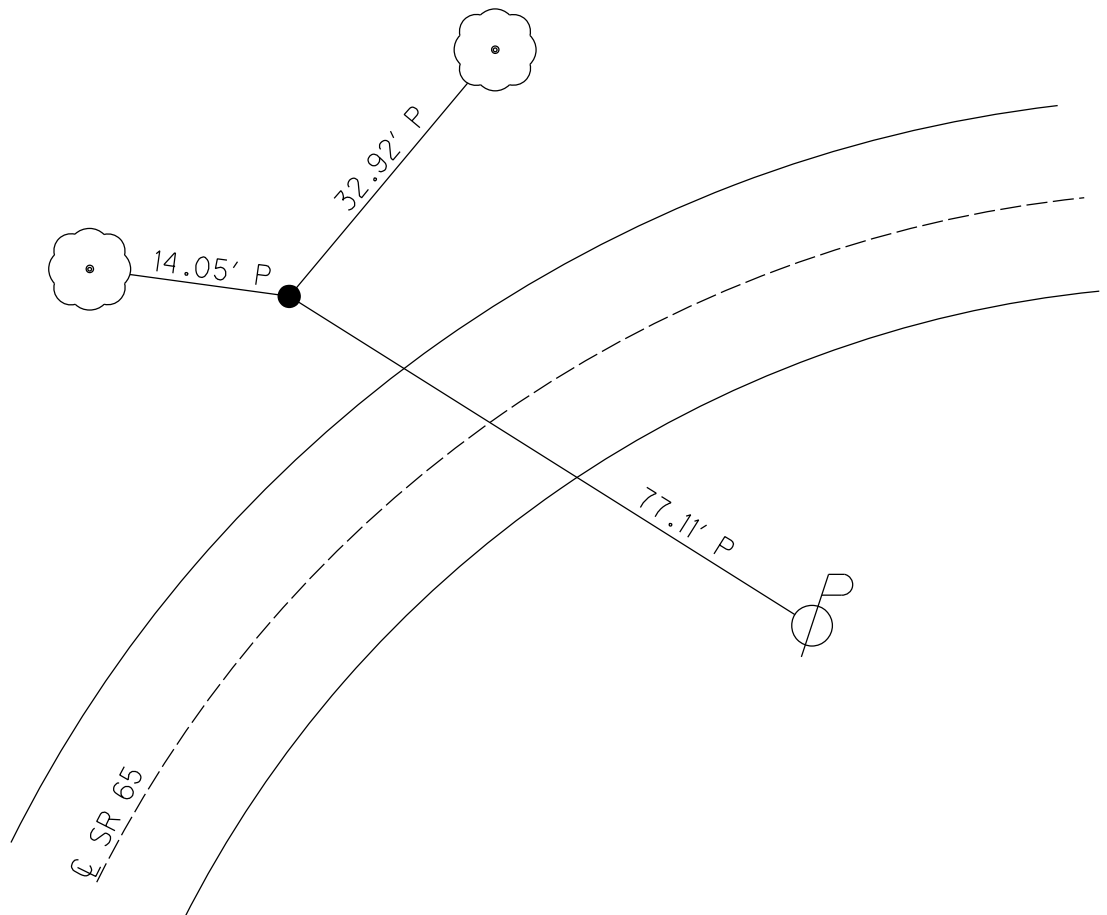

O.D.O.T. DISTRICT 2 SURVEY OFFICE (USE ONLY)

PERSONNEL

REFERENCE NO. 30 E

SHEET 7 OF 23

NOTES BARRIERE
H.C. MILLER
R.C. BLUBAUGH

DATE 7/1/24
WEATHER SUNNY
TEMP. 74°

ROUTE SR 65
COUNTY WOOD
TOWNSHIP PERRYSBURG
SECTION 69

DWG BY BARRIERE PID 101291

T 3 N R 12 MI RESERVE

TYPE MONUMENT MAG/WASHER

ON SURFACE - BELOW ON

OFFSET $\varnothing$ PAVEMENT 7.1' LT LT : RT

TO EDGE PAVEMENT

STATION: 1066+22

HORIZ.DATUM: NAD83 (2011)


GEOID: 18

GRID: NORTHING: 697801.237


EASTING: 1666843.670

LDP: NORTHING: 519831.704

EASTING: 177026.634

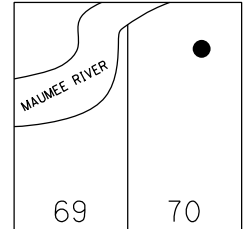

RECORD:
SET MAG/WASHER
10/28/05, SAH
FD MAG/WASHER
REFE30
12/16/19, JFO
FD MAG/WASHER
REF30E
5/8/23, TDN
10/12/23, TDN
FD MAG/WASH
REF30E
7/1/24, JAM

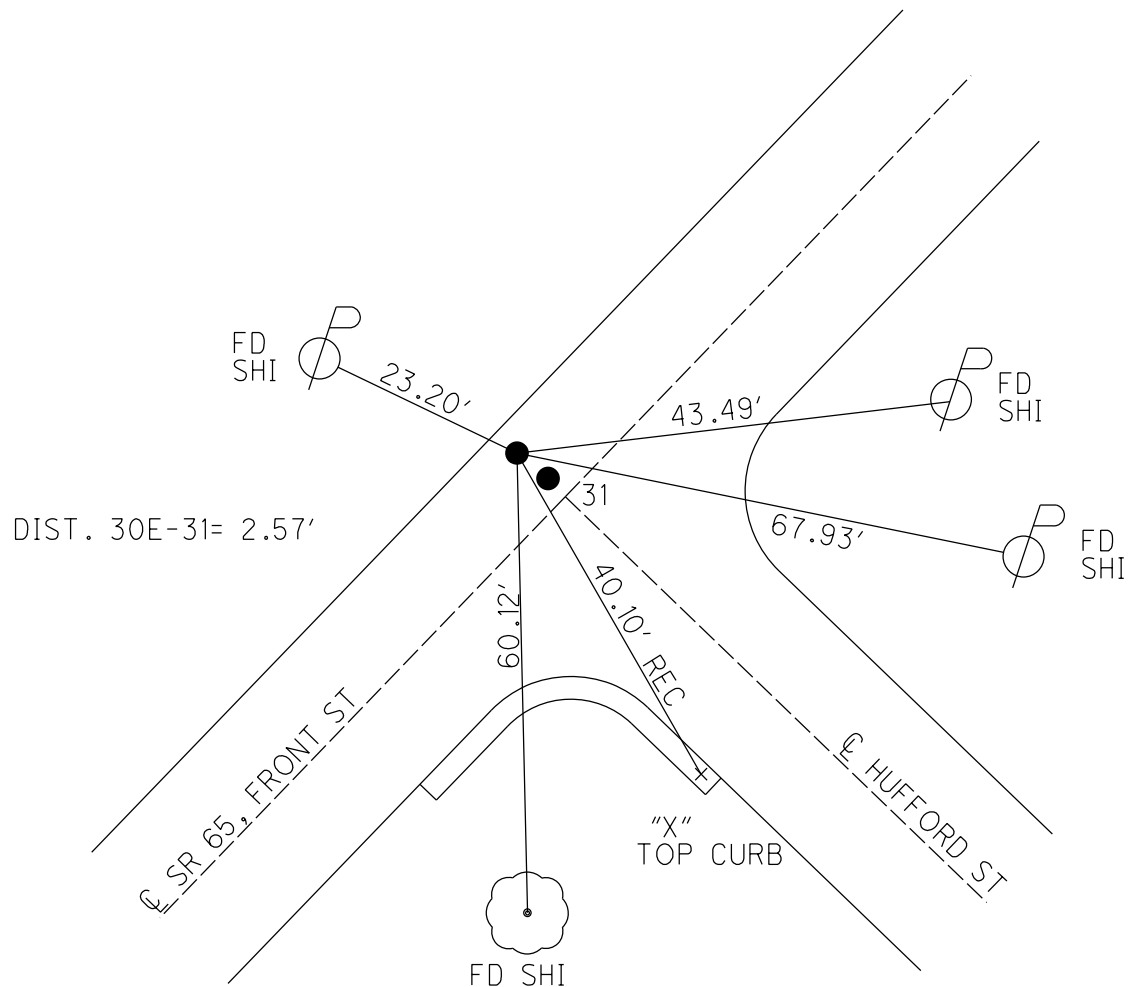

O.D.O.T. DISTRICT 2 SURVEY OFFICE (USE ONLY)

PERSONNEL

REFERENCE NO. 31

SHEET 8 OF 23

NOTES BARRIERE

DATE 7/1/24

ROUTE SR 65

H.C. MILLER

WEATHER SUNNY

COUNTY WOOD

R.C. BLUBAUGH

TEMP. 74°

TOWNSHIP PERRYSBURG

DWG BY BARRIERE

PID 101291

SECTION 70

T 3 N R 12 MI RESERVE

TYPE MONUMENT MAG/WASHER

ON SURFACE - BELOW ON

OFFSET $\varnothing$ PAVEMENT 4.6' LT LT : RT

TO EDGE PAVEMENT

STATION: 1066+22

HORZ.DATUM: NAD83 (2011)


GEOID: 18

GRID: NORTHING: 697799.288


EASTING: 1666845.401

LDP: NORTHING: 519829.847

EASTING: 177028.355

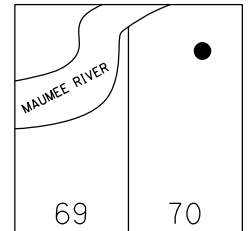

RECORD:
 SET MAG/WASHER
 10/28/05, SAH
 FD MAG/WASHER
 REF 31
 12/16/19, JFO
 FD MAG/WASHER
 REF 31
 5-8-23, TDN
 10/12/23, TDN
 FD MAG/WASH
 REF 31
 7/1/24, JAM

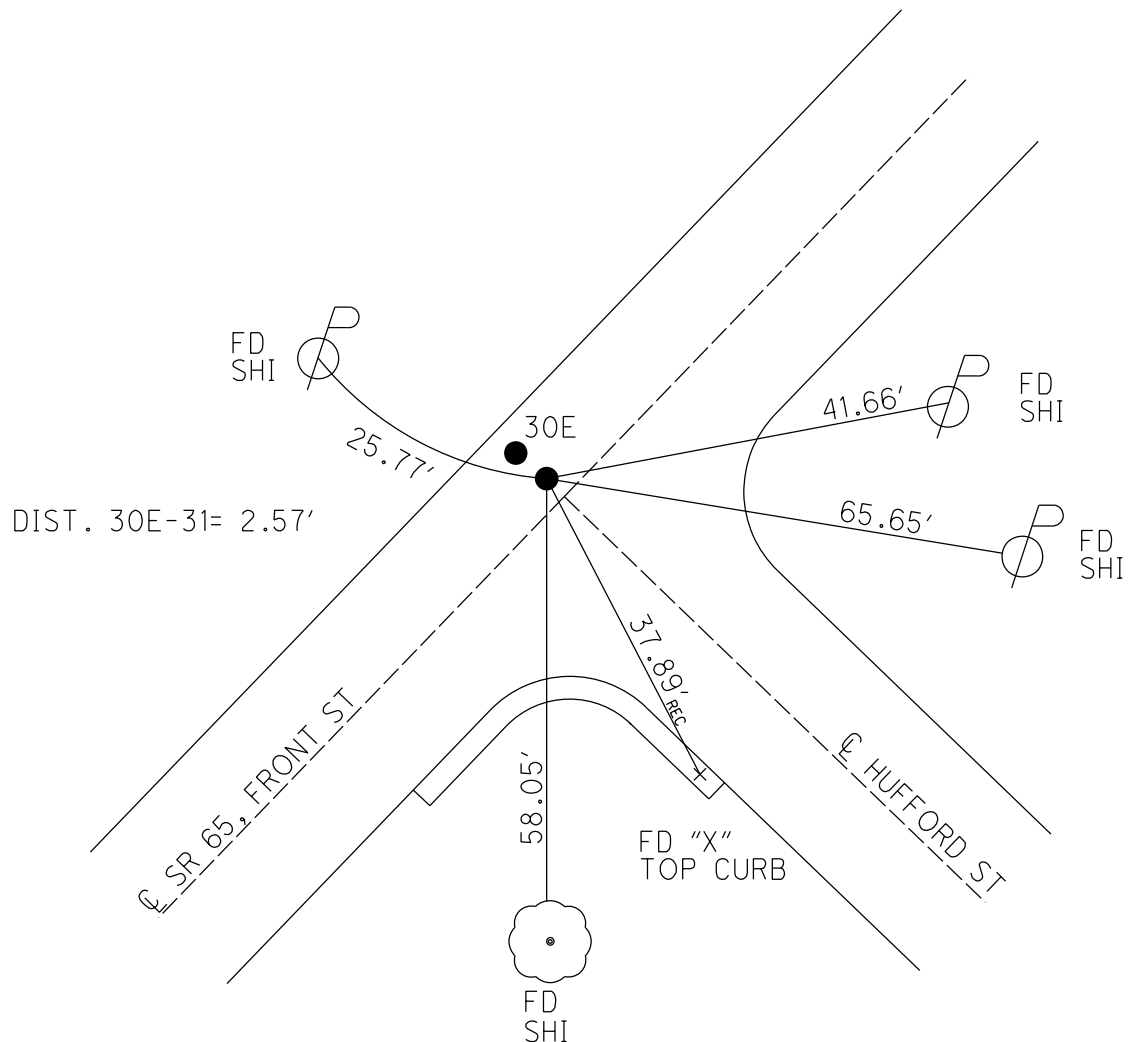

O.D.O.T. DISTRICT 2 SURVEY OFFICE (USE ONLY)

PERSONNEL

REFERENCE NO. 31 A

SHEET 9 OF 23

NOTES BARRIERE

DATE 7/1/24

ROUTE SR 65

H.C. MILLER

WEATHER SUNNY

COUNTY WOOD

R.C. BLUBAUGH

TEMP. 74°

TOWNSHIP PERRYSBURG

DWG BY BARRIERE

PID 101291

SECTION 70

T 3 N R 12 MI RESERVE

TYPE MONUMENT MAG/WASHER

ON SURFACE - BELOW ON

OFFSET ϕ PAVEMENT 7.2' LT LT : RT

TO EDGE PAVEMENT

STATION: 1070+08

HORZ.DATUM: NAD83 (2011)


GEOID: 18

GRID: NORTHING: 698062.320

EASTING: 1667128.321


LDP: NORTHING: 520096.579

EASTING: 177307.750

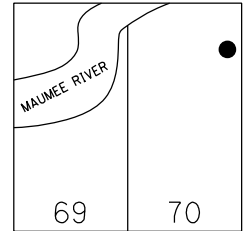

RECORD:
SET MAG/WASHER
10-28-05, SAH
FD MAG/WASHER
REFA31
11-7-2019, JLL
FD MAG/WASHER
5-8-23, TDN
10/12/23, TDN
FD MAG/WASHER
7/10/24, TDN

NOTE: UNDER BRIDGE

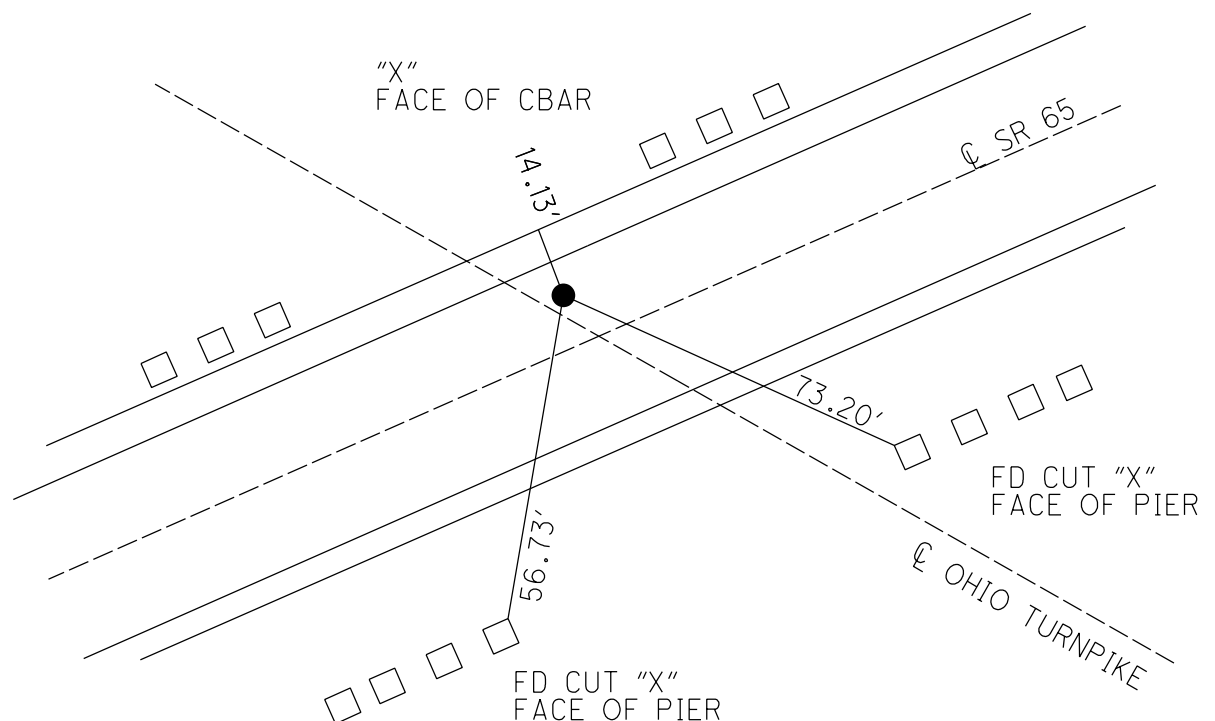

O.D.O.T. DISTRICT 2 SURVEY OFFICE (USE ONLY)

PERSONNEL

REFERENCE NO. 31 B

SHEET 10 OF 23

NOTES BARRIERE
H.C. MILLER
R.C. BLUBAUGH

DATE 7/1/24
WEATHER SUNNY
TEMP. 70°

ROUTE SR 65
COUNTY WOOD
TOWNSHIP PERRYSBURG
SECTION 71
T 3 N R 12 MI RESERVE

DWG BY BARRIERE PID 101291

TYPE MONUMENT MAG SHANK

ON SURFACE - BELOW ON

OFFSET $\varnothing$ PAVEMENT 7.0' LT LT : RT

TO EDGE PAVEMENT

STATION: 1075+11

HORIZ.DATUM: NAD83 (2011)


GEOID: 18

GRID: NORTHING: 698402.077


EASTING: 1667499.575

LDP: NORTHING: 520441.148

EASTING: 177674.556

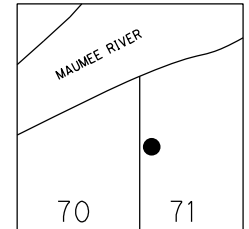

RECORD:
SET MAG/WASHER
10-28-05, SAH
FD MAG SHANK
REFB31
11-7-2019, JLL
FD MAG SHANK
REFB31
11-17-22, TDN
5-8-23, TDN
10/12/23, TDN
FD MAG SHANK
REF31B
7/1/24, JAM
FD MAG SHANK
NEWREF31B
7/10/24, TDN

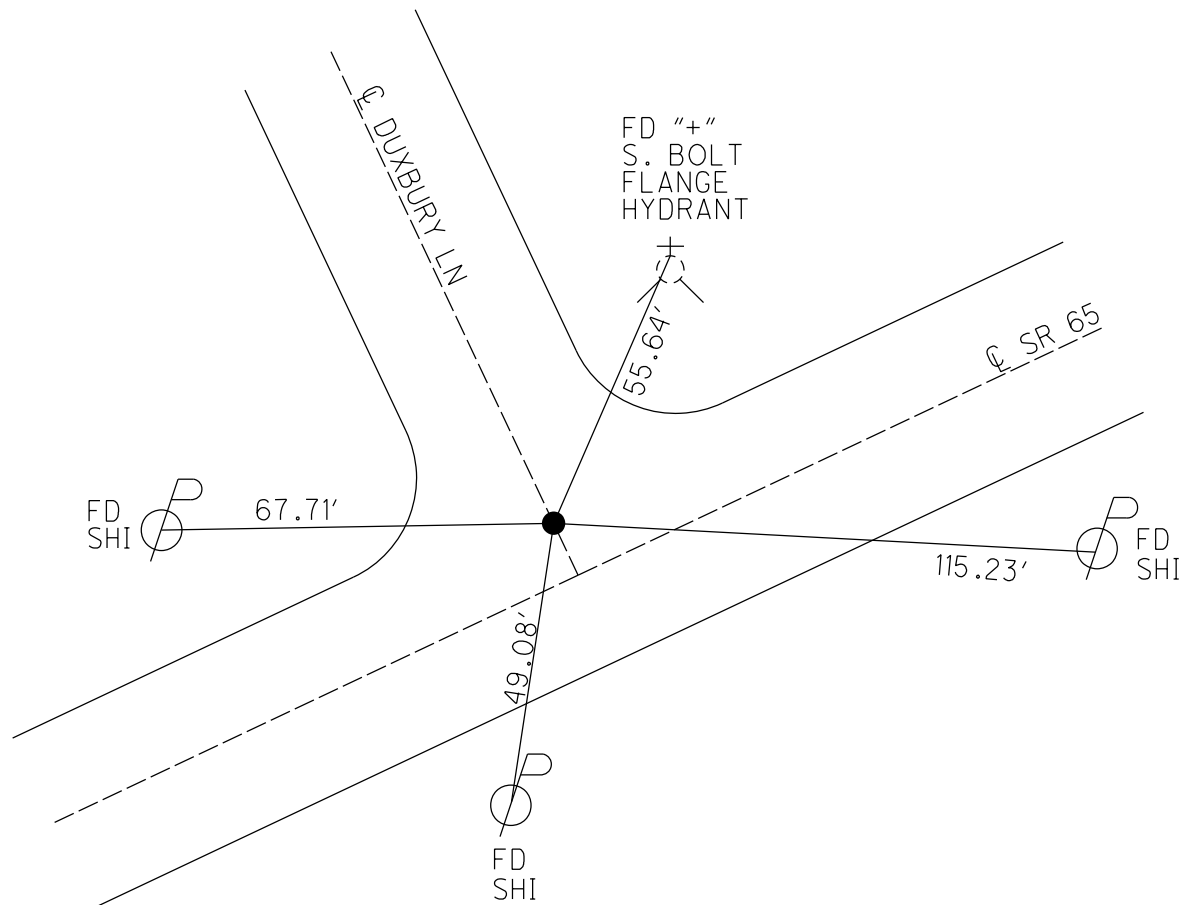

O.D.O.T. DISTRICT 2 SURVEY OFFICE (USE ONLY)

PERSONNEL

REFERENCE NO. 32

SHEET 11 OF 23

NOTES BARRIERE
H.C. MILLER
R.C. BLUBAUGH

DATE 7/1/24
WEATHER SUNNY
TEMP. 70°

ROUTE SR 65
COUNTY WOOD
TOWNSHIP PERRYSBURG
SECTION 71

DWG BY BARRIERE PID 101291

T 3 N R 12 MI RESERVE

TYPE MONUMENT MAG SHANK

ON SURFACE - BELOW ON

OFFSET $\odot$ PAVEMENT 7.0' LT LT : RT

TO EDGE PAVEMENT

STATION: 1088+83

HORIZ.DATUM: NAD83 (2011)


GEOID: 18

GRID: NORTHING: 699328.185


EASTING: 1668510.815

LDP: NORTHING: 521380.648

EASTING: 178673.513

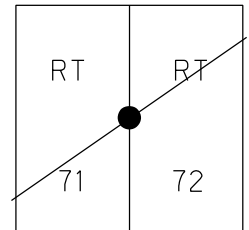

RECORD: P.I.
STA 85+02.65
 $\Delta = 0^\circ 05' RT$
FD OVER BRASS MON
1978
SET MAG/WASHER
10-27-05, SAH
FD MAG/WASHER
REF 32
11-17-22, TDN
FD MAG/WASHER
REF 32
5-8-23, TDN
10/12/23, TDN
FD MAG/WASHER
REF 32
7/1/24, JAM

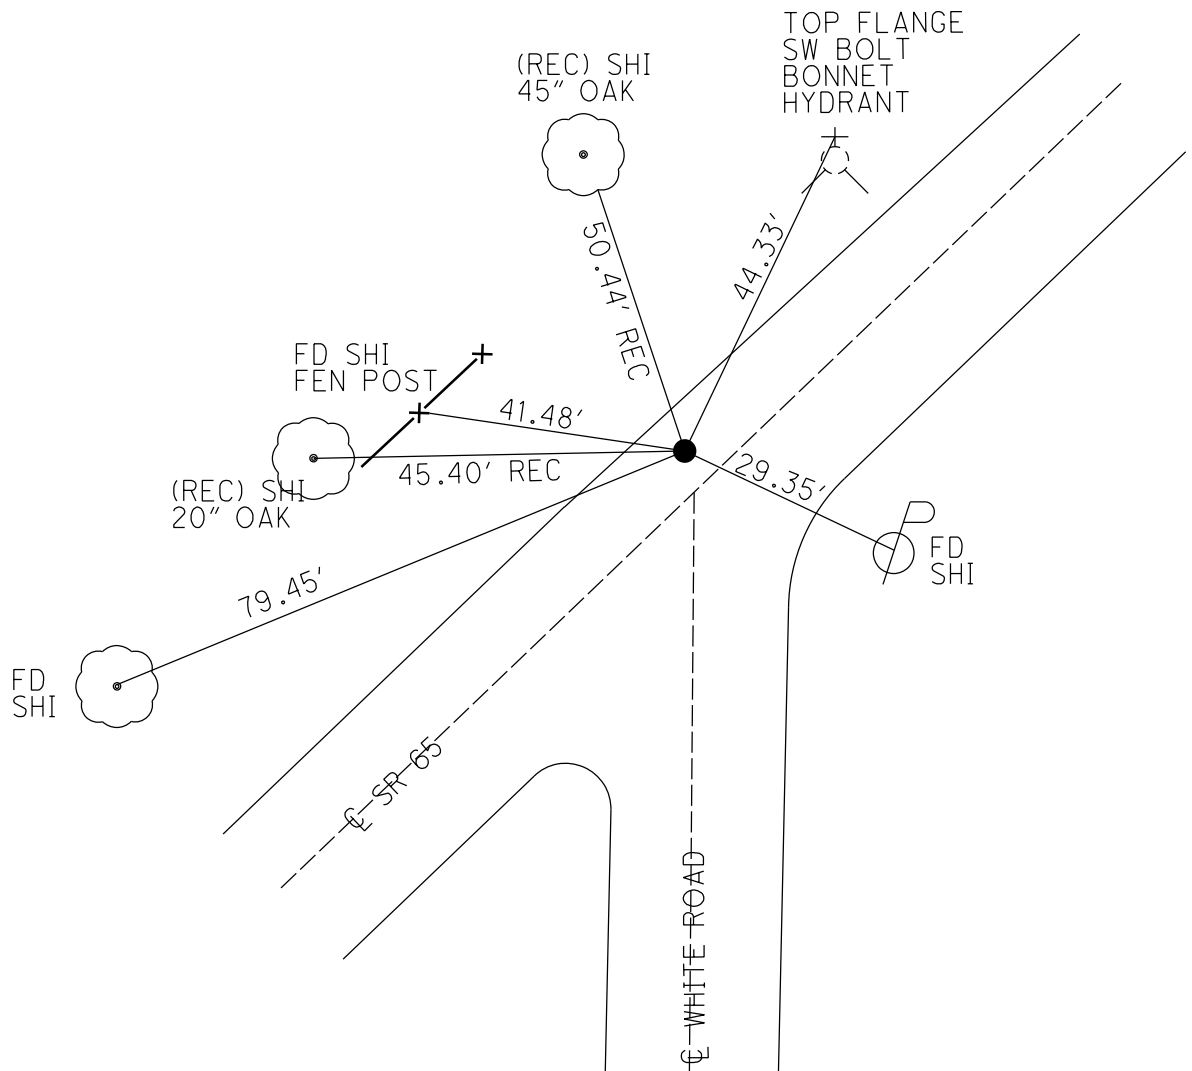

O.D.O.T. DISTRICT 2 SURVEY OFFICE (USE ONLY)

PERSONNEL

REFERENCE NO. 32 A

SHEET 12 OF 23

NOTES BARRIERE
H.C. MILLER
R.C. BLUBAUGH

DATE 7/1/24
WEATHER SUNNY
TEMP. 70°

ROUTE SR 65
COUNTY WOOD
TOWNSHIP PERRYSBURG
SECTION 71

DWG BY BARRIERE PID 101291

T 3 N R 12 MI RESERVE

TYPE MONUMENT MAG SHANK

ON SURFACE - BELOW ON

OFFSET $\angle$ PAVEMENT 3.9' LT LT : RT

TO EDGE PAVEMENT

STATION: 1117+89

HORIZ.DATUM: NAD83 (2011)


GEOID: 18

GRID: NORTHING: 701287.946


EASTING: 1670654.892

LDP: NORTHING: 523368.511

EASTING: 180791.712

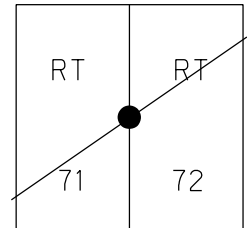

RECORD: P.I.
STA. 114+07.85
 $\Delta = 0^{\circ}05'$ LT
SET P.K.NAIL
ATOP I-BOLT
1937
SET MAG/WASHER
10-27-05, SAH
FD MAG/WASHER
REFA32
11-17-22, DSA
FD MAG/WASHER
5-8-23, TDN
10/12/23, TDN
FD MAG/WASHER
REF32A
7/1/24, JAM

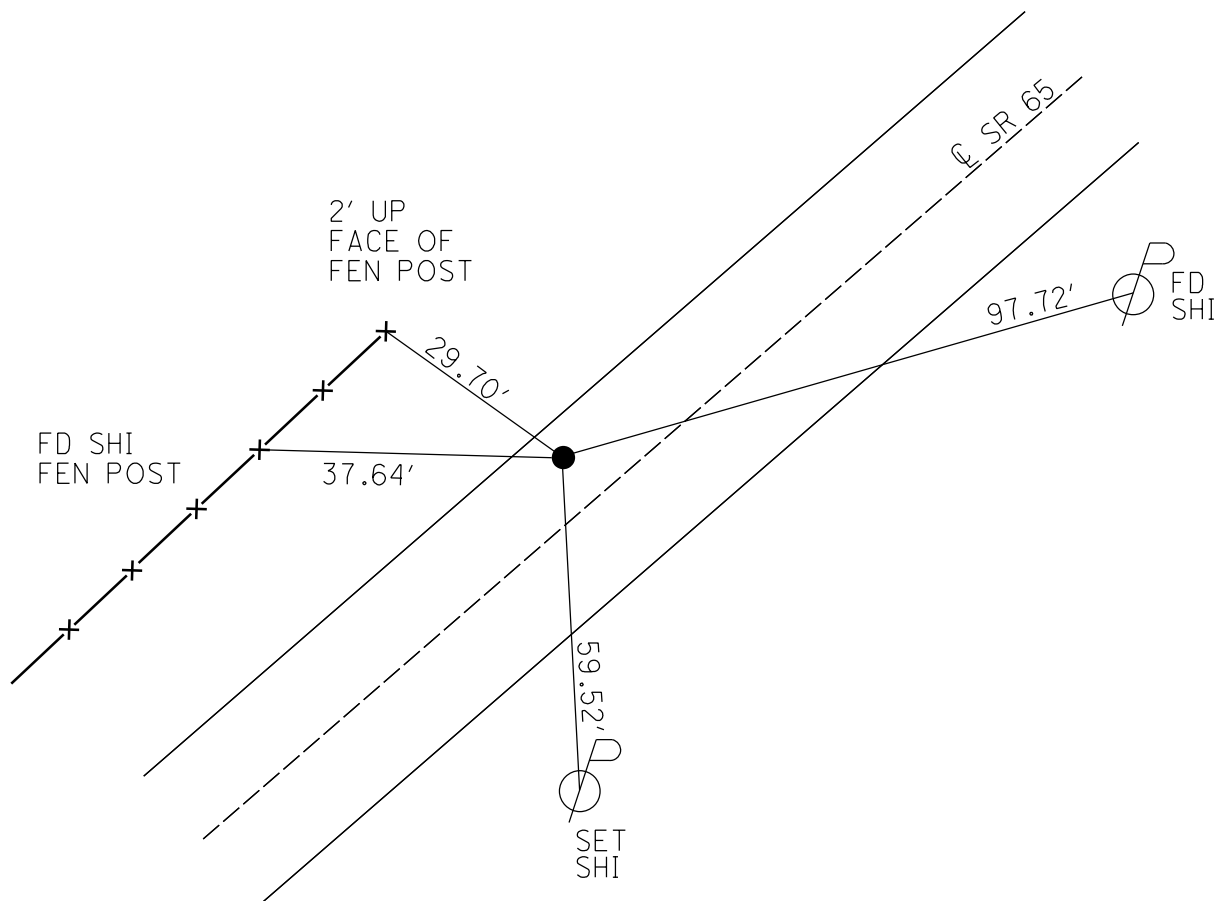

O.D.O.T. DISTRICT 2 SURVEY OFFICE (USE ONLY)

PERSONNEL

REFERENCE NO. 32 B

SHEET 13 OF 23

NOTES BARRIERE
H.C. MILLER
R.C. BLUBAUGH

DATE 7/1/24
WEATHER SUNNY
TEMP. 70°

ROUTE SR 65
COUNTY WOOD
TOWNSHIP PERRYSBURG
SECTION 75
T 3 N R 12 MI RESERVE

DWG BY BARRIERE PID 101291

TYPE MONUMENT MAG/WASHER

ON SURFACE - BELOW ON

OFFSET $\odot$ PAVEMENT 5.7' LT LT : RT

TO EDGE PAVEMENT

STATION: 1142+70

HORIZ.DATUM: NAD83 (2011)


GEOID: 18

GRID: NORTHING:


EASTING:

LDP: NORTHING: 525066.893


EASTING: 182597.887

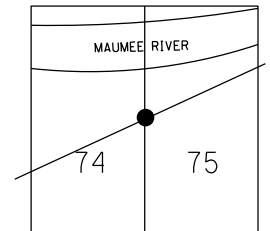

RECORD: P.I.
STA.138+88.8
 $\Delta=0^{\circ}30'$ LT
SET P.K.NAIL
ATOP IPIPE
1937
SET MAG/WASHER
10-27-05, SAH
FD MAG/WASHER
REF32B
11-17-22, TDN
FD MAG/WASHER
REF32B
5-8-23, TDN
10/12/23, TDN
FD MAG/WASHER
REF32B
7/1/24, JAM

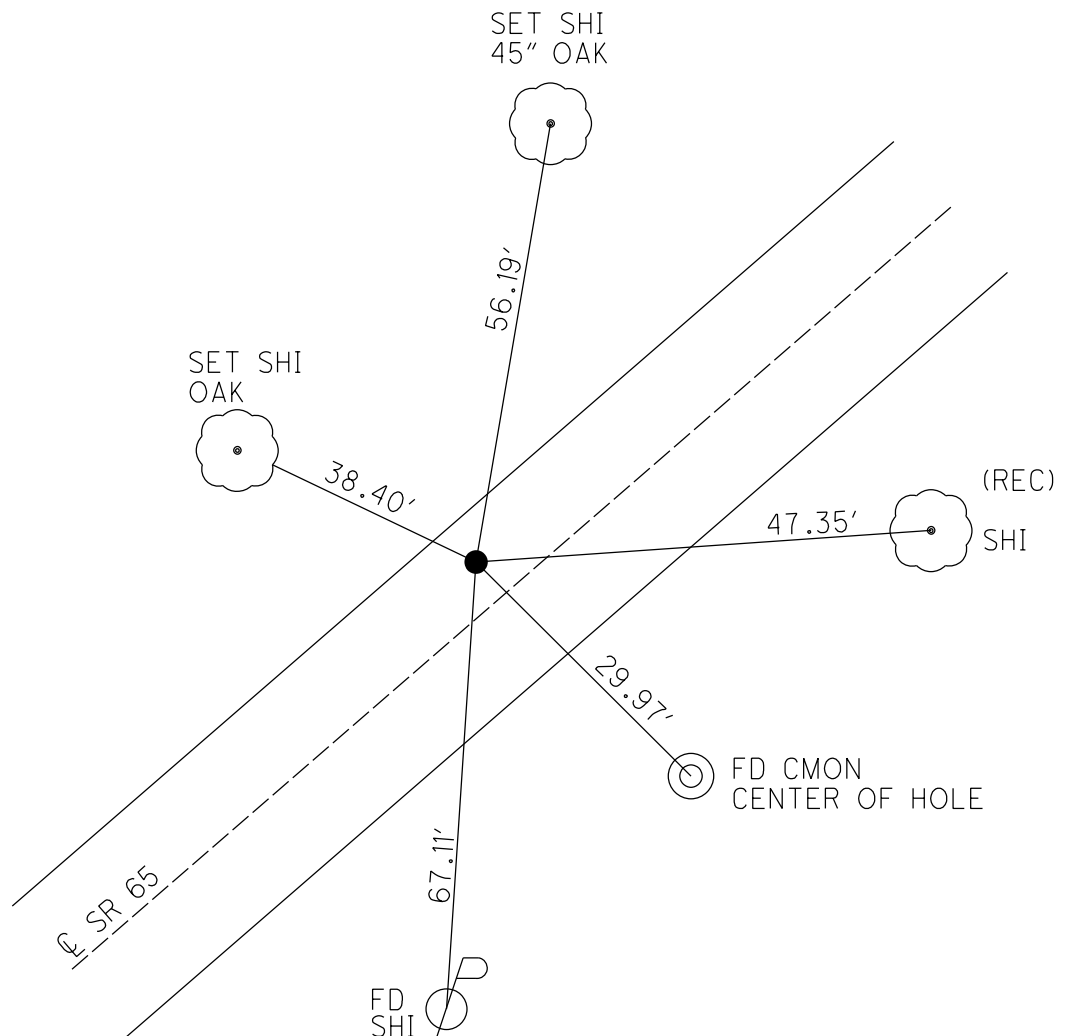

DIST.32C-32CA= 60.43'

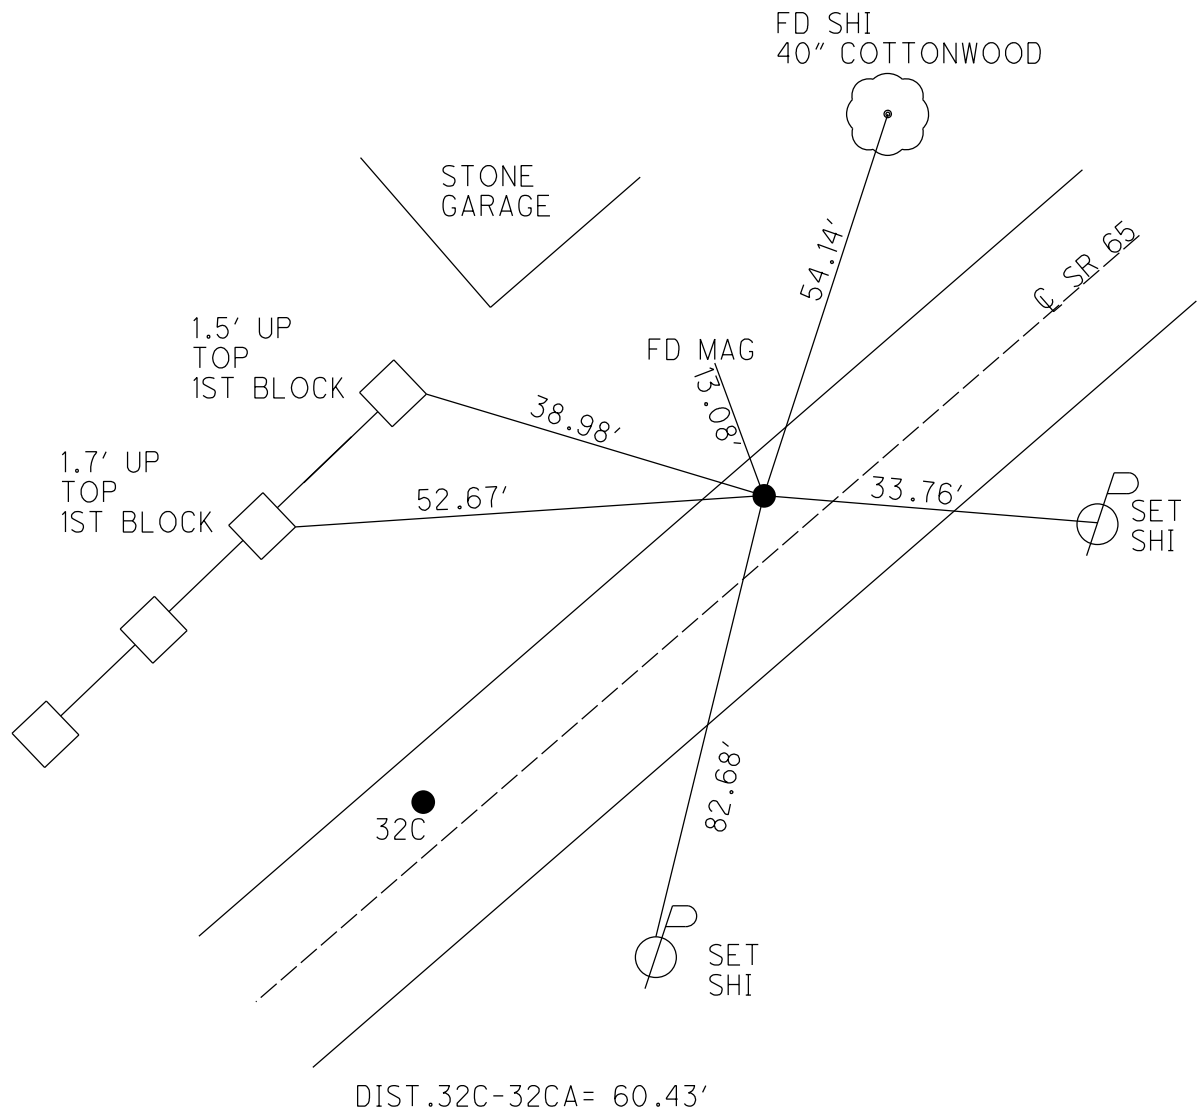

O.D.O.T. DISTRICT 2 SURVEY OFFICE (USE ONLY)

PERSONNEL

REFERENCE NO. 32 CB

SHEET 16 OF 23

NOTES BARRIERE
H.C. MILLER
R.C. BLUBAUGH

DATE 7/1/24
WEATHER SUNNY
TEMP. 68°

ROUTE SR 65
COUNTY WOOD
TOWNSHIP PERRYSBURG
SECTION 75
T 3 N R 12 MI RESERVE

DWG BY BARRIERE PID 101291

TYPE MONUMENT MAG SHANK

ON SURFACE - BELOW ON

OFFSET Q PAVEMENT 0.3' LT LT : RT

TO EDGE PAVEMENT

STATION: 1160+35

HORIZ.DATUM: NAD83 (2011)


GEOID: 18

GRID: NORTHING: 704083.837


EASTING: 1673837.423

LDP: NORTHING: 526206.366

EASTING: 183937.184

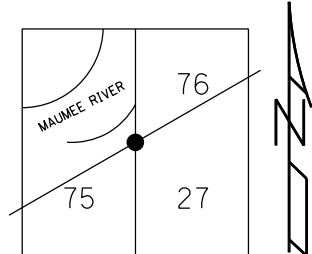

RECORD:
ORIGIN UNKNOWN
FD P.K.NAIL
9/14/05, DCH
SET MAG/WASHER
10/27/05, SAH
FD MAG SHANK
REF32CB
5/8/23, TDN
10/12/23, TDN
FD MAG SHANK
REF32CB
7/1/24, JAM

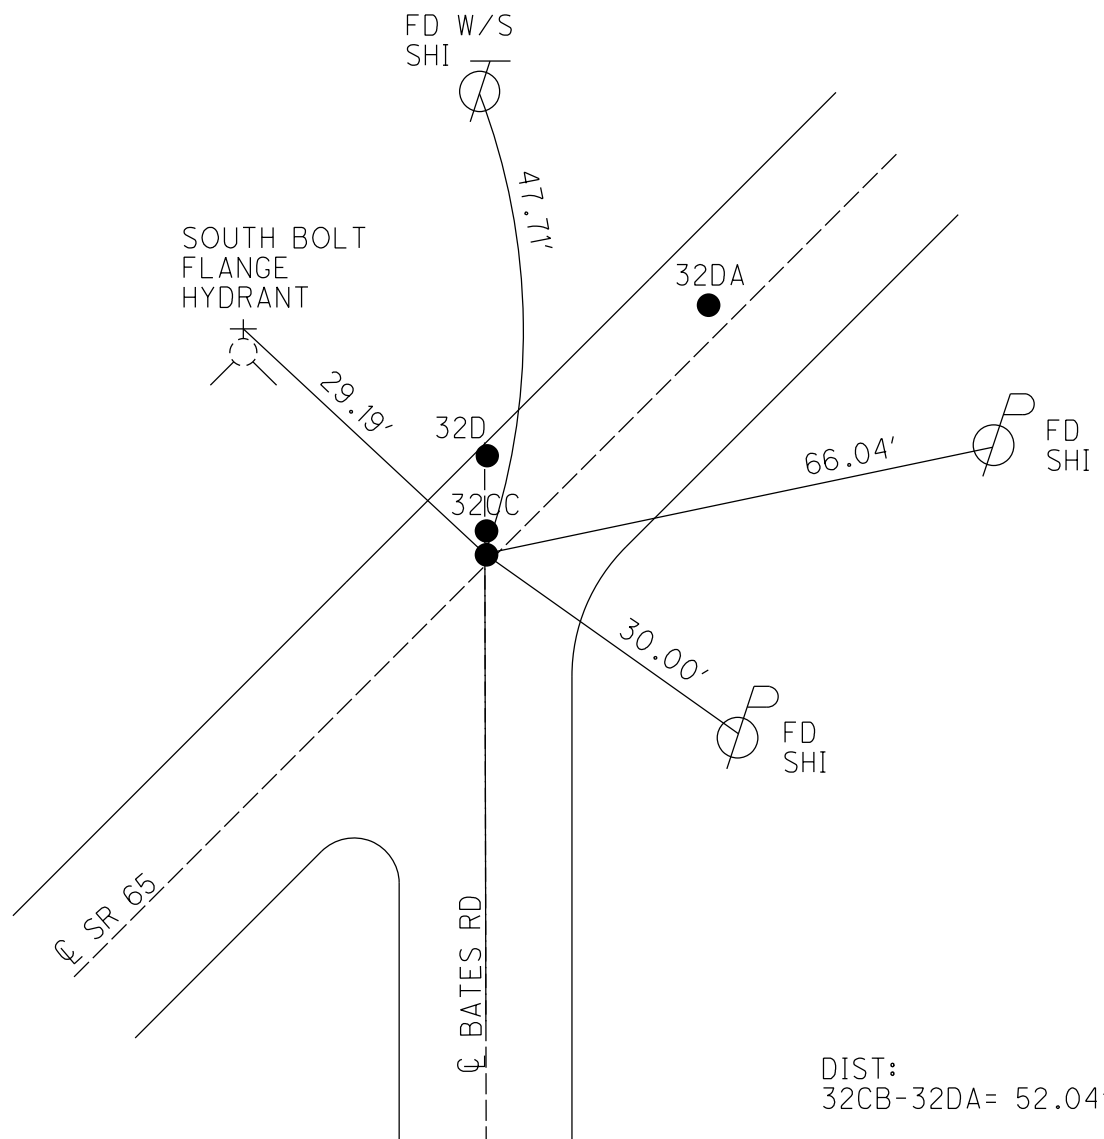

O.D.O.T. DISTRICT 2 SURVEY OFFICE (USE ONLY)

PERSONNEL

REFERENCE NO. 32 CC

SHEET 16 OF 23

NOTES BARRIERE
H.C. MILLER
R.C. BLUBAUGH

DATE 7/1/24
WEATHER SUNNY
TEMP. 68°

ROUTE SR 65
COUNTY WOOD
TOWNSHIP PERRYSBURG
SECTION 75

DWG BY BARRIERE PID 101291

T 3 N R 12 MI RESERVE

TYPE MONUMENT MAG/WASHER

ON SURFACE - BELOW ON

OFFSET $\angle$ PAVEMENT 1.2' LT LT : RT

TO EDGE PAVEMENT

STATION: 1160+35

HORIZ.DATUM: NAD83 (2011)


GEOID: 18

GRID: NORTHING: 704084.736

EASTING: 1673837.378


LDP: NORTHING: 526207.253

EASTING: 183937.153

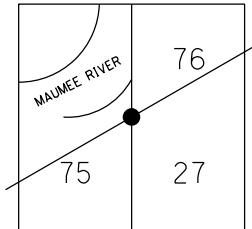

RECORD:

ORIGIN UNKNOWN
FD P.K.NAIL
9/14/05, DCH
SET MAG/WASHER
10/27/05, SAH
FD MAG/WASHER
REF32CC
5/8/23, TDN
10/12/23, TDN
FD MAG/WASH
REF32CC
7/1/24, JAM

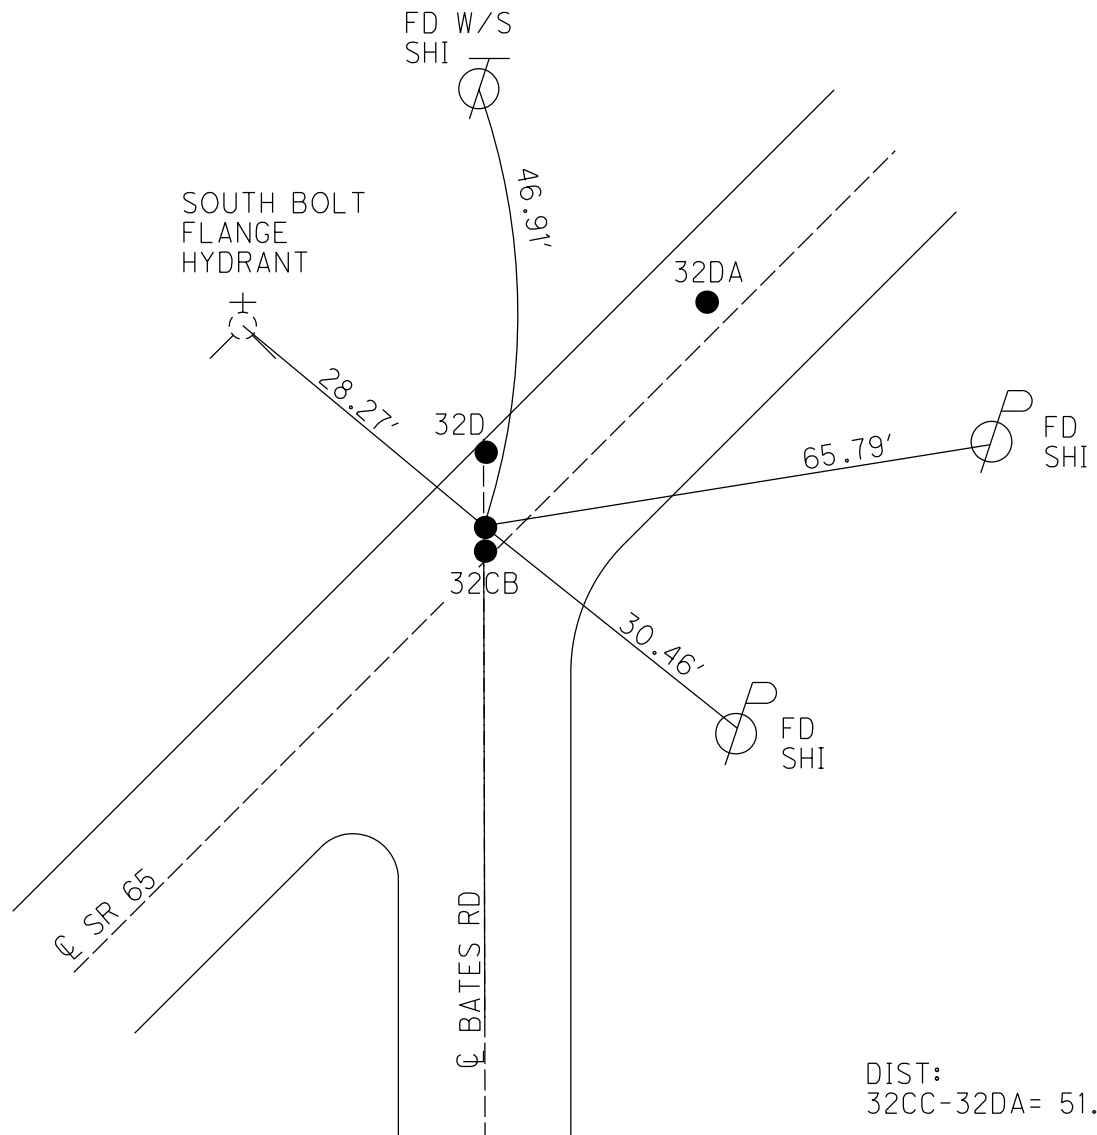

DIST:
32CC-32DA= 51.51'

O.D.O.T. DISTRICT 2 SURVEY OFFICE (USE ONLY)

PERSONNEL

REFERENCE NO. 32 D

SHEET 18 OF 23

NOTES BARRIERE
H.C. MILLER
R.C. BLUBAUGH

DATE 7/1/24
WEATHER SUNNY
TEMP. 68°

ROUTE SR 65
COUNTY WOOD
TOWNSHIP PERRYSBURG
SECTION 75

DWG BY BARRIERE PID 101291

T 3 N R 12 MI RESERVE

TYPE MONUMENT MAG/WASHER

ON SURFACE - BELOW ON

OFFSET $\varnothing$ PAVEMENT 10.9' LT LT : RT

TO EDGE PAVEMENT

STATION: 1160+37

HORIZ.DATUM: NAD83 (2011)


GEOID: 18

GRID: NORTHING: 704094.544


EASTING: 1673837.437

LDP: NORTHING: 526217.068

EASTING: 183937.044

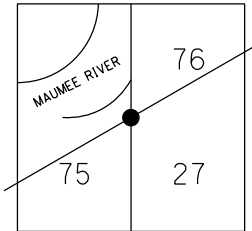

RECORD:
STA 156+49.15
 $\Delta = 0^\circ 0'$
SET P.K.NAIL
1937
FD IPIN
6" DOWN
9/14/05, DCH
SET MAG/WASHER
10-27-05, SAH
FD MAG/WASHER
REF32D
5-8-23, TDN
10/12/23, TDN
FD MAG/WASH
REF32D
7/1/24, JAM

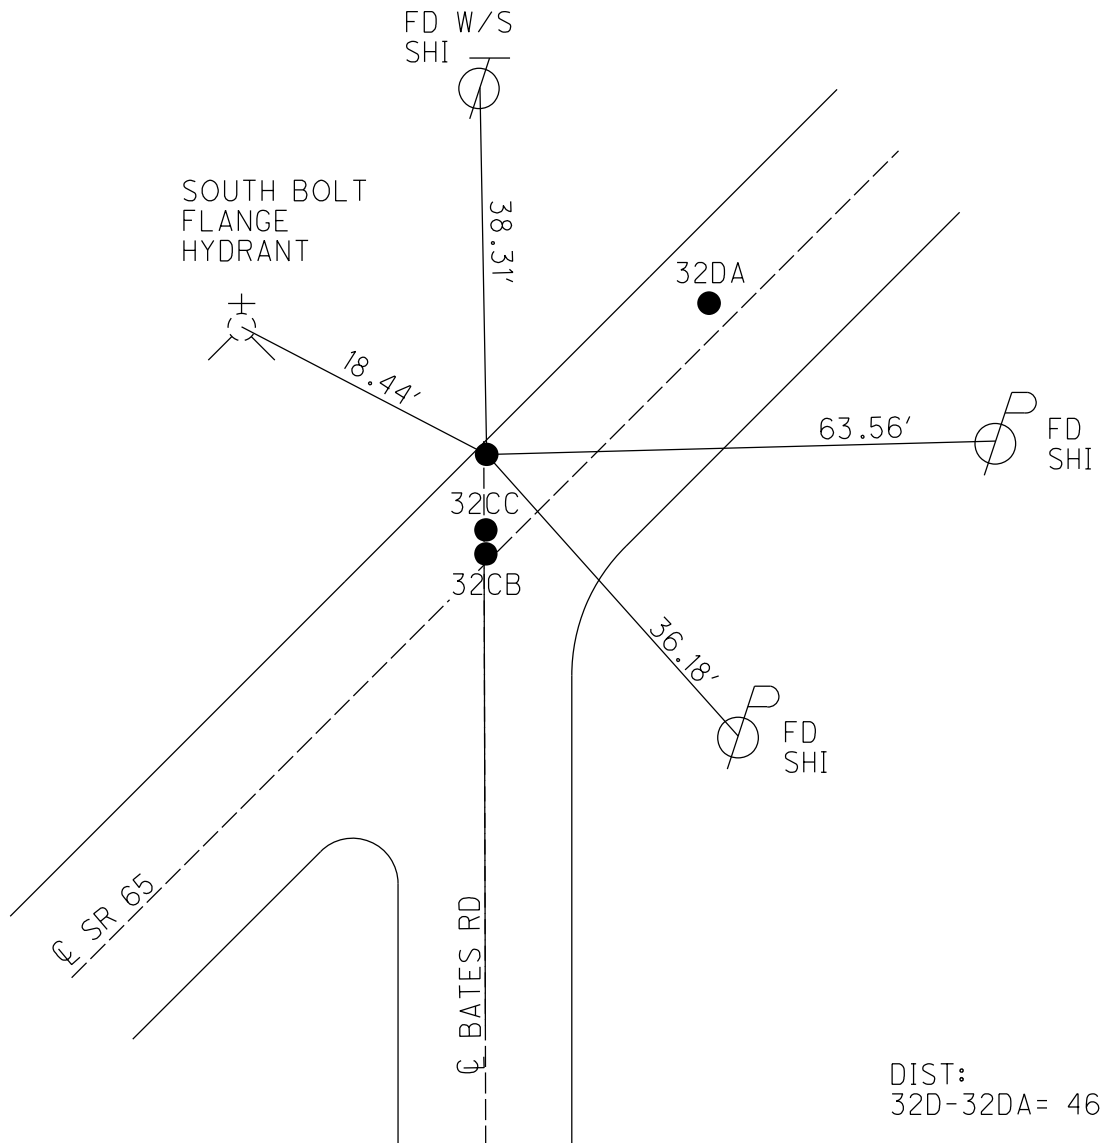

DIST:
32D-32DA= 46.31'

O.D.O.T. DISTRICT 2 SURVEY OFFICE (USE ONLY)

PERSONNEL

REFERENCE NO. 32 DA

SHEET 19 OF 23

NOTES BARRIERE
H.C. MILLER
R.C. BLUBAUGH

DATE 7/1/24
WEATHER SUNNY
TEMP. 68°

ROUTE SR 65
COUNTY WOOD
TOWNSHIP PERRYSBURG
SECTION 75

DWG BY BARRIERE PID 101291

T 3 N R 12 MI RESERVE

TYPE MONUMENT MAG/WASHER

ON SURFACE - BELOW ON

OFFSET $\varnothing$ PAVEMENT 1.2' LT LT : RT

TO EDGE PAVEMENT

STATION: 1160+87

HORZ.DATUM: NAD83 (2011)


GEOID: 18

GRID: NORTHING: 704115.381

EASTING: 1673878.811


LDP: NORTHING: 526238.456

EASTING: 183978.187

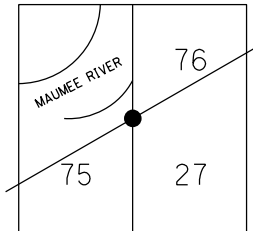

RECORD:

P.I.
STA.157+00.85
FD SM.R.R.SPIKE
9/14/05, DCH
SET MAG/WASHER
10/27/05, SAH
FD MAG/WASHER
REF32DA
5/8/23, TDN
10/12/23, TDN
FD MAG/WASH
REF32DA
7/1/24, JAM

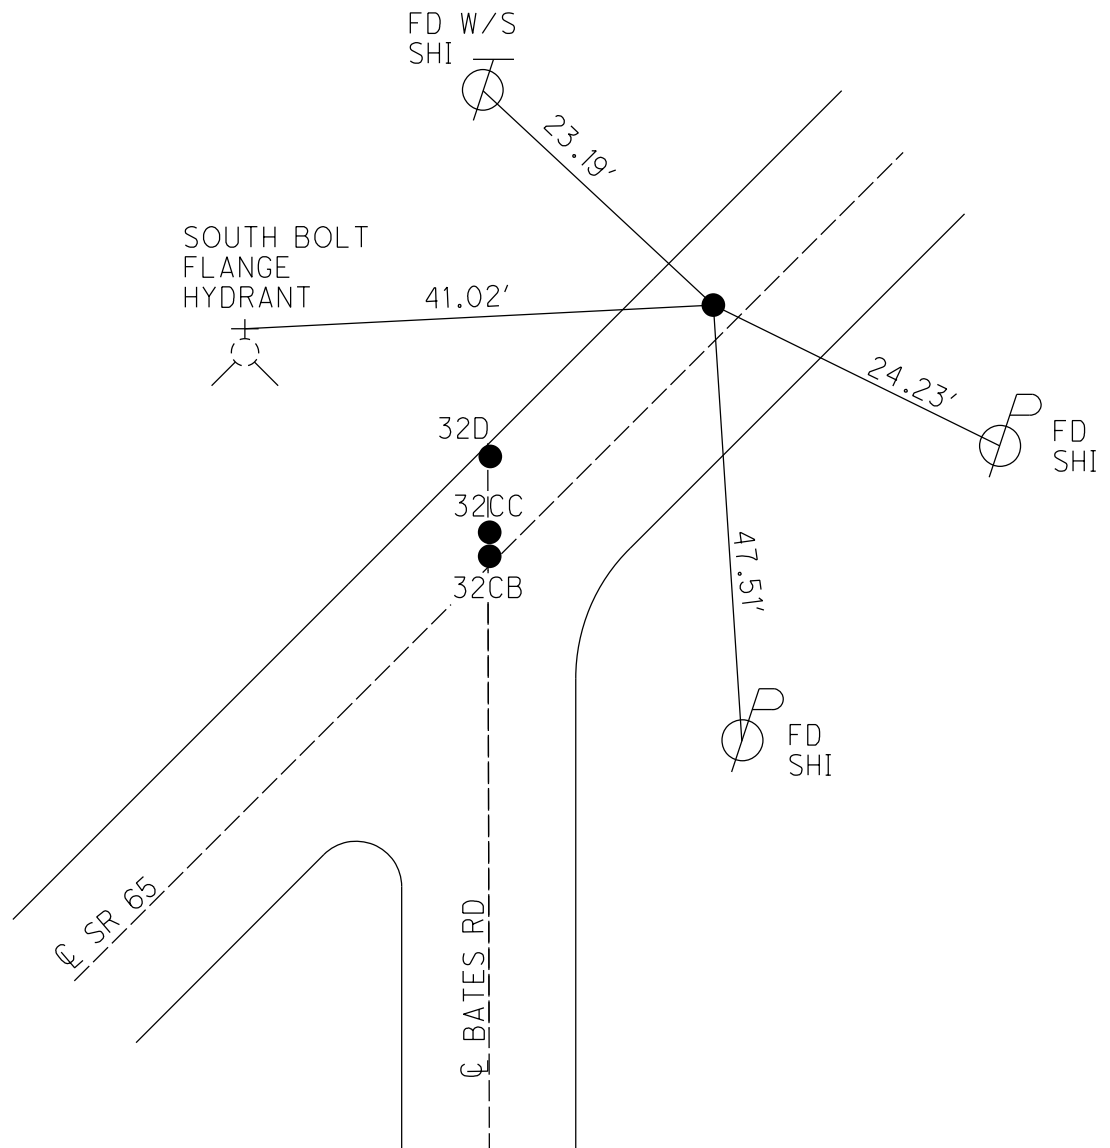

O.D.O.T. DISTRICT 2 SURVEY OFFICE (USE ONLY)

PERSONNEL

REFERENCE NO. 35

SHEET 20 OF 23

NOTES BARRIERE
H.C. MILLER
R.C. BLUBAUGH

DATE 7/1/24
WEATHER SUNNY
TEMP. 68°

ROUTE SR 65
COUNTY WOOD
TOWNSHIP PERRYSBURG
SECTION 78

DWG BY BARRIERE PID 101291

T 8 N N 11 E

TYPE MONUMENT MAG/WASHER

ON SURFACE - BELOW ON

OFFSET $\varnothing$ PAVEMENT 5.8' LT LT : RT

TO EDGE PAVEMENT

STATION: 1198+18

HORIZ.DATUM: NAD83 (2011)

GEOID: 18

GRID: NORTHING: 706739.871


EASTING: 1676540.680

LDP: NORTHING: 528897.886


EASTING: 186605.235

79	80	81	82	83
78	●			
77				
76				

SEC 23

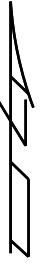

RECORD:
FD P.K. NAIL
4/24/91, MB
SET PK/WASHER
5-31-91, MB
CITY OF ROSSFORD
TO SET MONBOX
FD MONBOX
W/1" IPIN & DIMPLE
REF35
10-5-21, DSA
FD MONBOX
REF35
7/1/24, JAM

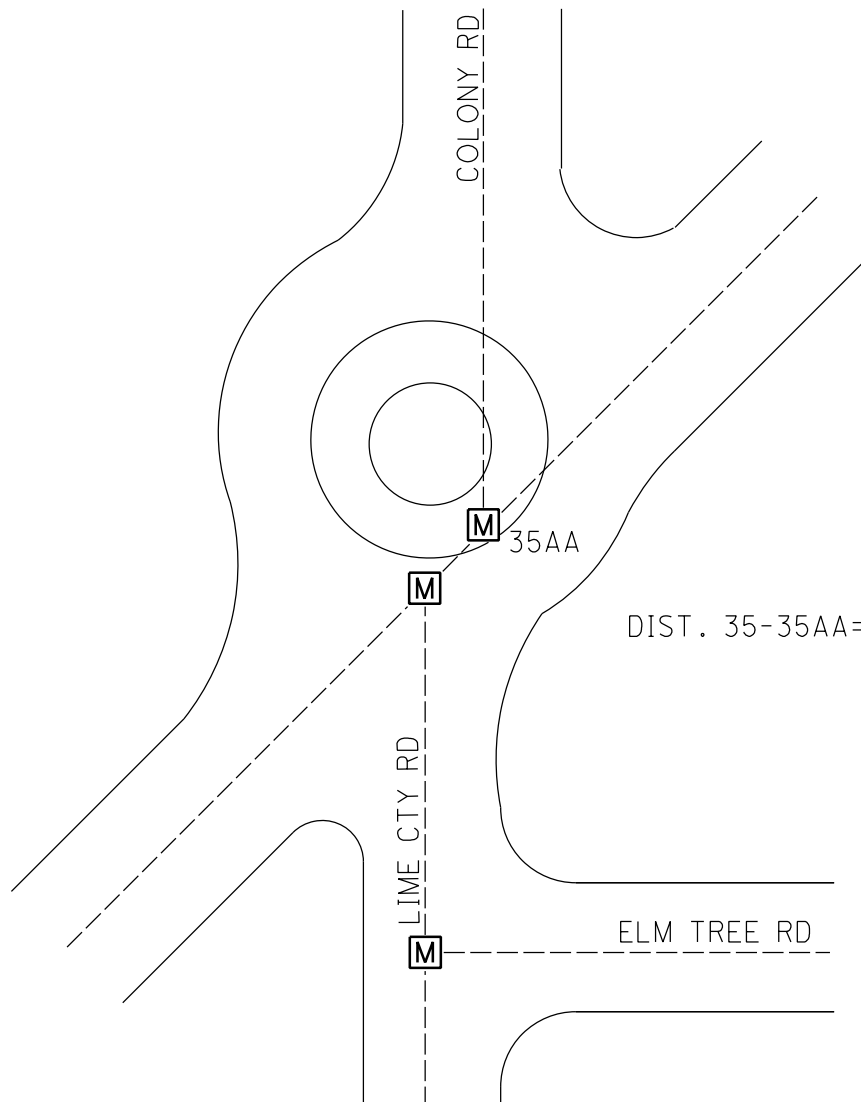

FD MONBOX
W/1" IPIN
N = 706631.394
E = 1676539.652

O.D.O.T. DISTRICT 2 SURVEY OFFICE (USE ONLY)

PERSONNEL

REFERENCE NO. 35AA

SHEET 10 OF 12

NOTES BARNHISEL

DATE 4-24-91

ROUTE SR 65

H.C. LOEHEKE

WEATHER CLOUDY

COUNTY WOOD

R.C. HOFFMAN

TEMP. 58° F

TOWNSHIP ROSSFORD

SECTION RT 78 | 80

DWG BY AUBLE

PID 90674

T 8 N N 11 E

TYPE MONUMENT PK NAIL

ON SURFACE - ~~BELOW~~ ON

OFFSET Q PAVEMENT 5.8' LT : RT

- TO - EDGE PAVEMENT

STATION: -

HORZ.DATUM: NAD83 (2011)

GEOID: 18

GRID: NORTHING: 706769.803


EASTING: 1676570.997

79	80	81	82	83
78	●			
77	●			
76				

SEC 23



RECORD:
FD P.K./WASHER
4/24/91, MB
SET PK/WASHER
5-31-91, MB
CITY OF ROSSFORD
TO SET MONBOX
FD MONBOX
W/1" IPIN & DIMPLE
REFAA35
10-5-21, DSA

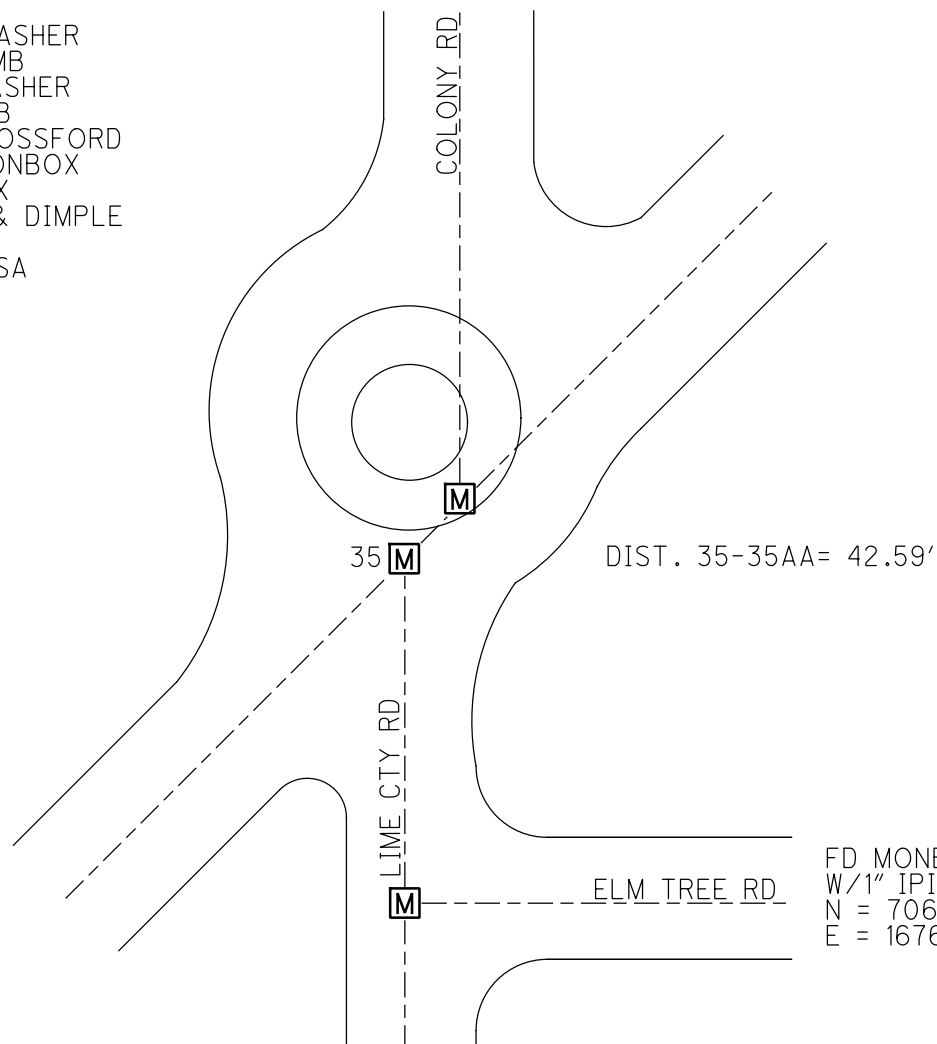

O.D.O.T. DISTRICT 2 SURVEY OFFICE (USE ONLY)

PERSONNEL

REFERENCE NO. 35 A

SHEET 11 OF 12

NOTES BARNHISEL

DATE 4-24-91

ROUTE SR 65

H.C. LOEHEKE

WEATHER CLOUDY

COUNTY WOOD

R.C. HOFFMAN

TEMP. 58° F

TOWNSHIP ROSSFORD

SECTION RT 81

DWG BY AUBLE

PID _____

T 8 N

N 11 E

TYPE MONUMENT 3/4" IRON ROD

~~ON SURFACE~~ - BELOW 6"

OFFSET CL PAVEMENT 48.5' ~~LT~~ : RT

34' TO RT EDGE PAVEMENT

STATION: 1218+53

HORIZ.DATUM: -

GEOID: -

GRID: NORTHING: -

EASTING: -

79	80	81	82	83
78		●		
77				SEC
76				23



RECORD: PI

9-8-76

PI STA: 214+85.80


$\Delta = 31^\circ 46'$ LT REC

SET 3/4" IRON ROD

NOTE: PIPE IS LEANING

LOOKS TO BE SLIDING

WITH DITCH BANK

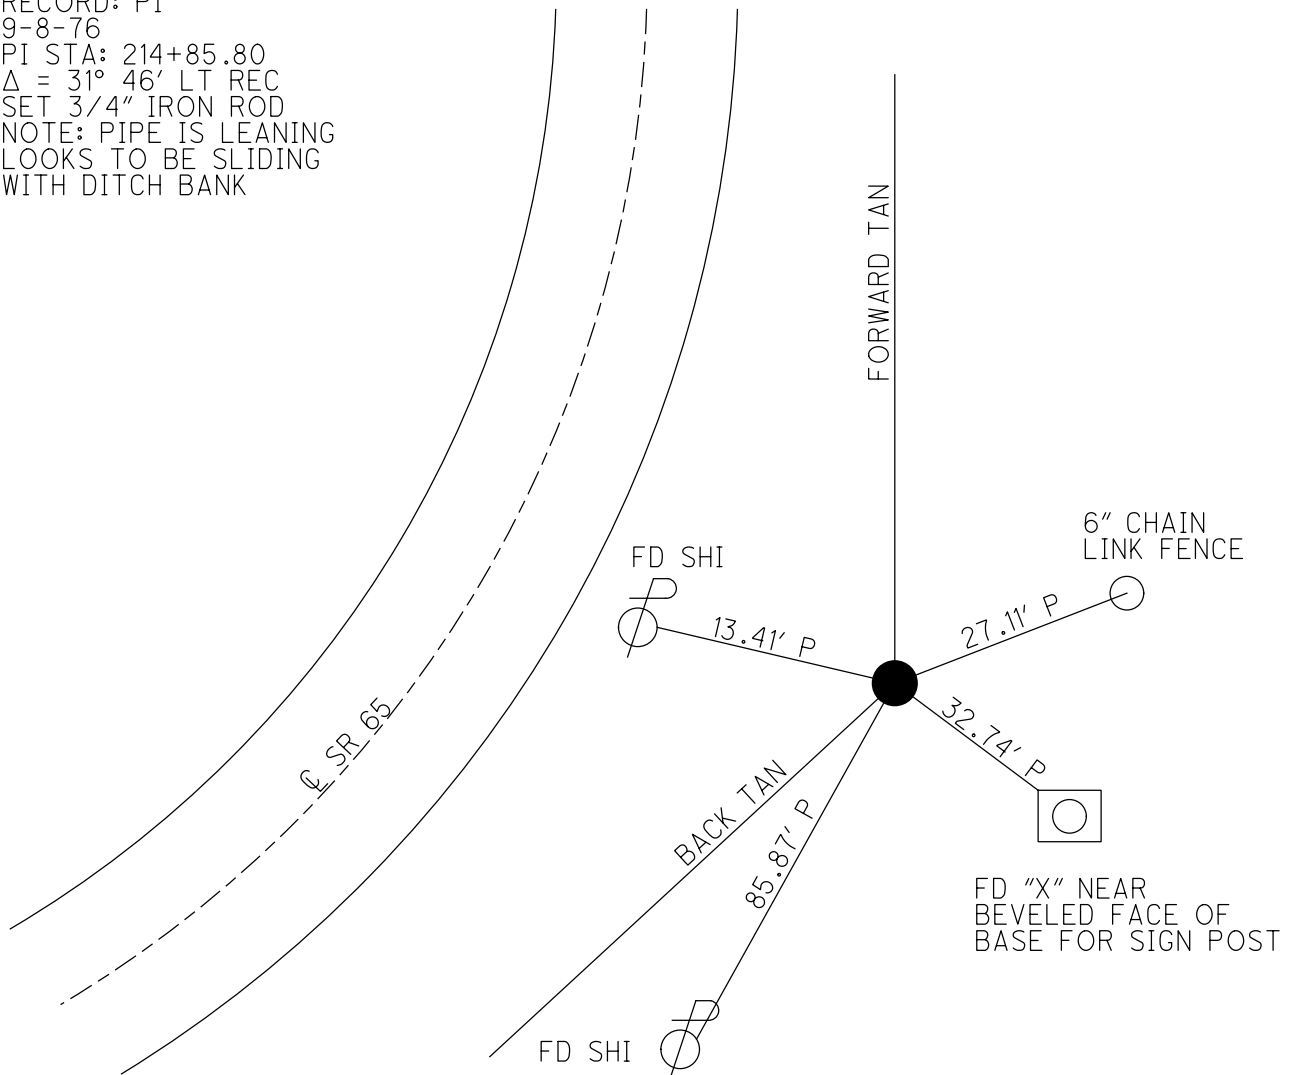

O.D.O.T. DISTRICT 2 SURVEY OFFICE (USE ONLY)

PERSONNEL

REFERENCE NO. 36

SHEET 12 OF 12

NOTES BARNHISEL

DATE 4-24-91

ROUTE SR 65

H.C. LOEHEKE

WEATHER CLOUDY

COUNTY WOOD

R.C. HOFFMAN

TEMP. 58° F

TOWNSHIP ROSSFORD

SECTION RT 81

DWG BY AUBLE

PID

T 8 N N 11 E

TYPE MONUMENT BRASS R/W PLATE

~~ON SURFACE~~ - BELOW 4"

OFFSET CL PAVEMENT 12.0' LT : RT

37' TO RT EDGE PAVEMENT

STATION: 1227+77

HORIZ.DATUM: -

GEOID: -

GRID: NORTHING: -

EASTING: -

79	80	81	82	83
		●		
78				
77			SEC	
76			23	



RECORD:

$\Delta = 31^\circ - 46'$

SET 1 ROD PER

R/W PLAN 1934

STA: 224+22.00

$\Delta = 32^\circ - 01'$

FD BRASS R/W


PLATE 4" DEEP

SET PK/WASHER

5-31-91, MB

CITY OF ROSSFORD

SUPPOSED TO SET MON

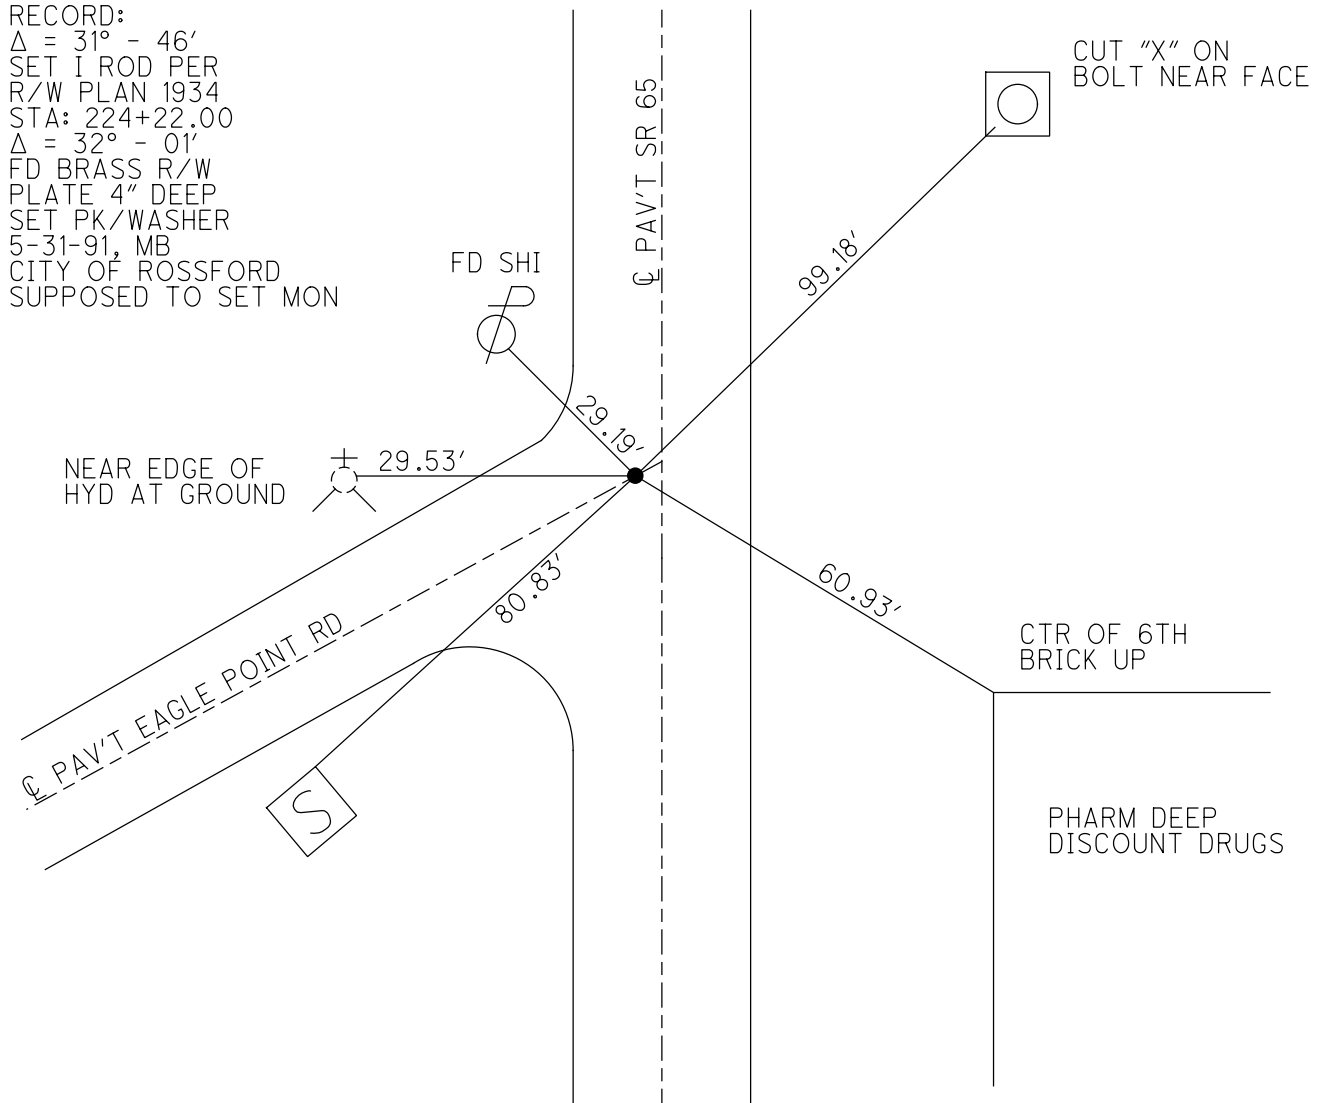

O.D.O.T. DISTRICT 2 SURVEY OFFICE (USE ONLY)

PERSONNEL

REFERENCE NO. A

SHEET 1 OF

NOTES TOMSIC

DATE 8/24/71

ROUTE SR 65

H.C. VANYO

WEATHER FAIR

COUNTY WOOD

R.C. GRANATA
JACKSON

TEMP. 88°

TOWNSHIP 12 MILE RESERVE

DWG BY NIESE PID

SECTION RT 83

T 3 US R E

TYPE MONUMENT BRASS PLATE IN CMON


ON SURFACE - ~~BELOW~~ ON

OFFSET Q PAVEMENT - LT : RT
- TO - EDGE PAVEMENT


STATION: 1279+86.9

HORZ.DATUM: GEOID:

GRID: NORTHING: EASTING:

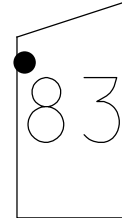

RECORD: P.I.
STA. 66+43.51
 $\Delta = 1^\circ 06' 00''$
FD BRASS PLATE
IN CMON
8/24/71, TOMSIC
1966 PLAN

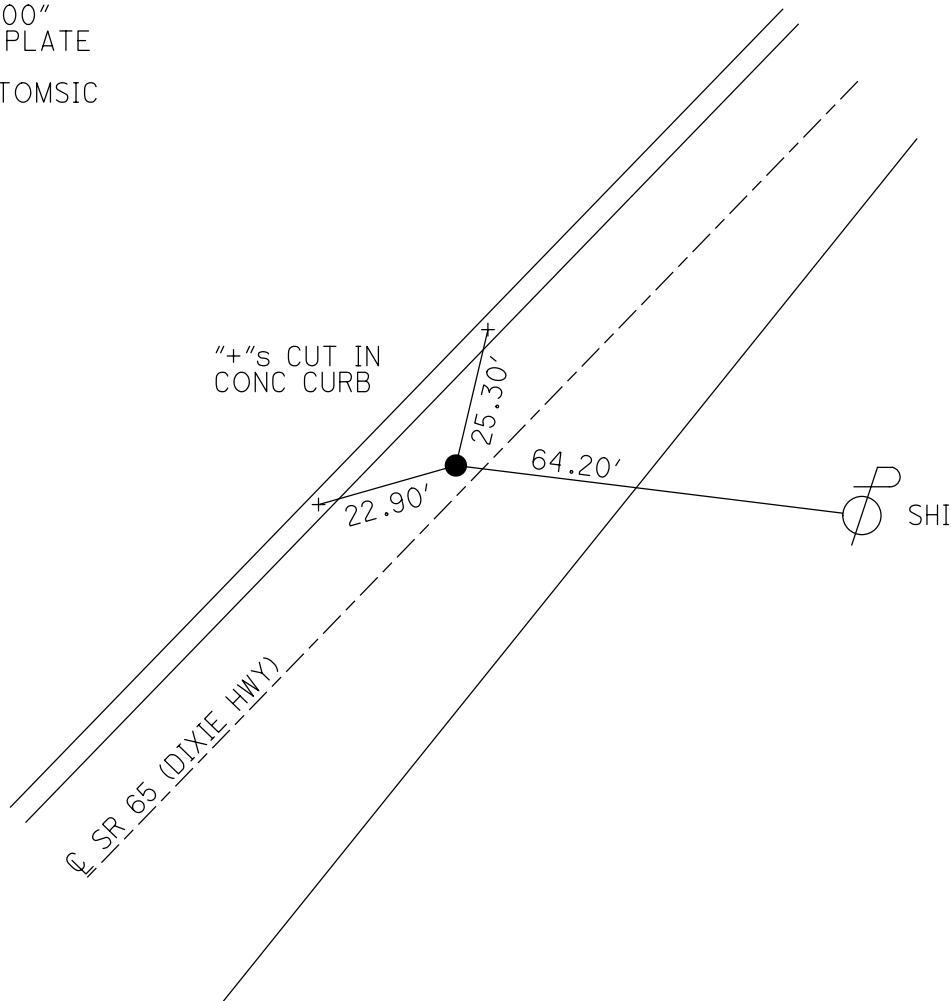

O.D.O.T. DISTRICT 2 SURVEY OFFICE (USE ONLY)

PERSONNEL

REFERENCE NO. B

SHEET 2 OF

NOTES TOMSIC

DATE 8/24/71

ROUTE SR 65

H.C. VANYO

WEATHER FAIR

COUNTY WOOD

R.C. GRANATA

TEMP. 88°

TOWNSHIP¹² MILE RESERVE

JACKSON

DWG BY NIESE PID SECTION RT 83

T3US R__E

TYPE MONUMENT BRASS PLATE

ON SURFACE - ~~BELOW~~ ON _____

OFFSET @ PAVEMENT _____ LT : RT

_____TO_____EDGE PAVEMENT

STATION: 1283+62


HORZ.DATUM: _____

GEOID: _____

GRID: NORTHING:_____ EASTING:_____

EASTING: _____

RECORD: P.O.T.
STA. 70+18.58
FD BRASS PLATE
8/24/71, TOMSIC
1966 PLANS

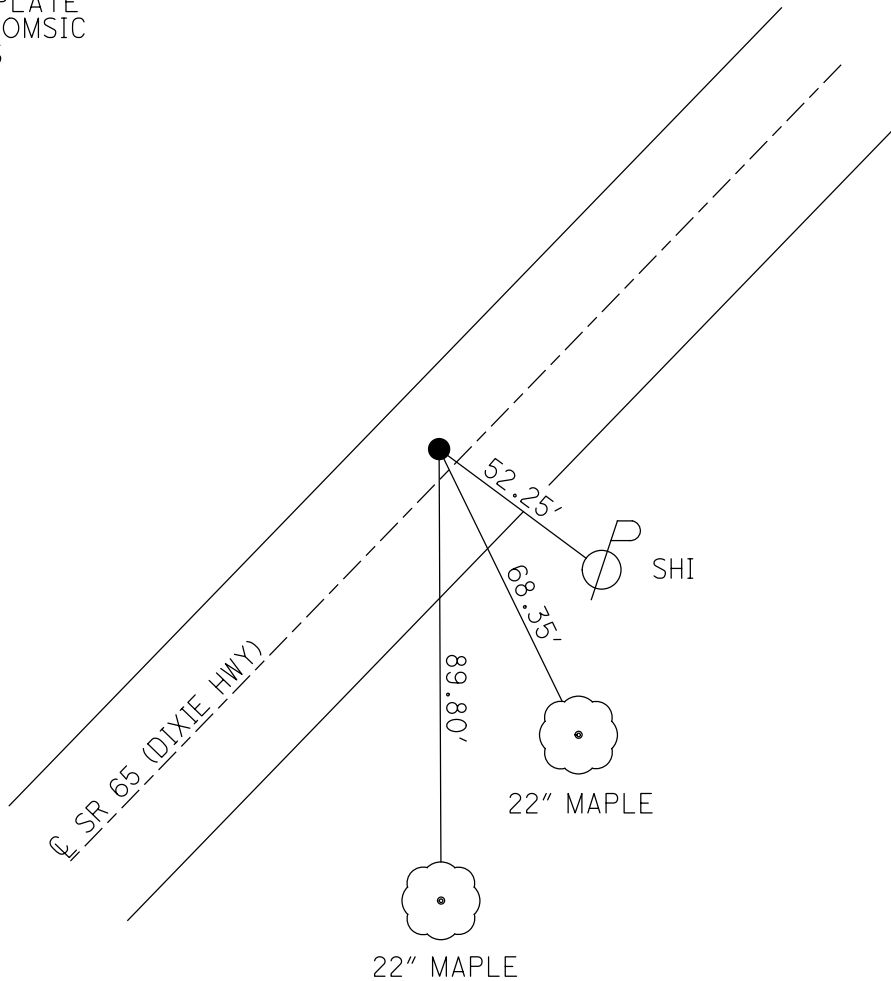

O.D.O.T. DISTRICT 2 SURVEY OFFICE (USE ONLY)

PERSONNEL

REFERENCE NO. C

SHEET 4 OF

NOTES LOEHRKE

DATE 7/7/94

ROUTE SR 65

H.C. CANTERBURY

WEATHER NICE

COUNTY WOOD

R.C. HERMILLER

TEMP. 74°

TOWNSHIP 12 MILE RESERVE

VOGEL/PRUNTY

SECTION RT 83

DWG BY NIESE

PID

T 3 US R E

TYPE MONUMENT 3" BRASS PLATE

~~ON SURFACE~~ - BELOW 4"

OFFSET CL PAVEMENT 5.8' LT : ~~RT~~

19.0' TO LT EDGE PAVEMENT


STATION: 1295+18.4

HORIZ.DATUM:

GEOID:

GRID: NORTHING:

EASTING:

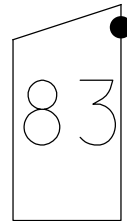

RECORD: P.I.
FROM 1969 PLAN
WOO-65-23.90
 $\Delta = 00^{\circ}08'30''$ LT
FD BRASS MON
3" DOWN
USED AS LUC-65-0+00
4/1/94, CL
FD 3" BRASS PLATE
4" BELOW
7/7/94, CL
NO PIN IN MONBOX
1996
SET IPIN IN MONBOX
8/15/96, CL

