

O.D.O.T. DISTRICT 2 SURVEY OFFICE (USE ONLY)

PERSONNEL

REFERENCE NO. 2 AC

SHEET 13 OF 40

NOTES O'DONNELL DATE 10/30/20
 H.C. AUBLE WEATHER CLOUDY
 R.C. O'DONNELL TEMP. 38°

ROUTE SR 65
 COUNTY WOOD
 TOWNSHIP GRAND RAPIDS
 SECTION 7
 T 5 N R 9 E

DWG BY RHOADES PID 95796

TYPE MONUMENT P.K.SHANK

ON SURFACE - ~~BELOW~~ ON

OFFSET ☉ PAVEMENT 5.33' ~~±~~ : RT

- TO - EDGE PAVEMENT



STATION: 57+65

HORZ.DATUM: NAD83 2011

GEOID: NAVD88 2018

GRID: NORTHING: 639165.232

EASTING: 1594350.682

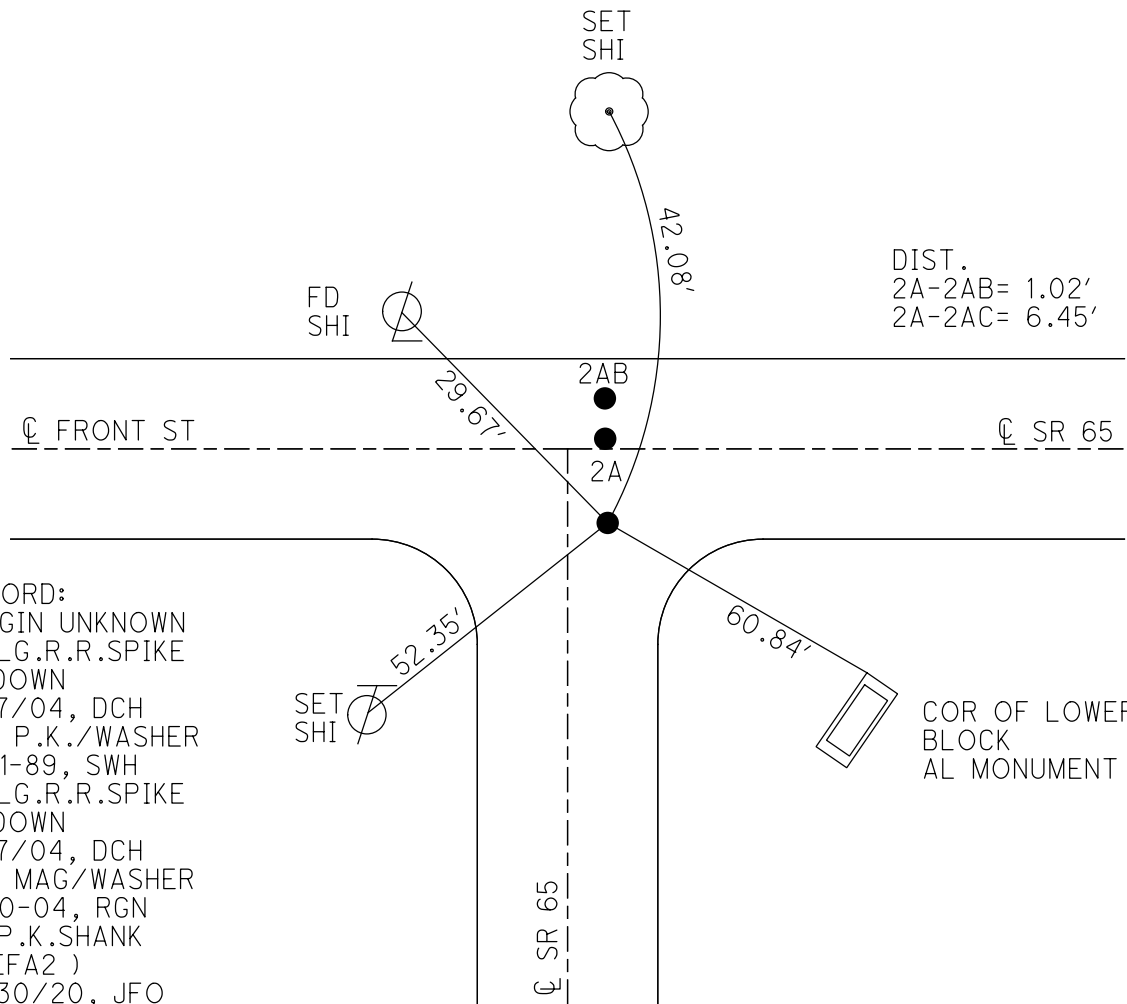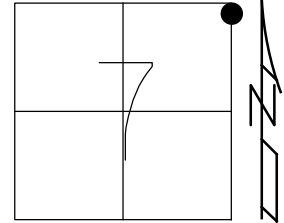

DIST.
 2A-2AB= 1.02'
 2A-2AC= 6.45'

RECORD:
 ORIGIN UNKNOWN
 FD LG.R.R.SPIKE
 4" DOWN
 6/17/04, DCH
 SET P.K./WASHER
 11-21-89, SWH
 FD LG.R.R.SPIKE
 4" DOWN
 6/17/04, DCH
 SET MAG/WASHER
 9-20-04, RGN
 FD P.K.SHANK
 (REFA2)
 10/30/20, JFO
 SET MAG/WASHER
 10/4/22, TDN

O.D.O.T. DISTRICT 2 SURVEY OFFICE (USE ONLY)

PERSONNEL

REFERENCE NO. 2 AC

SHEET 13 OF 16

NOTES HOMAN

DATE 6/17/04

ROUTE SR 65

H.C. HUSS

WEATHER CLOUDY

COUNTY WOOD

R.C. NUHFER

TEMP. 84° F

TOWNSHIP GRAND RAPIDS

SECTION 7

DWG BY RHOADES

PID _____

T 5 N R 9 E

TYPE MONUMENT LG.R.R.SPIKE

~~ON SURFACE~~ - BELOW 4"

OFFSET \odot PAVEMENT 5.33' ~~LT~~ : RT

- TO - EDGE PAVEMENT


STATION: 57+62

HORZ.DATUM: -


GEOID: -

GRID: NORTHING: -

EASTING: -

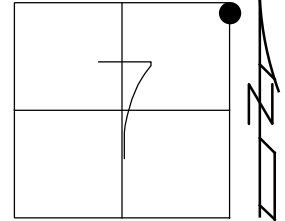

RECORD:
ORIGIN UNKNOWN
FD LG.R.R.SPIKE
4" DOWN
6/17/04, DCH
SET P.K./WASHER
11-21-89, SWH
SET MAG/WASHER
9-20-04, RGN

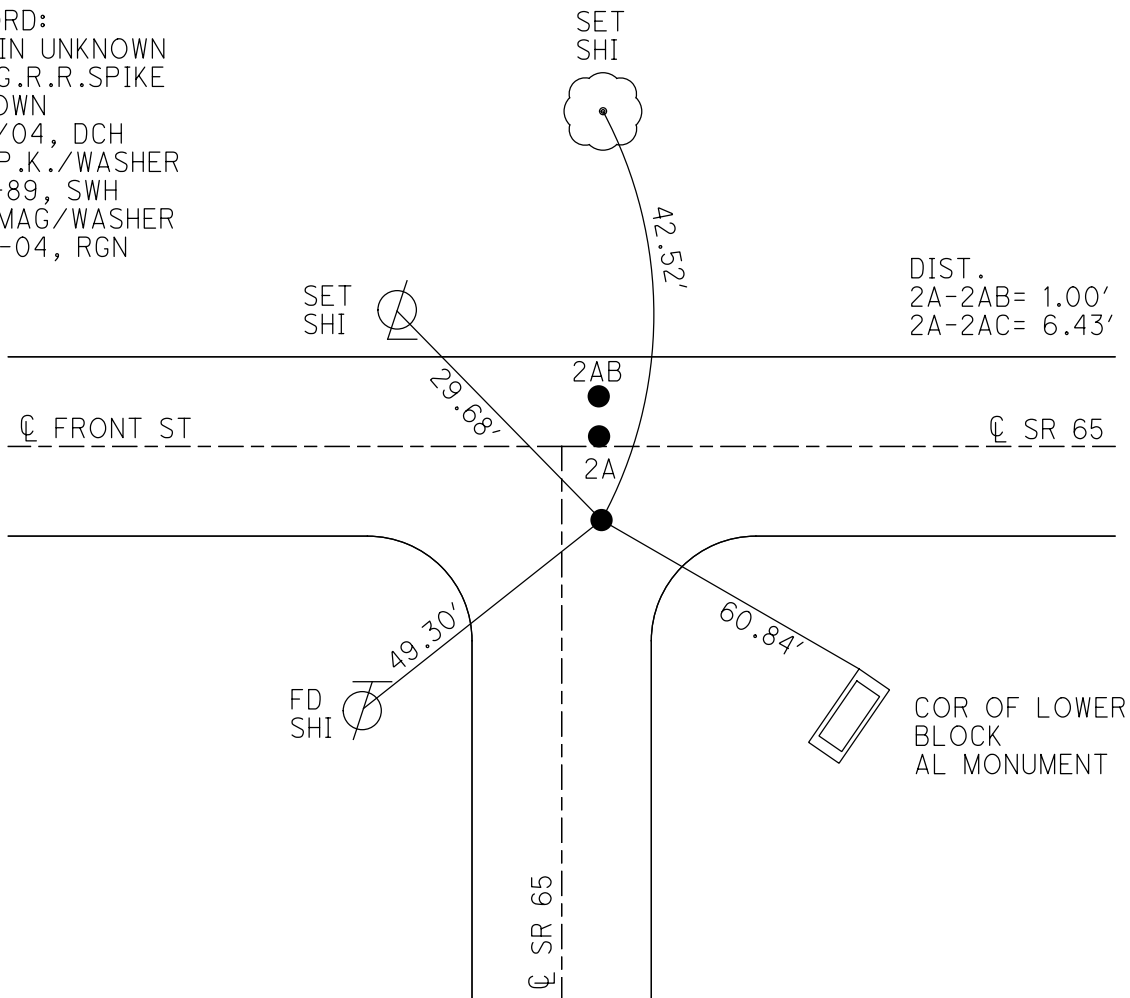

DIST.
2A-2AB= 1.00'
2A-2AC= 6.43'

COR OF LOWER
BLOCK
AL MONUMENT

O.D.O.T. DISTRICT 2 SURVEY OFFICE

PERSONNEL _____

REFERENCE NO. 2-A

SHEET 9 OF 49

NOTES Huss

H.C. Homan

R.C. Adkins

DATE 6-17-04

WEATHER Cldy

TEMP. +84°F

ROUTE S.R. 65

COUNTY Wood

TOWNSHIP Grand Rapids

SECTION 7

T 5 N R 9 E


TYPE MONUMENT A - Small RR Spk
B - 2 1/2 RR Spk

~~ON SURFACE~~ BELOW All - 4" Below

~~LEFT & PAV'T~~ RIGHT A 1.1' Lt

9.5' TO Lt. EDGE PAVEMENT

S.L.M. 57 + 68

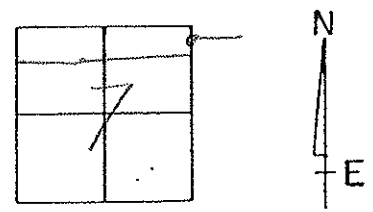


Record: Origin
Unknown

Set N/Shi
in 15"
tree

A - 36.37'
B - 35.45'
C - 42.52'

Set PK/Washer
11-21-89
SWH

Set Mag/Wch
All pts.
9-20-04
RGN

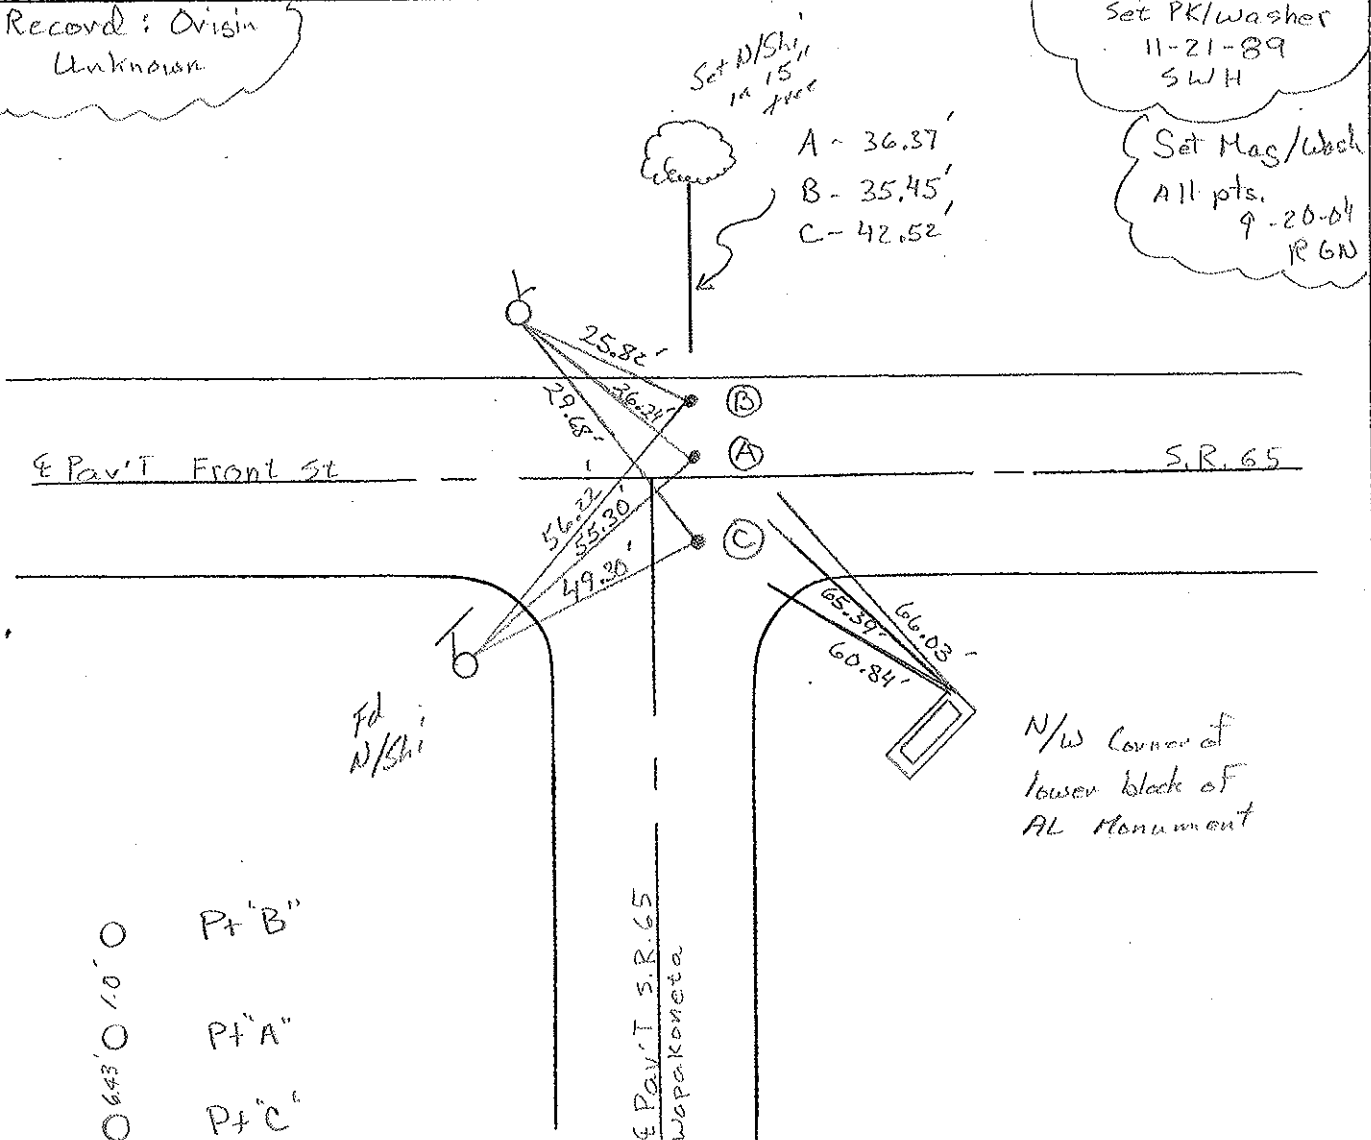

○ 643' 1.0' ○ Pt "B"
 ○ Pt "A"
 ○ Pt "C"

O.D.O.T. DISTRICT 2 SURVEY OFFICE

PERSONNEL

REFERENCE NO. 2-A

SHEET 5 OF 12

NOTES HOFFMAN

H.C. LOSHRKE

R.G. BARNHISEL

DATE 9-7-89

WEATHER CLEAR

TEMP. 88°

ROUTE SR 65

COUNTY WOOD

TOWNSHIP GRAND RAPIDS

SECTION 7

T5 N R 9 E

TYPE MONUMENT "A" SMALL R.R. SPIKE


~~ON SURFACE~~ - BELOW 1 1/2"

~~LEFT- & PAVT. - RIGHT~~ 1.7'

~~TO~~ EDGE PAVEMENT 2.3' E. & S. & SOUTH

S.L.M. 57 + 68


Set P.K./WASHER
11-21-89
SWH

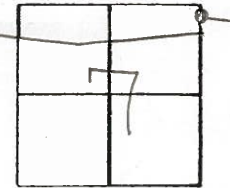

"B" = ORIGIN UNKNOWN
Fd. R.R. SPK / "A" AT SURFACE

PTS. "B" & "C" Set P.K. NAIL
11-21-89
SWH

"C" = ORIGIN UNKNOWN
Fd. BENT R.R. SPK AT SURFACE

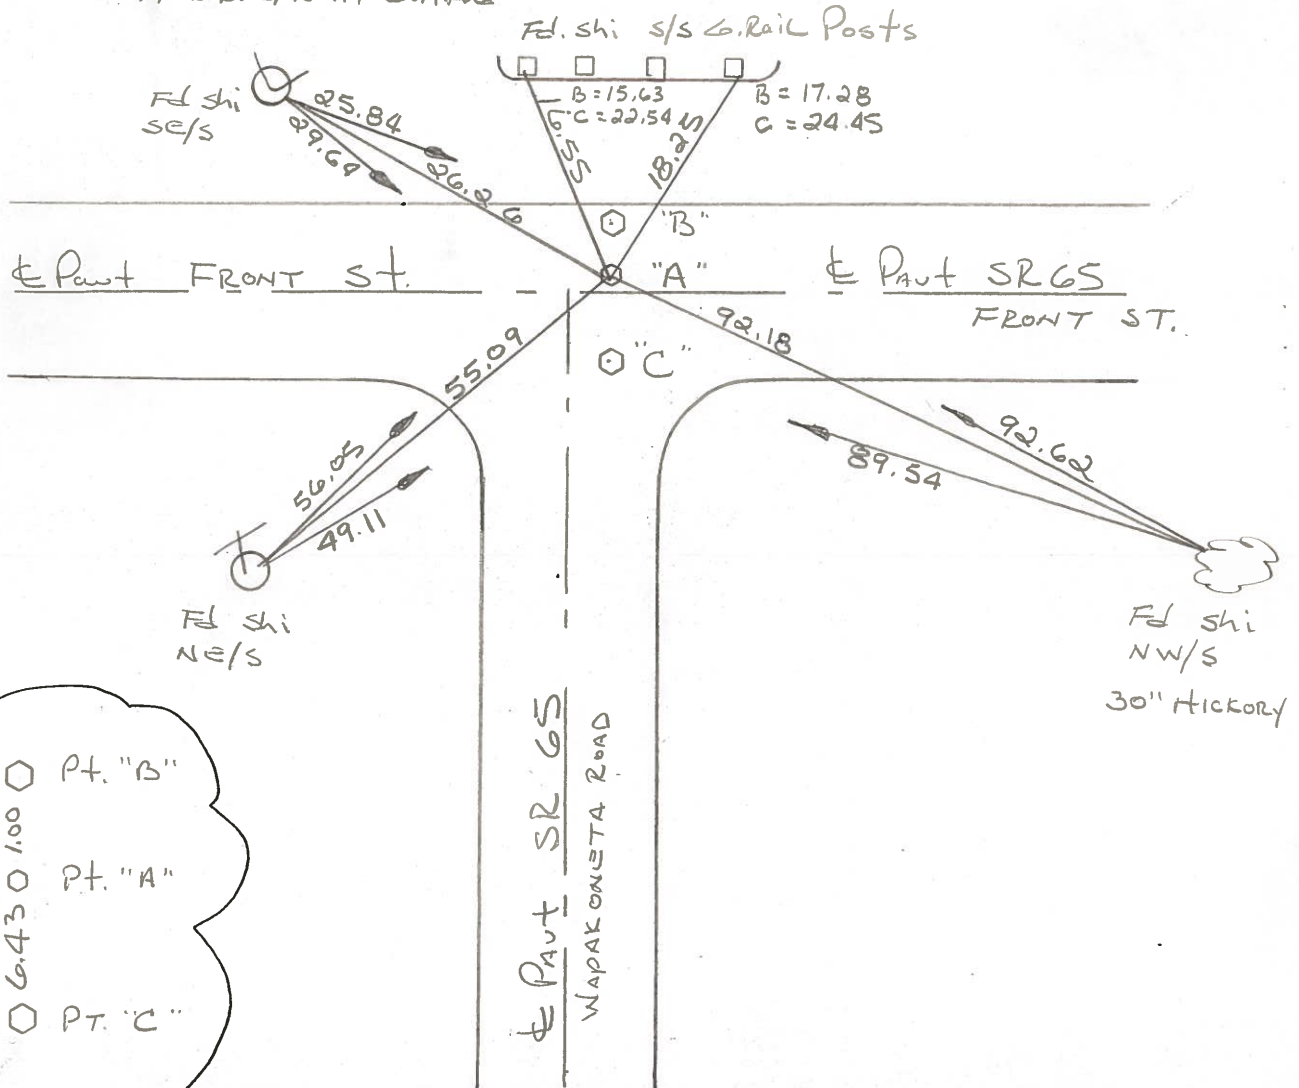

County Wood S.R. 65

Date 12-3-81

Township Grand Rapids

Weather Clear

Section 7 @ Grand Rapids

Temp. +40°


T&N, R&E

Personnel Hoffman


Loehrke

Householder

2-A
(Pt. "A")

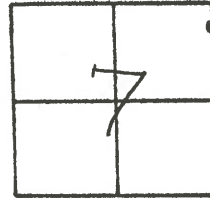


Pt. "A" Fd. small R.R. SPK, 1 1/2" Below surface
1.7' N. of & PAUT S.R. 65 EAST
2.3' E. of & PAUT S.R. 65 south

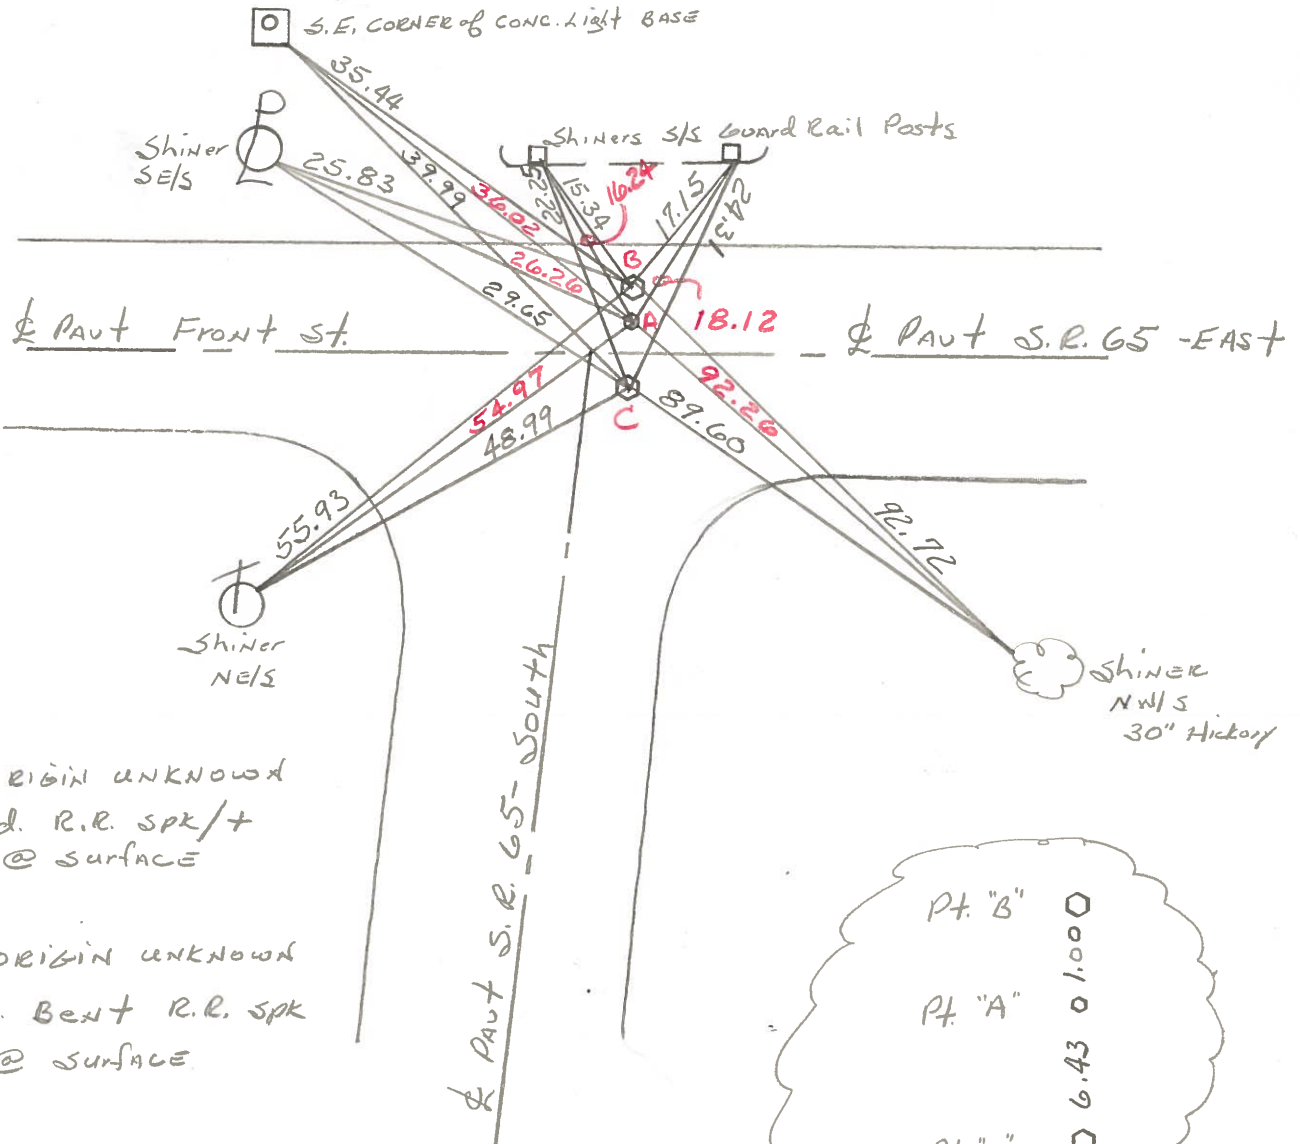

Pt. "B" ORIGIN UNKNOWN
Fd. R.R. SPK/+
@ SURFACE

Pt. "C" ORIGIN UNKNOWN
Fd. Bent R.R. SPK
@ SURFACE

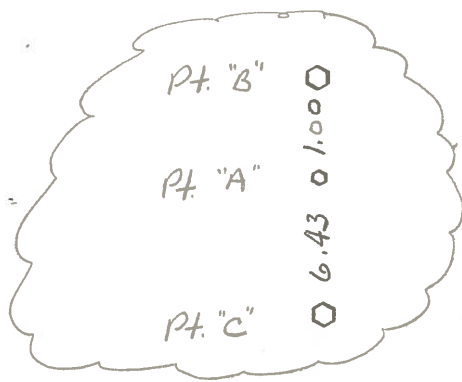

O.D.O.T. DISTRICT 2 SURVEY OFFICE

SHEET

OF

County WOOD S.R. 65

Date 7-16-73

Township GRAND RAPID

Weather PT. CLOUDY

Section 7

Temp. 70°

T5N, R9E


Personnel BURNSIDE

SMITH

BOWERS


BAGDANAS

KIJOWSKI

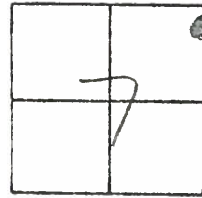

#2

2-A

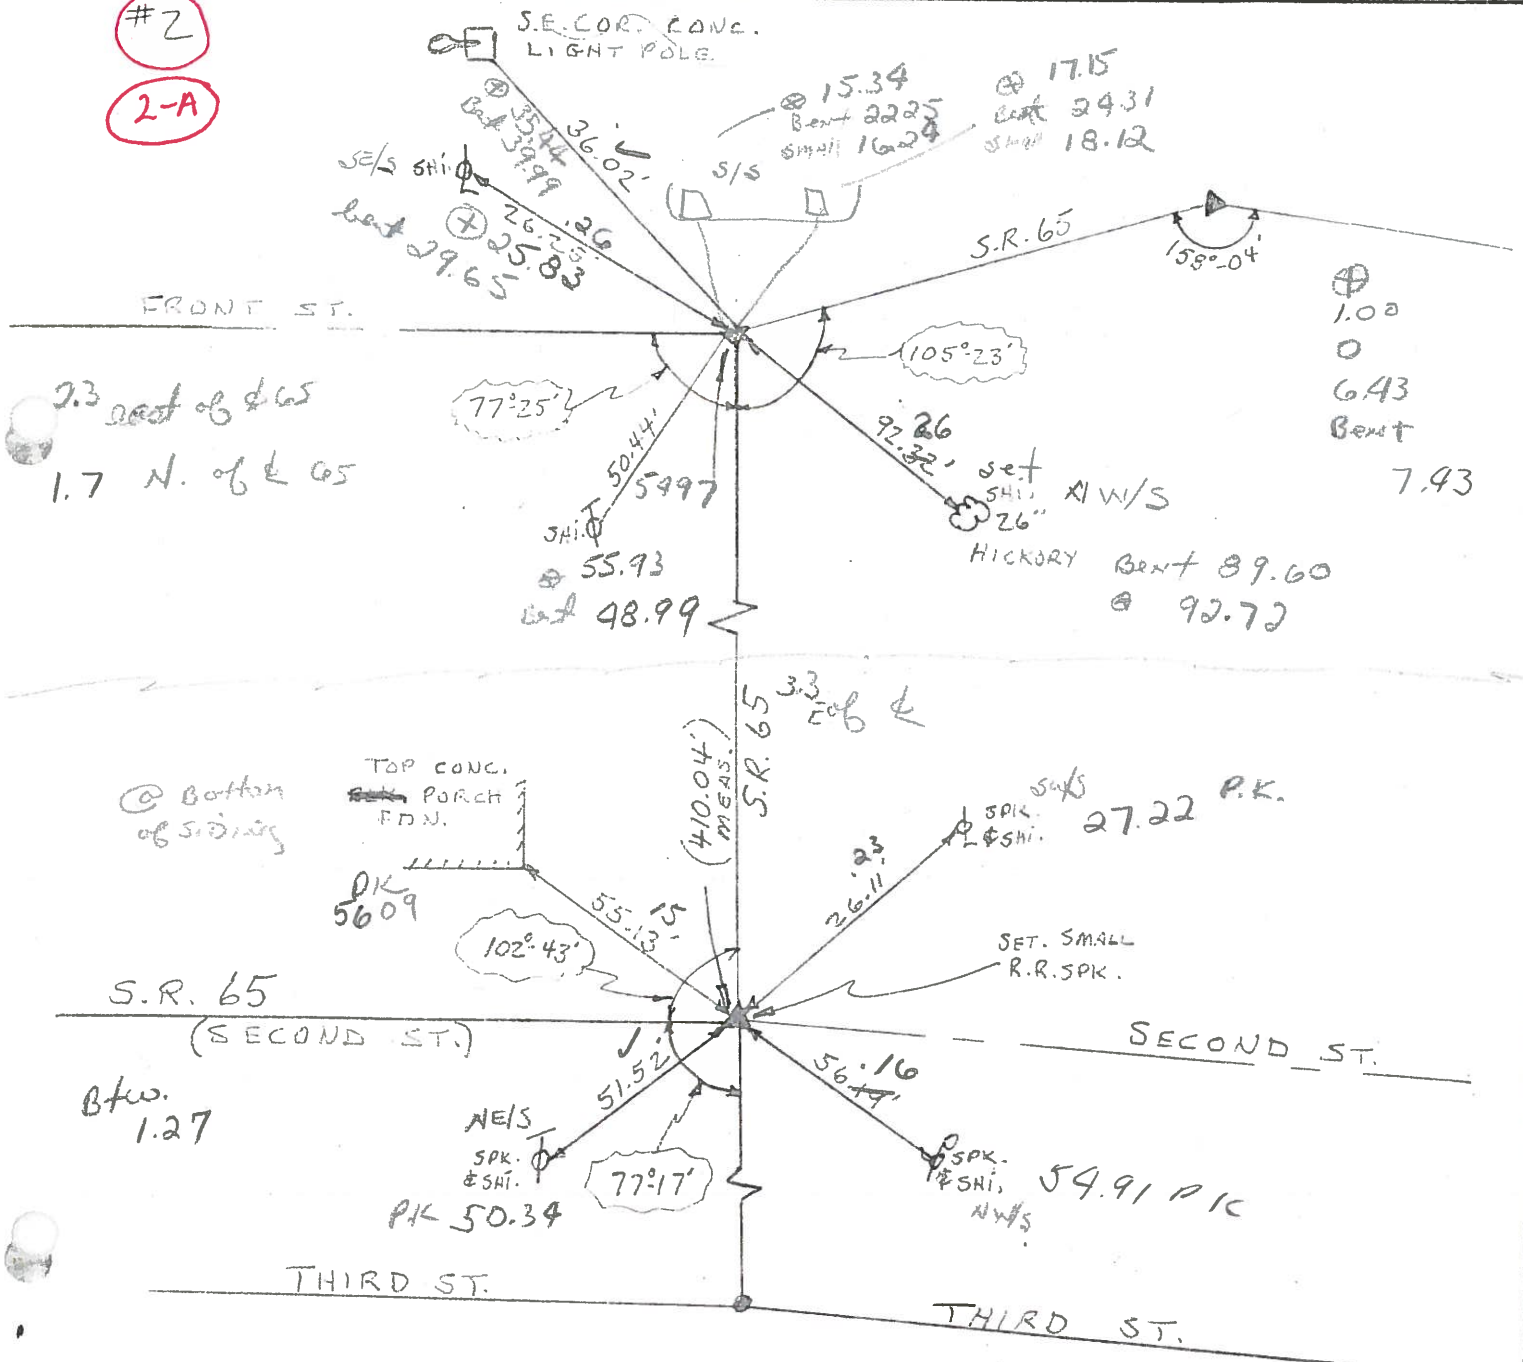

O.D.O.T. DISTRICT 2 SURVEY OFFICE

SHEET

OF

County WOOD S.R. 65

Date 7-16-73

Township GRAND RAPID

Weather PT. CLOUDY

Section 7

Temp. 70°

T5N, R9E


Personnel BURNSIDE

SMITH

BOWERS

BAGDANAS

KIJAWSKI

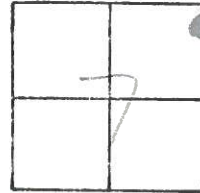

#2

2-A

