


O.D.O.T. DISTRICT 2 SURVEY OFFICE (USE ONLY)

PERSONNEL _____ REFERENCE NO. 17 D SHEET 40 OF 63
 NOTES WESTFALL DATE 4/22/15 ROUTE SR 65
 H.C. O'DONNELL WEATHER CLOUDY COUNTY WOOD
 R.C. LEU TEMP. 40° TOWNSHIP MIDDLETON
RHOADES SECTION 20
 T 6 N R 10 E


TYPE MONUMENT P.K./WASHER
 ON SURFACE - ~~BELOW~~ ON
~~LEFT~~ - PAV'T - RIGHT 0.6'
10.1' TOLT EDGE PAVEMENT
 S.L.M. 476+76.32
 Grid: Northing: 659067.399 Easting: 1628125.25

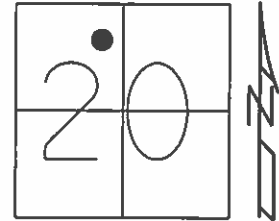

RECORD: P.C.
 STA. 376+86.89
 SET P.K.NAIL, 1972

FD P.K./WASHER
 7/16/92
 SET P.K./WASHER
 9/4/92, MB
 FD P.K./WASHER
 5/25/04
 GPS, REFD17
 8/6/13, SDC
 SET MAG/WASHER
 GPS, NEWREFD17
 9/11/15, JFO

RECORD: P.I.
 CURVE DATA 1926
 STA. 378+61.95
 $\Delta = 3^{\circ}30' \text{ LT}$
 $D = 1^{\circ} 00'$
 $R = 5729.65$
 $T = 175.06$
 $L = 350.00$

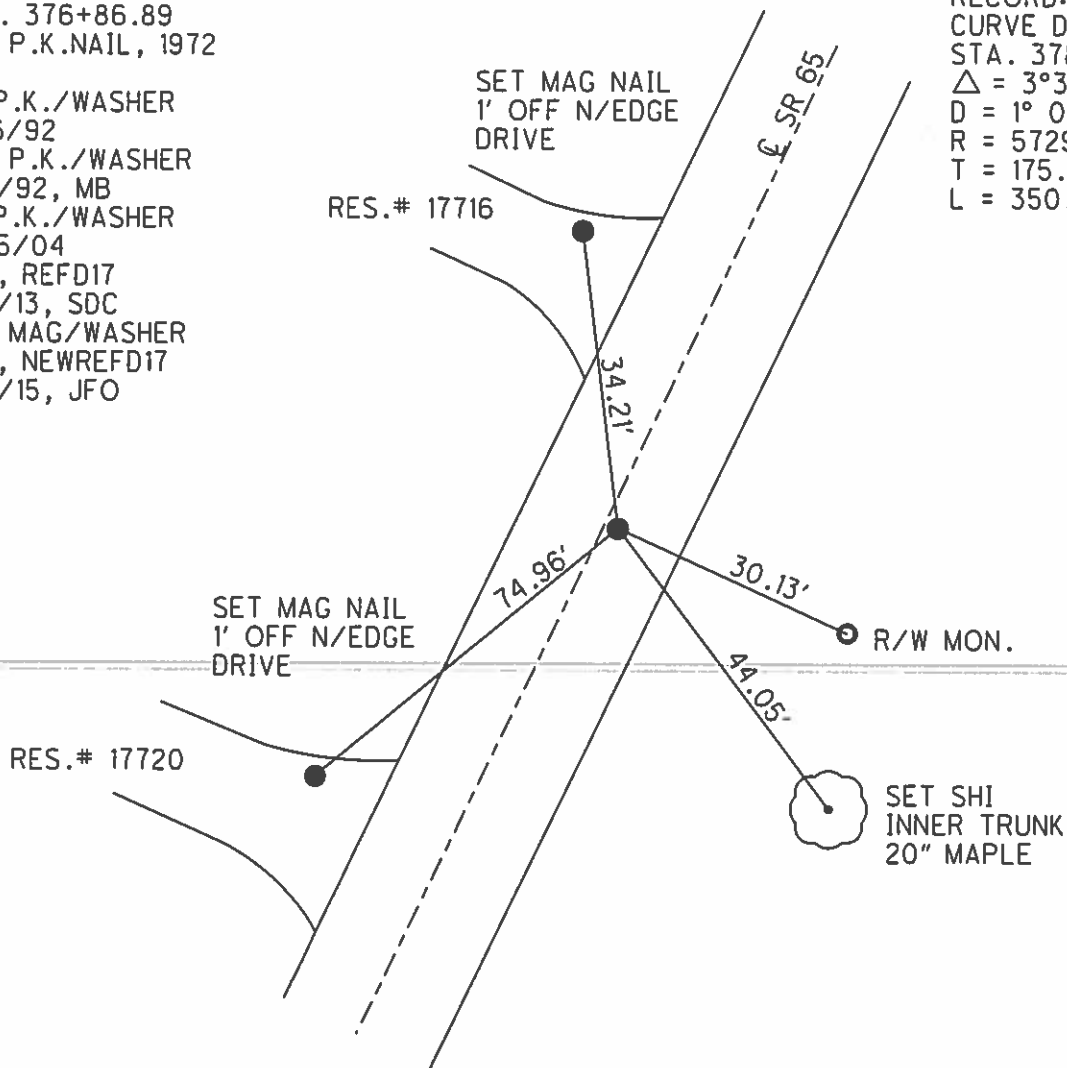

O.D.O.T. DISTRICT 2 SURVEY OFFICE

PERSONNEL

REFERENCE NO. _____

SHEET 24 OF 36

NOTES BARNHISEL

H.C. VAN DUSEN

R.C. KUSZ

BURNETT

DATE 5/25/04
~~7-16-92~~

WEATHER CLOUDY

TEMP. +75°

ROUTE 65

COUNTY WOOD

TOWNSHIP WASHINGTON

SECTION 20

T 6 N R 10 E

P.C. P.T.

TYPE MONUMENT P.K. WASHER P.K. WASHER


ON SURFACE - BELOW YES YES

~~SET~~ - PAV'T. - RIGHT 0.6 RT ON &

9.4
10.1 TO LT EDGE PAVEMENT

S.L.M. 475+63 479+12

(17-D)
(17-E)

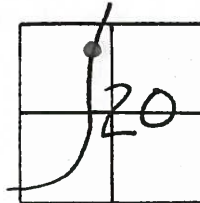


RECORD:
Curve DATA 1926
P.I. = 378+61.95
 $\Delta = 3^{\circ}-30' \text{ LT}$
 $D = 1^{\circ}-00'$
 $T = 175.06$
 $R = 5729.65$
 $L = 350.00$

RECORD:
P.T. = 380+36.89
SET PK 1972

Reset P.K. + WASHERS
9-4-92
MB

Preventive Maintenance
Microsurfaced 2004
Existing Point Uncovered
Date 8/5/04 MB

RECORD:
P.C. = 376+86.89
SET PK 1972

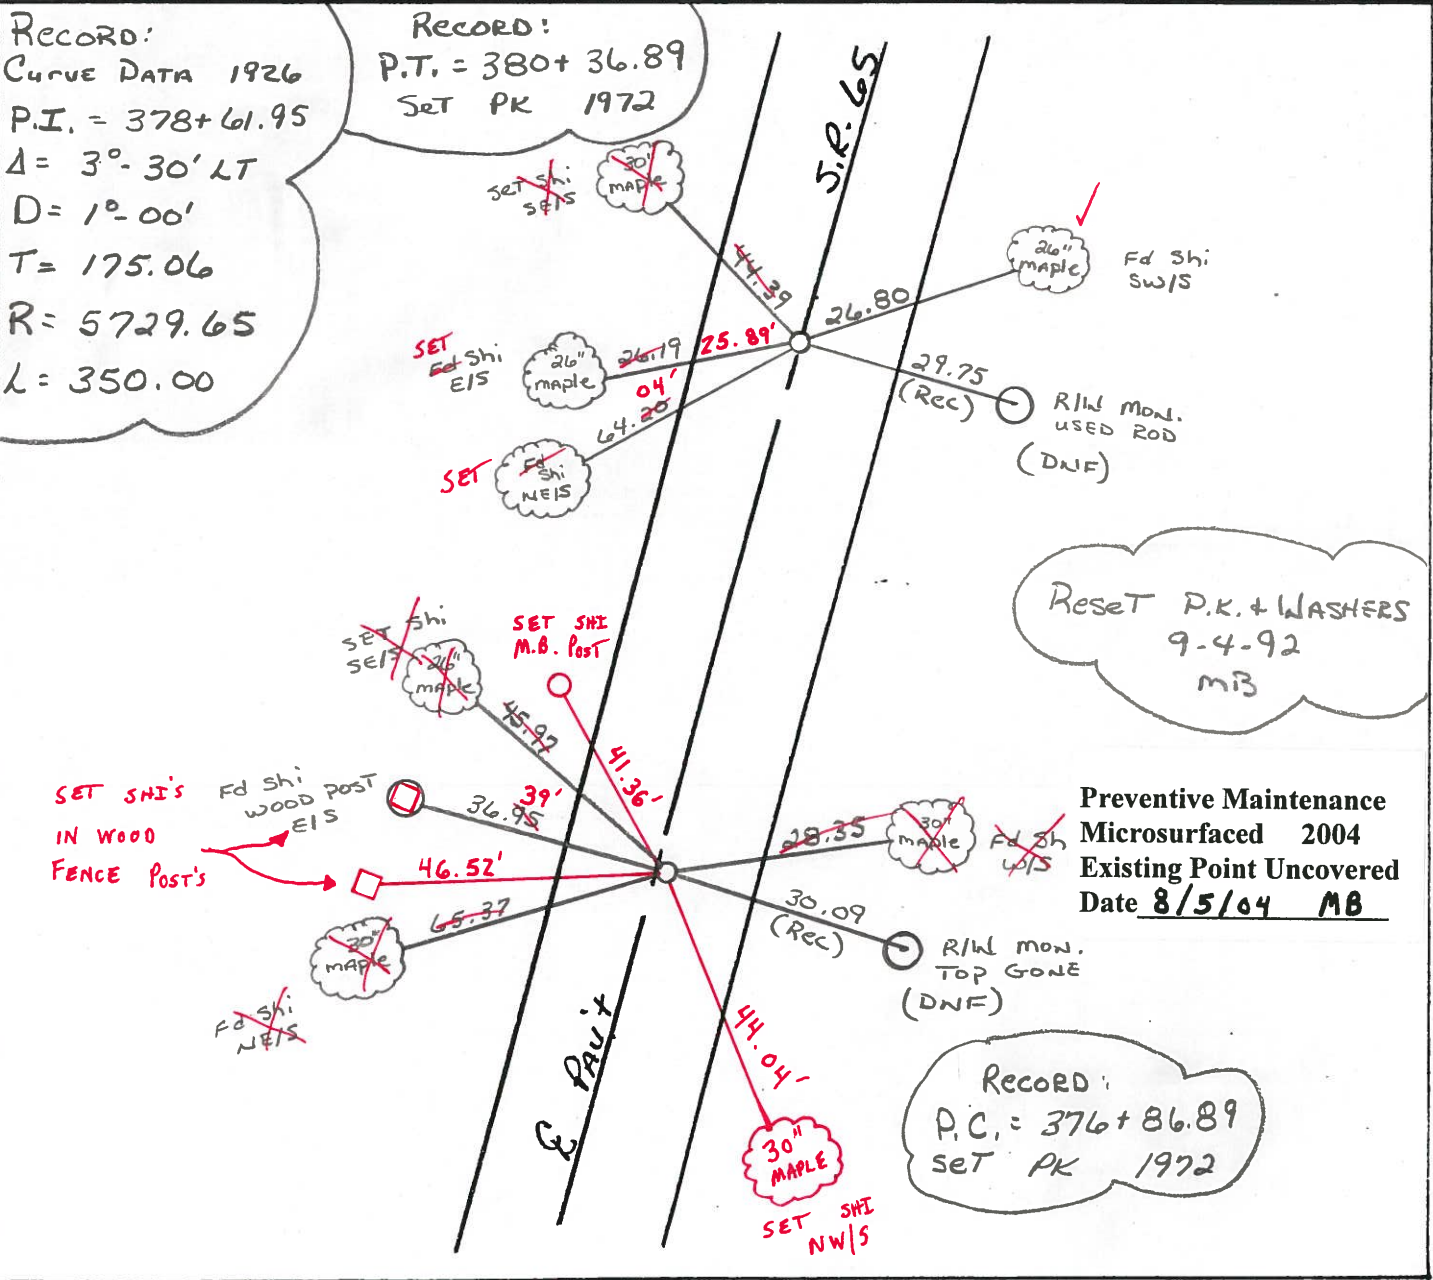

County Wood S.R. 65

Date 4-10-84

Township MIDDLETON


Weather Clear

Section 20

Temp. +50°

T6N, R10E

Personnel HOFFMAN

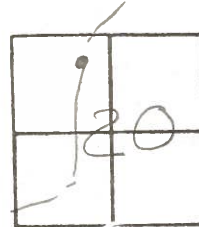

17-D

LOENZLE

HOUSEHOLDER H.C.

17-E

BARNHISEL R.C.


SET P.K./WASHER
@ BOTH PTS
10-10-84
S.W.H.

SLM 479+14
Fd P.K. @ surface
on & part
9.0' TO RT. EP,
9.3' TO LT. EP

RECORD:
P.T. STA 380+36
SET P.K. 1972

SLM 475+65
Fd. P.K @ surface
on & part
9.0' TO RT. EP,
9.2' TO LT. EP

RECORD:
P.C. = 376+86.89
Set P.K. 1972

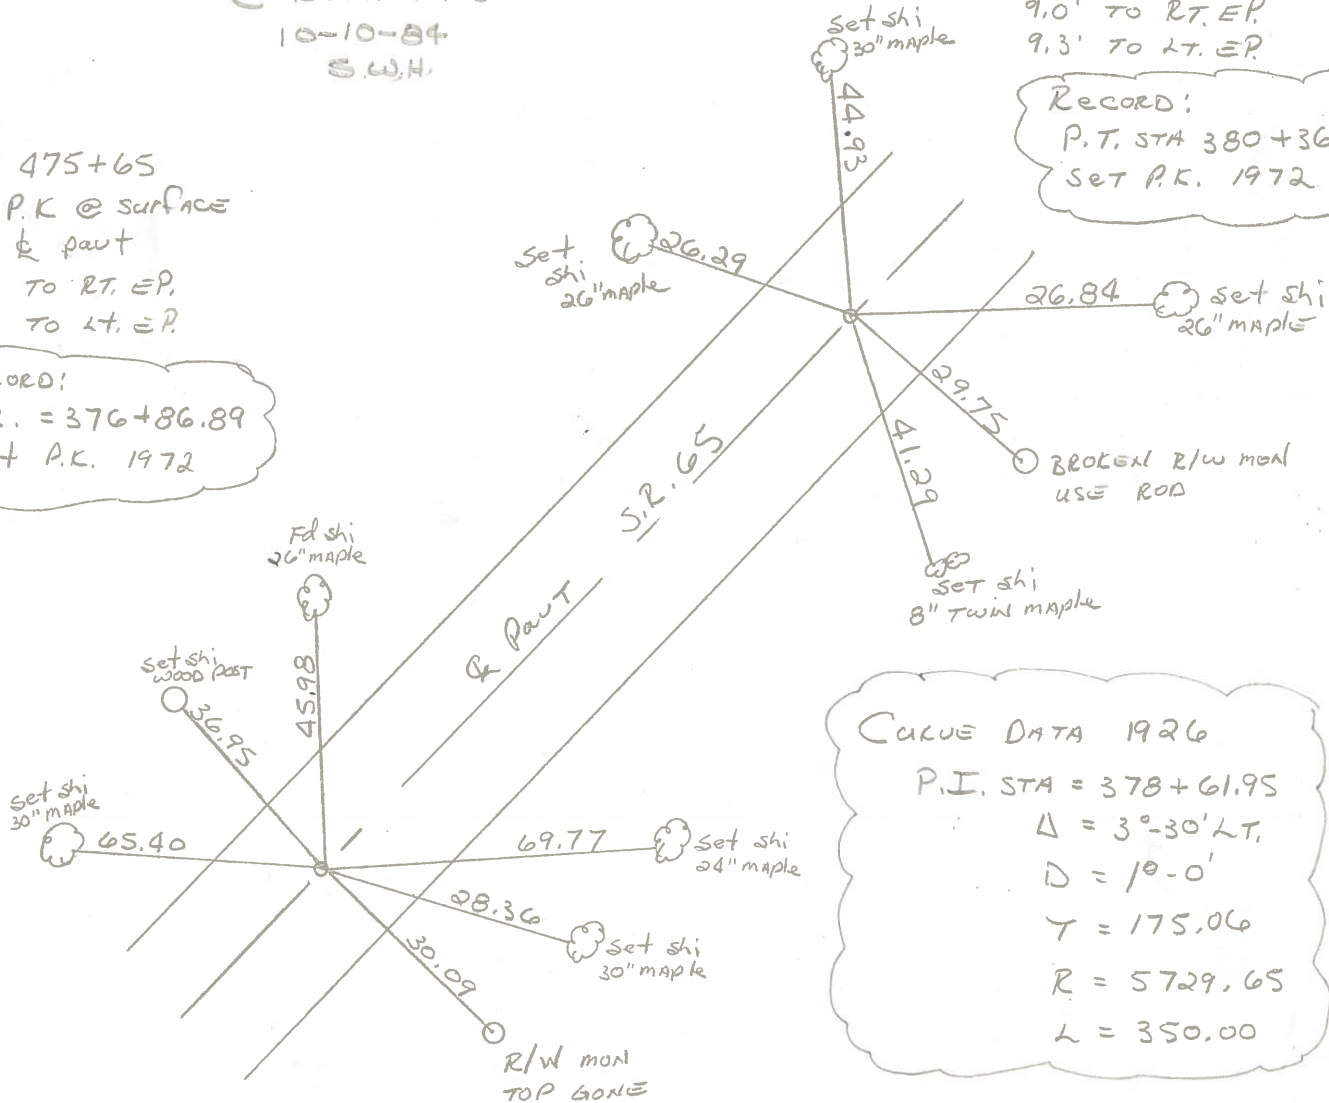

CURVE DATA 1926
P.I. STA = 378+61.95
 $\Delta = 3^{\circ}-30' \text{ LT}$
 $D = 10'-0'$
 $T = 175.06$
 $R = 5729.65$
 $L = 350.00$

PERSONNEL TITLE PERSONNEL TITLE
 BURNSIDE _____
 SMITH _____
 BOWERS _____

COUNTY Wood DATE 11-6-72
 S. R. 65 WEATHER CLEAR
 SEC. MIDDLETON TWP TEMP. +57°

DESCRIPTION ESTABLISH & REF. & CONTROL POINTS JOB NO.
 LEFT CENTER LINE RIGHT

