

O.D.O.T. DISTRICT 2 SURVEY OFFICE (USE ONLY)

PERSONNEL _____ REFERENCE NO. 26 AB SHEET 44 OF 44

NOTES LEU _____ DATE 08-14-14 ROUTE SR 65
H.C. HOMAN _____ WEATHER SUNNY COUNTY WOOD
R.C. WESTFALL _____ TEMP. 70°F TOWNSHIP PERRYSBURG
SECTION RT 62
T 7 N R 10 E

TYPE MONUMENT P.K./WASHER _____


~~ON SURFACE~~ - BELOW 3" _____

LEFT - \odot PAV'T - ~~RIGHT~~ 2.7' _____

9.6 TO LT EDGE PAVEMENT _____


S.L.M. 829+96 _____

Grid: Northing: 685595.141 Easting: 1646861.046

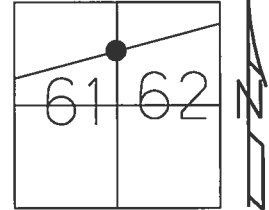

NOTE: DIST. 26-26A= 0.96'

- RECORD:
- FD P.K.NAIL
- FD P.K./WASHER
- 5/19/95, SAH
- SET P.K./WASHER
- 8-8-95, SAH
- FD P.K.SHANK
- REFA26
- 9/21/12, SAH
- FD P.K./WASHER
- REFA26
- 8-14-14, JLL
- SET MAG/WASHER
- 08-03-15, JLL

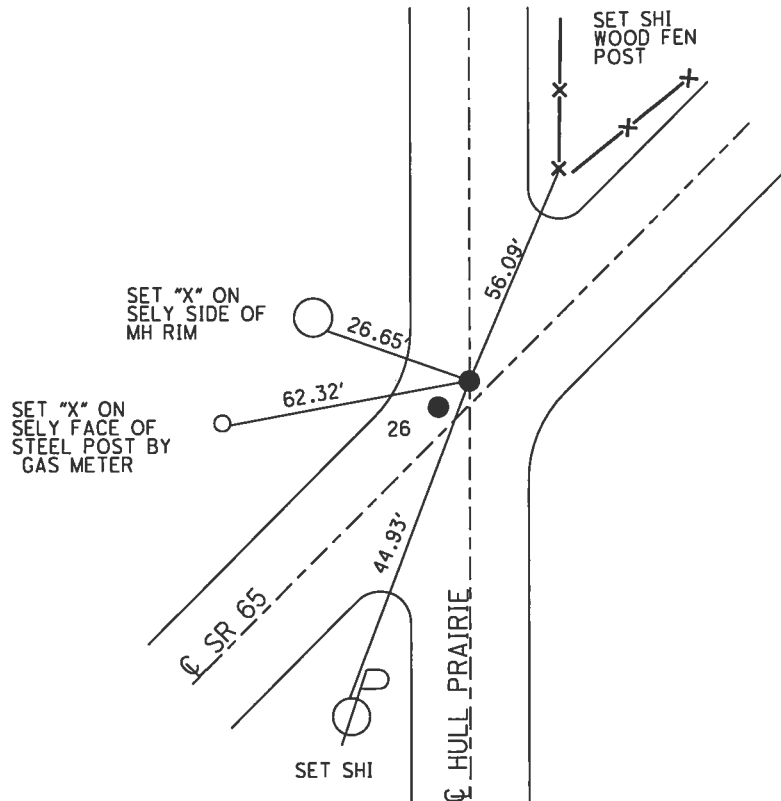

O.D.O.T. DISTRICT 2 SURVEY OFFICE

PERSONNEL

REFERENCE NO. 26

SHEET 71 OF 91

NOTES BARNHISEL

H.C. COROES

R.C. BARNHISEL

DATE 5-19-95

WEATHER Sunny

TEMP. +78°F

ROUTE SR-65

COUNTY Wood

TOWNSHIP Perrysburg

SECTION RT 61

T 7 N R 10 E


TYPE MONUMENT PK/WASHER

ON SURFACE - ~~BELOW~~

LEFT - ~~C PAV'T.~~ - RIGHT 1.3' LT


9.6 TO LT EDGE PAVEMENT

S.L.M. 827+89

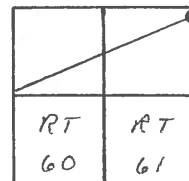

Record
 "A" Fd PK. @ surface
 1.3' Lt. of E Pav SR 65
 3.5' East of E Pav H.P. Rd
 "B" Fd Rail Road site w/
 @ surface origin unknown
 PI Sta. = 827+48.71
 A = 70°-31' 20" RT

SET PK/WASHER
 8-8-95
 SAH

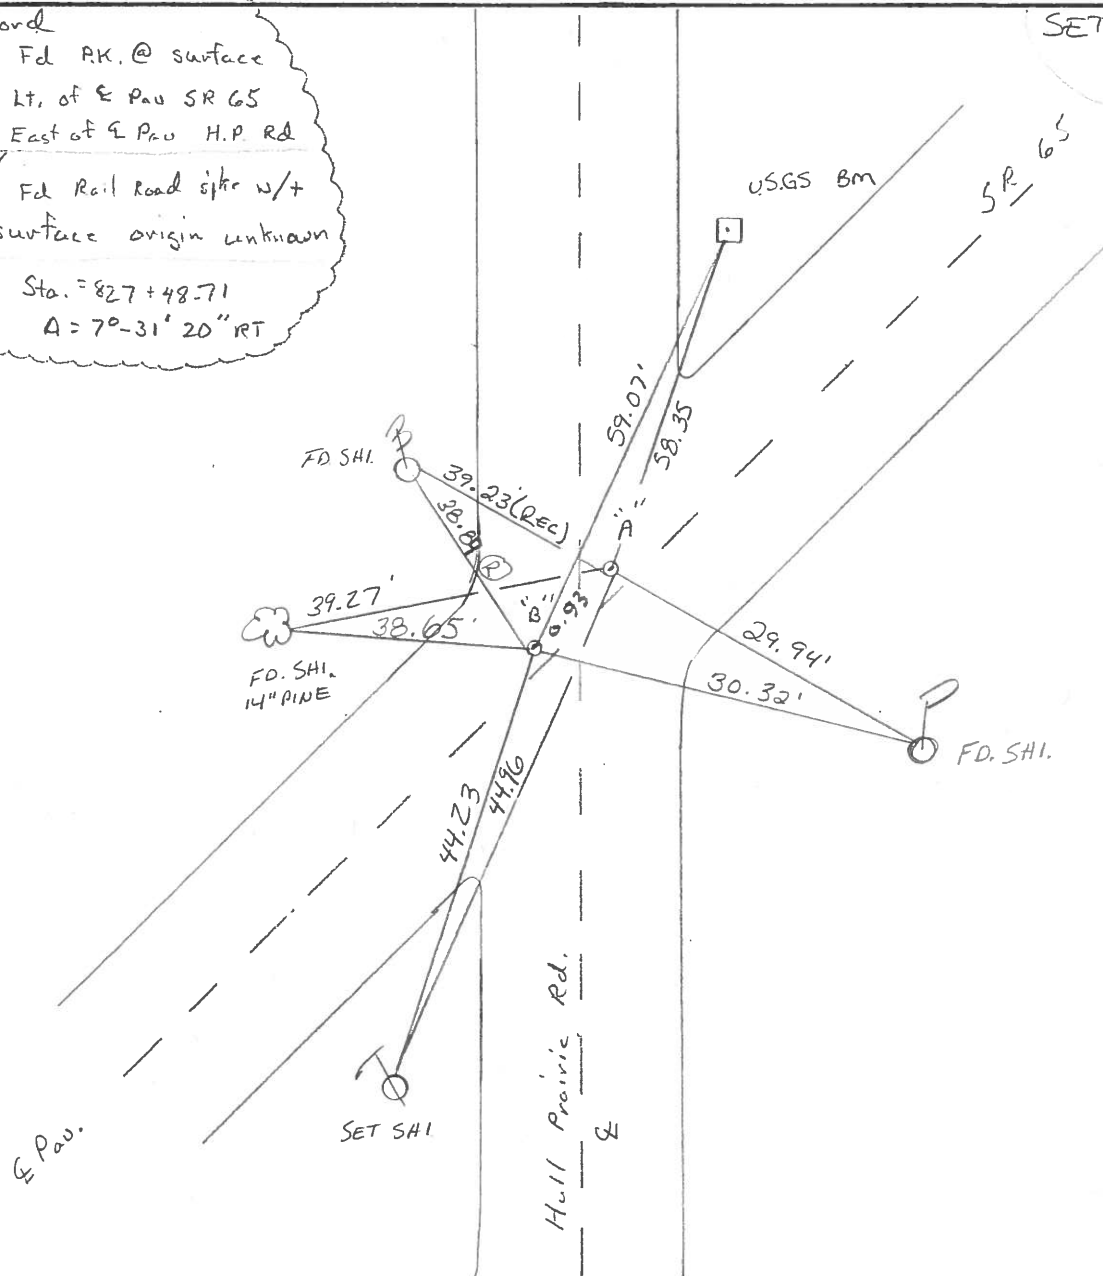

County WOOD S.R. 65

Date 5-10-84

Township PERRYSBURG

Weather clear

Section R.T. 61

Temp. 40°


T7N, R10E

Personnel HOFFMAN

LOENRKE

HOUSEHOLDER H.C.

BRANNISSEL RC

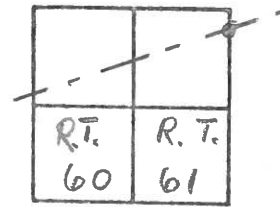

Ref. No 26

#26

SLM = 827+89

SET PK/WASHER
@ BOTH POINTS
11-5-84
SW.H.

"A" = Fd P.K. @ surface
1.4' LT. of & PAVT SR65
3.5' EAST of & PAVT Hull-PRairie.

Record:
P.I. STA. = 827+48.71
 $\Delta = 7^{\circ}-31'-20''$ RT.

"B" = Fd R.R. SPK w/ "T" @ surface
ORIGINAL UNKNOWN

