

O.D.O.T. DISTRICT 2 SURVEY OFFICE (USE ONLY)

PERSONNEL

REFERENCE NO. 5

SHEET 13 OF 30

NOTES ASTON

DATE 4/22/24

ROUTE SR 105

H.C. MILLER

WEATHER BREEZY

COUNTY WOOD

R.C. NIESE

TEMP. 50°

TOWNSHIP CENTER

SECTION 22

DWG BY _____ PID NO PID

T 5 N R 11 E

TYPE MONUMENT MINI MAG/ WASHER

ON SURFACE - BELOW ON

OFFSET Q PAVEMENT 2.7' LT : RT

7' TO LT EDGE PAVEMENT


STATION: 117+65

HORZ.DATUM: LDP:WOOD


GEOID: 18

GRID: NORTHING: 624910.033

EASTING: 1672433.494

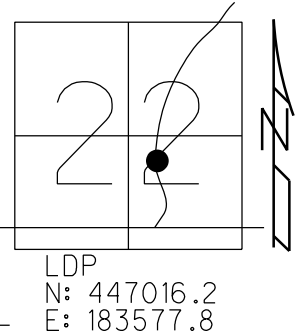


RECORD: P.I.
STA. 118+10.85
 $\Delta = 5^\circ 24' 20''$ RT
FD P.K./WASHER
4/15/02, MC
SET P.K./WASHER
6/12/02, DCH
FD P.K./WASHER
REF5
6/2/16, JFO
SET 1" MAG/WASHER
NEWREF5
6/20/17, JFO
FD MINI MAG/W
REF5
4-22-24, TDN

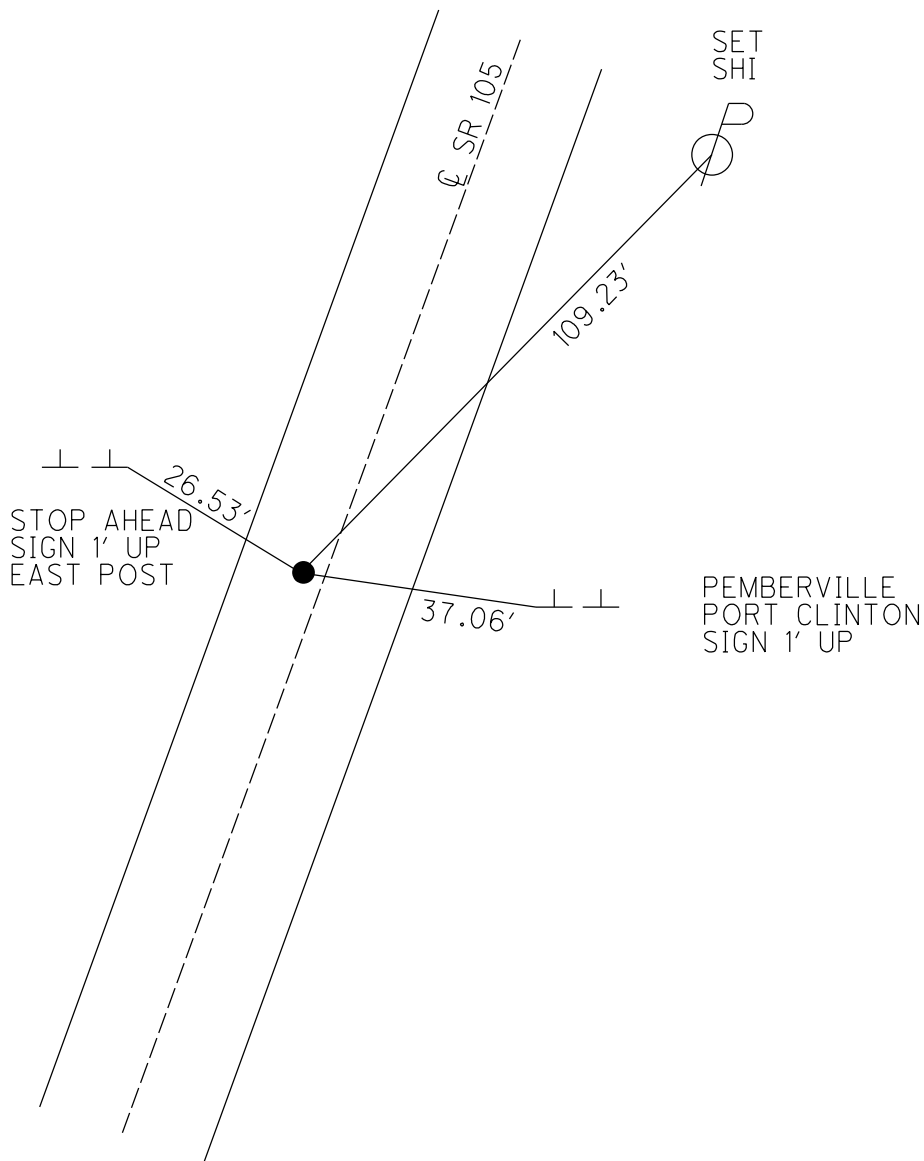

O.D.O.T. DISTRICT 2 SURVEY OFFICE (USE ONLY)


PERSONNEL	REFERENCE NO. <u>5</u>	SHEET <u>12</u> OF <u>28</u>
NOTES	DATE <u>9/9/16</u>	ROUTE <u>SR 105</u>
H.C. <u>RHOADES</u>	WEATHER <u>SUNNY</u>	COUNTY <u>WOOD</u>
R.C. <u>RHOADES</u>	TEMP. <u>82°</u>	TOWNSHIP <u>CENTER</u>
		SECTION <u>22</u>
		T <u>5</u> N <u>R</u> <u>11</u> E

TYPE MONUMENT P.K./WASHER
 ON SURFACE - ~~BELOW~~ ON
 LEFT - CL PAV'T - ~~RIGHT~~ 2.7'
7' TO LT EDGE PAVEMENT
 S.L.M. 117+65

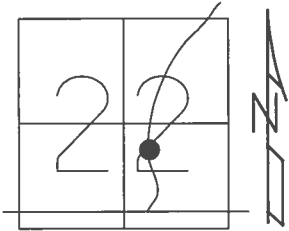

GRID: NORTHING: 624910.033 EASTING: 1672433.494

RECORD: P.I.
 STA. 118+10.85
 $\Delta = 5^\circ 24' 20''$ RT
 FD P.K./WASHER
 4/15/02, MC
 SET P.K./WASHER
 6/12/02, DCH
 FD P.K./WASHER
 REF5
 6/2/16, JFO
 SET 1" MAG/WASHER
 NEWREF5
 6/20/17, JFO

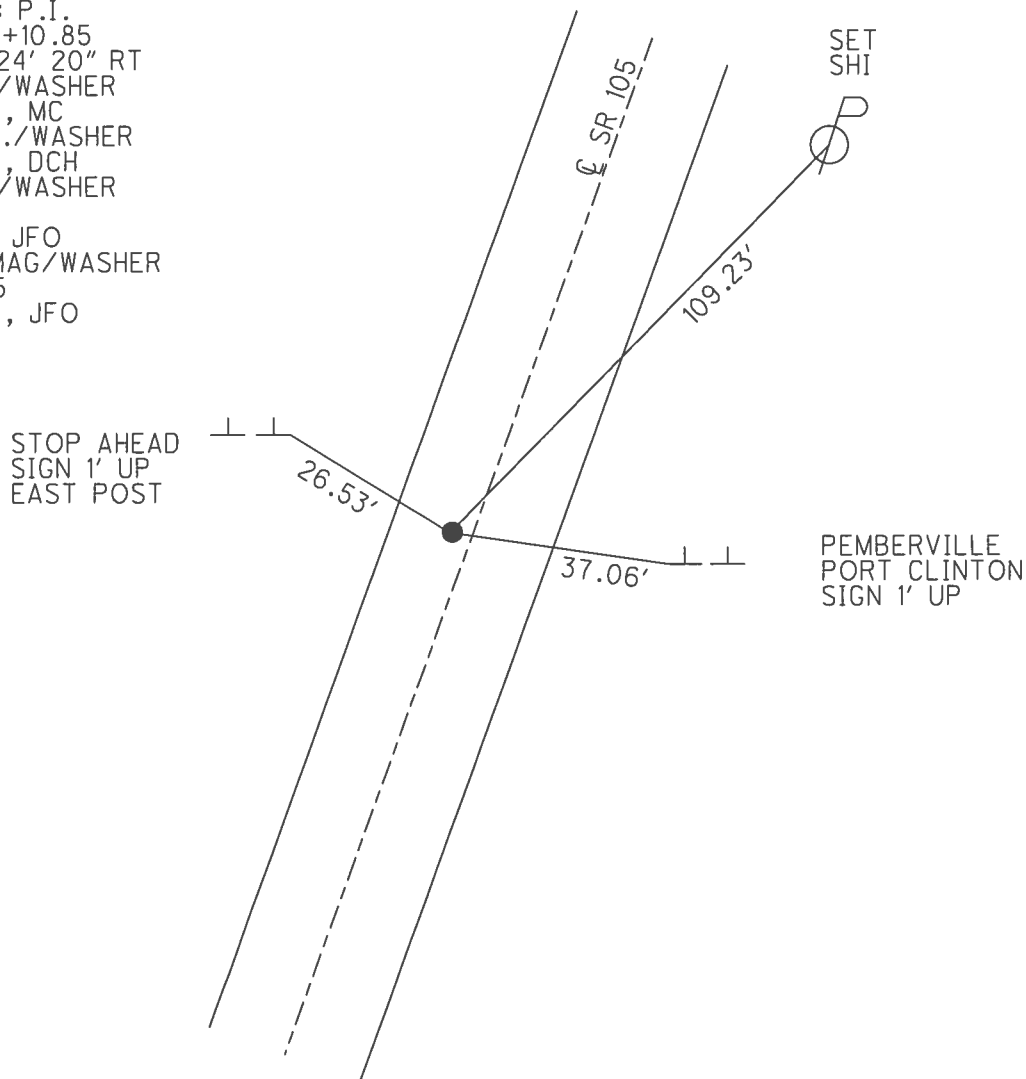

O.D.O.T. DISTRICT 2 SURVEY OFFICE (USE ONLY)

PERSONNEL

REFERENCE NO.

5

SHEET 12 OF 21

NOTES MOSER

DATE 4/15/02

ROUTE SR 105

H.C. MOSER

WEATHER SUNNY

COUNTY WOOD

R.C. CANTERBURY

TEMP. 65°

TOWNSHIP CENTER

SECTION 22

T 5 N R 11 E

TYPE MONUMENT P.K./WASHER

ON SURFACE - ~~BELOW~~ ON


LEFT - C PAV'T - ~~RIGHT~~ 2.7'

7' TO LT EDGE PAVEMENT


S.L.M. 117+65

GRID: NORTHING:_____ EASTING:_____

EASTING:

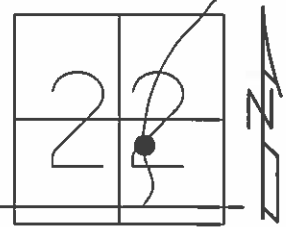

RECORD: P.I.
STA. 118+10.85
 $\Delta = 5^{\circ} 24' 20''$ RT
SET P.K./WASHER
6/12/02, DCH

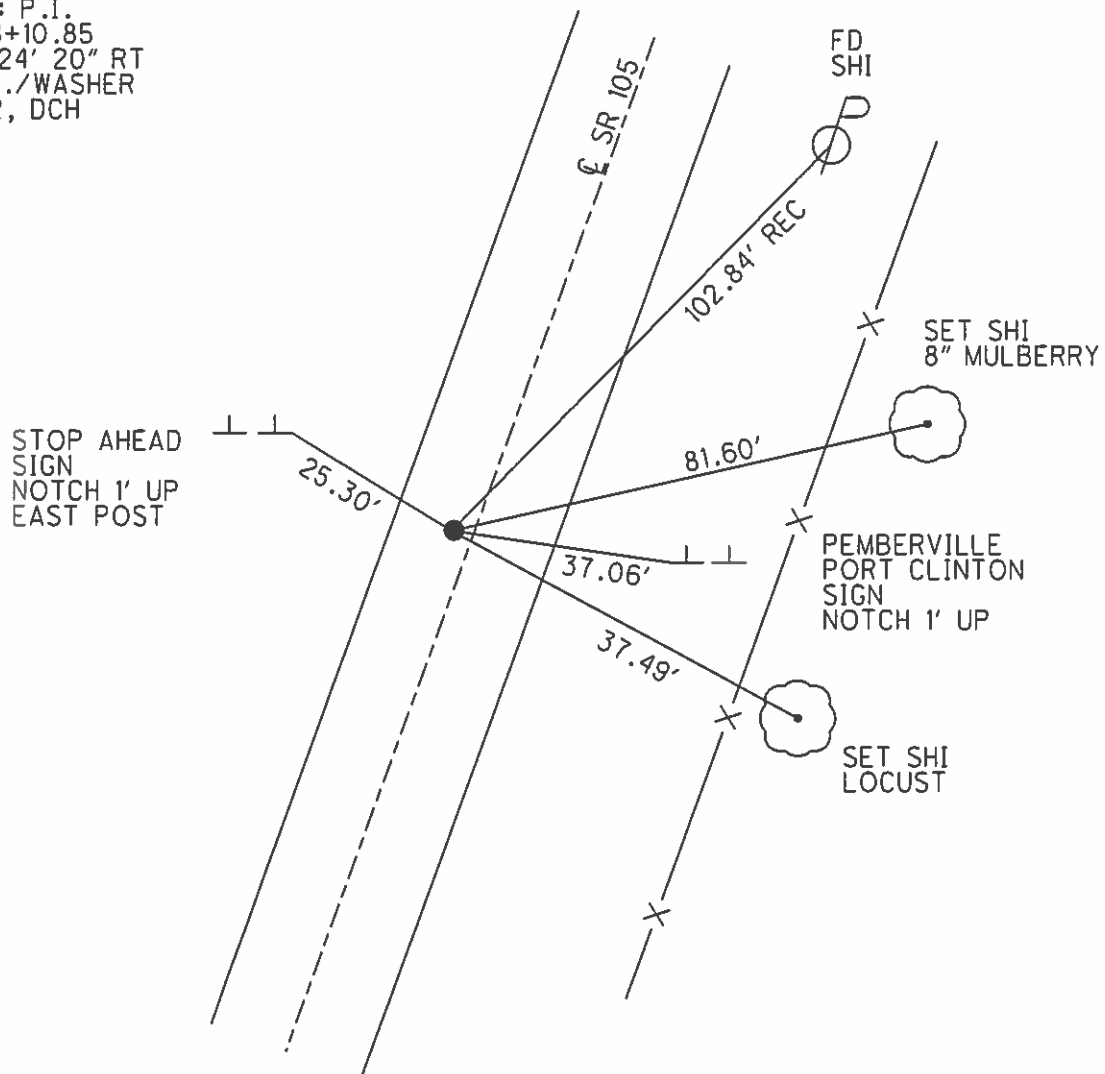

O.D.O.T. DISTRICT 2 SURVEY OFFICE

PERSONNEL

REFERENCE NO. 5

SHEET 10 OF 57

NOTES BARNHISEL

H.C. VAN DUSEN

R.C. BARNHISEL

DATE 8-15-91

WEATHER SUNNY

TEMP. +85°

ROUTE 105

COUNTY WOOD

TOWNSHIP CENTER

SECTION 22

T. 5 N. R. 11 E.


TYPE MONUMENT P.K. & WASHER

ON SURFACE - BELOW YES

LEFT- & PAV'T. - RIGHT 3.0


6.7 TO LT EDGE PAVEMENT

S.L.M. 117+65

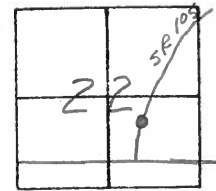

RECORD: P.I. #4
STA: 118+10.85
 $\Delta = 5^\circ 24' - 20''$ RT.

Set PK & WASHER
4-8-92
BUD

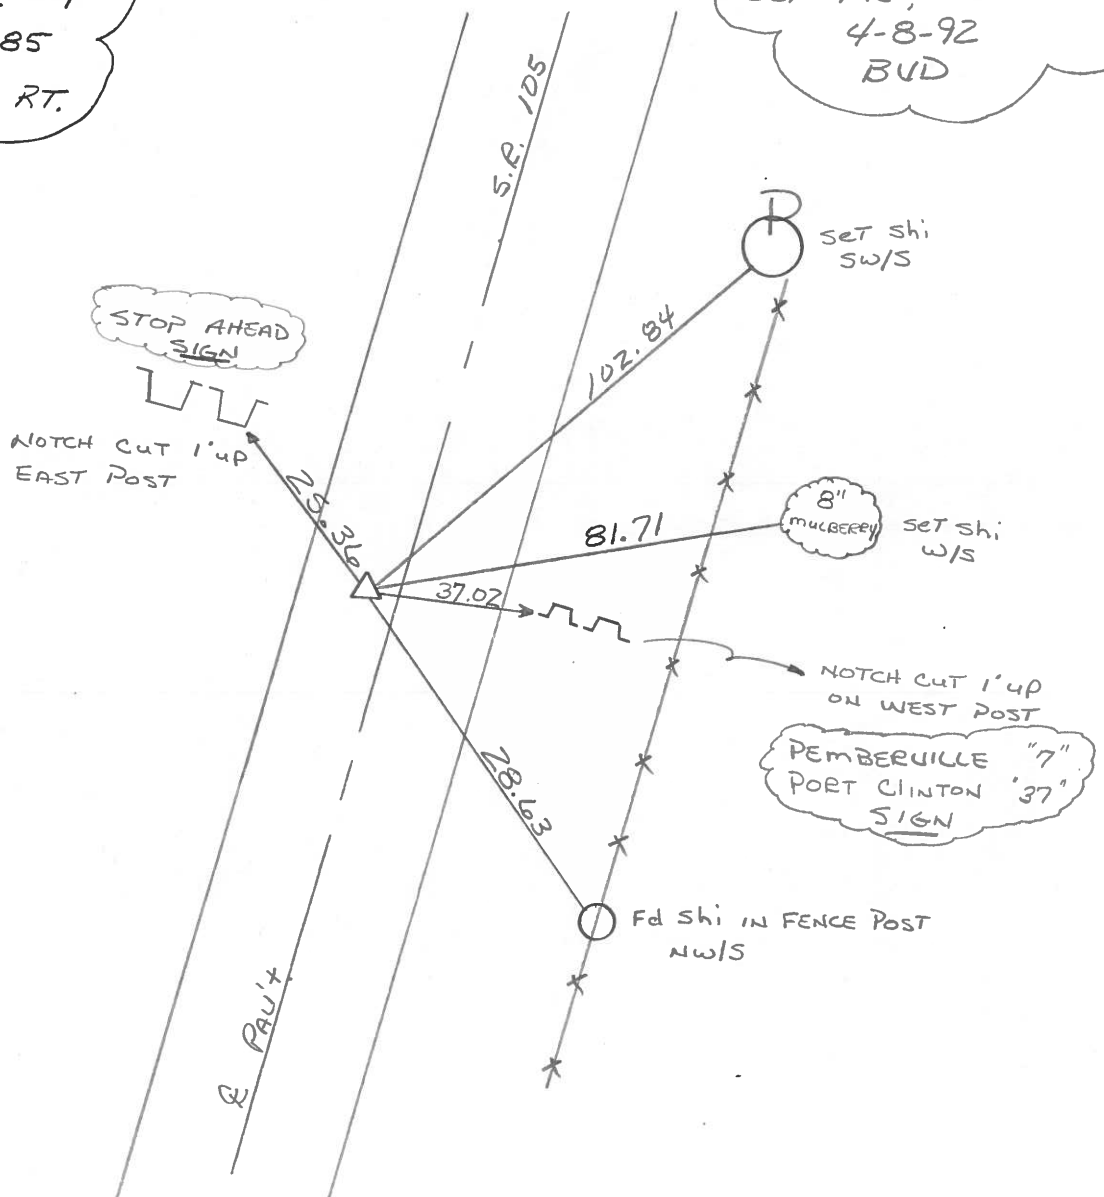


Q.D.O.T. DISTRICT 2 SURVEY OFFICE

SHEET _____ OF _____

County WOOD S.R. 105Township CENTERSection 22


T.N, R.E

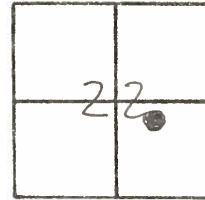Personnel HOFFMANHOUSEHOLDERLOEHRKEDate 4-19-82Weather CLEARTemp. +65°

#5

P.I. #4

STA. 118+10.85

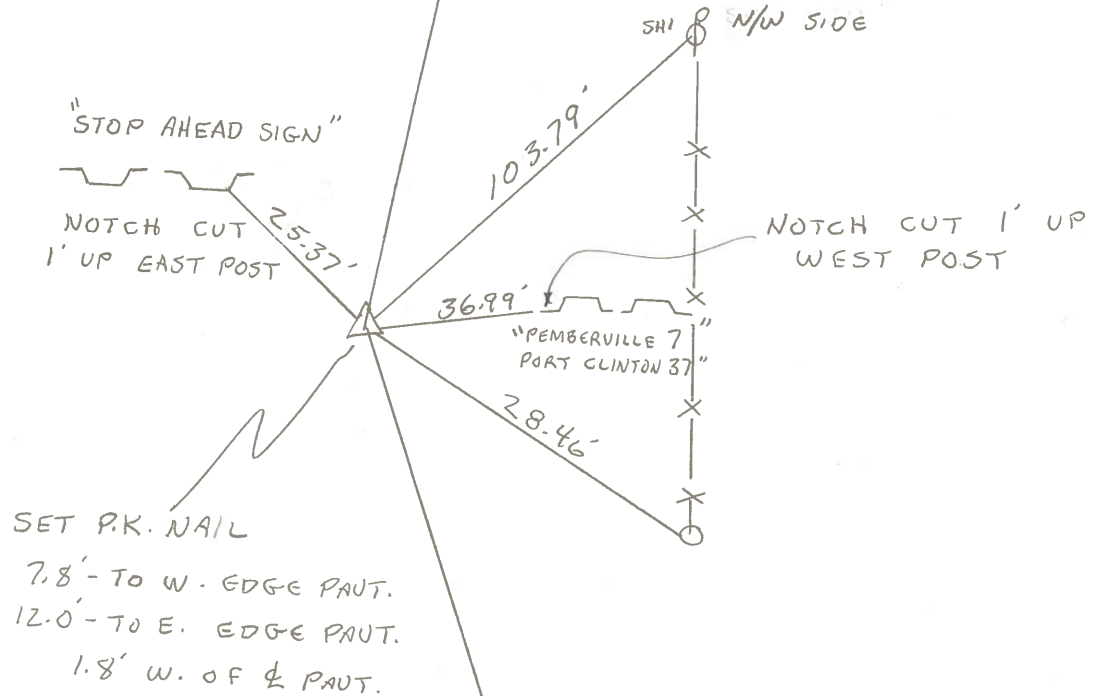 $\Delta = 5^{\circ}-24'-20''$ RT.SET P.K. & WASHER
5-25-82 S.W.H.

PERSONNEL	TITLE	PERSONNEL	TITLE	COUNTY	DATE	WEATHER	TEMP.
Stone	Notes			Wood	28 Aug. 72	Woods	78°
Dunn	H.C.			S. R. #105			
Curtis	R.C.			SEC. 22			
Brannen	PI						

DESCRIPTION References to Control Points JOB NO. _____

LEFT CENTER LINE RIGHT

