

O.D.O.T. DISTRICT 2 SURVEY OFFICE (USE ONLY)

PERSONNEL

REFERENCE NO. 12A

SHEET 24 OF 28

NOTES ASTON

DATE 4/22/2024

ROUTE SR 105

H.C. MILLER

WEATHER BREEZY

COUNTY WOOD

R.C. NIESE

TEMP. 30°

TOWNSHIP CENTER

SECTION 22

DWG BY _____ PID NO PID

T 5 N R 11 E

TYPE MONUMENT MAG/ WASHER

ON SURFACE - BELOW ON

OFFSET Q PAVEMENT 0.7' ~~LT~~ : RT

9.1' TO LT EDGE PAVEMENT


STATION: 153+00

HORIZ.DATUM: LDP:WOOD

GEOID: 18

GRID: NORTHING: 627678.020


EASTING: 1674450.970

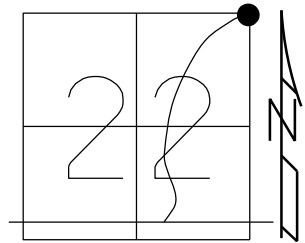

LDP
N: 449810.8
E: 185558.8

RECORD:


FD P.K./WASHER
4/15/02, MB
SET P.K./WASHER
6/12/02, DCH
FD P.K./WASHER
REFA12
6/2/16, JFO
SET MAG/WASHER
NEWREFA12
6/20/17, JFO
FD MAG/W
REF12A
4-22-24, JAM

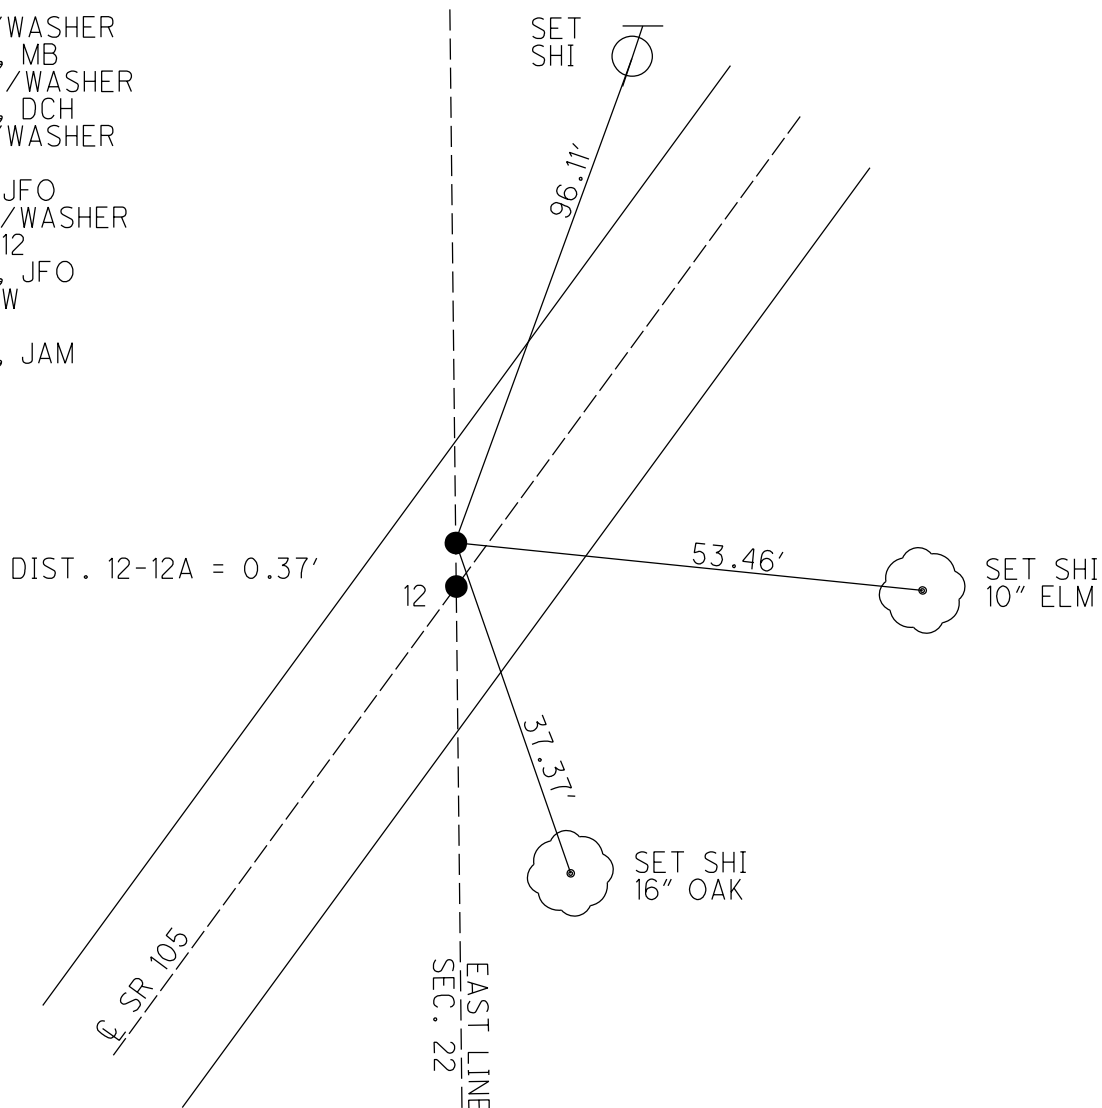

O.D.O.T. DISTRICT 2 SURVEY OFFICE (USE ONLY)


PERSONNEL	REFERENCE NO. <u>12 A</u>	SHEET <u>21</u> OF <u>28</u>
NOTES	DATE <u>9/12/16</u>	ROUTE <u>SR 105</u>
H.C. <u>RHOADES</u>	WEATHER <u>SUNNY</u>	COUNTY <u>WOOD</u>
R.C. <u>RHOADES</u>	TEMP. <u>55°</u>	TOWNSHIP <u>CENTER</u>
		SECTION <u>22</u>
		T <u>5</u> N R <u>11</u> E

TYPE MONUMENT P.K./WASHER
 ON SURFACE - ~~BELOW~~ ON
 LEFT - C PAV'T - ~~RIGHT~~ 0.7'
9.1' TO LT EDGE PAVEMENT
 S.L.M. 153+00

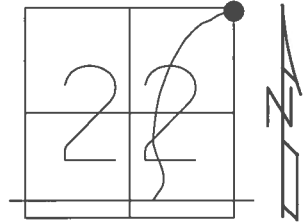

GRID: NORTHING: 627678.020 EASTING: 1674450.970

RECORD:
 FD P.K./WASHER
 4/15/02, MB
 SET P.K./WASHER
 6/12/02, DCH
 FD P.K./WASHER
 REFA12
 6/2/16, JFO
 SET MAG/WASHER
 NEWREFA12
 6/20/17, JFO

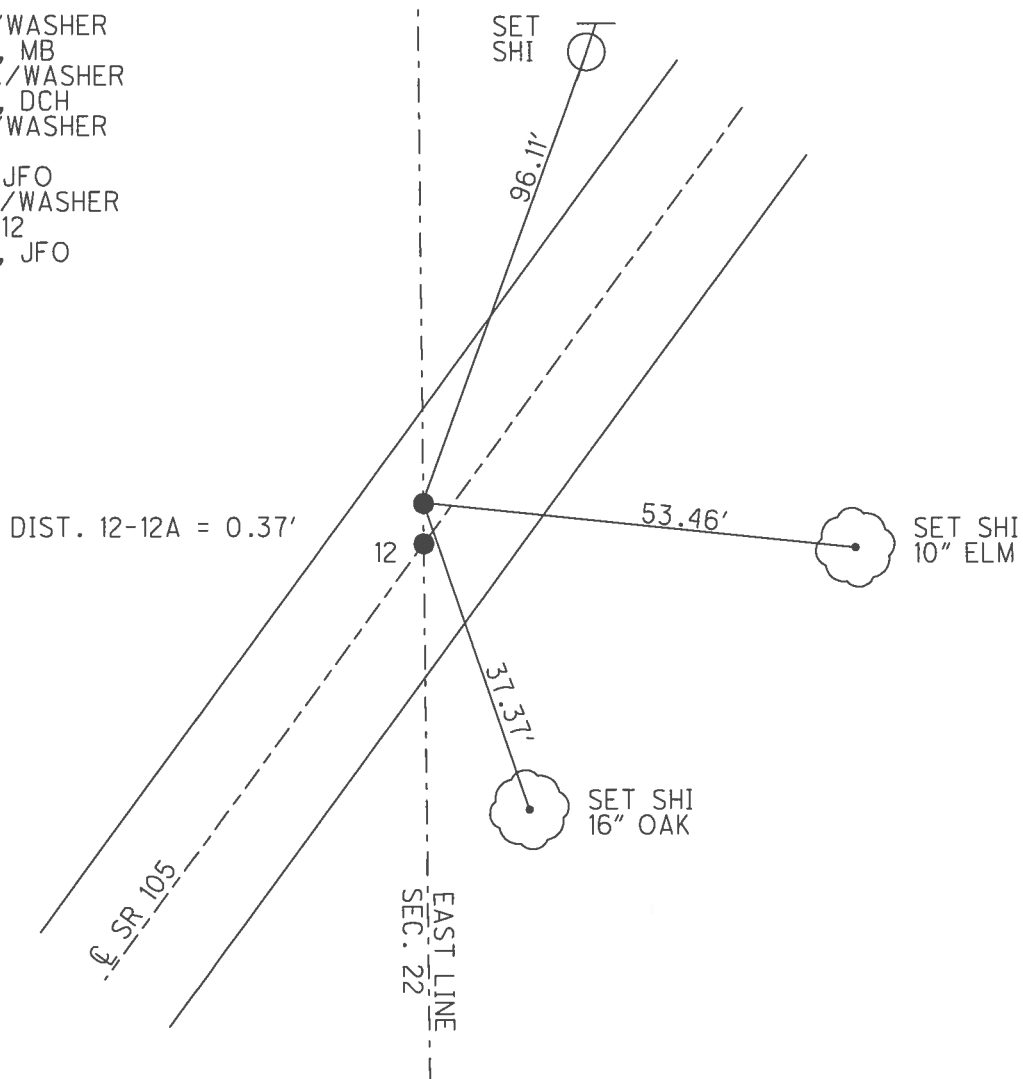


SR 105

O.D.O.T. DISTRICT 2 SURVEY OFFICE (USE ONLY)


PERSONNEL	REFERENCE NO. <u>12 A</u>	SHEET <u>21</u> OF <u>21</u>	
NOTES	DATE <u>4/15/02</u>	ROUTE <u>SR 105</u>	
H.C. <u>MOSER</u>	WEATHER <u>SUNNY</u>	COUNTY <u>WOOD</u>	
R.C. <u>CANTERBURY</u>	TEMP. <u>70°</u>	TOWNSHIP <u>CENTER</u>	
		SECTION <u>22</u>	
		T <u>5</u> N R <u>11</u> E	

TYPE MONUMENT P.K./WASHER
 ON SURFACE - ~~BELOW~~ ON
 LEFT - Q PAV'T - RIGHT ON
9.1' TO LT EDGE PAVEMENT
 S.L.M. 153+00

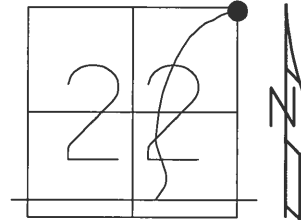

GRID: NORTHING: _____ EASTING: _____

SET P.K./WASHER
6/12/02, DCH

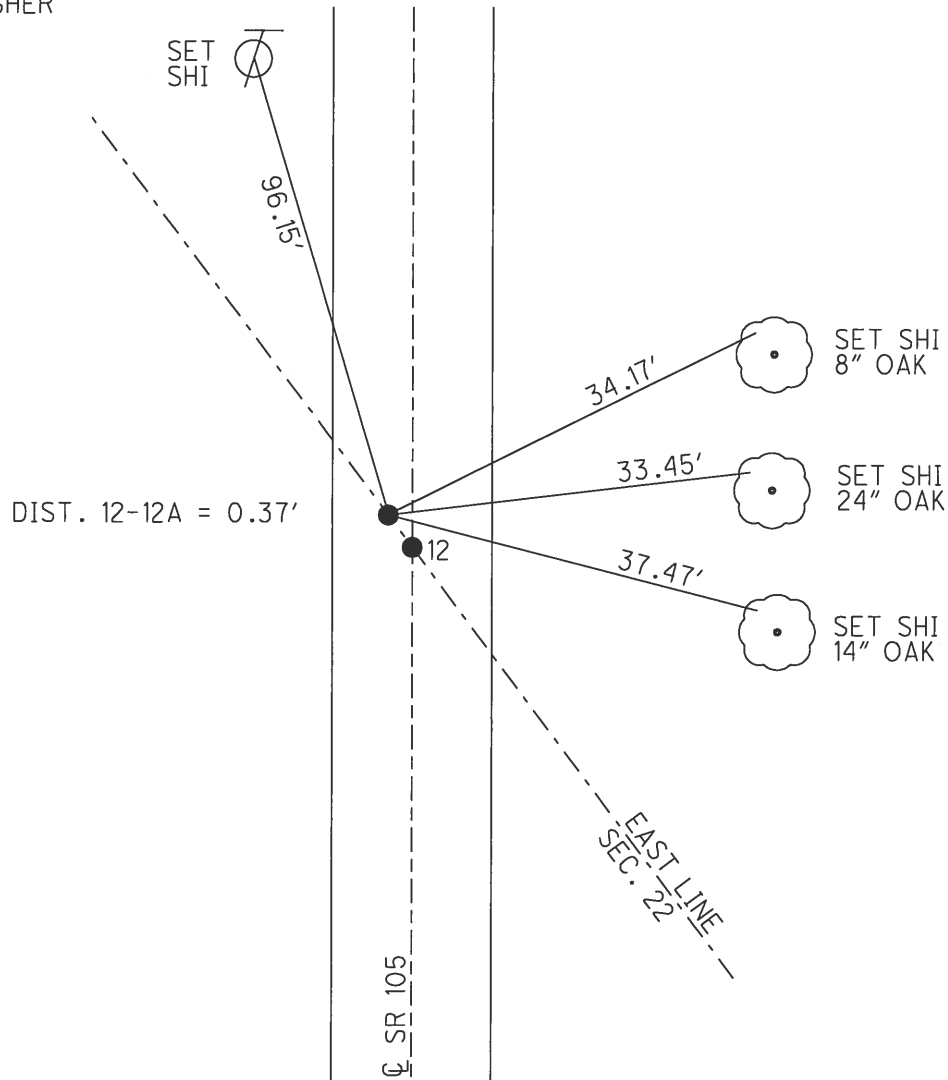

O.D.O.T. DISTRICT 2 SURVEY OFFICE

PERSONNEL

REFERENCE NO. 12

SHEET 17 OF 57

NOTES LONG

H.C. VANDUSEN

R.C. BARNHISEL

DATE 8-19-91

WEATHER cloudy

TEMP. 70°

ROUTE 105

COUNTY WOOD

TOWNSHIP CENTER

SECTION 22

T 5 N R 11 E

TYPE MONUMENT PK & WASHER



ON SURFACE - BELOW YES

~~LEFT~~ - C PAV'T. - RIGHT yes

10.5 TO RT EDGE PAVEMENT

S.L.M. 152+96

0.39 BETWEEN PTS

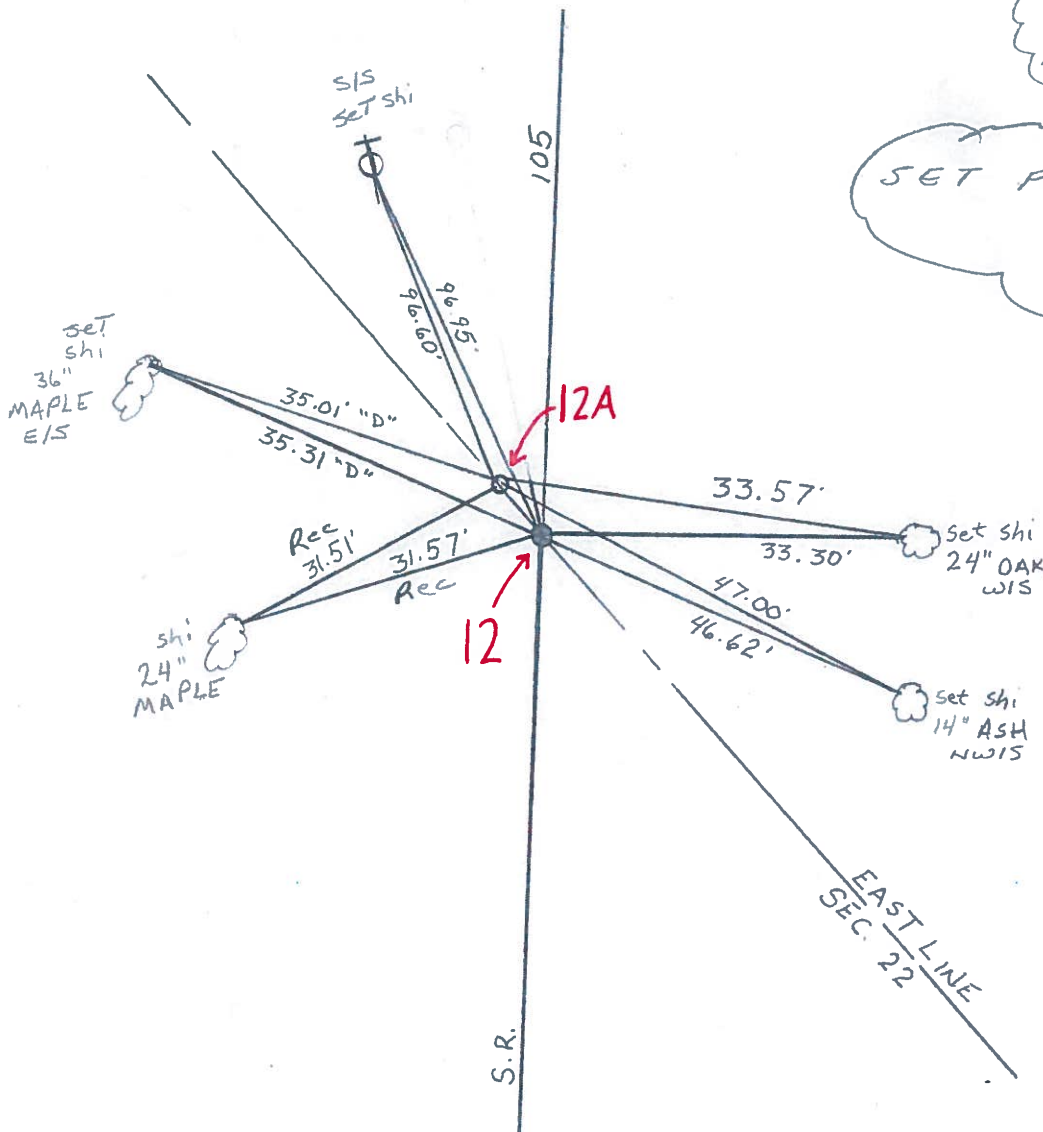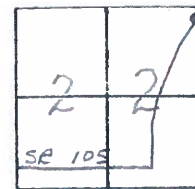


RECORD
P.O.T.
153+65.35

SET PK & WASHER
4-8-92
BVD

County WOOD S.R. 105Date 4-19-82Township CENTERWeather CLEARSection 22Temp. +72°

T.N, R.E

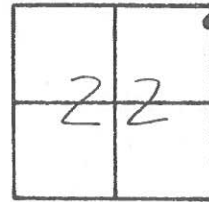Personnel HOFFMANHOUSEHOLDERLOEHRKE# 12

P.O.T.

153+65.35

