


O.D.O.T. DISTRICT 2 SURVEY OFFICE (USE ONLY)


PERSONNEL _____ REFERENCE NO. 44 A SHEET 51 OF 54
 NOTES RHOADES DATE 9/13/16 ROUTE SR 105
 H.C. O'DONNELL WEATHER SUNNY COUNTY WOOD
 R.C. TODD TEMP. 76° TOWNSHIP WEBSTER
 _____ SECTION 7
 _____ T 5 N R 11 E

TYPE MONUMENT P.K./WASHER
 ON SURFACE - ~~BELOW~~ ON _____
~~LEFT~~ - ☉ PAV'T - RIGHT _____
 _____ TO _____ EDGE PAVEMENT
 S.L.M. 294+03

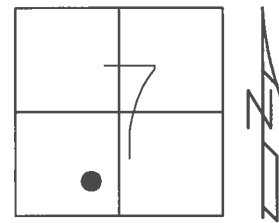

GRID: NORTHING: 633441.951 EASTING: 1686650.218


RECORD:
 FD P.K./WASHER
 4/15/02, DCH
 SET P.K./WASHER
 6/13/02, DCH
 FD P.K./WASHER
 REFA44
 6/10/16, JFO
 SET 1" MAG/WASHER
 8/2/17, DCH

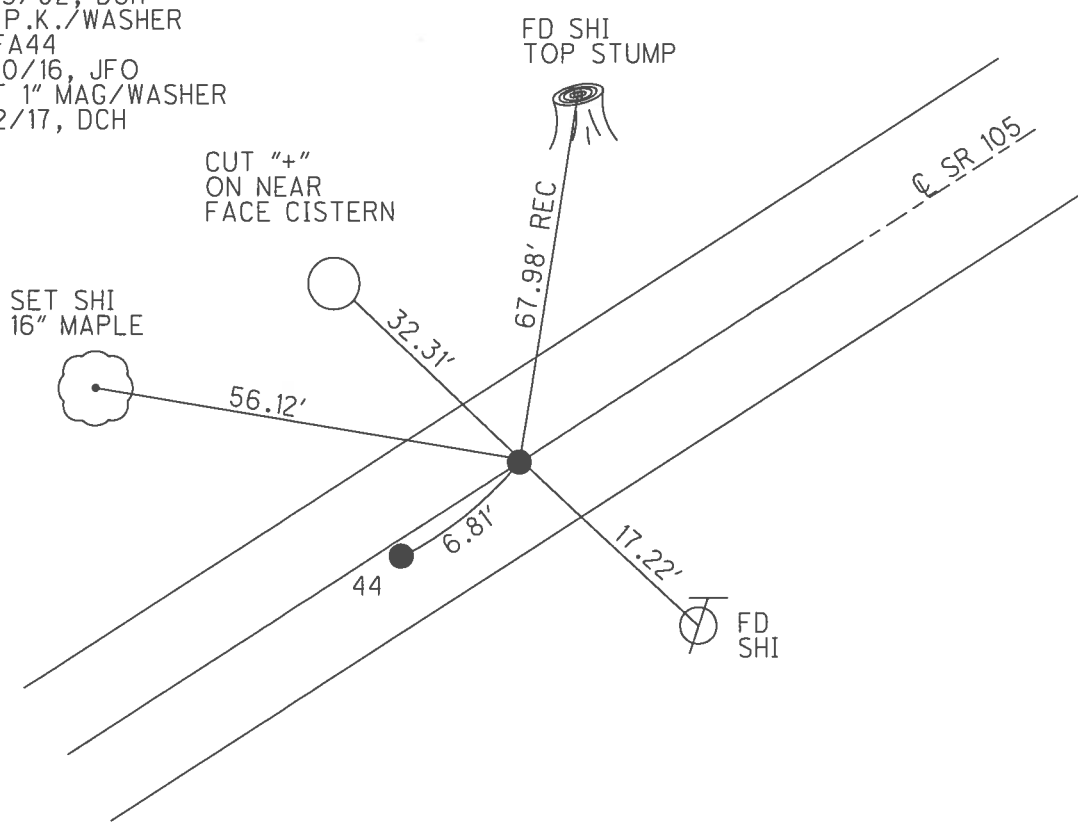

O.D.O.T. DISTRICT 2 SURVEY OFFICE (USE ONLY)


PERSONNEL _____ REFERENCE NO. 44 A SHEET 51 OF 54
 NOTES ROUSOS DATE 4/15/02 ROUTE SR 105
 H.C. HOMAN WEATHER SUNNY COUNTY WOOD
 R.C. BROWN TEMP. 74° TOWNSHIP WEBSTER
 _____ SECTION 7
 _____ T 5 N R 11 E

TYPE MONUMENT P.K./WASHER
 ON SURFACE - ~~BELOW~~ ON _____
~~LEFT~~ - ☉ PAV'T - RIGHT _____
 - TO - EDGE PAVEMENT
 S.L.M. 294+03

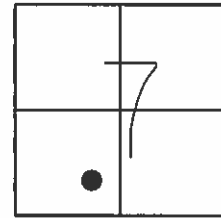

GRID: NORTHING: _____ EASTING: _____

RECORD:
 SET P.K./WASHER
 6/13/02, DCH

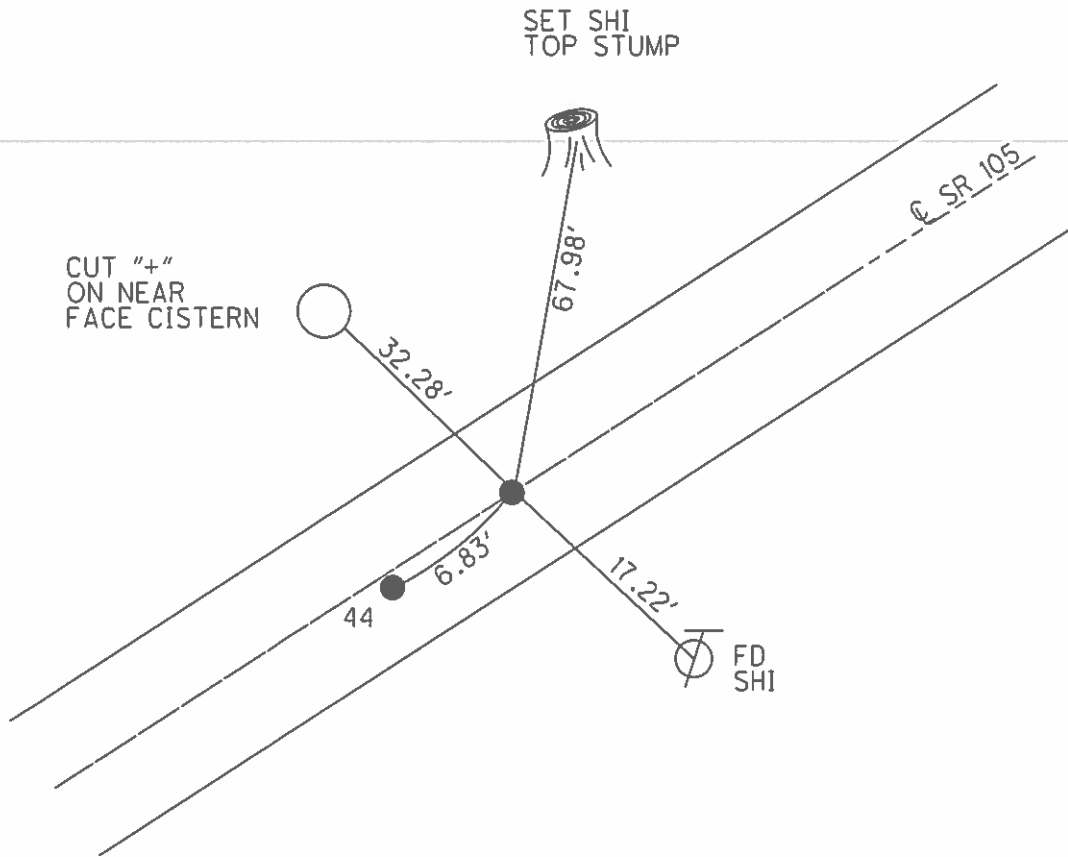

O.D.O.T. DISTRICT 2 SURVEY OFFICE

PERSONNEL

REFERENCE NO. 44

SHEET 54 OF 57

NOTES LONG

H.C. VANDUSEN

R.C. BARNHISEL

DATE 8-27-91

WEATHER SUNNY

TEMP. 88°

ROUTE 105

COUNTY WOOD

TOWNSHIP WEBSTER

SECTION 7

T. 5 N. R. 11 E.


TYPE MONUMENT P.K./WASHER

ON SURFACE - BELOW YES

LEFT- & PAV'T. - RIGHT 1.0'

9.2' TO RT EDGE PAVEMENT


S.L.M. 293+94 "A"

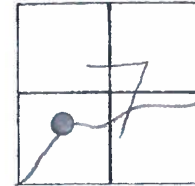

SET PK & WASHER
 4-9-92
 BVD

RECORD
 P.I. #40
 295+17.31
 $\Delta = 1^{\circ} - 05' - 20''$ LT.

A=44
B=44A

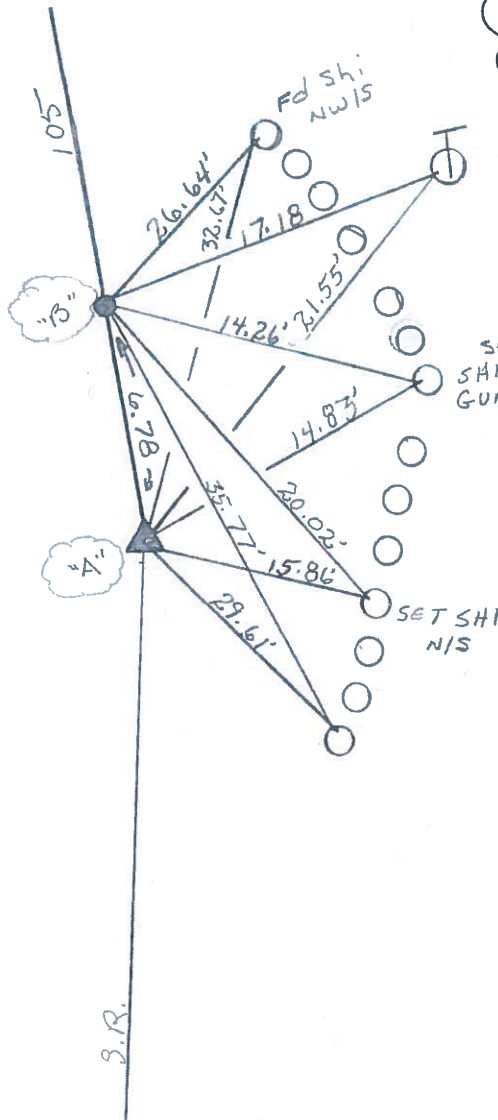

SET SHINERS IN GUARD RAIL POSTS N/S

SET SHI N/S

County WOOD S.R. 105

Date 4-23

Township WEBSTER

Weather CLOUDY

Section 7

Temp. +45


T, N, R, E

Personnel HOFFMAN

HOUSEHOLDER

LOHRKE

#44

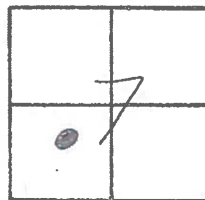


P.I. #40

295+17.31

1" Δ = 1°-05'-20" LT.

A = 44
B = 44A

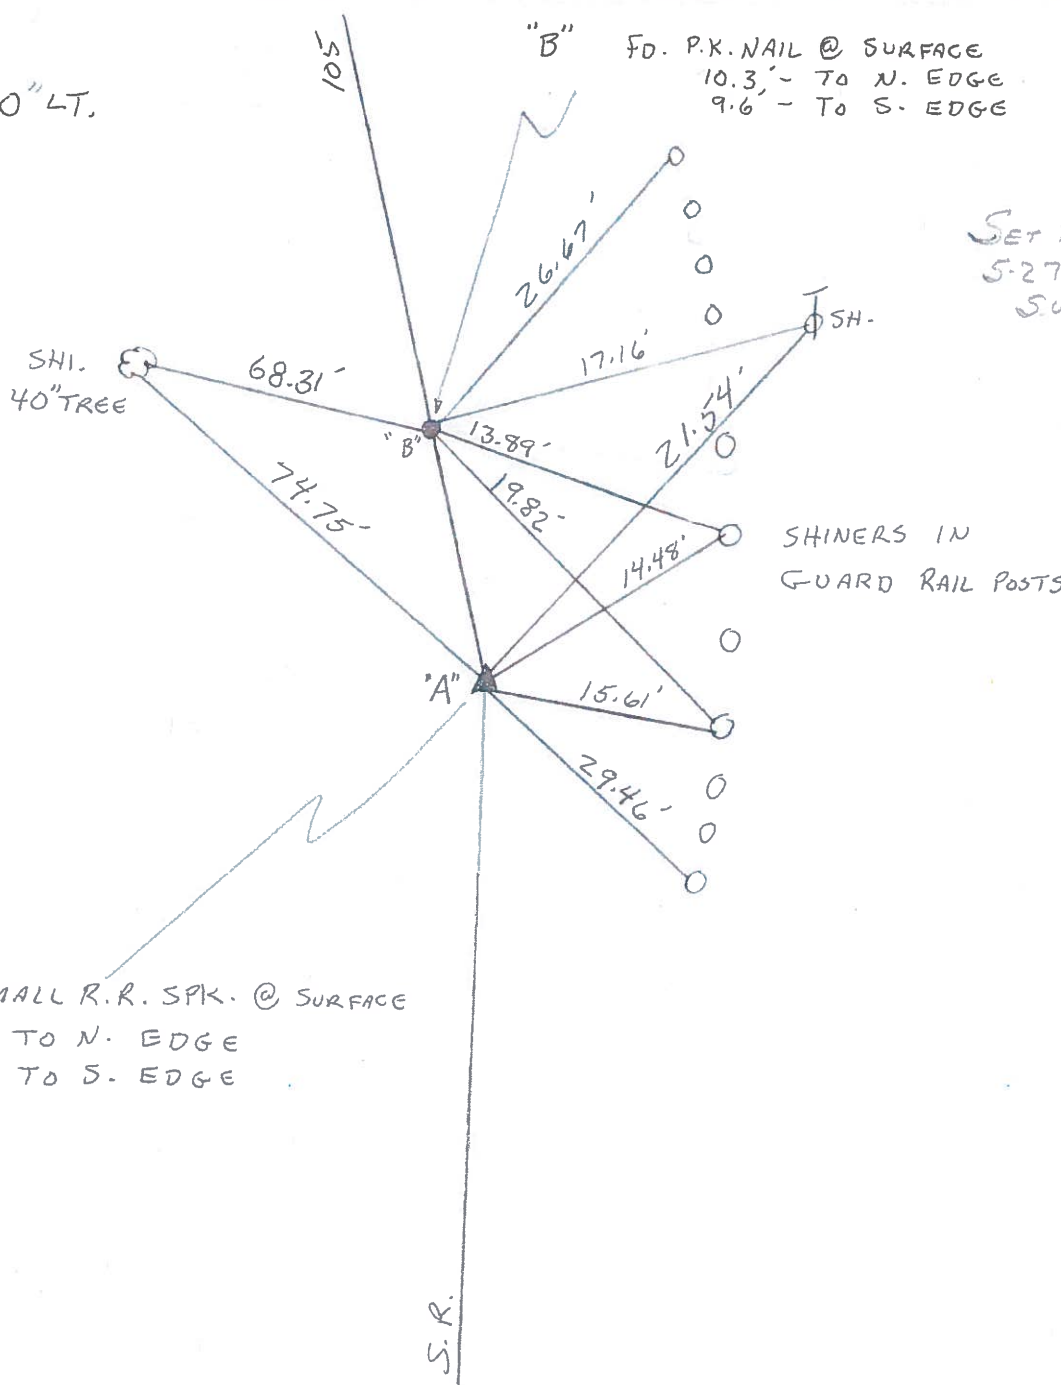

"B" FD. P.K. NAIL @ SURFACE
10.3' - TO N. EDGE
9.6' - TO S. EDGE

SET P.K./WASAG
5-27-82
S.W.H.

SHINERS IN
GUARD RAIL POSTS

FD. SMALL R.R. SPK. @ SURFACE
10.3 - TO N. EDGE
9.6 - TO S. EDGE

S.R.